



STATE OF VERMONT AGENCY OF TRANSPORTATION

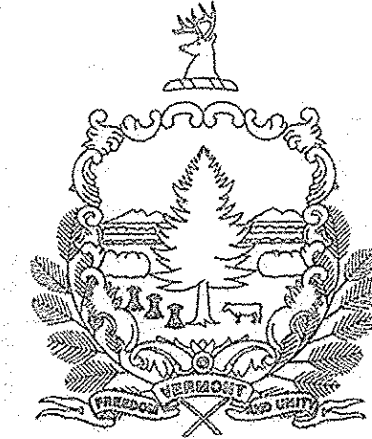

PROPOSED IMPROVEMENT BRIDGE PROJECT TOWN OF BRIDPORT COUNTY OF ADDISON VT ROUTE 125 (MAJOR COLLECTOR) BRIDGE NUMBERS 2 AND 5

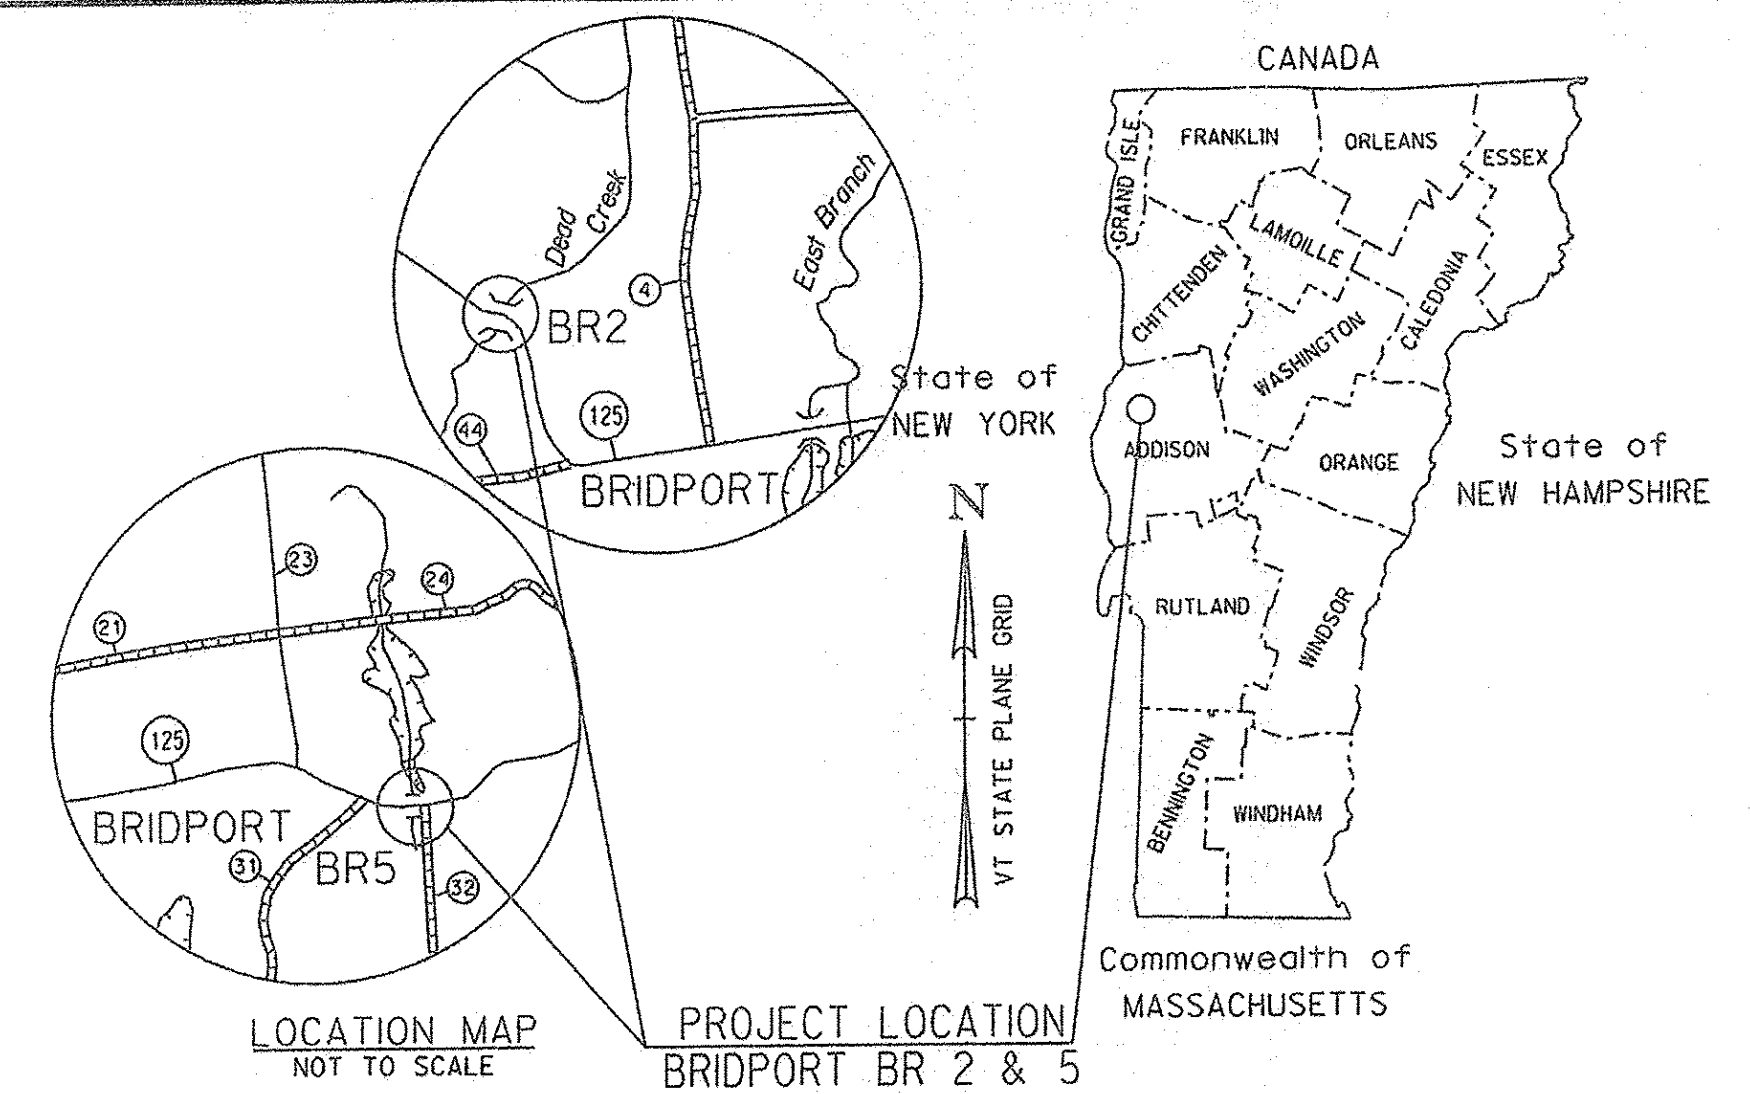



RECORD PLANS	
CONTRACTOR:	PECKHAM ROAD CORPORATION - WHITE PLAINS, NY
RESIDENT ENGINEER:	CHRIS LAVALETTE
CONSTRUCTION BEGAN:	MAY 21, 2015
CONSTRUCTION COMPLETE:	AUGUST 6, 2015
RECORD PLANS BY:	CHRIS LAVALETTE & AARON JAMES
I HEREBY CERTIFY THAT ALL THE CONSTRUCTION REQUIRED BY THIS SET OF DRAWINGS HAS BEEN ACCOMPLISHED AS INDICATED HEREIN.	
BY:	RESIDENT ENGINEER
DATE:	9/1/16
NOTE: Any further information concerning final quantities, amounts or other details relative to this project may be found at Central Files in the electronic archives.	

PROJECT LOCATION: BRIDGE NO. 2 IS LOCATED ON VERMONT ROUTE 125, 2.3 MILES WEST OF THE JUNCTION WITH VERMONT ROUTE 22A. BRIDGE NO. 5 IS LOCATED ON VERMONT ROUTE 125, 1.6 MILES EAST OF THE JUNCTION WITH VERMONT ROUTE 22A.

PROJECT DESCRIPTION: REPLACEMENT OF EXISTING CORRUGATED STEEL CULVERTS WITH PRECAST CONCRETE STRUCTURES ALONG WITH RELATED ROADWAY AND CHANNEL WORK.


LENGTH OF PROJECT: BRIDGE 2: 140 FEET
BRIDGE 5: 80 FEET

TOTAL PROJECT LENGTH: 220 FEET

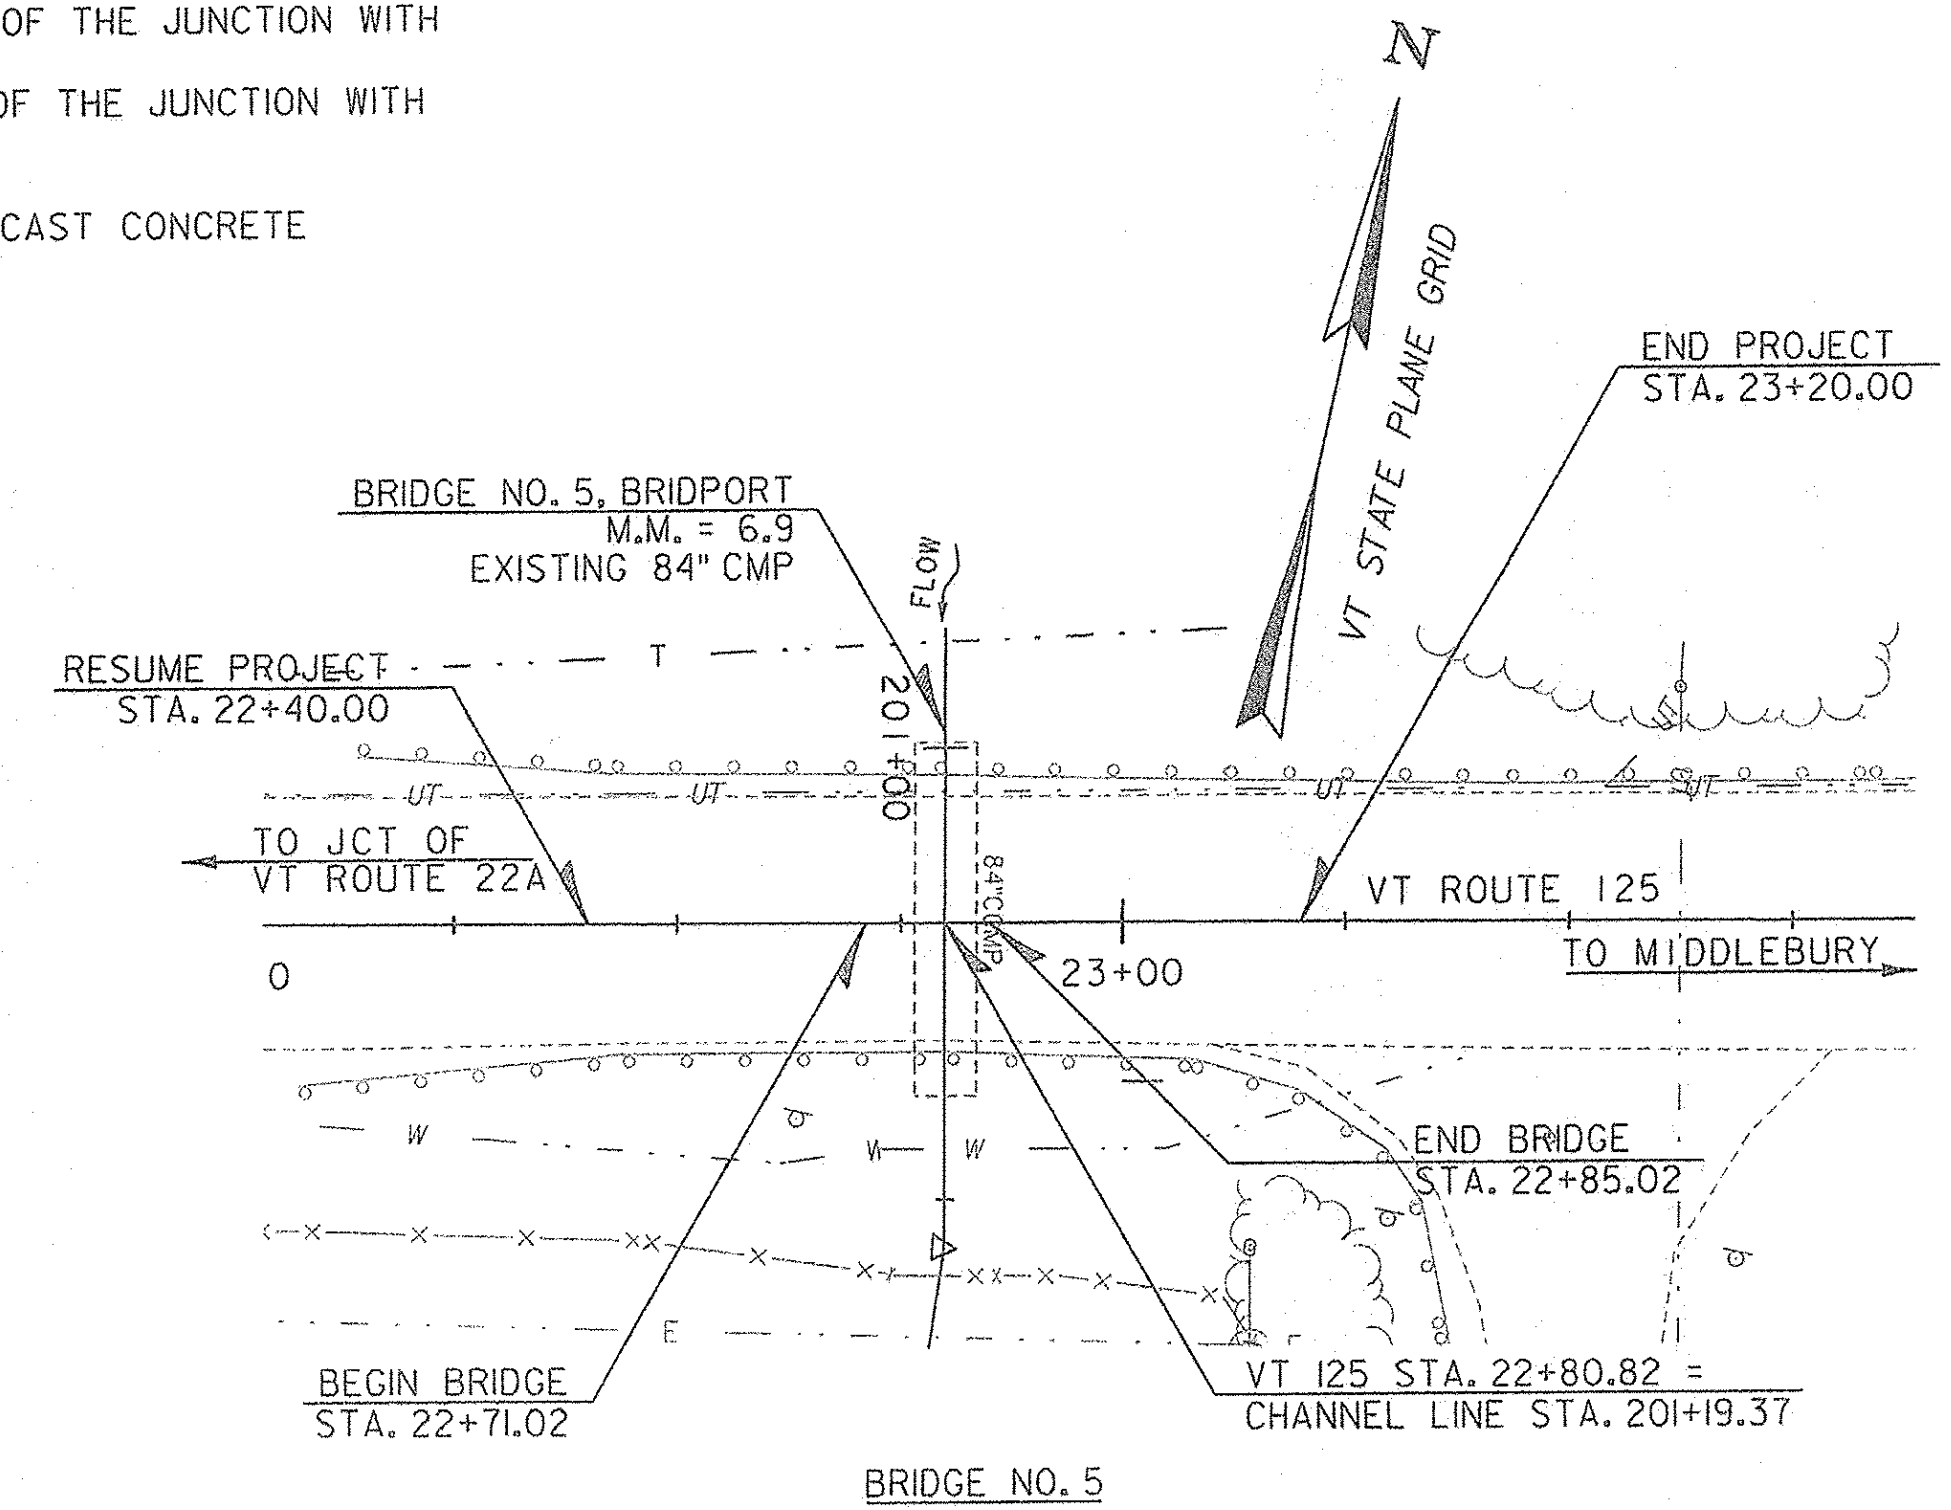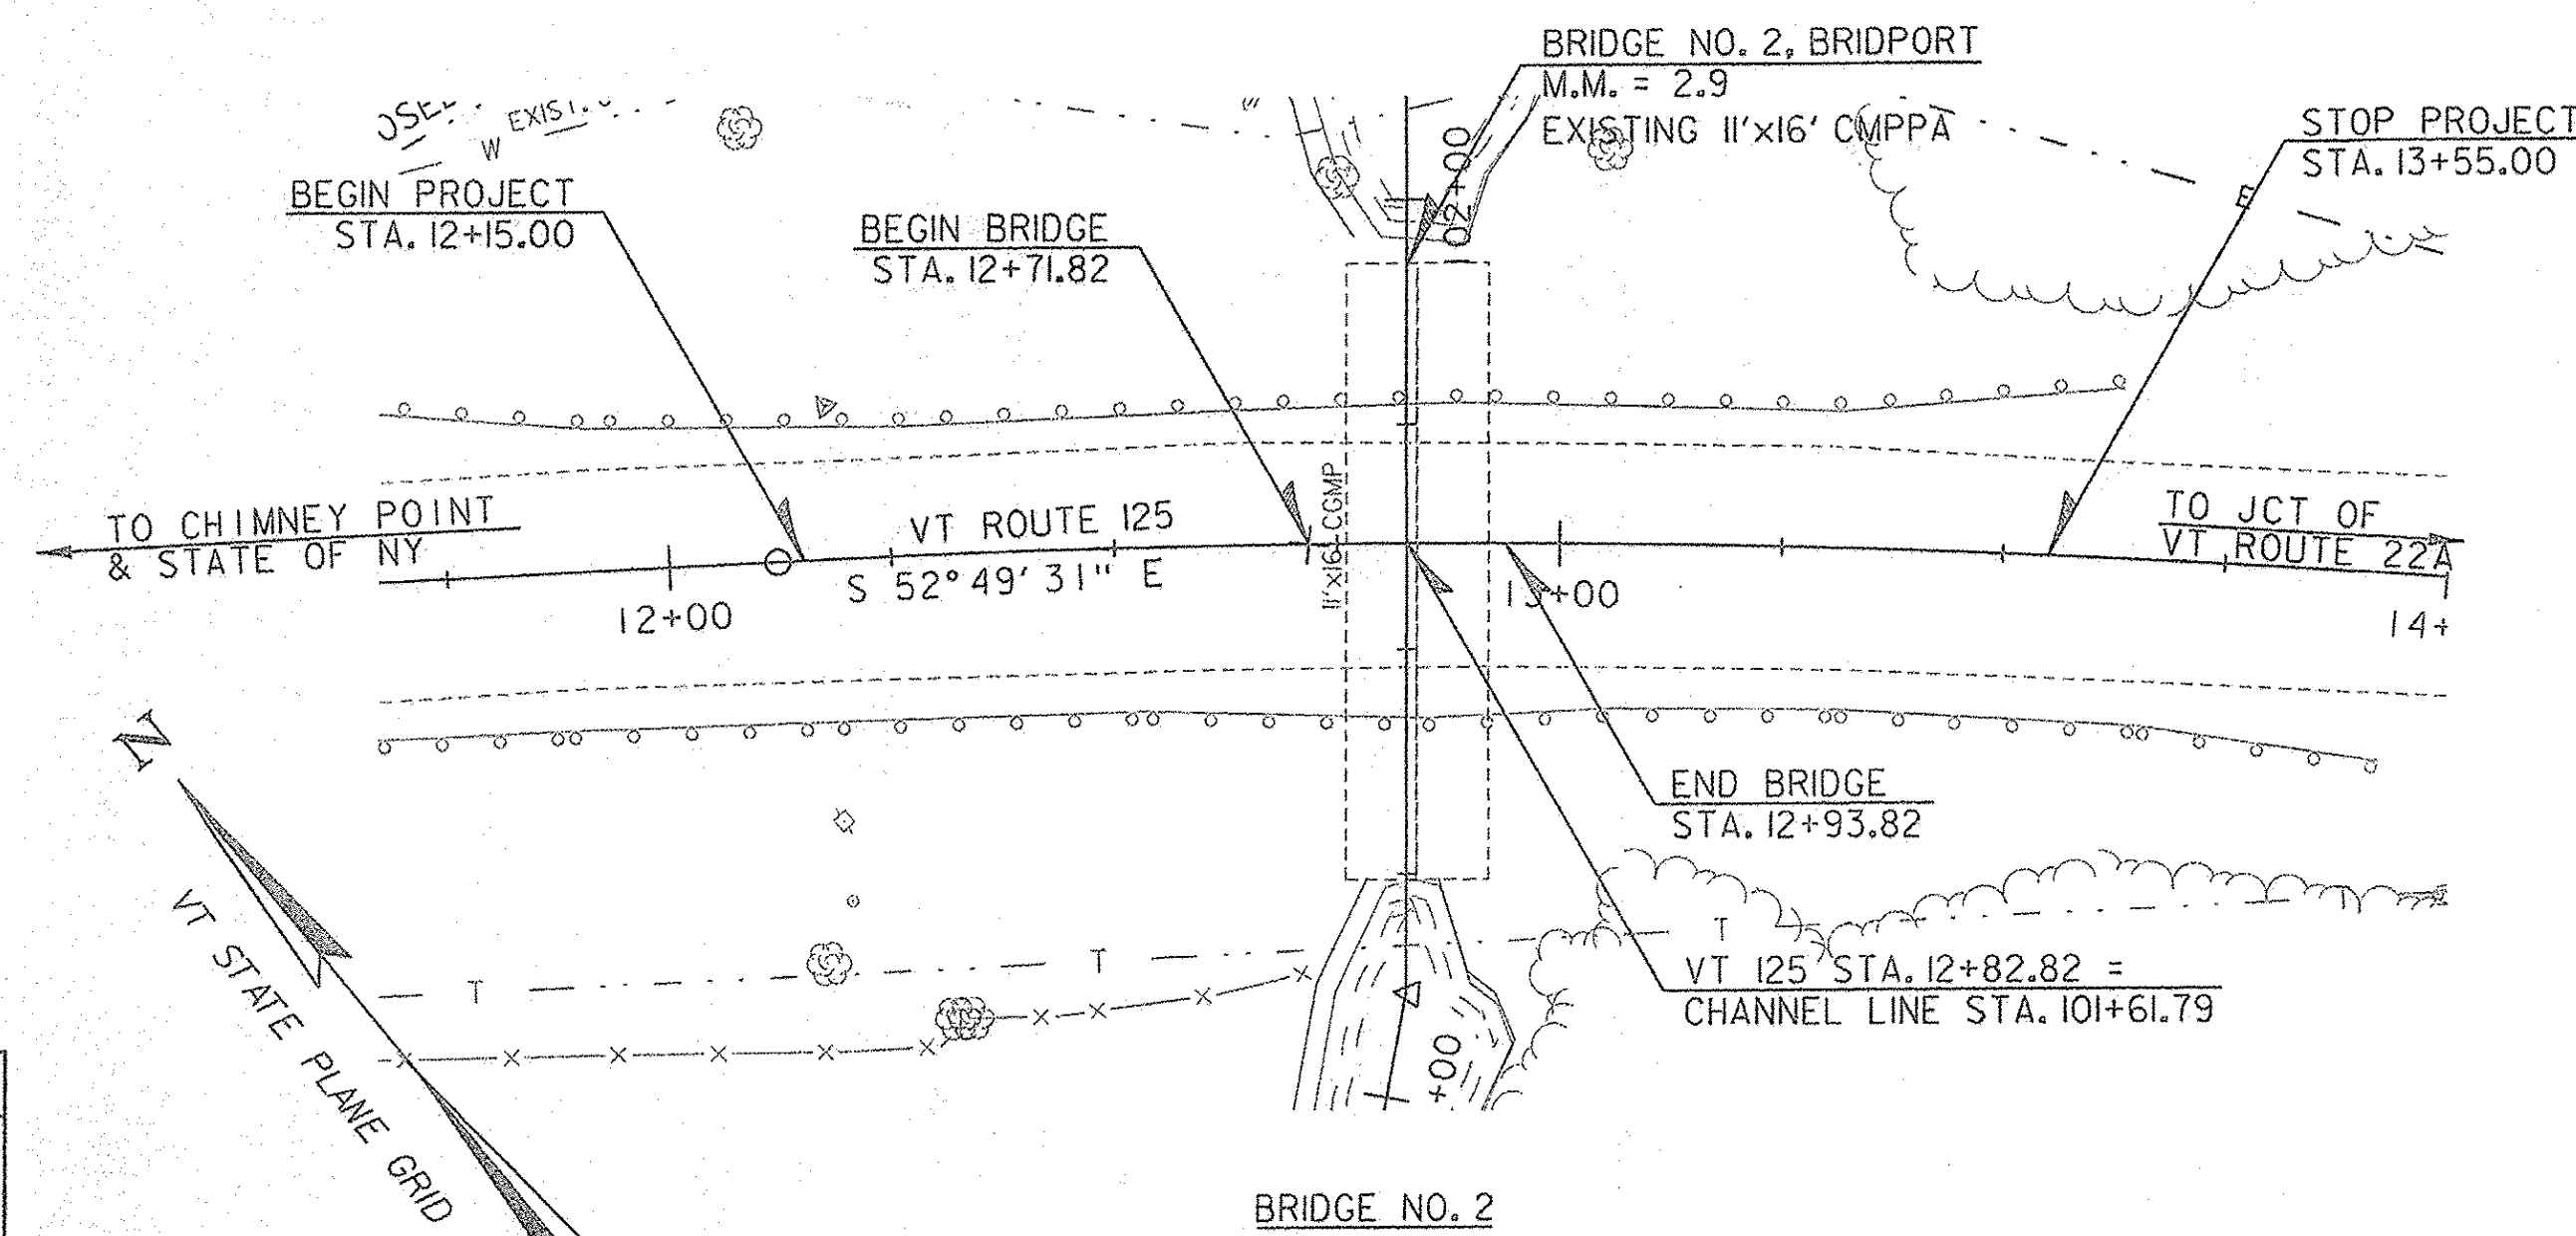

CONSTRUCTION IS TO BE CARRIED ON IN ACCORDANCE WITH THESE PLANS AND THE STANDARD SPECIFICATIONS FOR CONSTRUCTION DATED 2011, AS APPROVED BY THE FEDERAL HIGHWAY ADMINISTRATION ON JULY 20, 2011 FOR USE ON THIS PROJECT, INCLUDING ALL SUBSEQUENT REVISIONS AND SUCH REVISED SPECIFICATIONS AND SPECIAL PROVISIONS AS ARE INCORPORATED IN THESE PLANS.

QUALITY ASSURANCE PROGRAM : LEVEL 2	
SURVEYED BY : VTRANS	
SURVEYED DATE : FEBRUARY 2012	
DATUM	
VERTICAL	(SEE SURVEY CONTROL AND TIE SHEETS)
HORIZONTAL	(SEE SURVEY CONTROL AND TIE SHEETS)

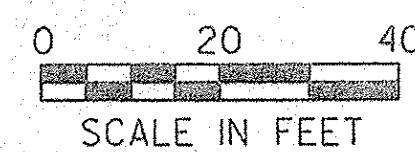

		DIRECTOR OF PROJECT DELIVERY APPROVED DATE 9/11/2014
	PROJECT MANAGER : MARK SARGENT	
	PROJECT NAME : BRIDPORT PROJECT NUMBER : STP CULV (29)	
	SHEET 1 OF 57 SHEETS	
Stantec Consulting Services Inc. 55 Green Mountain Drive South Burlington VT U.S.A. 05403 Phone: (802) 864-0223 Fax: (802) 864-0165 www.stantec.com		

PRELIMINARY INFORMATION SHEET (BRIDGE)

INDEX OF SHEETS

FINAL HYDRAULIC REPORT - BRIDGE NO. 2

PLAN SHEETS

STANDARDS LIST

INDEX OF SHEETS

VAOT STANDARD SHEETS

PAGE NO.	SHEET TITLE
1	TITLE SHEET
2	PRELIMINARY INFORMATION SHEET - BR2
3	PRELIMINARY INFORMATION SHEET - BR5
4	PROJECT NOTES
5-10	QUANTITY SHEETS - QS1 - QS6
11	CONVENTIONAL SYMBOLOLOGY LEGEND
12	TYPICAL SECTIONS - BR2
13	SURVEY CONTROL AND TIES - BR2
14	PLAN LAYOUT SHEET - BR2
15	ROADWAY PROFILE - BR2
16	STREAM PROFILE - BR2
17	STRUCTURAL PLAN AND DETAILS - BR2
18	DETOUR PLAN - BR2
19	TRAFFIC CONTROL DETAILS 1 - BR2
20	TRAFFIC CONTROL DETAILS 2 - BR2
21	BORING PLAN - BR2
22	BORING LOG 1 - BR2
23	BORING LOG 2 - BR2
24	ROADWAY CROSS SECTIONS - RXS1 - BR2
25	ROADWAY CROSS SECTIONS - RXS2 - BR2
26	ROADWAY CROSS SECTIONS - RXS3 - BR2
27	ROADWAY CROSS SECTIONS - RXS4 - BR2
28	CHANNEL CROSS SECTIONS - CXS1 - BR2
29	CHANNEL CROSS SECTIONS - CXS2 - BR2
30	CHANNEL CROSS SECTIONS - CXS3 - BR2
31	EPSC NARRATIVE - ECN1 - BR2
32	EPSC CONSTRUCTION SITE PLAN - ECP1 - BR2
33	EROSION CONTROL DETAILS - ECD1 - BR2
34	EROSION CONTROL DETAILS - ECD2 - BR2
35	PROJECT IMPACTS PLAN 1 - BR2
36	PROJECT IMPACTS PLAN 2 - BR2
37	TYPICAL SECTIONS - BR5
38	SURVEY CONTROL AND TIES - BR5
39	PLAN LAYOUT SHEET - BR5
40	ROADWAY PROFILE - BR5
41	STREAM PROFILE - BR5
42	STRUCTURAL PLAN AND DETAILS - BR5
43	DETOUR PLAN - BR5
44	TRAFFIC CONTROL DETAILS 1 - BR5
45	TRAFFIC CONTROL DETAILS 2 - BR5
46	BORING PLAN - BR5
47	BORING LOG 1 - BR5
48	ROADWAY CROSS SECTIONS - RXS1 - BR5
49	ROADWAY CROSS SECTIONS - RXS2 - BR5
50	CHANNEL CROSS SECTIONS - CXS1 - BR5
51	CHANNEL CROSS SECTIONS - CXS2 - BR5
52	EPSC NARRATIVE - ECN1 - BR5
53	EPSC CONSTRUCTION SITE PLAN - ECP1 - BR5
54	EROSION CONTROL DETAILS - ECD1 - BR5
55	EROSION CONTROL DETAILS - ECD2 - BR5
56	PROJECT IMPACTS PLAN 1 - BR5
57	PROJECT IMPACTS PLAN 2 - BR5

E-121	STANDARD SIGN PLACEMENT - CONVENTIONAL ROAD	08/08/95
E-123	GUIDE SIGN PLACEMENT - MISCELLANEOUS DETAILS	03/16/04
E-171A	TRAFFIC CONTROL SIGNALS GENERAL NOTES & DETAILS	08/09/95
E-172	VEHICLE LOOP DETAILS	08/09/95
E-191	PAVEMENT MARKING DETAILS	02/01/99
E-192	PAVEMENT MARKING DETAILS	10/12/00
E-193	PAVEMENT MARKING DETAILS	08/18/95
G-1	STEEL BEAM GUARDRAIL WITH STEEL POSTS	02/10/14
G-10	STEEL BEAM GUARDRAIL WITH WOOD POSTS	02/10/14
G-10	STEEL BEAM GUARDRAIL APPROACH END TERMINAL	02/10/14
G-10	STEEL BEAM GUARDRAIL TRAILING END TERMINAL	02/10/14
G-10	ANCHOR FOR STEEL BEAM GUARDRAIL	02/10/14
T-1	TRAFFIC CONTROL GENERAL NOTES	08/06/12
T-10	CONVENTIONAL ROADS CONSTRUCTION APPROACH SIGNING	08/06/12
T-17	TRAFFIC CONTROL MISCELLANEOUS DETAILS	08/06/12
T-28	CONSTRUCTION SIGN DETAILS	08/06/12
T-29	CONSTRUCTION SIGN DETAILS	08/06/12
T-30	CONSTRUCTION SIGN DETAILS	08/06/12
T-31	CONSTRUCTION SIGN DETAILS	08/06/12
T-35	CONSTRUCTION ZONE LONGITUDINAL DROP-OFFS	08/06/12
T-36	CONSTRUCTION ZONE LONGITUDINAL DROP-OFFS FOR PAVING	08/06/12
T-42	BRIDGE NUMBER PLAQUE	04/09/14
T-45	SQUARE TUBE SIGN POST AND ANCHOR	01/02/13

STRUCTURE DETAIL SHEETS

SD-366.00 LONGSPAN STEEL BEAM GUARDRAIL, GALVANIZED 01/03/14

HYDROLOGIC DATA

Date: 1 November 2013

DRAINAGE AREA: 7.57 sq. mi.
CHARACTER OF TERRAIN: Lowland agricultural with some wooded areas
STREAM CHARACTERISTICS: Perennial, sinuous
NATURE OF STREAMBED: Flat, clay streambed material

PEAK FLOW DATA

Q 2.33 = 175 cfs Q 50 = 690 cfs
Q 10 = 435 cfs Q 100 = 800 cfs
Q 25 = 585 cfs Q 500 = 1120 cfs

DATE OF FLOOD OF RECORD: Unknown
ESTIMATED DISCHARGE: Unknown
WATER SURFACE ELEV.: Unknown
NATURAL STREAM VELOCITY: @ Q50 = 4.5 fps
ICE CONDITIONS: Light
DEBRIS: Light
DOES THE STREAM REACH MAXIMUM HIGHWATER ELEV. RAPIDLY? No
IS ORDINARY RISE RAPID? No
IS STAGE AFFECTED BY UPSTREAM OR DOWNSTREAM CONDITIONS? No
IF YES, DESCRIBE:

WATERSHED STORAGE: <1% HEADWATERS:
UNIFORM: X
IMMEDIATELY ABOVE SITE:

EXISTING STRUCTURE INFORMATION

STRUCTURE TYPE: 17' x 11'-2" corrugated multi-plate pipe arch (CMPPA)
YEAR BUILT: 1956
CLEAR SPAN(NORMAL TO STREAM): 17'
VERTICAL CLEARANCE ABOVE STREAMBED: 11'-2"
WATERWAY OF FULL OPENING: 146 sq. ft.
DISPOSITION OF STRUCTURE: Remove and replace
TYPE OF MATERIAL UNDER SUBSTRUCTURE: See borings

WATER SURFACE ELEVATIONS AT:

Q2.33 = 137.8' VELOCITY = 6.2 fps
Q10 = 139.9' " 7.7 fps
Q25 = 141.0' " 8.5 fps
Q50 = 141.7' " 9.1 fps
Q100 = 142.4' " 9.6 fps

LONG TERM STREAMBED CHANGES: None noted

IS THE ROADWAY OVERTOPPED BELOW Q100: No
FREQUENCY: N/A
RELIEF ELEVATION: 155.7'
DISCHARGE OVER ROAD @Q100: None

UPSTREAM STRUCTURE

TOWN: Bridport DISTANCE: 6,300'
HIGHWAY #: TH 44 STRUCTURE #: BR 22
CLEAR SPAN: 39'-8" CLEAR HEIGHT: 6'-11"
YEAR BUILT: Unknown FULL WATERWAY: 194 sf
STRUCTURE TYPE: Wood deck on steel beams with concrete abutments; upstream confluence

DOWNSTREAM STRUCTURE

TOWN: Bridport DISTANCE: 11,500'
HIGHWAY #: TH 5 STRUCTURE #: BR 26
CLEAR SPAN: 11' CLEAR HEIGHT: 11'
YEAR BUILT: Unknown FULL WATERWAY: 95 sf
STRUCTURE TYPE: Culvert

LRFR LOAD RATING FACTORS

LOADING LEVELS	TRUCK						
	H-20	HL-93	SS2	6 AXLE	3A. STR.	4A. STR.	5A. SEMI
TONNAGE	20	36	36	66	30	34.5	38
INVENTORY							
POSTING							
OPERATING							
COMMENTS:							

AS BUILT "REBAR" DETAIL

LEVEL I	LEVEL II	LEVEL III
TYPE:	TYPE:	TYPE:
GRADE:	GRADE:	GRADE:

TRAFFIC DATA

YEAR	ADT	DHV	% D	% T	ADTT	ESAL
2013	1400	190	64	10	130	20 year ESAL for flexible pavement from 2013 to 2023 : 397000
2023	1400	190	64	11.8	150	20 year ESAL for flexible pavement from 2013 to 2033 : 869000 Design Speed : 50 mph

PROPOSED STRUCTURE

STRUCTURE TYPE: Precast Concrete Box Culvert

CLEAR SPAN(NORMAL TO STREAM): 20.0'
VERTICAL CLEARANCE ABOVE STREAMBED: 8.0'
WATERWAY OF FULL OPENING: 160 sq. ft.

WATER SURFACE ELEVATIONS AT:

Q2.33 = 137.0' VELOCITY = 2.9 fps
Q10 = 138.9' " 4.4 fps
Q25 = 139.8' " 5.1 fps
Q50 = 140.4' " 5.5 fps
Q100 = 141.0' " 6.0 fps

IS THE ROADWAY OVERTOPPED BELOW Q100: No
FREQUENCY: N/A
RELIEF ELEVATION: 156.8'
DISCHARGE OVER ROAD @Q100: None

AVERAGE LOW ELEVATION OF SUPERSTRUCTURE: 141.9'
VERTICAL CLEARANCE: @ Q50 = 1.5'

SCOUR: Replacement structure is a box culvert so scour is not a concern.

REQUIRED CHANNEL PROTECTION: Stone Fill, Type II

PERMIT INFORMATION

AVERAGE DAILY FLOW: 15 cfs DEPTH OR ELEVATION:
ORDINARY LOW WATER: 7 cfs Depth = 0.5'
ORDINARY HIGH WATER: 75 cfs Depth = 2.0'

TEMPORARY BRIDGE REQUIREMENTS

STRUCTURE TYPE: Temporary Bridge not Required
CLEAR SPAN (NORMAL TO STREAM): N/A
VERTICAL CLEARANCE ABOVE STREAMBED: N/A
WATERWAY AREA OF FULL OPENING: N/A

ADDITIONAL INFORMATION

TRAFFIC MAINTENANCE NOTES

1. MAINTAIN TRAFFIC ON AN OFF SITE DETOUR.
2. TRAFFIC SIGNALS ARE NOT NECESSARY.
3. SIDEWALKS ARE NOT NECESSARY

DESIGN VALUES

1. DESIGN LIVE LOAD HL-93
2. FUTURE PAVEMENT d_p : 3.0 INCH
3. DESIGN SPAN L: 0.00 FT
4. MIN. MID-SPAN POS. CAMBER @ RELEASE (PRESTRESSED UNITS) Δ : ---
5. PRESTRESSING STRAND f_y : ---
6. PRESTRESSED CONCRETE STRENGTH f'_c : ---
7. PRESTRESSED CONCRETE RELEASE STRENGTH f'_{cr} : ---
8. CONCRETE, HIGH PERFORMANCE CLASS AA f'_c : ---
9. CONCRETE, HIGH PERFORMANCE CLASS A f'_c : ---
10. CONCRETE, HIGH PERFORMANCE CLASS B f'_c : 3.5 KSI
11. CONCRETE, CLASS C f'_c : ---
12. REINFORCING STEEL f_y : 60 KSI
13. STRUCTURAL STEEL AASHTO M270 f_y : ---
14. NOMINAL BEARING RESISTANCE OF SOIL q_n : * 10 KSF
15. SOIL BEARING RESISTANCE FACTOR (REFER TO AASHTO LRFD) ϕ : * 0.45
16. NOMINAL BEARING RESISTANCE OF ROCK q_n : ---
17. ROCK BEARING RESISTANCE FACTOR (REFER TO AASHTO LRFD) ϕ : ---

18. PILE RESISTANCE FACTOR ϕ : ---
19. LATERAL PILE DEFLECTION Δ : ---
20. BASIC WIND SPEED V_{3s} : ---
21. MINIMUM GROUND SNOW LOAD p_g : ---
22. SEISMIC DATA PGA : 0 S_s : ---
 S_f : ---

23. * SEE GEOTECHNICAL REPORT

24. ---
25. ---
26. ---

PROJECT NAME: **Bridport**
PROJECT NUMBER: **STP CULV (29)**

FILE NAME: z11c264_BR2_PI.xls PLOT DATE: 3/18/2014
PROJECT LEADER: M. CHENETTE DRAWN BY: L. BUXTON
DESIGNED BY: A. LACHANCE CHECKED BY: M. CHENETTE
PRELIMINARY INFORMATION SHEET - BR2 SHEET 2 OF 57

PRELIMINARY INFORMATION SHEET (BRIDGE)

LRFD

INDEX OF SHEETS

PLAN SHEETS

SEE SHEET 2

STANDARDS LIST

FINAL HYDRAULIC REPORT - BRIDGE NO. 5

HYDROLOGIC DATA

Date: 29 October 2013

DRAINAGE AREA : 0.76 sq. mi.
 CHARACTER OF TERRAIN : Lowland agricultural with some wooded areas
 STREAM CHARACTERISTICS : Perennial, flat, straight
 NATURE OF STREAMBED : Clay streambed

PEAK FLOW DATA

Q 2.33 = 30 cfs Q 50 = 150 cfs
 Q 10 = 90 cfs Q 100 = 180 cfs
 Q 25 = 125 cfs Q 500 = 250 cfs

DATE OF FLOOD OF RECORD : Unknown
 ESTIMATED DISCHARGE : Unknown
 WATER SURFACE ELEV. : Unknown
 NATURAL STREAM VELOCITY : @ Q50 = 2.6 fps
 ICE CONDITIONS : Light
 DEBRIS : Light
 DOES THE STREAM REACH MAXIMUM HIGHWATER ELEV. RAPIDLY? Yes
 IS ORDINARY RISE RAPID? Yes
 IS STAGE AFFECTED BY UPSTREAM OR DOWNSTREAM CONDITIONS? Yes
 IF YES, DESCRIBE : Downstream Payne Road crossing creates a backwater condition at the subject culvert, making the structure outlet controlled.

WATERSHED STORAGE : <1% HEADWATERS :
 UNIFORM : X
 IMMEDIATELY ABOVE SITE :

EXISTING STRUCTURE INFORMATION

STRUCTURE TYPE : 7'-0" corrugated metal pipe (CMP)
 YEAR BUILT : 1949
 CLEAR SPAN(NORMAL TO STREAM) : 7'-0"
 VERTICAL CLEARANCE ABOVE STREAMBED : 7'-0"
 WATERWAY OF FULL OPENING : 38.5 sq. ft.
 DISPOSITION OF STRUCTURE : Remove and replace
 TYPE OF MATERIAL UNDER SUBSTRUCTURE : See borings

WATER SURFACE ELEVATIONS AT:

Q2.33 = 238.8 ft VELOCITY = 1.5 fps
 Q10 = 240.5 ft " 3.0 fps
 Q25 = 241.5 ft " 3.6 fps
 Q50 = 242.2 ft " 3.9 fps
 Q100 = 242.7 ft " 2.6 fps

LONG TERM STREAMBED CHANGES : None noted

IS THE ROADWAY OVERTOPPED BELOW Q100: Yes
 FREQUENCY : Q50
 RELIEF ELEVATION : 242.0 ft
 DISCHARGE OVER ROAD @Q100 : 79.0 cfs

UPSTREAM STRUCTURE

TOWN : Bridport DISTANCE : 1,500'
 HIGHWAY # : TH 24 STRUCTURE # :
 CLEAR SPAN : 4'-0" CLEAR HEIGHT : 4'-0"
 YEAR BUILT : Unknown FULL WATERWAY : 12.6 sq. ft.
 STRUCTURE TYPE : 48" dia. corrugated metal pipe

DOWNSTREAM STRUCTURE

TOWN : Bridport DISTANCE : 950'
 HIGHWAY # : TH 32 STRUCTURE # : BR 28
 CLEAR SPAN : 5'-6" CLEAR HEIGHT : 5'-6"
 YEAR BUILT : Unknown FULL WATERWAY : 23.8 sq. ft.
 STRUCTURE TYPE : 66" dia. corrugated metal pipe

LRFR LOAD RATING FACTORS

LOADING LEVELS	TRUCK						
	H-20	HL-93	3S2	6 AXLE	3A. STR.	4A. STR.	5A. SEM
TONNAGE	20	36	36	66	30	34.5	38
INVENTORY							
POSTING							
OPERATING							
COMMENTS:							

AS BUILT "REBAR" DETAIL		
LEVEL I	LEVEL II	LEVEL III
TYPE:	TYPE:	TYPE:
GRADE:	GRADE:	GRADE:

PROPOSED STRUCTURE

STRUCTURE TYPE : Precast Concrete Box Culvert

CLEAR SPAN(NORMAL TO STREAM) : 12'-0"
 VERTICAL CLEARANCE ABOVE STREAMBED : 7'-0" / 5'-0"
 WATERWAY OF FULL OPENING : 76.0 sq. ft.

WATER SURFACE ELEVATIONS AT:

Q2.33 = 238.7 ft VELOCITY = 0.9 fps
 Q10 = 240.3 ft " 1.7 fps
 Q25 = 241.2 ft " 2.0 fps
 Q50 = 241.9 ft " 2.2 fps
 Q100 = 242.6 ft " 1.8 fps

IS THE ROADWAY OVERTOPPED BELOW Q100: Yes
 FREQUENCY : N/A
 RELIEF ELEVATION : 242.0 ft
 DISCHARGE OVER ROAD @Q100 : 48.9 cfs

AVERAGE LOW ELEVATION OF SUPERSTRUCTURE : 242.3 ft
 VERTICAL CLEARANCE : @ Q50 = 0.4'

SCOUR : Replacement structure is a box culvert so scour is not a concern.

REQUIRED CHANNEL PROTECTION : Stone Fill, Type II

PERMIT INFORMATION

AVERAGE DAILY FLOW : 1.5 cfs DEPTH OR ELEVATION:
 ORDINARY LOW WATER : 0.8 cfs Depth = 1.5'
 ORDINARY HIGH WATER : 8 cfs Depth = 2.0'

TEMPORARY BRIDGE REQUIREMENTS

STRUCTURE TYPE : Temporary Bridge not Required
 CLEAR SPAN (NORMAL TO STREAM) : N/A
 VERTICAL CLEARANCE ABOVE STREAMBED : N/A
 WATERWAY AREA OF FULL OPENING : N/A

ADDITIONAL INFORMATION

TRAFFIC MAINTENANCE NOTES

1. MAINTAIN TRAFFIC ON AN OFF SITE DETOUR.
2. TRAFFIC SIGNALS ARE NOT NECESSARY.
3. SIDEWALKS ARE NOT NECESSARY

DESIGN VALUES

1. DESIGN LIVE LOAD HL-93
2. FUTURE PAVEMENT d_p : 3.0 INCH
3. DESIGN SPAN L: 0.00 FT
4. MIN. MID-SPAN POS. CAMBER @ RELEASE (PRESTRESSED UNITS) Δ : ---
5. PRESTRESSING STRAND f_y : ---
6. PRESTRESSED CONCRETE STRENGTH f'_c : ---
7. PRESTRESSED CONCRETE RELEASE STRENGTH f'_{ci} : ---
8. CONCRETE, HIGH PERFORMANCE CLASS AA f'_c : ---
9. CONCRETE, HIGH PERFORMANCE CLASS A f'_c : ---
10. CONCRETE, HIGH PERFORMANCE CLASS B f'_c : 3.5 KSI
11. CONCRETE, CLASS C f'_c : ---
12. REINFORCING STEEL f_y : 60 KSI
13. STRUCTURAL STEEL AASHTO M270 f_y : ---
14. NOMINAL BEARING RESISTANCE OF SOIL q_n : * 1.36 KSF
15. SOIL BEARING RESISTANCE FACTOR (REFER TO AASHTO LRFD) ϕ : * 0.45
16. NOMINAL BEARING RESISTANCE OF ROCK q_n : ---
17. ROCK BEARING RESISTANCE FACTOR (REFER TO AASHTO LRFD) ϕ : ---

18. PILE RESISTANCE FACTOR ϕ : ---
19. LATERAL PILE DEFLECTION Δ : ---
20. BASIC WIND SPEED V_{3s} : ---
21. MINIMUM GROUND SNOW LOAD pg : ---
22. SEISMIC DATA PGA : 0 S_s : ---
23. * SEE GEOTECHNICAL REPORT S_f : ---
24. ---
25. ---
26. ---

PROJECT NAME : **Bridport**
 PROJECT NUMBER : **STP CULV(29)**
 FILE NAME : z11c264_BR5_P1.xls PLOT DATE : 3/18/2014
 PROJECT LEADER : M. CHENETTE DRAWN BY : L. BUXTON
 DESIGNED BY : A LACHANCE CHECKED BY : M. CHENETTE
 PRELIMINARY INFORMATION SHEET - BR5 SHEET 3 OF 57

TRAFFIC DATA

YEAR	ADT	DHV	% D	% T	ADTT	
2013	1900	210	66	7.5	150	10 year ESAL for flexible pavement from 2013 to 2023 : 385000
2023	2000	230	66	9	190	20 year ESAL for flexible pavement from 2013 to 2033 : 882000 Design Speed : 50 mph

PROJECT NOTES

GENERAL

1. ALL MATERIALS AND CONSTRUCTION SHALL CONFORM TO THE STATE OF VERMONT AGENCY OF TRANSPORTATION 2011 STANDARD SPECIFICATIONS FOR HIGHWAY AND BRIDGE CONSTRUCTION AND ITS LATEST REVISIONS AND THE 5TH EDITION OF THE AASHTO LRFD BRIDGE DESIGN SPECIFICATION AND ITS LATEST REVISIONS.
2. THE CONTRACTOR WILL BE ALLOWED TO CLOSE BRIDGE BR2 FOR ONE FIVE DAY (120 HOUR) PERIOD AND WILL BE ALLOWED TO CLOSE BRIDGE BR5 FOR ONE THREE DAY (72 HOUR) PERIOD. DURING THAT TIME THE CONTRACTOR WILL BE ALLOWED TO WORK 24 HOURS PER DAY. THE CONTRACTOR SHALL SCHEDULE THEIR WORK SUCH THAT THE BRIDGE IS NOT CLOSED DURING HOLIDAY PERIODS. SEE SPECIAL PROVISIONS FOR ADDITIONAL INFORMATION AND REQUIREMENTS.
3. THE CONTRACTOR SHALL ENSURE ACCESS TO ALL DRIVES AND SIDE ROADS AT ALL TIMES DURING CONSTRUCTION.
4. ALL DIMENSIONS SHOWN IN THE PLANS ARE HORIZONTAL OR VERTICAL AND ARE GIVEN AT 68°F.
5. IN-STREAM CONSTRUCTION SHALL OCCUR ONLY WITHIN THE TIMEFRAME IN THE PROJECT PERMITS INCLUDED IN THE CONTRACT DOCUMENTS. IF THE CONTRACTOR PROPOSES TO PERFORM IN STREAM WORK OUTSIDE OF THESE TIMEFRAMES, THE CONTRACTOR SHALL OBTAIN WRITTEN APPROVAL FROM THE APPROPRIATE REGULATING ENTITIES PRIOR TO PERFORMING THE WORK.

PRECAST CONCRETE BOX CULVERTS AND WINGWALLS

1. THE BOX CULVERT INCLUDING SILLS, HEADWALLS, CUT-OFF WALLS, AND WINGWALLS WILL BE PAID FOR UNDER THE APPROPRIATE SECTION 540 CONTRACT ITEM.
2. THE BOX CULVERT INCLUDING THE SILLS, HEADWALLS AND WINGWALL STEMS SHALL BE PRECAST. THE CUT-OFF-WALL AND WINGWALL FOOTINGS MAY BE EITHER PRECAST OR CAST IN PLACE. THE DESIGN OF THESE CULVERTS SHALL BE THE RESPONSIBILITY OF THE FABRICATOR. CULVERT SHALL BE DESIGNED FOR AN HL-93 LIVE LOAD. CAST-IN-PLACE CONCRETE SHALL MEET THE REQUIREMENTS OF SECTION 501 FOR CONCRETE, HIGH PERFORMANCE CLASS B.
3. THE CONTRACTOR SHALL SUBMIT FABRICATION DRAWINGS FOR THE BOX CULVERTS AND ALL ASSOCIATED DETAILS IN ACCORDANCE WITH SUBSECTION 105.03.
4. THE BOX CULVERT TYPICAL SECTIONS SHOWN IN THE DRAWINGS ARE FOR SCHEMATIC PURPOSES ONLY. THE ACTUAL SHAPE OF THE BOX CULVERT AND ITS COMPONENTS WILL BE DEPENDENT ON THE FABRICATOR.
5. ALL BOX CULVERT JOINTS SHALL BE STRENGTHENED WITH PERMANENT CLOSURE HARDWARE. ALL HARDWARE COMPONENTS SHALL BE GALVANIZED IN ACCORDANCE WITH SUBSECTION 726.08.
6. ALL REINFORCING TO BE LEVEL I (UNCOATED). PAYMENT FOR REINFORCING WILL BE INCLUDED UNDER THE APPROPRIATE SECTION 540 CONTRACT ITEM.
7. AFTER BOX CULVERT SECTIONS HAVE BEEN SET IN THEIR FINAL POSITION, THE EXTERIOR (TOP AND SIDES) AND INTERIOR (SIDES AND BOTTOM) OF ALL BOX CULVERT JOINTS, AND ALL LIFTING HOLES, SHALL BE GROUTED WITH MORTAR, TYPE IV. PRIOR TO THE APPLICATION OF ANY WATERPROOFING, ALL MORTAR SHALL BE WET CURED A MINIMUM OF 12 HOURS OR UNTIL THE COMPRESSIVE STRENGTH HAS REACHED 2000 psi.
8. A TWO FOOT WIDE STRIP OF SHEET MEMBRANE WATERPROOFING SHALL BE APPLIED AT EACH SIDE JOINT IN ACCORDANCE WITH SUBSECTION 540.10. THE MEMBRANE SHALL BE CENTERED ON THE JOINT AND SHALL RUN THE ENTIRE HEIGHT OF THE JOINT. THE ENTIRE TOP OF THE BOX CULVERT SHALL THEN BE COVERED WITH TORCH APPLIED MEMBRANE. TORCH APPLIED MEMBRANE WILL BE PAID SEPARATELY UNDER CONTRACT ITEM 519.20. THE MEMBRANE SHEETS SHALL OVERLAP THE EDGES OF THE CULVERT BY ONE FOOT ON EACH SIDE AS SHOWN IN THE PLANS.
9. WATER REPELLENT IN ACCORDANCE WITH ITEM 514.10 SHALL BE APPLIED TO ALL EXPOSED SURFACES EXCEPT THE INSIDE OF THE BOX.

SIMULATED STREAM BED

1. BED MATERIAL TO BE PLACED IN THE RECONSTRUCTED CHANNEL AND BOX CULVERT IS INTENDED TO MIMIC THE NATIVE CHANNEL. THE MATERIAL SHALL BE STONE FILL TYPE II SUPPLEMENTED WITH THE TAILINGS OF A TOPSOIL SCREENING OPERATION WITH GRADATION ADJUSTED TO CONFORM TO THE FOLLOWING TABLE:

STONE/SIEVE SIZE	% FINER, BY WEIGHT
36"	100
12"	30-85
#4	4-30
#200	4-12

2. INSTALLATION OF THE BED MATERIAL MAY REQUIRE INDIVIDUAL PLACEMENT OF LARGE STONES AT SPECIFIC LOCATIONS, AS DIRECTED BY THE ENGINEER. THE MATERIAL ACCEPTANCE AND PLACEMENT WILL BE PER THE STREAM ALTERATIONS ENGINEER, AND WILL BE IN ACCORDANCE WITH ITEM 900.608, SPECIAL PROVISION (STONE FILL, CULVERT LINING).

UTILITY COORDINATION

1. THE CONTRACTOR IS ADVISED TO EXERCISE CAUTION WHILE WORKING IN AREAS OF OVERHEAD UTILITIES. OVERHEAD UTILITIES WILL BE RELOCATED BY THE UTILITY COMPANIES PRIOR TO CONSTRUCTION. CONTRACTOR COORDINATION WITH THE UTILITIES IS ENCOURAGED FOR THE CONTRACTORS CONVENIENCE. THE FOLLOWING UTILITY CONTACT INFORMATION IS PROVIDED FOR THE CONVENIENCE OF THE CONTRACTOR. UTILITIES INCLUDE BUT ARE NOT LIMITED TO:

-GREEN MOUNTAIN POWER: 1-802-747-5460

-WAITSFIELD AND CHAMPLAIN VALLEY TELECOM: 1-802-496-8323

-TRI-TOWN WATER DISTRICT #1: 1-802-758-2202

2. THE LOCATION OF THE UNDERGROUND UTILITIES SHOWN ON THE PLANS IS APPROXIMATE. EXISTING UNDERGROUND UTILITIES TO BE LOCATED WITH EXPLORATORY EXCAVATION AS DIRECTED BY THE ENGINEER. IF RELOCATION IS REQUIRED IT WILL BE THE RESPONSIBILITY OF THE UTILITY OWNER.

ALL DIG SAFE REQUIREMENTS ARE STILL APPLICABLE.

3. SEE UTILITY SPECIAL PROVISIONS FOR ADDITIONAL INFORMATION AND REQUIREMENTS.

TRAFFIC CONTROL

1. SIGNS SHALL BE INSTALLED SO AS NOT TO OBSTRUCT EXISTING SIGNS OR CORNER SIGHT DISTANCE FROM HIGHWAYS OR DRIVES.
2. ORANGE SOLID SUBSTRATE CONSTRUCTION SIGNS SHALL HAVE RETROREFLECTIVE SHEETING EQUAL TO OR EXCEEDING "AMERICAN SOCIETY FOR TESTING AND MATERIALS" (ASTM D 4956) TYPE VII, VIII OR IX REQUIREMENTS, UNLESS OTHERWISE NOTED.
3. SIGNS SHALL BE ERECTED BEFORE THE START OF ANY WORK AND SHALL BE COVERED UNTIL WORK COMMENCES, DURING PERIODS OF INACTIVITY OR UPON COMPLETION OF THE WORK. EACH SIGN SHALL BE ERECTED IN A NEAT AND WORKMANLIKE MANNER. SIGNS SHALL BE REMOVED UPON COMPLETION OF THE WORK AT THE DISCRETION OF THE ENGINEER.
4. FIXED SIGNS SHALL BE SET SECURELY IN THE GROUND. THE BOTTOM OF A SIGN SHALL BE AT LEAST SEVEN FEET ABOVE THE EDGE OF PAVEMENT. THE NEAREST EDGE OF A SIGN SHALL BE AT LEAST SIX FEET OUTSIDE THE SHOULDER POINT OR FOUR FEET OUTSIDE GUARDRAIL. EACH POST SHALL HAVE 2 (MIN.) BOLTS WHERE ATTACHED TO SIGN.
5. PORTABLE SIGNS SHALL BE PLACED ON THE EDGE OF ROADWAY AND A ONE FOOT MINIMUM ABOVE TRAVELED WAY. ALL VEGETATION THAT INTERFERES WITH VISIBILITY OF THE SIGNS SHALL BE REMOVED. WHEN PLACED BEHIND GUARDRAIL, THE BOTTOM OF THE SIGN FACE SHALL BE ABOVE THE TOP OF THE GUARDRAIL.
6. WHERE SIGN INSTALLATIONS ARE NOT PROTECTED BY GUARDRAIL OR OTHER APPROVED TRAFFIC BARRIERS, ALL SIGN STANDS AND POST INSTALLATIONS SHALL BE "NATIONAL COOPERATIVE HIGHWAY RESEARCH PROGRAM" (NCHRP) REPORT 350 COMPLIANT. NO SIGN POSTS SHALL EXTEND OVER THE TOP OF THE SIGN INSTALLED ON SAID POST(S). WHEN ANCHORS ARE INSTALLED, STUB SHALL NOT BE GREATER THAN FOUR INCHES ABOVE EXISTING GROUND.
7. THE PORTABLE CHANGEABLE MESSAGE SIGNS (PCMS) SHALL BE USED AT THE DISCRETION OF THE ENGINEER AND IN ACCORDANCE WITH SECTION 6F.60 OF THE MUTCD.

PROJECT NAME: BRIDPORT
PROJECT NUMBER: STP CULV(29)

FILE NAME: zllc264frm.dgn
PROJECT LEADER: M. CHENETTE
DESIGNED BY: J. HUNGERFORD
PROJECT NOTES

PLOT DATE: 9/12/2014
DRAWN BY: L. BUXTON
CHECKED BY: M. CHENETTE
SHEET 4 OF 57



QUANTITY SHEET 1

SUMMARY OF ESTIMATED QUANTITIES						TOTALS		DESCRIPTIONS				DETAILED SUMMARY OF QUANTITIES						
					ROADWAY	EROSION CONTROL	BRIDGE NO. 2	BRIDGE NO. 5	FULL C.E. ITEMS	GRAND TOTAL	FINAL	UNIT	ITEMS	ITEM NUMBER	ROUND	QUANTITIES	UNIT	ITEMS
					1					1		LS	CLEARING AND GRUBBING, INCLUDING INDIVIDUAL TREES AND STUMPS (VT 125 - BRIDGE NO. 2)	201.10				
					1					1		LS	CLEARING AND GRUBBING, INCLUDING INDIVIDUAL TREES AND STUMPS (VT 125 - BRIDGE NO. 5)	201.10				
					1330					1330		CY	COMMON EXCAVATION	203.15				
							400	140		540		CY	UNCLASSIFIED CHANNEL EXCAVATION	203.27				
					1					1		CY	TRENCH EXCAVATION OF EARTH, EXPLORATORY (N.A.B.I.)	204.22				
							1900	570		2470		CY	STRUCTURE EXCAVATION	204.25				
							1100	330		1430		CY	GRANULAR BACKFILL FOR STRUCTURES	204.30				
					660					660		SY	COLD PLANING, BITUMINOUS PAVEMENT	210.10				
					970					970		CY	SUBBASE OF DENSE GRADED CRUSHED STONE	301.35				
					1					1		LU	PRICE ADJUSTMENT, ASPHALT CEMENT (N.A.B.I.)	406.50				
							5	2		7		GAL	WATER REPELLENT, SILANE	514.10				
							200	100		300		SY	SHEET MEMBRANE WATERPROOFING, TORCH APPLIED	519.20				
							1			1		EACH	REMOVAL OF STRUCTURE (16' X 11' x 68' CMPPA)	529.15				
								1		1		EACH	REMOVAL OF STRUCTURE (84" X 41'-0" CGMP)	529.15				
									1	1		LS	PRECAST CONCRETE STRUCTURE (12'-0" X 9'-0" X 41'-0" BOX)	540.10				
							1			1		LS	PRECAST CONCRETE STRUCTURE (20'-0" X 10'-0" X 66'-0" BOX)	540.10				
					1					1		MGAL	DUST CONTROL WITH WATER	609.10				
					1					1		TON	DUST AND ICE CONTROL WITH CALCIUM CHLORIDE	609.15				
					115					115		CY	STONE FILL, TYPE I	613.10				
							700	30		730		CY	STONE FILL, TYPE II	613.11				
					1					1		EACH	RELOCATE MAILBOX, MULTIPLE SUPPORT	617.12				
					67					67		LF	REMOVAL OF EXISTING FENCE	620.55				
					463					463		LF	STEEL BEAM GUARDRAIL, GALVANIZED	621.20				
					650					650		LF	STEEL BEAM GUARDRAIL, GALVANIZED W/8 FEET POSTS	621.205				
								188		188		LF	STEEL BEAM GUARDRAIL, GALVANIZED/NESTED	621.206				
					8					8		EACH	ANCHOR FOR STEEL BEAM RAIL	621.60				
					901					901		LF	REMOVAL AND DISPOSAL OF GUARDRAIL	621.80				
					200					200		HR	FLAGGERS	630.15				
									1	1		LS	FIELD OFFICE, ENGINEERS	631.10				
									1	1		LS	TESTING EQUIPMENT, BITUMINOUS	631.17				
									3000	3000		DL	FIELD OFFICE TELEPHONE (N.A.B.I.)	631.26				
					1					1		LS	MOBILIZATION/DEMobilIZATION	635.11				
					13					13		EACH	PORTABLE CHANGEABLE MESSAGE SIGN	641.15				
					1240					1240		LF	DURABLE 4 INCH WHITE LINE	646.400				
					1240					1240		LF	DURABLE 4 INCH YELLOW LINE	646.410				
					775					775		SY	GEOTEXTILE FOR ROADBED SEPARATOR	649.11				
							1050	40		1090		SY	GEOTEXTILE UNDER STONE FILL	649.31				
						100				100		SY	GEOTEXTILE FOR SILT FENCE	649.51				
					30					30		LB	SEED	651.15				

NOTE: FOR DETAILED BREAKDOWN OF QUANTITIES BETWEEN BR2 AND BR5 SEE BR2 AND BR5 QUANTITY SHEETS

PROJECT NAME: BRIDPORT
PROJECT NUMBER: STP CULV(29)

FILE NAME: zllc264frm.dgn
PROJECT LEADER: M. CHENETTE
DESIGNED BY: J. HUNGERFORD
QUANTITY SHEET 1

PLOT DATE: 9/12/2014
DRAWN BY: L. BUXTON
CHECKED BY: J. HUNGERFORD
SHEET 5 OF 57



QUANTITY SHEET 2

SUMMARY OF ESTIMATED QUANTITIES						TOTALS		DESCRIPTIONS				DETAILED SUMMARY OF QUANTITIES						
					ROADWAY	EROSION CONTROL	BRIDGE NO. 2	BRIDGE NO. 5	FULL C.E. ITEMS	GRAND TOTAL	FINAL	UNIT	ITEMS	ITEM NUMBER	ROUND	QUANTITIES	UNIT	ITEMS
					160					160		LB	FERTILIZER	651.18				
					2					2		TON	AGRICULTURAL LIMESTONE	651.20				
					2					2		TON	HAY MULCH	651.25				
					120					120		CY	TOPSOIL	651.35				
					985					985		SY	GRUBBING MATERIAL	651.40				
						1				1		LS	EPSC PLAN (VT 125 - BRIDGE NO. 2)	652.10				
						1				1		LS	EPSC PLAN (VT 125 - BRIDGE NO. 5)	652.10				
						80				80		HR	MONITORING EPSC PLAN	652.20				
						1				1		LU	MAINTENANCE OF EPSC PLAN (N.A.B.I.) (VT 125 - BRIDGE NO. 2)	652.30				
						1				1		LU	MAINTENANCE OF EPSC PLAN (N.A.B.I.) (VT 125 - BRIDGE NO. 5)	652.30				
					1850					1850		SY	TEMPORARY EROSION MATTING	653.20				
					10					10		CY	TEMPORARY STONE CHECK DAM, TYPE I	653.25				
					60					60		CY	VEHICLE TRACKING PAD	653.35				
					2					2		EACH	FILTER BAG	653.45				
					1450					1450		LF	PROJECT DEMARCATION FENCE	653.55				
					1					1		LU	PRICE ADJUSTMENT, FUEL (N.A.B.I.)	690.50				
							160	90		250		CY	SPECIAL PROVISION (STONE FILL, CULVERT LINING)	900.608				
								225		225		LF	SPECIAL PROVISION (WLDLIFE GUIDE FENCE)	900.640				
							1			1		LS	SPECIAL PROVISION (TEMPORARY RELOCATION OF STREAM) (VT 125 - BRIDGE NO. 2)	900.645				
								1		1		LS	SPECIAL PROVISION (TEMPORARY RELOCATION OF STREAM) (VT 125 - BRIDGE NO. 5)	900.645				
					1					1		LS	SPECIAL PROVISION (TRAFFIC CONTROL, ALL-INCLUSIVE) (VT 125 - BRIDGE NO. 2)	900.645				
					1					1		LS	SPECIAL PROVISION (TRAFFIC CONTROL, ALL-INCLUSIVE) (VT 125 - BRIDGE NO. 5)	900.645				
							1			1		LU	SPECIAL PROVISION (INCENTIVE/DISINCENTIVE)(N.A.B.I.)(VT 125 - BRIDGE NO. 2)	900.650				
								1		1		LU	SPECIAL PROVISION (INCENTIVE/DISINCENTIVE)(N.A.B.I.)(VT 125 - BRIDGE NO. 5)	900.650				
						1	1			2		LU	SPECIAL PROVISION (MAT DENSITY PAY ADJUSTMENT, SMALL QUANTITY)(N.A.B.I.)	900.650				
						1	1			2		LU	SPECIAL PROVISION (MIXTURE PAY ADJUSTMENT)(N.A.B.I.)	900.650				
							470	340		810		TON	SPECIAL PROVISION (BITUMINOUS CONCRETE PAVEMENT, SMALL QUANTITY)	900.680				

NOTE: FOR DETAILED BREAKDOWN OF QUANTITIES BETWEEN BR2 AND BR5 SEE BR2 AND BR5 QUANTITY SHEETS

PROJECT NAME: BRIDPORT
PROJECT NUMBER: STP CULV(29)

FILE NAME: zllc264frm.dgn
PROJECT LEADER: M. CHENETTE
DESIGNED BY: J. HUNGERFORD
QUANTITY SHEET 2

PLOT DATE: 9/12/2014
DRAWN BY: L. BUXTON
CHECKED BY: J. HUNGERFORD
SHEET 6 OF 57



BR2 QUANTITY SHEET 1

SUMMARY OF ESTIMATED QUANTITIES										TOTALS		DESCRIPTIONS				DETAILED SUMMARY OF QUANTITIES		
						ROADWAY	EROSION CONTROL	BRIDGE NO. 2	FULL C.E. ITEMS	GRAND TOTAL	FINAL	UNIT	ITEMS	ITEM NUMBER	ROUND	QUANTITIES	UNIT	ITEMS
						1				1		LS	CLEARING AND GRUBBING, INCLUDING INDIVIDUAL TREES AND STUMPS	201.10				
						780				780		CY	COMMON EXCAVATION	203.15				
								400		400		CY	UNCLASSIFIED CHANNEL EXCAVATION	203.27				
						0.5				0.5		CY	TRENCH EXCAVATION OF EARTH, EXPLORATORY (N.A.B.I.)	204.22				
								1900		1900		CY	STRUCTURE EXCAVATION	204.25				
								1100		1100		CY	GRANULAR BACKFILL FOR STRUCTURES	204.30				
						340				340		SY	COLD PLANING, BITUMINOUS PAVEMENT	210.10				
						570				570		CY	SUBBASE OF DENSE GRADED CRUSHED STONE	301.35				
								5		5		GAL	WATER REPELLENT, SILANE	514.10				
								200		200		SY	SHEET MEMBRANE WATERPROOFING, TORCH APPLIED	519.20				
								1		1		EACH	REMOVAL OF STRUCTURE (16' X 11' x 68' CMPPA)	529.15				
								1		1		LS	PRECAST CONCRETE STRUCTURE (20'-0" X 10'-0" X 66'-0" BOX)	540.10				
						0.5				0.5		MGAL	DUST CONTROL WITH WATER	609.10				
						0.5				0.5		TON	DUST AND ICE CONTROL WITH CALCIUM CHLORIDE	609.15				
								700		700		CY	STONE FILL, TYPE II	613.11				
						67				67		LF	REMOVAL OF EXISTING FENCE	620.55				
						650				650		LF	STEEL BEAM GUARDRAIL, GALVANIZED W/8 FEET POSTS	621.205				
						4				4		EACH	ANCHOR FOR STEEL BEAM RAIL	621.60				
						538				538		LF	REMOVAL AND DISPOSAL OF GUARDRAIL	621.80				
						100				100		HR	FLAGGERS	630.15				
									0.5	0.5		LS	FIELD OFFICE, ENGINEERS	631.10				
									0.5	0.5		LS	TESTING EQUIPMENT, BITUMINOUS	631.17				
									1500	1500		DL	FIELD OFFICE TELEPHONE (N.A.B.I.)	631.26				
						0.5				0.5		LS	MOBILIZATION/DEMobilIZATION	635.11				
						7				7		EACH	PORTABLE CHANGEABLE MESSAGE SIGN	641.15				
						680				680		LF	DURABLE 4 INCH WHITE LINE	646.400				
						680				680		LF	DURABLE 4 INCH YELLOWLINE	646.410				
						525				525		SY	GEOTEXTILE FOR ROADBED SEPARATOR	649.11				
								1050		1050		SY	GEOTEXTILE UNDER STONE FILL	649.31				
							60			60		SY	GEOTEXTILE FOR SILT FENCE	649.51				
						20				20		LB	SEED	651.15				
						90				90		LB	FERTILIZER	651.18				
						1				1		TON	AGRICULTURAL LIMESTONE	651.20				
						1				1		TON	HAY MULCH	651.25				
						70				70		CY	TOPSOIL	651.35				
						950				950		SY	GRUBBING MATERIAL	651.40				
							1			1		LS	EPSC PLAN	652.10				
							40			40		HR	MONITORING EPSC PLAN	652.20				
							1			1		LU	MAINTENANCE OF EPSC PLAN (N.A.B.I.)	652.30				
							1500			1500		SY	TEMPORARY EROSION MATTING	653.20				

PROJECT NAME: BRIDPORT
 PROJECT NUMBER: STP CULV(29)

FILE NAME: zllc264frm.dgn
 PROJECT LEADER: M. CHENETTE
 DESIGNED BY: J. HUNGERFORD
 BR2 QUANTITY SHEET 1

PLOT DATE: 8/22/2014
 DRAWN BY: L. BUXTON
 CHECKED BY: J. HUNGERFORD
 SHEET 7 OF 57



BR2 QUANTITY SHEET 2

SUMMARY OF ESTIMATED QUANTITIES										TOTALS		DESCRIPTIONS				DETAILED SUMMARY OF QUANTITIES			
							ROADWAY	EROSION CONTROL	BRIDGE NO. 2	FULL C.E. ITEMS	GRAND TOTAL	FINAL	UNIT	ITEMS	ITEM NUMBER	ROUND	QUANTITIES	UNIT	ITEMS
								1500			1500		SY	TEMPORARY EROSION MATTING	653.20				
								10			10		CY	TEMPORARY STONE CHECK DAM, TYPE I	653.25				
								30			30		CY	VEHICLE TRACKING PAD	653.35				
								1			1		EACH	FILTER BAG	653.45				
								810			810		LF	PROJECT DEMARCATION FENCE	653.55				
									160		160		CY	SPECIAL PROVISION (STONE FILL, CULVERT LINING)	900.608				
									1		1		LS	SPECIAL PROVISION (TEMPORARY RELOCATION OF STREAM)(VT 125 - BRIDGE NO. 2)	900.645				
							1				1		LS	SPECIAL PROVISION (TRAFFIC CONTROL, ALL-INCLUSIVE)(VT 125 - BRIDGE NO. 2)	900.645				
									1		1		LU	SPECIAL PROVISION (INCENTIVE/DISINCENTIVE)(N.A.B.I)(VT 125 - BRIDGE NO. 2)	900.650				
									1		1		LU	SPECIAL PROVISION (MAT DENSITY PAY ADJUSTMENT, SMALL QUANTITY)(N.A.B.I)	900.650				
									1		1		LU	SPECIAL PROVISION (MIXTURE PAY ADJUSTMENT)(N.A.B.I)	900.650				
									470		470		TON	SPECIAL PROVISION (BITUMINOUS CONCRETE PAVEMENT, SMALL QUANTITY)	900.680				

PROJECT NAME: BRIDPORT
 PROJECT NUMBER: STP CULV(29)

FILE NAME: zllc264frm.dgn
 PROJECT LEADER: M. CHENETTE
 DESIGNED BY: J. HUNGERFORD
 BR2 QUANTITY SHEET 2

PLOT DATE: 9/12/2014
 DRAWN BY: L. BUXTON
 CHECKED BY: J. HUNGERFORD
 SHEET 8 OF 57



BR5 QUANTITY SHEET I

SUMMARY OF ESTIMATED QUANTITIES										TOTALS		DESCRIPTIONS				DETAILED SUMMARY OF QUANTITIES			
							ROADWAYS	EROSION CONTROL	BRIDGE NO. 5	FULL C.E. ITEMS	GRAND TOTAL	FINAL	UNIT	ITEMS	ITEM NUMBER	ROUND	QUANTITIES	UNIT	ITEMS
							1				1		LS	CLEARING AND GRUBBING, INCLUDING INDIVIDUAL TREES AND STUMPS	201.10				
							550				550		CY	COMMON EXCAVATION	203.15				
									140		140		CY	UNCLASSIFIED CHANNEL EXCAVATION	203.27				
							0.5				0.5		CY	TRENCH EXCAVATION OF EARTH, EXPLORATORY (N.A.B.I.)	204.22				
									570		570		CY	STRUCTURE EXCAVATION	204.25				
									330		330		CY	GRANULAR BACKFILL FOR STRUCTURES	204.30				
							320				320		SY	COLD PLANING, BITUMINOUS PAVEMENT	210.10				
							400				400		CY	SUBBASE OF DENSE GRADED CRUSHED STONE	301.35				
									2		2		GAL	WATER REPELLENT, SILANE	514.10				
									100		100		SY	SHEET MEMBRANE WATERPROOFING, TORCH APPLIED	519.20				
									1		1		EACH	REMOVAL OF STRUCTURE (84" X 41'-0" CGMP)	529.15				
									1		1		LS	PRECAST CONCRETE STRUCTURE (12'-0" X 9'-0" X 41'-0" BOX)	540.10				
							0.5				0.5		MGAL	DUST CONTROL WITH WATER	609.10				
							0.5				0.5		TON	DUST AND ICE CONTROL WITH CALCIUM CHLORIDE	609.15				
							115				115		CY	STONE FILL, TYPE I	613.10				
									30		30		CY	STONE FILL, TYPE II	613.11				
							1				1		EACH	RELOCATE MAILBOX, MULTIPLE SUPPORT	617.12				
							463				463		LF	STEEL BEAM GUARDRAIL, GALVANIZED	621.20				
							188				188		LF	STEEL BEAM GUARDRAIL, GALVANIZED/NESTED	621.206				
							4				4		EACH	ANCHOR FOR STEEL BEAM RAIL	621.60				
							363				363		LF	REMOVAL AND DISPOSAL OF GUARDRAIL	621.80				
							100				100		HR	FLAGGERS	630.15				
										0.5	0.5		LS	FIELD OFFICE, ENGINEERS	631.10				
										0.5	0.5		LS	TESTING EQUIPMENT, BITUMINOUS	631.17				
										1500	1500		DL	FIELD OFFICE TELEPHONE (N.A.B.I.)	631.26				
							0.5				0.5		LS	MOBILIZATION/DEMOBILIZATION	635.11				
							6				6		EACH	PORTABLE CHANGEABLE MESSAGE SIGN	641.15				
							560				560		LF	DURABLE 4 INCH WHITE LINE	646.400				
							560				560		LF	DURABLE 4 INCH YELLOW LINE	646.410				
							250				250		SY	GEOTEXTILE FOR ROADBED SEPARATOR	649.11				
									40		40		SY	GEOTEXTILE UNDER STONE FILL	649.31				
								40			40		SY	GEOTEXTILE FOR SILT FENCE	649.51				
							10				10		LB	SEED	651.15				
							70				70		LB	FERTILIZER	651.18				
							1				1		TON	AGRICULTURAL LIMESTONE	651.20				
							1				1		TON	HAY MULCH	651.25				
							50				50		CY	TOPSOIL	651.35				
							35				35		SY	GRUBBING MATERIAL	651.40				
								1			1		LS	EPSC PLAN	652.10				
								40			40		HR	MONITORING EPSC PLAN	652.20				

PROJECT NAME: BRIDPORT
 PROJECT NUMBER: STP CULV(29)

FILE NAME: zllc264frm.dgn
 PROJECT LEADER: M. CHENETTE
 DESIGNED BY: J. HUNGERFORD
 BR5 QUANTITY SHEET I

PLOT DATE: 8/22/2014
 DRAWN BY: L. BUXTON
 CHECKED BY: J. HUNGERFORD
 SHEET 9 OF 57



BR5 QUANTITY SHEET 2

SUMMARY OF ESTIMATED QUANTITIES										TOTALS		DESCRIPTIONS				DETAILED SUMMARY OF QUANTITIES			
							ROADWAY	EROSION CONTROL	BRIDGE NO. 5	FULL C.E. ITEMS	GRAND TOTAL	FINAL	UNIT	ITEMS	ITEM NUMBER	ROUND	QUANTITIES	UNIT	ITEMS
								40			40		HR	MONITORING EPSC PLAN	652.20				
								1			1		LU	MAINTENANCE OF EPSC PLAN (N.A.B.I.) (VT 125 - BRIDGE NO. 5)	652.30				
								350			350		SY	TEMPORARY EROSION MATTING	653.20				
								30			30		CY	VEHICLE TRACKING PAD	653.35				
								1			1		EACH	FILTER BAG	653.45				
								640			640		LF	PROJECT DEMARCATION FENCE	653.55				
									90		90		CY	SPECIAL PROVISION (STONE FILL, CULVERT LINING)	900.608				
							225				225		LF	SPECIAL PROVISION (WLDLIFE GUIDE FENCE)	900.640				
									1		1		LS	SPECIAL PROVISION (TEMPORARY RELOCATION OF STREAM)(VT 125 - BRIDGE NO. 5)	900.645				
							1				1		LS	SPECIAL PROVISION (TRAFFIC CONTROL, ALL-INCLUSIVE)(VT 125 - BRIDGE NO. 5)	900.645				
									1		1		LU	SPECIAL PROVISION (INCENTIVE/DISINCENTIVE)(VT 125 - BRIDGE NO. 5)	900.650				
									1		1		LU	SPECIAL PROVISION (MAT DENSITY PAY ADJUSTMENT)(N.A.B.I.)	900.650				
									1		1		LU	SPECIAL PROVISION (MIXTURE PAY ADJUSTMENT)	900.650				
									340		340		TON	SPECIAL PROVISION (BITUMINOUS CONCRETE PAVEMENT, SMALL QUANTITY)	900.680				

PROJECT NAME: BRIDPORT
 PROJECT NUMBER: STP CULV(29)

FILE NAME: zllc264frm.dgn
 PROJECT LEADER: M. CHENETTE
 DESIGNED BY: J. HUNGERFORD
 BR5 QUANTITY SHEET 2

PLOT DATE: 9/12/2014
 DRAWN BY: L. BUXTON
 CHECKED BY: J. HUNGERFORD
 SHEET 10 OF 57



GENERAL INFORMATION

SYMBOLY LEGEND NOTE

THE SYMBOLY ON THIS SHEET IS INTENDED TO COVER STANDARD CONVENTIONAL SYMBOLY. THE SYMBOLY IS USED FOR EXISTING & PROPOSED FEATURES WITH HEAVIER LINEWEIGHT, IN COMBINATION WITH PROJECT ANNOTATION, AS NOTED ON PROJECT PLAN SHEETS. THIS LEGEND SHEET COVERS THE BASICS. SYMBOLY ON PLANS MAY VARY, PLAN ANNOTATIONS AND NOTES SHOULD BE USED TO CLARIFY AS NEEDED.

R. O. W. ABBREVIATIONS (CODES) & SYMBOLS

POINT CODE	DESCRIPTION
CH	CHANNEL EASEMENT
CONST	CONSTRUCTION EASEMENT
CUL	CULVERT EASEMENT
D&C	DISCONNECT & CONNECT
DIT	DITCH EASEMENT
DR	DRAINAGE EASEMENT
DRIVE	DRIVEWAY EASEMENT
EC	EROSION CONTROL
HWY	HIGHWAY EASEMENT
I&M	INSTALL & MAINTAIN EASEMENT
LAND	LANDSCAPE EASEMENT
R&RES	REMOVE & RESET
R&REP	REMOVE & REPLACE
SR	SLOPE RIGHT
UE	UTILITY EASEMENT
(P)	PERMANENT EASEMENT
(T)	TEMPORARY EASEMENT
■	BNDNS BOUND SET
□	BNDNS BOUND TO BE SET
●	IPNS IRON PIN SET
⊙	IPNS IRON PIN TO BE SET
⊗	CALC EXISTING ROW POINT
○	PROW PROPOSED ROW POINT
[LENGTH]	LENGTH CARRIED ON NEXT SHEET

COMMON TOPOGRAPHIC POINT SYMBOLS

POINT CODE	DESCRIPTION
#	APL BOUND APPARENT LOCATION
□	BM BENCH MARK
■	BND BOUND
▣	CB CATCH BASIN
⊕	COMB COMBINATION POLE
▣	DITHR DROP INLET THROATED DNC
⊕	EL ELECTRIC POWER POLE
○	FPOLE FLAGPOLE
○	GASFIL GAS FILLER
○	GP GUIDE POST
*	GSO GAS SHUT OFF
○	GUY GUY POLE
○	GUYW GUY WIRE
*	GV GATE VALVE
⊗	H TREE HARDWOOD
△	HCTRL CONTROL HORIZONTAL
▲	HVCTRL CONTROL HORIZ. & VERTICAL
◇	HYD HYDRANT
●	IP IRON PIN
●	IPIPE IRON PIPE
⊕	LI LIGHT - STREET OR YARD
⊕	MB MAILBOX
○	MH MANHOLE (MH)
■	MM MILE MARKER
●	PM PARKING METER
■	PMK PROJECT MARKER
○	POST POST STONE/WOOD
⊕	RRSIG RAILROAD SIGNAL
⊕	RRSL RAILROAD SWITCH LEVER
⊕	S TREE SOFTWOOD
⊕	SAT SATELLITE DISH
⊕	SHRUB SHRUB
⊕	SIGN SIGN
⊕	STUMP STUMP
⊕	TEL TELEPHONE POLE
○	TIE TIE
⊕	TSIGN SIGN W/DOUBLE POST
⊕	VCTRL CONTROL VERTICAL
○	WELL WELL
*	WSO WATER SHUT OFF

THESE ARE COMMON VAOT SURVEY POINT SYMBOLS FOR EXISTING FEATURES, ALSO USED FOR PROPOSED FEATURES WITH HEAVIER LINEWEIGHT, IN COMBINATION WITH PROPOSED ANNOTATION.

PROPOSED GEOMETRY CODES

CODE	DESCRIPTION
PC	POINT OF CURVATURE
PI	POINT OF INTERSECTION
CC	CENTER OF CURVE
PT	POINT OF TANGENCY
PCC	POINT OF COMPOUND CURVE
PRC	POINT OF REVERSE CURVE
POB	POINT OF BEGINNING
POE	POINT OF ENDING
STA	STATION PREFIX
AH	AHEAD STATION SUFFIX
BK	BACK STATION SUFFIX
D	CURVE DEGREE OF (100FT)
R	CURVE RADUIS OF
T	CURVE TANGENT LENGTH
L	CURVE LENGTH OF
E	CURVE EXTERNAL DISTANCE

UTILITY SYMBOLY

UNDERGROUND UTILITIES

— UT —	TELEPHONE
— UE —	ELECTRIC
— UC —	CABLE (TV)
— UEC —	ELECTRIC+CABLE
— UET —	ELECTRIC+TELEPHONE
— UCT —	CABLE+TELEPHONE
— UECT —	ELECTRIC+CABLE+TELEP.
— G —	GAS LINE
— W —	WATER LINE
— S —	SANITARY SEWER (SEPTIC)

ABOVE GROUND UTILITIES (AERIAL)

— T —	TELEPHONE
— E —	ELECTRIC
— C —	CABLE (TV)
— EC —	ELECTRIC+CABLE
— ET —	ELECTRIC+TELEPHONE
— AER E&T —	ELECTRIC+TELEPHONE
— CT —	CABLE+TELEPHONE
— ECT —	ELECTRIC+CABLE+TELEP.
—	UTILITY POLE GUY WIRE

PROJECT CONSTRUCTION SYMBOLY

— — — CZ — — —	CLEAR ZONE
— — — — —	PLAN LAYOUT MATCHLINE

PROJECT CONSTRUCTION FEATURES

▲ —▲—▲—▲—▲	TOP OF CUT SLOPE
○ —○—○—○—○	TOE OF FILL SLOPE
⊕ —⊕—⊕—⊕—⊕	STONE FILL
⊕ —⊕—⊕—⊕—⊕	BOTTOM OF DITCH
— — — — —	CULVERT PROPOSED
— — — — —	STRUCTURE SUBSURFACE
PDF — PDF —	PROJECT DEMARCATION FENCE
BF — BF —	BARRIER FENCE
XXXXXXXXXXXX	TREE PROTECTION ZONE (TPZ)
//// //// ////	STRIPING LINE REMOVAL
~~~~~	SHEET PILES

**CONVENTIONAL BOUNDARY SYMBOLY**

**BOUNDARY LINES**

— — — — —	TOWN BOUNDARY LINE
— — — — —	COUNTY BOUNDARY LINE
— — — — —	STATE BOUNDARY LINE
— — — — —	PROPOSED STATE R.O.W. (LIMITED ACCESS)
— — — — —	PROPOSED STATE R.O.W.
— — — — —	STATE ROW (LIMITED ACCESS)
— — — — —	STATE ROW
— — — — —	TOWN ROW
— — — — —	PERMANENT EASEMENT LINE (P)
— — — — —	TEMPORARY EASEMENT LINE (T)
— — — — —	SURVEY LINE
— P — — P —	PROPERTY LINE (P/L)
SR — SR — SR —	SLOPE RIGHTS
6f — 6f —	6F PROPERTY BOUNDARY
4f — 4f —	4F PROPERTY BOUNDARY
HAZ — HAZ —	HAZARDOUS WASTE

**EPSC LAYOUT PLAN SYMBOLY**

**EPSC MEASURES**

ONNOONNOONNO	FILTER CURTAIN
— — — — —	SILT FENCE
— X — X — X — X —	SILT FENCE WOVEN WIRE
— — — — —	CHECK DAM
■	DISTURBED AREAS REQUIRING RE-VEGETATION
⊗	EROSION MATTING

**ENVIRONMENTAL RESOURCES**

— — — — —	WETLAND BOUNDARY
— — — — —	RIPARIAN BUFFER ZONE
— — — — —	WETLAND BUFFER ZONE
— — — — —	SOIL TYPE BOUNDARY
— T&E —	THREATENED & ENDANGERED SPECIES
— HAZ — HAZ —	HAZARDOUS WASTE AREA
— AG —	AGRICULTURAL LAND
— HABITAT —	FISH & WILDLIFE HABITAT
— FLOOD PLAN —	FLOOD PLAN
— OHW —	ORDINARY HIGH WATER (OHW)
— — — — —	STORM WATER
— — — — —	USDA FOREST SERVICE LANDS
— — — — —	WILDLIFE HABITAT SUIT/CONN

**ARCHEOLOGICAL & HISTORIC**

— ARCH —	ARCHEOLOGICAL BOUNDARY
— HISTORIC DIST —	HISTORIC DISTRICT BOUNDARY
— HISTORIC —	HISTORIC AREA
Ⓜ	HISTORIC STRUCTURE

**CONVENTIONAL TOPOGRAPHIC SYMBOLY**

**EXISTING FEATURES**


— — — — —	ROAD EDGE PAVEMENT
— — — — —	ROAD EDGE GRAVEL
— — — — —	DRIVEWAY EDGE
— — — — —	DITCH
— — — — —	FOUNDATION
x — x — x — x —	FENCE (EXISTING)
□ — □ — □ — □ —	FENCE WOOD POST
○ — ○ — ○ — ○ —	FENCE STEEL POST
~~~~~	GARDEN
○ — ○ — ○ — ○ —	ROAD GUARDRAIL
	RAILROAD TRACKS
— — — — —	CULVERT (EXISTING)
— — — — —	STONE WALL
— — — — —	WALL
~~~~~	WOOD LINE
~~~~~	BRUSH LINE
~~~~~	HEDGE
— — — — —	BODY OF WATER EDGE
//// //// ////	LEDGE EXPOSED

PROJECT NAME: BRIDPORT  
PROJECT NUMBER: STP CULV(29)


FILE NAME: zllc264legend.dgn  
PROJECT LEADER: M. CHENETTE  
DESIGNED BY: VTRANS  
CONVENTIONAL SYMBOLY LEGEND

PLOT DATE: 8/22/2014  
DRAWN BY: VTRANS  
CHECKED BY: VTRANS  
SHEET II OF 57



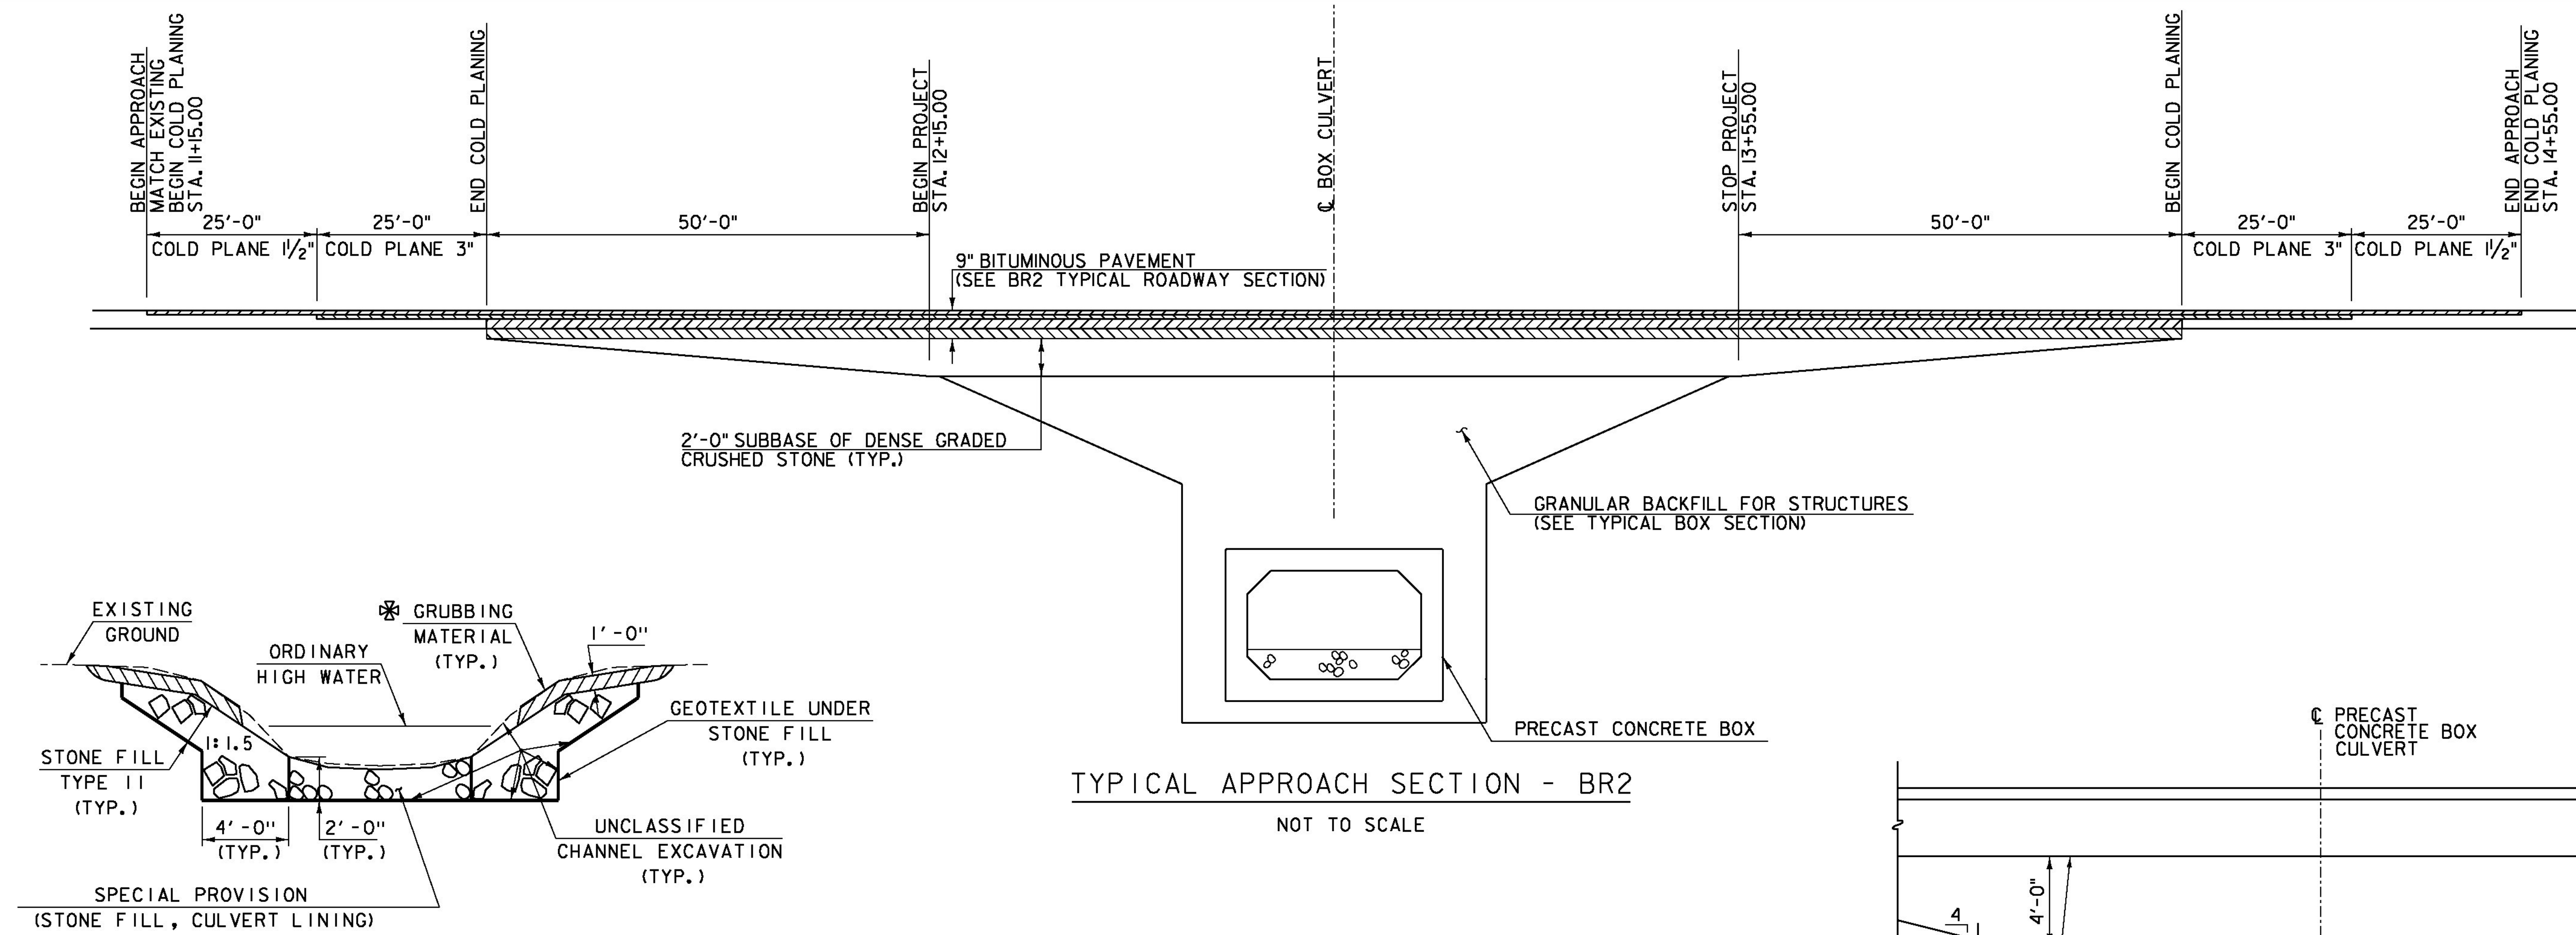


TYPICAL APPROACH SECTION - BR2  
NOT TO SCALE

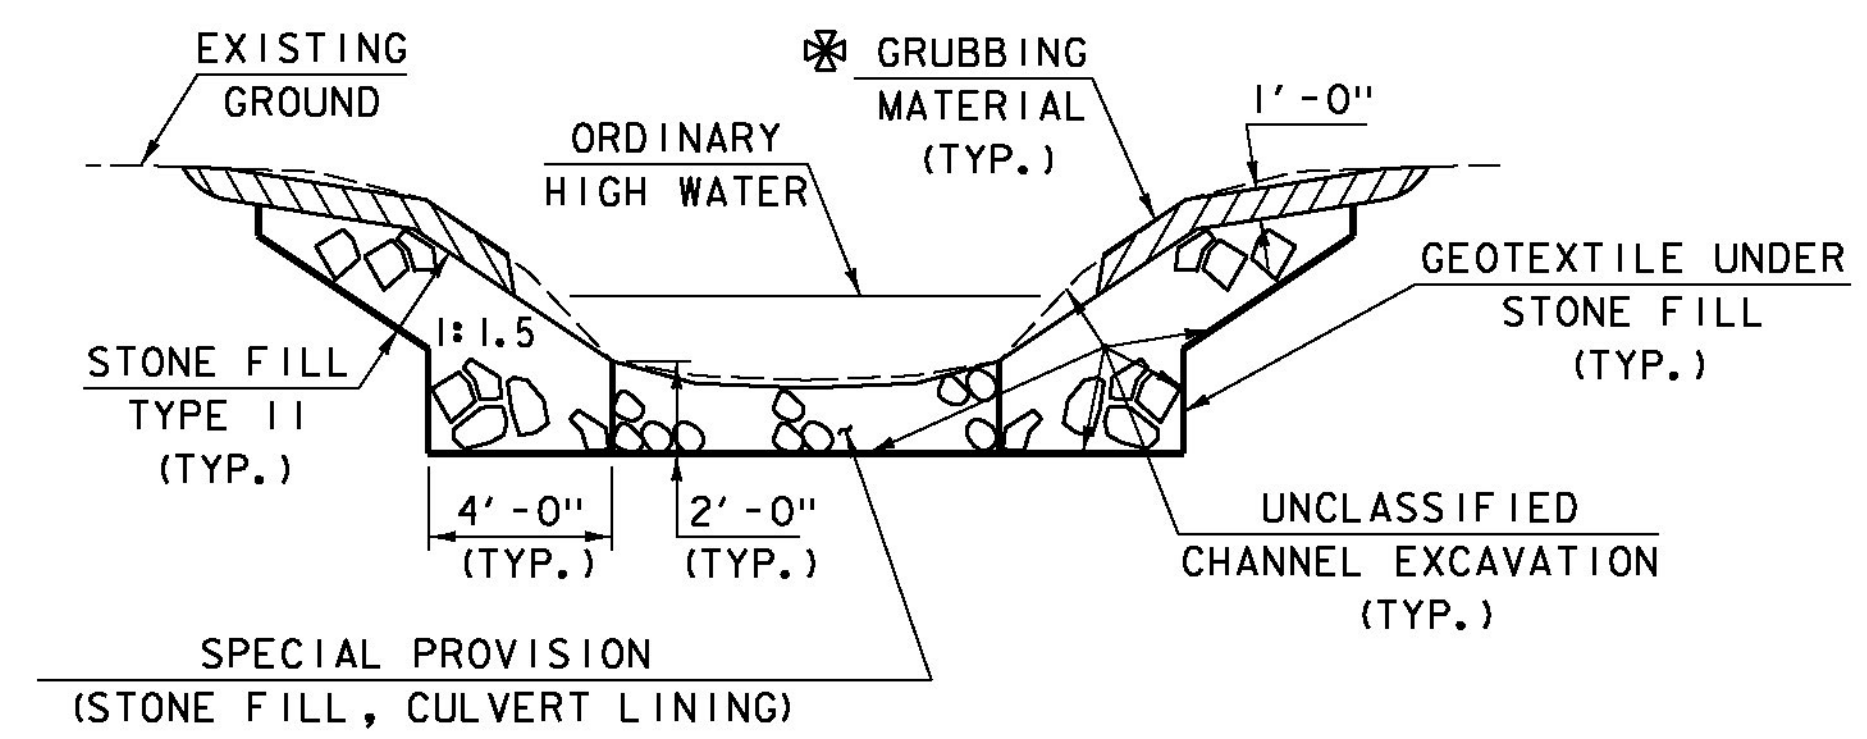

CHANNEL TYPICAL SECTION  
NOT TO SCALE

✱ WHENEVER CHANNEL SLOPE INTERSECTS ROADWAY SUBBASE, GRUBBING MATERIAL SHALL BEGIN AT THE BOTTOM OF SUBBASE.

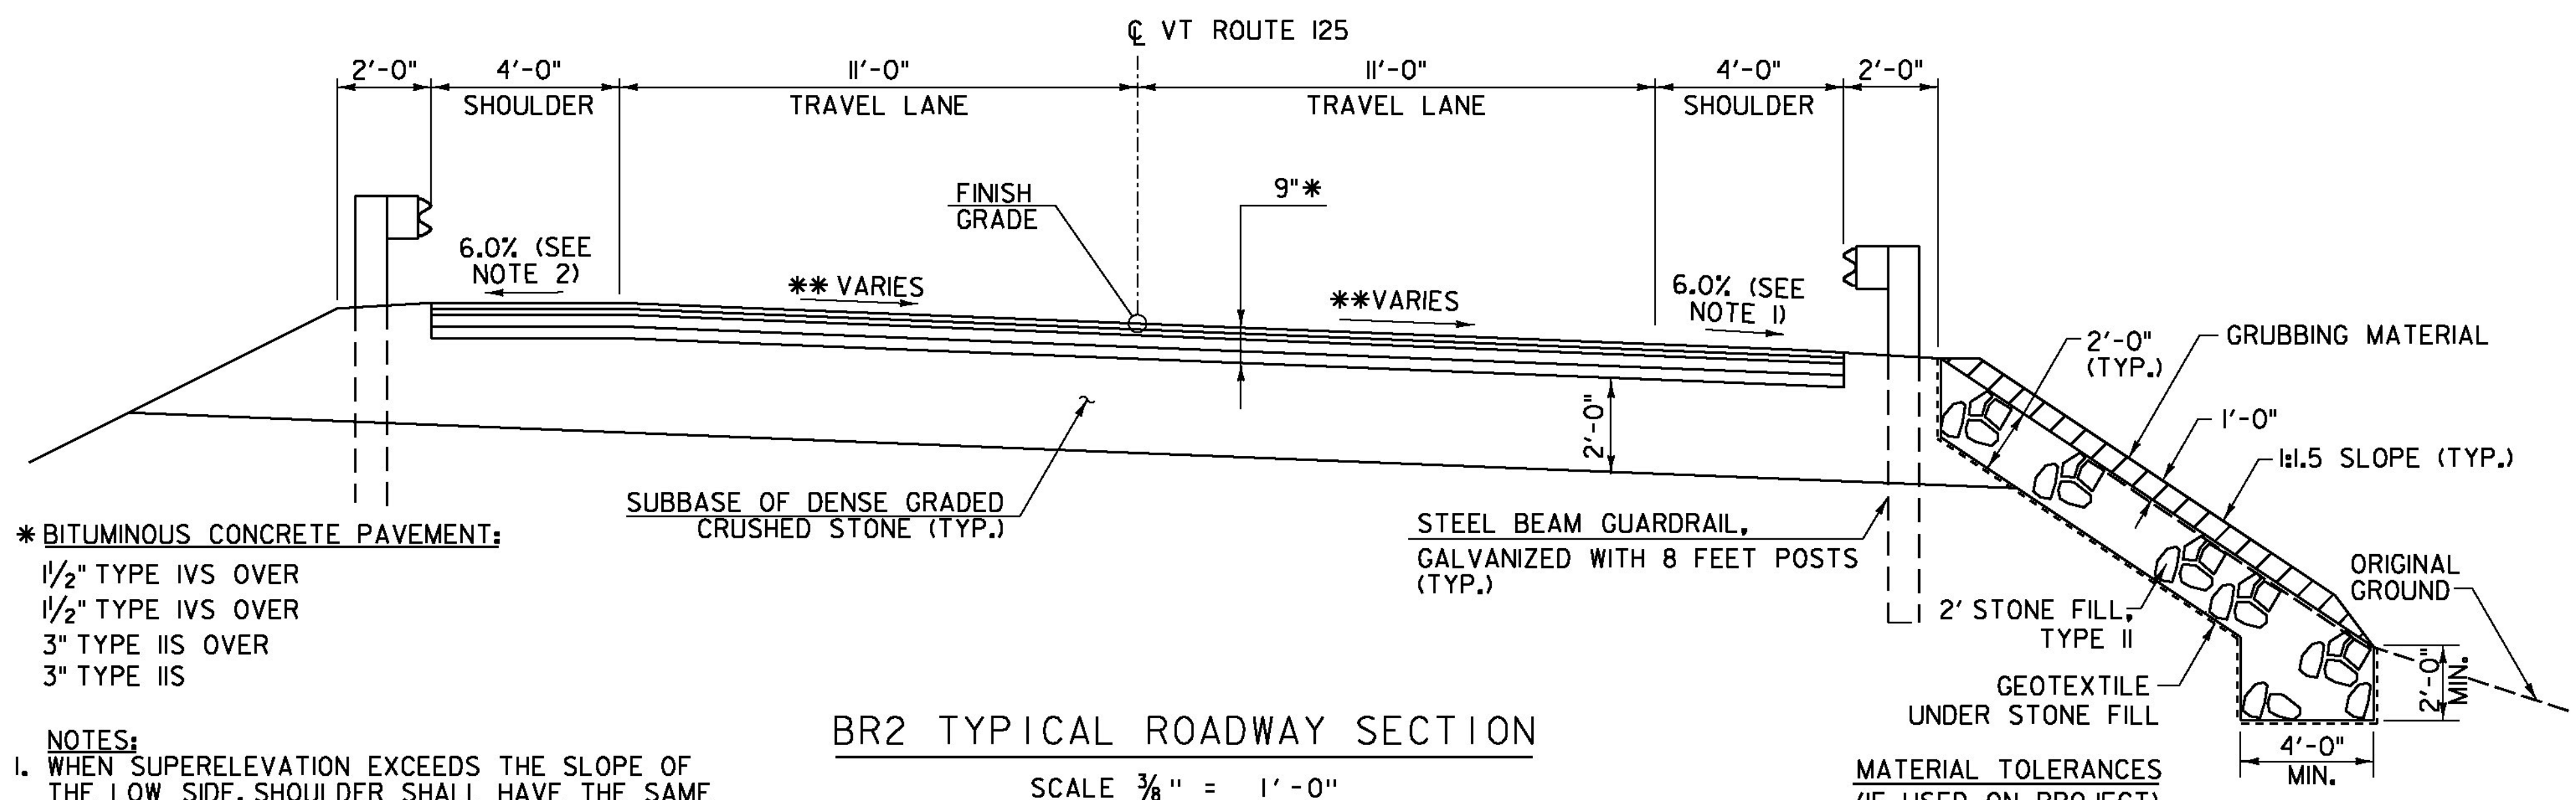


BR2 TYPICAL ROADWAY SECTION  
SCALE 3/8" = 1'-0"

* BITUMINOUS CONCRETE PAVEMENT:  
1/2" TYPE IVS OVER  
1/2" TYPE IVS OVER  
3" TYPE IIS OVER  
3" TYPE IIS

NOTES:  
1. WHEN SUPERELEVATION EXCEEDS THE SLOPE OF THE LOW SIDE, SHOULDER SHALL HAVE THE SAME SLOPE AS THE TRAVEL WAY.  
2. MAXIMUM HIGHSIDE SHOULDER ROLLOVER SHALL NOT EXCEED 7%.

** SEE BANKING DIAGRAM ON SHEET 11, MATCH EXISTING CROSS SLOPE ON APPROACHES.

SURFACE	
- PAVEMENT (TOTAL THICKNESS)	+/- 1/4"
- AGGREGATE SURFACE COARSE	+/- 1/2"
SUBBASE	+/- 1"
SAND BORROW	+/- 1"

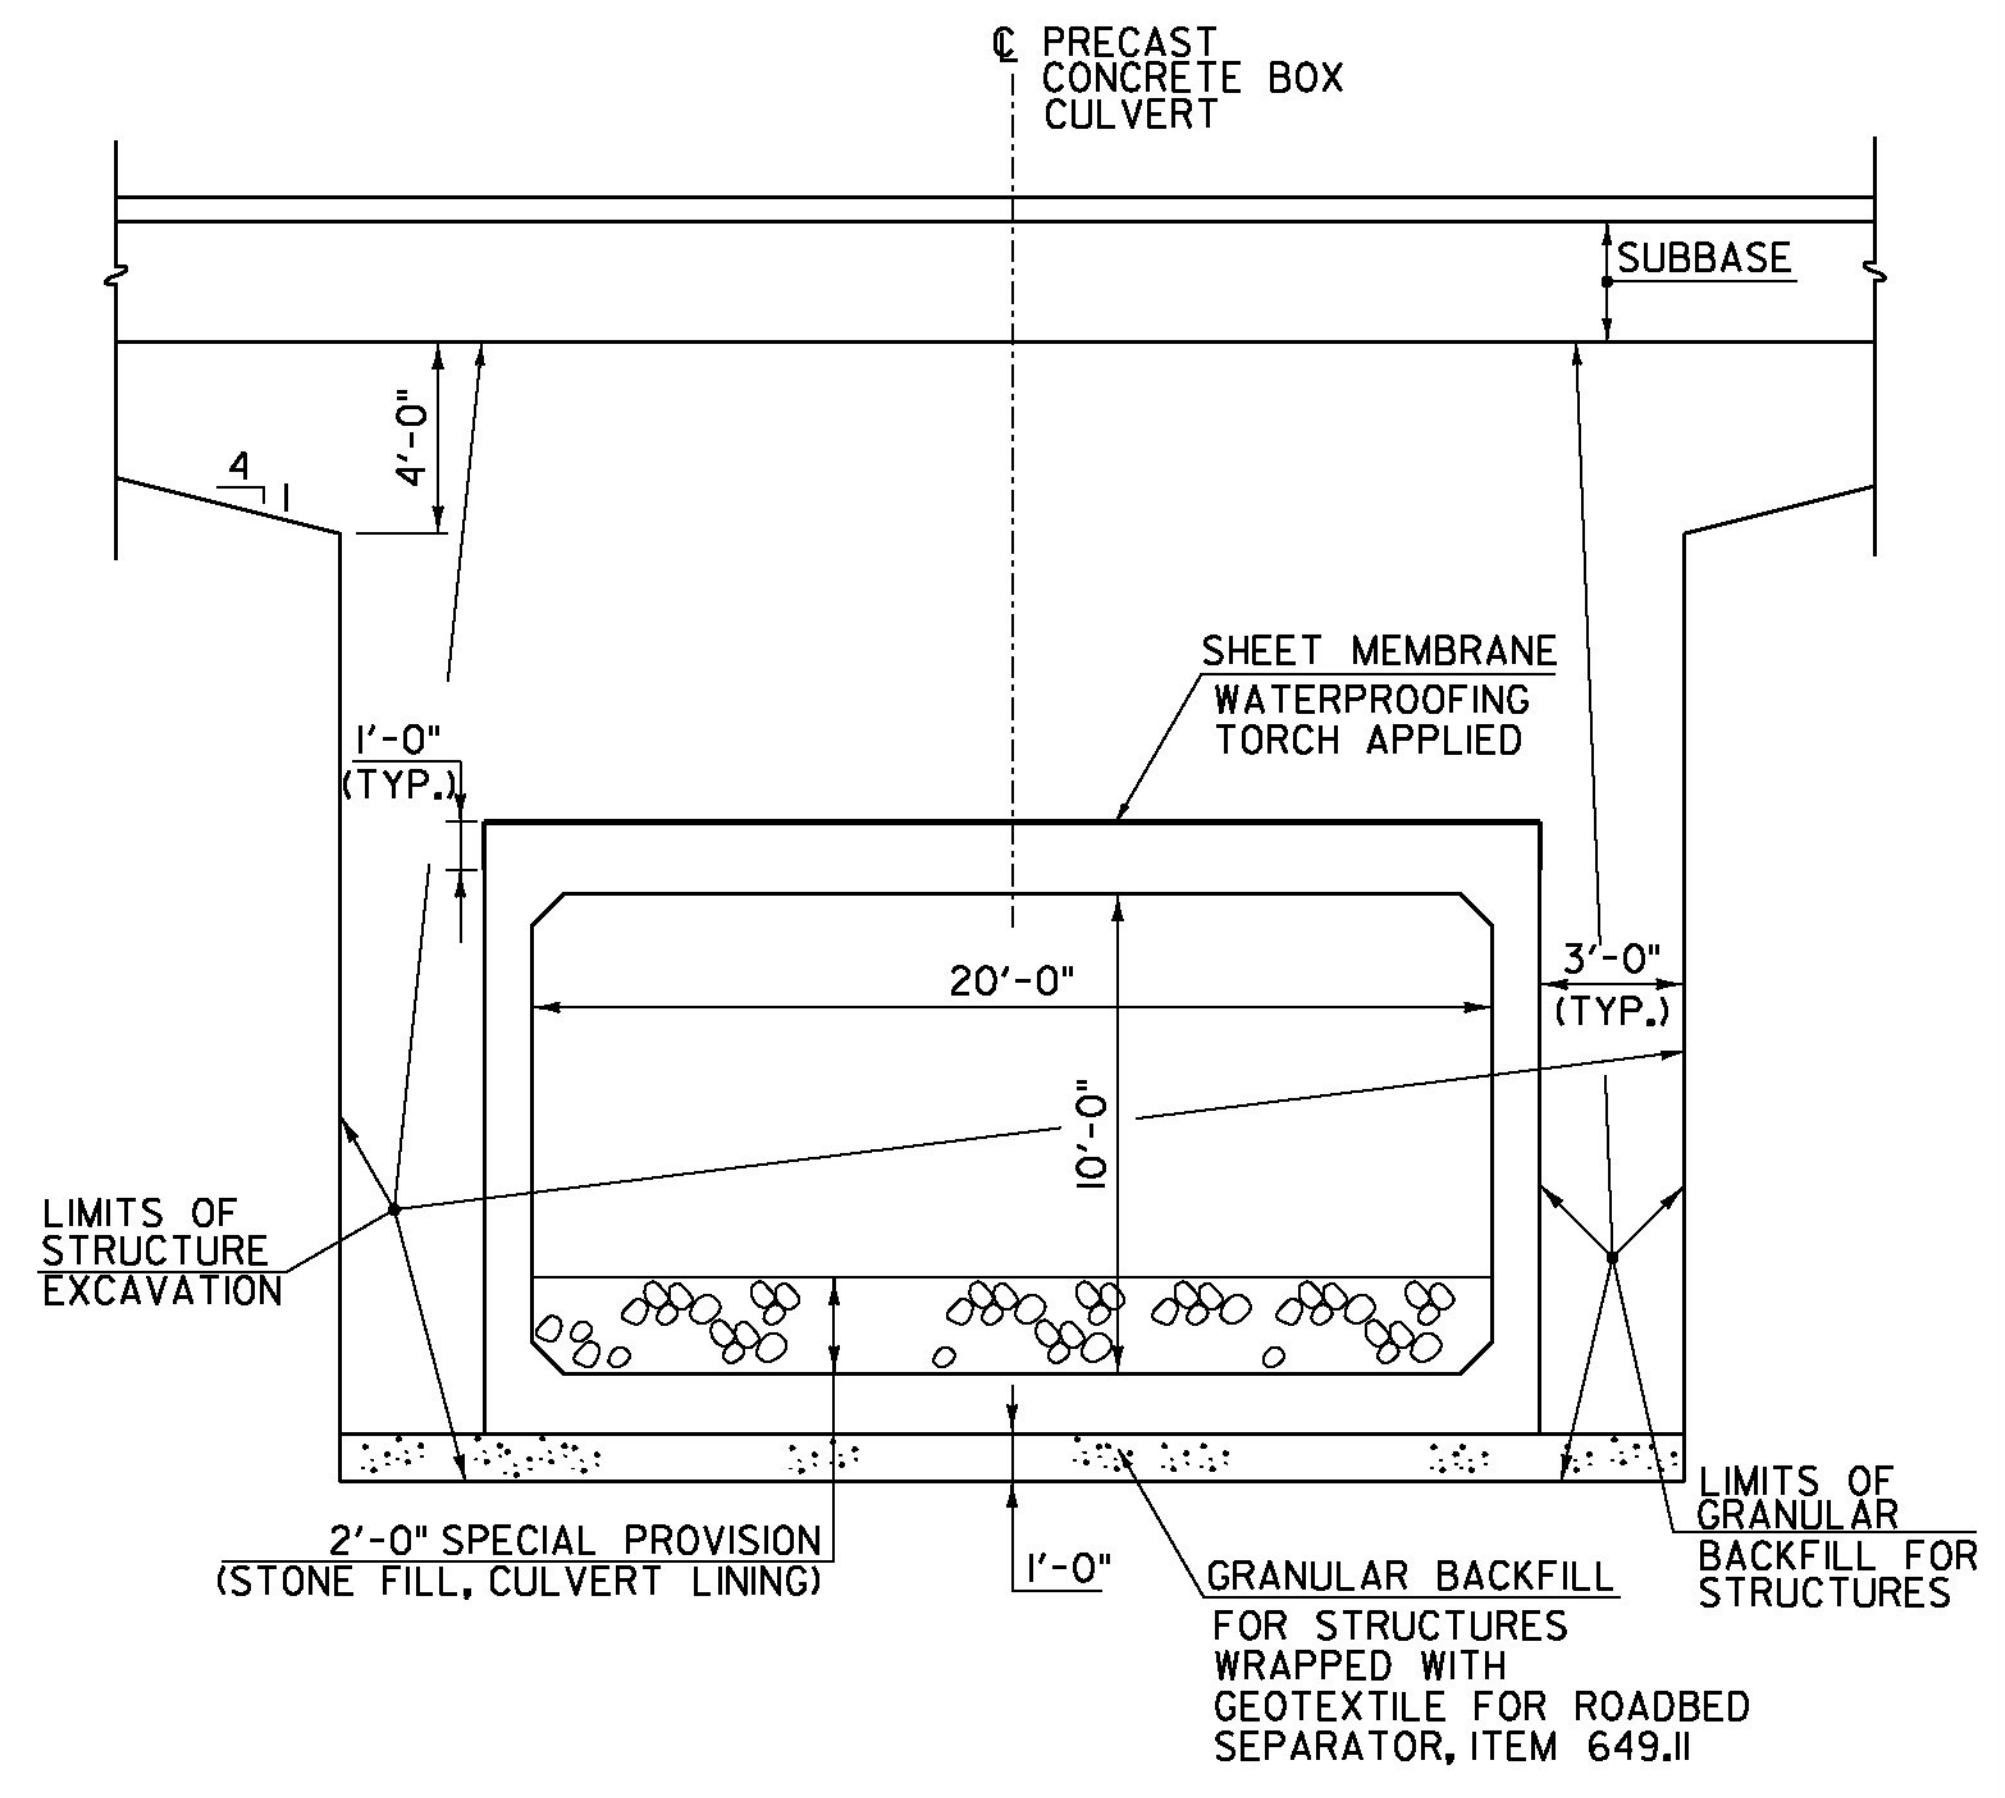

PRECAST CONCRETE BOX TYPICAL SECTION - BR2  
SCALE: 1/4" = 1'-0"

NOTE:  
FOR WINGWALL EARTHWORK SECTION, SEE STRUCTURAL PLAN AND DETAILS - BR2.

PROJECT NAME:	BRIDPORT	FILE NAME:	z11c264typsec.dgn	PLOT DATE:	8/22/2014
PROJECT NUMBER:	STP CULV(29)	PROJECT LEADER:	M. CHENETTE	DRAWN BY:	L. BUXTON
		DESIGNED BY:	J. HUNGERFORD	CHECKED BY:	M. CHENETTE
		TYPICAL SECTIONS - BR2			SHEET 12 OF 57



GPS CONTROL POINTS






HVCTRL #1  
 DIG HARD AZ MK  
 NORTH = 544657.447  
 EAST = 1418699.138  
 ELEV. = 214.710

GENERAL LOCATION, BRIDPORT, VERMONT.  
 TO REACH FROM THE INTERSECTION OF VT. ROUTES 22A AND 125 WEST IN BRIDPORT GO WEST ALONG VT. ROUTE 125 FOR 1.6 MI (2.6 KM) TO THE MARK ON THE LEFT. IT IS ABOUT 0.5 MI (0.8 KM) WEST OF THE VT. ROUTE 125 BRIDGE OVER THE EAST BRANCH DEAD CREEK. THE MARK IS SET FLUSH WITH THE GROUND SURFACE IN THE TOP OF A 30 CM DIAMETER CONCRETE MONUMENT SET 1.4 M (4.6 FT) DEEP. IT IS 4.1 M (13.5 FT) SOUTH OF AND ABOUT 0.3 M (1.0 FT) LOWER THAN THE SOUTH EDGE OF PAVEMENT OF VT. ROUTE 125, 28.2 M (92.5 FT) SOUTHWEST OF POLE NO. 21, 18.1 M (59.4 FT) EAST OF A 50 CM HICKORY, 9.6 M (31.5 FT) EAST OF THE CENTERLINE OF A GRAVEL DRIVE, AND 0.3 M (1.0 FT) NORTH OF A FIBERGLASS WITNESS POST

HVCTRL #2  
 DIG HARD  
 NORTH = 545190.812  
 EAST = 1422015.220  
 ELEV. = 171.234






GENERAL LOCATION, BRIDPORT, VERMONT.  
 TO REACH FROM THE INTERSECTION OF VT. ROUTES 22A AND 125 WEST IN BRIDPORT GO WEST ALONG VT. ROUTE 125 FOR 0.9 MI (1.4 KM) TO THE MARK ON THE RIGHT. IT IS ABOUT 0.15 MI (0.24 KM) EAST OF THE VT. ROUTE 125 BRIDGE OVER THE EAST BRANCH DEAD CREEK. THE MARK IS SET 0.1 M (0.3 FT) BELOW THE GROUND SURFACE IN THE TOP OF A 30 CM (12") DIAMETER CONCRETE MONUMENT SET 1.4 M (4.6 FT) DEEP. IT IS 4.6 M (15.1 FT) NORTH OF AND ABOUT 0.3 M (1.0 FT) LOWER THAN THE NORTH EDGE OF PAVEMENT OF VT. ROUTE 125, 20.4 M (66.9 FT) NORTHEAST OF UNDERGROUND TELEPHONE BOX NO. L11/7, 44.1 M (144.7 FT) SOUTHEAST OF A 90 CM OAK, AND 0.5 M (1.6 FT) SOUTH OF A WIRE FENCE AND A FIBERGLASS WITNESS POST.

TRAVERSE TIES

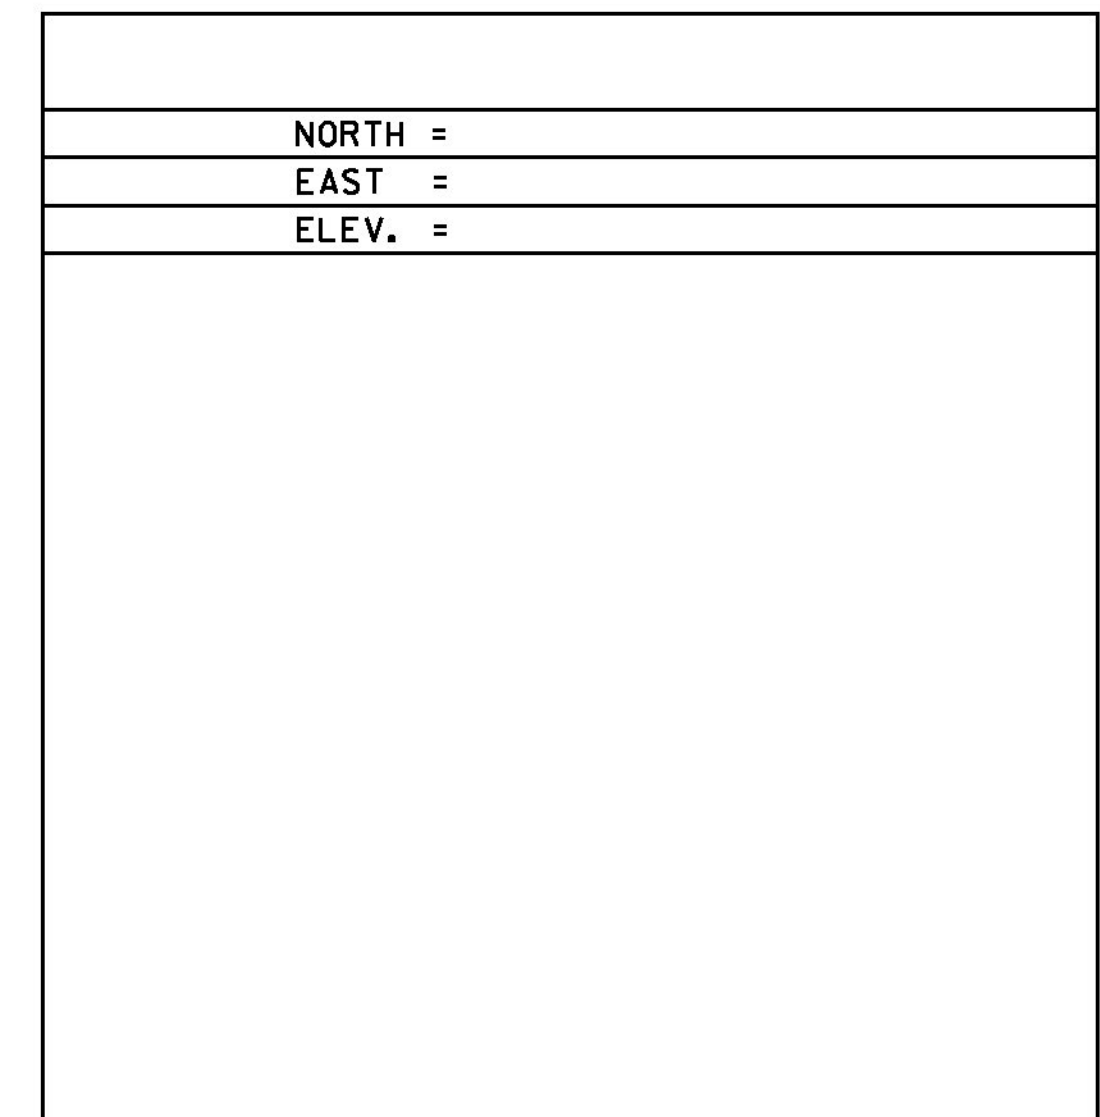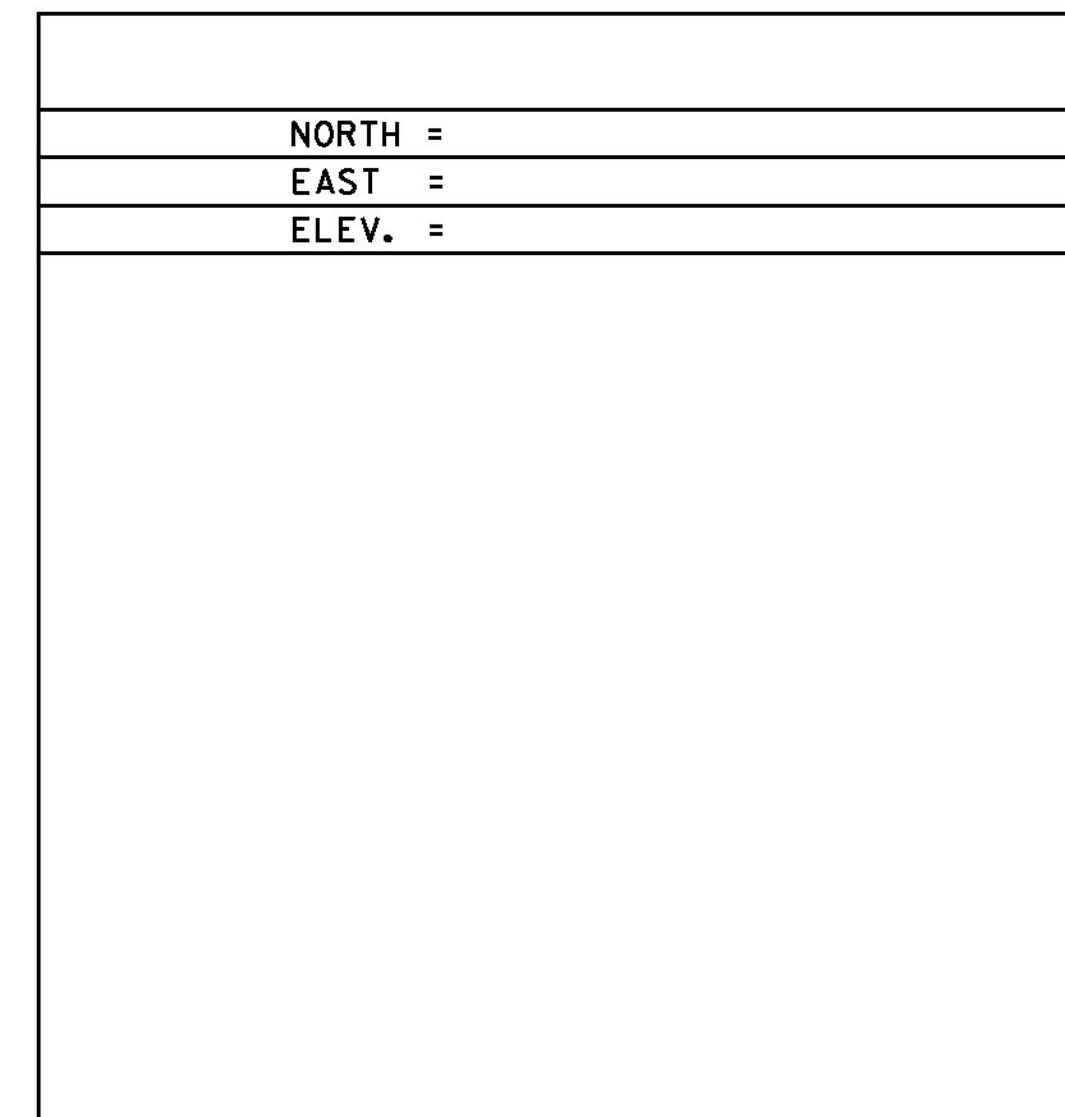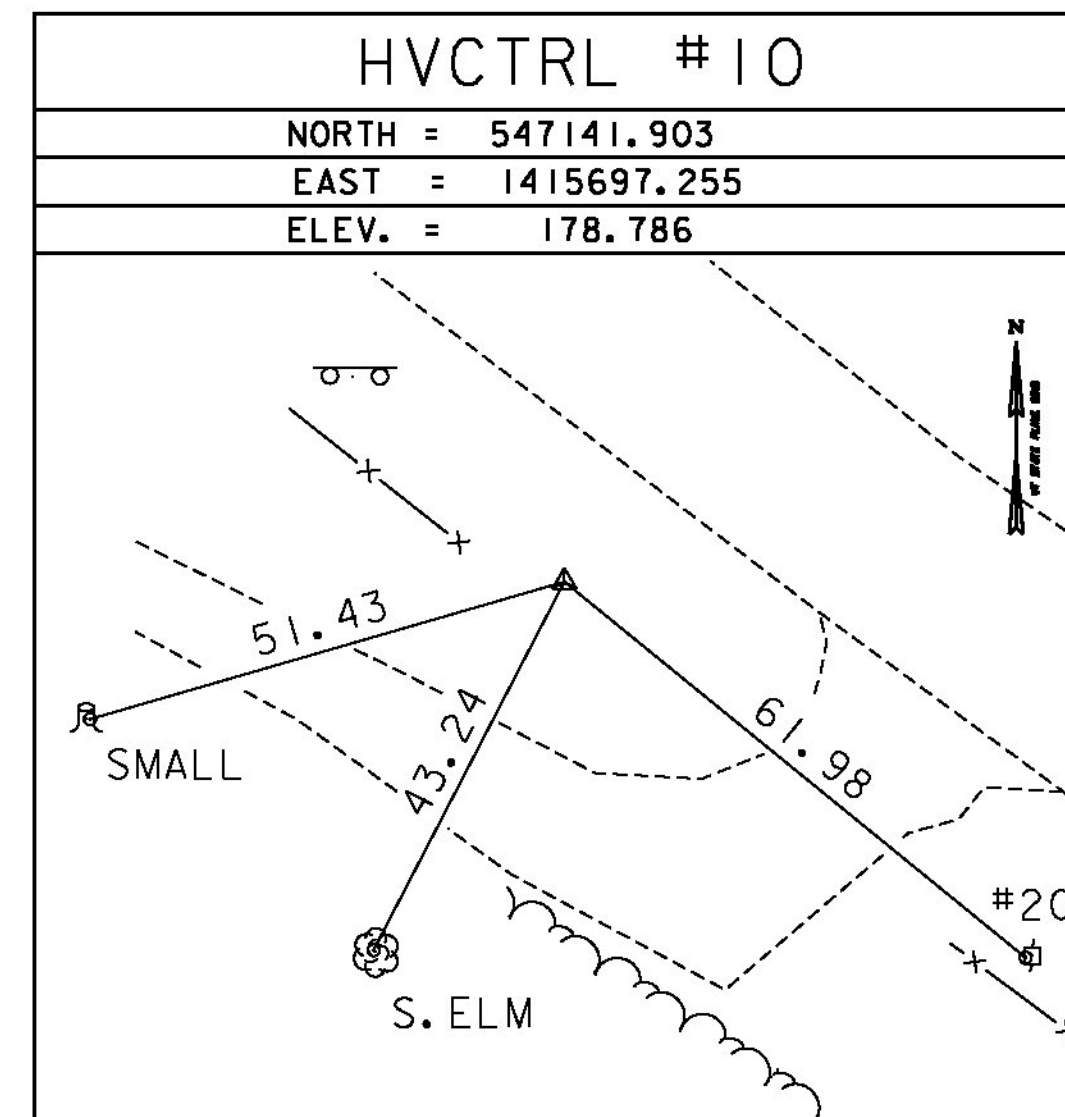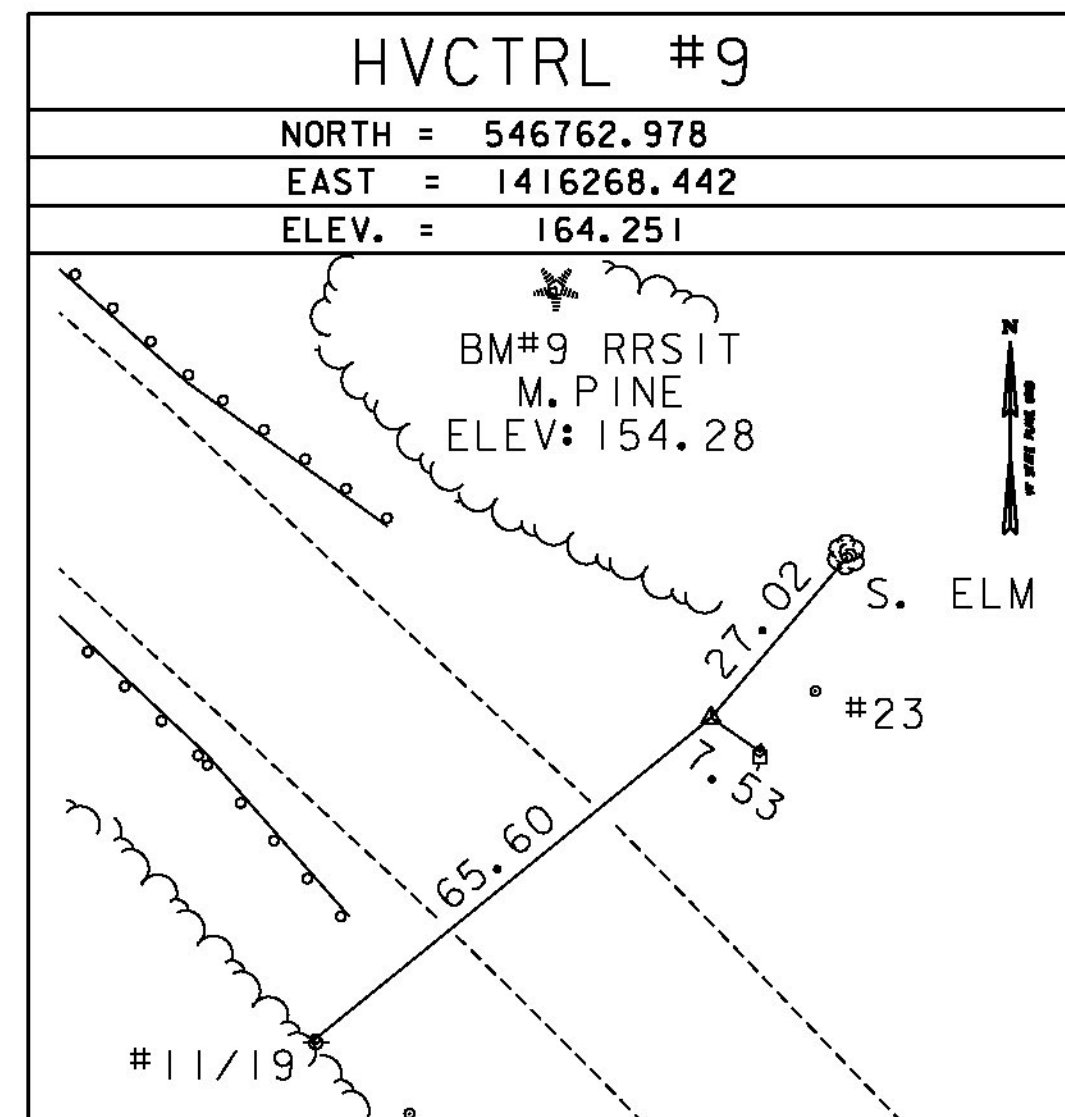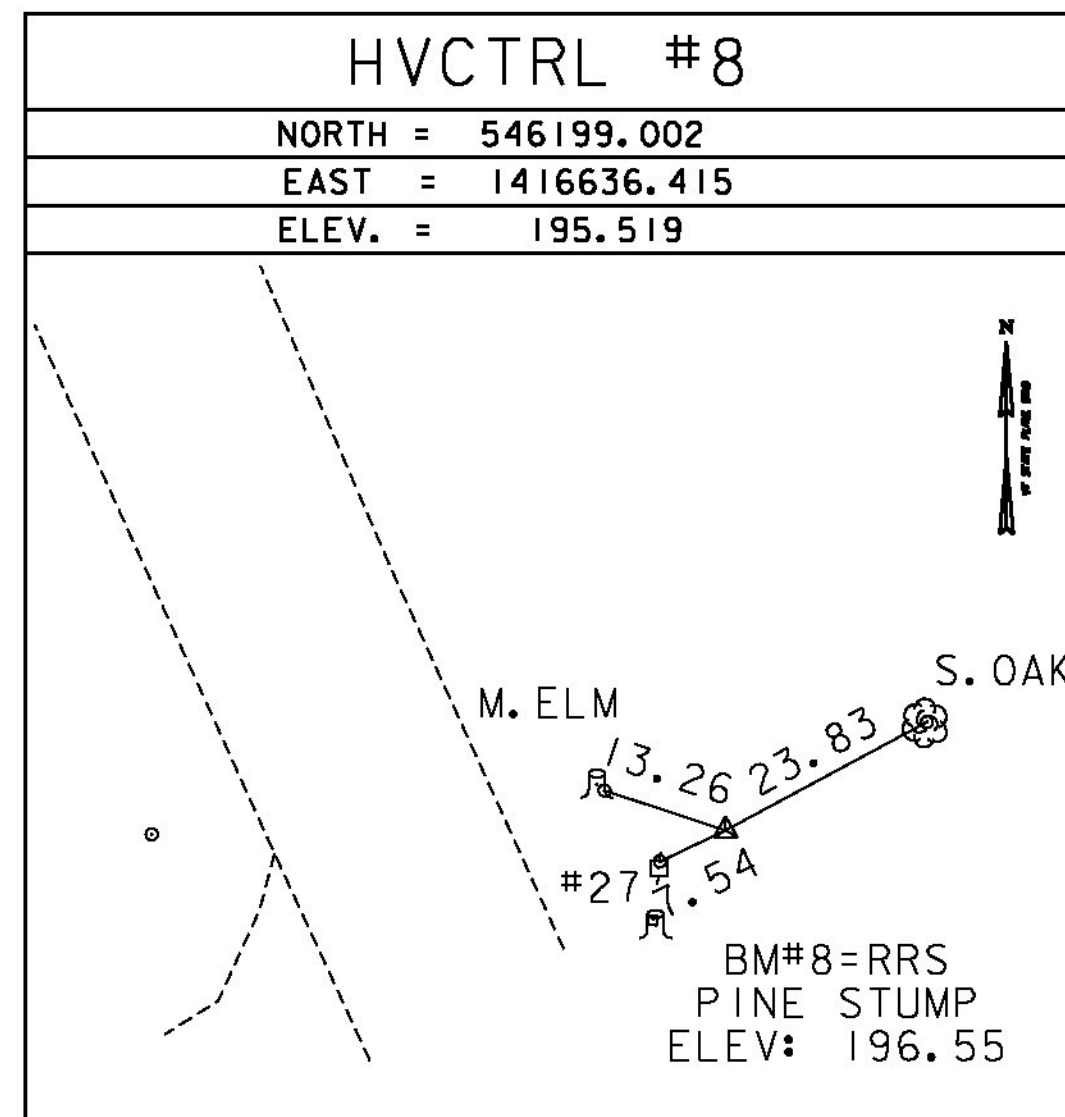

* MAIN TRAVERSE COMPLETED 1/25/2012 BY L. ORVIS P.C. & G. HITCHCOCK

ALIGNMENT TIES

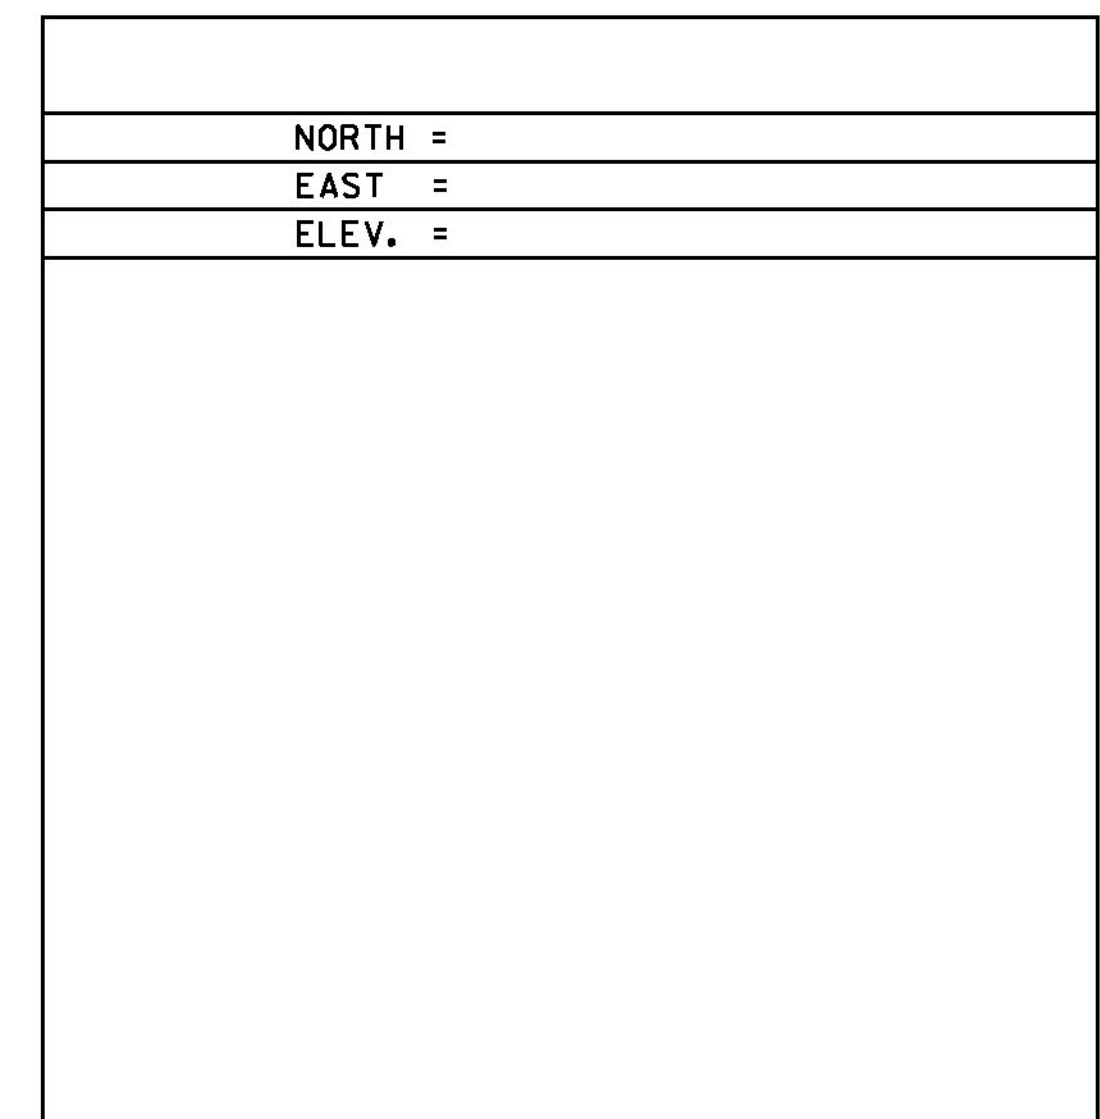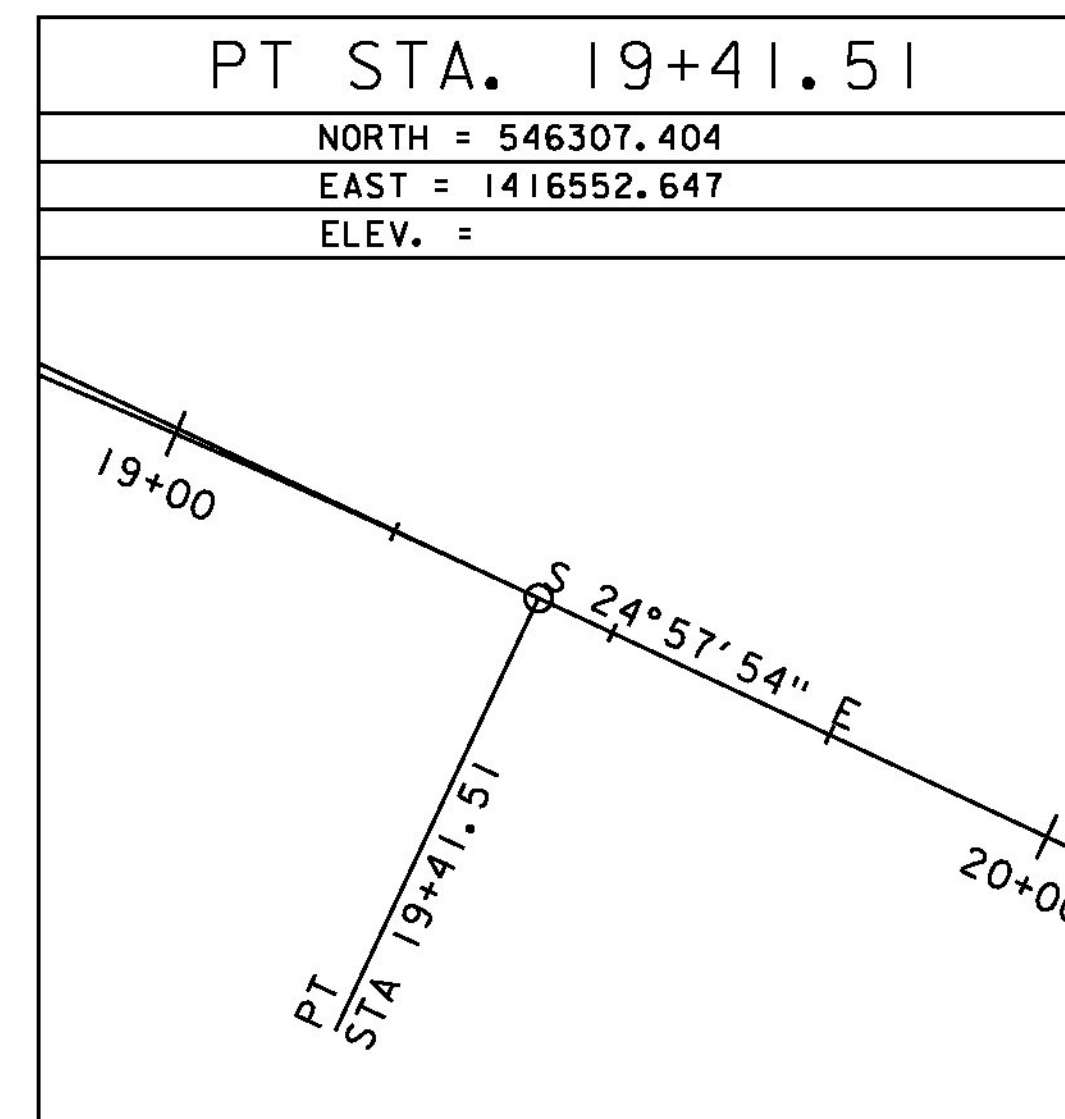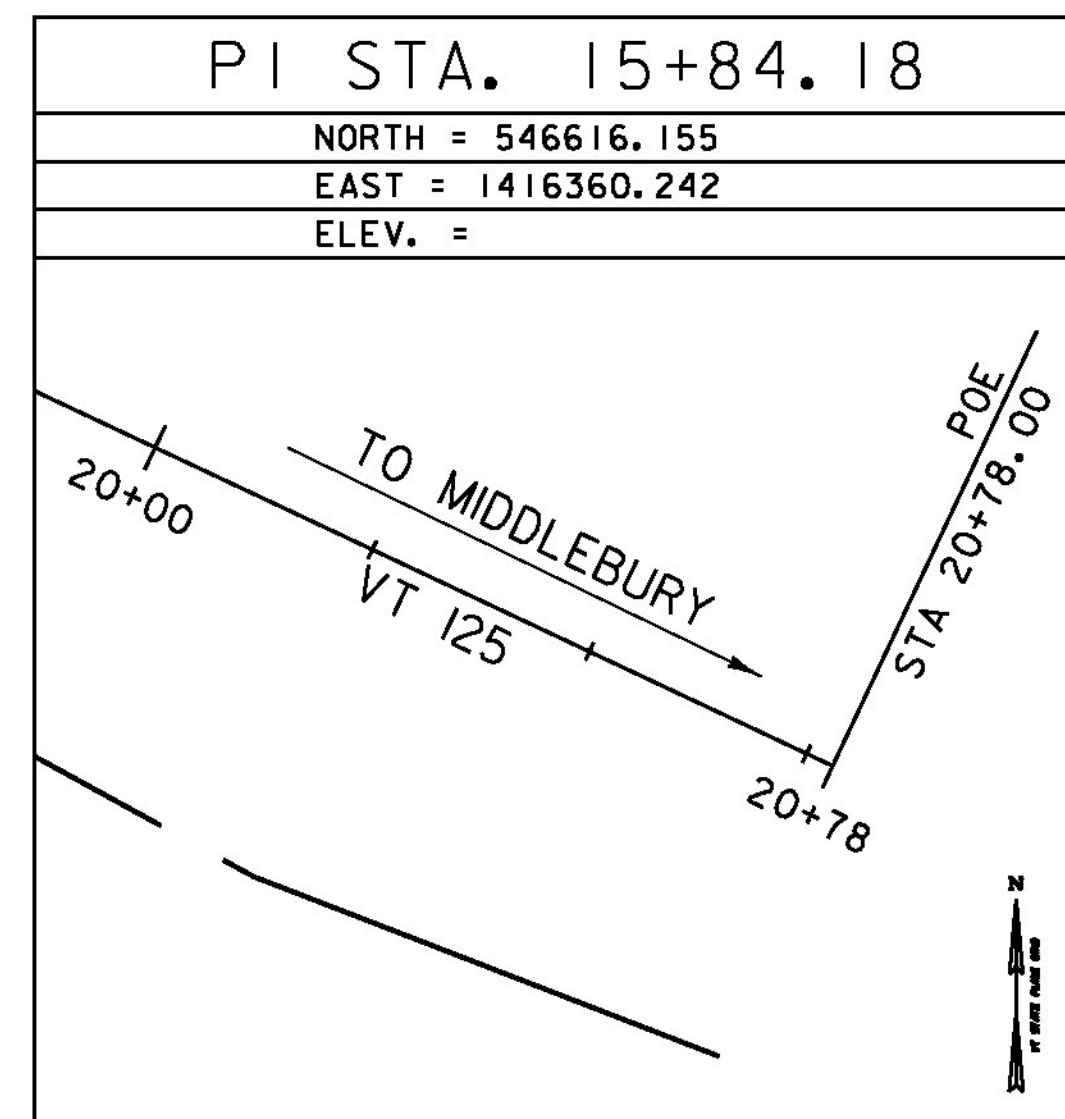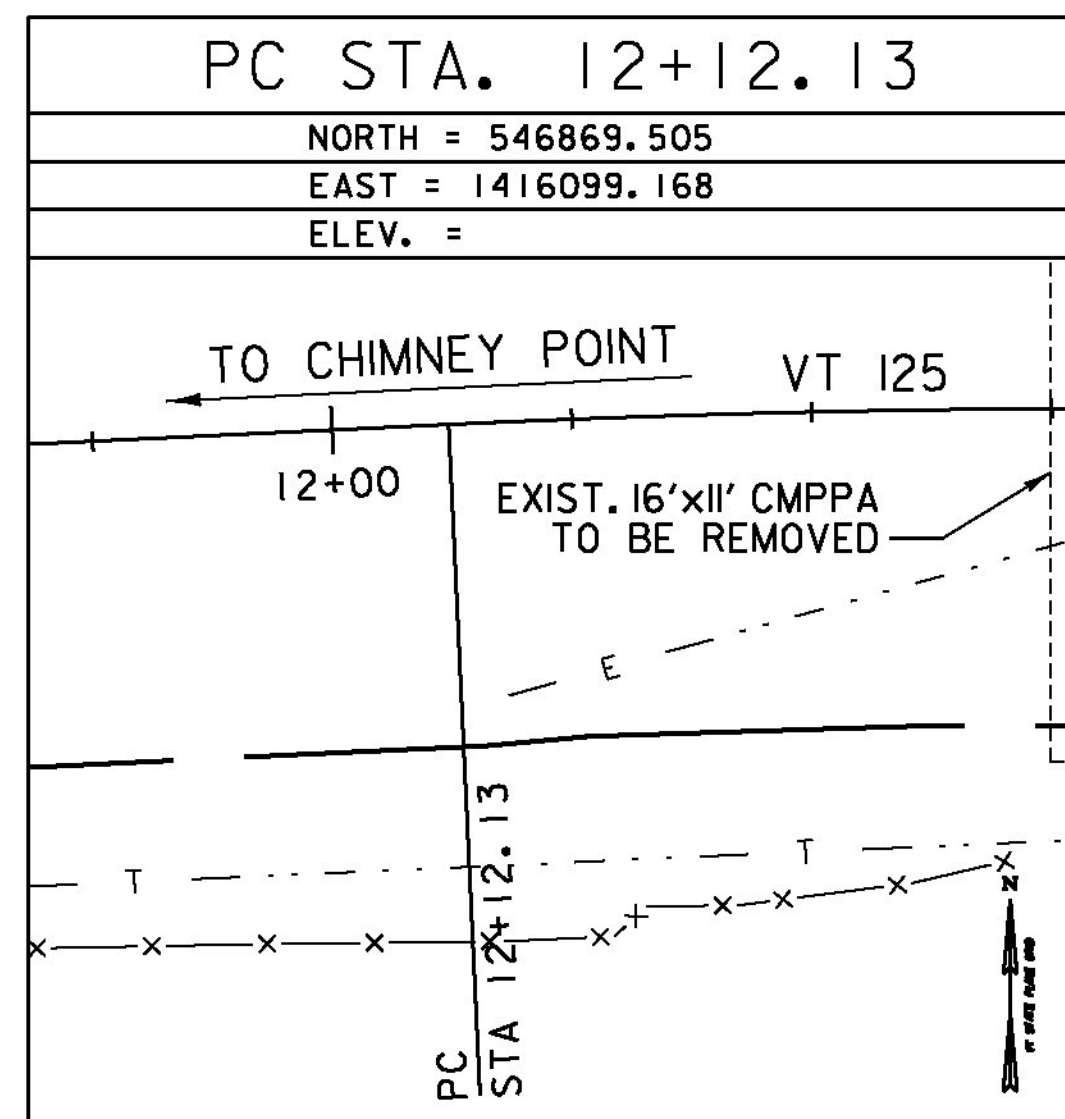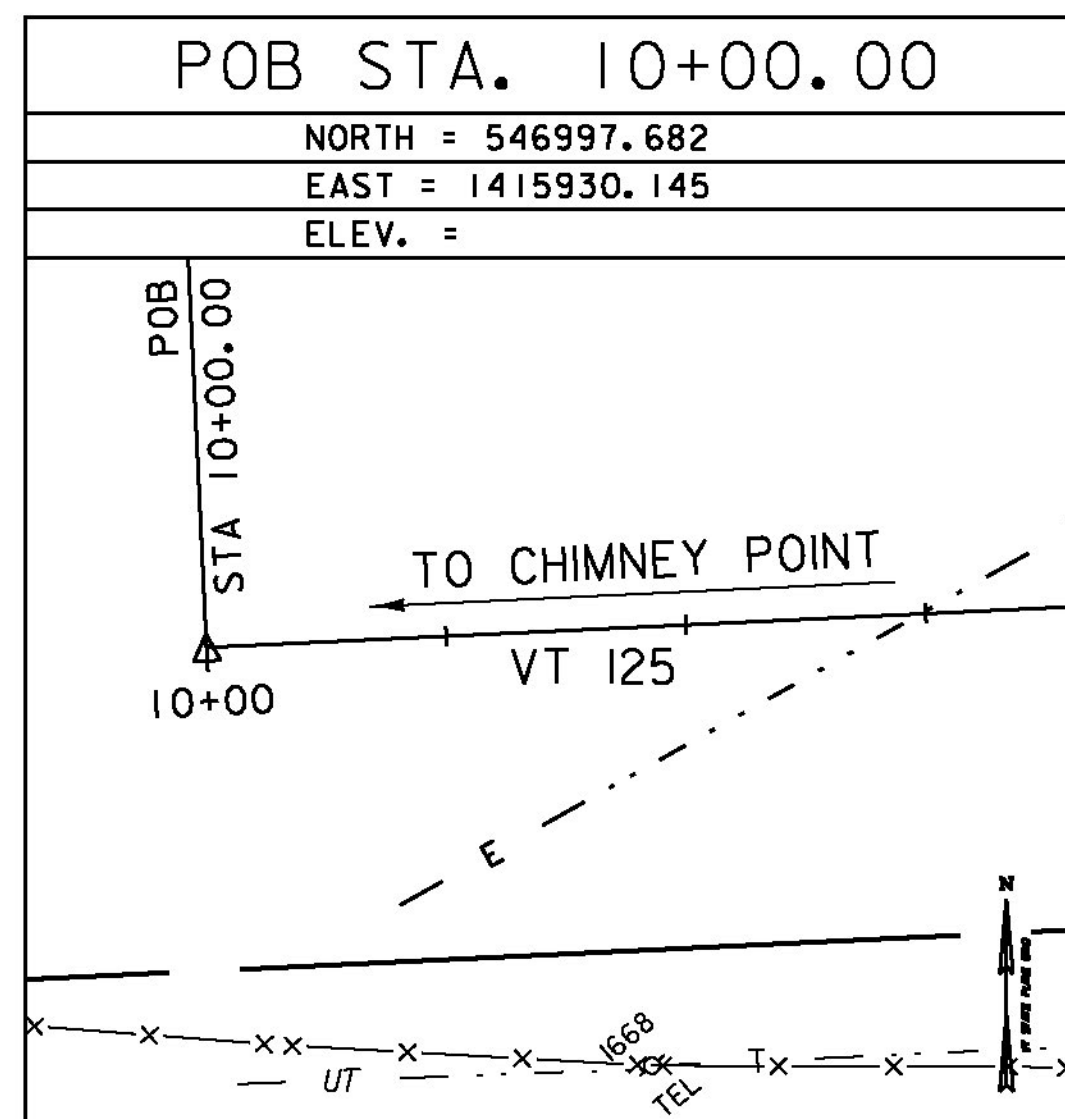

DATUM	
VERTICAL	NAVD 88
HORIZONTAL	NAD 83 (96)
ADJUSTMENT	COMPASS

PROJECT NAME: BRIDPORT  
 PROJECT NUMBER: STP CULV(29)



FILE NAME: zllc2641te_br2.dgn  
 PROJECT LEADER: M. CHENETTE  
 DESIGNED BY: J. HUNGERFORD  
 SURVEY CONTROL AND TIES - BR2

PLOT DATE: 8/22/2014  
 DRAWN BY: L. BUXTON  
 CHECKED BY: M. CHENETTE  
 SHEET 13 OF 57




- 621.205 - STEEL BEAM GUARDRAIL, GALVANIZED WITH 8 FEET POSTS  
STA. 10+62.70, RT. TO 14+01.00, RT.  
STA. 11+05.5, LT. TO 14+02.5, LT.
- 621.60 - ANCHOR FOR STEEL BEAM RAIL  
STA. 10+62.7, RT.  
STA. 11+05.5, LT.  
STA. 14+01.0, RT.  
STA. 14+02.5, LT.
- 621.80 - REMOVAL AND DISPOSAL OF GUARDRAIL  
STA 10+65.20 TO 13+92.53, RT.  
STA. 11+63.86 TO 13+61.58, LT.
- 620.55 - REMOVAL OF EXISTING FENCE  
STA 12+32.00 RT. TO 12+99.00, RT.

CURVE DATA  
 DELTA = 27° 51' 37.47"  
 D = 3° 49' 10.99"  
 R = 1500.00'  
 L = 729.38.00'

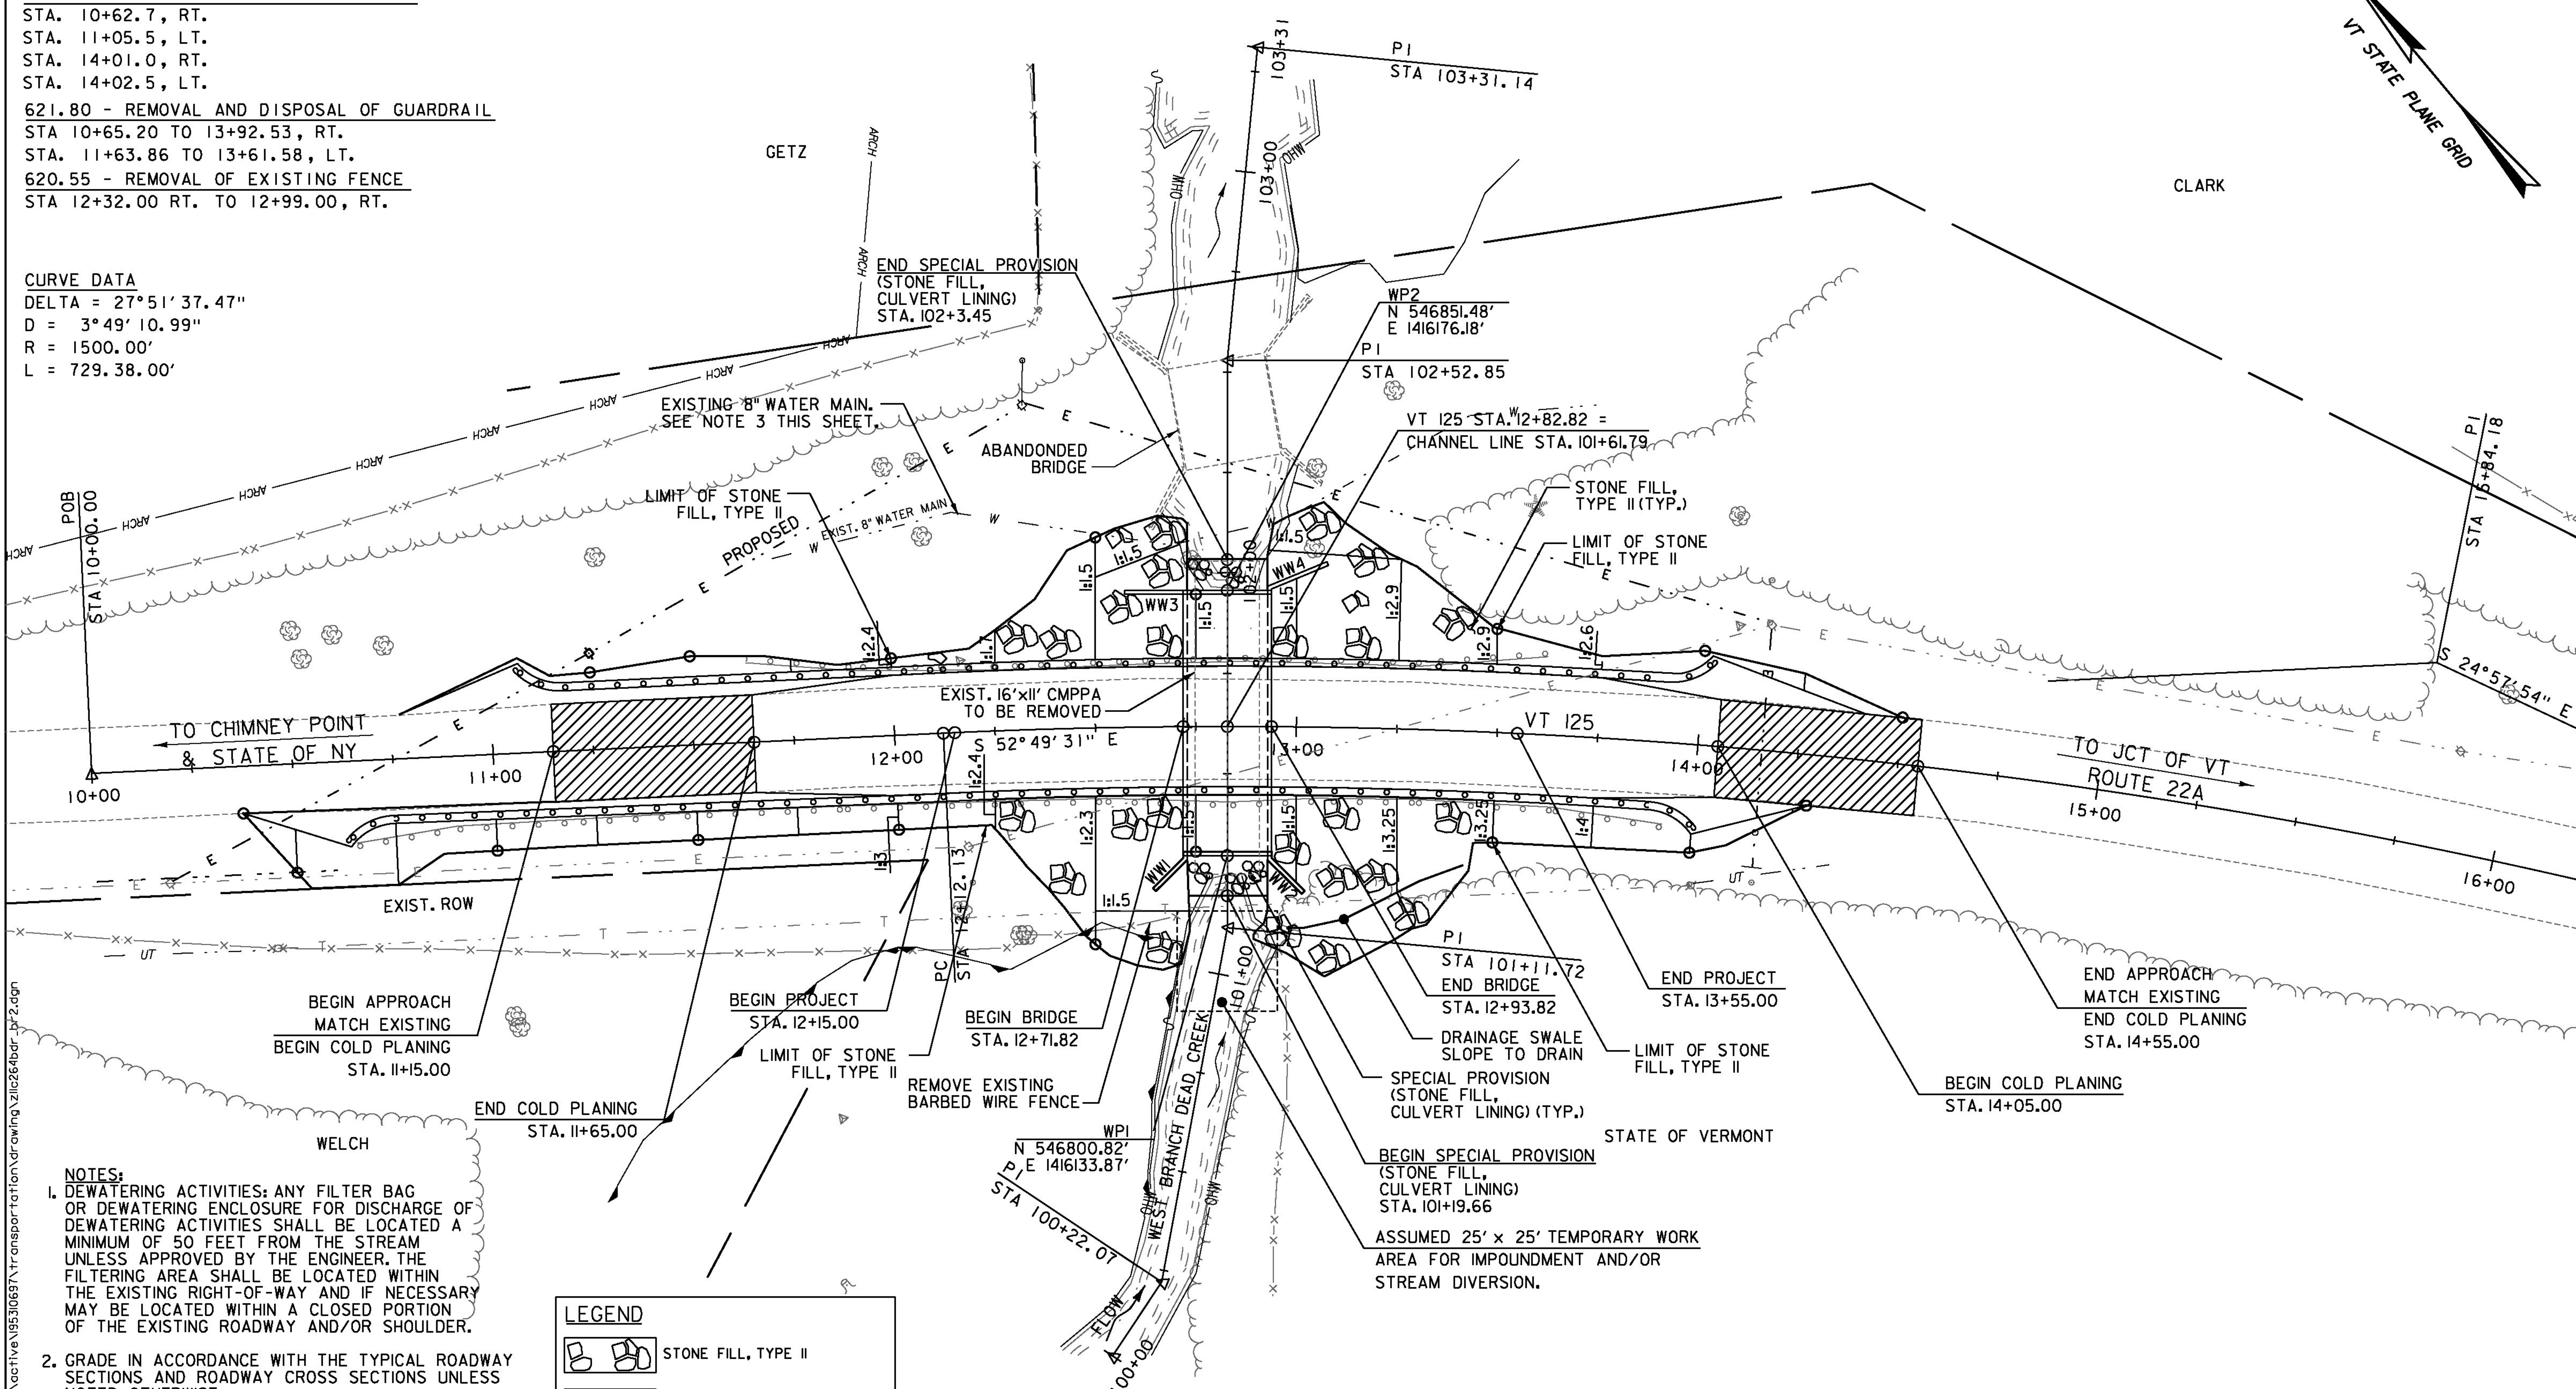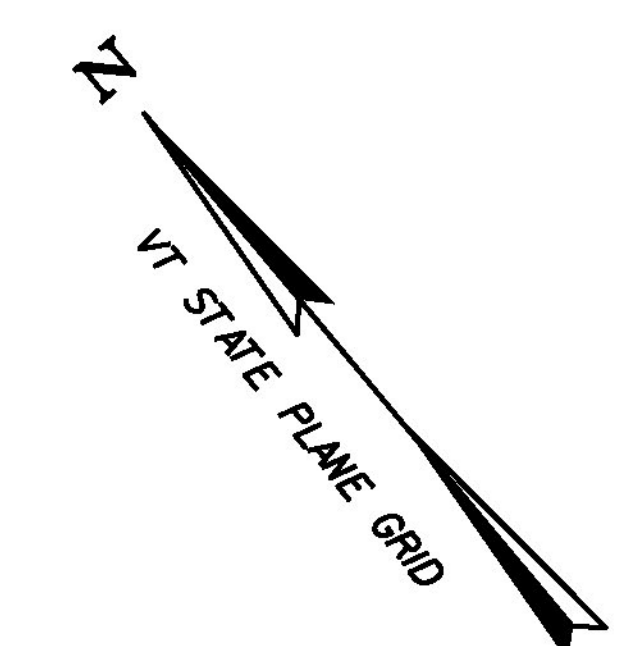


- NOTES:
- DEWATERING ACTIVITIES: ANY FILTER BAG OR DEWATERING ENCLOSURE FOR DISCHARGE OF DEWATERING ACTIVITIES SHALL BE LOCATED A MINIMUM OF 50 FEET FROM THE STREAM UNLESS APPROVED BY THE ENGINEER. THE FILTERING AREA SHALL BE LOCATED WITHIN THE EXISTING RIGHT-OF-WAY AND IF NECESSARY MAY BE LOCATED WITHIN A CLOSED PORTION OF THE EXISTING ROADWAY AND/OR SHOULDER.
  - GRADE IN ACCORDANCE WITH THE TYPICAL ROADWAY SECTIONS AND ROADWAY CROSS SECTIONS UNLESS NOTED OTHERWISE.
  - THE LOCATION OF UNDERGROUND UTILITIES SHOWN ON THE PLANS IS APPROXIMATE. THE CONTRACTOR SHALL PERFORM EXPLORATORY EXCAVATIONS TO VERIFY THE DEPTH AND LOCATIONS OF UNDERGROUND UTILITIES, AS DIRECTED BY THE ENGINEER. THE EXPLORATORY WORK SHALL BE PAID FOR UNDER ITEM 204.22 TRENCH EXCAVATION OF EARTH, EXPLORATORY.

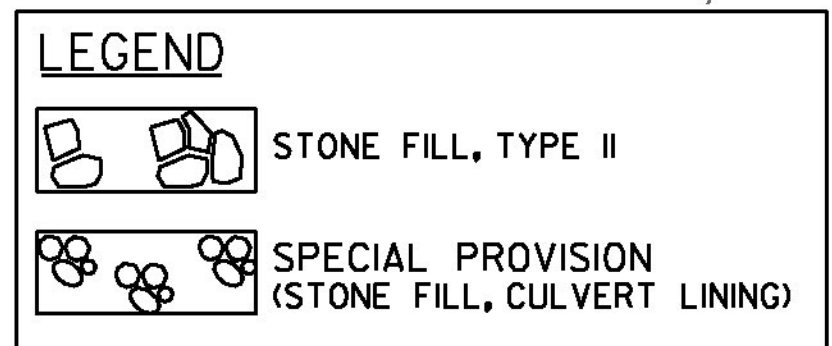

PLAN  
 SCALE: 1" = 20'-0"  
 0 20 40

PROJECT NAME:	BRIDPORT	PLOT DATE:	8/22/2014
PROJECT NUMBER:	STP CULV(29)	DRAWN BY:	L. BUXTON
FILE NAME:	zllc264bdr_br2.dgn	DESIGNED BY:	J. HUNGERFORD
PROJECT LEADER:	M. CHENETTE	CHECKED BY:	M. CHENETTE
PLAN LAYOUT SHEET - BR2		SHEET	14 OF 57




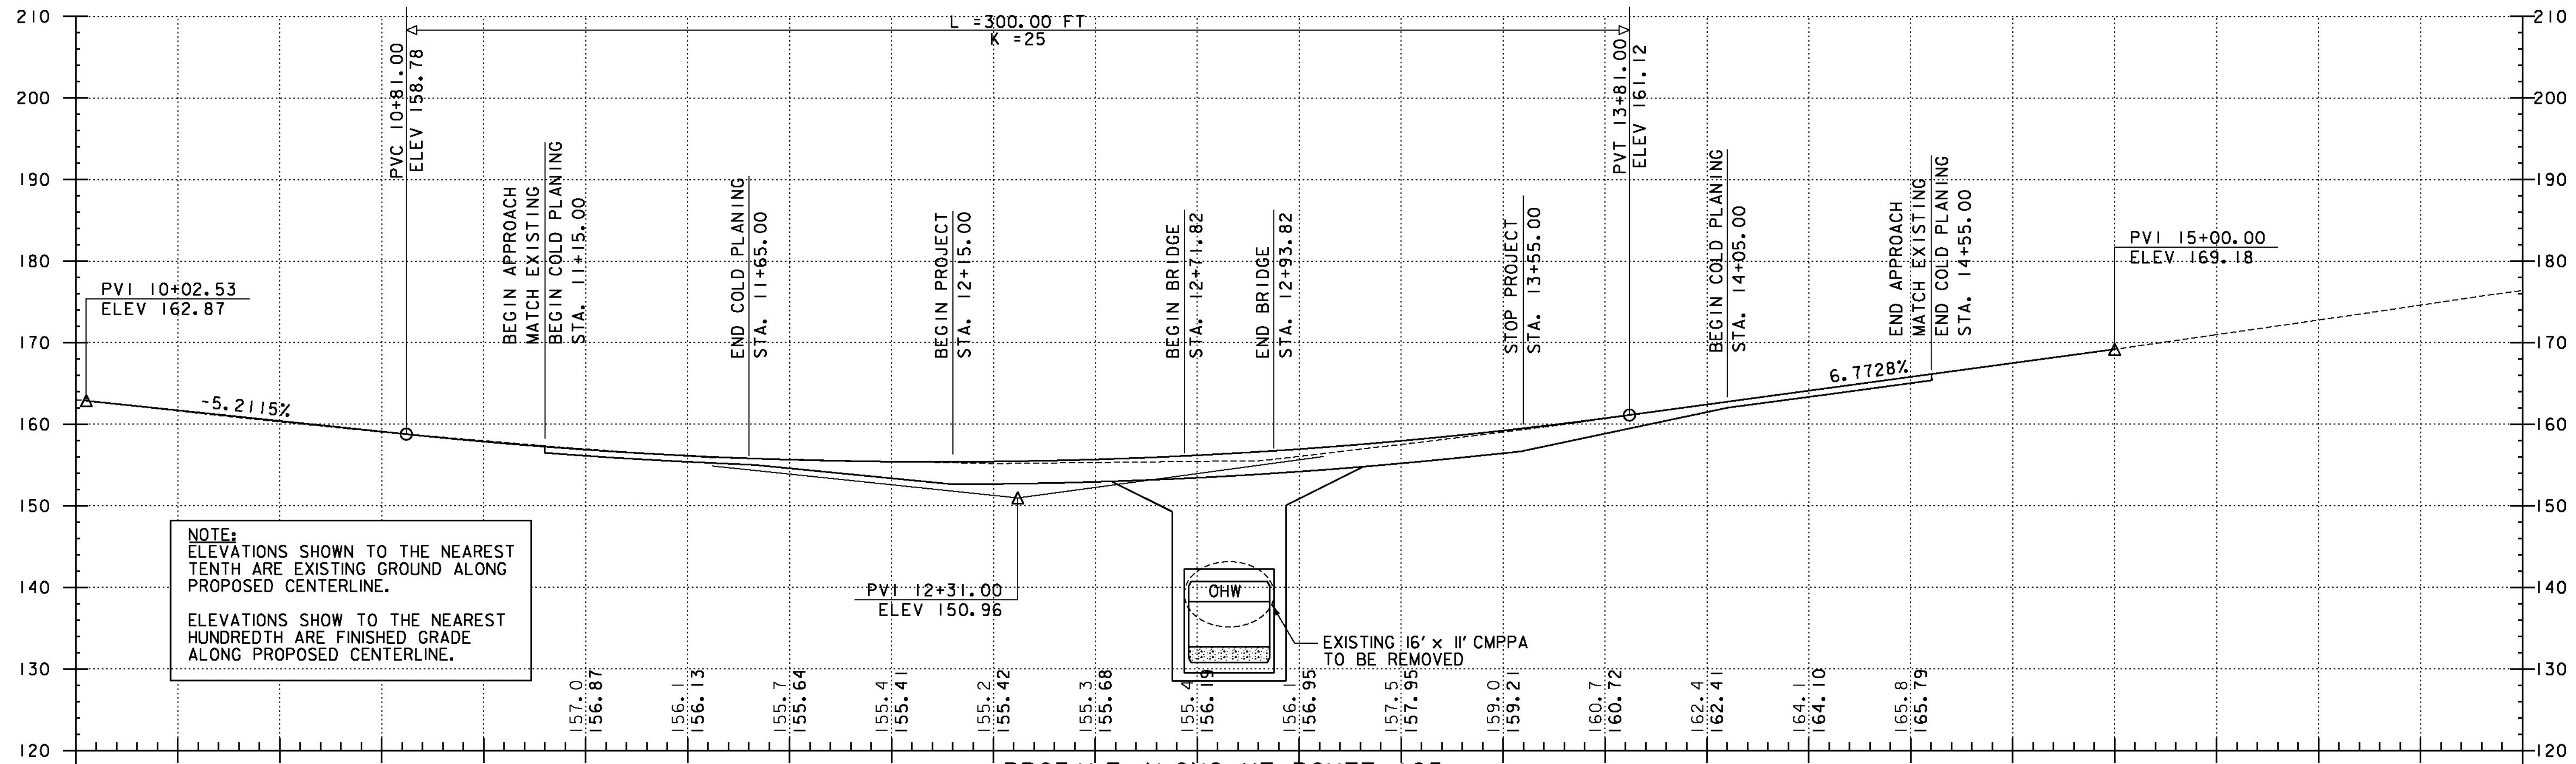

NOTE:  
 ELEVATIONS SHOWN TO THE NEAREST TENTH ARE EXISTING GROUND ALONG PROPOSED CENTERLINE.  
 ELEVATIONS SHOW TO THE NEAREST HUNDREDTH ARE FINISHED GRADE ALONG PROPOSED CENTERLINE.

PROFILE ALONG VT ROUTE 125

HORIZONTAL SCALE: 1" = 20' VERTICAL SCALE: 1" = 10'

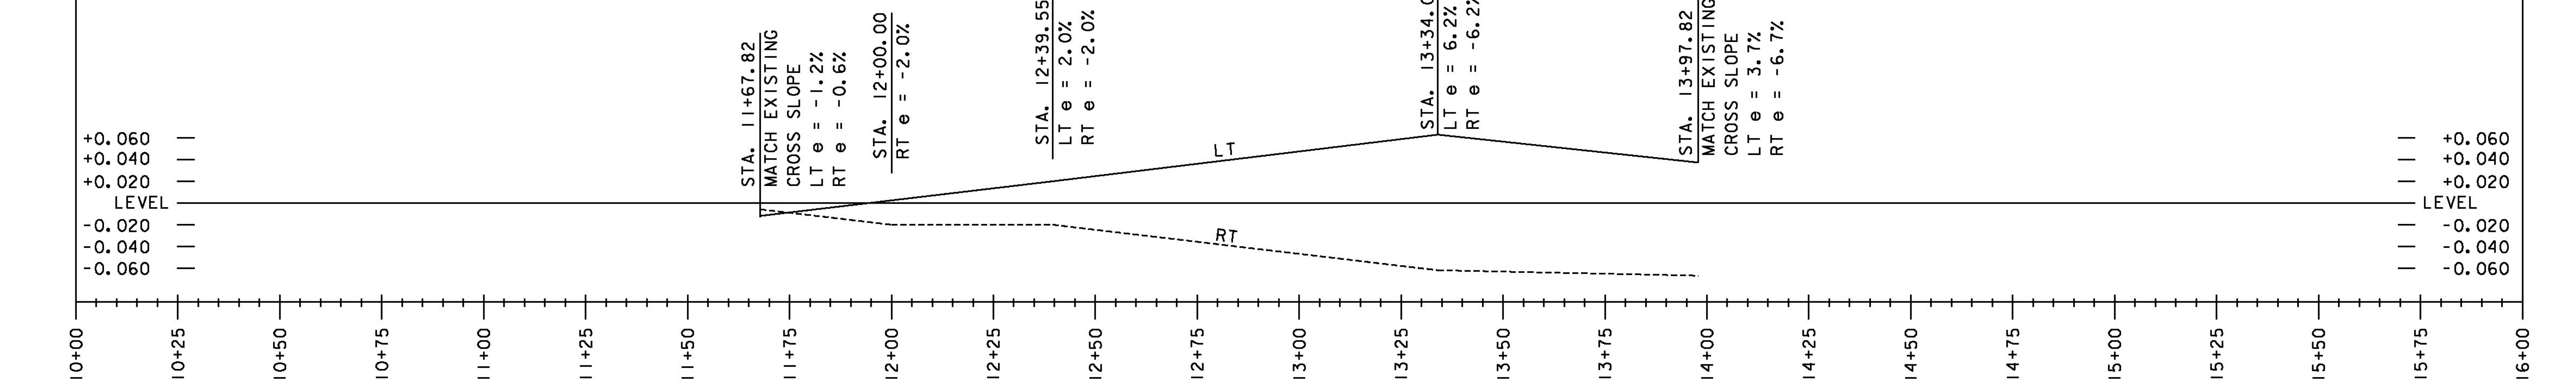


BANKING DIAGRAM

HORIZONTAL SCALE: 1" = 20' VERTICAL SCALE: N. T. S.


NOTE:  
 STATIONING IN FEET AND SUPERELEVATIONS IN PERCENTAGES

PROJECT NAME: BRIDPORT	FILE NAME: zllc264pro.dgn	PLOT DATE: 8/22/2014
PROJECT NUMBER: STP CULV(29)	PROJECT LEADER: M. CHENETTE	DRAWN BY: L. BUXTON
	DESIGNED BY: J. HUNGERFORD	CHECKED BY: M. CHENETTE
	ROADWAY PROFILE - BR2	SHEET 15 OF 57



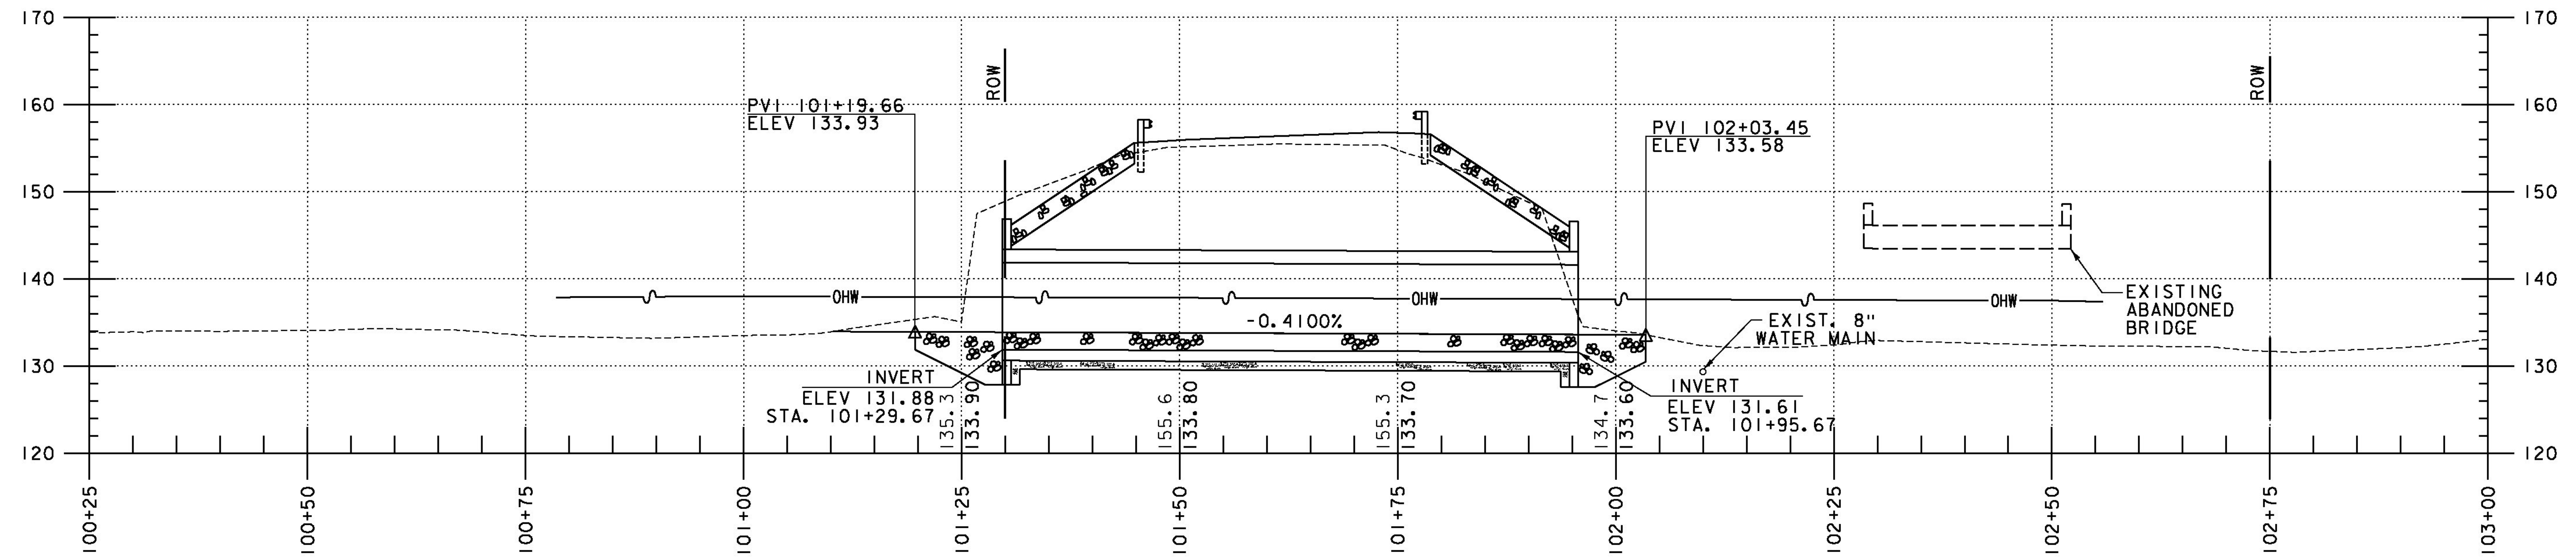


STREAM PROFILE

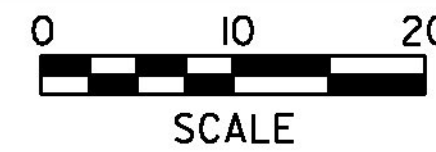

NOTE:  
ELEVATIONS SHOWN TO THE NEAREST TENTH ARE EXISTING GROUND ALONG PROPOSED CENTERLINE.

ELEVATIONS SHOW TO THE NEAREST HUNDREDTH ARE FINISHED GRADE ALONG PROPOSED CENTERLINE.

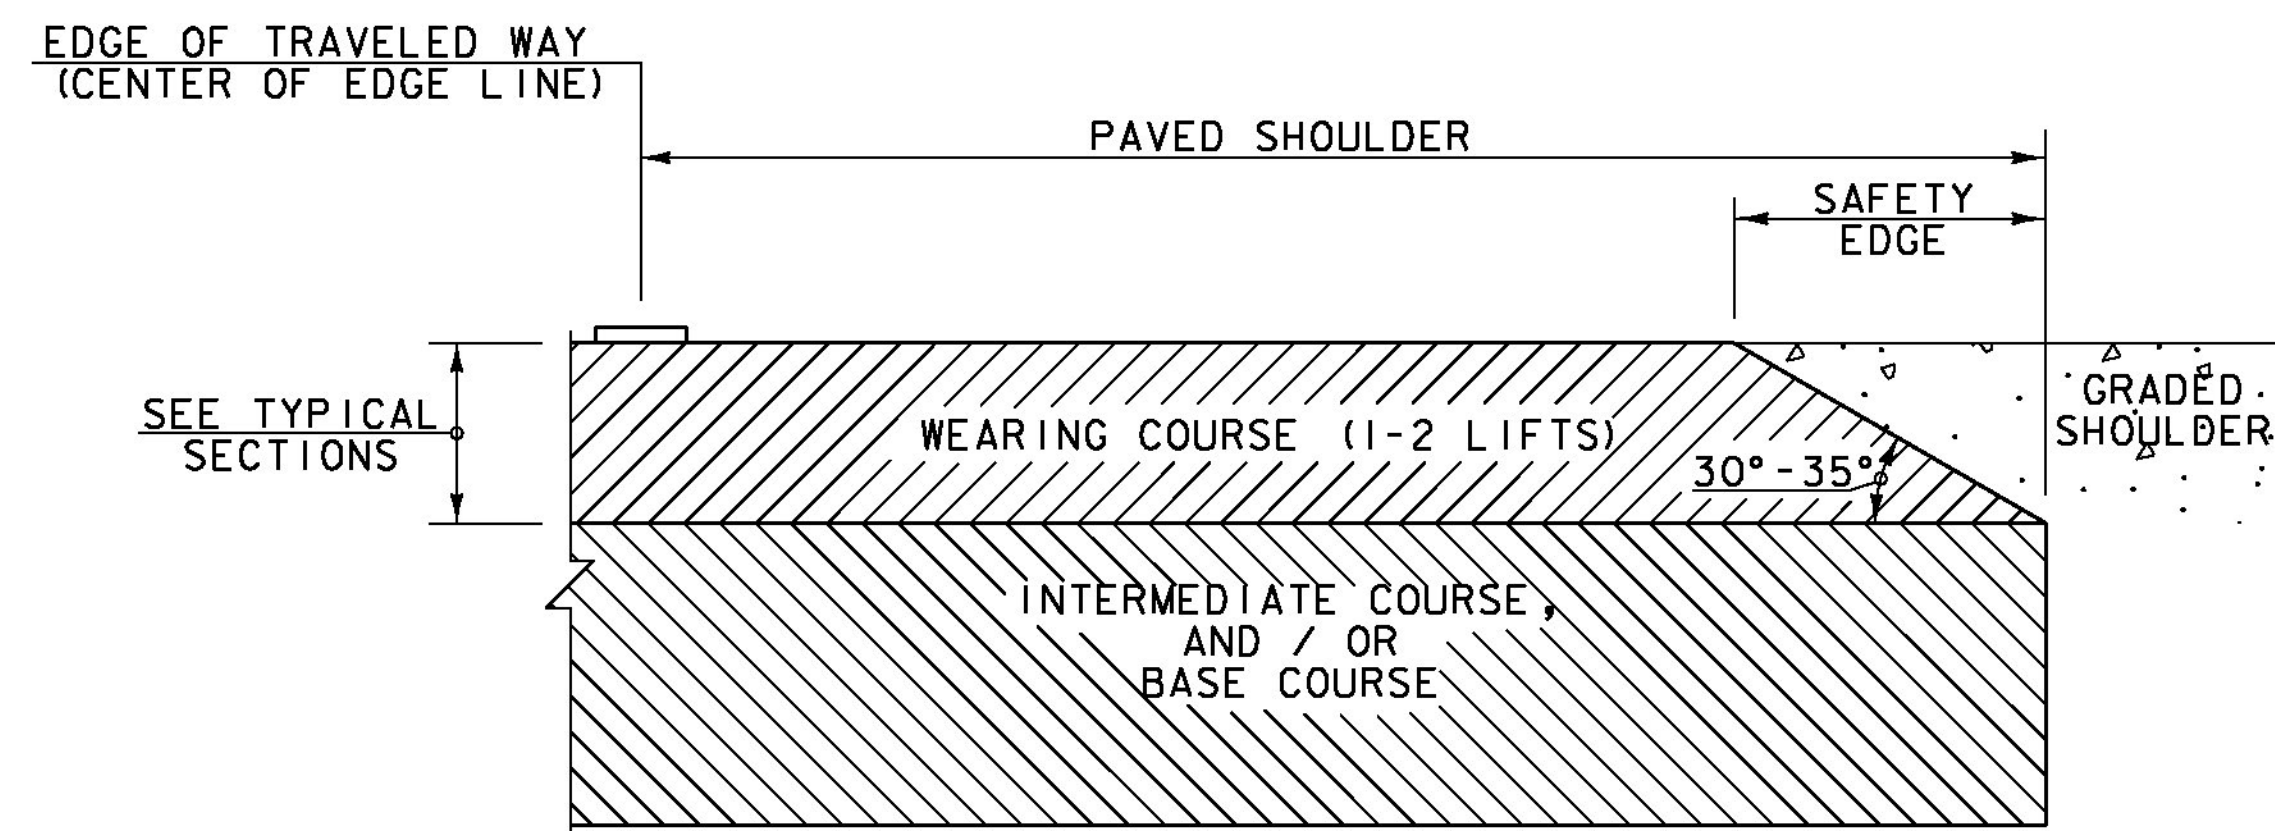


SAFETY EDGE DETAIL

NOT TO SCALE

NOTES:

1. THE EDGE OF PAVEMENT SHALL BE FORMED IN SUCH A WAY THAT THE BITUMINOUS CONCRETE PAVEMENT IS EXTRUDED OR COMPRESSED TO FORM THE 30 TO 35 DEGREE ANGLE. DEVICES THAT SIMPLY STRIKE-OFF THE MIX WITHOUT PROVIDING ANY COMPACTIVE EFFORT WILL NOT BE ALLOWED.
2. THE PAVED SHOULDER EXTENDS FROM THE EDGE OF TRAVELED WAY TO THE EDGE OF THE WEARING COURSE, INCLUDING THE "SAFETY EDGE".

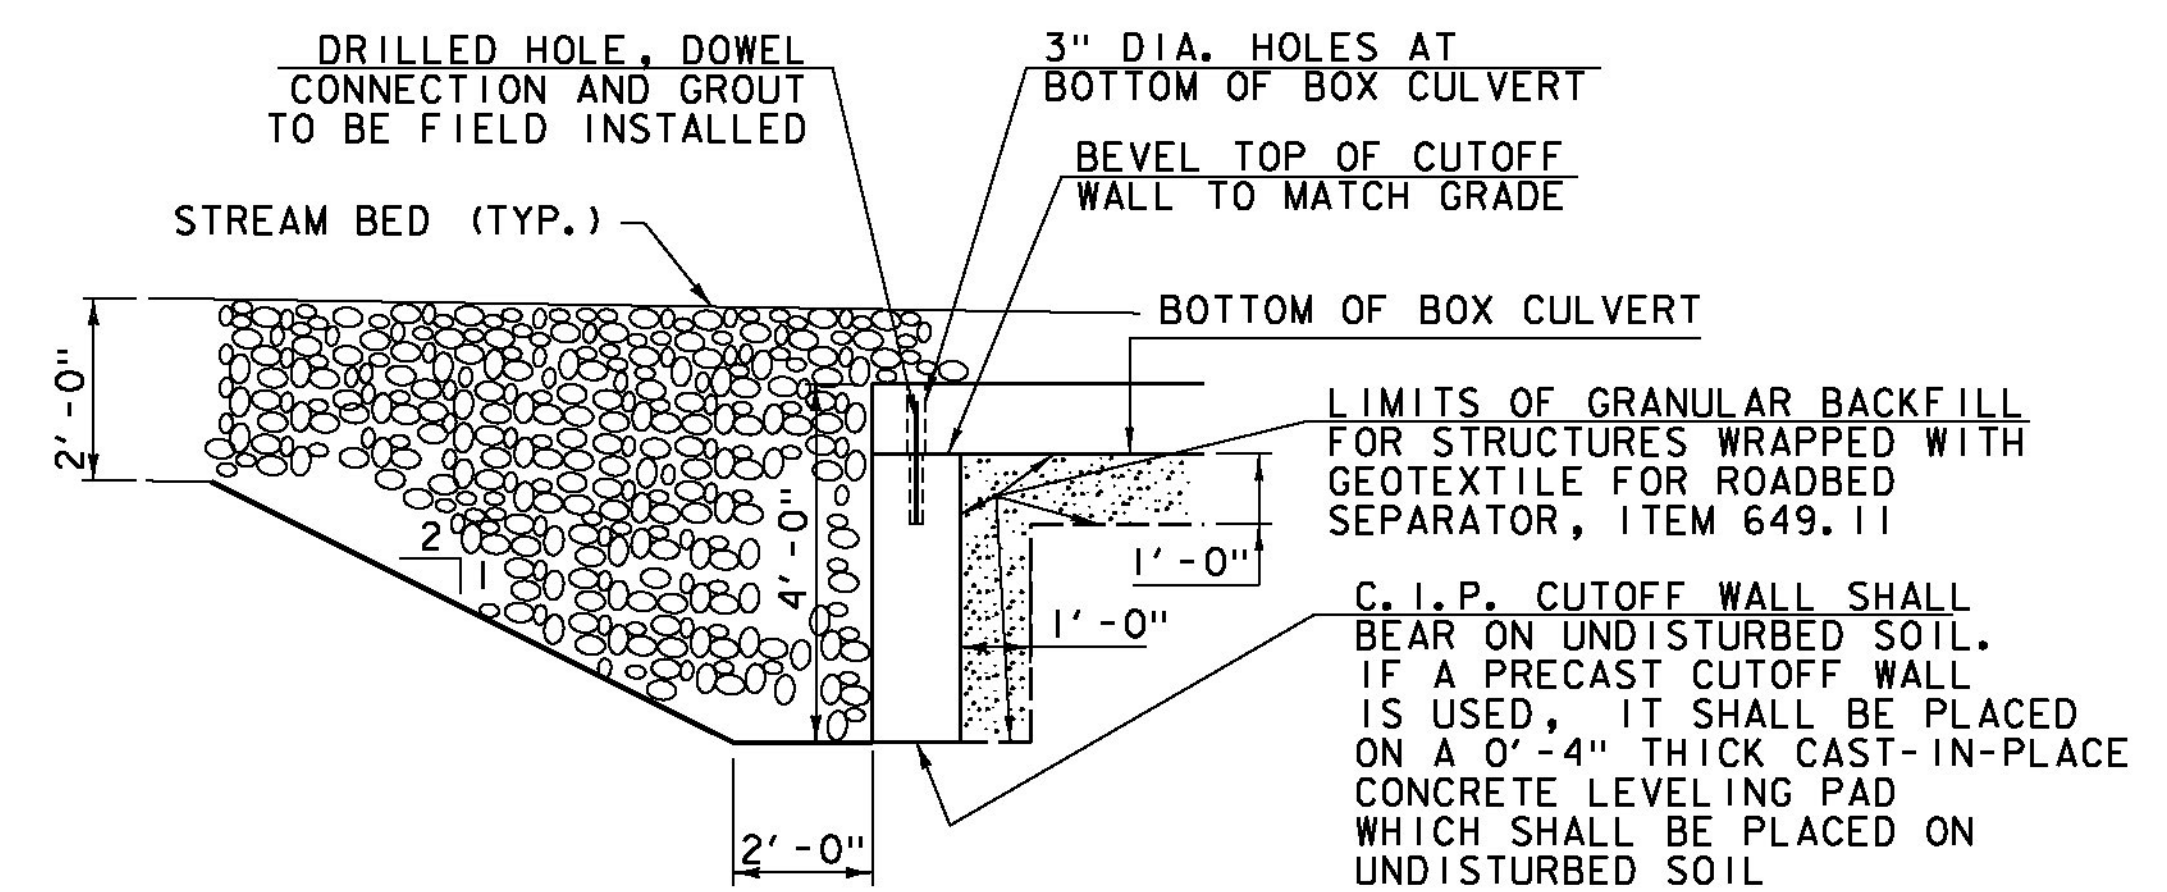

CUTOFF WALL DETAIL


NOT TO SCALE

PROJECT NAME: BRIDPORT  
PROJECT NUMBER: STP CULV(29)

FILE NAME: zllc264xs_br2.dgn  
PROJECT LEADER: M. CHENETTE  
DESIGNED BY: J. HUNGERFORD  
STREAM PROFILE - BR2

PLOT DATE: 8/22/2014  
DRAWN BY: L. BUXTON  
CHECKED BY: M. CHENETTE  
SHEET 16 OF 57






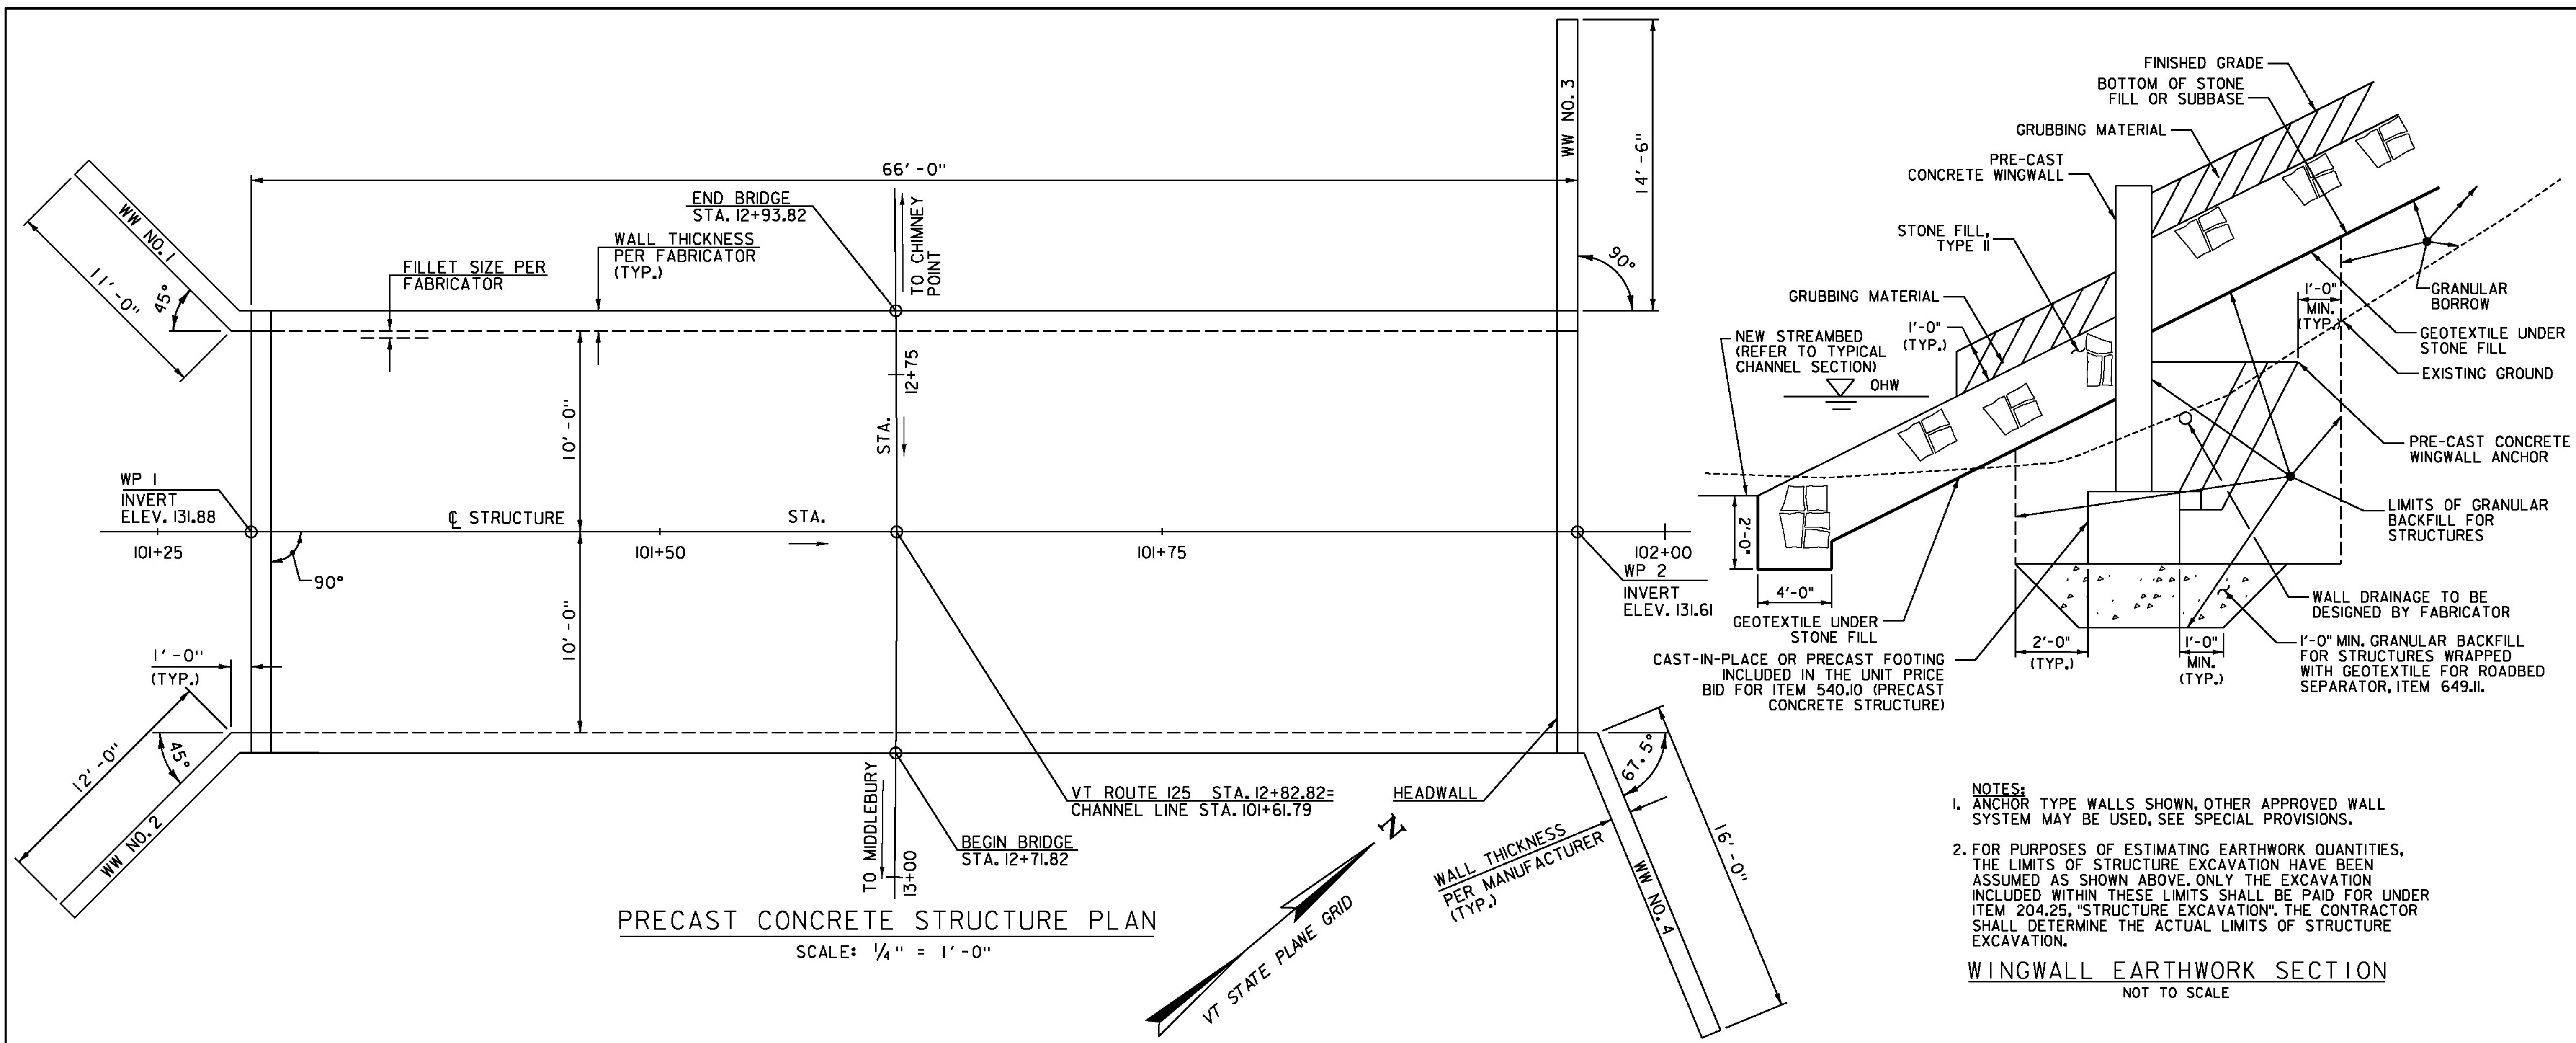

PRECAST CONCRETE STRUCTURE PLAN  
SCALE: 1/4" = 1'-0"



NOTES:  
 1. ANCHOR TYPE WALLS SHOWN, OTHER APPROVED WALL SYSTEM MAY BE USED, SEE SPECIAL PROVISIONS.  
 2. FOR PURPOSES OF ESTIMATING EARTHWORK QUANTITIES, THE LIMITS OF STRUCTURE EXCAVATION HAVE BEEN ASSUMED AS SHOWN ABOVE. ONLY THE EXCAVATION INCLUDED WITHIN THESE LIMITS SHALL BE PAID FOR UNDER ITEM 204.25, "STRUCTURE EXCAVATION". THE CONTRACTOR SHALL DETERMINE THE ACTUAL LIMITS OF STRUCTURE EXCAVATION.

WINGWALL EARTHWORK SECTION  
NOT TO SCALE

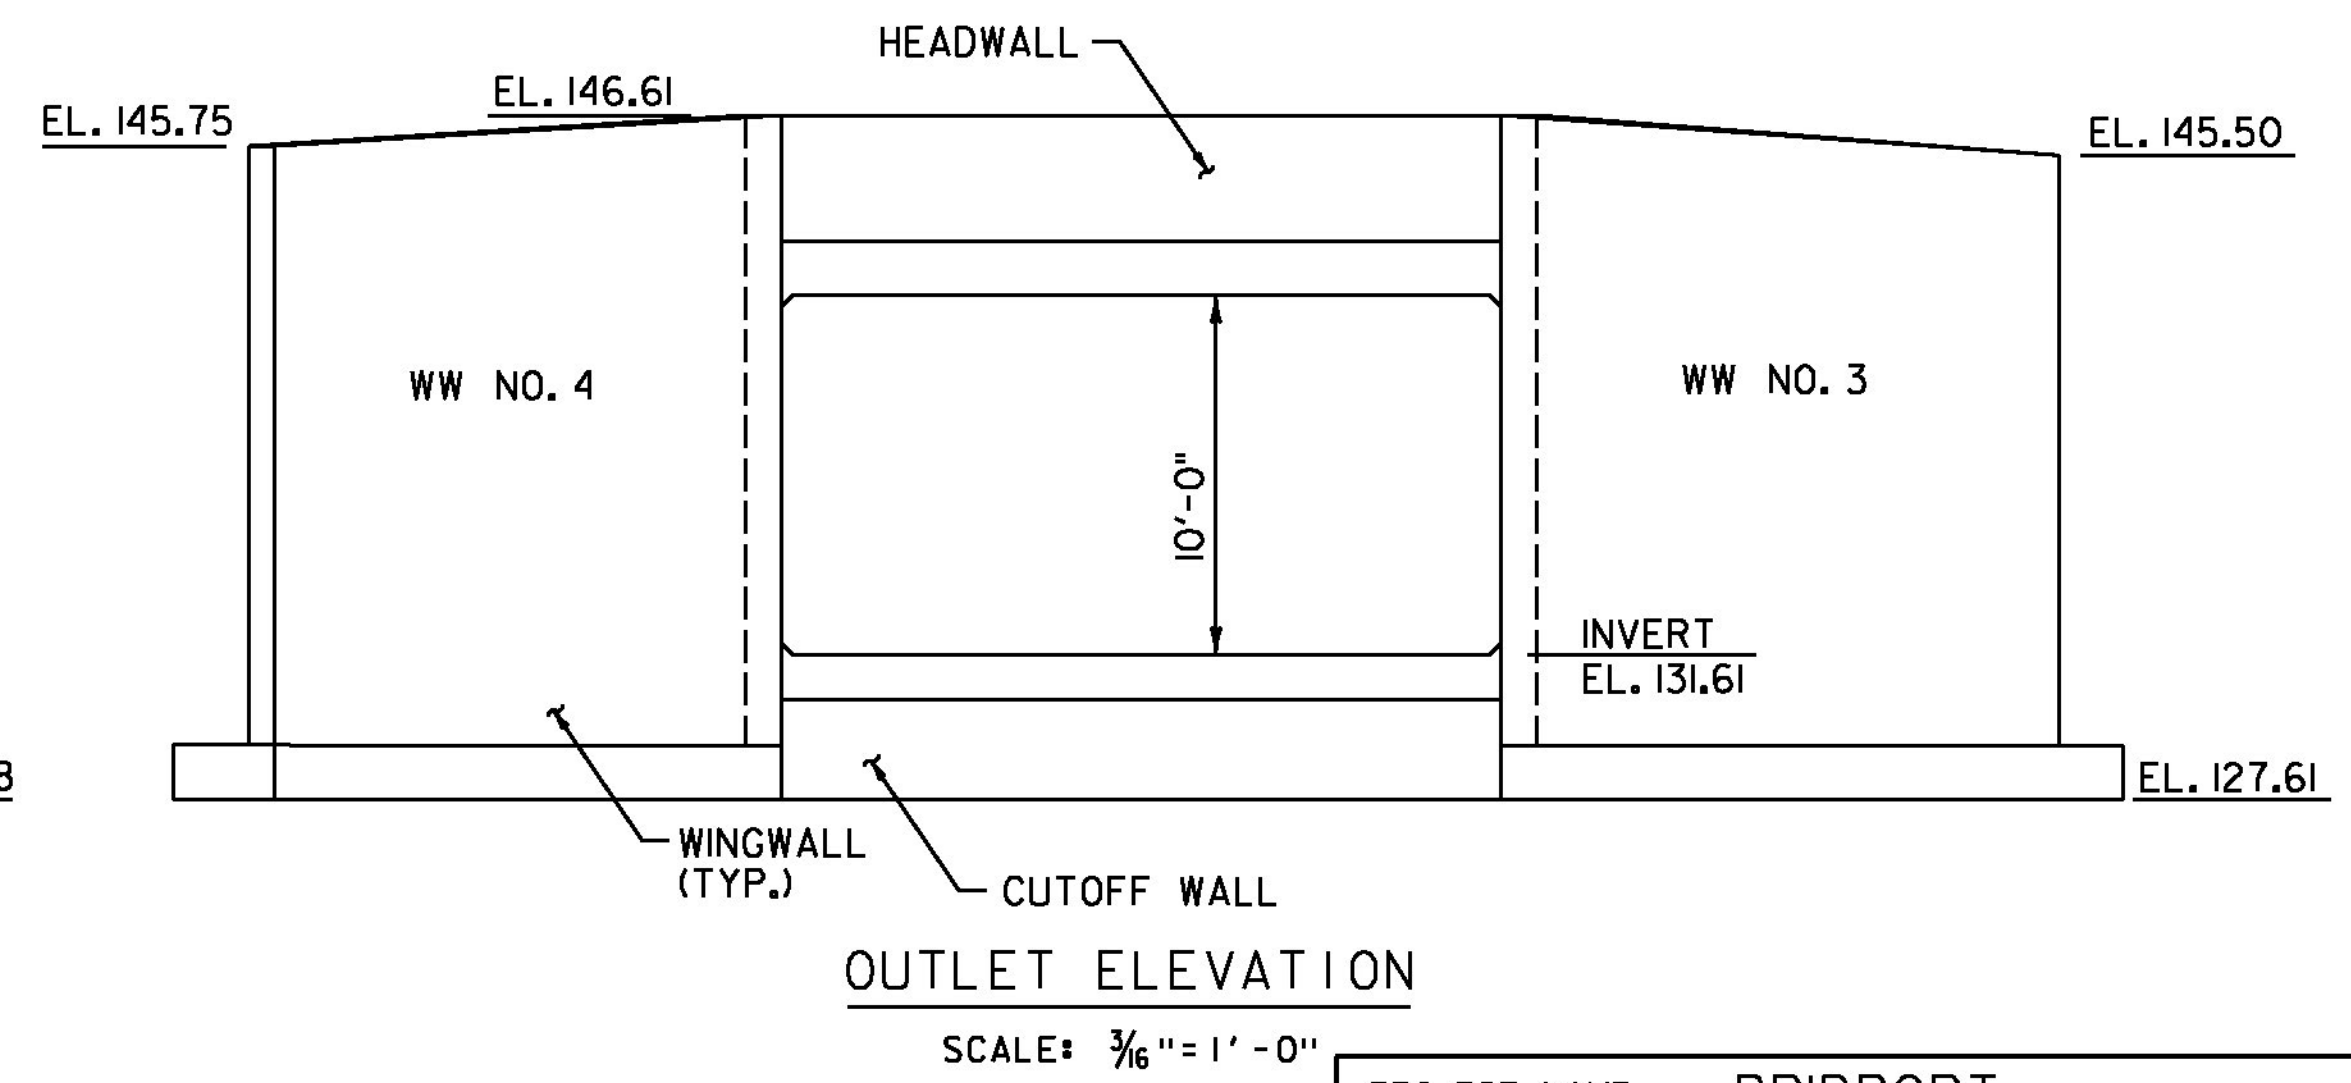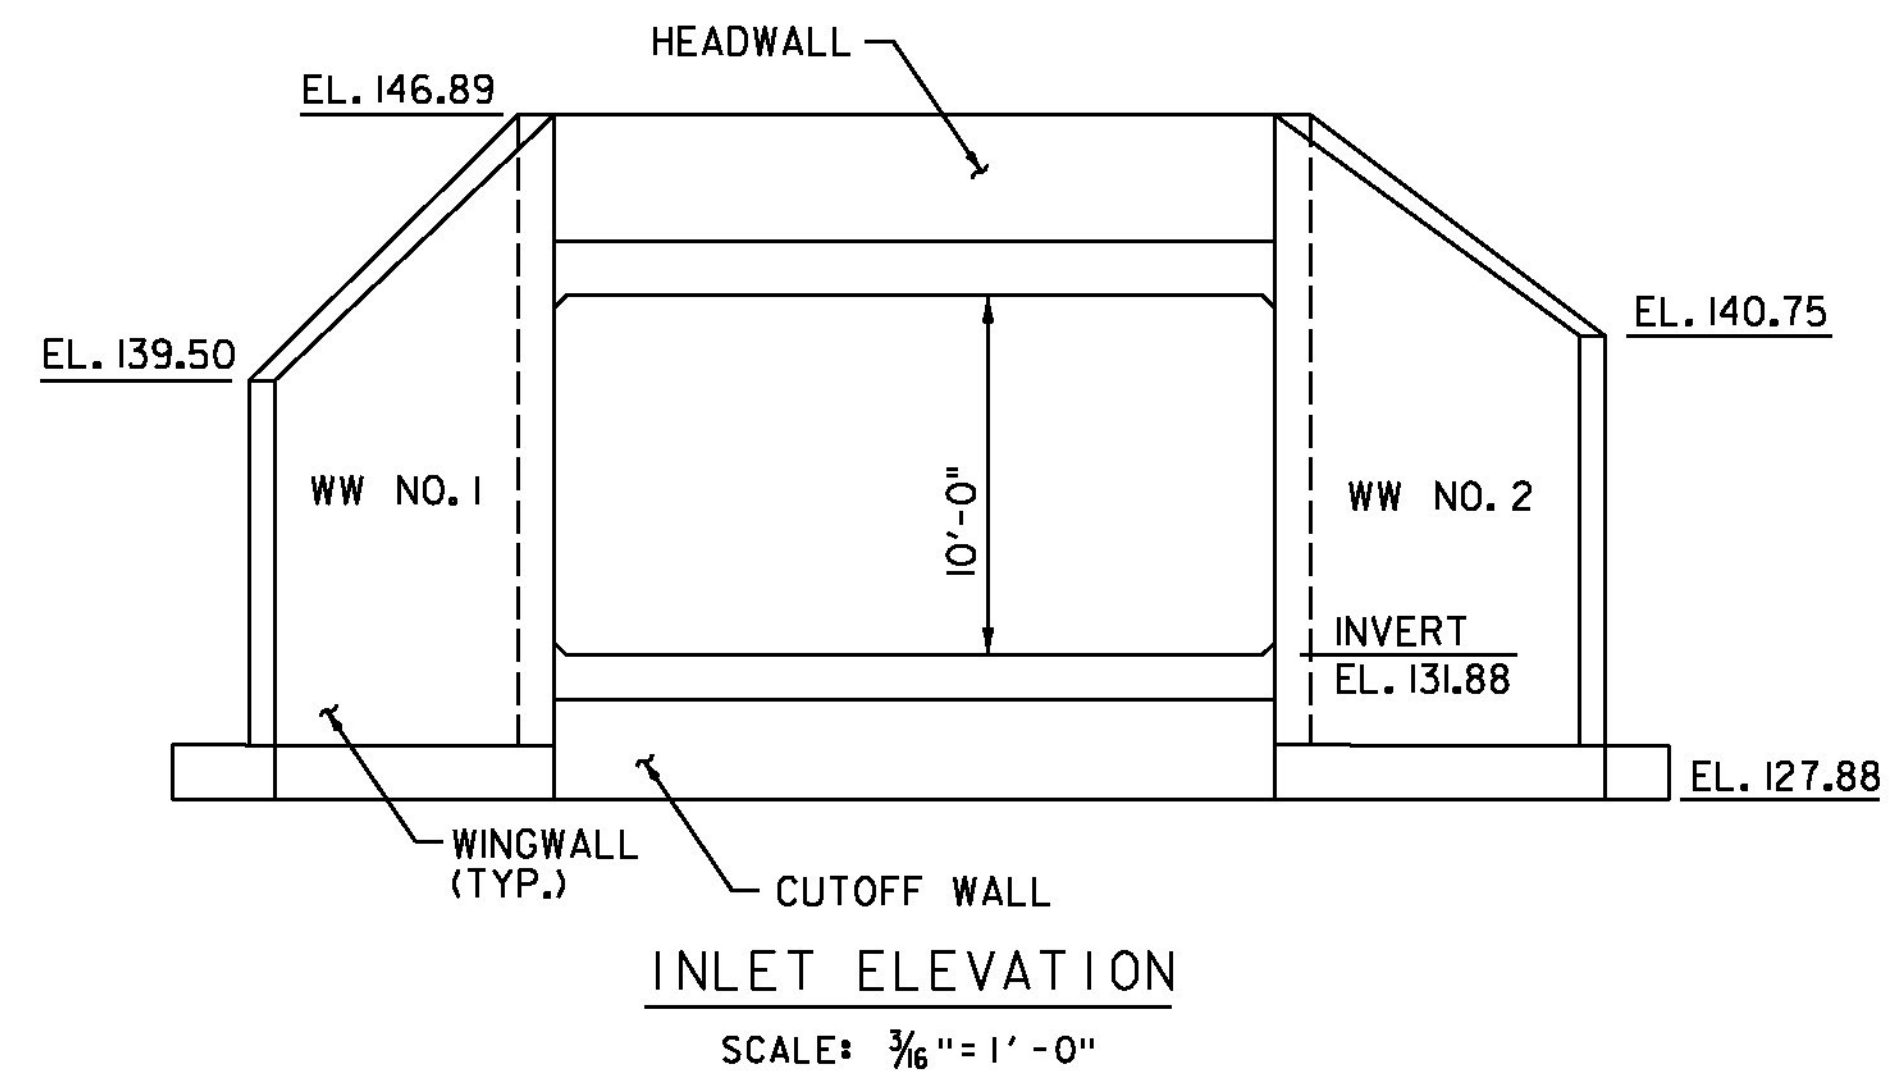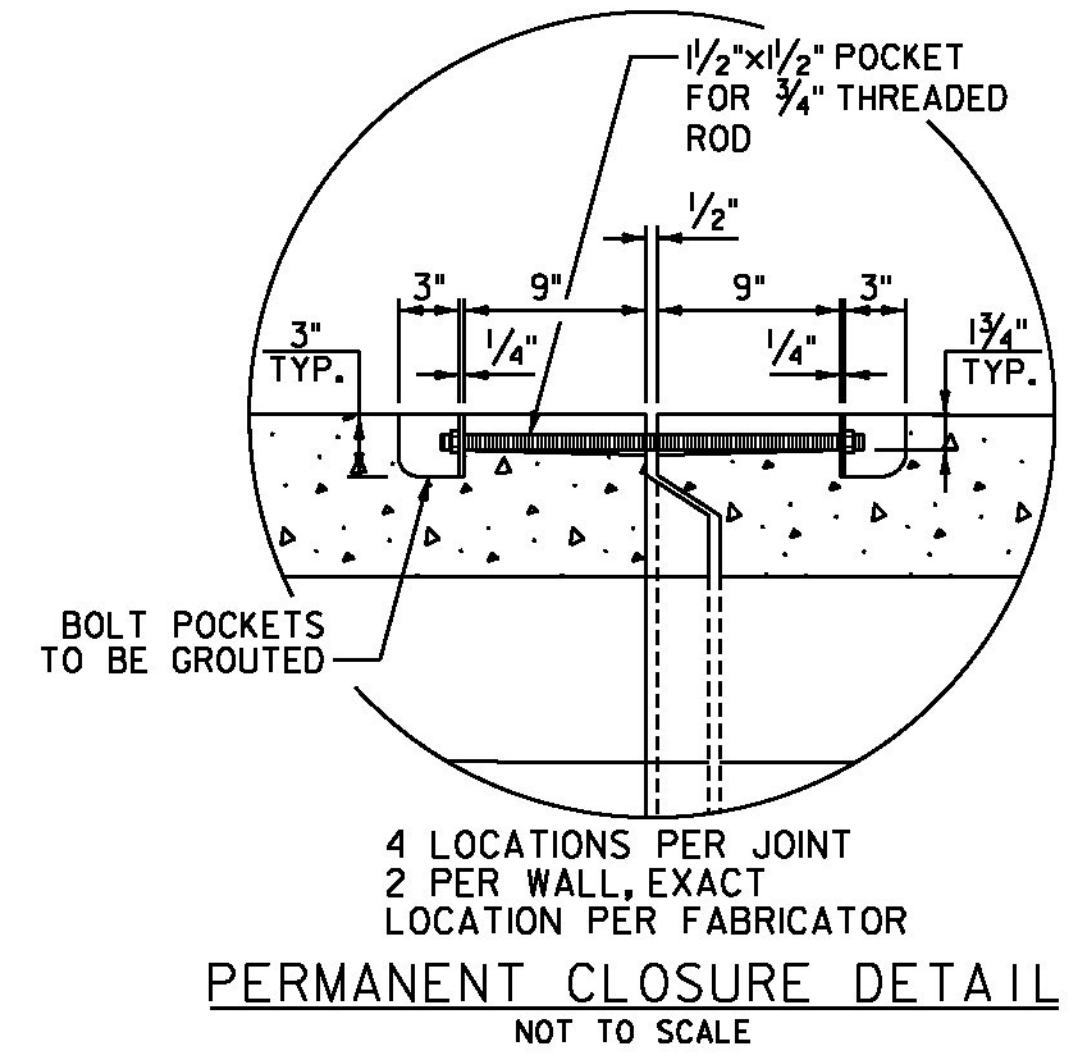

PROJECT NAME:	BRIDPORT
PROJECT NUMBER:	STP CULV(29)
FILE NAME:	zllc264strpl.br2.dgn
PROJECT LEADER:	M. CHENETTE
DESIGNED BY:	J. HUNGERFORD
STRUCTURAL PLAN AND DETAILS - BR2	
PLOT DATE:	8/22/2014
DRAWN BY:	L. BUXTON
CHECKED BY:	M. CHENETTE
SHEET	17 OF 57



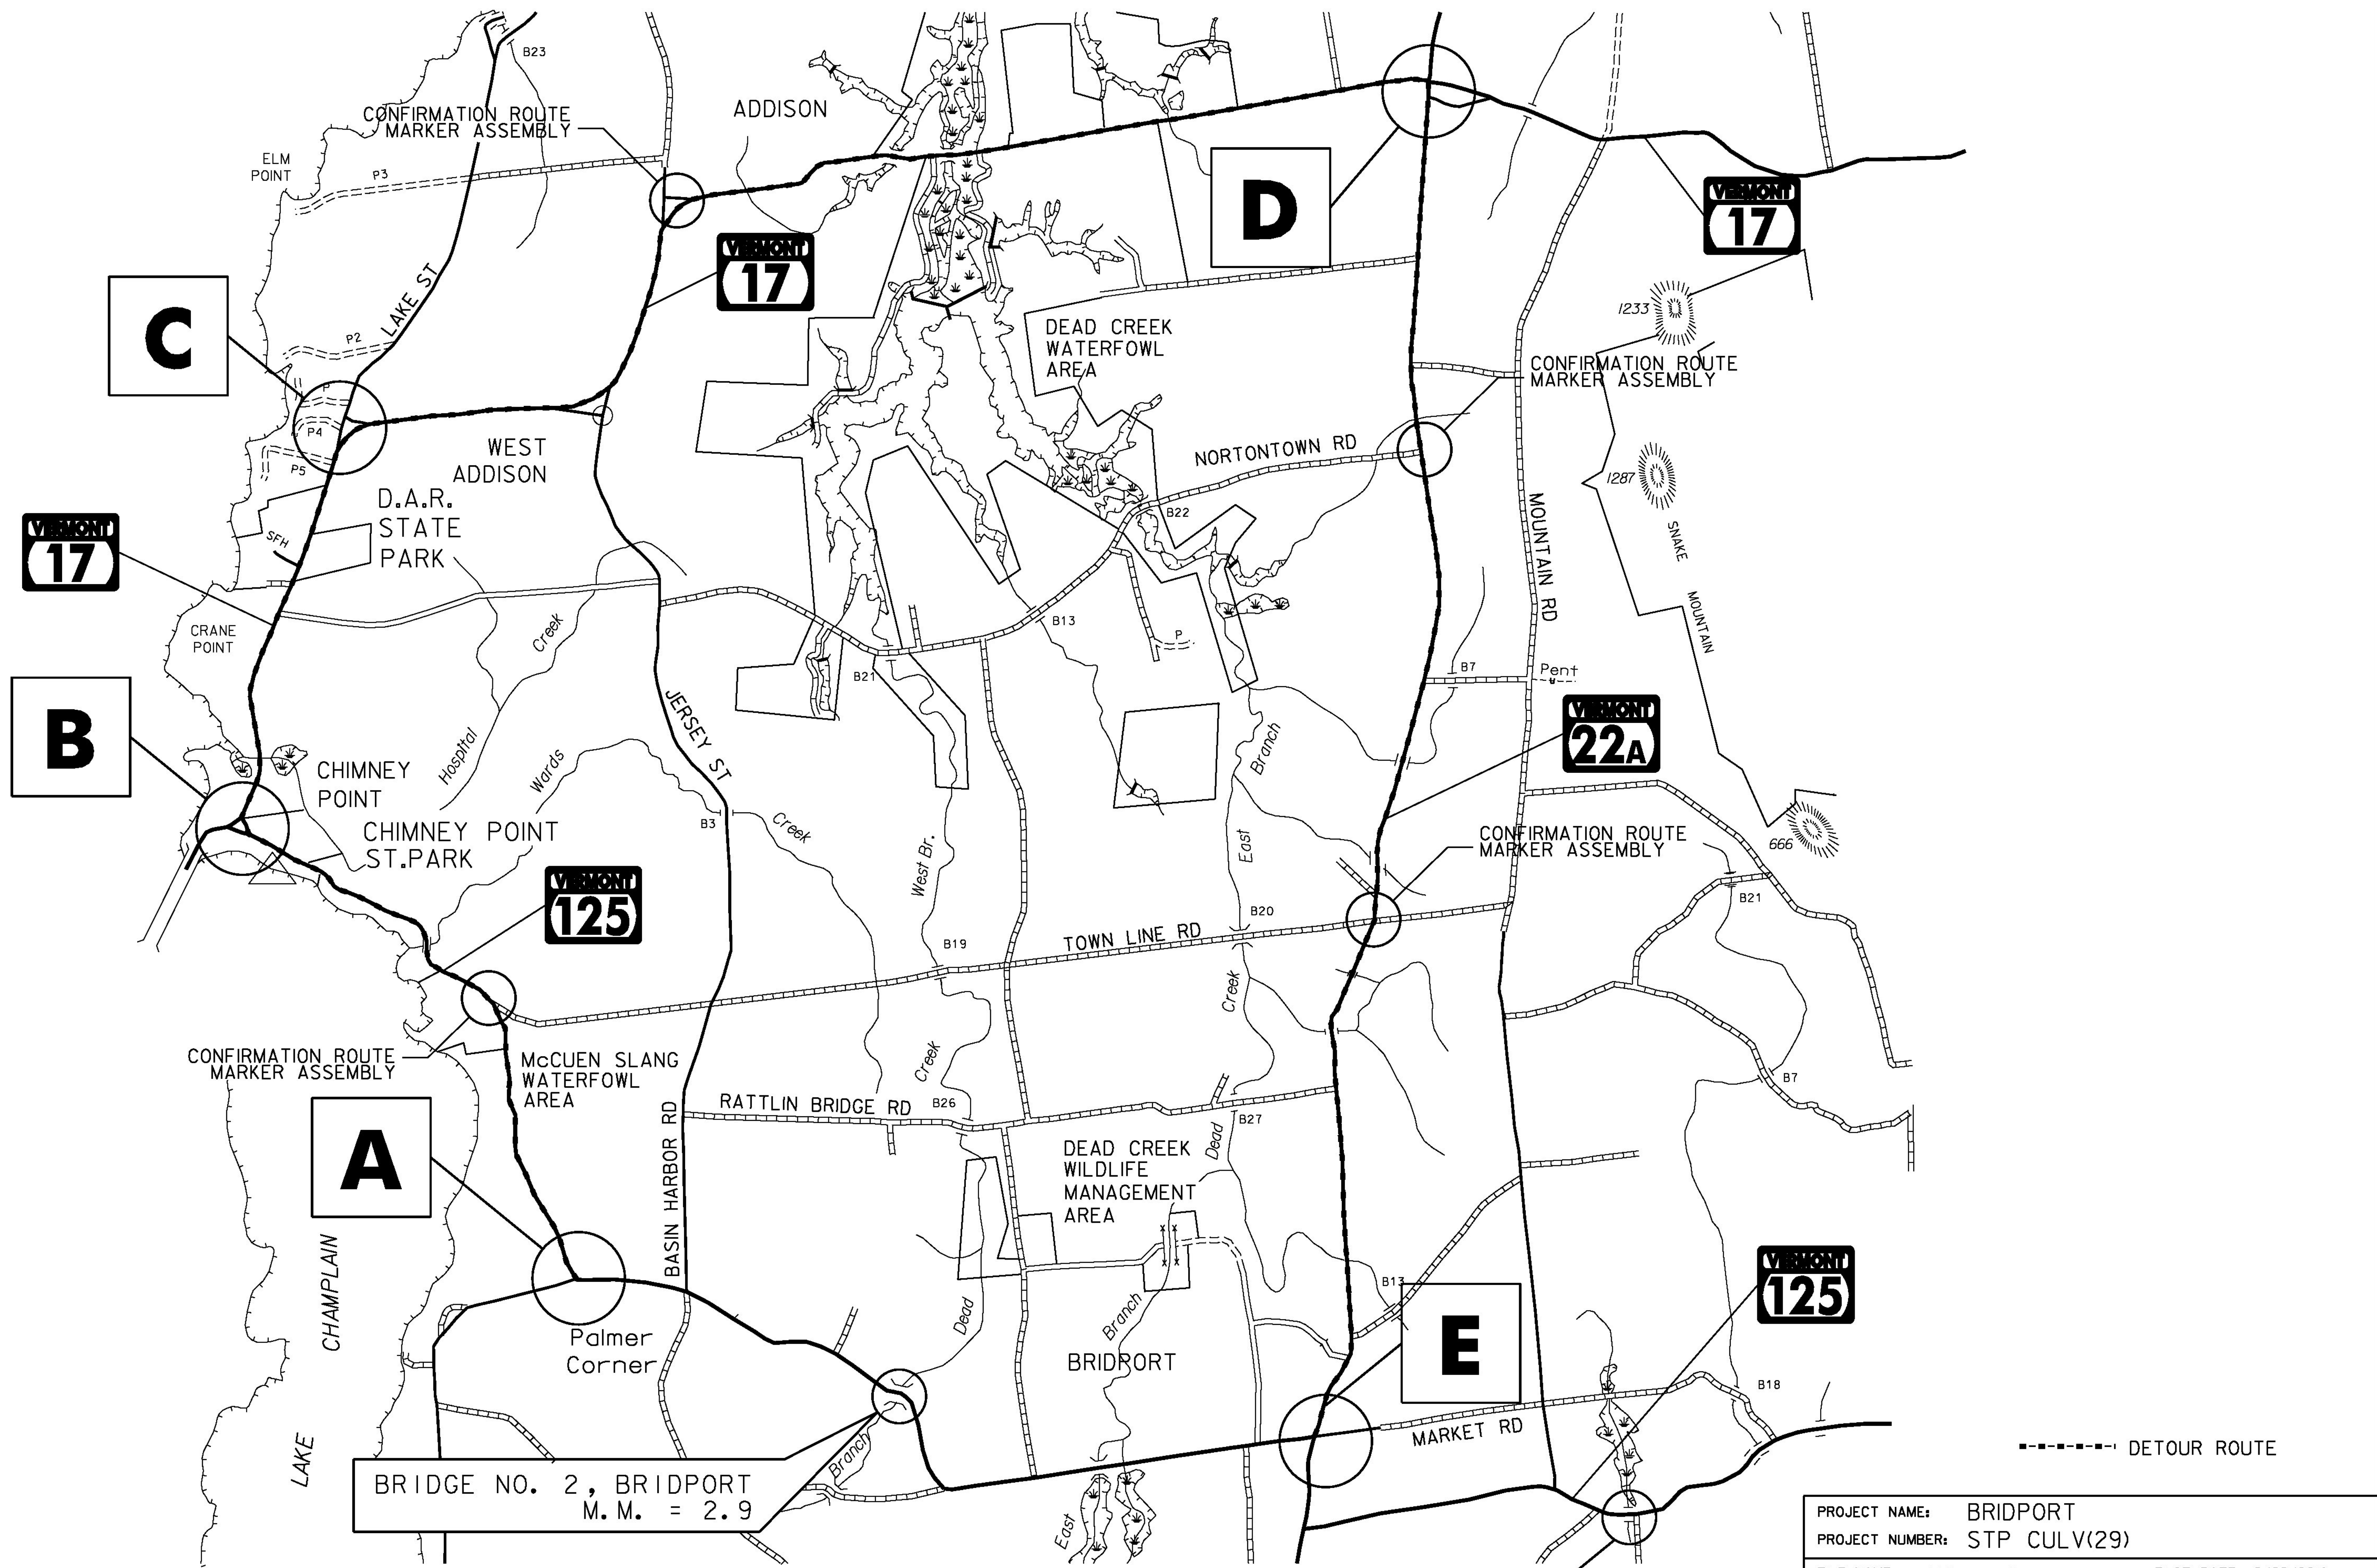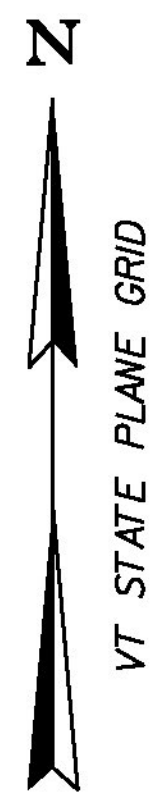


BRIDGE NO. 2, BRIDPORT  
M.M. = 2.9

BRIDPORT DETOUR PLAN - BR2  
NOT TO SCALE

BRIDGE BR 5

PROJECT NAME: BRIDPORT	PLOT DATE: 8/22/2014
PROJECT NUMBER: STP CULV(29)	DRAWN BY: J. SOTER
FILE NAME: zllc264+cpl_br2.dgn	CHECKED BY: J. HUNGERFORD
PROJECT LEADER: M. CHENETTE	SHEET 18 OF 57
DESIGNED BY: I. MAYNARD	
DETOUR PLAN - BR2	

----- DETOUR ROUTE

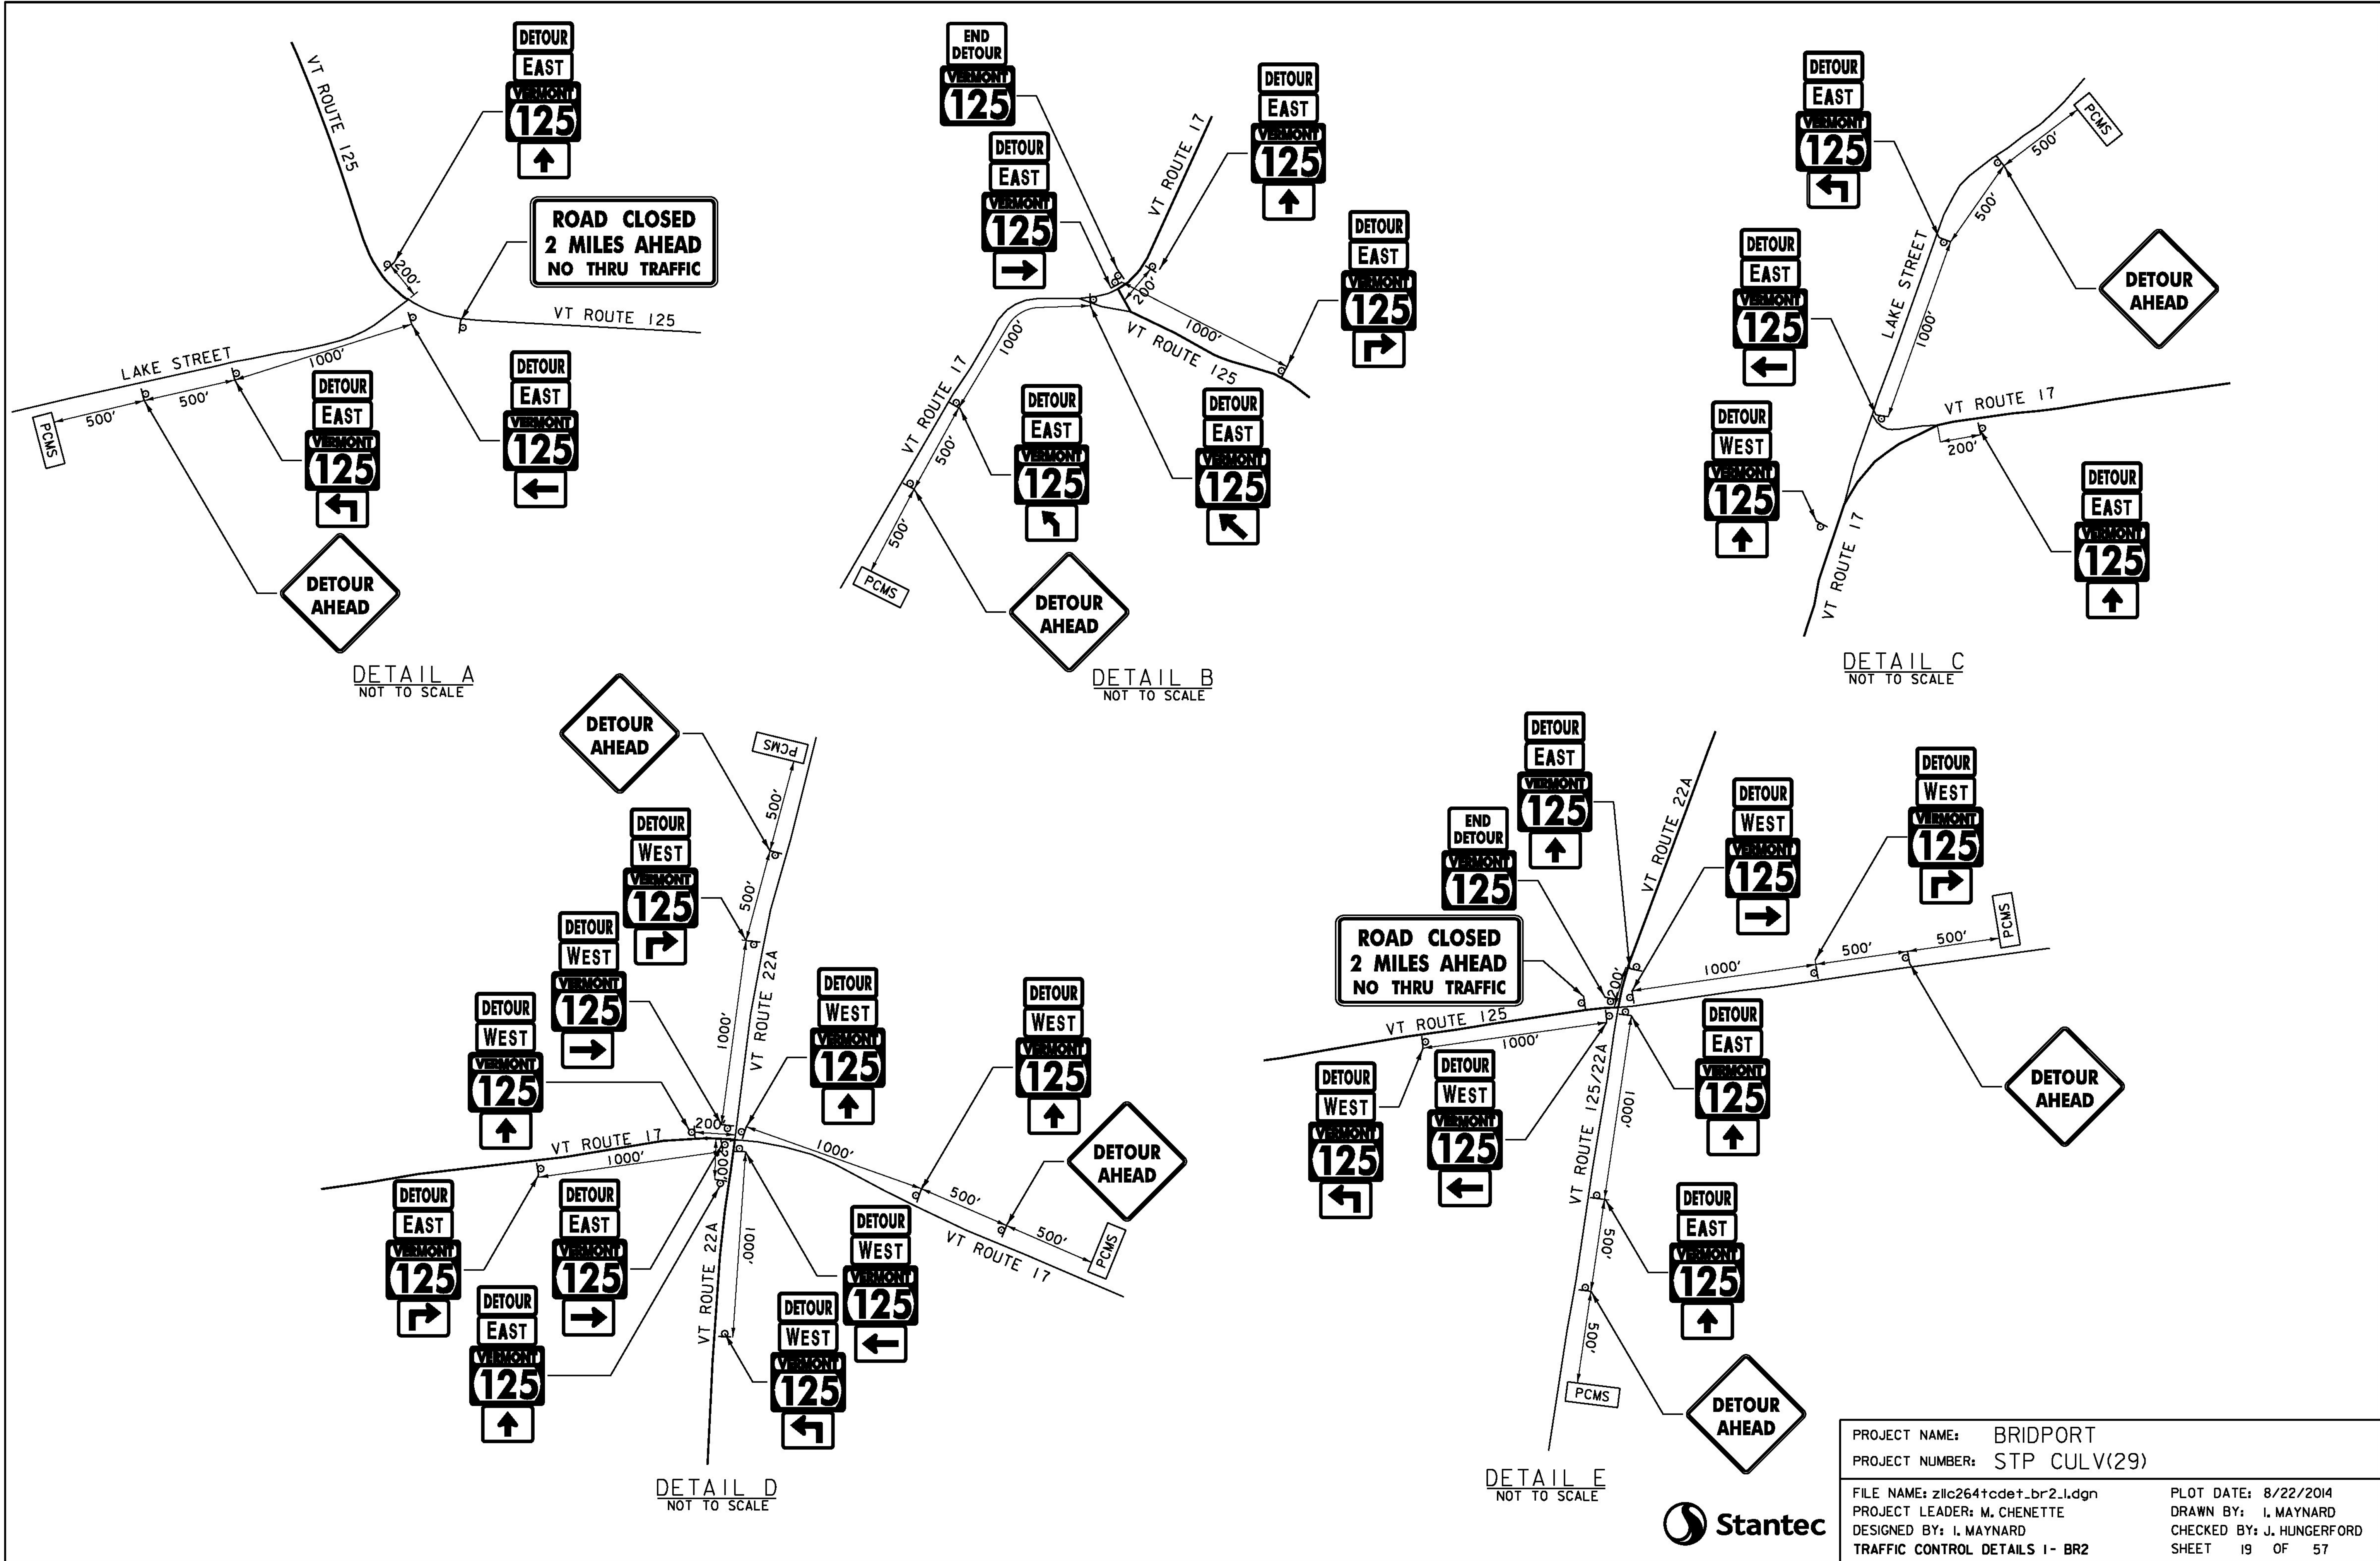

DETAIL A  
NOT TO SCALE

DETAIL B  
NOT TO SCALE



DETAIL C  
NOT TO SCALE

DETAIL D  
NOT TO SCALE

DETAIL E  
NOT TO SCALE

PROJECT NAME:	BRIDPORT	FILE NAME:	zllc264+cdet_br2.l.dgn	PLOT DATE:	8/22/2014
PROJECT NUMBER:	STP CULV(29)	PROJECT LEADER:	M. CHENETTE	DRAWN BY:	I. MAYNARD
		DESIGNED BY:	I. MAYNARD	CHECKED BY:	J. HUNGERFORD
		TRAFFIC CONTROL DETAILS I - BR2		SHEET	19 OF 57



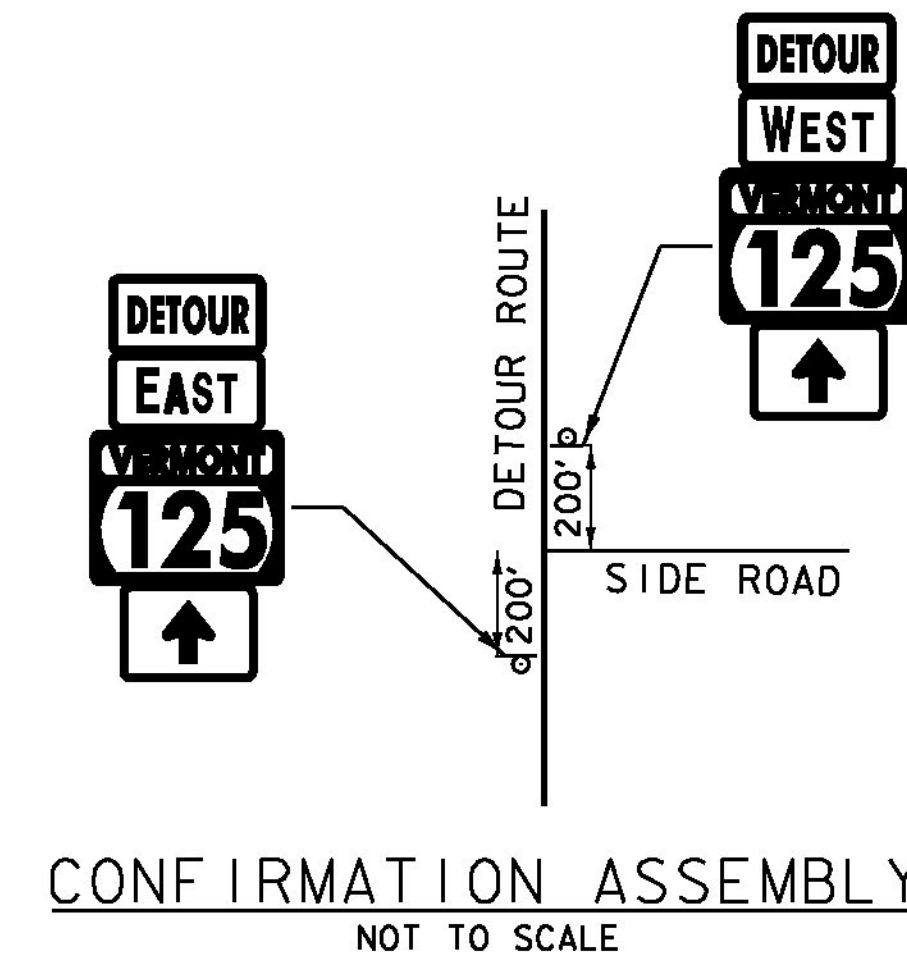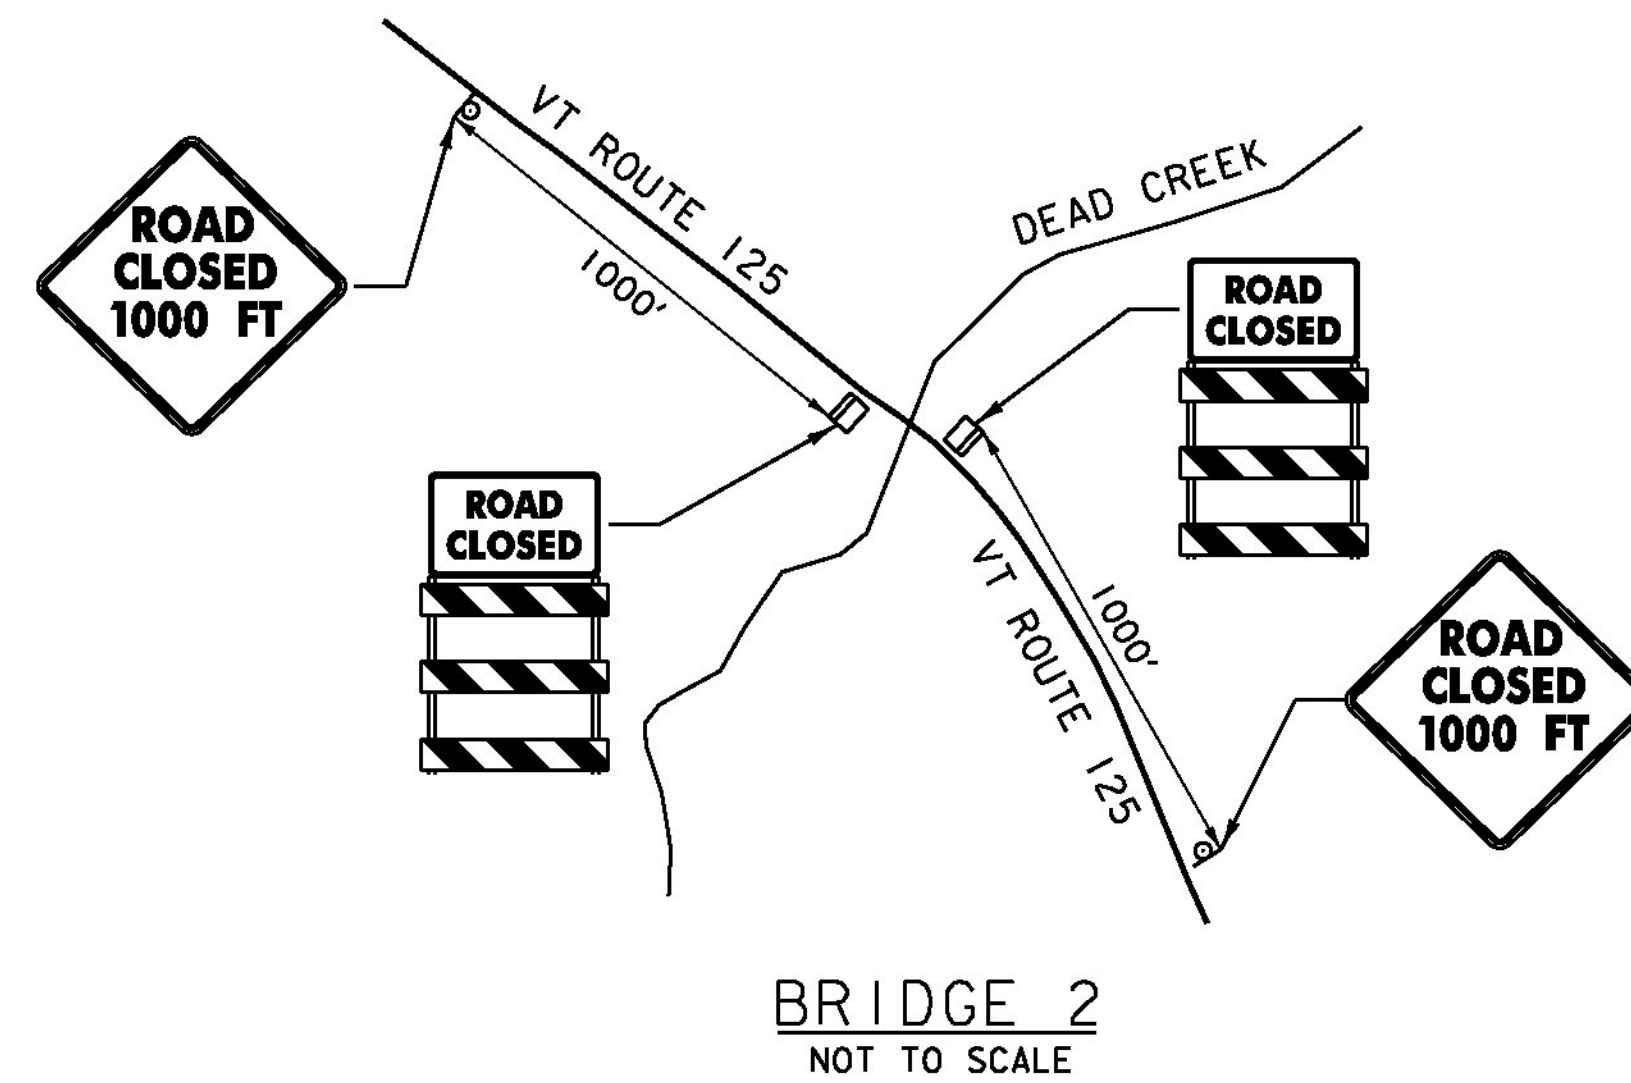

PCMS = PORTABLE CHANGEABLE MESSAGE SIGN

ID NUMBER	SIGN TEXT	SIZE OF SIGN		NUMBER OF SIGNS REQ'D.	AREA OF EACH SIGN (SF)	COLOR	REMARKS
		WIDTH	HEIGHT				
W20-2	DETOUR AHEAD	48"	48"	7	16.00	B/F0	
W20-3	ROAD CLOSED 1000 FT	48"	48"	2	16.00	B/F0	
M6-3	↑	21"	15"	13	2.19	B/F0	MOUNT BELOW MI-6A
M6-1R	→	21"	15"	4	2.19	B/F0	MOUNT BELOW MI-6A
M6-1L	←	21"	15"	4	2.19	B/F0	MOUNT BELOW MI-6A
M6-2L	↖	21"	15"	1	2.19	B/F0	MOUNT BELOW MI-6A
M5-1L	↙	21"	15"	4	2.19	B/F0	MOUNT BELOW MI-6A
M5-1R	↘	21"	15"	4	2.19	B/F0	MOUNT BELOW MI-6A
M5-2L	↗	21"	15"	1	2.19	B/F0	MOUNT BELOW MI-6A
M4-8	DETOUR	24"	12"	31	2.00	B/F0	MOUNT ABOVE M3-2 OR M3-4
M4-8a	END DETOUR	24"	18"	2	3.00	B/F0	MOUNT BELOW MI-6A
M3-2	EAST	24"	12"	18	2.00	G/W	
M3-4	WEST	24"	12"	13	2.00	G/W	
M1-6B	VERMONT 125	30"	24"	33	5.00	G/W	
R11-2C	ROAD CLOSED	48"	30"	2	10.00	B/W	
R11-3B	ROAD CLOSED 2 MILES AHEAD NO THRU TRAFFIC	60"	30"	2	12.50	B/W	

B/F0 = BLACK ON RETROREFLECTIVE ORANGE BACKGROUND  
 G/W = GREEN ON RETROREFLECTIVE WHITE BACKGROUND  
 B/W = BLACK ON RETROREFLECTIVE WHITE BACKGROUND

NOTES:

- ALL COSTS OF INSTALLING, MAINTAINING, AND REMOVING THE SIGNS AND BARRICADES IN THIS TRAFFIC CONTROL PLAN AS NECESSARY TO MEET PROJECT CONDITIONS SHALL BE INCLUDED IN ITEM 900.645 SPECIAL PROVISION (TRAFFIC CONTROL, ALL-INCLUSIVE). SEE SPECIAL PROVISIONS.
- ALL TRAFFIC SIGNS SHALL CONFORM TO THE MANUAL ON UNIFORM TRAFFIC CONTROL DEVICES (MUTCD) 2009 EDITION.
- "ROAD CLOSED" SIGNS SHALL BE MOUNTED AND MAINTAINED ON RETROREFLECTIVE TYPE III BARRICADES.
- TYPE III CONSTRUCTION BARRICADES SHALL BE PLACED SO AS TO PHYSICALLY EXCLUDE TRAFFIC FROM THE ENTIRE ROADWAY WIDTH OR AT THE DISCRETION OF THE ENGINEER.
- WHEN POSSIBLE LOCATE THE "ROAD CLOSED 1000 FT" SIGN NEAR A LOCATION WHERE DRIVERS CAN TURN AROUND.
- THE MI-6B, THE M3-2 AND THE M3-4 SIGNS SHALL BECOME THE PROPERTY OF THE STATE AFTER THEY ARE REMOVED FROM THE DETOUR. THE CONTRACTOR SHALL DELIVER THE SIGNS TO THE STATE AT THE DISTRICT #5 GARAGE.
- WHERE POSSIBLE LOCATE DETOUR ROUTE MARKER ASSEMBLIES ADJACENT TO EXISTING ROUTE MARKER ASSEMBLIES.
- SIGN SPACING IS FOR REFERENCE ONLY, FIELD ADJUSTMENTS AS APPROVED BY THE ENGINEER.
- EXISTING SIGNS IN CONFLICT WITH THIS DETOUR PLAN SHALL BE COVERED WHEN NECESSARY, AS APPROVED BY THE ENGINEER.

MESSAGES FOR PORTABLE CHANGEABLE MESSAGE SIGNS (PCMS) - REGIONAL DETOUR

STARTING 2 WEEKS PRIOR TO CLOSURE

	MESSAGE 1	MESSAGE 2	
(ROUTE) **	<b>VT 125</b>	<b>MMMM DD</b>	(DATE) *
	<b>ROAD</b>	<b>TO</b>	
	<b>CLOSED</b>	<b>MMMM DD</b>	(DATE) *

DURING CLOSURE

	MESSAGE 1	MESSAGE 2
(ROUTE) **	<b>VT 125</b>	<b>EAST OF</b>
	<b>ROAD</b>	<b>BASIN</b>
	<b>CLOSED</b>	<b>HARBR RD</b>

* - DATE SHALL BE SPELLED OUT (I.E. JUNE 10 NOT 6/10)  
 ** - ROUTE 125 SHALL SPECIFY E (EAST) OR W (WEST) AS APPROPRIATE FOR THE DETOUR.



PROJECT NAME: BRIDPORT  
 PROJECT NUMBER: STP CULV(29)

FILE NAME: zllc264+cdet_br2.2.dgn  
 PROJECT LEADER: M. CHENETTE  
 DESIGNED BY: I. MAYNARD  
 TRAFFIC CONTROL DETAILS 2 - BR2

PLOT DATE: 8/22/2014  
 DRAWN BY: I. MAYNARD  
 CHECKED BY: J. HUNGERFORD  
 SHEET 20 OF 57

**SOIL CLASSIFICATION**

AASHTO

A1	Gravel and Sand
A3	Fine Sand
A2	Silty or Clayey Gravel and Sand
A4	Silty Soil - Low Compressibility
A5	Silty Soil - Highly Compressible
A6	Clayey Soil - Low Compressibility
A7	Clayey Soil - Highly Compressible

**ROCK QUALITY DESIGNATION**

R.Q.D. (%)	ROCK DESCRIPTION
<25	Very Poor
25 to 50	Poor
51 to 75	Fair
76 to 90	Good
>90	Excellent

**SHEAR STRENGTH**

UNDRAINED SHEAR STRENGTH IN P.S.F.	CONSISTENCY
<250	Very Soft
250-500	Soft
500-1000	Med. Stiff
1000-2000	Stiff
2000-4000	Very Stiff
>4000	Hard

**CORRELATION GUIDE OF "N" TO DENSITY/CONSISTENCY**

DENSITY (GRANULAR SOILS)		CONSISTENCY (COHESIVE SOILS)	
N	DESCRIPTIVE TERM	N	DESCRIPTIVE TERM
<5	Very Loose	<2	Very Soft
5-10	Loose	2-4	Soft
11-24	Med. Dense	5-8	Med. Stiff
25-50	Dense	9-15	Stiff
>50	Very Dense	16-30	Very Stiff
		31-60	Hard
		>60	Very Hard

**COMMONLY USED SYMBOLS**


▼	Water Elevation
⊕	Standard Penetration Boring
⊗	Auger Boring
⊙	Rod Sounding
S	Sample
N	Standard Penetration Test Blow Count Per Foot For: 2" O.D. Sampler 1 3/8" I.D. Sampler Hammer Weight Of 140 Lbs. Hammer Fall Of 30"
VS	Field Vane Shear Test
US	Undisturbed Soil Sample
B	Blast
DC	Diamond Core
MD	Mud Drill
WA	Wash Ahead
HSA	Hollow Stem Auger
AX	Core Size 1 1/8"
BX	Core Size 1 3/8"
NX	Core Size 2 1/8"
M	Double Tube Core Barrel Used
LL	Liquid Limit
PL	Plastic Limit
PI	Plasticity Index
NP	Non Plastic
w	Moisture Content (Dry Wgt. Basis)
D	Dry
M	Moist
MTW	Moist To Wet
W	Wet
Sat	Saturated
Bo	Boulder
Gr	Gravel
Sa	Sand
SI	Silt
Cl	Clay
HP	Hardpan
Le	Ledge
NLTD	No Ledge To Depth
CNPF	Can Not Penetrate Further
TLOB	To Ledge Or Boulder
NR	No Recovery
Rec.	Recovery
%Rec.	Percent Recovery
RQD	Rock Quality Designation
CBR	California Bearing Ratio
<	Less Than
>	Greater Than
R	Refusal (N > 100)

**COLOR**

blk	Black	pnk	Pink
bl	Blue	pu	Purple
brn	Brown	rd	Red
dk	Dark	tn	Tan
gry	Gray	wh	White
gn	Green	yel	Yellow
lt	Light	mltc	Multicolored
or	Orange		

**DEFINITIONS (AASHTO)**

<b>BEDROCK (LEDGE)</b> - Rock in its native location of indefinite thickness.	<b>VARVED</b> - Alternate layers of silt and clay.
<b>BOULDER</b> - A rock fragment with an average dimension > 12 inches.	<b>HARDPAN</b> - Extremely dense soil, cemented layer, not softened when wet.
<b>COBBLE</b> - Rock fragments with an average dimension between 3 and 12 inches.	<b>MUCK</b> - Soft organic soil (containing > 10% organic material).
<b>GRAVEL</b> - Rounded particles of rock < 3" and > 0.075" (#10 sieve).	<b>MOISTURE CONTENT</b> - Weight of water divided by dry weight of soil.
<b>SAND</b> - Particles of rock < 0.075" (#10 sieve) and > 0.0029" (#200 sieve).	<b>FLOWING SAND</b> - Granular soil so saturated (loose) that it flows into drill casing during extraction of wash rod.
<b>SILT</b> - Soil < 0.0029" (#200 sieve), non or slightly plastic and exhibits no strength when air-dried.	<b>STRIKE</b> - Angle from magnetic north to line of intersection of bed with a horizontal plane.
<b>CLAY</b> - Fine grained soil, exhibits plasticity when moist and considerable strength when air-dried.	<b>DIP</b> - Inclination of bed with a horizontal plane.

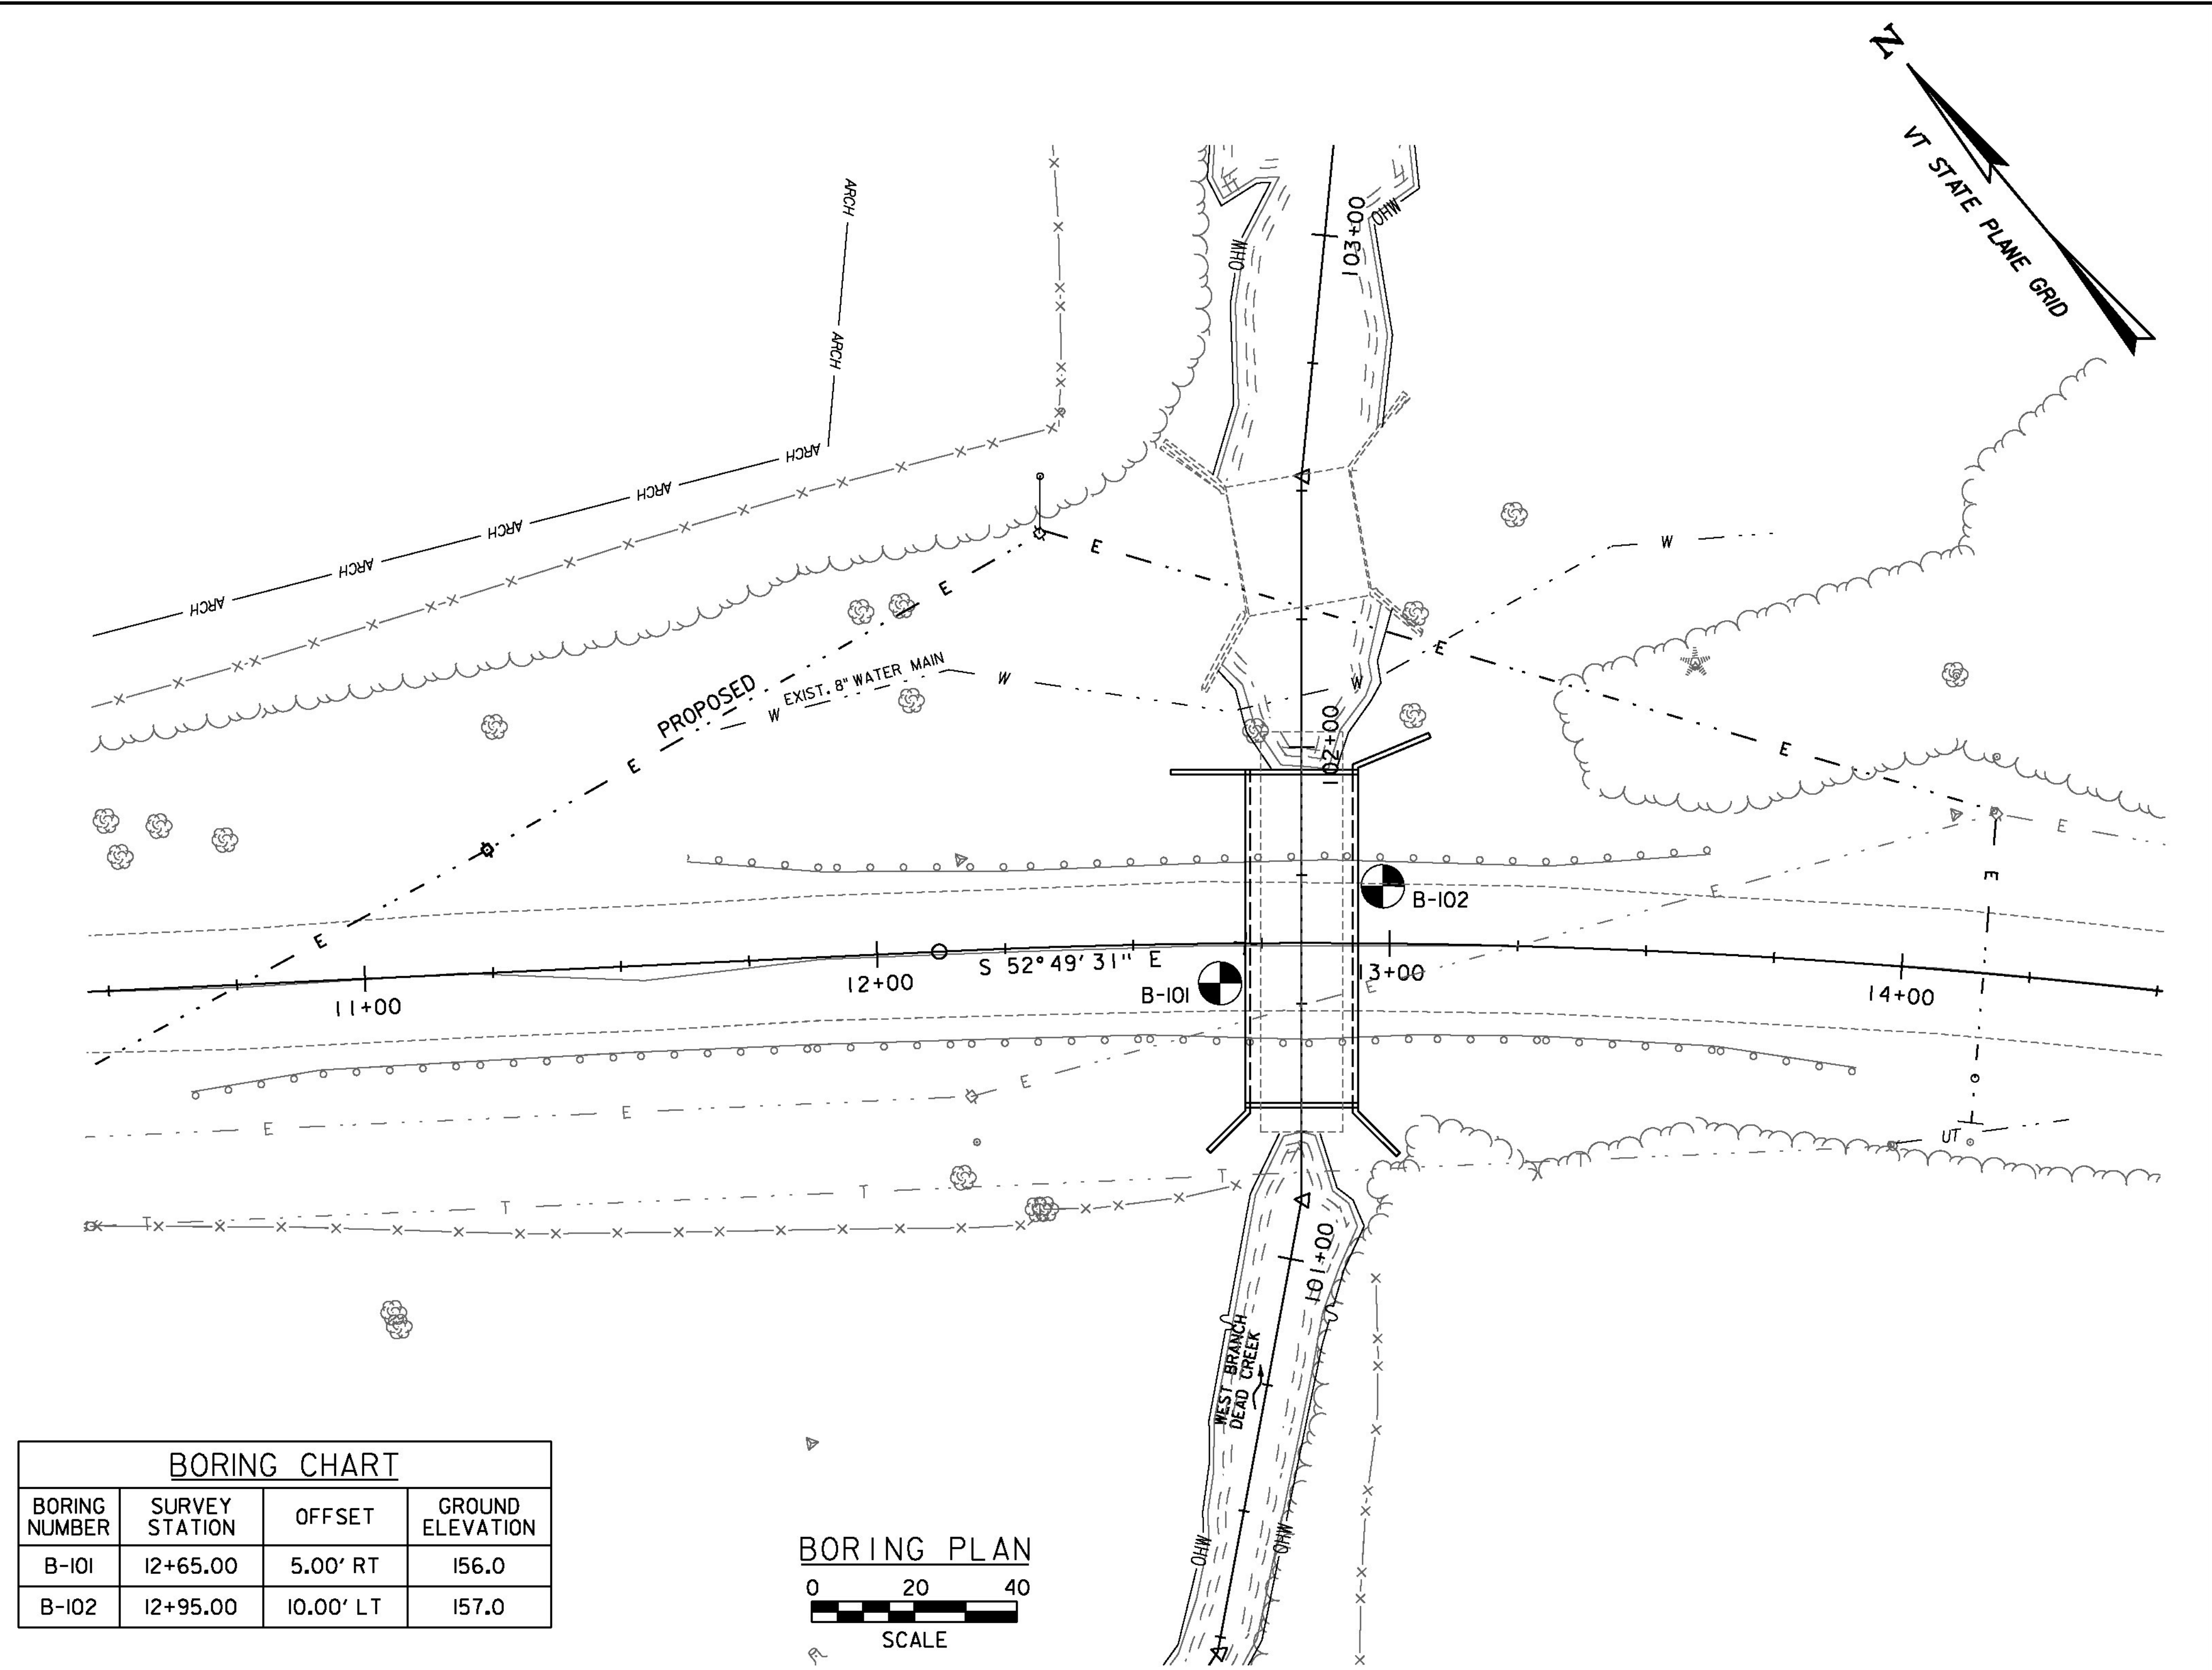

**BORING CHART**

BORING NUMBER	SURVEY STATION	OFFSET	GROUND ELEVATION
B-101	12+65.00	5.00' RT	156.0
B-102	12+95.00	10.00' LT	157.0

**GENERAL NOTES**

- The subsurface explorations shown herein were made on Oct. 25, 2012 by N.H. Boring.
- Soil and rock classifications, properties and descriptions are based on engineering interpretation from available subsurface information and may not necessarily reflect actual variations in subsurface conditions that may be encountered between individual boring or sample locations.
- Observed water levels and/or conditions indicated are as recorded at the time of exploration and may vary according to the prevailing rainfall, methods of exploration and other factors.
- Engineering judgement was exercised in preparing the subsurface information presented herein. Analysis and interpretation of subsurface data was performed and interpreted for Agency design and estimating purposes. Presentation of the information in the Contract is intended to provide the Contractor access to the same data available to the Agency. The subsurface information is presented in good faith and is not intended as a substitute for personal investigation, independent interpretation, independent analysis or judgement by the Contractor.
- Pictorial structure details shown on the boring plan layout or soils profile are for illustrative purposes only and may not accurately portray final contract details.
- Terminology used on boring logs to describe the hardness, degree of weathering, and spacing of fractures, joints and other discontinuities in the bedrock is defined in the AASHTO Manual on Subsurface Investigations, 1988.

**LEGEND:**



PROJECT NAME: BRIDPORT  
PROJECT NUMBER: STP CULV(29)

FILE NAME: zllc264bdr_bor_pl_br2.dgn  
PROJECT LEADER: M. CHENETTE  
DESIGNED BY: J. HUNGERFORD  
BORING PLAN - BR2

PLOT DATE: 8/22/2014  
DRAWN BY: L. BUXTON  
CHECKED BY: M. CHENETTE  
SHEET 21 OF 57



STATE OF VERMONT AGENCY OF TRANSPORTATION MATERIALS & RESEARCH SECTION SUBSURFACE INFORMATION		BORING LOG		Boring No.: B-101						
		BRIDPORT STP CULV(29) VT-125 BR-2&5		Page No.: 1 of 2						
				Pin No.: 11C264						
				Checked By: LAR						
Boring Crew: GARROW, WHITLOCK		Casing	Sampler	Groundwater Observations						
Date Started: 9/19/12	Date Finished: 9/21/12	Type: WB	SS	Date	Depth (ft)					
VTSPG NAD83: N 546829.94 ft E 1416137.25 ft		I.D.: 4 in	1.5 in	09/21/12	19.4					
Station: 12+65	Offset: 5.00	Hammer Wt: N.A.	140 lb.	AM, Casing in HP						
Ground Elevation: 156.0 ft		Hammer Fall: N.A.	30 in.							
		Hammer/Rod Type: Auto/AWJ								
		Rig: CME 45C SKID	CE = 1.33							
Depth (ft)	Strata (1)	CLASSIFICATION OF MATERIALS (Description)		Blows/ft (N Value)	Moisture Content %	Gravel %	Sand %	Fines %	LL %	PI %
		Asphalt Pavement, 0.0 ft - 1.7 ft								
		Field Note: GrSa with a lot of Asphalt Pavement, blk-brn, Moist, Rec. = 0.5 ft		9-14-11-7 (25)						
5		A-7-6, Cl, gry, Moist, Rec. = 0.4 ft		2-2-1-2 (3)	32.2	17.5	5.9	76.6	66	38
		Shelby Tube, gry, Moist, Rec. = 1.6 ft, 9.0 ft - 11.0 ft								
		Shelby Tube, gry, Moist, Rec. = 1.7 ft, 11.0 ft - 13.0 ft								
15		A-7-6, Cl, gry, Moist, Rec. = 1.8 ft		WH-3-3-5 (6)	38.1	1.1	2.1	96.8	65	38
		A-1-a, SaGr, brn, Moist, Rec. = 0.4 ft		4-5-6-3 (11)	10.5	55.2	36.8	8.0		
20		A-4, GrSaSi, gry, Moist, Rec. = 0.3 ft		R05.0"	7.9	23.3	29.7	47.0		
25		A-4, SaGrSi, gry, Moist, Rec. = 0.4 ft		28-R05.0"	7.1	31.1	29.7	39.2		
		Field Note: Cobble, Clean out casing								
		A-4, SaSi, gry, Moist, Rec. = 0.7 ft		44-R05.0"	7.0	19.1	30.7	50.2		
35		A-4, GrSaSi, gry, Moist, Rec. = 0.6 ft		25-43-R03.5"	8.0	24.2	28.1	47.7		
Notes: 1. Stratification lines represent approximate boundary between material types. Transition may be gradual. 2. N Values have not been corrected for hammer energy. CE is the hammer energy correction factor. 3. Water level readings have been made at times and under conditions stated. Fluctuations of groundwater may occur due to other factors than those present at the time measurements were made.										

BOTTOM OF CULVERT  
APPROX. EL. 130.8

BORING LOG 2 BRIDPORT STP CULV(29) (P.1) VERMONT.AOT.BOT 1/10/13

STATE OF VERMONT AGENCY OF TRANSPORTATION MATERIALS & RESEARCH SECTION SUBSURFACE INFORMATION		BORING LOG		Boring No.: B-101						
		BRIDPORT STP CULV(29) VT-125 BR-2&5		Page No.: 2 of 2						
				Pin No.: 11C264						
				Checked By: LAR						
Boring Crew: GARROW, WHITLOCK		Casing	Sampler	Groundwater Observations						
Date Started: 9/19/12	Date Finished: 9/21/12	Type: WB	SS	Date	Depth (ft)					
VTSPG NAD83: N 546829.94 ft E 1416137.25 ft		I.D.: 4 in	1.5 in	09/21/12	19.4					
Station: 12+65	Offset: 5.00	Hammer Wt: N.A.	140 lb.	AM, Casing in HP						
Ground Elevation: 156.0 ft		Hammer Fall: N.A.	30 in.							
		Hammer/Rod Type: Auto/AWJ								
		Rig: CME 45C SKID	CE = 1.33							
Depth (ft)	Strata (1)	CLASSIFICATION OF MATERIALS (Description)		Blows/ft (N Value)	Moisture Content %	Gravel %	Sand %	Fines %	LL %	PI %
		A-4, SaSi, gry, Moist, Rec. = 1.1 ft		22-33-40-R (73)	6.9	19.4	31.0	49.6		
45		A-4, SaGrSi, gry, Moist, Rec. = 0.6 ft		26-37-R05.0"	7.3	28.9	27.1	44.0		
50		A-4, SaGrSi, gry, Moist, Rec. = 1.2 ft		18-29-30-R (59)	7.3	31.2	27.5	41.3		
55		Visual Description: SaGrSi, gry, Moist, Rec. = 0.3 ft, insufficient sample for testing. Similar material to 52.0 - 53.8 ft.		16-30-39-R (69)	8.6					
60		Field Note: No Recovery. Appears to be the same material		26-37-R05.0"						
65		Visual Description: SaGrSi HP, gry, Moist, Rec. = 0.3 ft, insufficient sample for testing. Similar material to 52.0 - 53.8 ft.		28-32-38-R (68)	6.3					
70		Visual Description: SaSiGr with Broken Rock, gry, Moist, Rec. = 0.2 ft, insufficient sample for testing.		21-24-33-R (57)	6.2					
75		Hole stopped @ 73.9 ft								
Notes: 1. Stratification lines represent approximate boundary between material types. Transition may be gradual. 2. N Values have not been corrected for hammer energy. CE is the hammer energy correction factor. 3. Water level readings have been made at times and under conditions stated. Fluctuations of groundwater may occur due to other factors than those present at the time measurements were made.										

BORING LOG 2 BRIDPORT STP CULV(29) (P.1) VERMONT.AOT.BOT 1/10/13

PROJECT NAME: BRIDPORT  
PROJECT NUMBER: STP CULV(29)

FILE NAME: zllc264bor_log_br2.dgn  
PROJECT LEADER: M. CHENETTE  
DESIGNED BY: VTRANS  
BORING LOG I - BR2

PLOT DATE: 8/22/2014  
DRAWN BY: L. BUXTON  
CHECKED BY: VTRANS  
SHEET 22 OF 57



STATE OF VERMONT AGENCY OF TRANSPORTATION MATERIALS & RESEARCH SECTION SUBSURFACE INFORMATION		BORING LOG		Boring No.: B-102					
Bridport STP CULV(29) VT-125 BR-2&5		Page No.: 1 of 2		Pin No.: 11C264					
Checked By: LAR		Boring Crew: GARROW, WHITLOCK		Casing Sampler					
Date Started: 9/10/12 Date Finished: 9/12/12		Type: WB SS		Groundwater Observations					
VTSPG NAD83: N 546823.89 ft E 1416173.72 ft		I.D.: 4 in 1.5 in		Date Depth (ft) Notes					
Station: 12+95 Offset: -10.00		Hammer Wt: N.A. 140 lb.		09/12/12 6.0 AM, Casing in HP					
Ground Elevation: 157.0 ft		Hammer Fall: N.A. 30 in.							
		Hammer/Rod Type: Auto/AWJ							
		Rig: CME 45C SKID CE = 1.33							
Depth (ft)	Strata (1)	CLASSIFICATION OF MATERIALS (Description)	Blows/6" (N Value)	Moisture Content %	Gravel %	Sand %	Fines %	LL %	PI %
		Asphalt Pavement, 0.0 ft - 1.8 ft							
		Field Note: SaGr with a lot of Asphalt Pavement, blk, Moist, Rec. = 0.5 ft	4-2-1-3 (3)						
5									
		A-7-6, SaCl, gry, Moist, Rec. = 0.6 ft	WH-1-2-3 (3)	28.7	6.4	40.9	52.7	56	33
10									
		Field Note: Roller Coned ahead in Clay							
		Field Note: Cl Shelby Tube, gry, Moist, Rec. = 1.8 ft							
		Field Note: Roller Coned ahead in Clay							
		Field Note: Cl Shelby Tube, gry, Moist, Rec. = 2.0 ft							
15									
		A-7-6, Cl, gry, Moist, Rec. = 0.8 ft	2-6-10-12 (16)	34.1	1.8	3.4	94.8	49	21
		A-1-b, GrSa, brn, Moist, Rec. = 0.4 ft		11.7	33.7	56.9	9.4		
20									
		A-4, GrClSi, gry, Moist, Rec. = 0.4 ft	8-22-28-19 (50)	32.8	32.2	18.0	49.8	35	10
		A-4, SaGrSi, gry, Moist, Rec. = 1.5 ft		8.8	35.4	28.8	35.8		
		A-4, GrSaSi, gry, Moist, Rec. = 1.3 ft	8-17-25-50 (42)	8.4	27.2	35.7	37.1		
		A-2-4, SiSaGr, gry, Moist, Rec. = 0.8 ft	44-R05.0"	7.5	41.9	30.5	27.6		
		Visual Description: SiSaGr, gry, Moist, Rec. = 0.2 ft, insufficient sample for testing. Material similar to 26-26.9 ft.	R02.5"	7.1					
		A-4, SaSi, gry, Moist, Rec. = 0.6 ft	35-R05.0"	7.1	19.6	33.7	46.7		
		A-4, GrSaSi, gry, Moist, Rec. = 0.8 ft	10-39-45-R (84)	7.2	20.4	32.1	47.5		
		A-2-4, SaSiGr, gry, Moist, Rec. = 0.4 ft	R05.0"	7.0	46.0	25.7	28.3		
		A-4, GrSaSi, gry, Moist, Rec. = 0.5 ft	28-R05.0"	6.7	28.5	31.3	40.2		
		Field Note: Cleaned out Cobble							
		A-4, GrSaSi, gry, Moist, Rec. = 0.9 ft	49-R05.0"	7.0	26.3	30.9	42.8		

BOTTOM OF CULVERT  
APPROX. EL. 130.8

BORING LOG 2 - BRIDPORT STP CULV(29).DPT VERMONT AUT.DOT 1/10/13

Notes:  
1. Stratification lines represent approximate boundary between material types. Transition may be gradual.  
2. N Values have not been corrected for hammer energy. CE is the hammer energy correction factor.  
3. Water level readings have been made at times and under conditions stated. Fluctuations of groundwater may occur due to other factors than those present at the time measurements were made.

STATE OF VERMONT AGENCY OF TRANSPORTATION MATERIALS & RESEARCH SECTION SUBSURFACE INFORMATION		BORING LOG		Boring No.: B-102					
Bridport STP CULV(29) VT-125 BR-2&5		Page No.: 2 of 2		Pin No.: 11C264					
Checked By: LAR		Boring Crew: GARROW, WHITLOCK		Casing Sampler					
Date Started: 9/10/12 Date Finished: 9/12/12		Type: WB SS		Groundwater Observations					
VTSPG NAD83: N 546823.89 ft E 1416173.72 ft		I.D.: 4 in 1.5 in		Date Depth (ft) Notes					
Station: 12+95 Offset: -10.00		Hammer Wt: N.A. 140 lb.		09/12/12 6.0 AM, Casing in HP					
Ground Elevation: 157.0 ft		Hammer Fall: N.A. 30 in.							
		Hammer/Rod Type: Auto/AWJ							
		Rig: CME 45C SKID CE = 1.33							
Depth (ft)	Strata (1)	CLASSIFICATION OF MATERIALS (Description)	Blows/6" (N Value)	Moisture Content %	Gravel %	Sand %	Fines %	LL %	PI %
		A-4, GrSaSi, gry, Moist, Rec. = 0.4 ft	5-16-46-R (62)	7.2	21.8	35.2	43.0		
45									
		A-4, SaGrSi, gry, Moist, Rec. = 1.2 ft	28-33-R06.0"	6.6	29.6	28.5	41.9		
50									
		A-4, SaGrSi, gry, Moist, Rec. = 1.4 ft	18-35-R06.0"	6.8	28.0	27.4	44.6		
55									
		A-4, GrSaSi, gry, Moist, Rec. = 0.5 ft	15-34-R05.0"	7.3	28.1	29.0	42.9		
60									
		A-4, SaGrSi, gry, Moist, Rec. = 1.1 ft	12-24-41-R (65)	7.2	32.8	26.8	40.4		
65									
		A-4, GrSaSi, gry, Moist, Rec. = 1.0 ft	20-28-37-R (65)	7.8	24.8	30.1	45.1		
70									
		Field Note: No Recovery. Appears to be the same material	13-31-R05.0"						
75		Hole stopped @ 74.4 ft							


BORING LOG 2 - BRIDPORT STP CULV(29).DPT VERMONT AUT.DOT 1/10/13

Notes:  
1. Stratification lines represent approximate boundary between material types. Transition may be gradual.  
2. N Values have not been corrected for hammer energy. CE is the hammer energy correction factor.  
3. Water level readings have been made at times and under conditions stated. Fluctuations of groundwater may occur due to other factors than those present at the time measurements were made.


PROJECT NAME: BRIDPORT  
PROJECT NUMBER: STP CULV(29)

FILE NAME: zllc264bor_log_br2.dgn PLOT DATE: 8/22/2014  
PROJECT LEADER: M. CHENETTE DRAWN BY: L. BUXTON  
DESIGNED BY: VTRANS CHECKED BY: VTRANS  
BORING LOG 2 - BR2 SHEET 23 OF 57



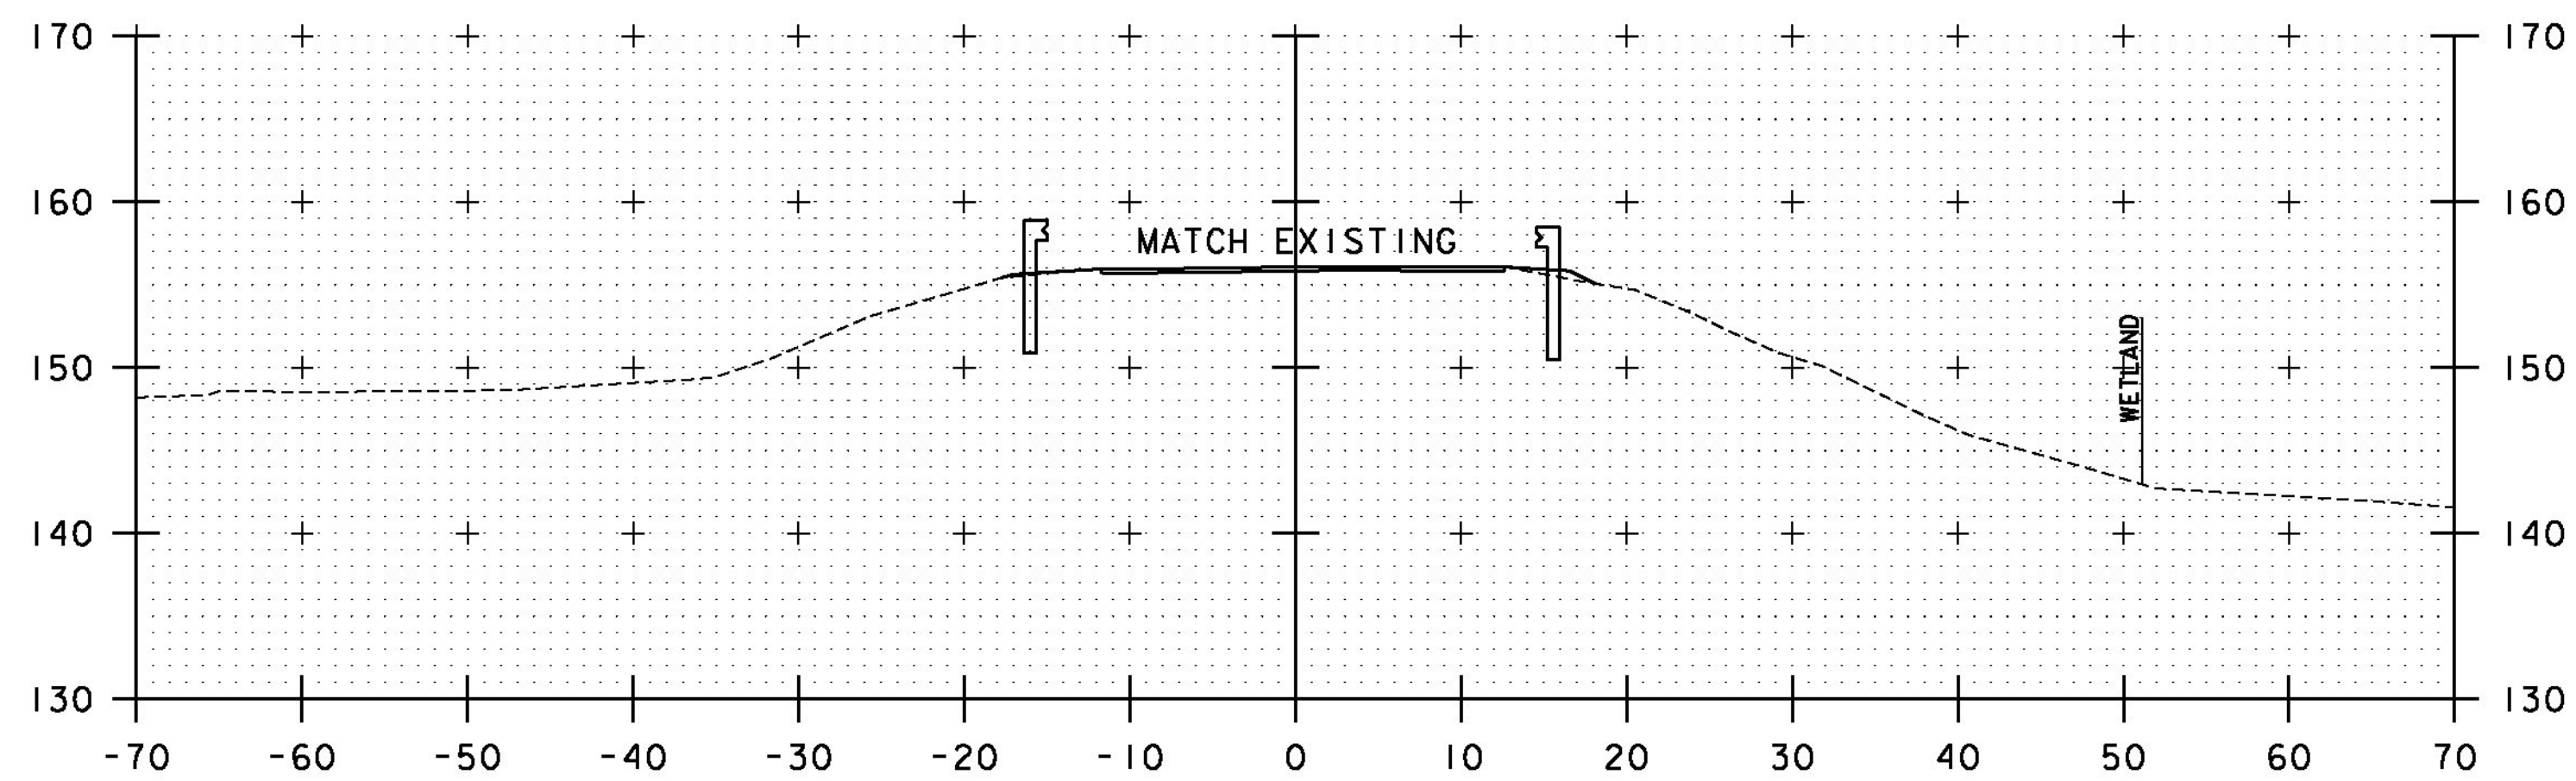


11+50

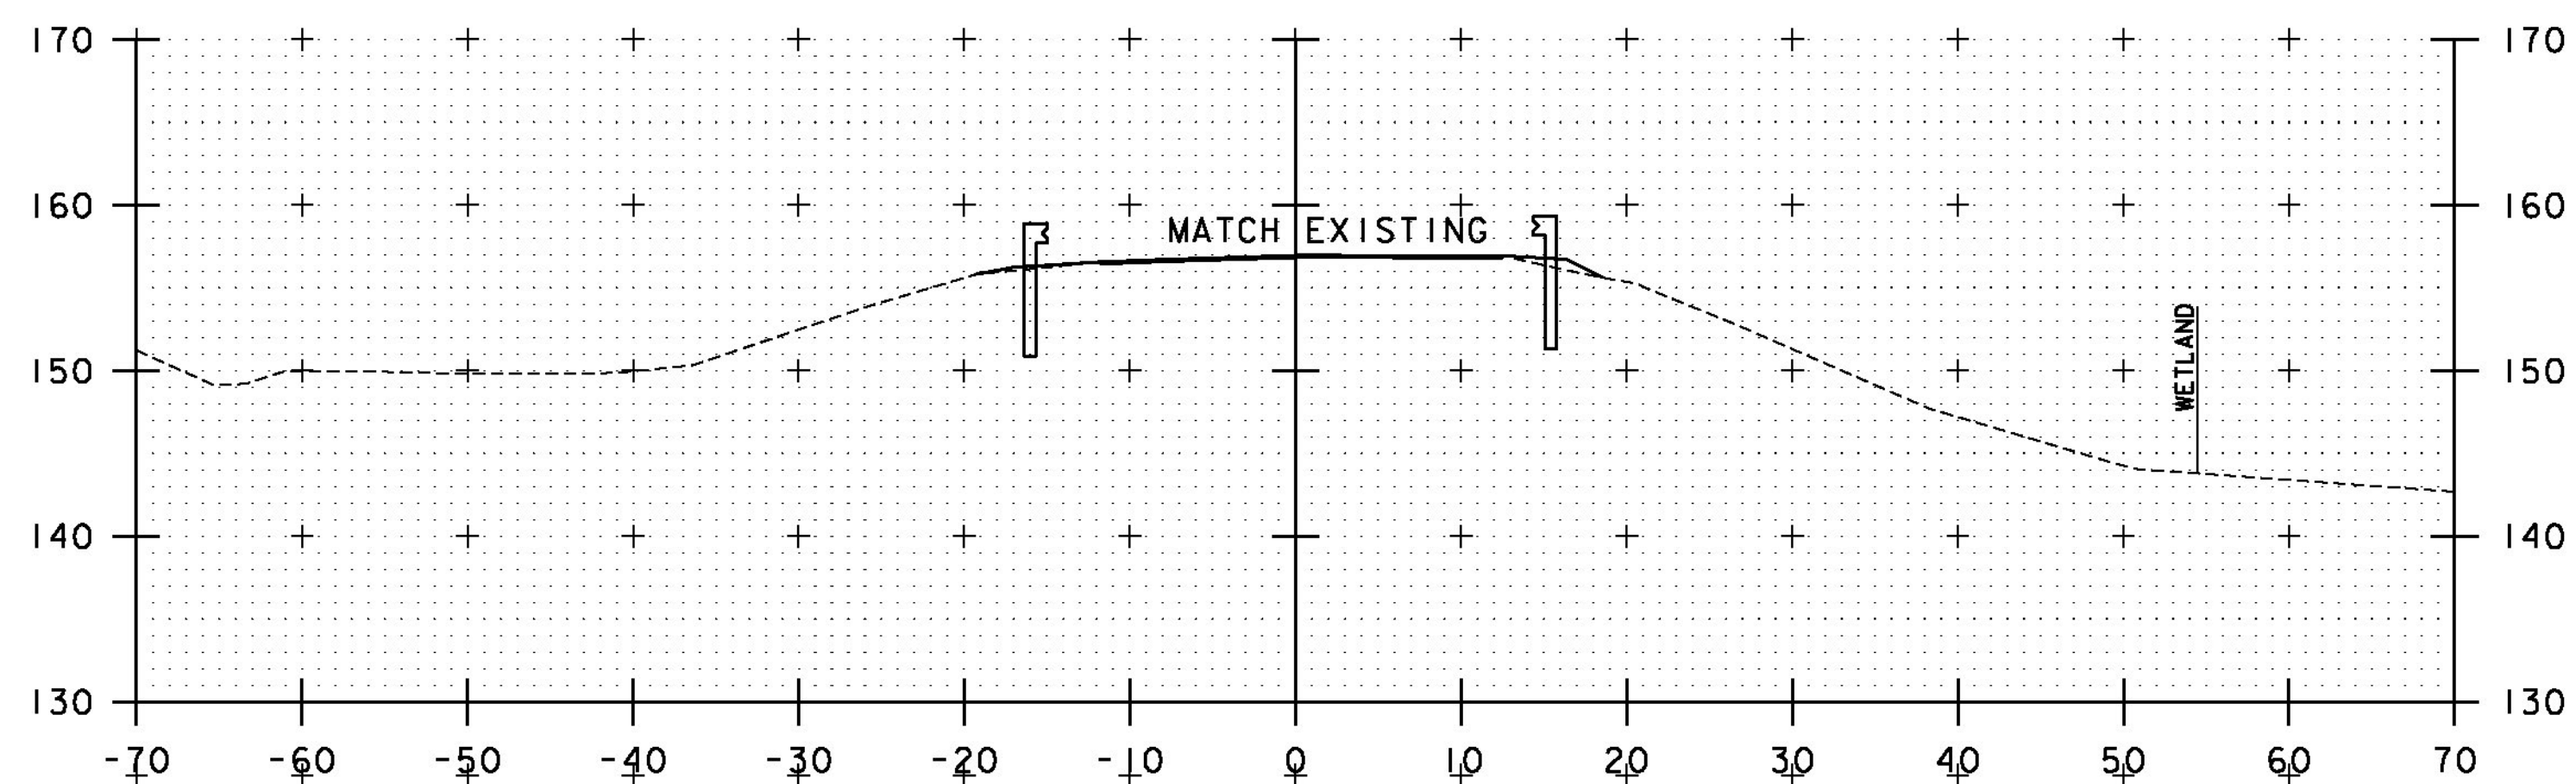


11+25

11+15  
BEGIN APPROACH

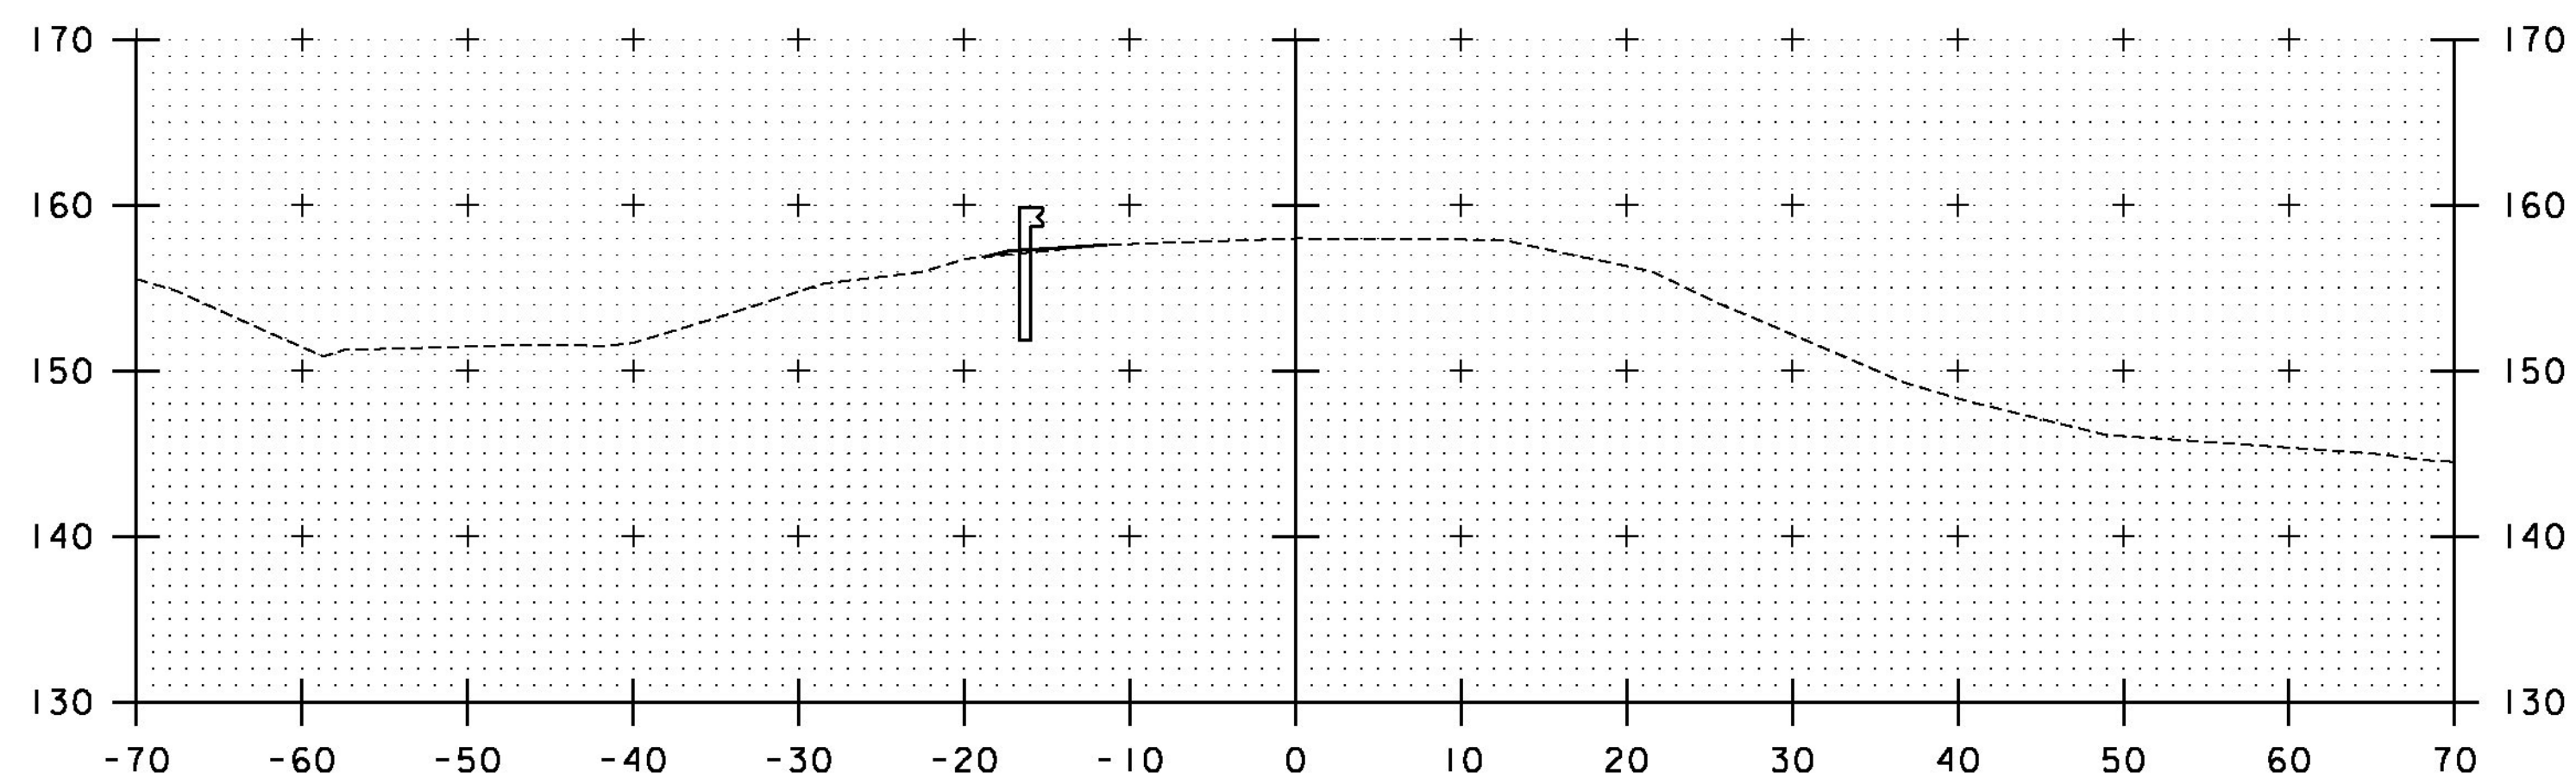


11+00

12+15  
BEGIN PROJECT

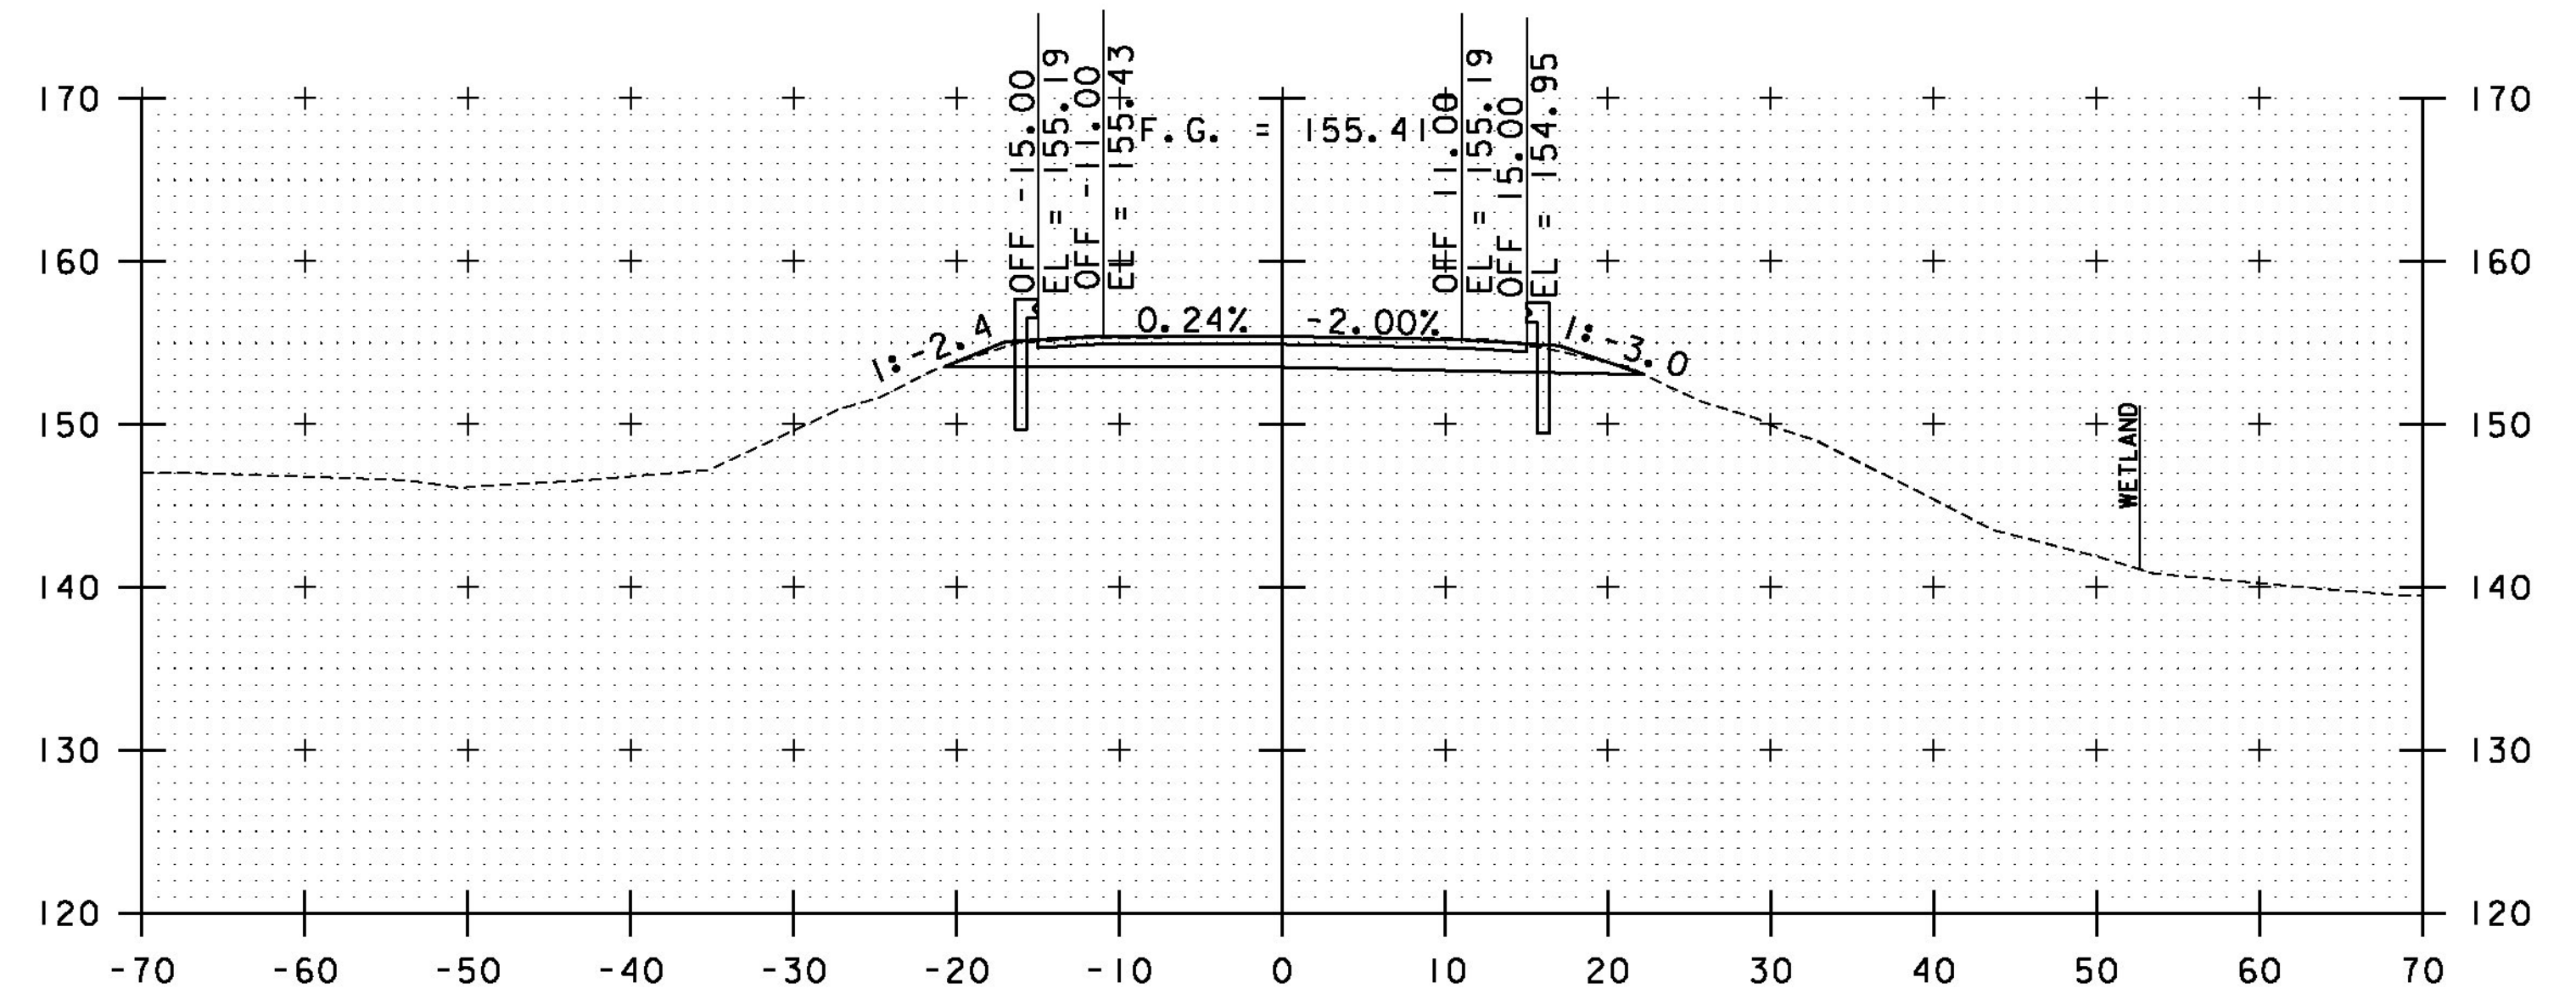

12+00

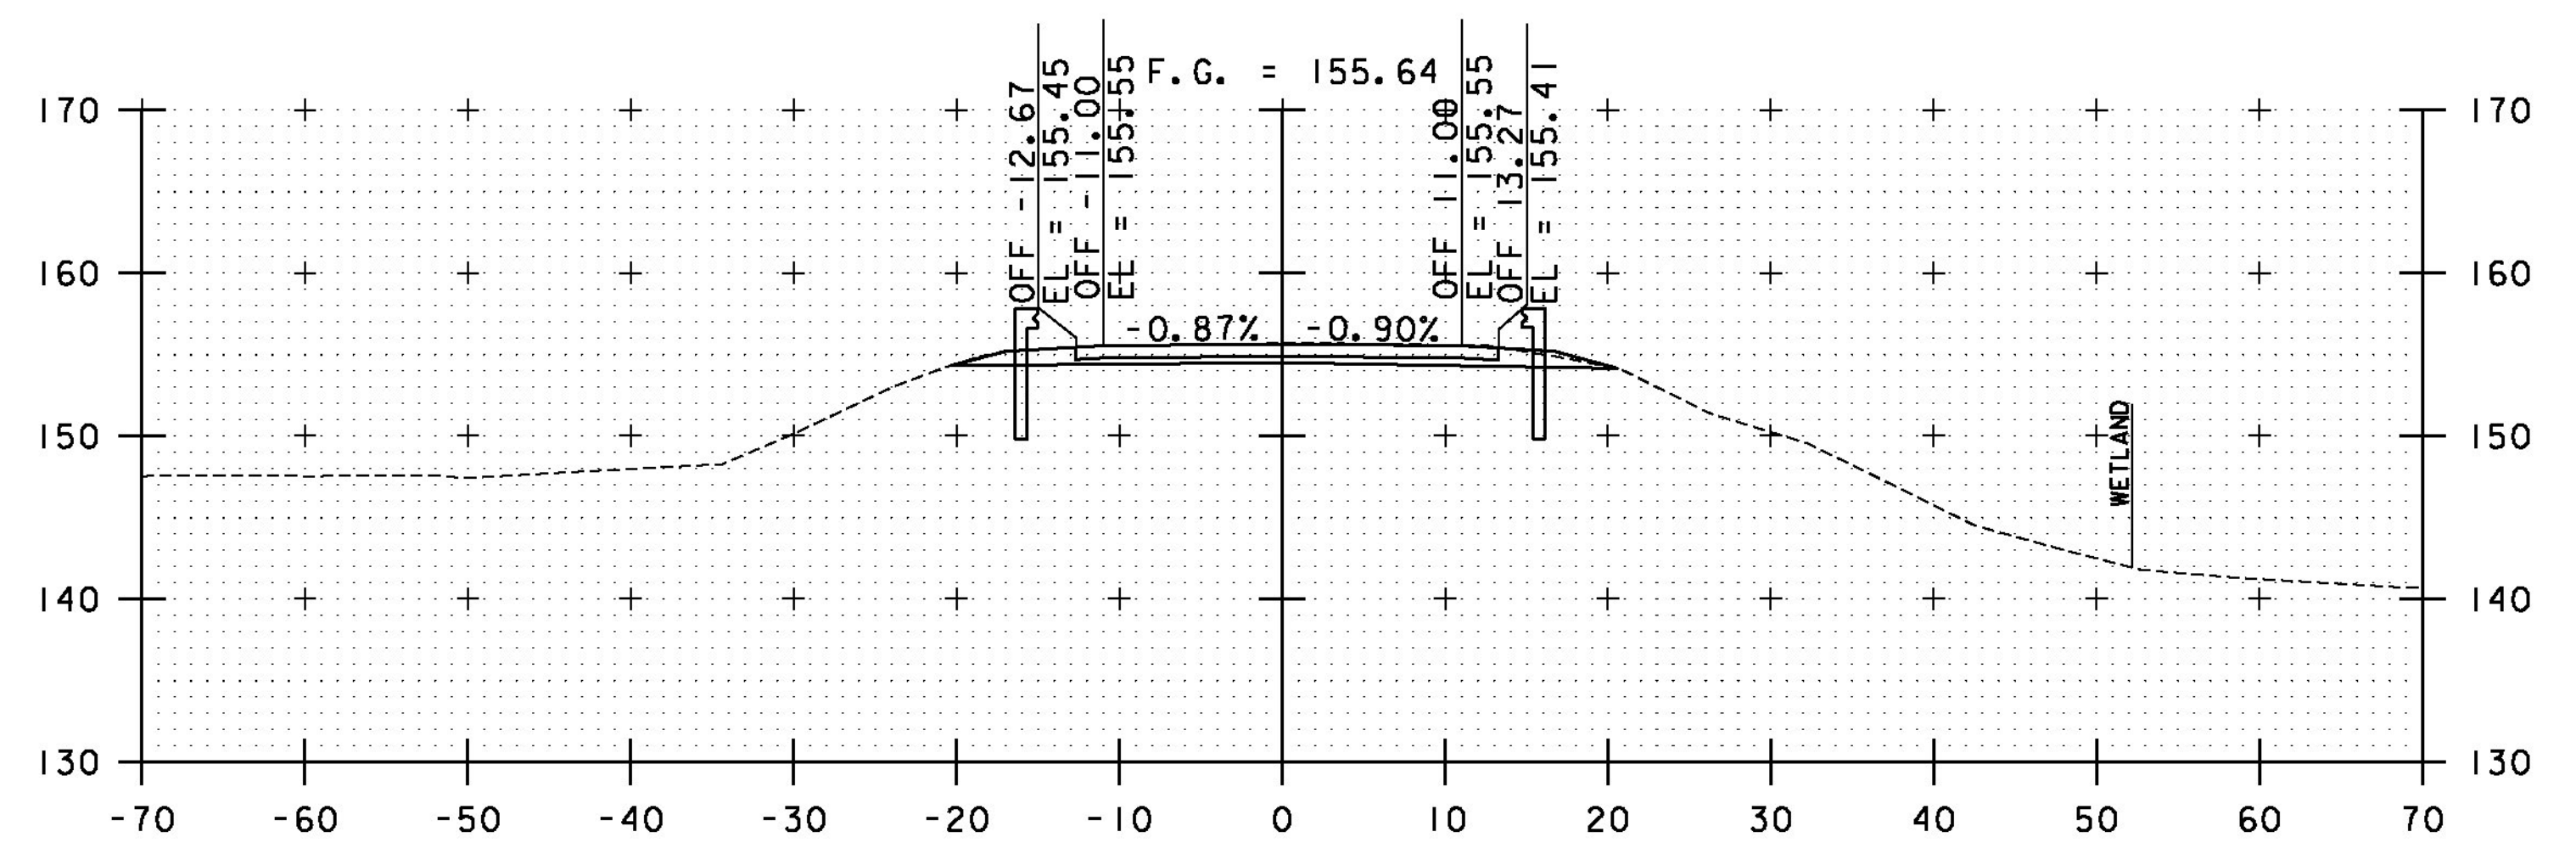


11+75

STA. 11+00 TO STA. 12+00



PROJECT NAME: BRIDPORT  
PROJECT NUMBER: STP CULV(29)

FILE NAME: zllc264xs_br2.dgn  
PROJECT LEADER: M. CHENETTE  
DESIGNED BY: J. HUNGERFORD  
ROADWAY CROSS SECTIONS - RXSI - BR2


PLOT DATE: 8/22/2014  
DRAWN BY: L. BUXTON  
CHECKED BY: M. CHENETTE  
SHEET 24 OF 57

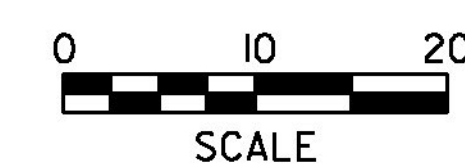


12+71.82  
BEGIN BRIDGE

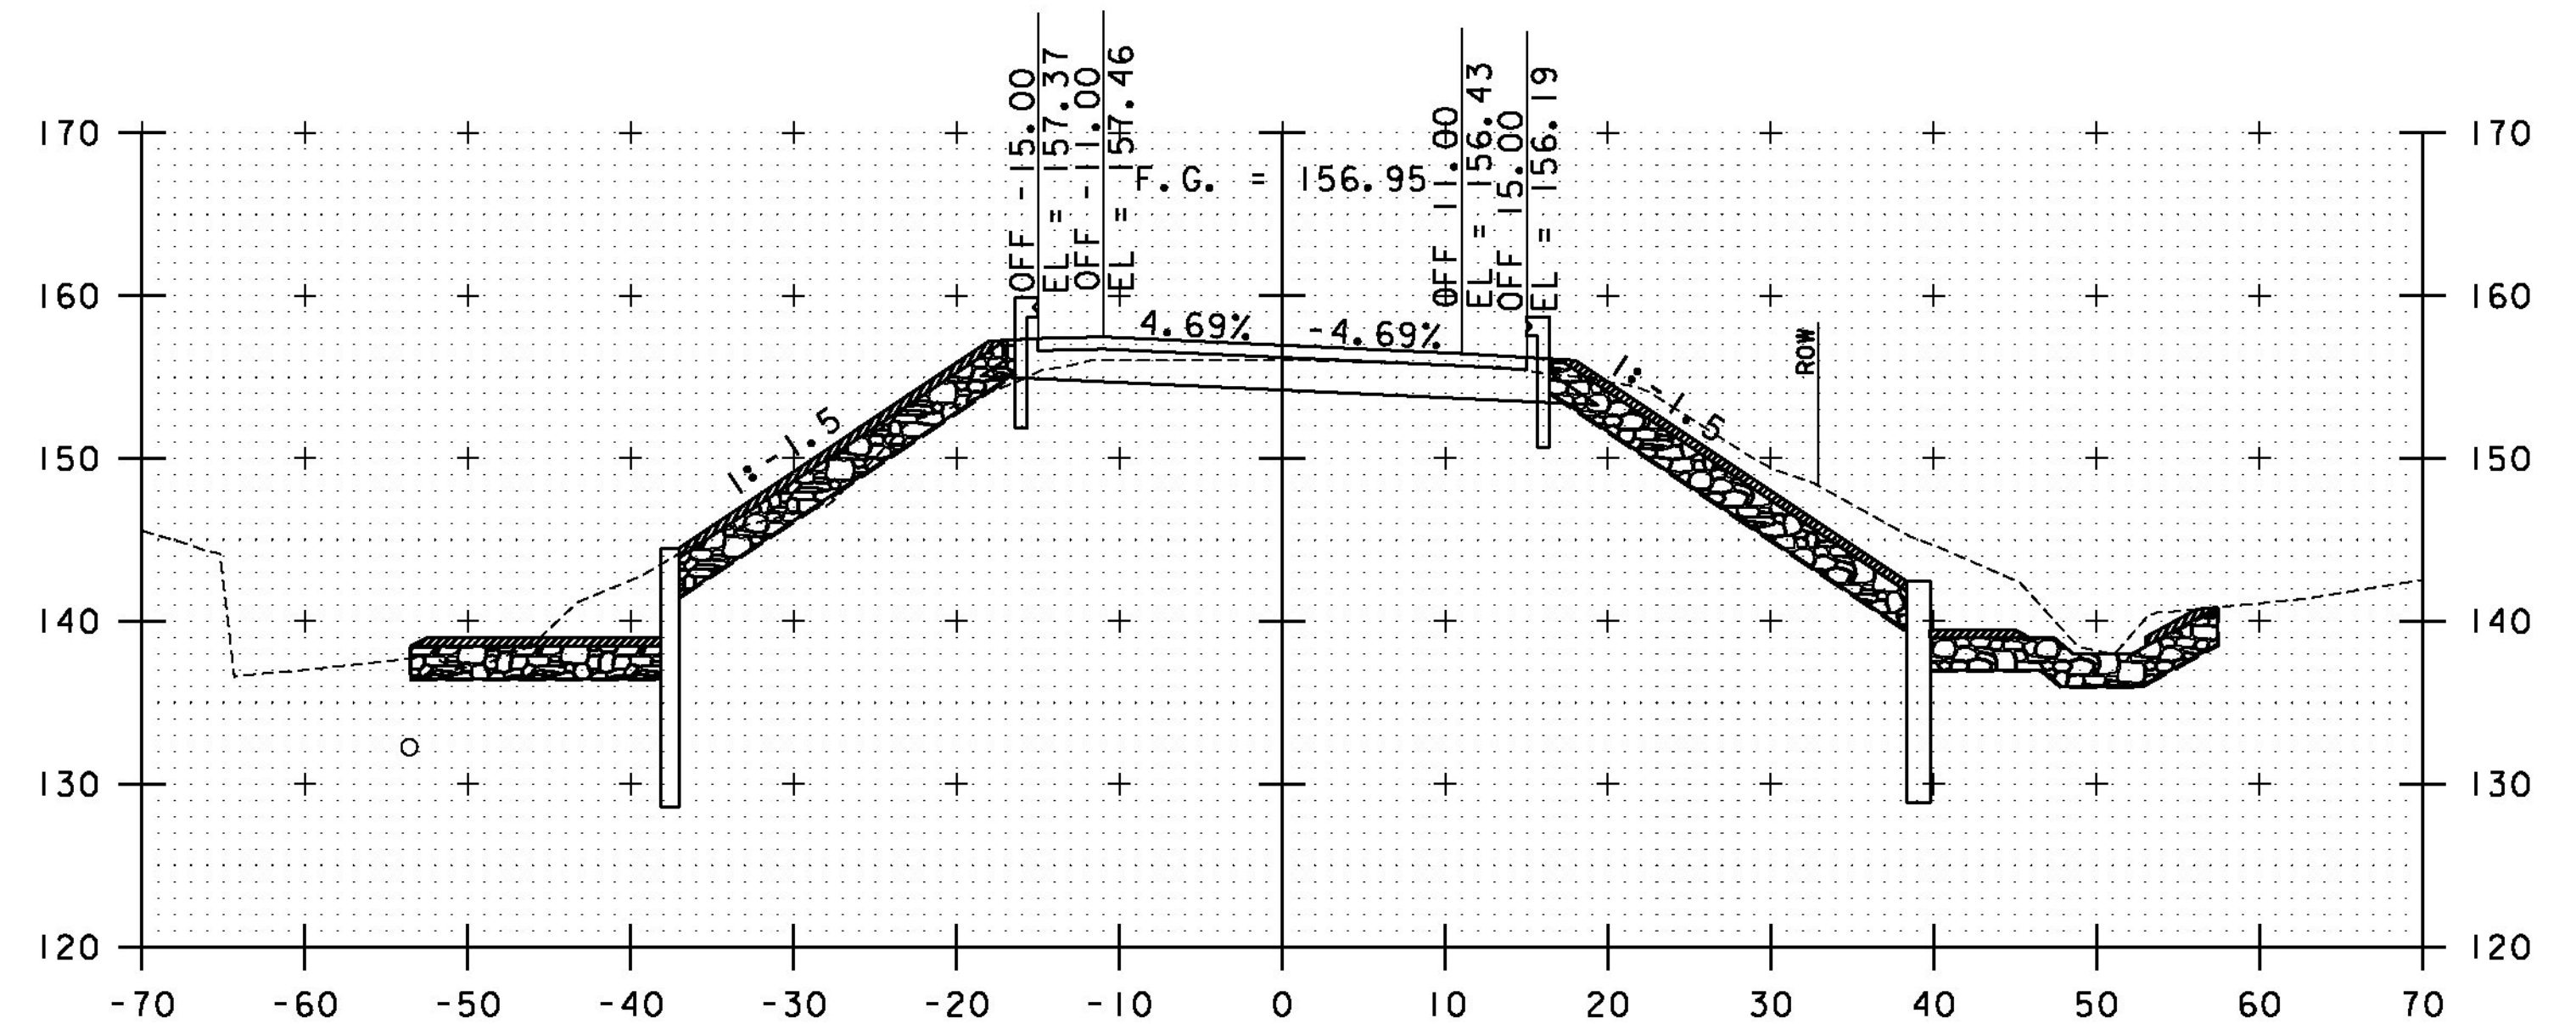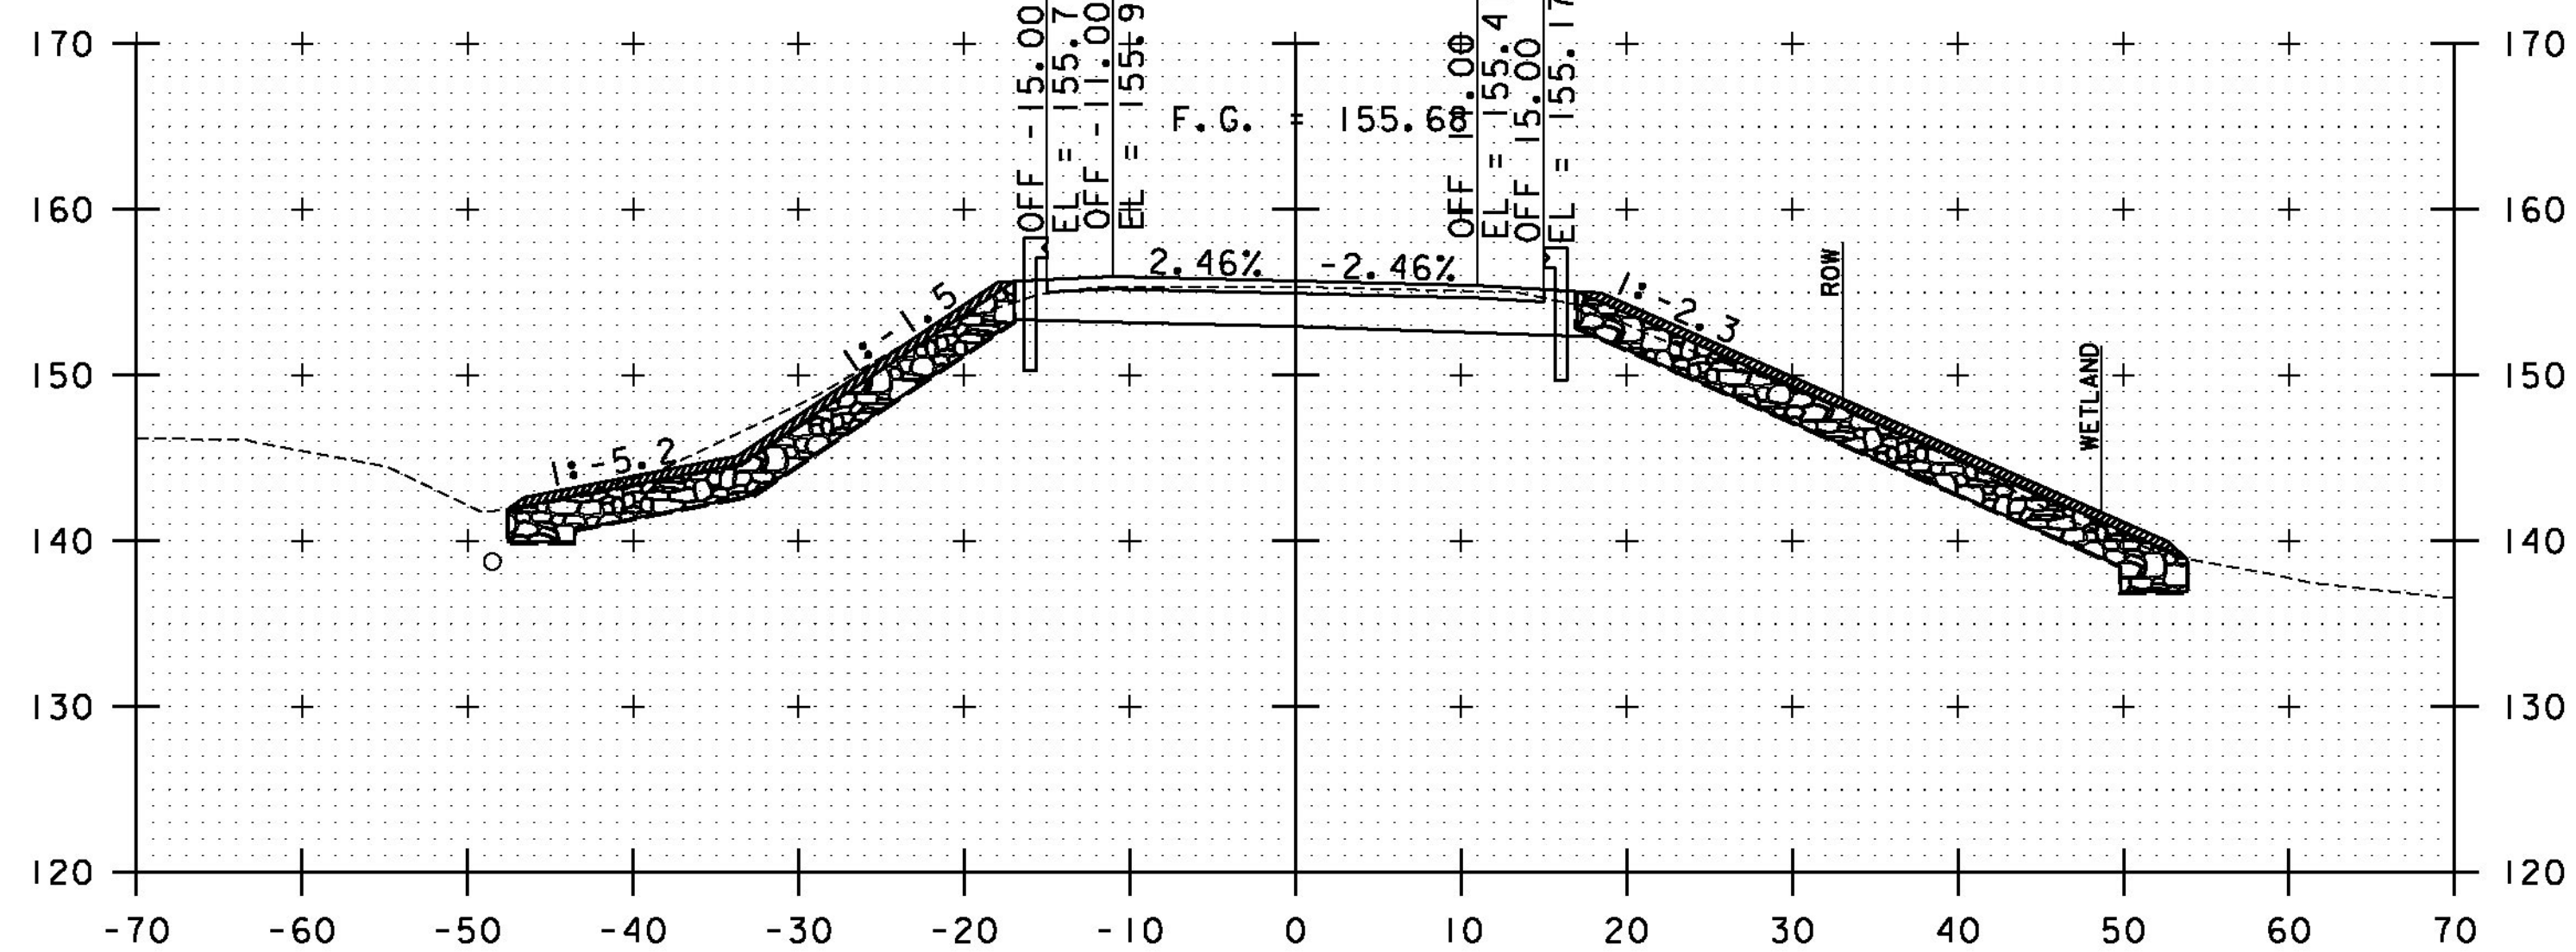

12+50

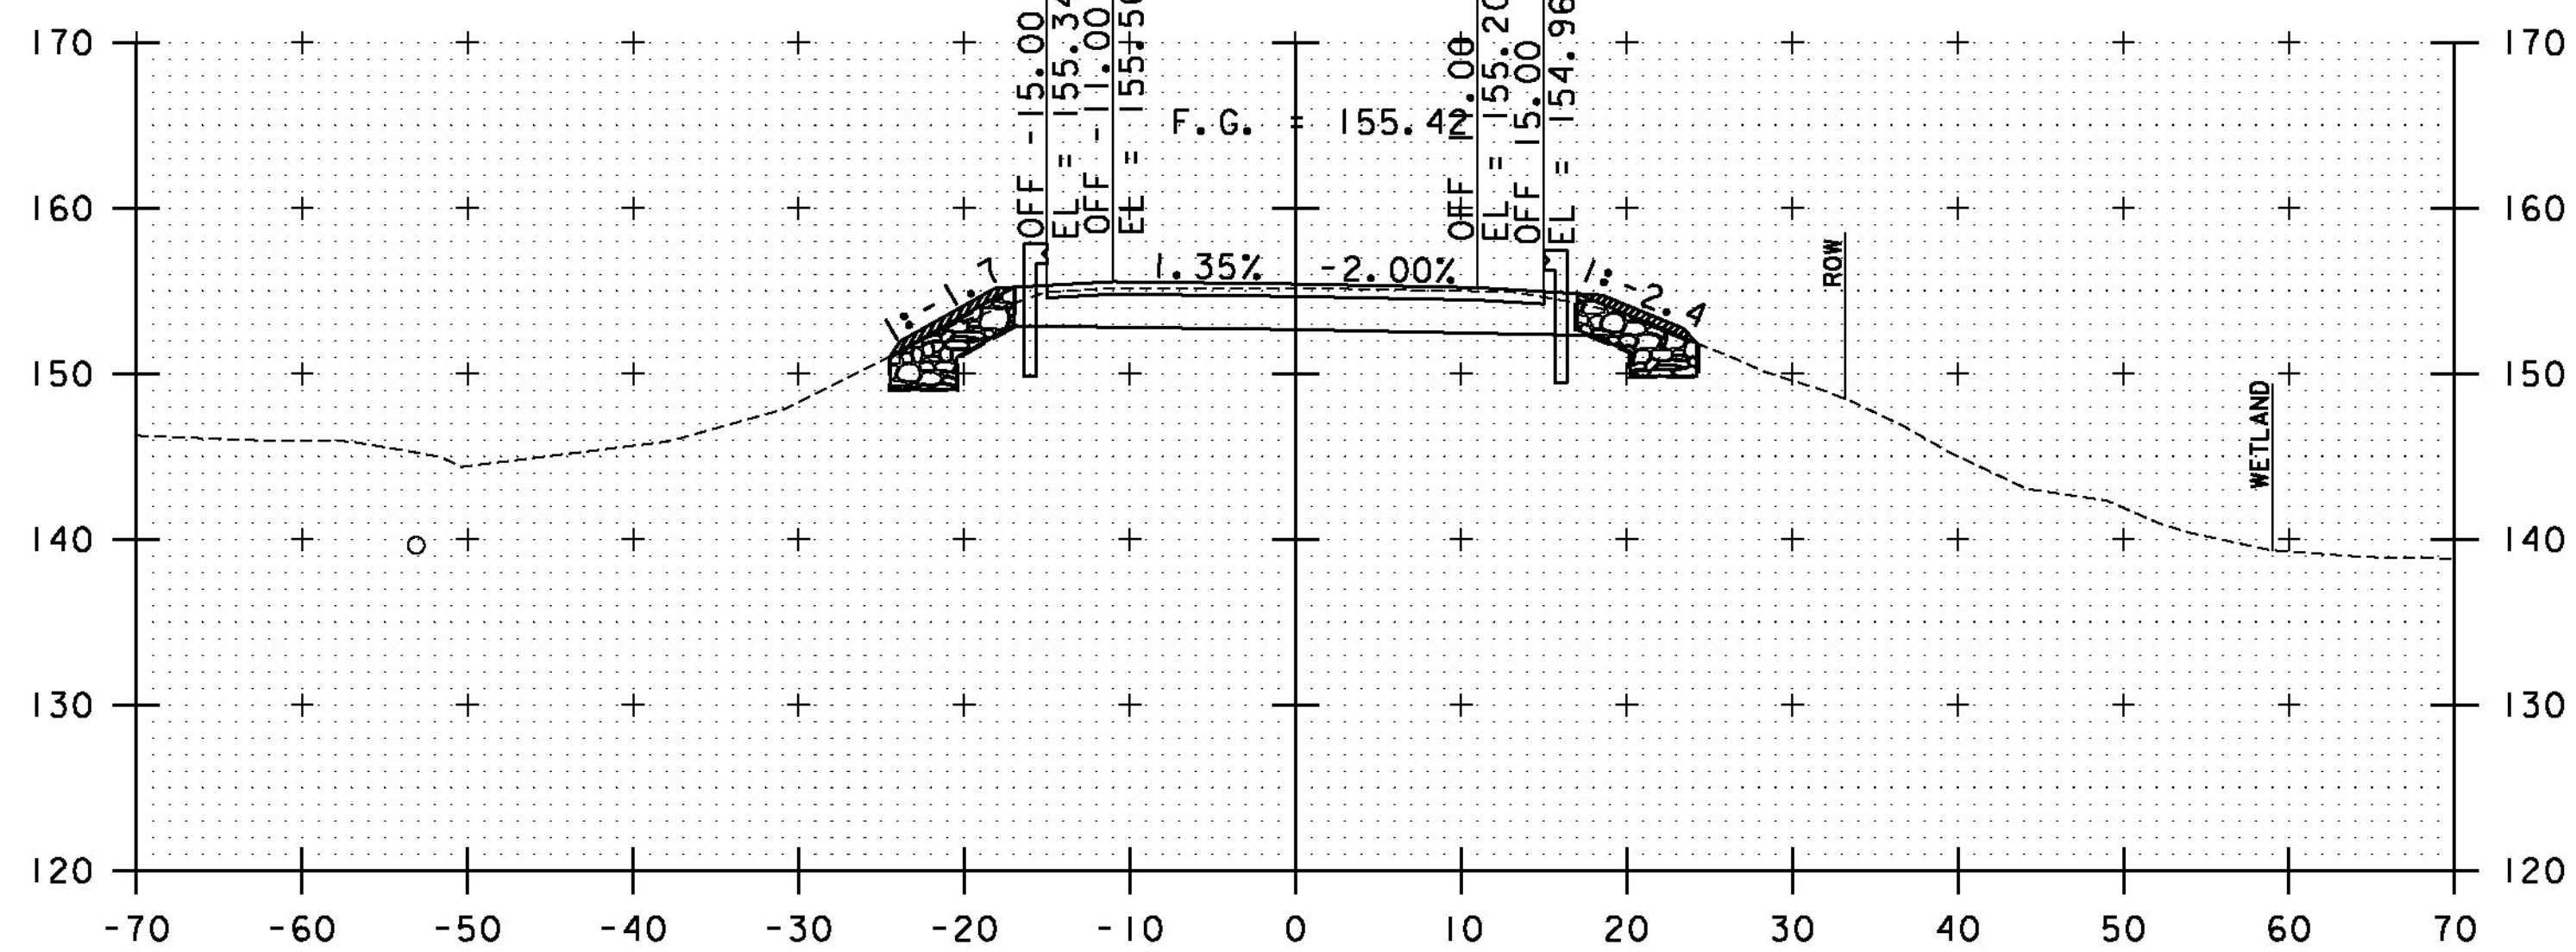

13+00  
12+93.82  
END BRIDGE

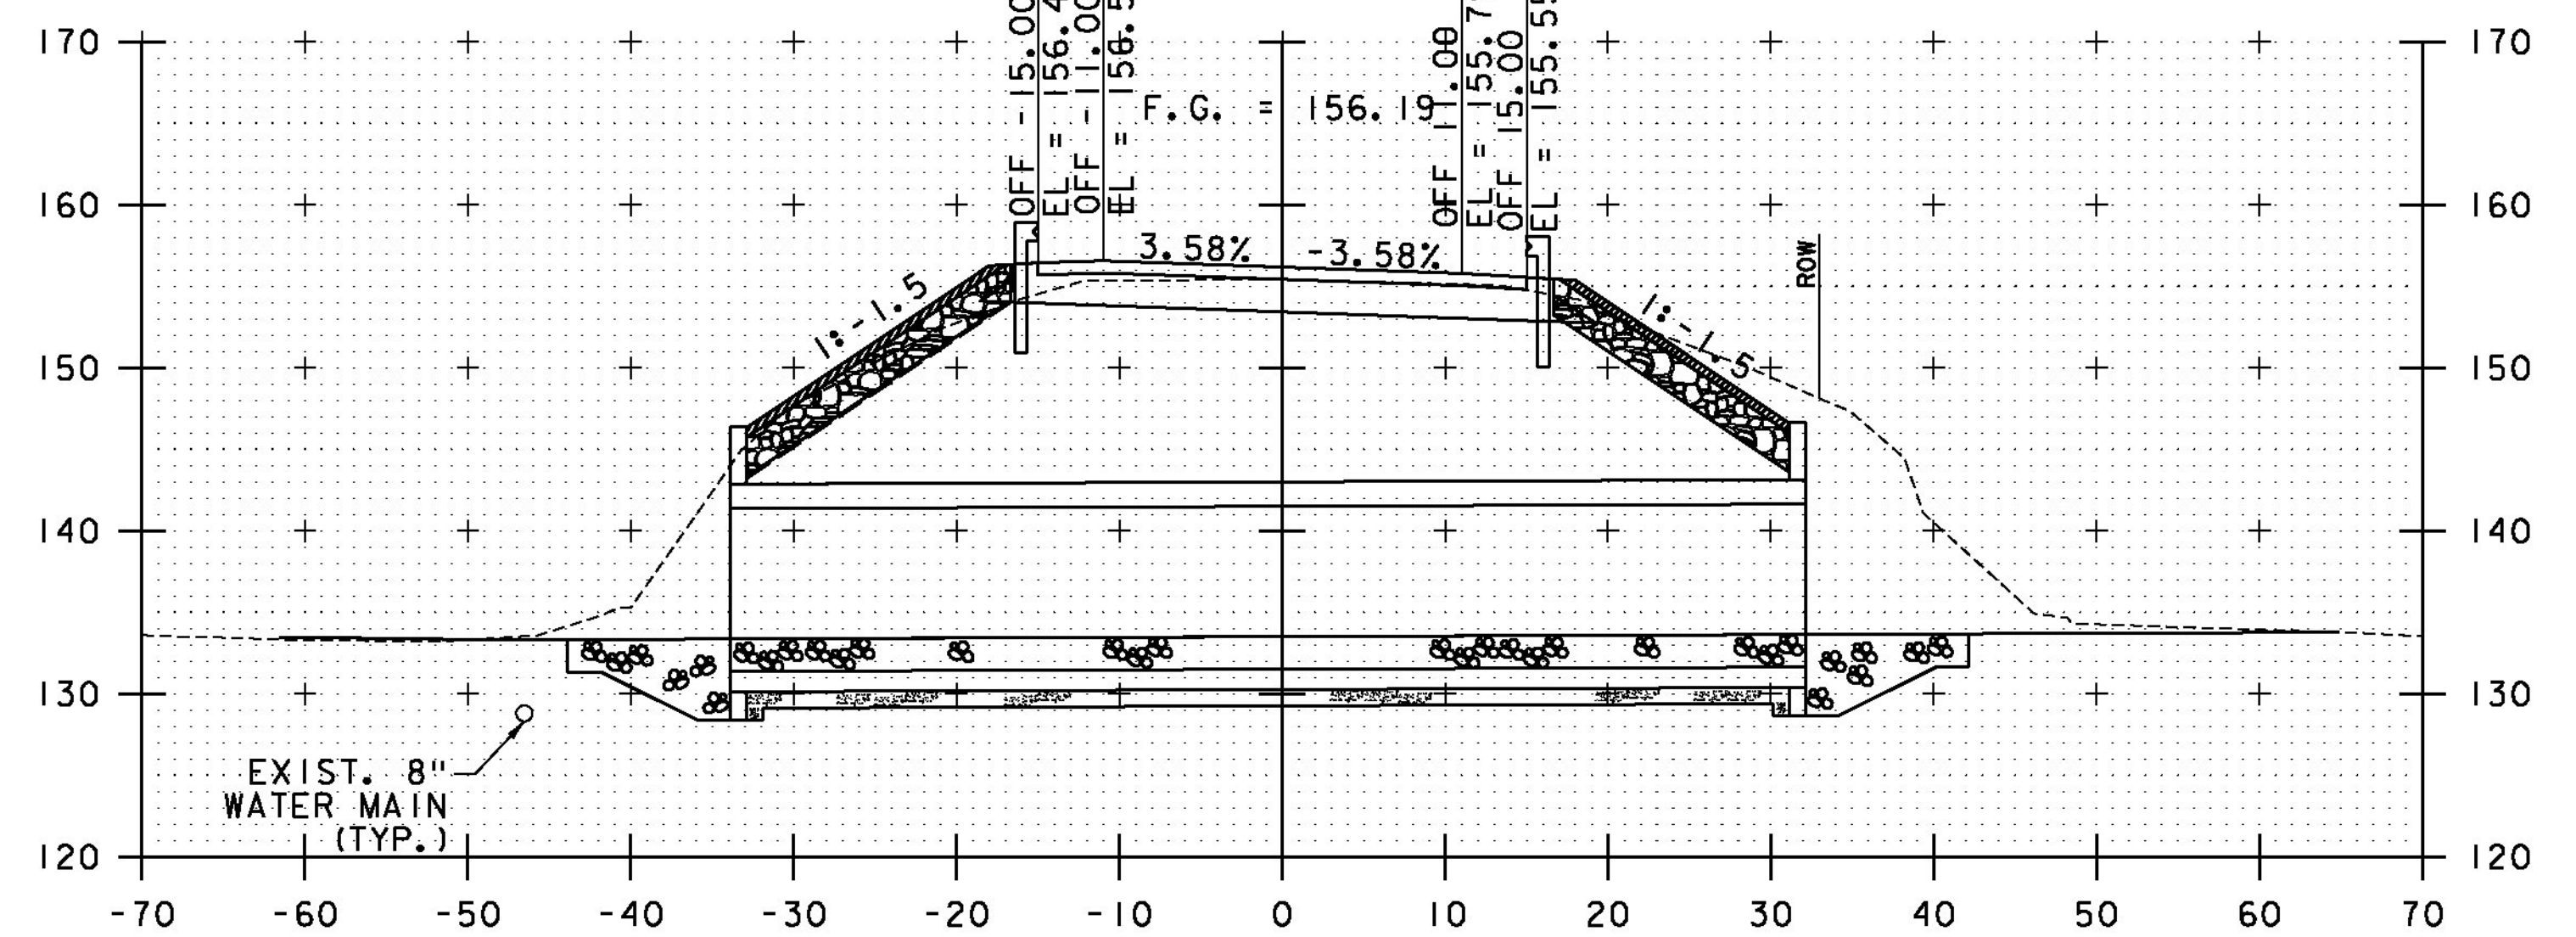

12+25


12+75


STA. 12+25 TO STA. 13+00

PROJECT NAME: BRIDPORT  
PROJECT NUMBER: STP CULV(29)


FILE NAME: zllc264xs_br2.dgn  
PROJECT LEADER: M. CHENETTE  
DESIGNED BY: J. HUNGERFORD  
ROADWAY CROSS SECTIONS - RXS2 - BR2

PLOT DATE: 8/22/2014  
DRAWN BY: L. BUXTON  
CHECKED BY: M. CHENETTE  
SHEET 25 OF 57

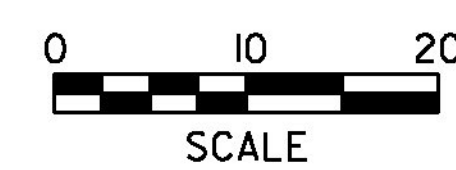


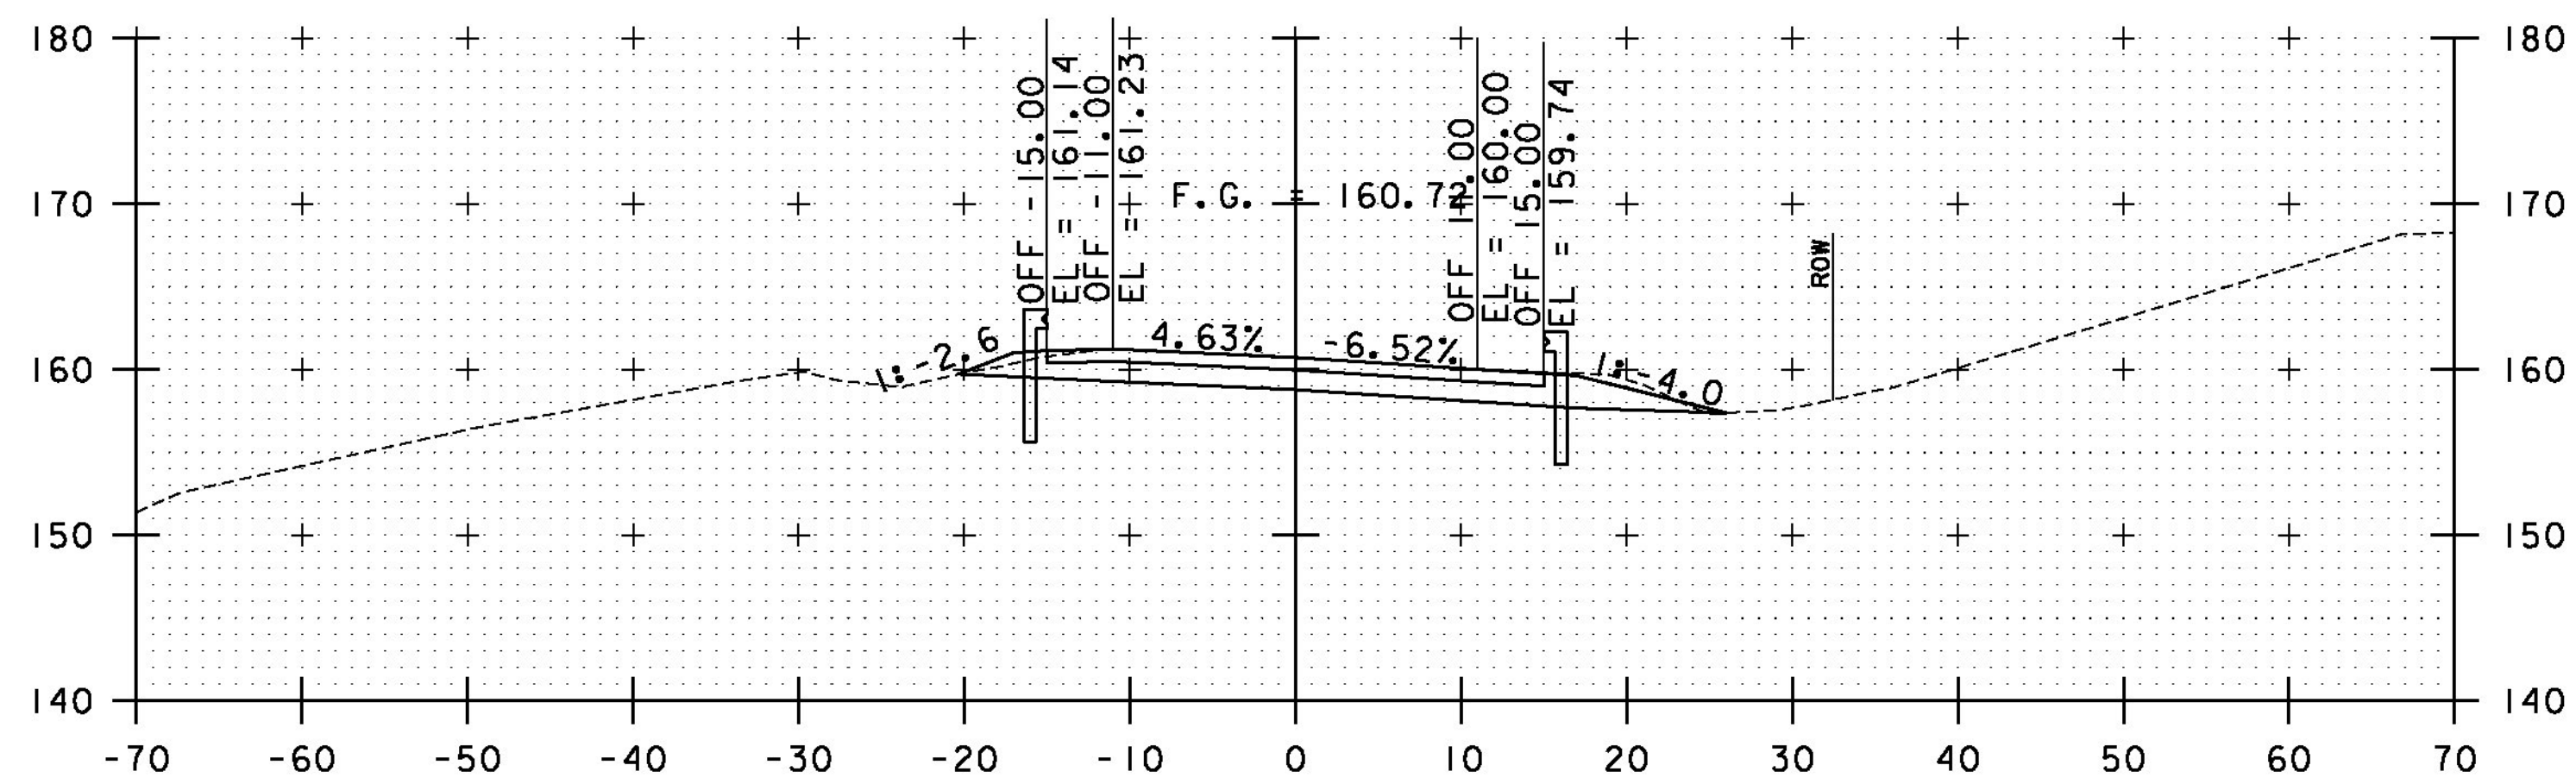


13+55  
END PROJECT

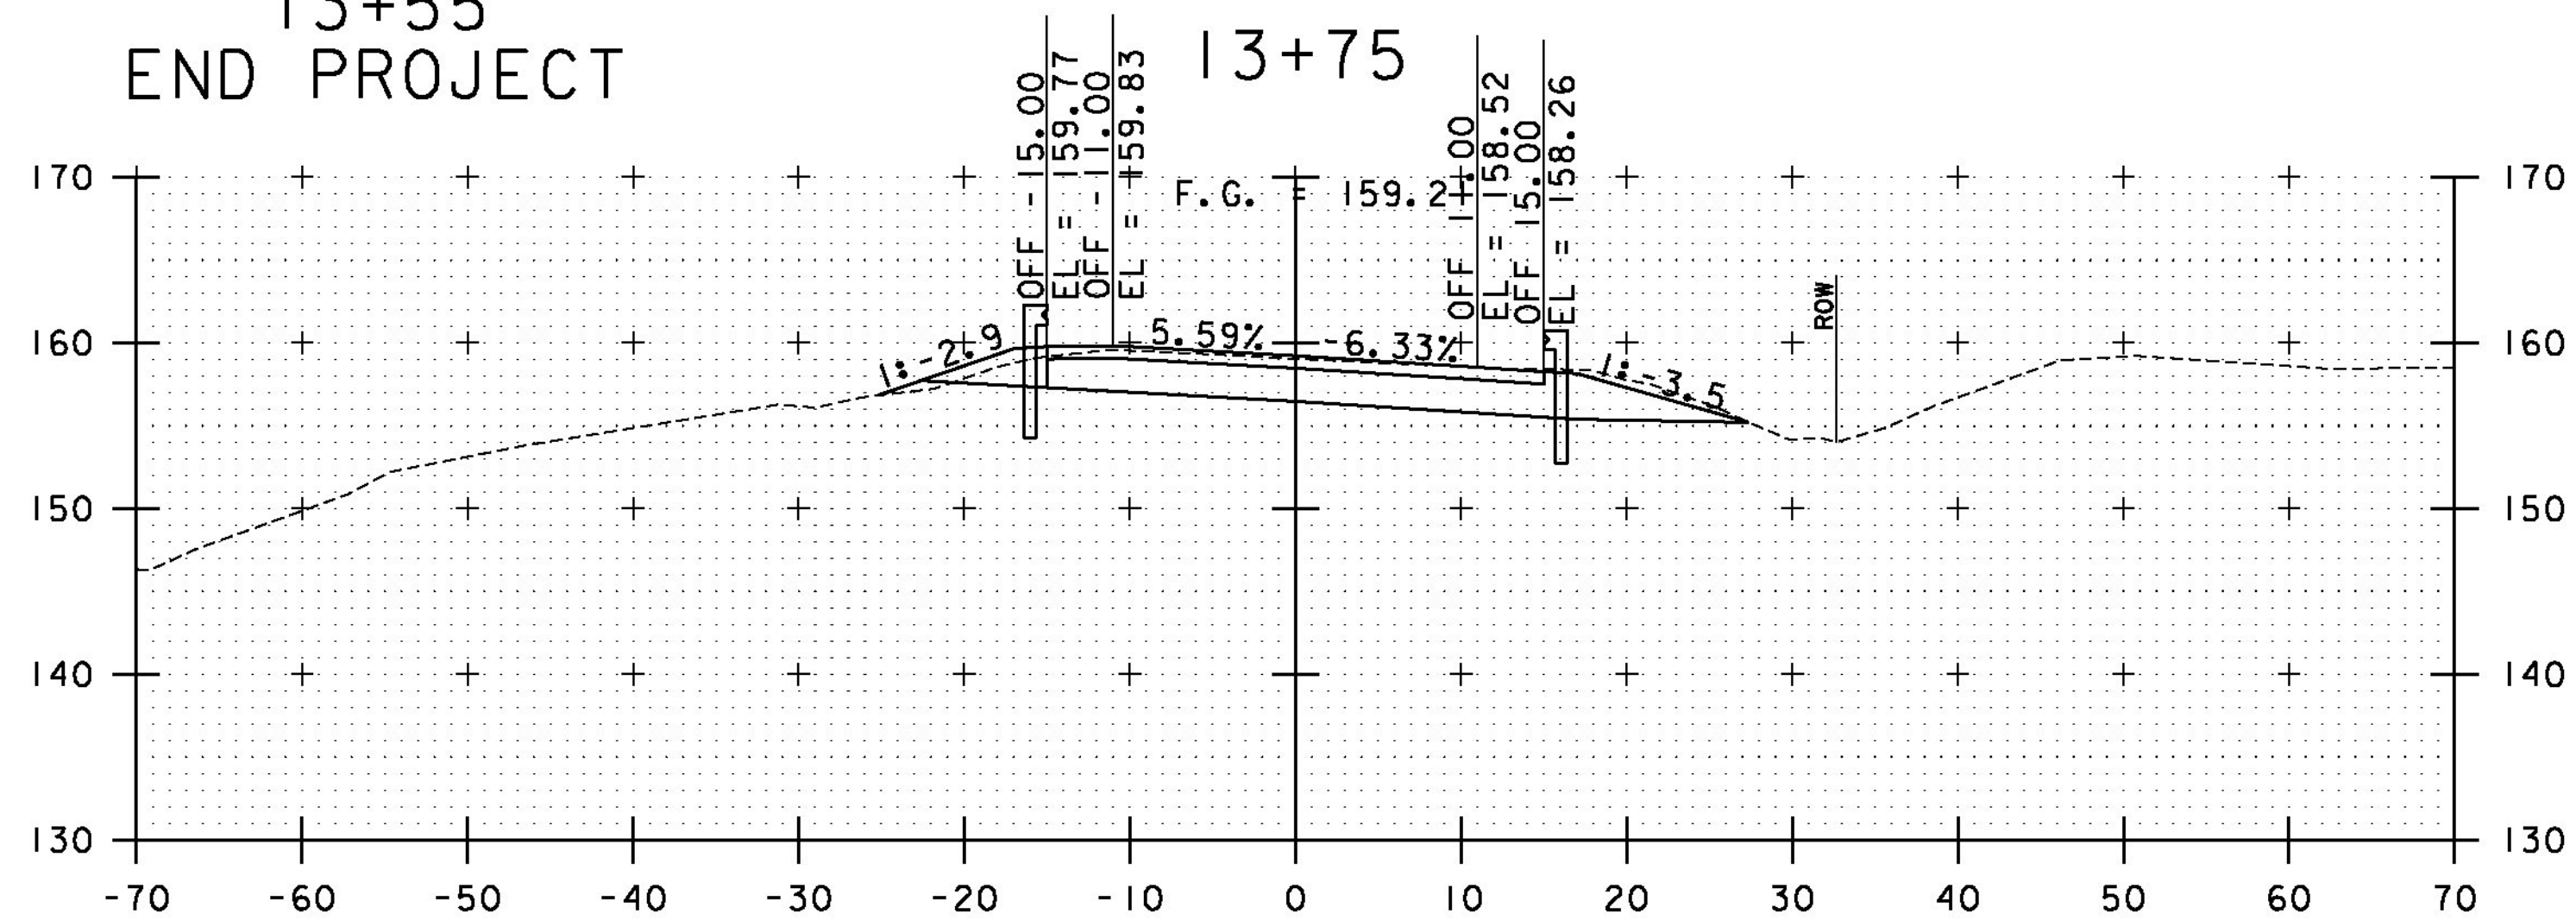


13+50

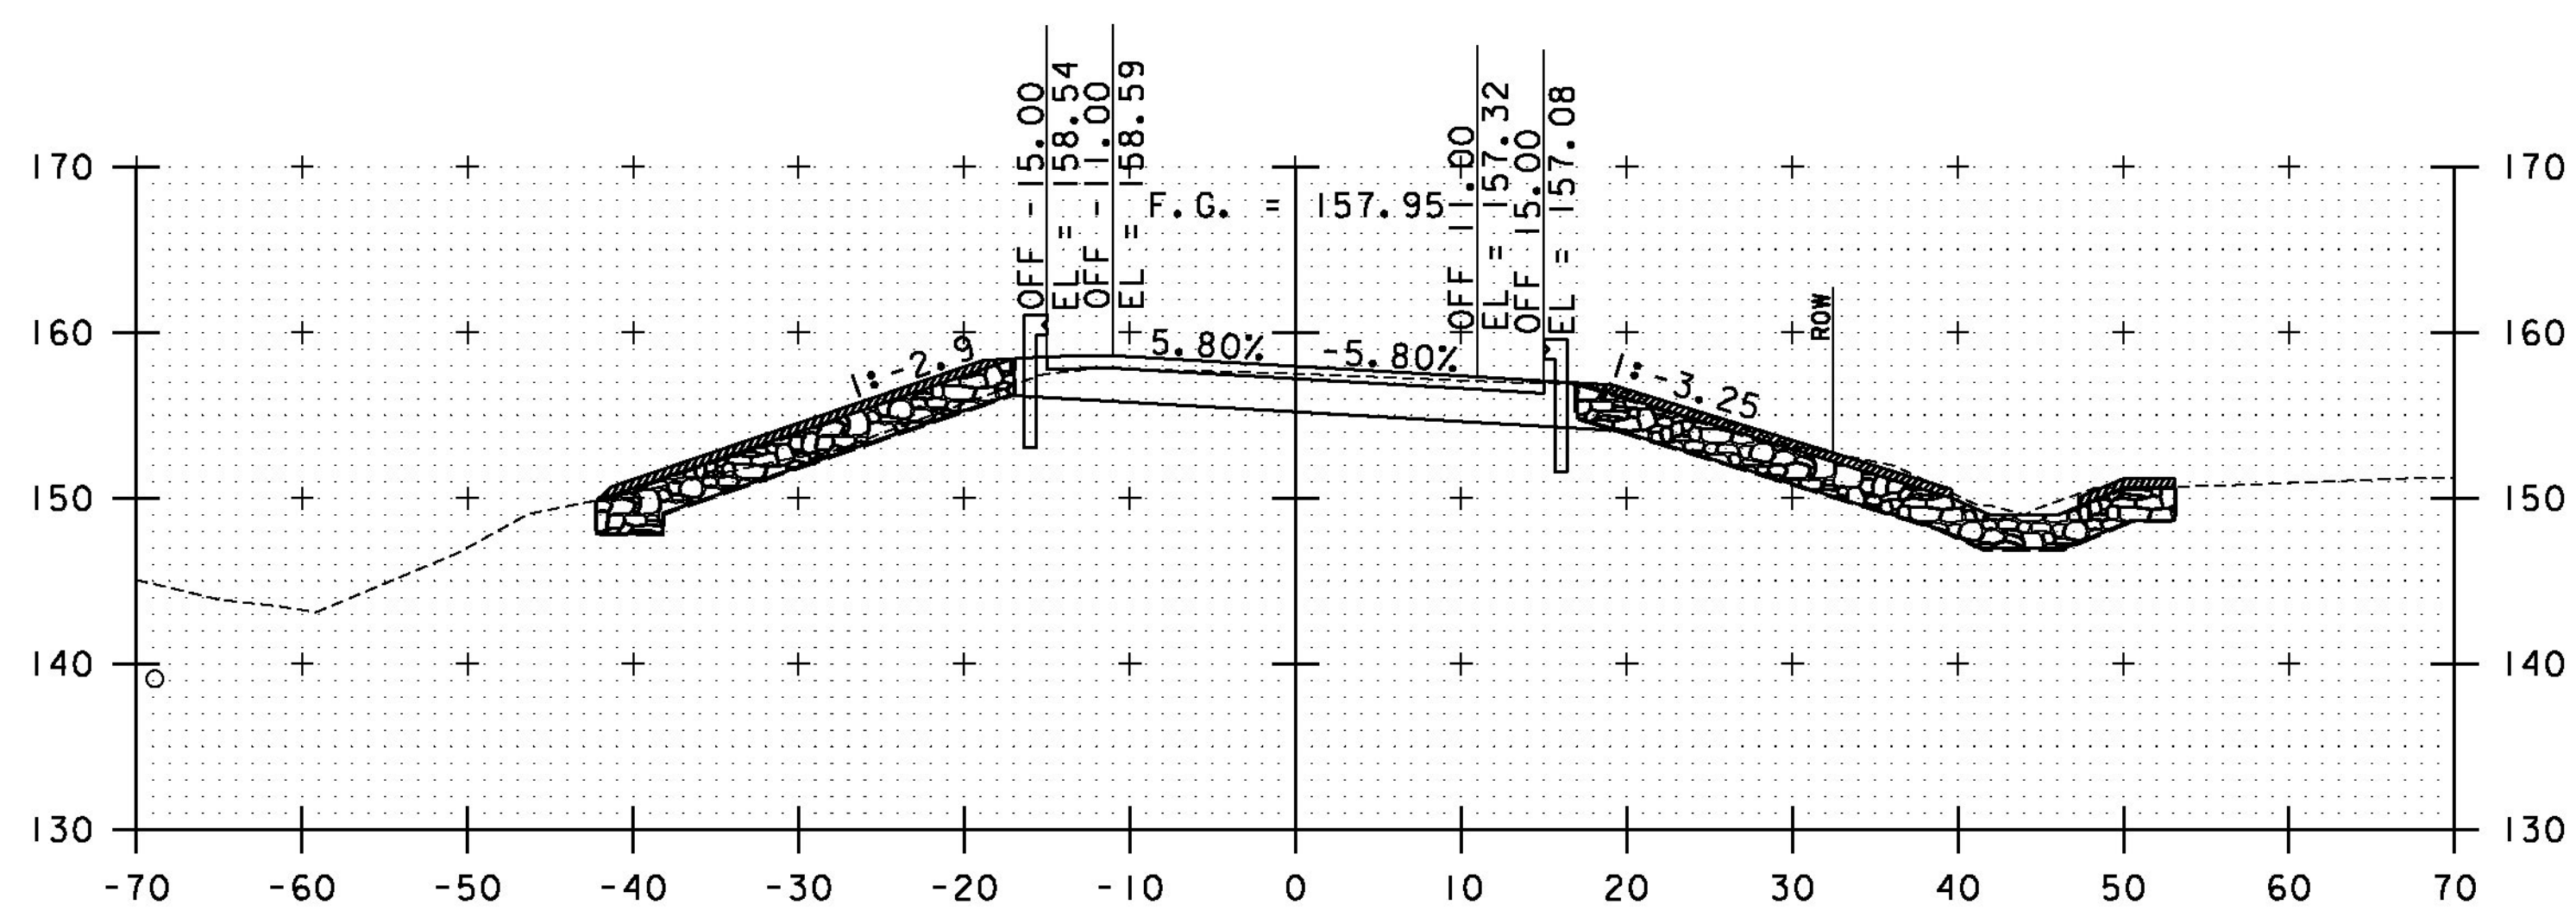

13+25

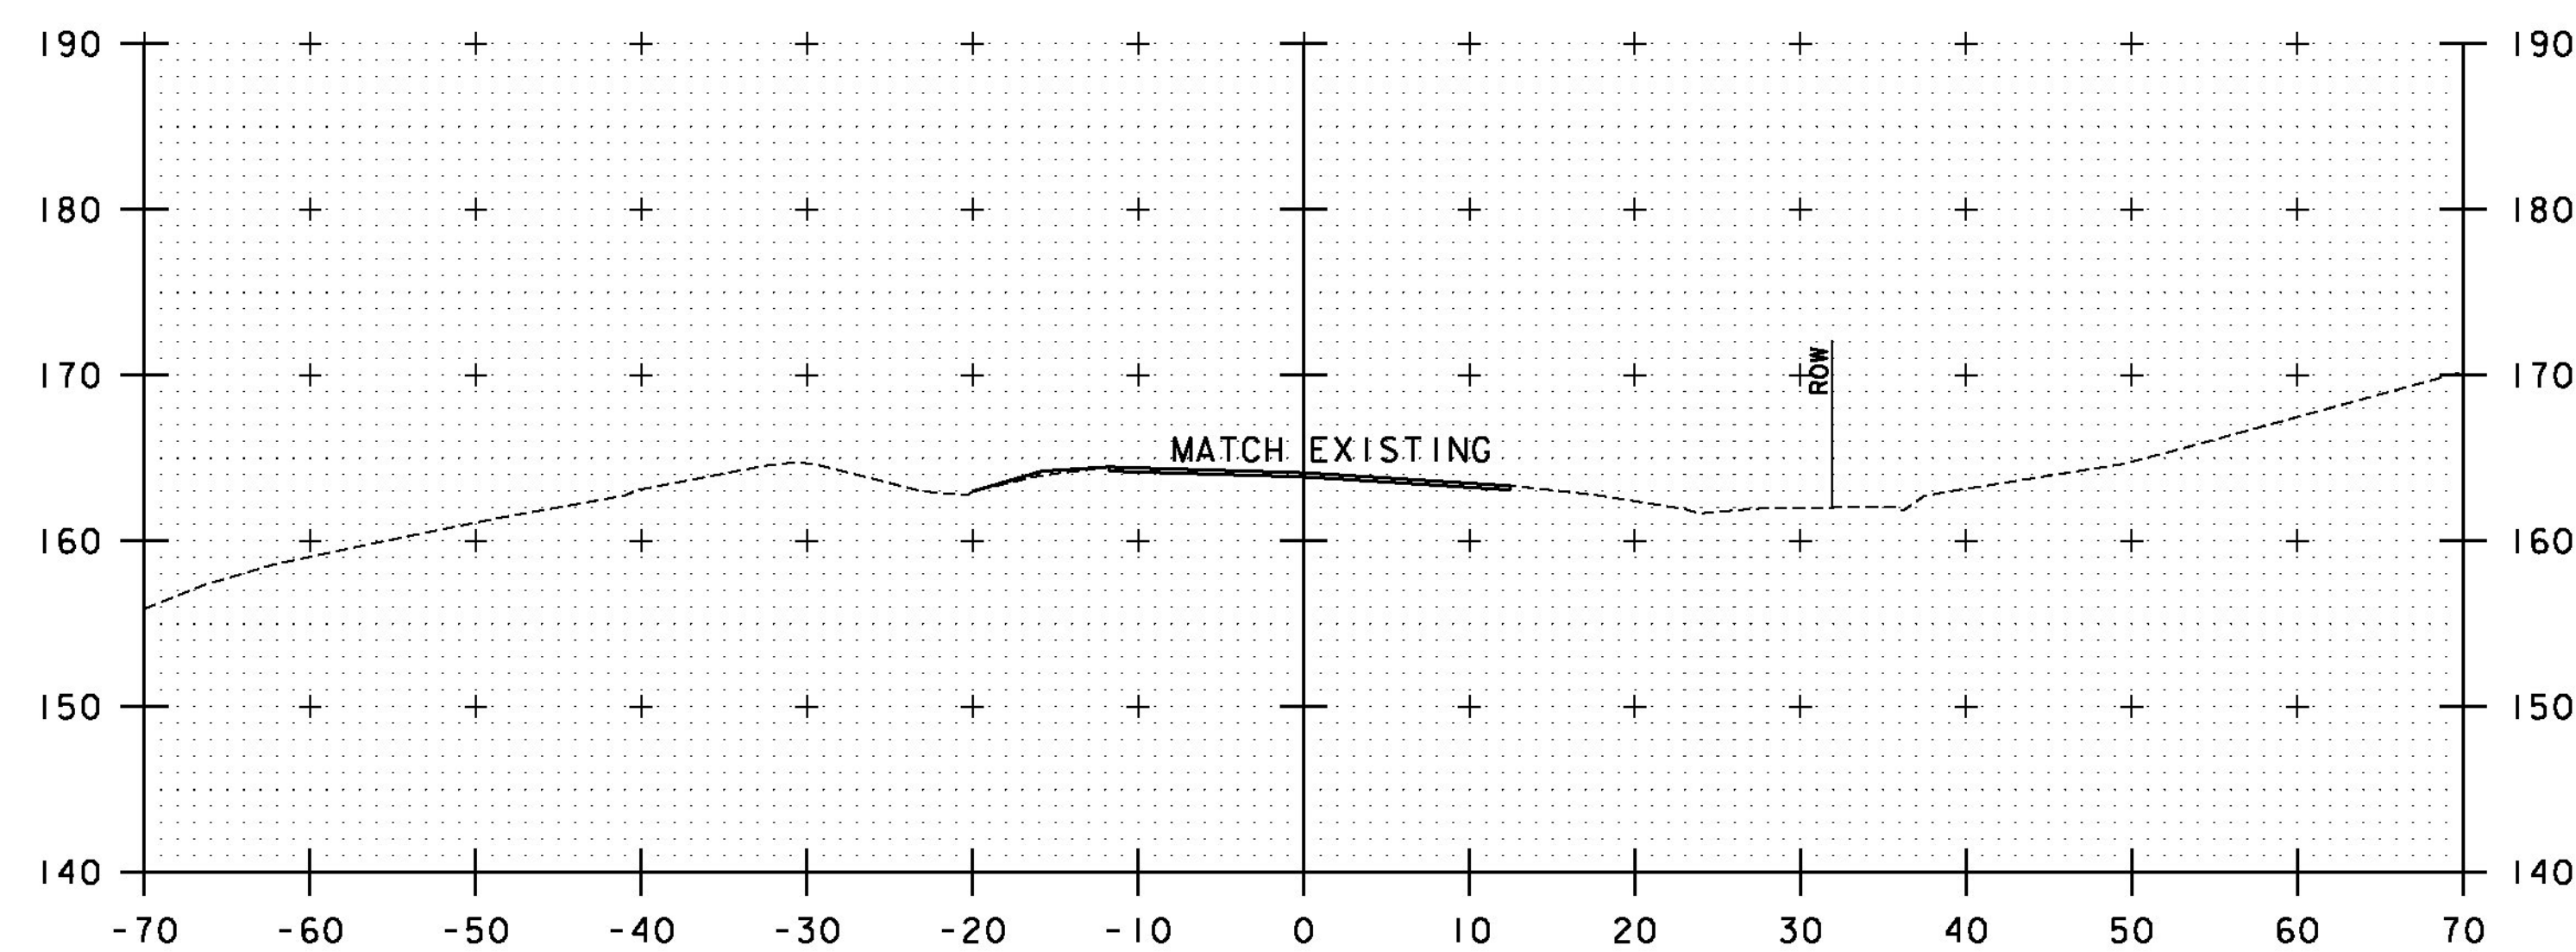

14+25

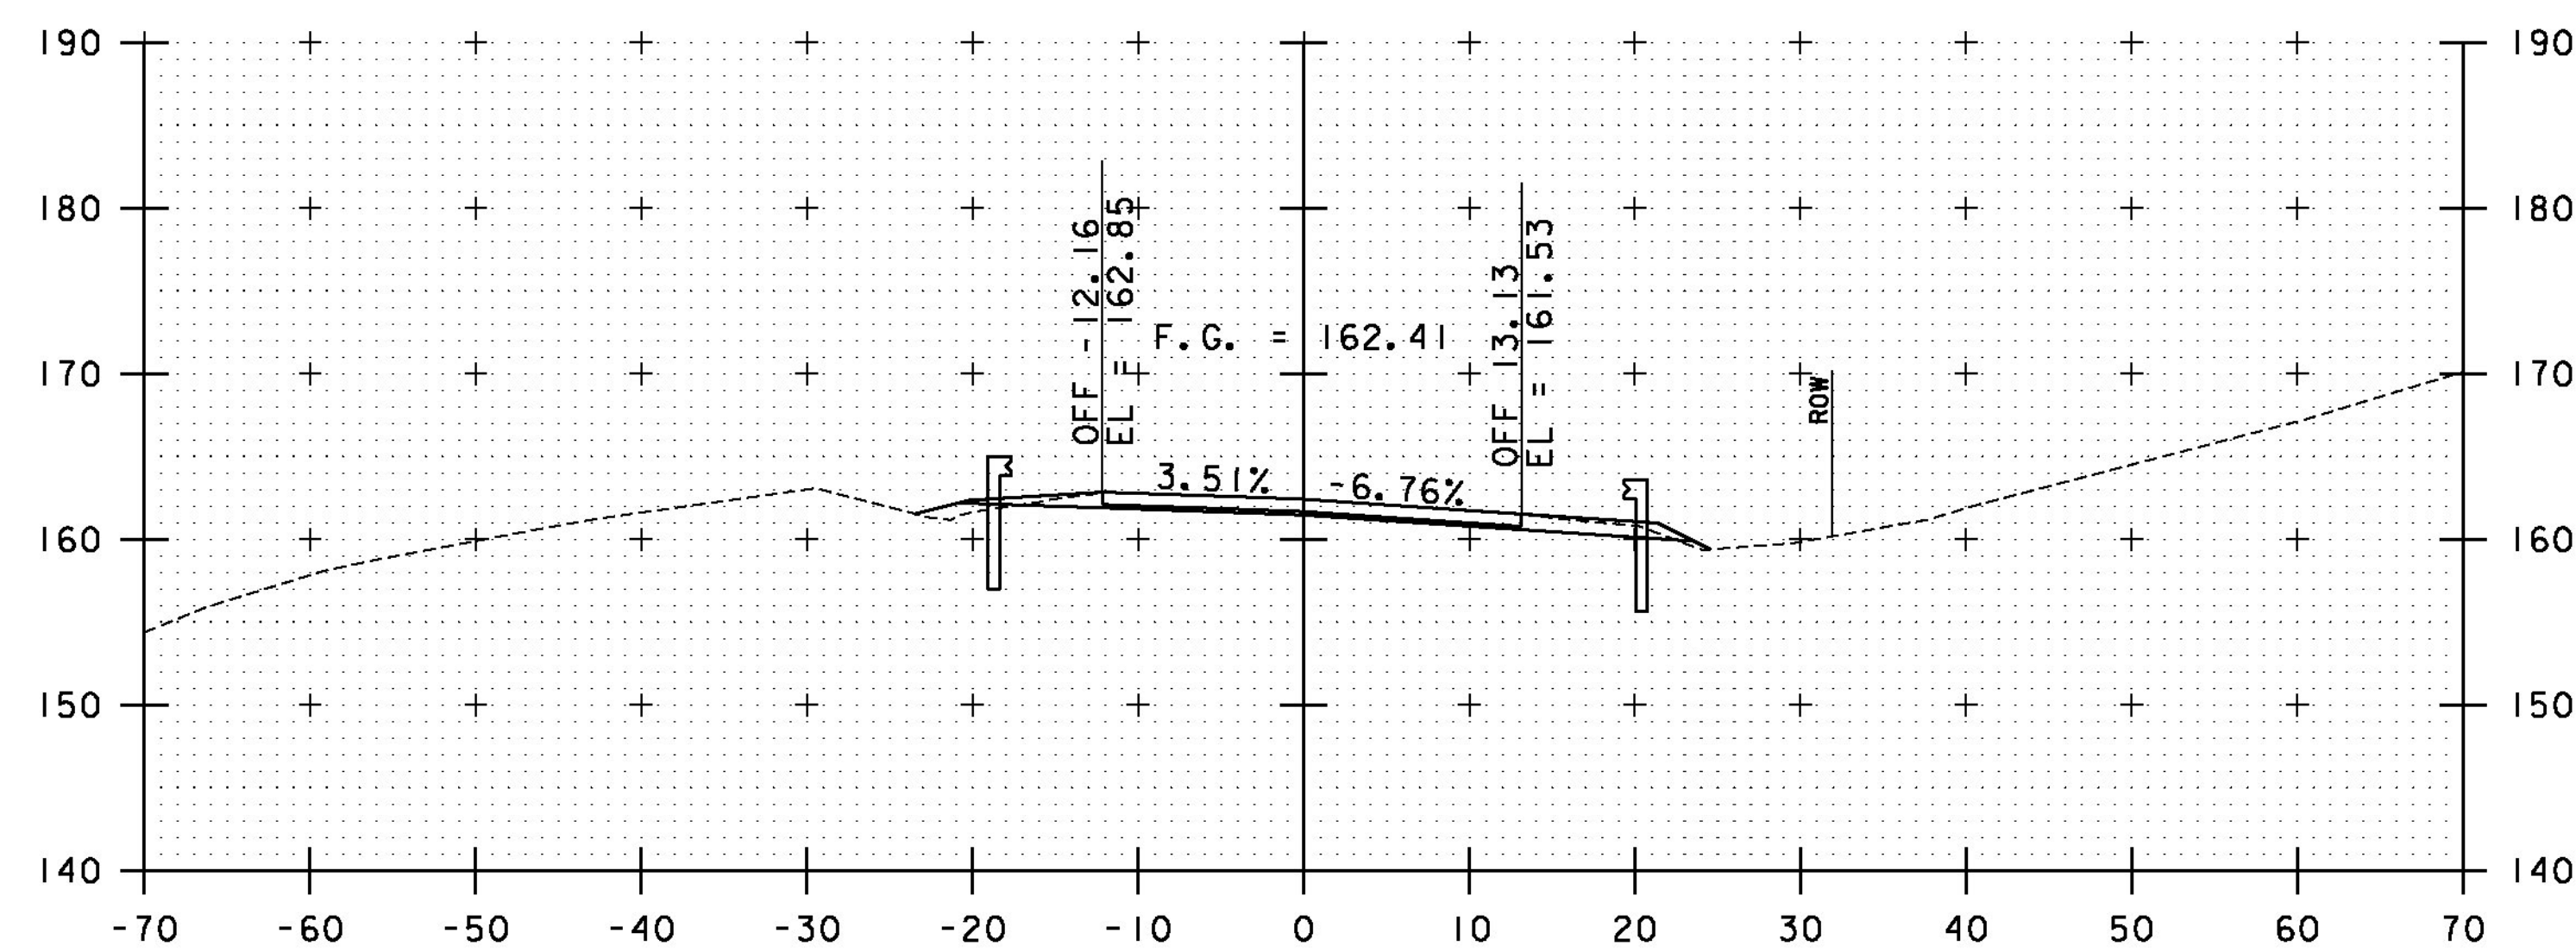


14+00


STA. 13+25 TO STA. 14+25

PROJECT NAME: BRIDPORT  
PROJECT NUMBER: STP CULV(29)

FILE NAME: zllc264xs_br2.dgn  
PROJECT LEADER: M. CHENETTE  
DESIGNED BY: J. HUNGERFORD  
ROADWAYCROSS SECTIONS - Rxs3 - BR2


PLOT DATE: 8/22/2014  
DRAWN BY: L. BUXTON  
CHECKED BY: M. CHENETTE  
SHEET 26 OF 57

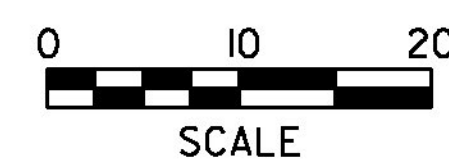

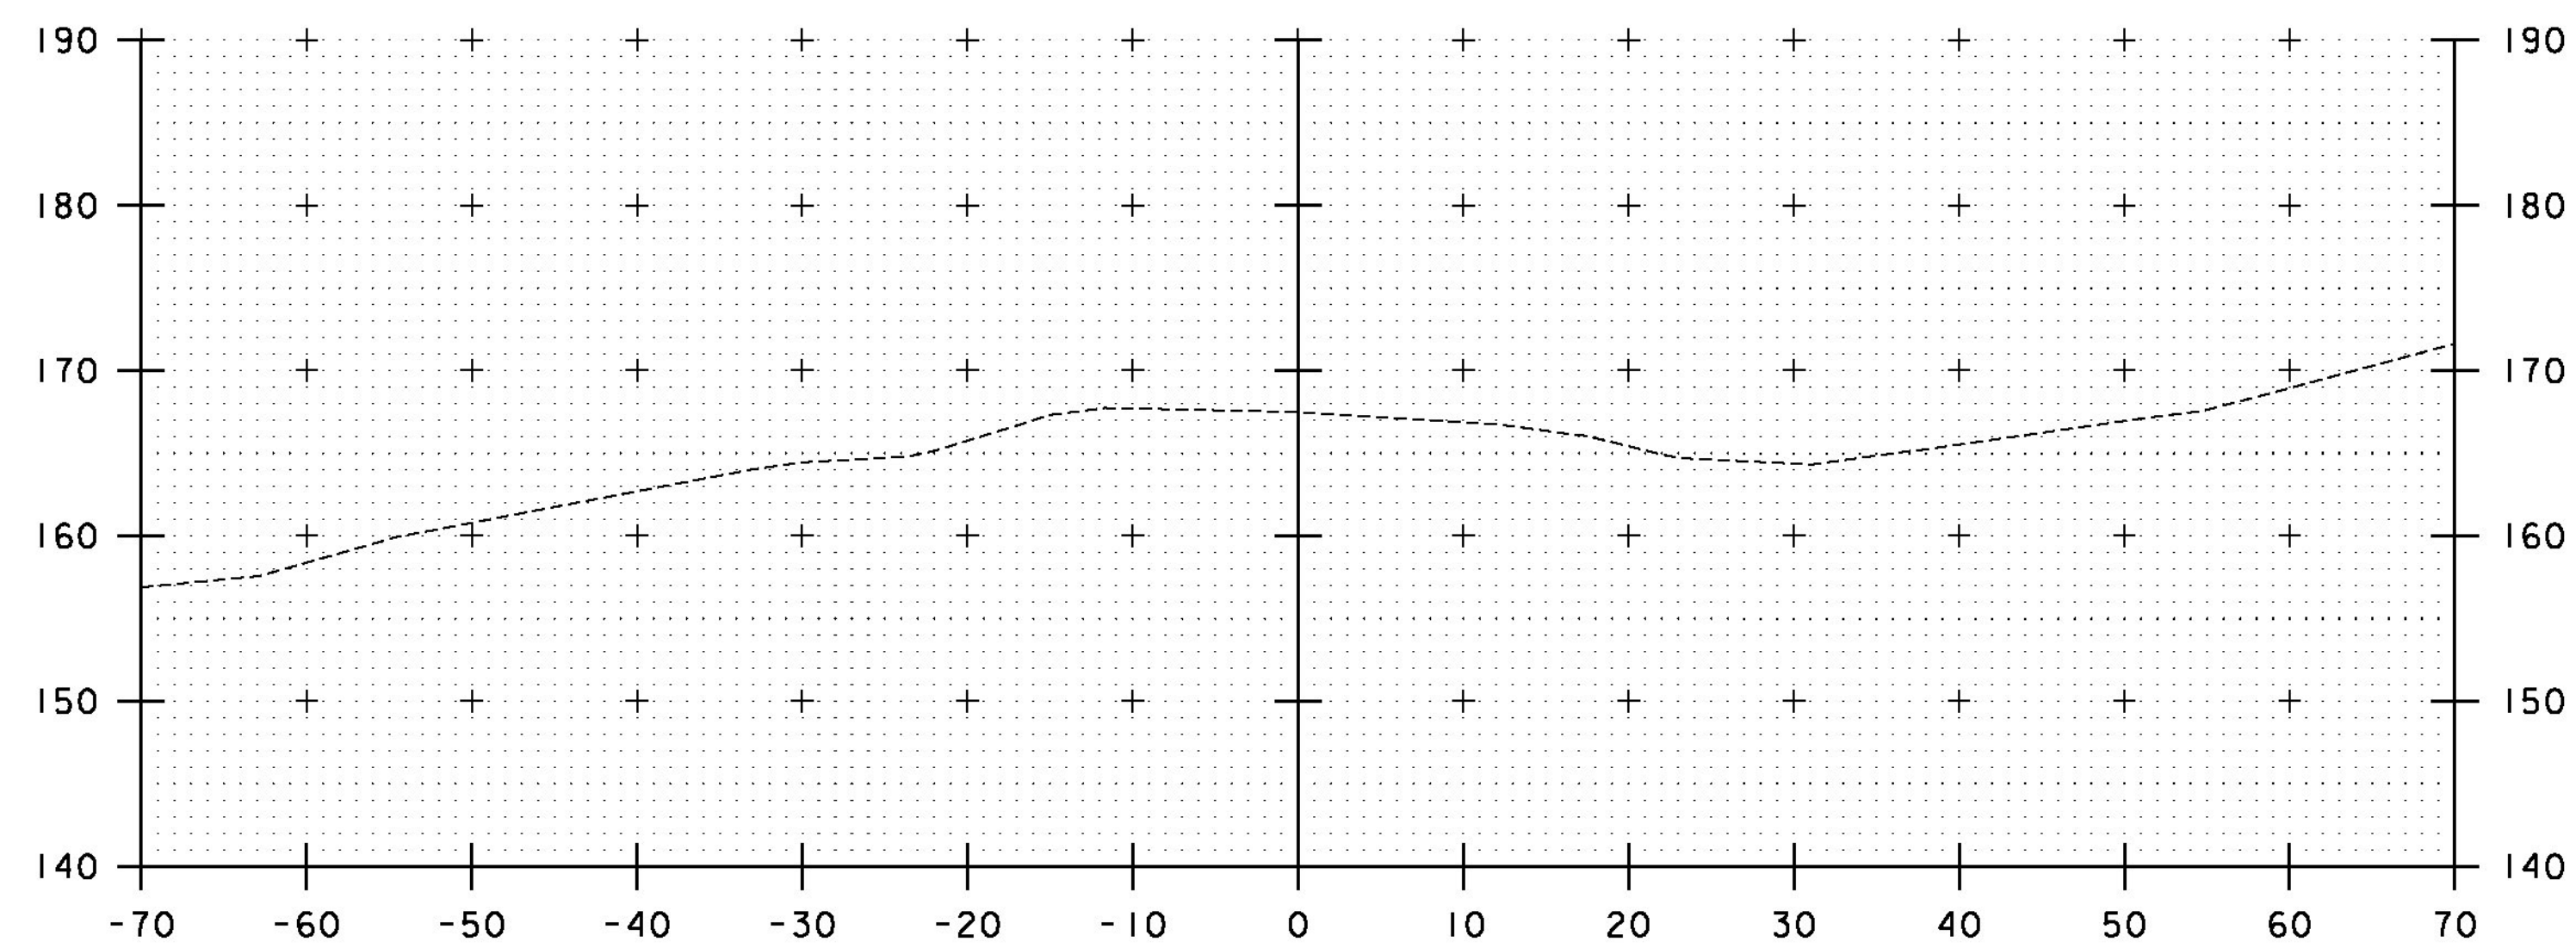

14+55  
END APPROACH

14+75

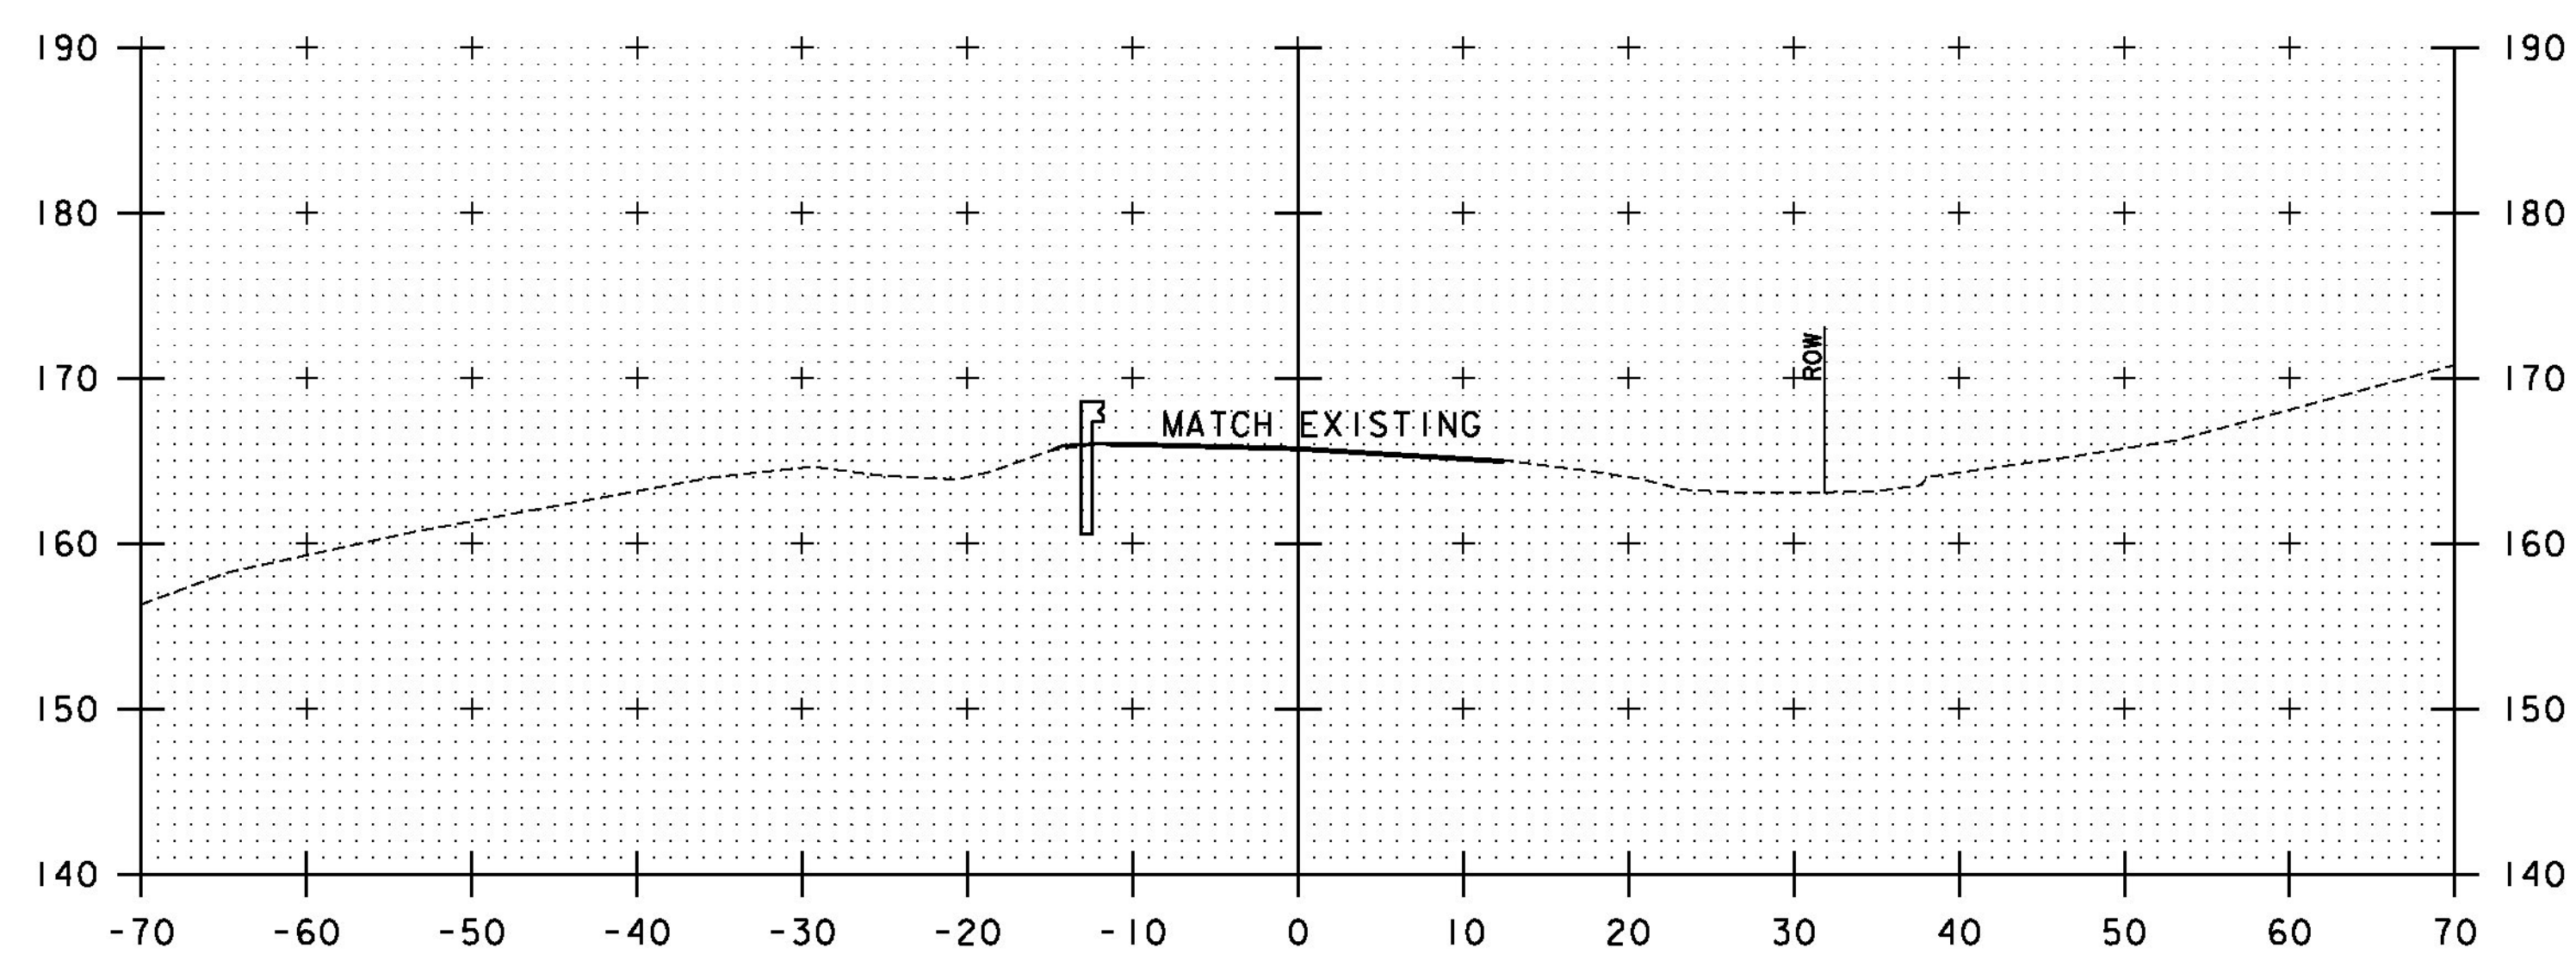


14+50


STA. 14+50 TO STA. 14+75

PROJECT NAME: BRIDPORT  
PROJECT NUMBER: STP CULV(29)

FILE NAME: zllc264xs_br2.dgn  
PROJECT LEADER: M. CHENETTE  
DESIGNED BY: J. HUNGERFORD  
ROADWAY CROSS SECTIONS - RXS4 - BR2


PLOT DATE: 8/22/2014  
DRAWN BY: L. BUXTON  
CHECKED BY: M. CHENETTE  
SHEET 27 OF 57

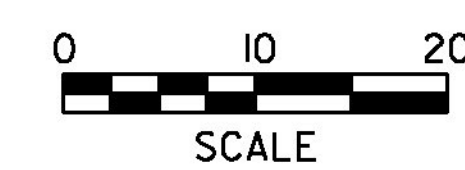

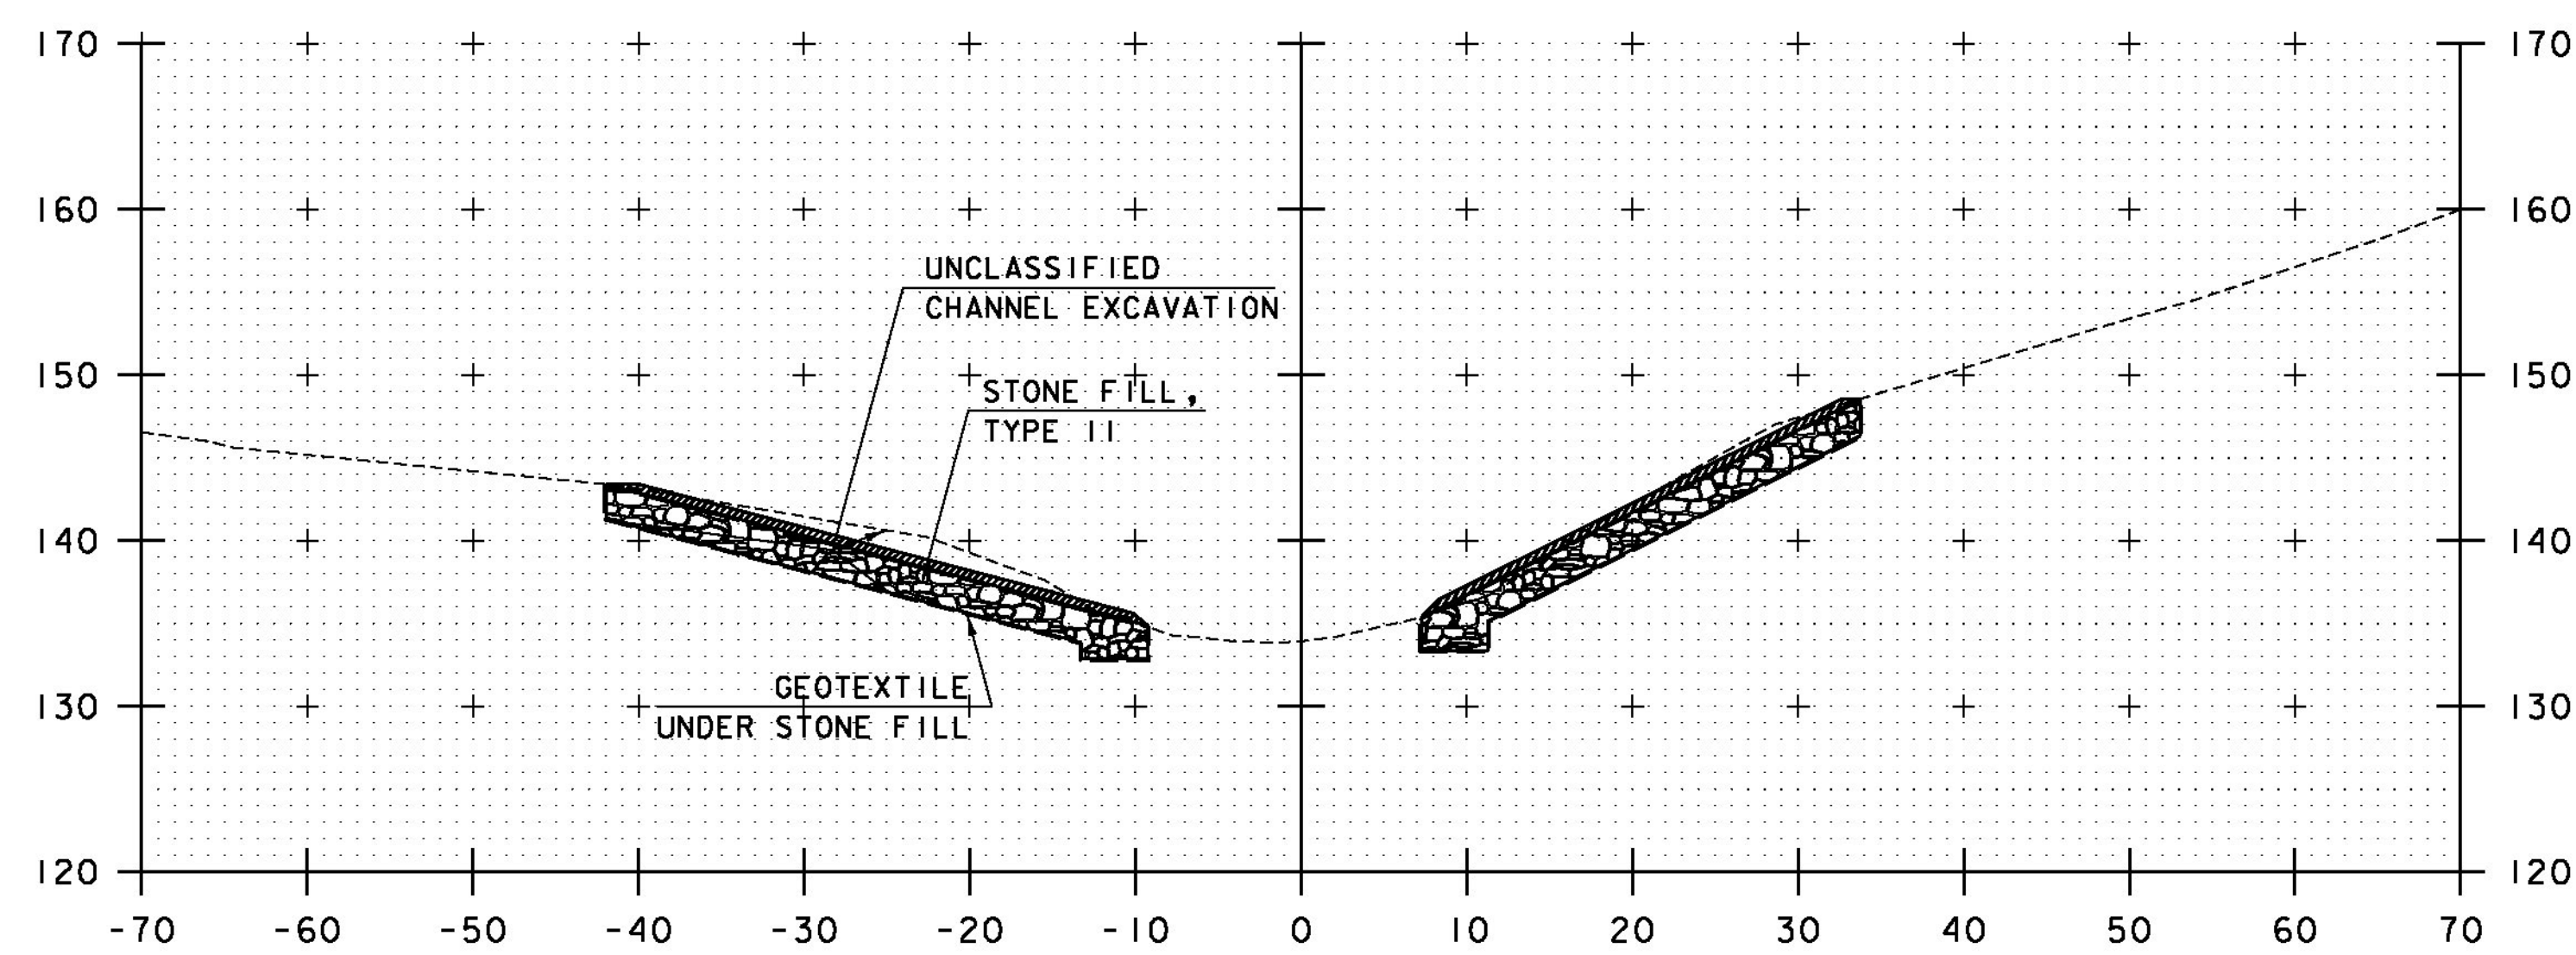


101+10

STA. 101+04 RT  
BEGIN UNCLASSIFIED CHANNEL EXCAVATION  
GEOTEXTILE UNDER STONE FILL  
STONE FILL, TYPE II  
GRUBBING MATERIAL

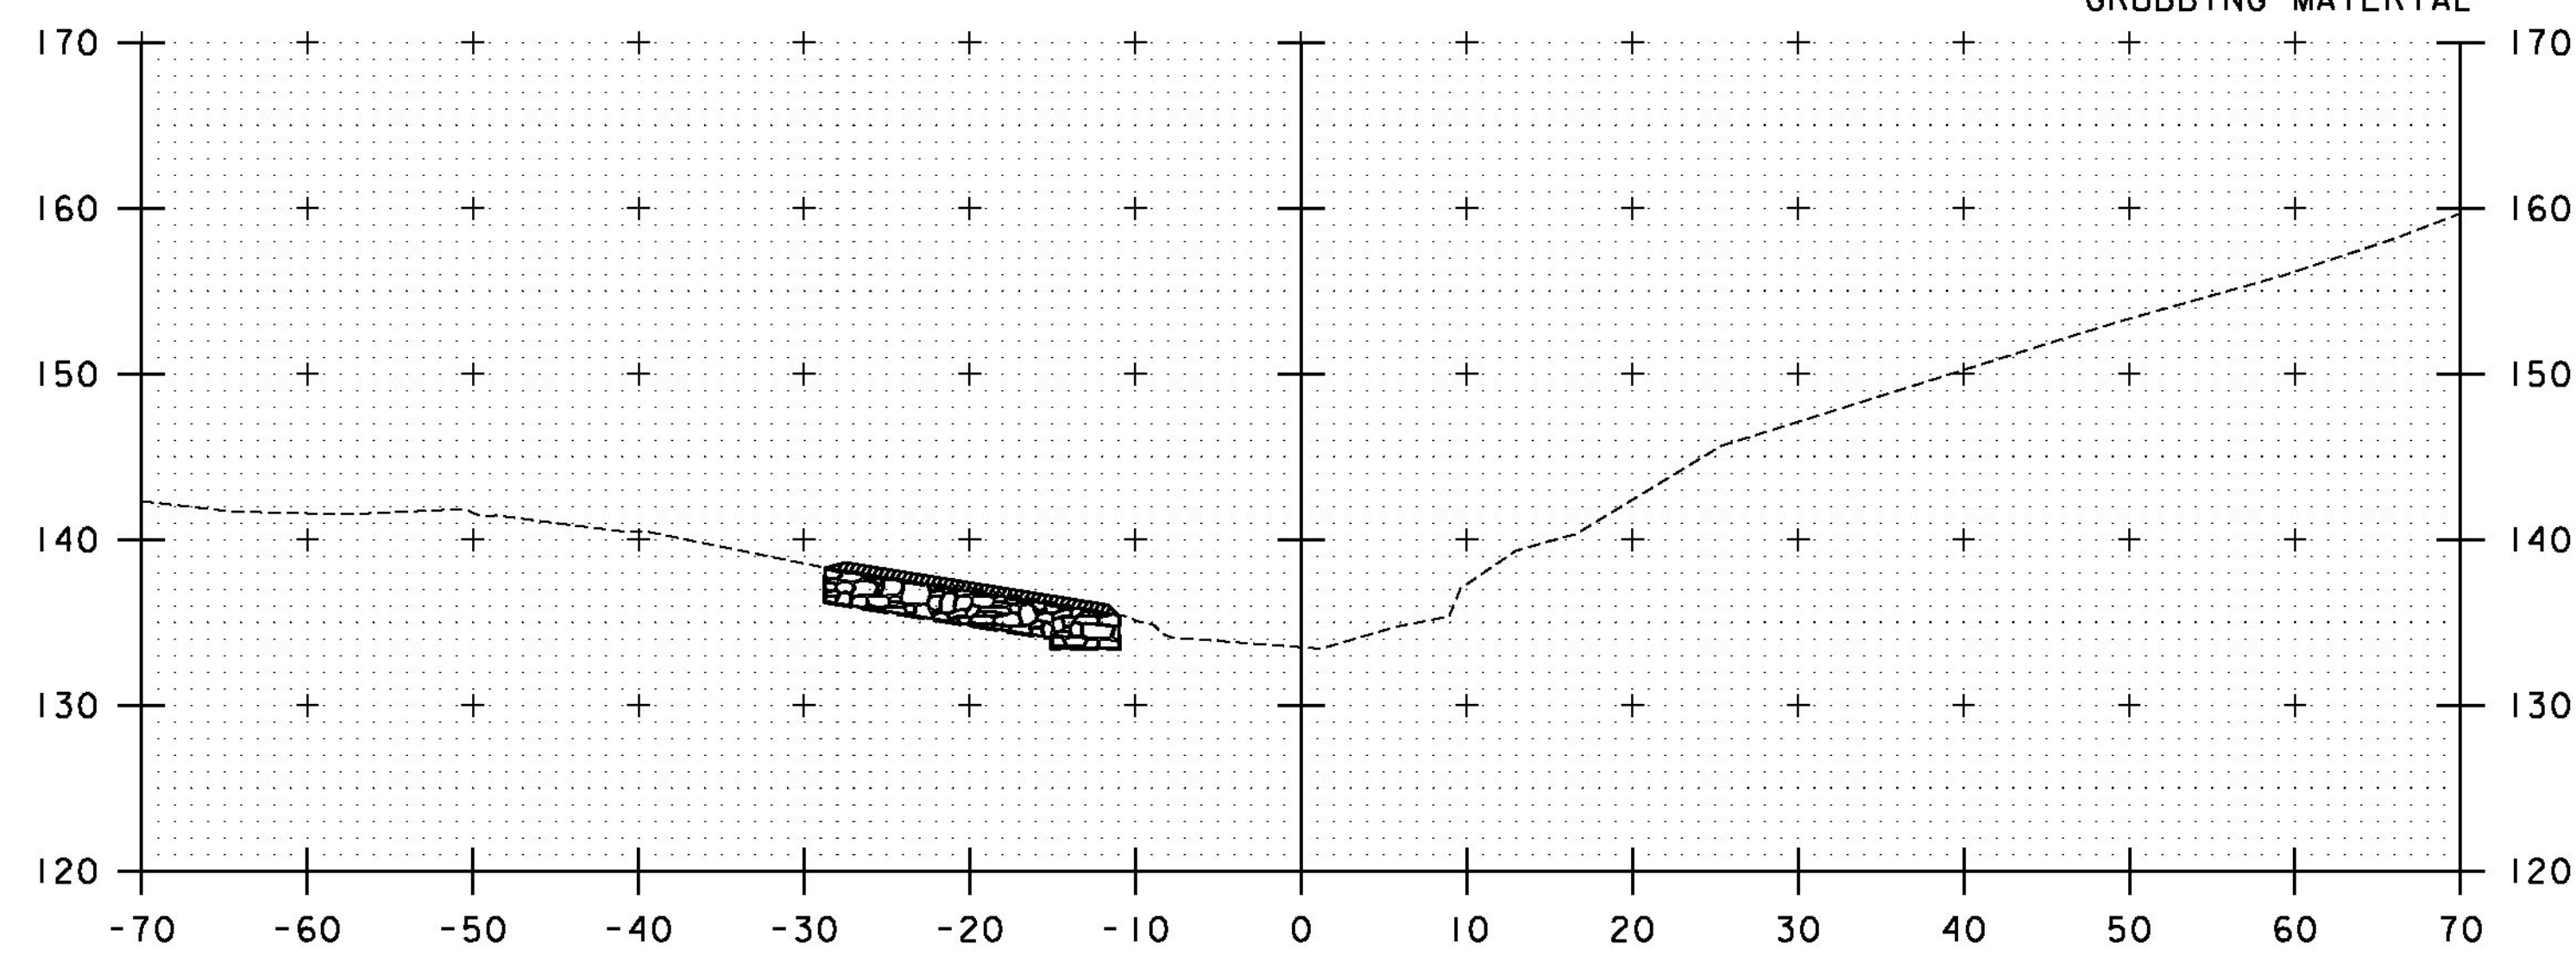

101+00


STA. 100+98 LT  
BEGIN UNCLASSIFIED CHANNEL EXCAVATION  
GEOTEXTILE UNDER STONE FILL  
STONE FILL, TYPE II  
GRUBBING MATERIAL

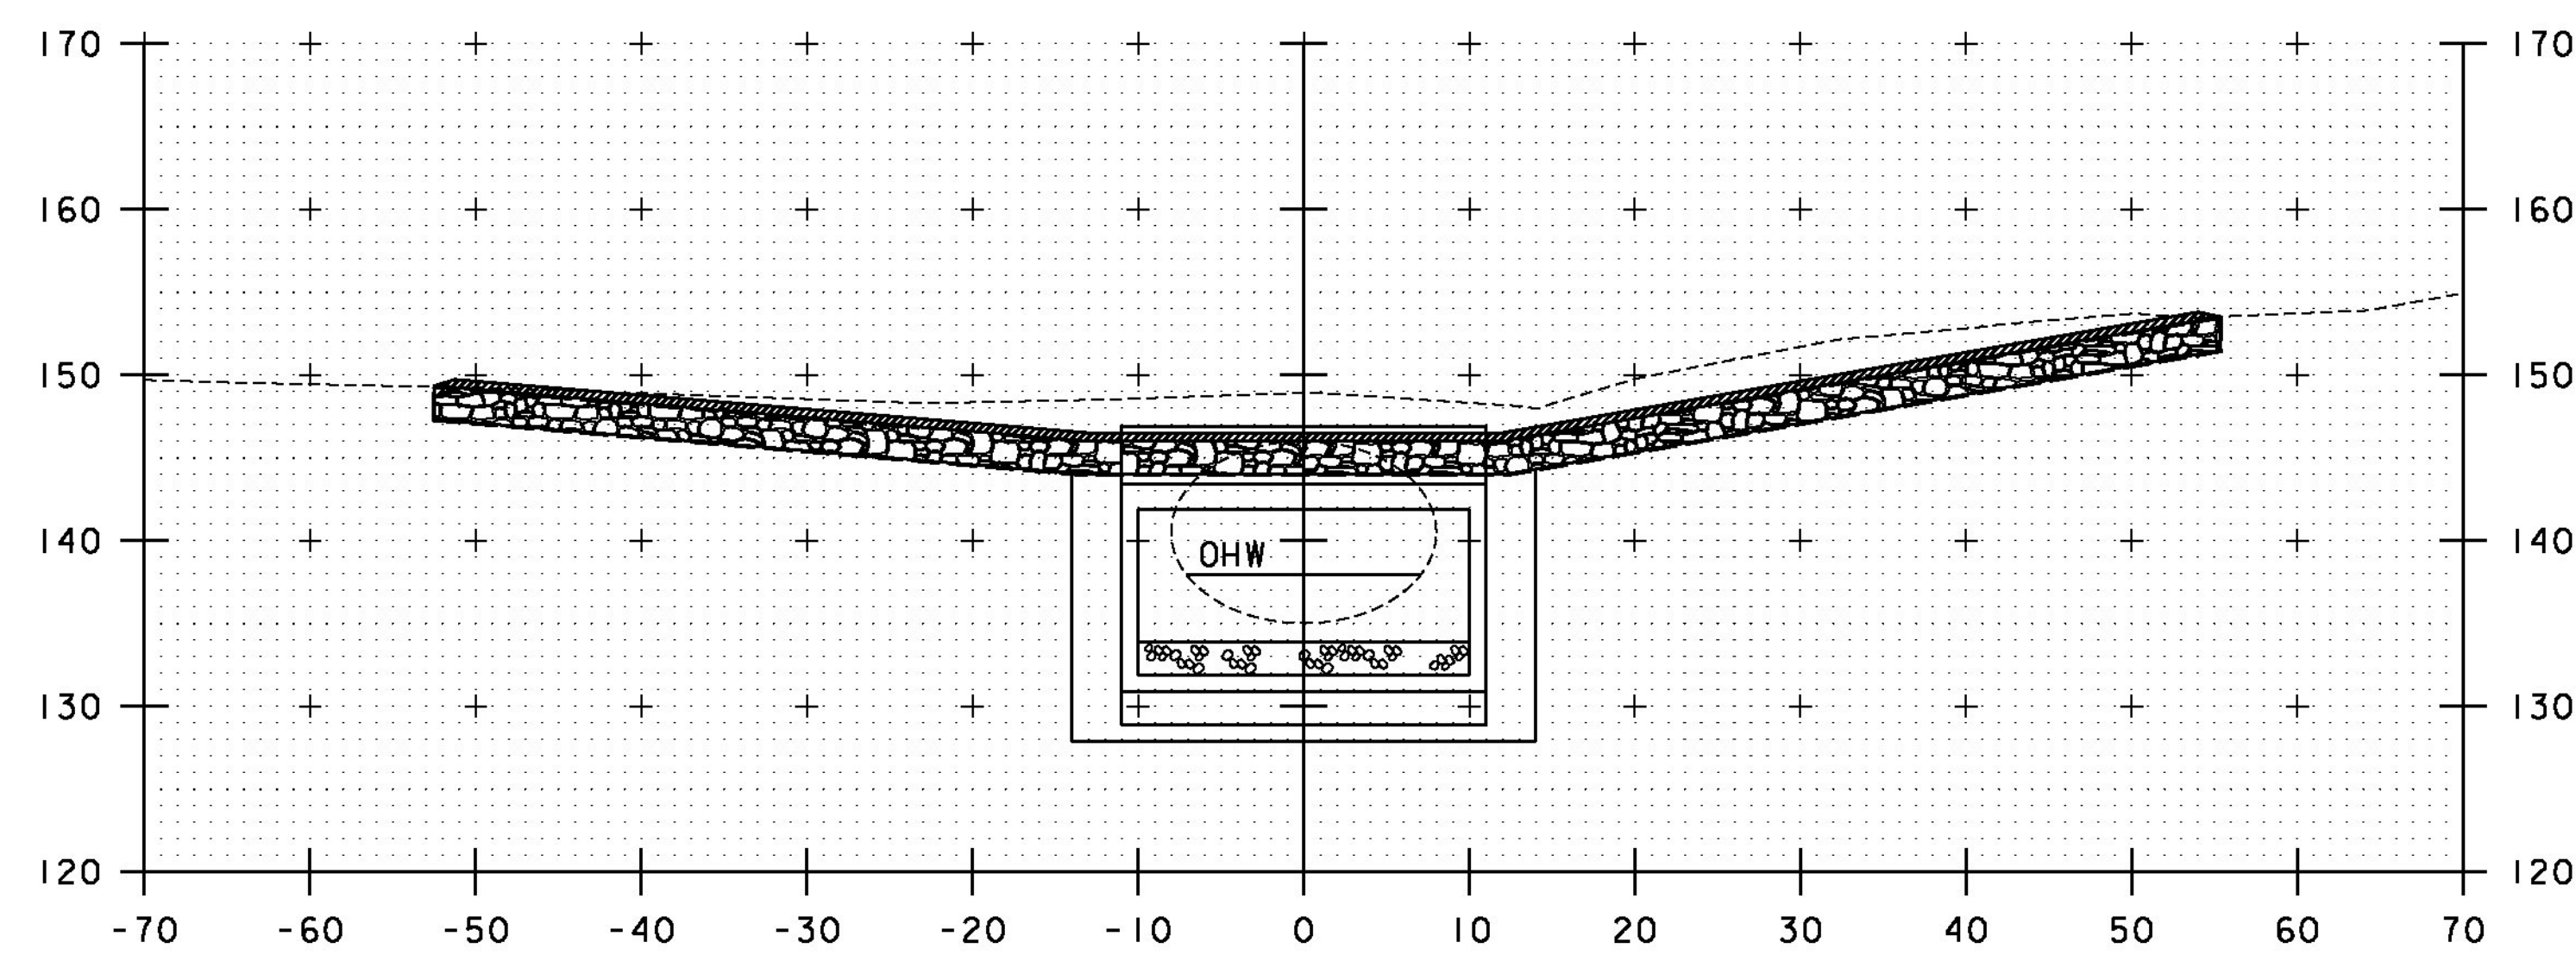

101+30

STA. 101+30 LT  
END UNCLASSIFIED CHANNEL EXCAVATION

STA. 101+30 RT  
END UNCLASSIFIED CHANNEL EXCAVATION

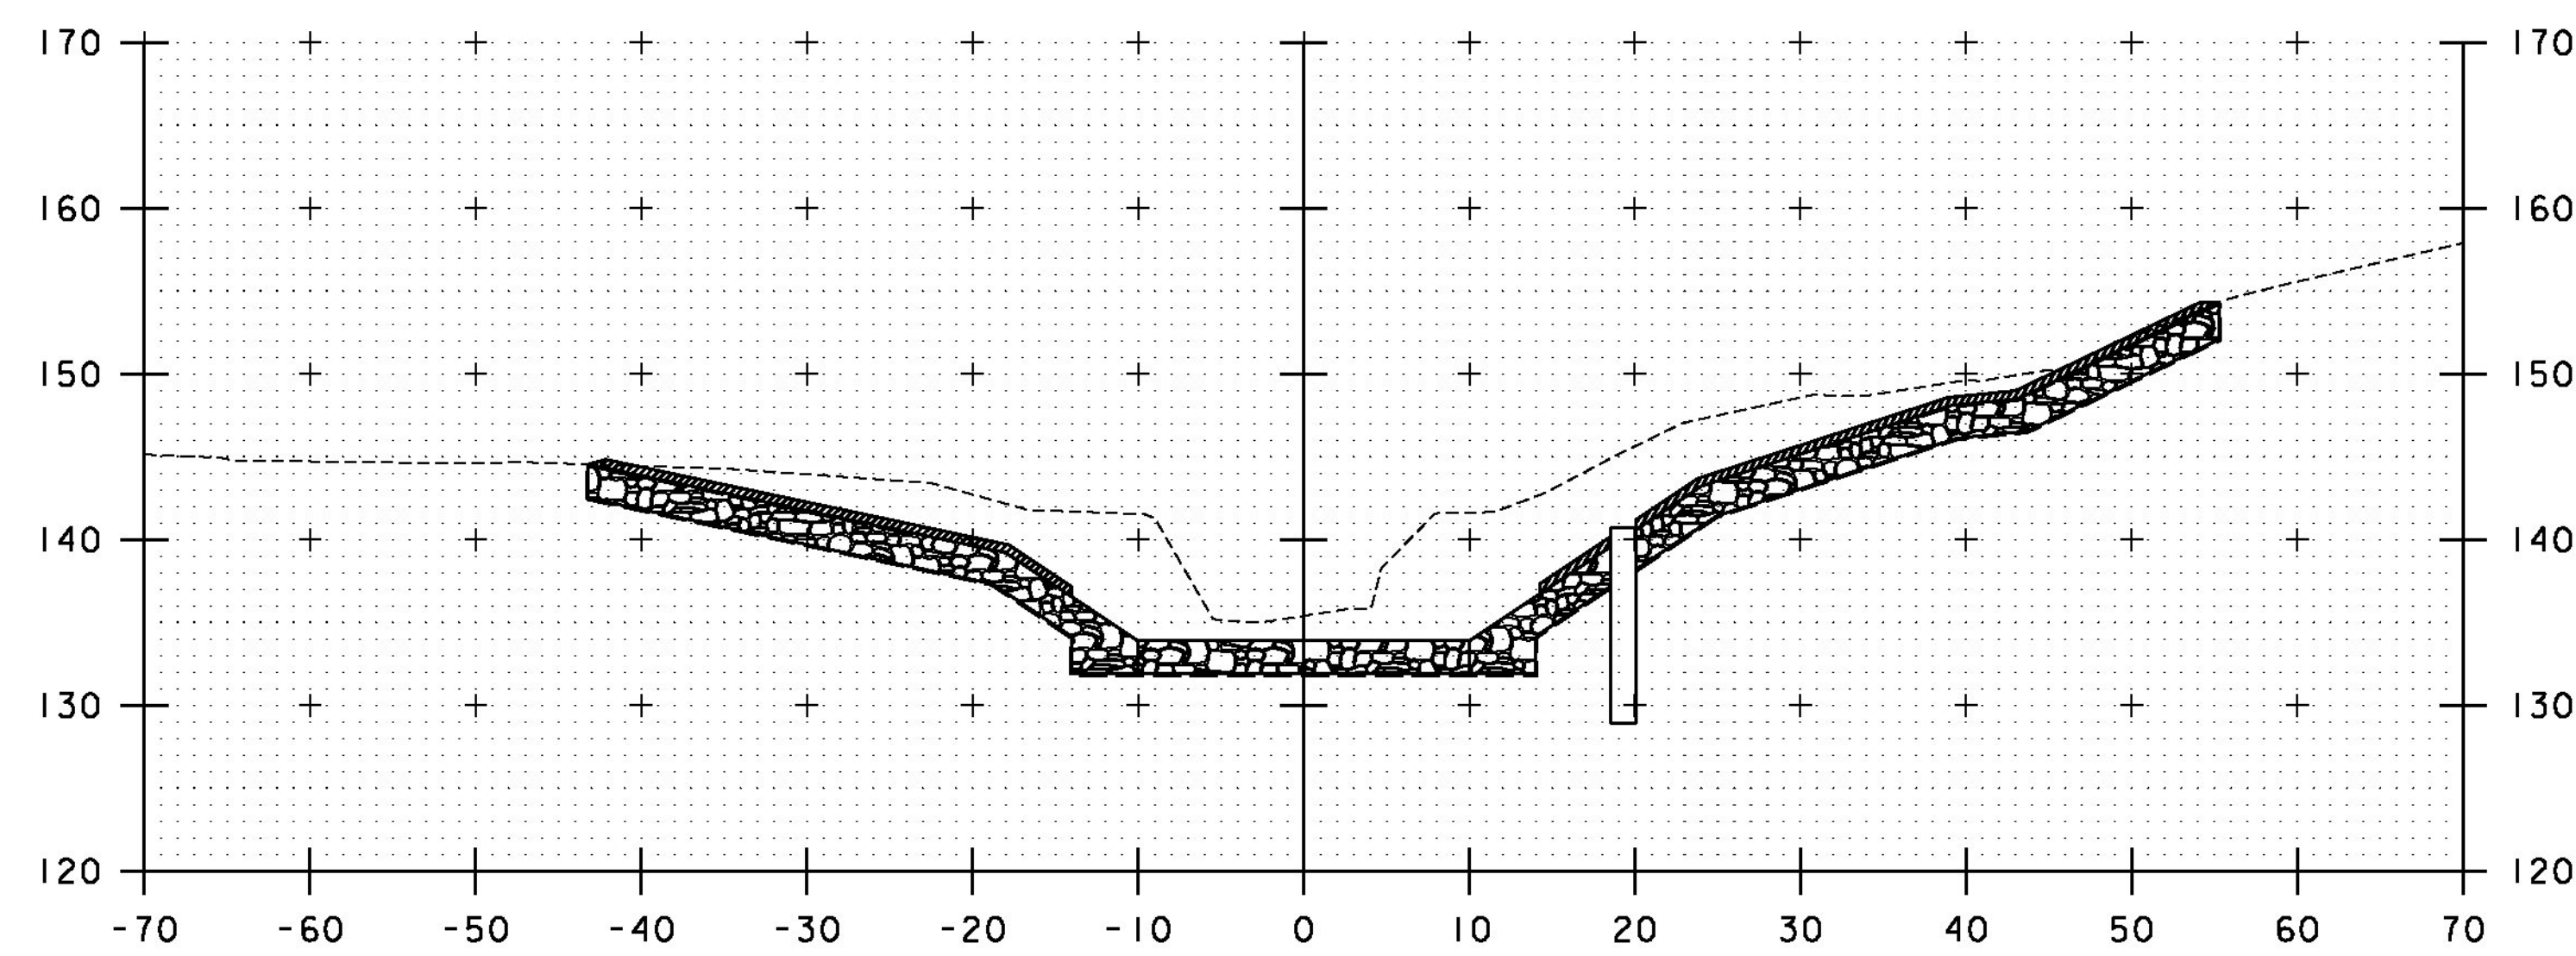


101+20


STA. 101+19 LT  
BEGIN SPECIAL PROVISION  
(STONE FILL, CULVERT LINING)

STA. 101+19 RT  
BEGIN SPECIAL PROVISION  
(STONE FILL, CULVERT LINING)

STA. 101+00 TO STA. 101+30

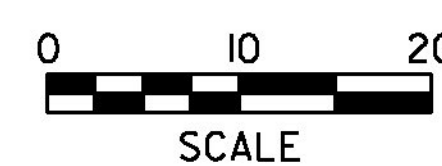


PROJECT NAME: BRIDPORT	FILE NAME: zllc264xs_br2.dgn	PLOT DATE: 8/22/2014
PROJECT NUMBER: STP CULV(29)	PROJECT LEADER: M. CHENETTE	DRAWN BY: L. BUXTON
	DESIGNED BY: J. HUNGERFORD	CHECKED BY: M. CHENETTE
	CHANNEL CROSS SECTIONS - CXSI - BR2	SHEET 28 OF 57

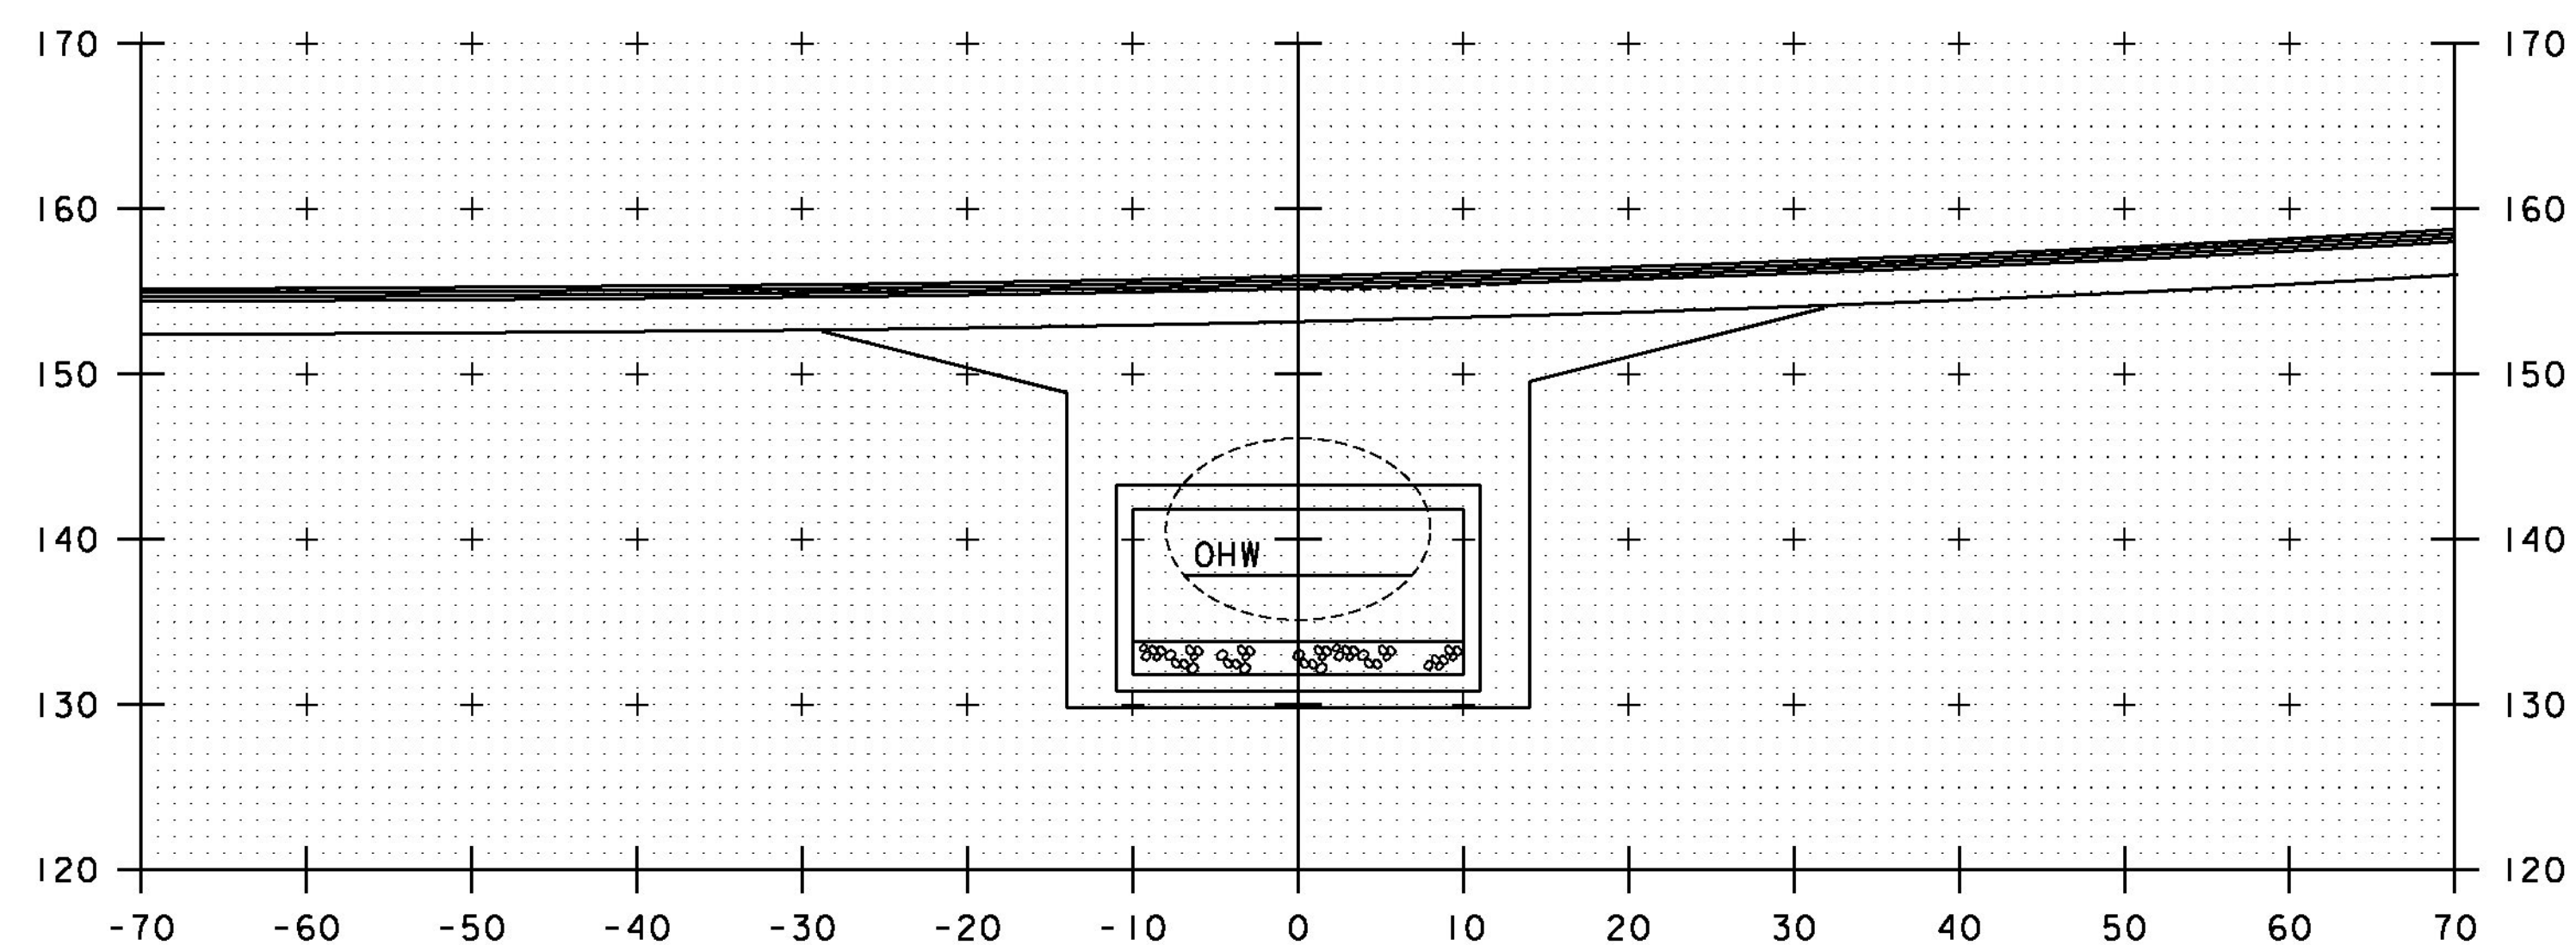


STA. 101+45 LT  
 END GEOTEXTILE UNDER STONE FILL  
 STONE FILL, TYPE II  
 GRUBBING MATERIAL

101+50


STA. 101+45 RT  
 END GEOTEXTILE UNDER STONE FILL  
 STONE FILL, TYPE II  
 GRUBBING MATERIAL

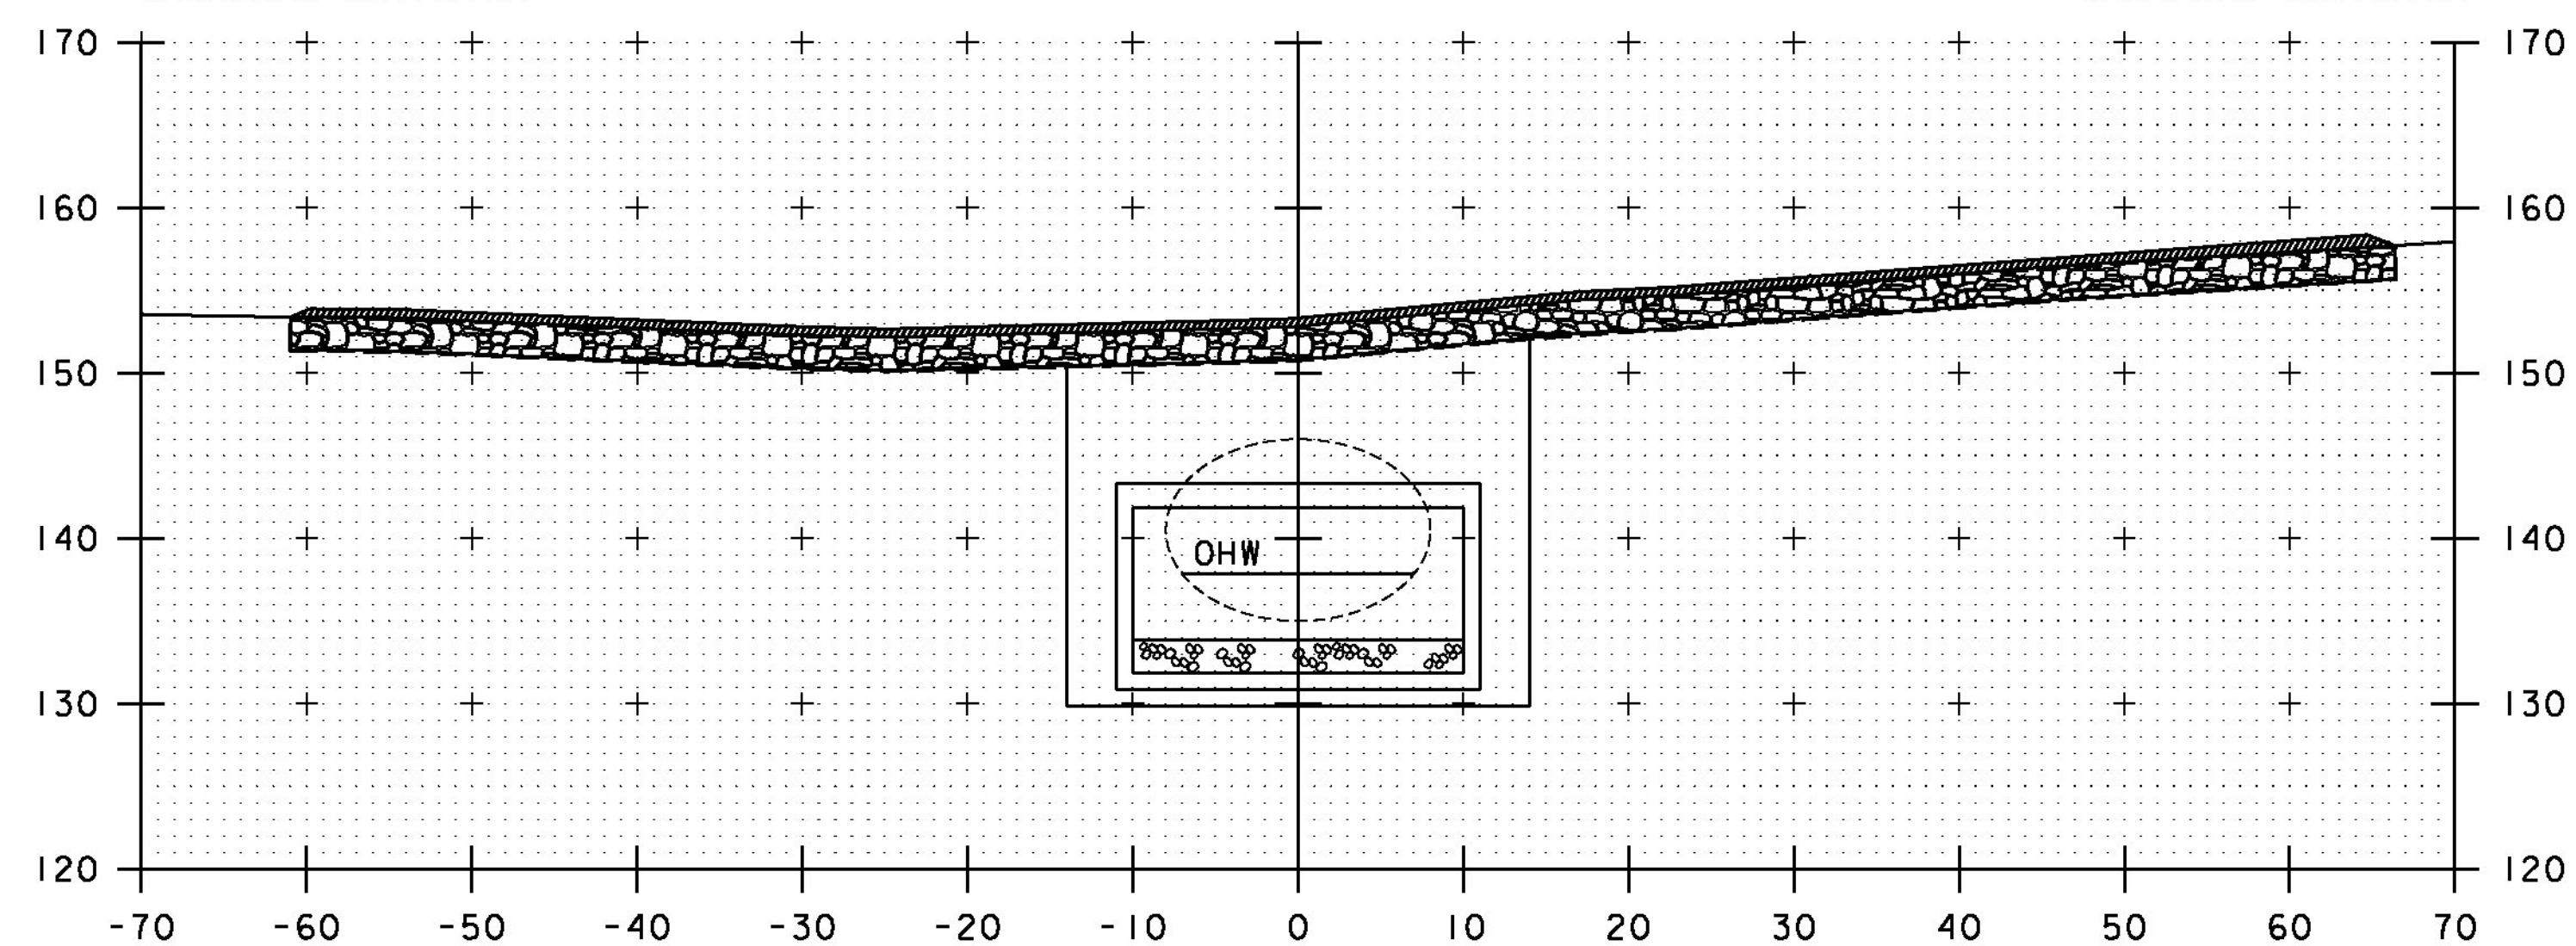

101+40

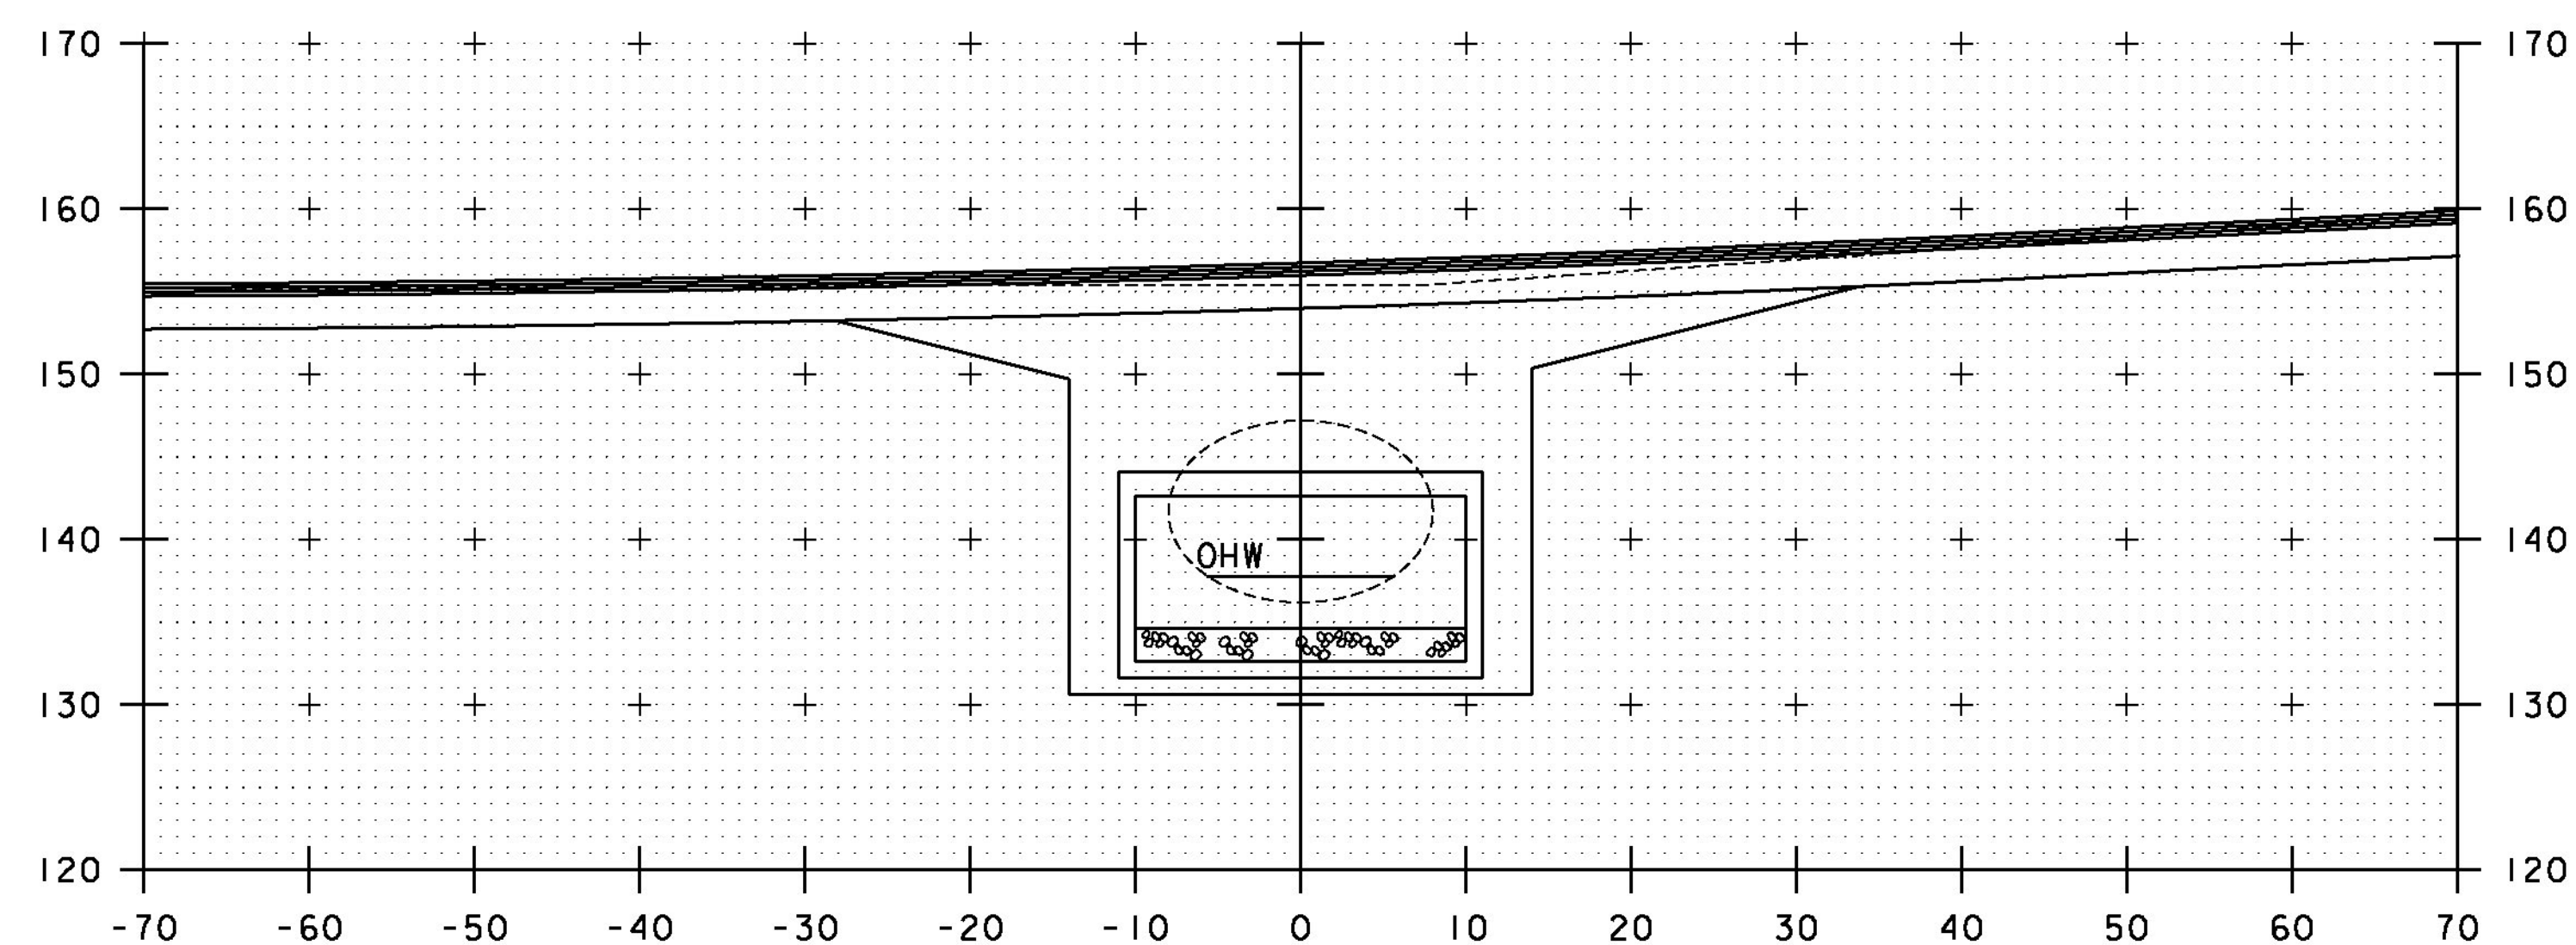

101+70

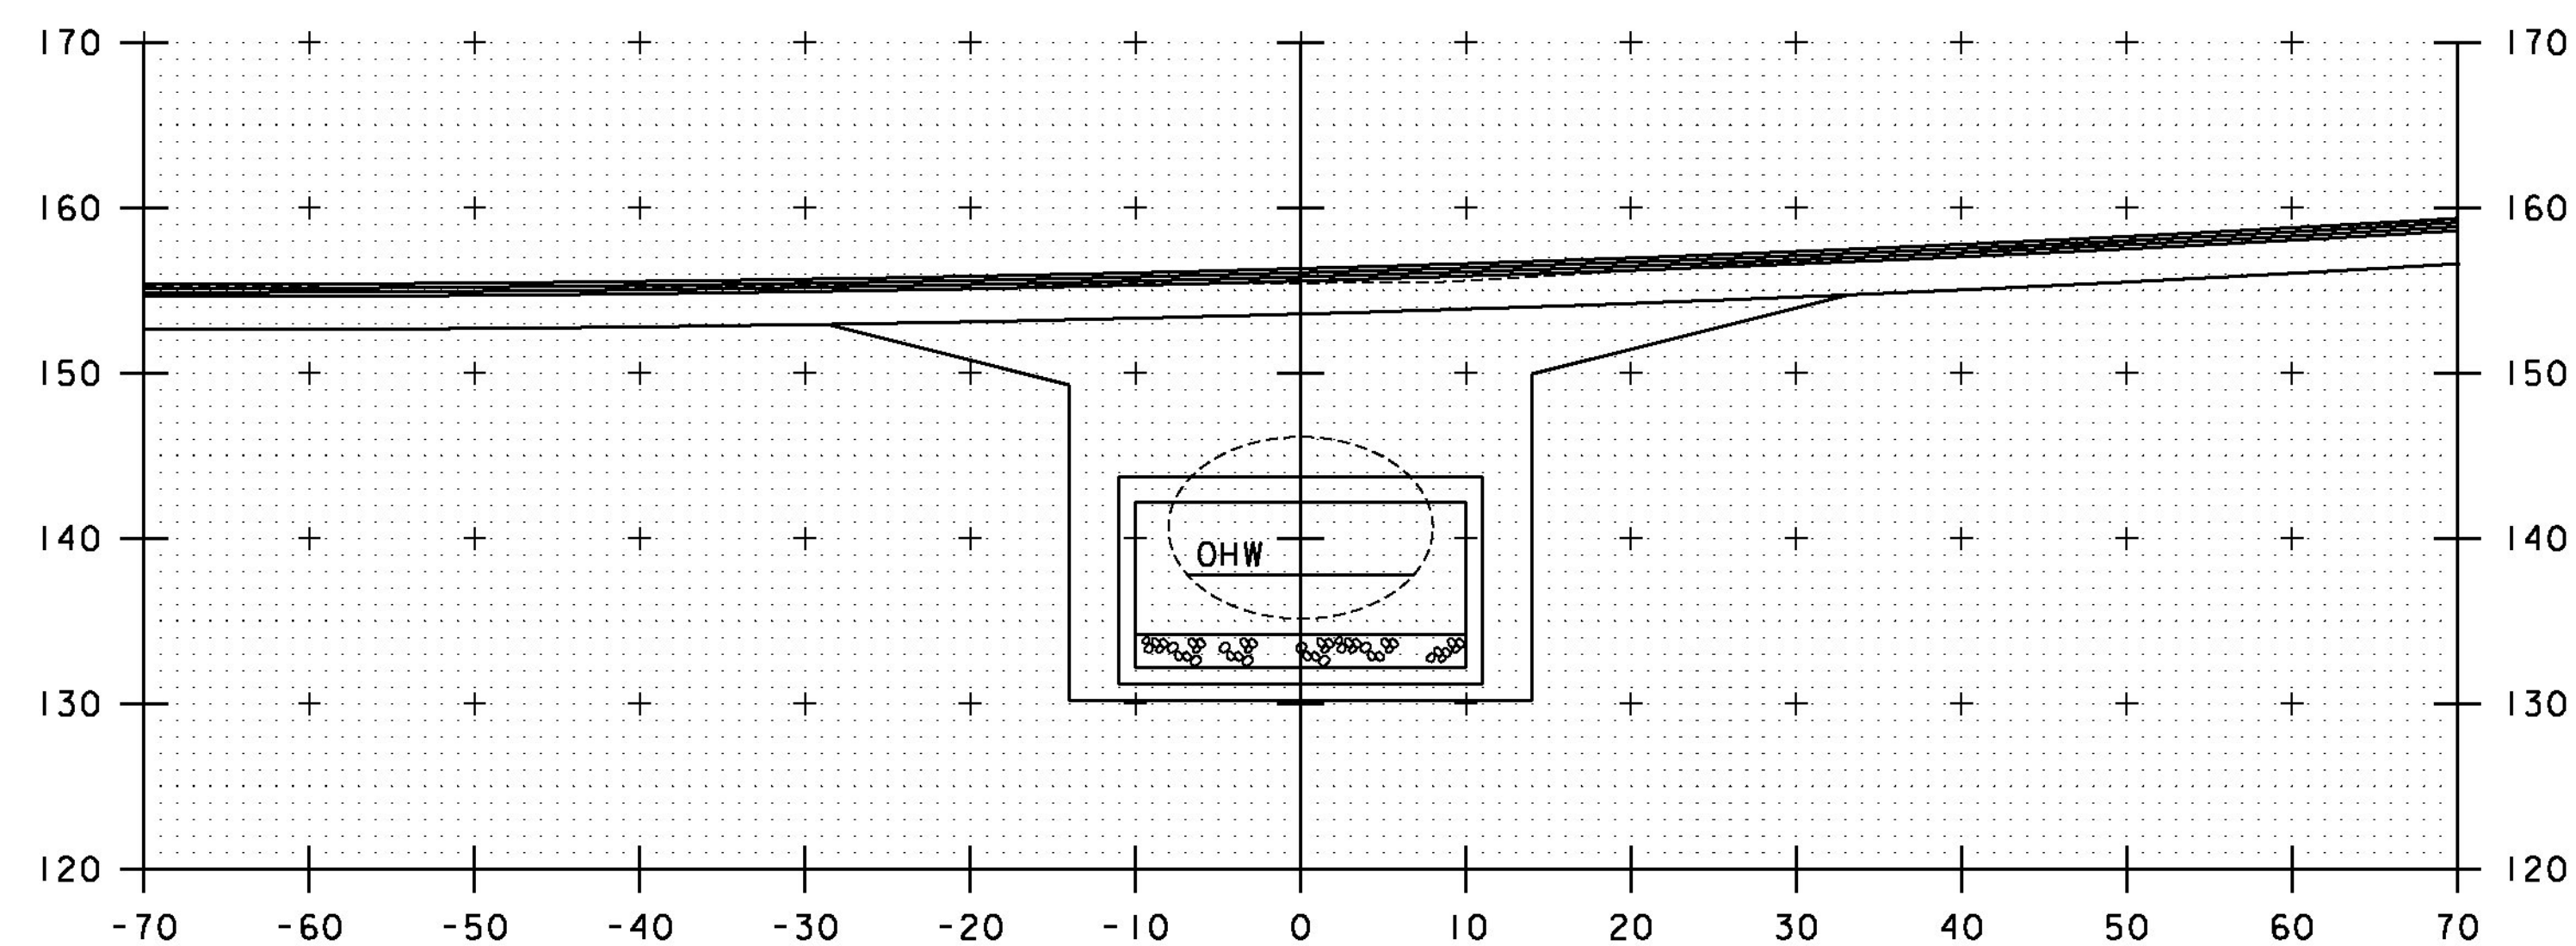


101+60


STA. 101+40 TO STA. 101+70

PROJECT NAME: BRIDPORT  
 PROJECT NUMBER: STP CULV(29)


FILE NAME: zllc264xs_br2.dgn  
 PROJECT LEADER: M. CHENETTE  
 DESIGNED BY: J. HUNGERFORD  
 CHANNEL CROSS SECTIONS - CXS2 - BR2

PLOT DATE: 8/22/2014  
 DRAWN BY: L. BUXTON  
 CHECKED BY: M. CHENETTE  
 SHEET 29 OF 57

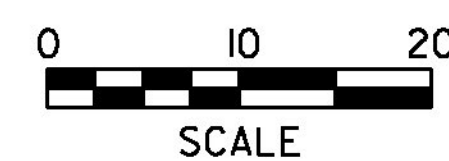

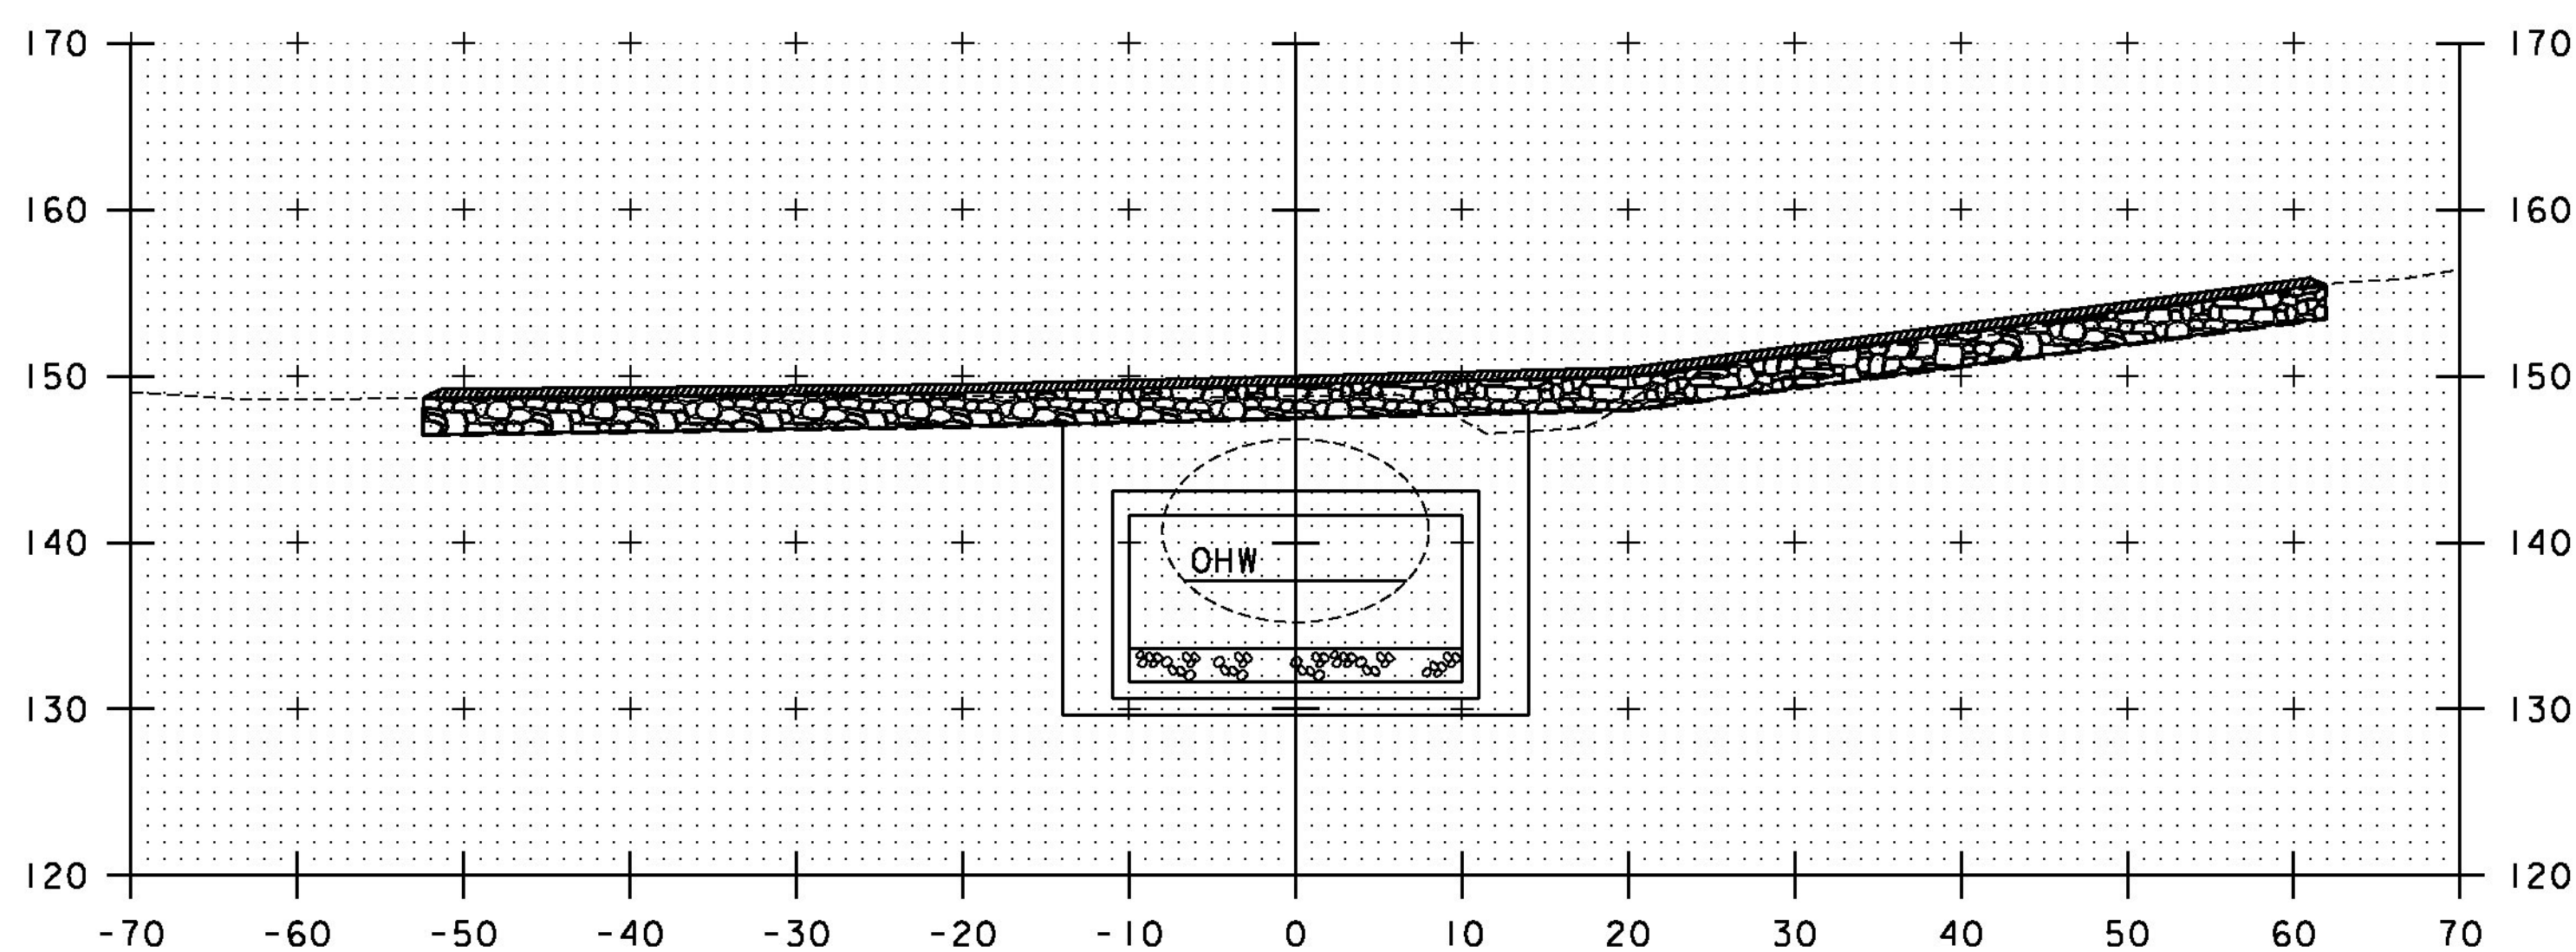


101+90

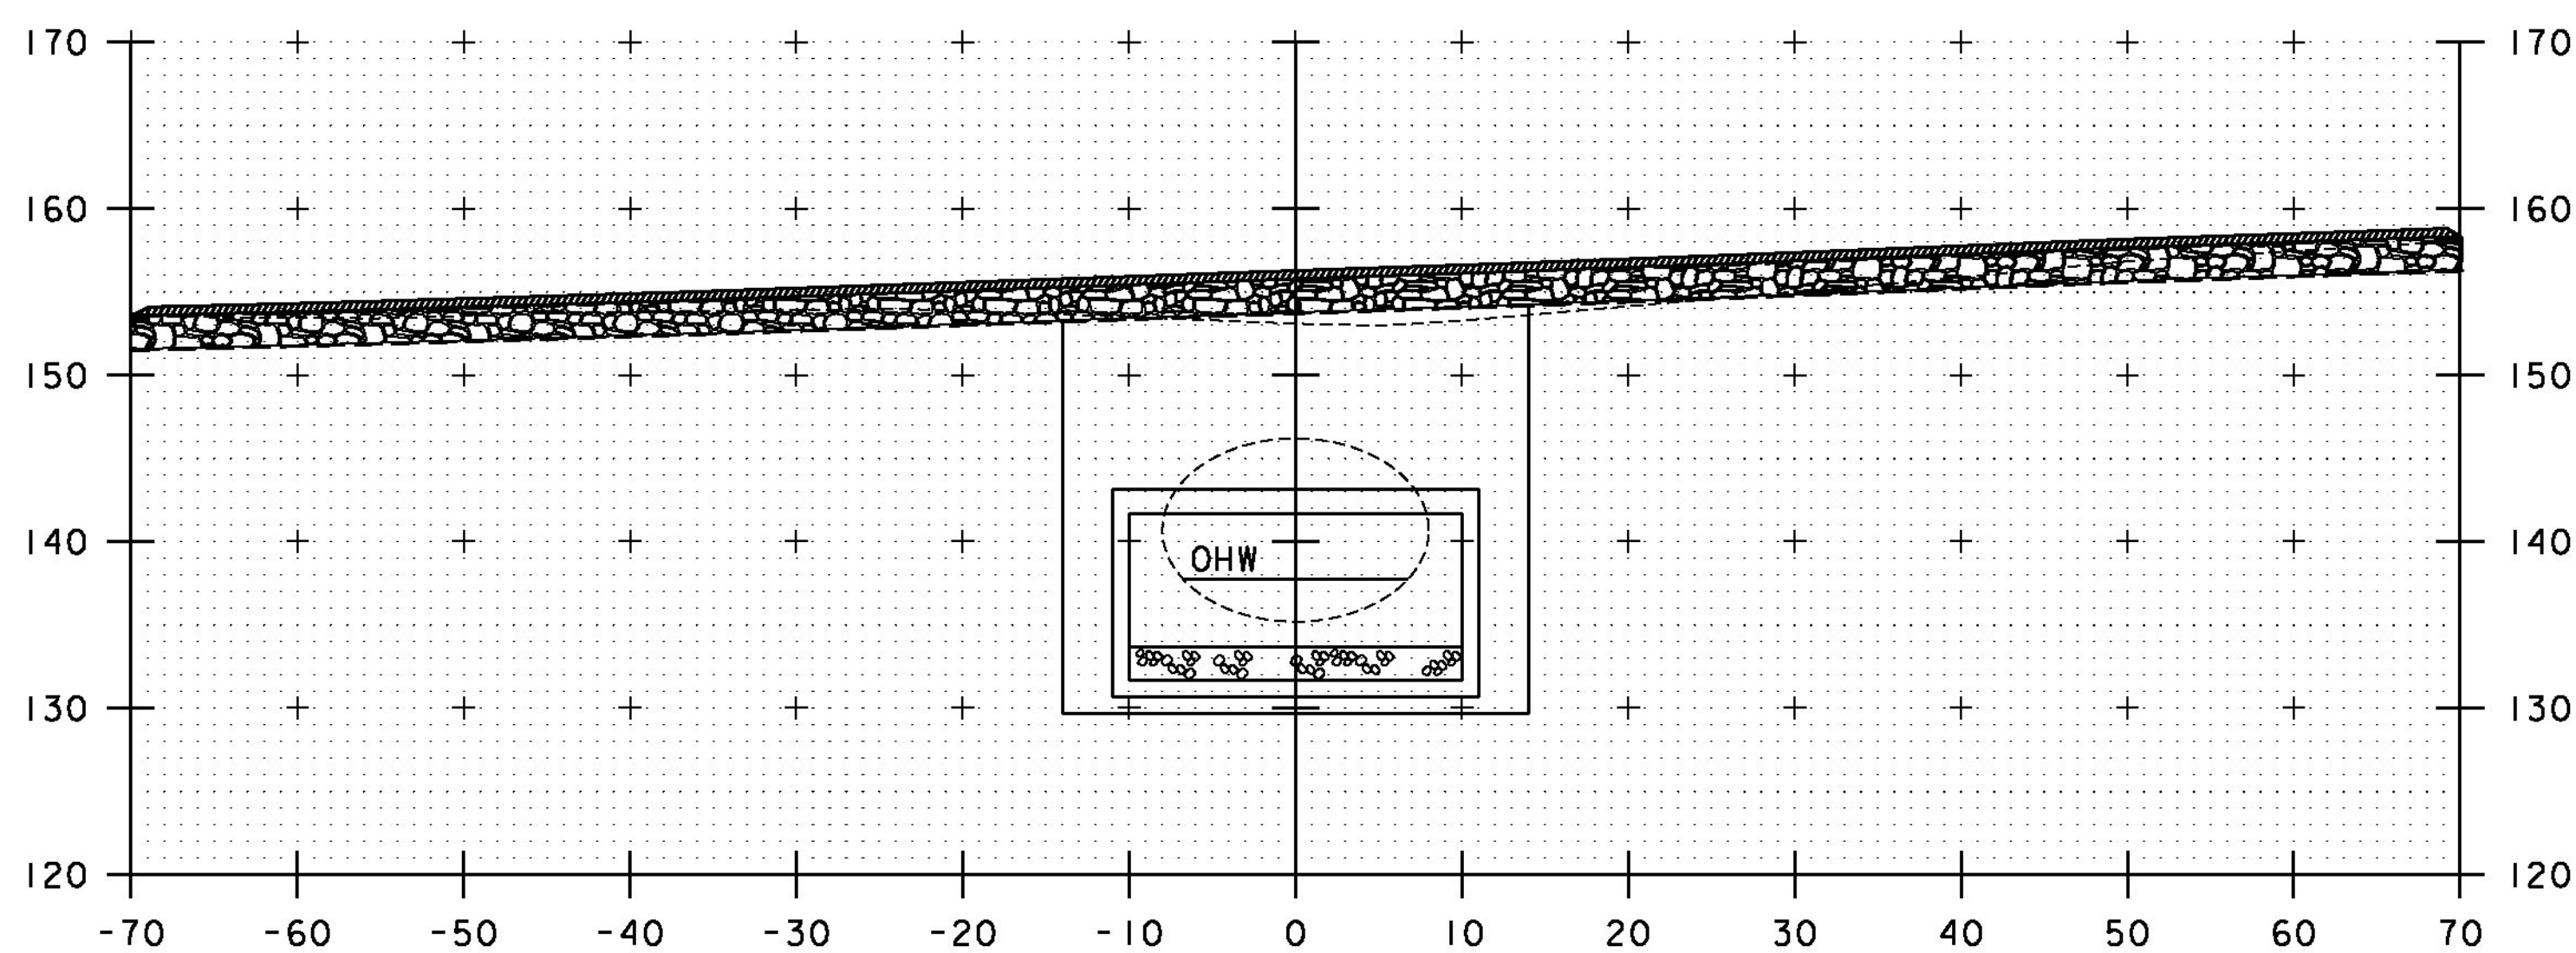


101+80

STA. 101+79 LT  
 BEGIN GEOTEXTILE UNDER STONE FILL  
 STONE FILL, TYPE II  
 GRUBBING MATERIAL

STA. 101+79 RT  
 BEGIN GEOTEXTILE UNDER STONE FILL  
 STONE FILL, TYPE II  
 GRUBBING MATERIAL

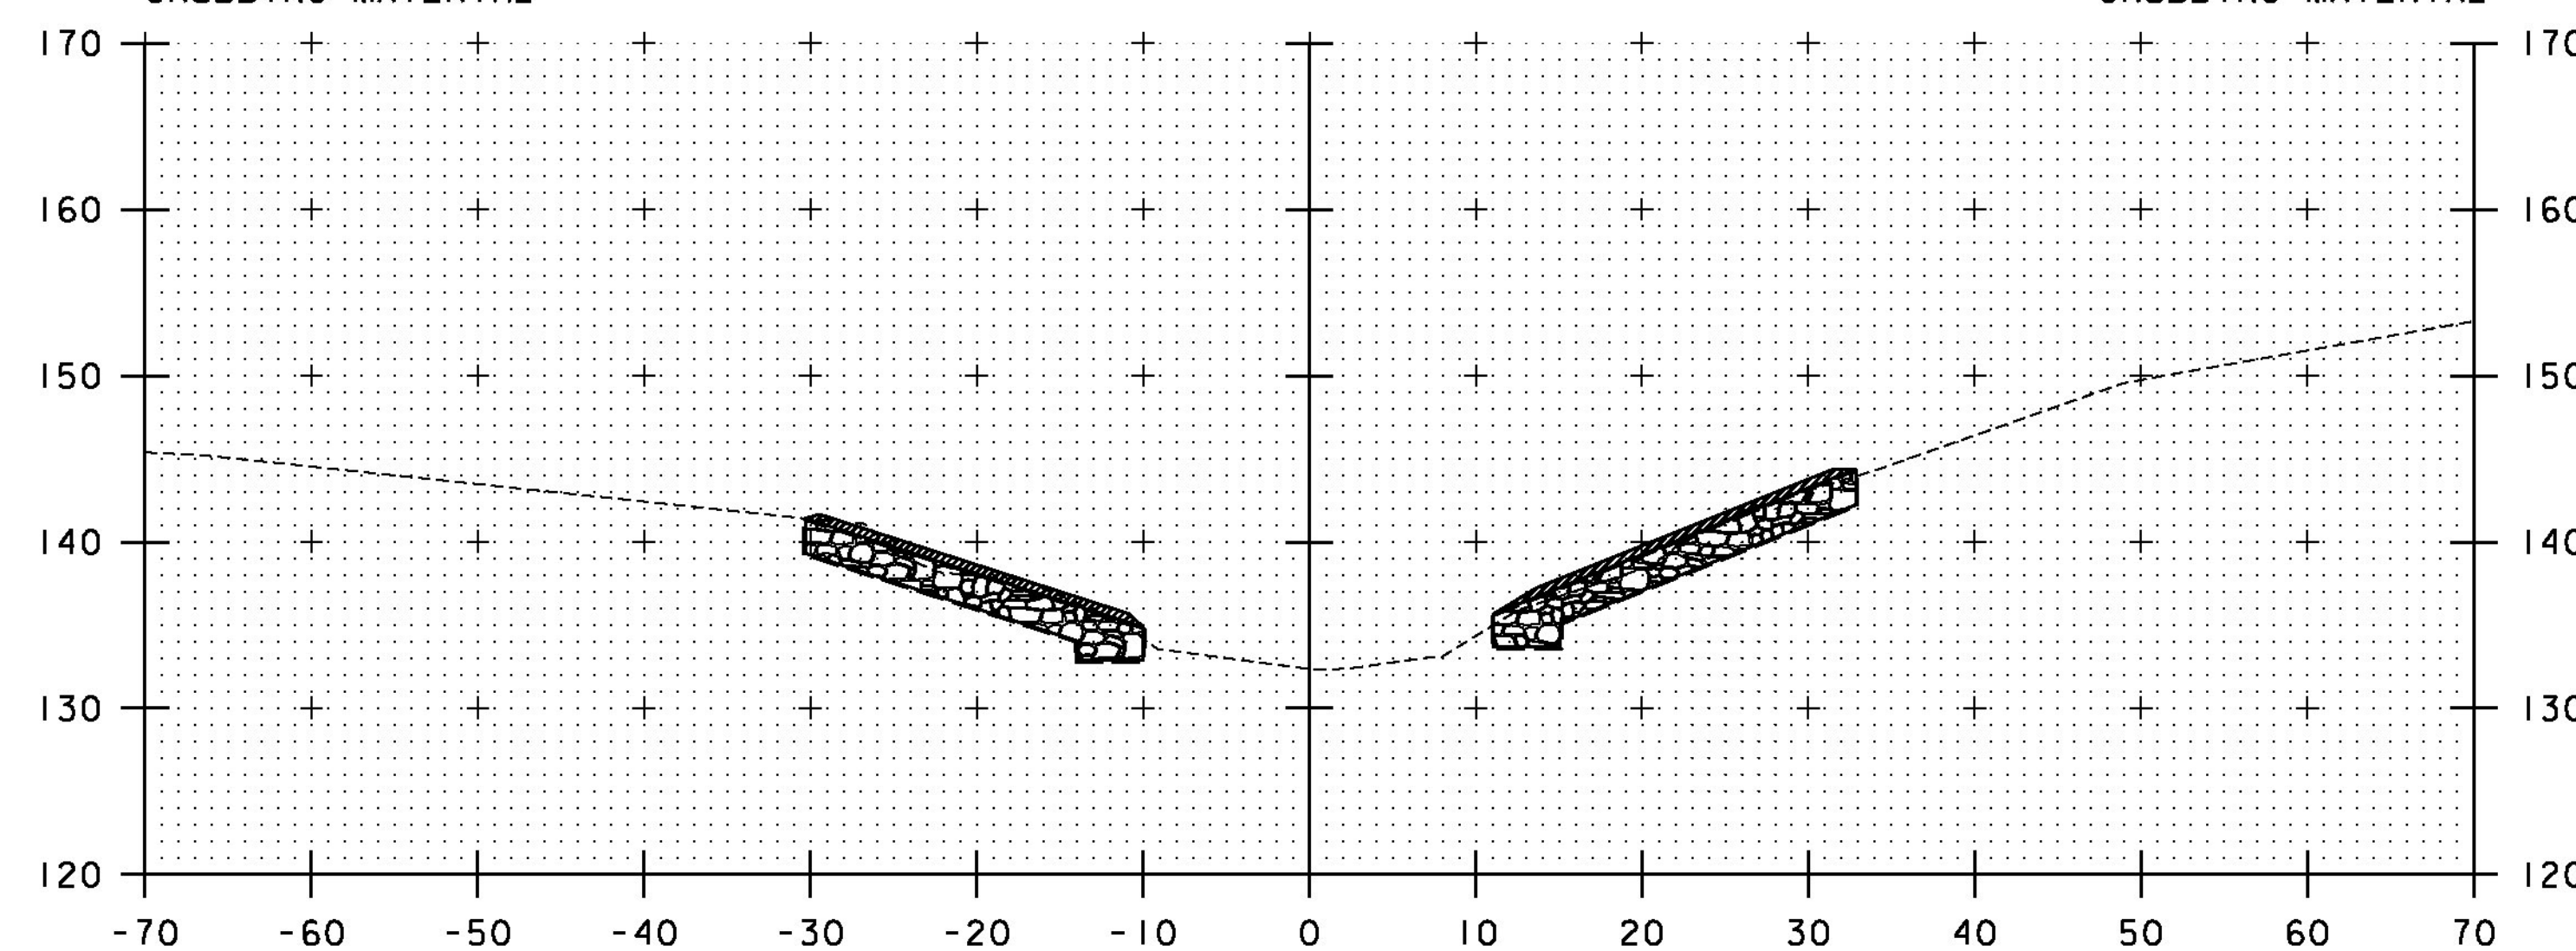

102+10

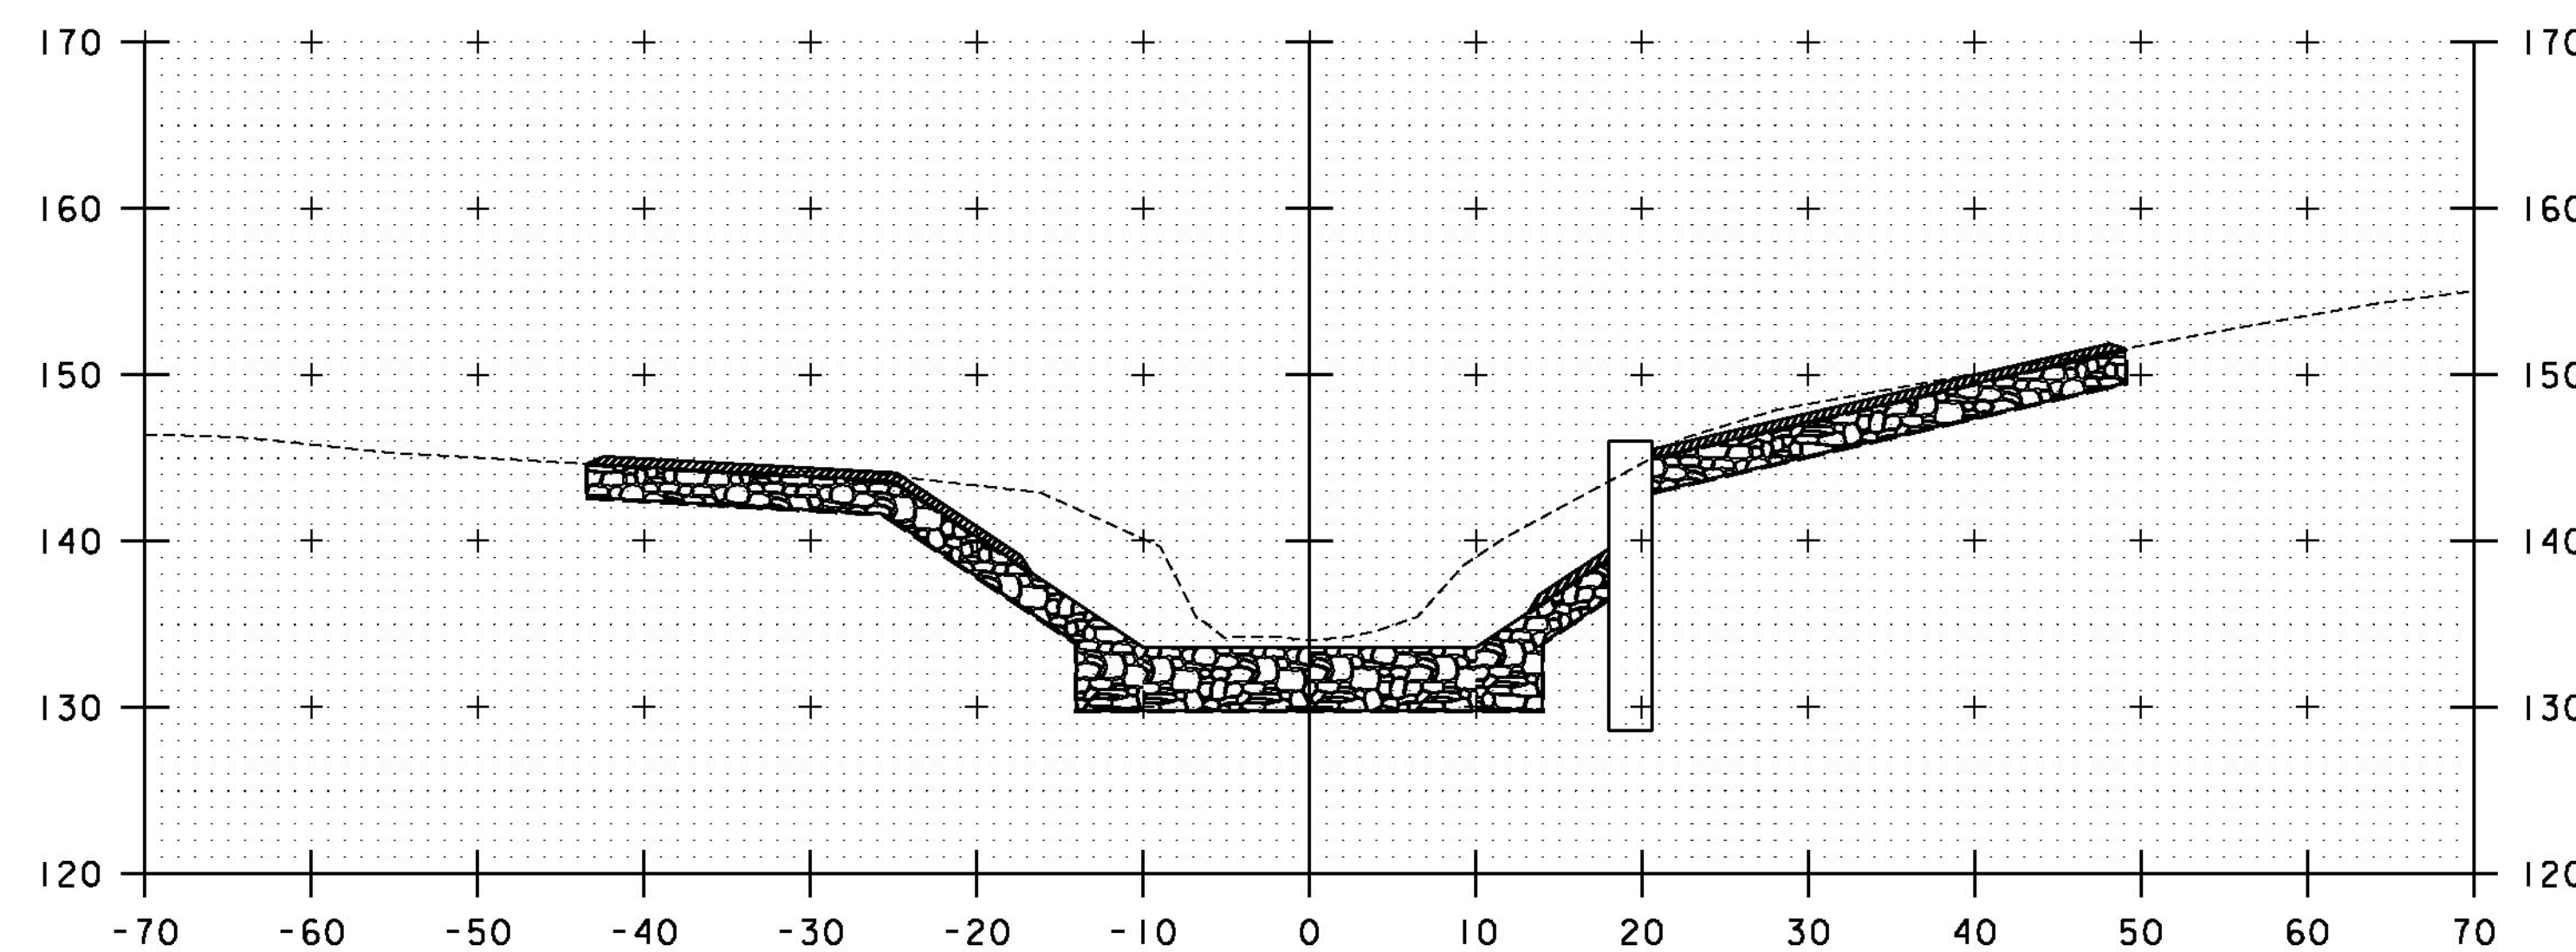

102+00

STA. 101+96 LT  
 BEGIN UNCLASSIFIED EXCAVATION


STA. 101+96 RT  
 BEGIN UNCLASSIFIED EXCAVATION

STA. 102+04 LT  
 END SPECIAL PROVISION (STONE FILL CULVERT LINING)  
 STA. 102+07 LT  
 END UNCLASSIFIED CHANNEL EXCAVATION  
 GEOTEXTILE UNDER STONE FILL  
 STONE FILL, TYPE II  
 GRUBBING MATERIAL

STA. 102+04 RT  
 END SPECIAL PROVISION (STONE FILL, CULVERT LINING)  
 STA. 102+18 RT  
 END UNCLASSIFIED CHANNEL EXCAVATION  
 GEOTEXTILE UNDER STONE FILL  
 STONE FILL, TYPE II  
 GRUBBING MATERIAL

STA. 101+80 TO STA. 102+10

PROJECT NAME: BRIDPORT	FILE NAME: zllc264xs_br2.dgn	PLOT DATE: 8/22/2014
PROJECT NUMBER: STP CULV(29)	PROJECT LEADER: M. CHENETTE	DRAWN BY: L. BUXTON
	DESIGNED BY: J. HUNGERFORD	CHECKED BY: M. CHENETTE
	CHANNEL CROSS SECTIONS - CXS3 - BR2	SHEET 30 OF 57

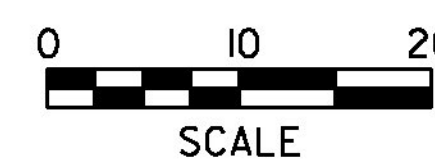

## EPSC PLAN NARRATIVE

### 1.1 PROJECT DESCRIPTION

THIS PROJECT INVOLVES THE REPLACEMENT OF BRIDGE #2, RELATED CHANNEL WORK AND INCIDENTALS. BRIDGE #2 IS AN EXISTING 11"x16" CORRUGATED METAL PLATE PIPE CULVERT, WHICH WILL BE REPLACED WITH A 20' SPAN PRECAST CONCRETE CULVERT TO CONVEY THE WEST BRANCH DEAD CREEK BENEATH VT ROUTE 125. BRIDGE #2 IS LOCATED IN THE TOWN OF BRIDPORT ON VT ROUTE 125, 2.3 MILES WEST OF THE JUNCTION WITH VERMONT ROUTE 22A.

NOTE: AREA OF DISTURBANCE INCLUDES LIMITS OF EARTH DISTURBANCE WITHIN THE PROJECT AREA, AS WELL AS WASTE, BORROW AND STAGING AREAS, AND OTHER EARTH DISTURBING ACTIVITIES WITHIN OR DIRECTLY ADJACENT TO THE PROJECT LIMITS AS SHOWN ON THE ATTACHED EPSC PLAN.

TOTAL AREA OF DISTURBANCE AS SHOWN ON THE ATTACHED EPSC PLAN IS APPROXIMATELY 0.67 ACRES.

IT IS ANTICIPATED THAT THIS PROJECT WILL LAST ONE CONSTRUCTION SEASON.

### 1.2 SITE INVENTORY

#### 1.2.1 TOPOGRAPHY

THE SITE IS MOSTLY LOWLAND AGRICULTURAL LANDS WITH SOME WOODED AREAS. THE STREAM BANKS ARE VEGETATED GRASSY UNDERGROWTH WITH GRASSY VEGETATION. VT ROUTE 125 IS WITHIN THE PROJECT SITE. THERE IS AN ABANDONED BRIDGE NORTH OF THE PROJECT SITE THAT SHOULD NOT BE IMPACTED BY THE PROJECT. THERE ARE OVERHEAD UTILITIES THAT WILL BE RELOCATED PRIOR TO START OF THE PROJECT.

#### 1.2.2 DRAINAGE, WATERWAYS, BODIES OF WATER, AND PROXIMITY TO NATURAL OR MAN-MADE WATER FEATURES

THE WATER SOURCE ON THE PROJECT SITE IS THE WEST BRANCH DEAD CREEK. THE PROJECT IS IN THE OTTER CREEK DRAINAGE BASIN. THE TOTAL CONTRIBUTING DRAINAGE AREA IS 7.06 SQ. MI. DUE TO THE NATURE OF THE SURROUNDING TERRAIN THE PROJECT SITE COULD RECEIVE RUNOFF FROM THE SURROUNDING SLOPES, ROADWAY DITCHES, AND THE ROADWAY OVERTOP THE CULVERT. THERE ARE CLASS II WETLANDS ON THE NORTH AND SOUTH SIDES OF THE PROJECT. SEE THE PROJECT IMPACTS PLANS.

#### 1.2.3 VEGETATION

THE VEGETATION IN THE PROJECT AREA CONSISTS OF GRASSY FARMLAND AND SOFTWOOD FOREST. THE IMPACT TO VEGETATION WILL BE LIMITED TO THAT WHICH IS RELATED TO THE EXCAVATION REQUIRED FOR THE INSTALLATION OF THE CULVERT, HEADWALLS, WINGWALLS, STONE FILL, AND TEMPORARY ACCESS. UPON PROJECT COMPLETION, THE CHANNEL AND DISTURBED AREAS WITH SLOPES GREATER THAN 2:1 WILL BE ARMORED WITH STONE FILL TYPE II AS SPECIFIED ON THE PLANS. DISTURBED VEGETATION WILL BE REESTABLISHED WITH STANDARD SEED AND MULCH PRACTICES.

#### 1.2.4 SOILS

ALL SOIL DATA CAME FROM THE U.S. DEPARTMENT OF AGRICULTURE SOIL CONSERVATION SERVICE FOR THE COUNTY OF ORLEANS, VERMONT. SOILS ON THE PROJECT SITE ARE VERGENNES CLAY, "K FACTOR" = 0.49. THE SOIL IS CONSIDERED HIGHLY ERODIBLE DUE TO K-VALUE.

NOTE: K-VALUES GENERALLY INDICATE THE FOLLOWING:

0.0-0.23 = LOW EROSION POTENTIAL  
0.24-0.36 = MODERATE EROSION POTENTIAL  
0.37 AND HIGHER = HIGH EROSION POTENTIAL

#### 1.2.5 SENSITIVE RESOURCE AREAS

CRITICAL HABITATS: YES, FRESHWATER MUSSELS PRESENT, AOP REQUESTED, INDIANA BAT TERRITORY  
HISTORICAL OR ARCHEOLOGICAL AREAS: NO  
PRIME AGRICULTURAL LAND: NO  
THREATENED AND ENDANGERED SPECIES: YES, FRESHWATER MUSSELS PRESENT, AOP REQUESTED, INDIANA BAT TERRITORY  
WATER RESOURCE: WEST BRANCH DEAD CREEK  
WETLANDS: YES, THERE ARE WETLANDS AT THE INLET AND OUTLET OF THE STRUCTURE. SEE THE PROJECT IMPACTS PLANS.

### 1.3 RISK EVALUATION

THIS PROJECT DOES NOT FALL UNDER THE JURISDICTION OF GENERAL PERMIT 3-9020 FOR STORMWATER RUNOFF FROM CONSTRUCTION SITES. SHOULD CHANGES PRIOR TO OR DURING CONSTRUCTION RESULT IN ONE OR MORE ACRES OF EARTH DISTURBANCE OR SHOULD THE PROJECT BECOME PART OF A LARGER PLAN OF DEVELOPMENT, THE CONTRACTOR WILL BE RESPONSIBLE FOR ANY ADDITIONAL PERMITTING.

### 1.4 EROSION PREVENTION AND SEDIMENT CONTROL

THE EROSION CONTROL PLANS ARE MEANT AS A GUIDELINE FOR PREVENTING EROSION AND CONTROLLING SEDIMENT TRANSPORT. THE PRINCIPLES OUTLINED IN THIS NARRATIVE CONSIST OF APPLYING MEASURES THROUGHOUT CONSTRUCTION OF THE PROJECT IN ORDER TO MINIMIZE SEDIMENT TRANSPORT TO THE RECEIVING WATERS. THE MEASURES INCLUDE STABILIZATION AND STRUCTURAL PRACTICES, STORM WATER CONTROLS AND OTHER POLLUTION PREVENTION PRACTICES. THEY HAVE BEEN PROPOSED BY THE DESIGNER AS A BASIS FOR PROTECTING RESOURCES AND WILL NEED TO BE BUILT UPON BASED ON THE SPECIFIC MEANS AND METHODS OF THE CONTRACTOR. REFER TO THE LOW RISK SITE HANDBOOK AND APPROPRIATE DETAIL SHEETS FOR SPECIFIC GUIDANCE AND CONSTRUCTION DETAILING. THE CONTRACTOR IS RESPONSIBLE FOR DEVELOPING AND SUBMITTING AN EPSC PLAN IN ACCORDANCE WITH SECTION 105 OF THE STANDARD SPECIFICATIONS.

IN ADDITION, THE CONTRACTOR SHALL DESIGN AND IMPLEMENT A TEMPORARY STREAM DIVERSION, INCLUDING EPSC MEASURES IN ACCORDANCE WITH ITEM 900.645, SPECIAL PROVISION (TEMPORARY RELOCATION OF STREAM).

ALL MEASURES SHALL BE REGULARLY MAINTAINED AND SHALL BE CHECKED FOR SEDIMENT BUILD-UP. SEDIMENT SHALL BE DISPOSED OF AT AN APPROVED SITE WHERE IT WILL NOT BE SUBJECT TO EROSION.

#### 1.4.1 MARK SITE BOUNDARIES

SITE BOUNDARIES AND AREAS CONSTRUCTION EQUIPMENT CAN ACCESS SHALL BE DELINEATED.

PROJECT DEMARCATION FENCING (PDF) SHALL BE USED TO PHYSICALLY MARK SITE BOUNDARIES.

#### 1.4.2 LIMIT DISTURBANCE AREA

PREVENTING INITIAL SOIL EROSION BY MINIMIZING THE EXPOSED AREA IS MUCH MORE EFFECTIVE THAN TREATING ERODED SEDIMENT. EARTH DISTURBANCE CAN BE MINIMIZED THROUGH CONSTRUCTION PHASING BY ONLY OPENING UP EARTH AS NECESSARY. THIS CAN LIMIT THE AREA THAT WILL BE DISTURBED AND EXPOSED TO EROSION. EMPLOY TEMPORARY CONSTRUCTION STABILIZATION PRACTICES IN INCREMENTAL STAGES AS PHASES CHANGE. FOR PROJECTS WHICH FALL UNDER THE CONSTRUCTION GENERAL PERMIT, ONLY THE ACREAGE LISTED ON THE PERMIT AUTHORIZATION MAY BE EXPOSED AT ANY GIVEN TIME.

MAINTAINING VEGETATED BUFFERS ALONG STREAM BANKS, WETLANDS OR OTHER SENSITIVE AREAS IS A CRUCIAL EROSION AND SEDIMENT CONTROL MEASURE THAT SHOULD BE ESTABLISHED WHEREVER POSSIBLE.

#### 1.4.3 SITE ENTRANCE/EXIT STABILIZATION

TRACKING OF SEDIMENT ONTO PUBLIC HIGHWAYS SHALL BE MINIMIZED TO REDUCE THE POTENTIAL FOR RUNOFF ENTERING RECEIVING WATERS. INSTALLATION SHALL COINCIDE WITH THE CONTRACTOR'S PROGRESS SCHEDULE.

STABILIZED CONSTRUCTION ENTRANCES SHALL BE INSTALLED AS PROPOSED ON THE EPSC PLAN AND ANYWHERE EQUIPMENT WILL BE GOING FROM AREAS OF EXPOSED SOILS TO PAVED SURFACES.

#### 1.4.4 INSTALL SEDIMENT BARRIERS

SEDIMENT BARRIERS SHALL BE UTILIZED TO INTERCEPT RUNOFF AND ALLOW SUSPENDED SEDIMENT TO SETTLE OUT. THEY SHALL BE INSTALLED PRIOR TO ANY UP SLOPE WORK.

SILT FENCE WILL BE INSTALLED AS SHOWN ON THE EPSC PLAN.

#### 1.4.5 DIVERT UPLAND RUNOFF

DIVERSIONARY MEASURES SHALL BE USED TO INTERCEPT RUNOFF FROM ABOVE THE CONSTRUCTION AND DIRECT IT AROUND THE DISTURBED AREA SO THAT CLEAN WATER DOES NOT BECOME MUDDIED WHILE TRAVELING OVER EXPOSED SOILS ON THE CONSTRUCTION SITE.

THE PROJECT AREA IS RELATIVELY FLAT WITH MINIMAL OFF-SITE RUNOFF FLOWING THROUGH THE SITE. THEREFORE DIVERSION MEASURES WILL NOT BE NECESSARY.

#### 1.4.6 SLOW DOWN CHANNELIZED RUNOFF

CHECK STRUCTURES SHALL BE UTILIZED TO REDUCE THE VELOCITY, AND THUS THE EROSION POTENTIAL, OF CONCENTRATED FLOW IN CHANNELS.

STONE CHECK DAMS WILL BE INSTALLED AS SHOWN ON THE EPSC PLAN.

#### 1.4.7 CONSTRUCT PERMANENT CONTROLS

THERE ARE NO PERMANENT STORMWATER TREATMENT DEVICES TO BE INSTALLED WITH THIS PROJECT.

#### 1.4.8 STABILIZE EXPOSED SOILS DURING CONSTRUCTION

ALL AREAS OF DISTURBANCE MUST HAVE TEMPORARY STABILIZATION IN PLACE WITHIN 48 HOURS OF DISTURBANCE OR IN ACCORDANCE WITH THE CONSTRUCTION GENERAL PERMIT 3-9020 AUTHORIZATION.

SURFACE ROUGHENING OF ALL EXPOSED SLOPES, COMBINED WITH TEMPORARY MULCHING, SHALL BE UTILIZED ON A REGULAR BASIS. BIODEGRADABLE EROSION CONTROL MATTING OR AN EQUIVALENT SHALL BE USED TO STABILIZE ALL SLOPES STEEPER THAN 1:3.

THE FORECAST OF RAINFALL EVENTS SHALL TRIGGER IMMEDIATE PROTECTION OF EXPOSED SOILS.

#### 1.4.9 WINTER STABILIZATION

VARIOUS MEASURES SPECIFIC TO WINTER MAY BE NECESSARY SHOULD THE PROJECT EXTEND INTO WINTER (OCTOBER 15 THROUGH APRIL 15). REFER TO THE LOW RISK SITE HANDBOOK FOR GUIDANCE.

#### 1.4.10 STABILIZE SOIL AT FINAL GRADE

EXPOSED SOIL MUST BE STABILIZED WITHIN 48 HOURS OF REACHING FINAL GRADE.

SEED, MULCH, FERTILIZER AND LIME SHALL BE USED TO ESTABLISH PERMANENT VEGETATION. FOR SLOPES STEEPER THAN 1:3, BIODEGRADABLE EROSION CONTROL MATTING OR AN EQUIVALENT SHALL BE USED INSTEAD OF MULCH.

#### 1.4.11 DE-WATERING ACTIVITIES

DISCHARGE FROM DEWATERING ACTIVITIES THAT FLOWS OFF OF THE CONSTRUCTION SITE MUST NOT CAUSE OR CONTRIBUTE TO A VIOLATION OF THE VERMONT WATER QUALITY STANDARDS.

SEDIMENT CONTAINMENT BAGS (FILTER BAGS) FOR HEADWALL WORK WILL BE USED AS NECESSARY AND AS DIRECTED BY THE ENGINEER. SEE SHEET 34 FOR DETAIL.

#### 1.4.12 INSPECT YOUR SITE

INSPECT THE PROJECT SITE BASED ON SPECIAL PROVISION REQUIREMENTS.

### 1.5 SEQUENCE AND STAGING

THIS SECTION WILL BE DEVELOPED BY THE CONTRACTOR USING THE GUIDANCE OUTLINED IN THE VTRANS EPSC PLAN CONTRACTOR CHECKLIST.

#### 1.5.2 OFF-SITE ACTIVITIES

IN ADDITION TO THE CONTRACTOR CHECKLIST ANY ACTIVITIES OUTSIDE THE CONSTRUCTION LIMITS SHALL FOLLOW SUBSECTIONS 105.25- 105.29 OF THE STANDARD SPECIFICATIONS FOR CONSTRUCTION.





PROJECT NAME: BRIDPORT  
PROJECT NUMBER: STP CULV(29)

FILE NAME: zllc264epsc nar_br2.dgn  
PROJECT LEADER: M. CHENETTE  
DESIGNED BY: J. HUNGERFORD  
EPSC NARRATIVE - ECN 1 - BR2

PLOT DATE: 8/22/2014  
DRAWN BY: L. BUXTON  
CHECKED BY: M. CHENETTE  
SHEET 31 OF 57

**LEGEND**

 STABILIZED CONSTRUCTION ENTRANCE

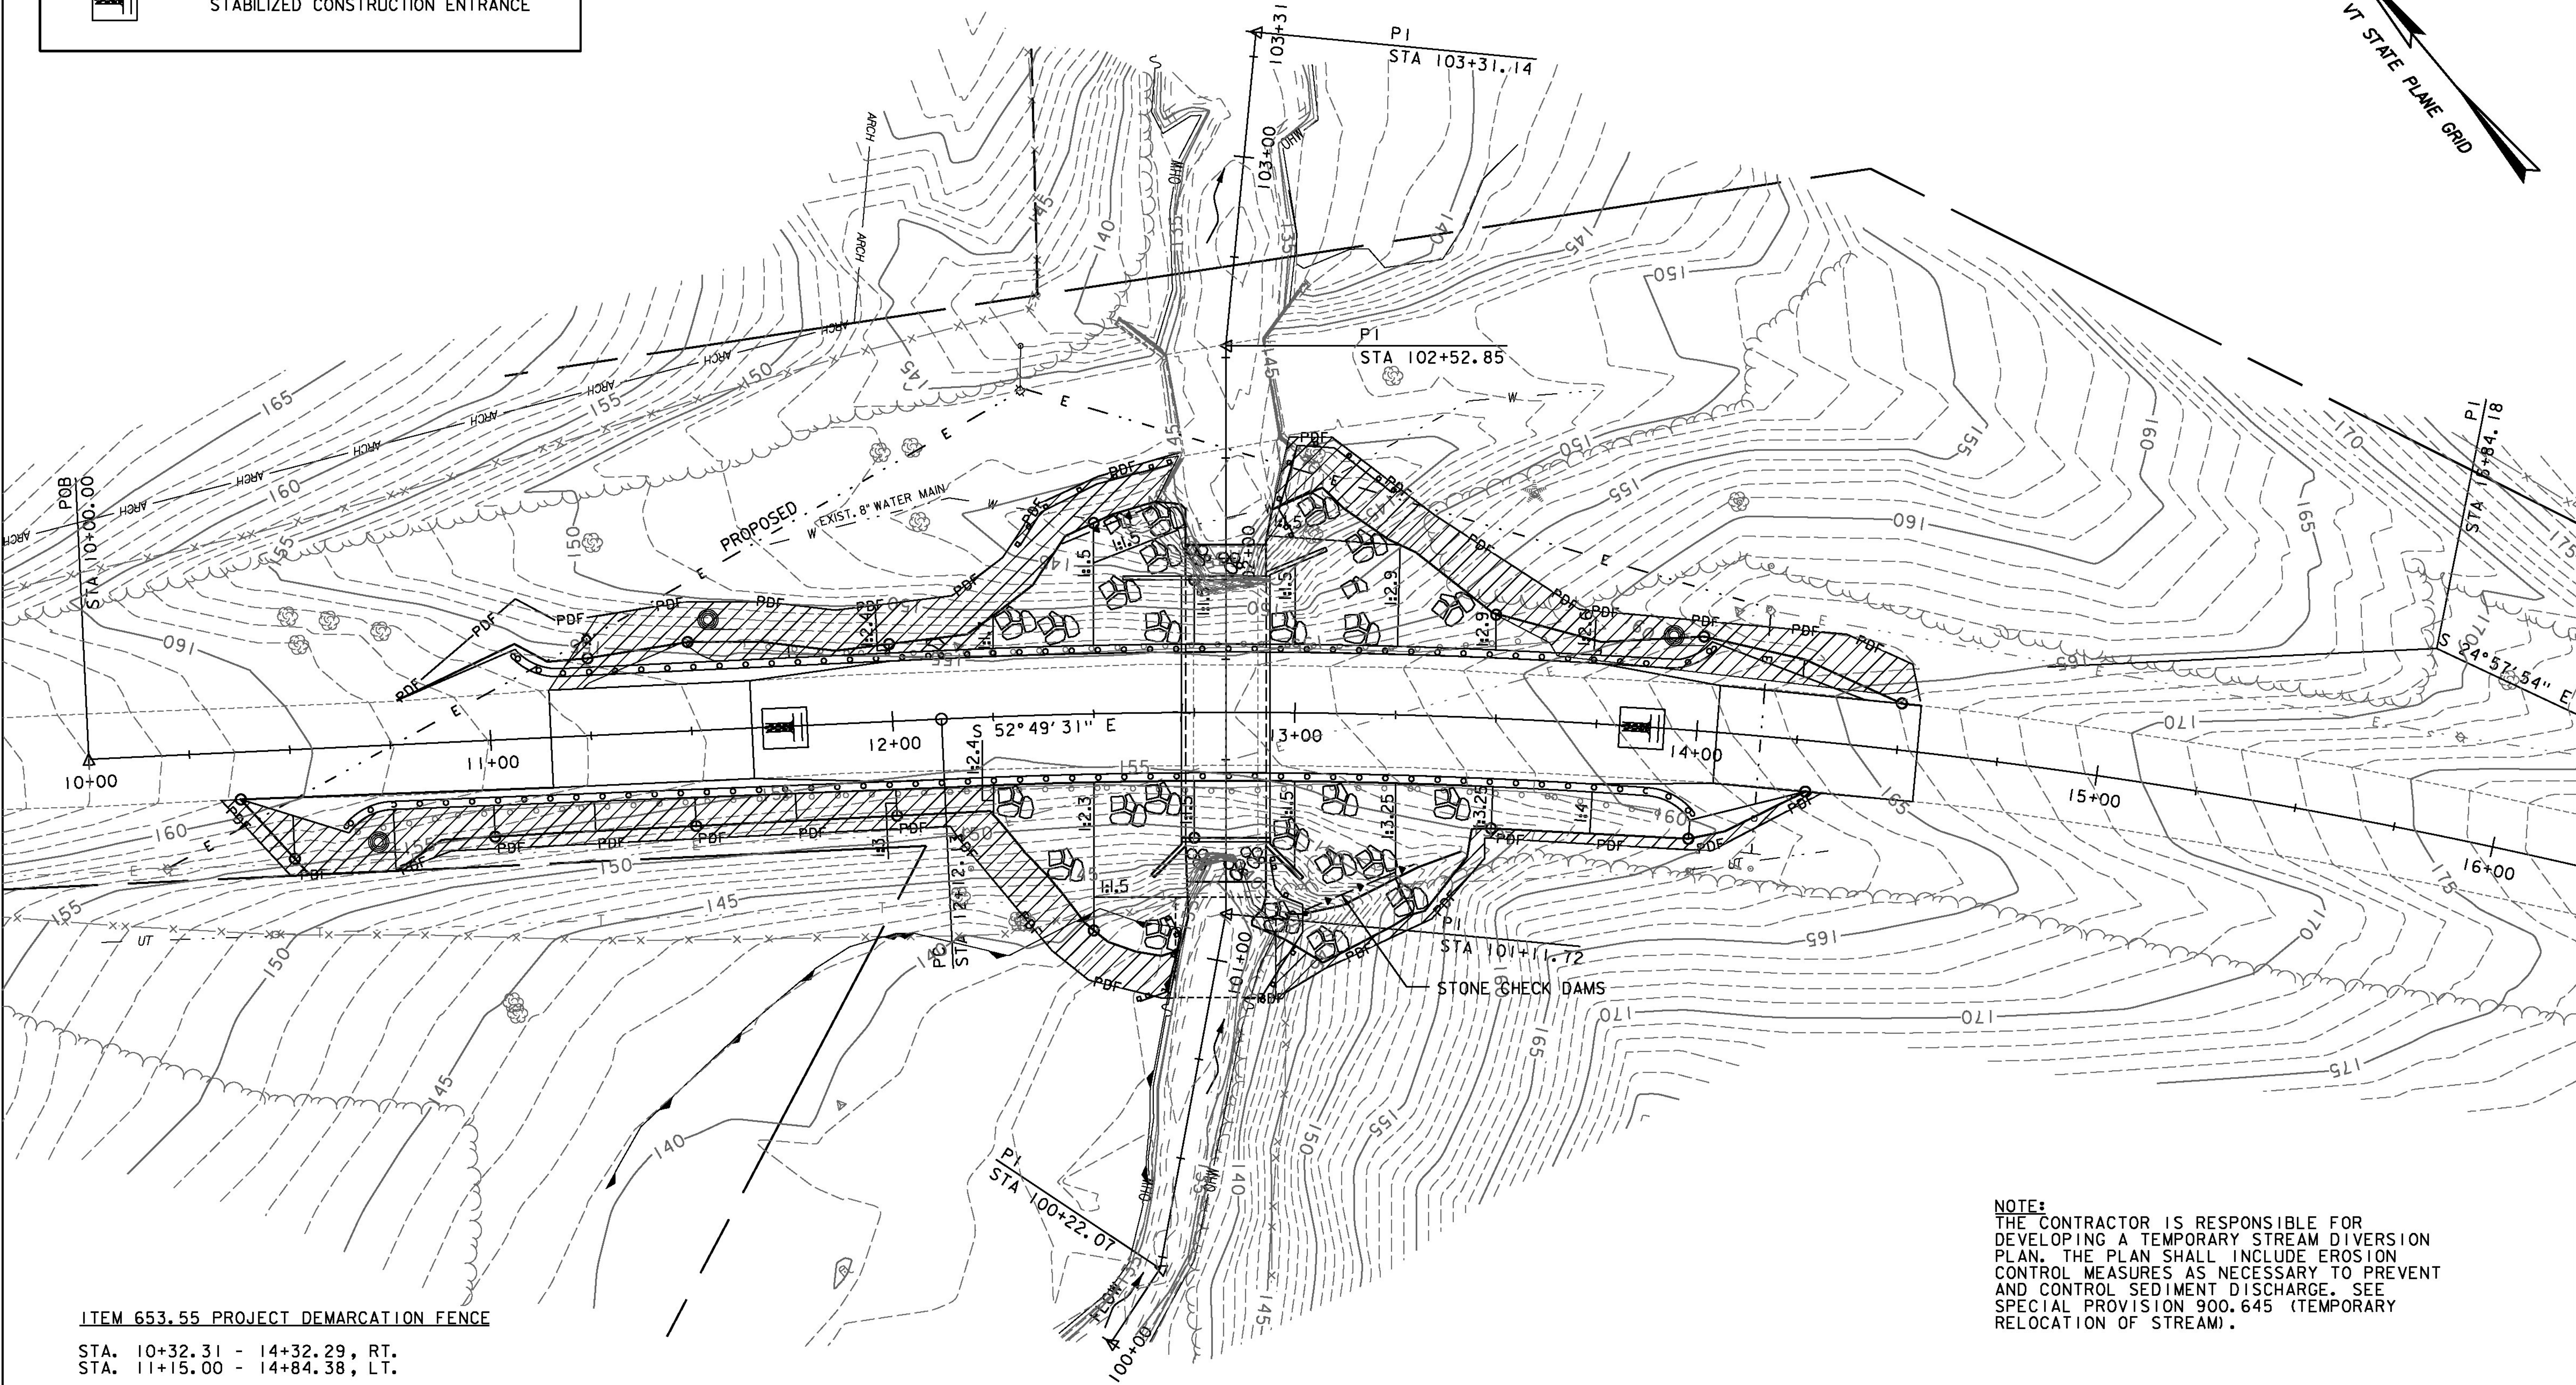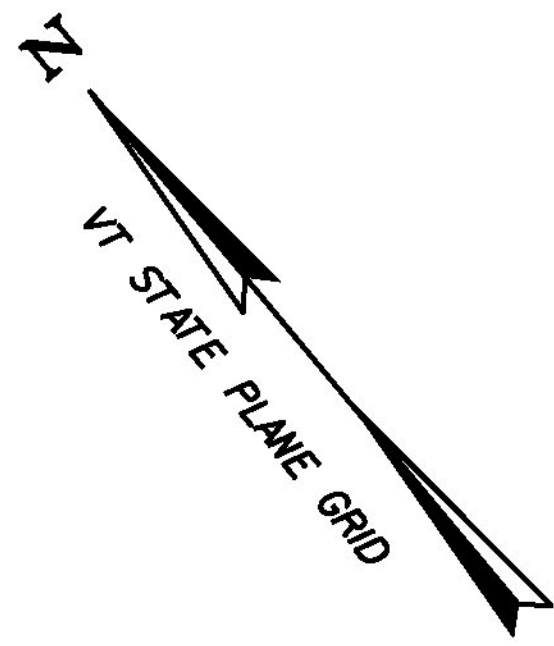


ITEM 653.55 PROJECT DEMARCATION FENCE

STA. 10+32.31 - 14+32.29, RT.  
STA. 11+15.00 - 14+84.38, LT.

ITEM 649.51 GEOTEXTILE FOR SILT FENCE

SEE LOCATIONS, THIS SHEET.

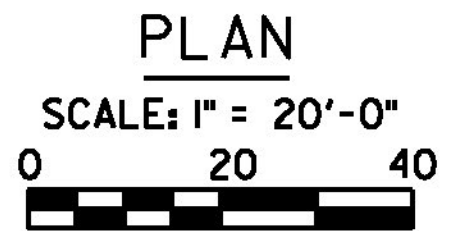


**NOTE:**  
THE CONTRACTOR IS RESPONSIBLE FOR DEVELOPING A TEMPORARY STREAM DIVERSION PLAN. THE PLAN SHALL INCLUDE EROSION CONTROL MEASURES AS NECESSARY TO PREVENT AND CONTROL SEDIMENT DISCHARGE. SEE SPECIAL PROVISION 900.645 (TEMPORARY RELOCATION OF STREAM).

PROJECT NAME: BRIDPORT  
PROJECT NUMBER: STP CULV(29)

FILE NAME: zllc264bdr_ero_br2.dgn  
PROJECT LEADER: M. CHENETTE  
DESIGNED BY: J. HUNGERFORD  
EPSC CONST. SITE PLAN - ECP 1- BR2

PLOT DATE: 8/22/2014  
DRAWN BY: L. BUXTON  
CHECKED BY: M. CHENETTE  
SHEET 32 OF 57



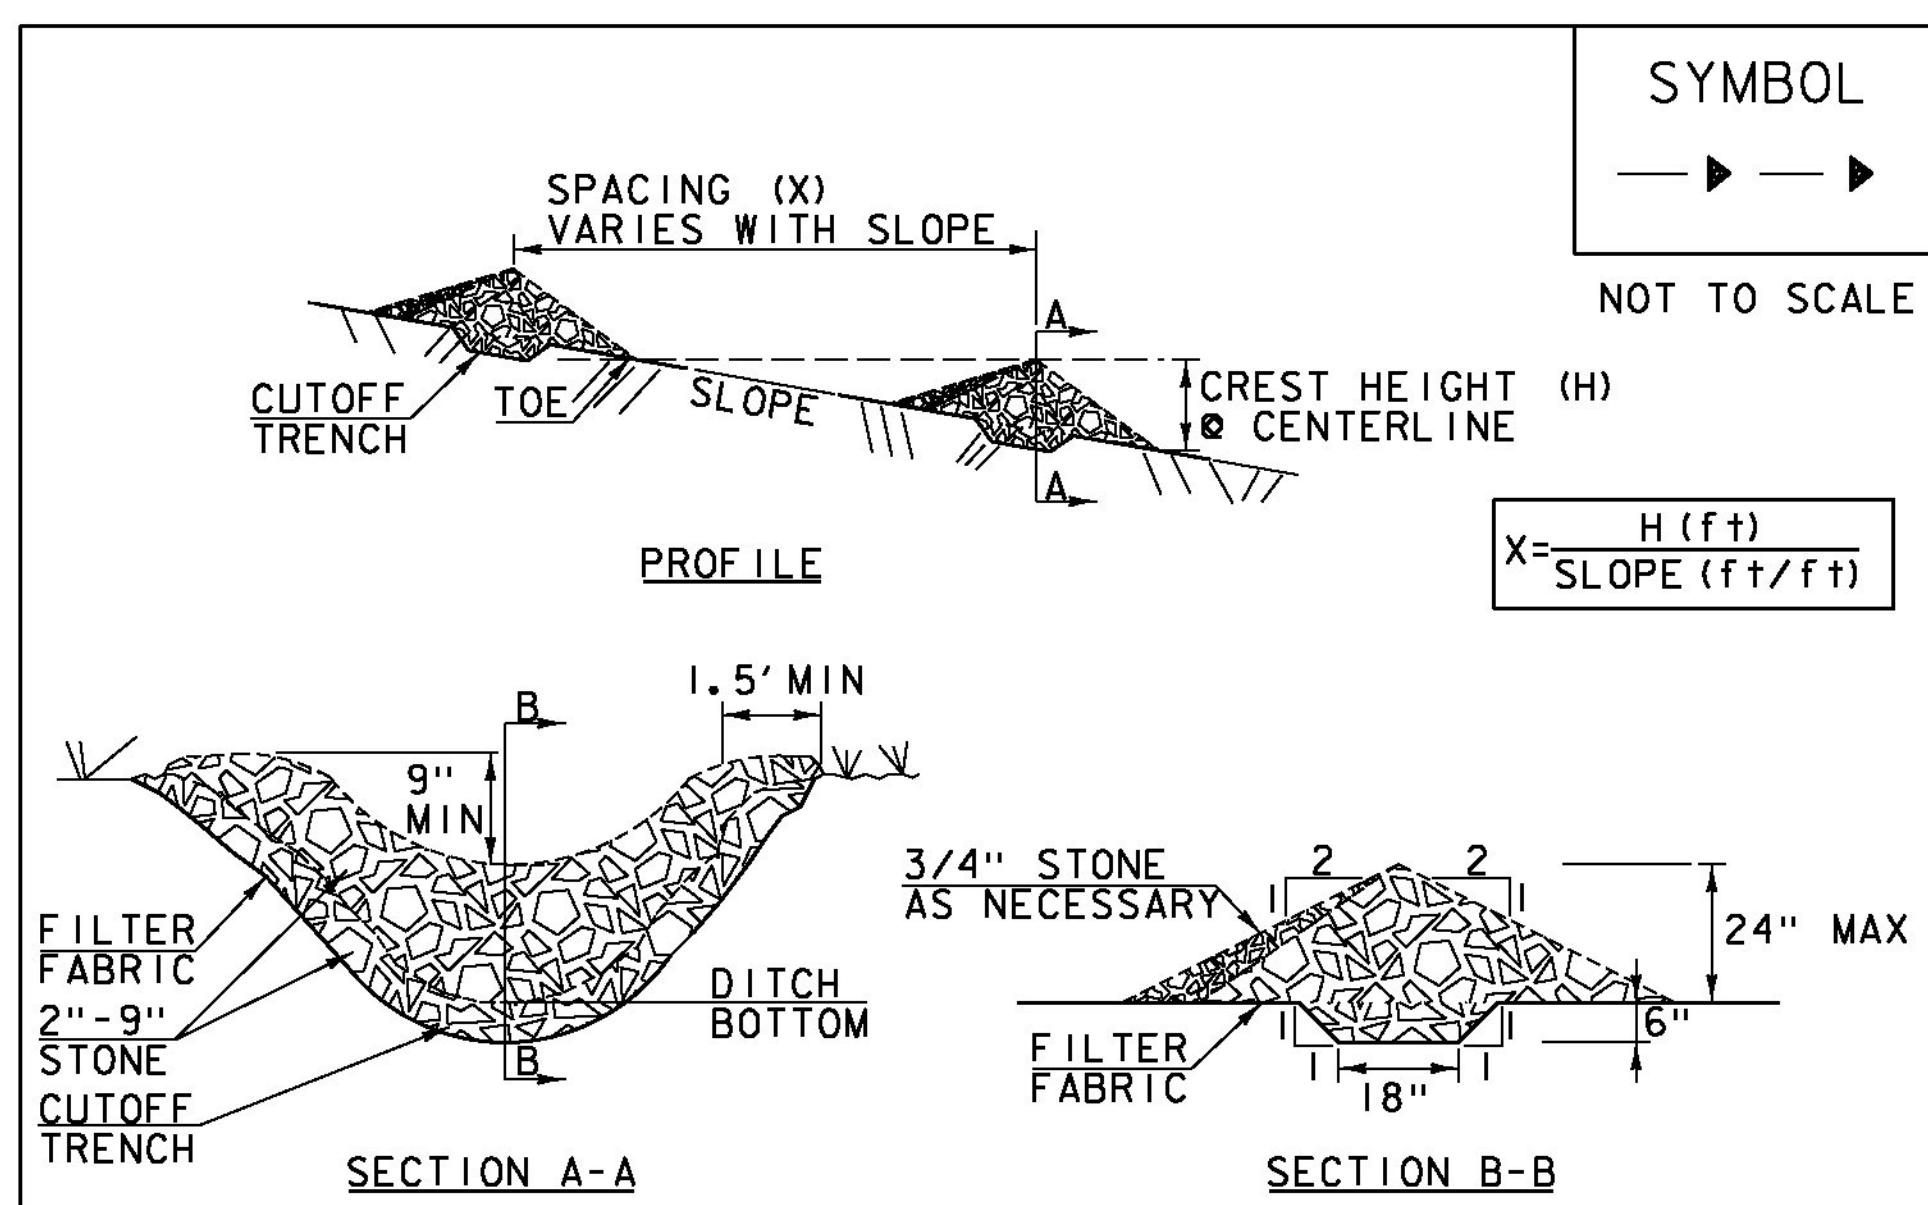

SYMBOL  
  
 NOT TO SCALE

**CONSTRUCTION SPECIFICATIONS**


1. STONE WILL BE PLACED ON A FILTER FABRIC FOUNDATION.
2. CHECK DAMS SHALL BE SPACED SO THAT THE ELEVATION OF THE CREST OF THE DOWNSTREAM DAM IS AT THE SAME ELEVATION AS THE TOE OF THE UPSTREAM DAM.
3. 3/4" FILTERING STONE MAY BE ADDED TO THE FACE OF THE CHECK DAM AS NECESSARY.
4. EXTEND THE STONE A MINIMUM OF 1.5' BEYOND THE DITCH BANKS TO PREVENT CUTTING AROUND THE DAM.
5. PROTECT CHANNEL DOWNSTREAM OF THE LOWEST CHECK DAM FROM SCOUR AND EROSION WITH STONE OR LINER AS APPROPRIATE.
6. ENSURE THAT CHANNEL APPURTENANCES SUCH AS CULVERT ENTRANCES BELOW CHECK DAMS ARE NOT SUBJECT TO DAMAGE OR BLOCKAGE FROM DISPLACED STONE.
7. MAXIMUM DRAINAGE AREA 2 ACRES.

ADAPTED FROM DETAILS PROVIDED BY: NEW YORK STATE DEC  
 ORIGINALLY DEVELOPED BY USDA-NRCS  
 VERMONT DEPARTMENT OF ENVIRONMENTAL CONSERVATION

**CHECK DAM**

NOTES:  
 REFER TO "THE VERMONT STANDARDS & SPECIFICATIONS FOR EROSION PREVENTION & SEDIMENT CONTROL -2006-" FROM THE VT AGENCY OF NATURAL RESOURCES FOR ADDITIONAL GUIDANCE.  
 THIS WORK SHALL BE PERFORMED IN ACCORDANCE WITH SECTION 653 FOR TEMPORARY STONE CHECK DAM, TYPE I (PAY ITEM 653.25)

REVISIONS	
MARCH 21, 2008	WHF
JANUARY 8, 2009	WHF

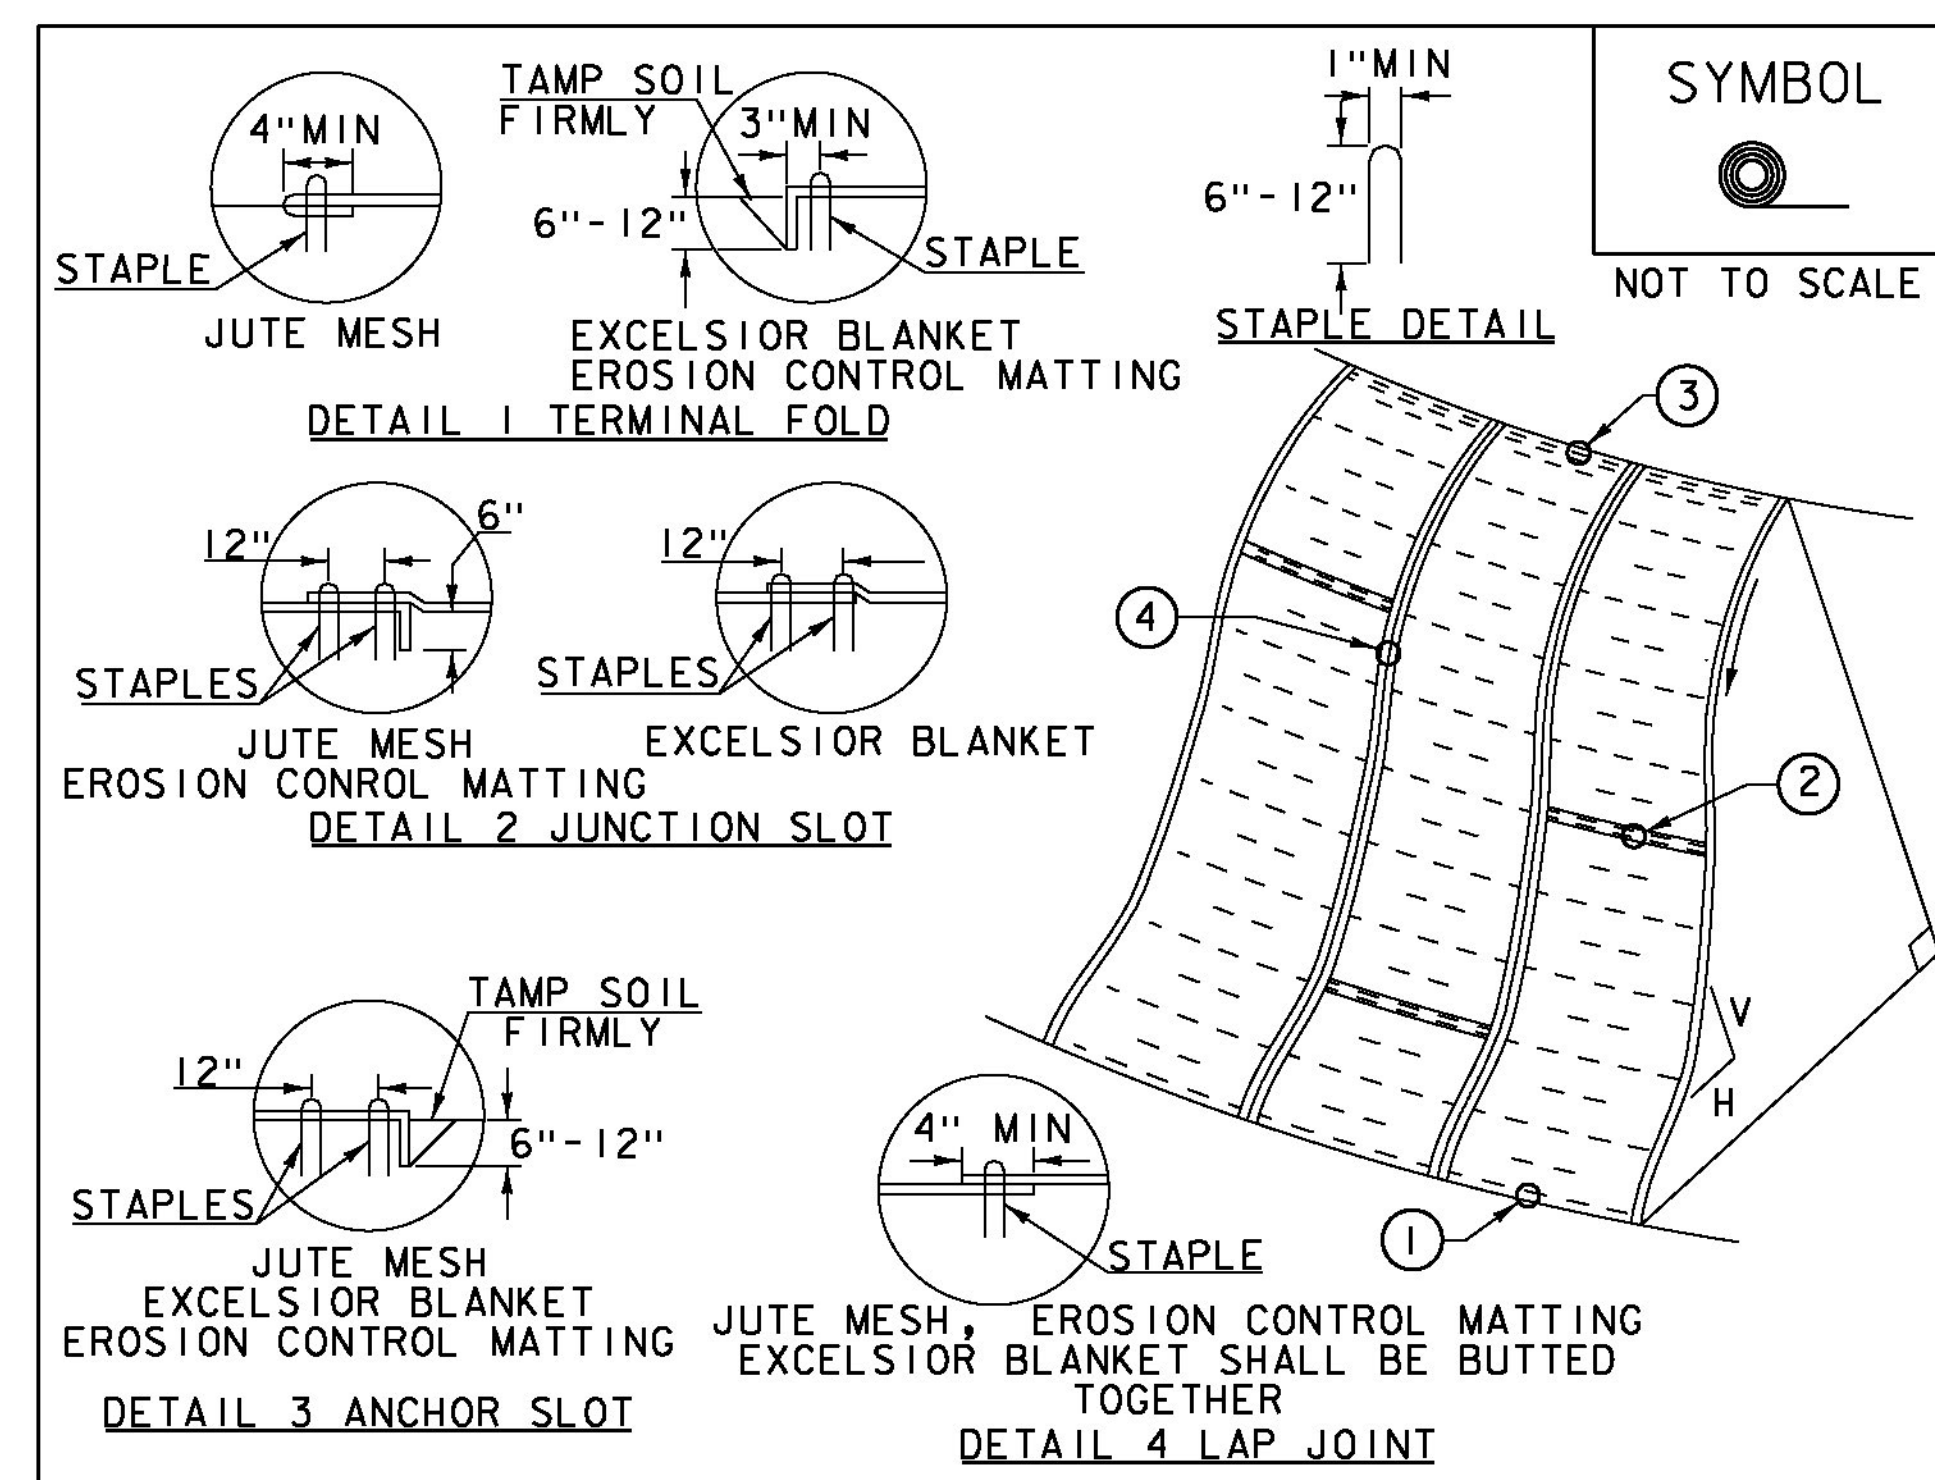

SYMBOL  
  
 NOT TO SCALE

**CONSTRUCTION SPECIFICATIONS**


1. APPLY TO SLOPES GREATER THAN 3H:1V OR WHERE NECESSARY TO AID IN ESTABLISHING VEGETATION.
2. APPLY FERTILIZER, LIME SEED PRIOR TO PLACING MATTING.
3. STAPLES ARE TO BE PLACED ALTERNATELY, IN COLUMNS APPROXIMATELY 2' APART AND IN ROWS APPROXIMATELY 3' APART. APPROXIMATELY 175 STAPLES ARE REQUIRED PER 4' X 225' ROLL OF MATERIAL AND 125 STAPLES ARE REQUIRED PER 4' X 150' ROLL OF MATERIAL.
4. DISTURBED AREAS SHALL BE SMOOTHLY GRADED. EROSION CONTROL MATERIAL SHALL BE PLACED LOOSELY OVER GROUND SURFACE. DO NOT STRETCH.
5. ALL TERMINAL ENDS AND TRANSVERSE LAPS SHALL BE STAPLED AT APPROXIMATELY 12" INTERVALS.

ADAPTED FROM DETAILS PROVIDED BY: NEW YORK STATE DEC  
 ORIGINALLY DEVELOPED BY USDA-NRCS  
 VERMONT DEPARTMENT OF ENVIRONMENTAL CONSERVATION

**ROLLED EROSION CONTROL PRODUCT (RECP) SIDE SLOPE**

NOTES:  
 REFER TO "THE VERMONT STANDARDS & SPECIFICATIONS FOR EROSION PREVENTION & SEDIMENT CONTROL -2006-" FROM THE VT AGENCY OF NATURAL RESOURCES FOR ADDITIONAL GUIDANCE.  
 THIS WORK SHALL BE PERFORMED IN ACCORDANCE WITH SECTION 653 AND AS SHOWN IN THE PLANS FOR TEMPORARY EROSION MATTING (PAY ITEM 653.20) OR PERMANENT EROSION MATTING (PAY ITEM 653.2).

REVISIONS	
APRIL 16, 2007	JMF
JANUARY 13, 2009	WHF

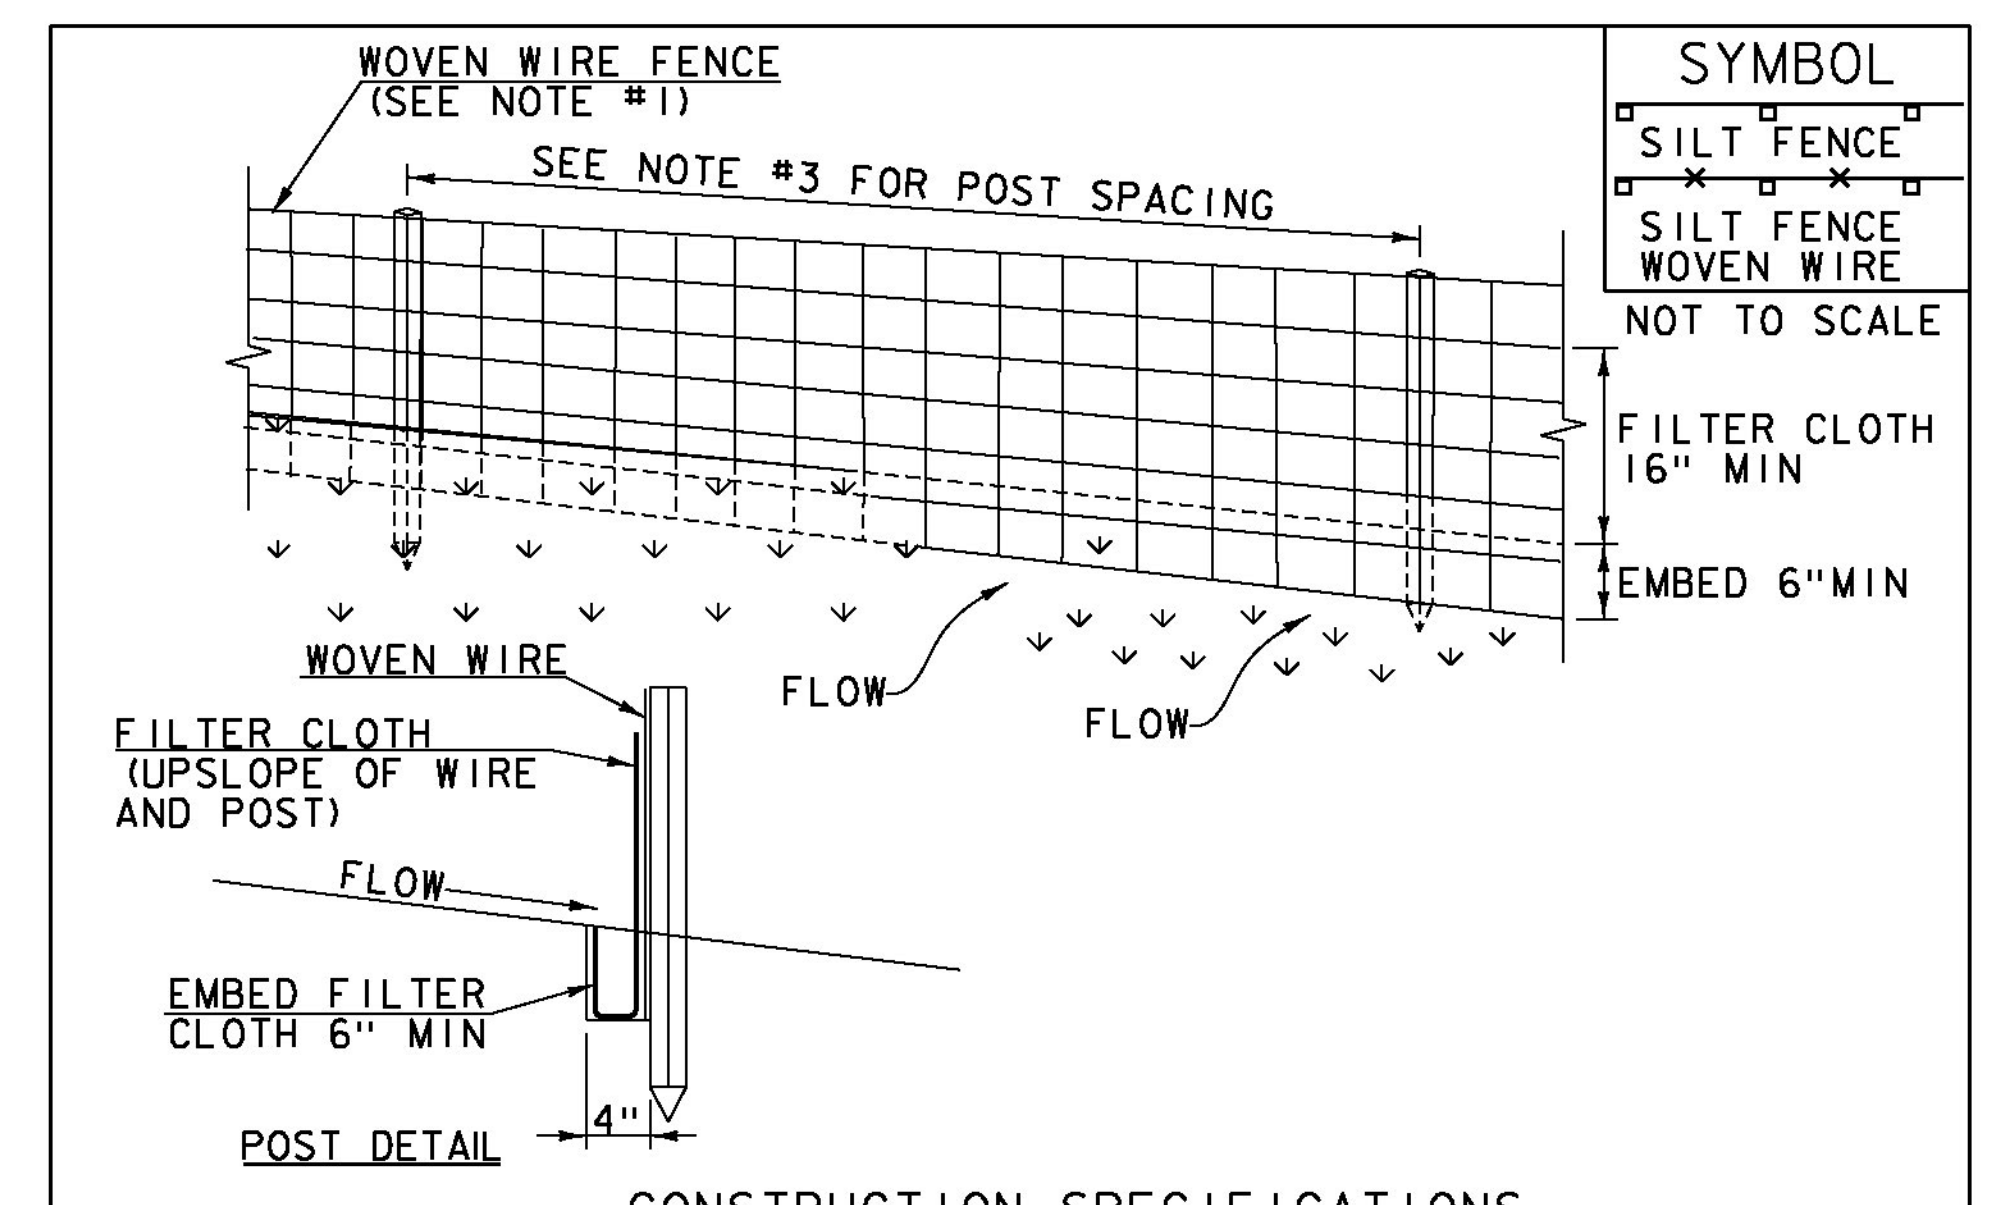

SYMBOL  
  
 NOT TO SCALE

**CONSTRUCTION SPECIFICATIONS**

1. WOVEN WIRE REINFORCED FENCE IS REQUIRED WITHIN 100' UPSLOPE OF RECEIVING WATERS WHEN THE PROJECT FALLS UNDER A CONSTRUCTION STORMWATER PERMIT. WOVEN WIRE SHALL BE A MIN. 14 GAUGE WITH A 6" MAX. MESH OPENING.
2. FILTER CLOTH SHALL BE EITHER FILTER X, MIRAF1100X, STABILINKA T140N OR APPROVED EQUIVALENT.
3. POST SPACING FOR WIRE-BACKED FENCE SHALL BE 10' MAXIMUM. FOR FILTER-CLOTH FENCE, WHEN ELONGATION IS >50%, POST SPACING SHALL NOT EXCEED 4' AND WHEN ELONGATION IS <50%, POST SPACING SHALL NOT EXCEED 6'.
4. WOVEN WIRE FENCE IS TO BE FASTENED SECURELY TO FENCE POSTS WITH WIRE TIES. FILTER CLOTH IS TO BE FASTENED SECURELY TO WOVEN WIRE FENCE WITH TIES SPACED EVERY 24" AT TOP AND MID SECTION.
5. WHEN TWO SECTIONS OF FILTER CLOTH ADJOIN EACH OTHER THEY SHALL BE OVER-LAPPED BY 6" AND FOLDED.
6. MAINTENANCE SHALL BE PERFORMED AS NEEDED AND MATERIAL REMOVED WHEN SEDIMENT REACHES HALF OF FABRIC HEIGHT.

ADAPTED FROM DETAILS PROVIDED BY: NEW YORK STATE DEC  
 ORIGINALLY DEVELOPED BY USDA-NRCS  
 VERMONT DEPARTMENT OF ENVIRONMENTAL CONSERVATION

**SILT FENCE**

NOTES:  
 REFER TO "THE VERMONT STANDARDS & SPECIFICATIONS FOR EROSION PREVENTION & SEDIMENT CONTROL -2006-" FROM THE VT AGENCY OF NATURAL RESOURCES FOR ADDITIONAL GUIDANCE.  
 THIS WORK SHALL BE PERFORMED IN ACCORDANCE WITH SECTION 649 AND AS SHOWN IN THE PLANS FOR GEOTEXTILE FOR SILT FENCE (PAY ITEM 649.51) OR GEOTEXTILE FOR SILT FENCE, WOVEN WIRE REINFORCED (PAY ITEM 649.515).

REVISIONS	
MARCH 21, 2008	WHF
DECEMBER 11, 2008	WHF
JANUARY 13, 2009	WHF



VAOT RURAL AREA MIX					
% WEIGHT	LBS/AC		NAME	GERM %	PURITY %
	BROADCAST	HYDROSEED			
37.5%	22.5	45	CREeping RED FESCUE	85%	98%
37.5%	22.5	45	TALL FESCUE	90%	95%
5.0%	3	6	RED TOP	90%	95%
15.0%	9	18	BIRDSFOOT TREFOIL	85%	98%
5.0%	3	6	ANNUAL RYE GRASS	85%	95%
100%	60	120			

VAOT URBAN AREA MIX					
% WEIGHT	LBS/AC		NAME	GERM %	PURITY %
	BROADCAST	HYDROSEED			
42.5%	34	68	CREeping RED FESCUE	85%	98%
10.0%	8	16	PERENNIAL RYE GRASS	90%	95%
42.5%	34	68	KENTUCKY BLUE GRASS	85%	85%
5.0%	4	8	ANNUAL RYE GRASS	85%	95%
100%	80	160			

SOIL AMENDMENT GUIDANCE			
FERTILIZER		LIME	
BROADCAST	HYDROSEED	BROADCAST	HYDROSEED
10-20-10	FOLLOW	PELLETIZED	FOLLOW
500 LBS/AC	MANUFACTURER	2 TONS/AC	MANUFACTURER


**CONSTRUCTION GUIDANCE**

- RURAL SEED MIX: USE AS INDICATED IN THE PLANS AND/OR FOR ALL ESTABLISHED UPLAND (NON WETLAND) AREAS DISTURBED BY THE CONTRACTOR.
- URBAN SEED MIX: USE AS INDICATED IN THE PLANS AND/OR FOR ALL ESTABLISHED LAWN AREAS DISTURBED BY THE CONTRACTOR.
- ALL SEED MIXTURES: SHALL NOT HAVE A WEED CONTENT EXCEEDING 0.40% BY WEIGHT AND SHALL BE FREE OF ALL NOXIOUS SEED.
- FERTILIZER AND LIMESTONE: SHALL FOLLOW RATES SHOWN ON PLAN OR AS DIRECTED BY THE ENGINEER
- HAY MULCH: TO BE PLACED ON EARTH SLOPES AT THE RATE OF 2 TONS/ACRE, ACHIEVE 90% GROUND COVER OR AS DIRECTED BY THE ENGINEER.
- TOPSOIL: TO BE USED WITH SEED AS INDICATED ON THE PLANS, OR AS DIRECTED BY THE ENGINEER.
- HYDROSEEDING: ALTHOUGH GUIDANCE IS GIVEN ABOVE THE SITE CONDITIONS AND THE TYPE OF HYDROSEED WILL ULTIMATELY DICTATE THE AMOUNTS AND TYPES OF SOIL AMENDMENTS TO BE APPLIED
- TURF ESTABLISHMENT: PLACING SEED, FERTILIZER, LIME AND MULCH PRIOR TO SEPTEMBER 15 AND AFTER APRIL 15 CAN BETTER ENSURE A VIGOROUS GROWTH OF GRASS.

ADAPTED FROM VTRANS TECHNICAL LANDSCAPE MANUAL FOR ROADWAYS AND TRANSPORTATION FACILITIES

**TURF ESTABLISHMENT**

REVISIONS		
JUNE 23, 2009	WHF	
JANUARY 15, 2010	WHF	
FEBRUARY 16, 2011	WHF	

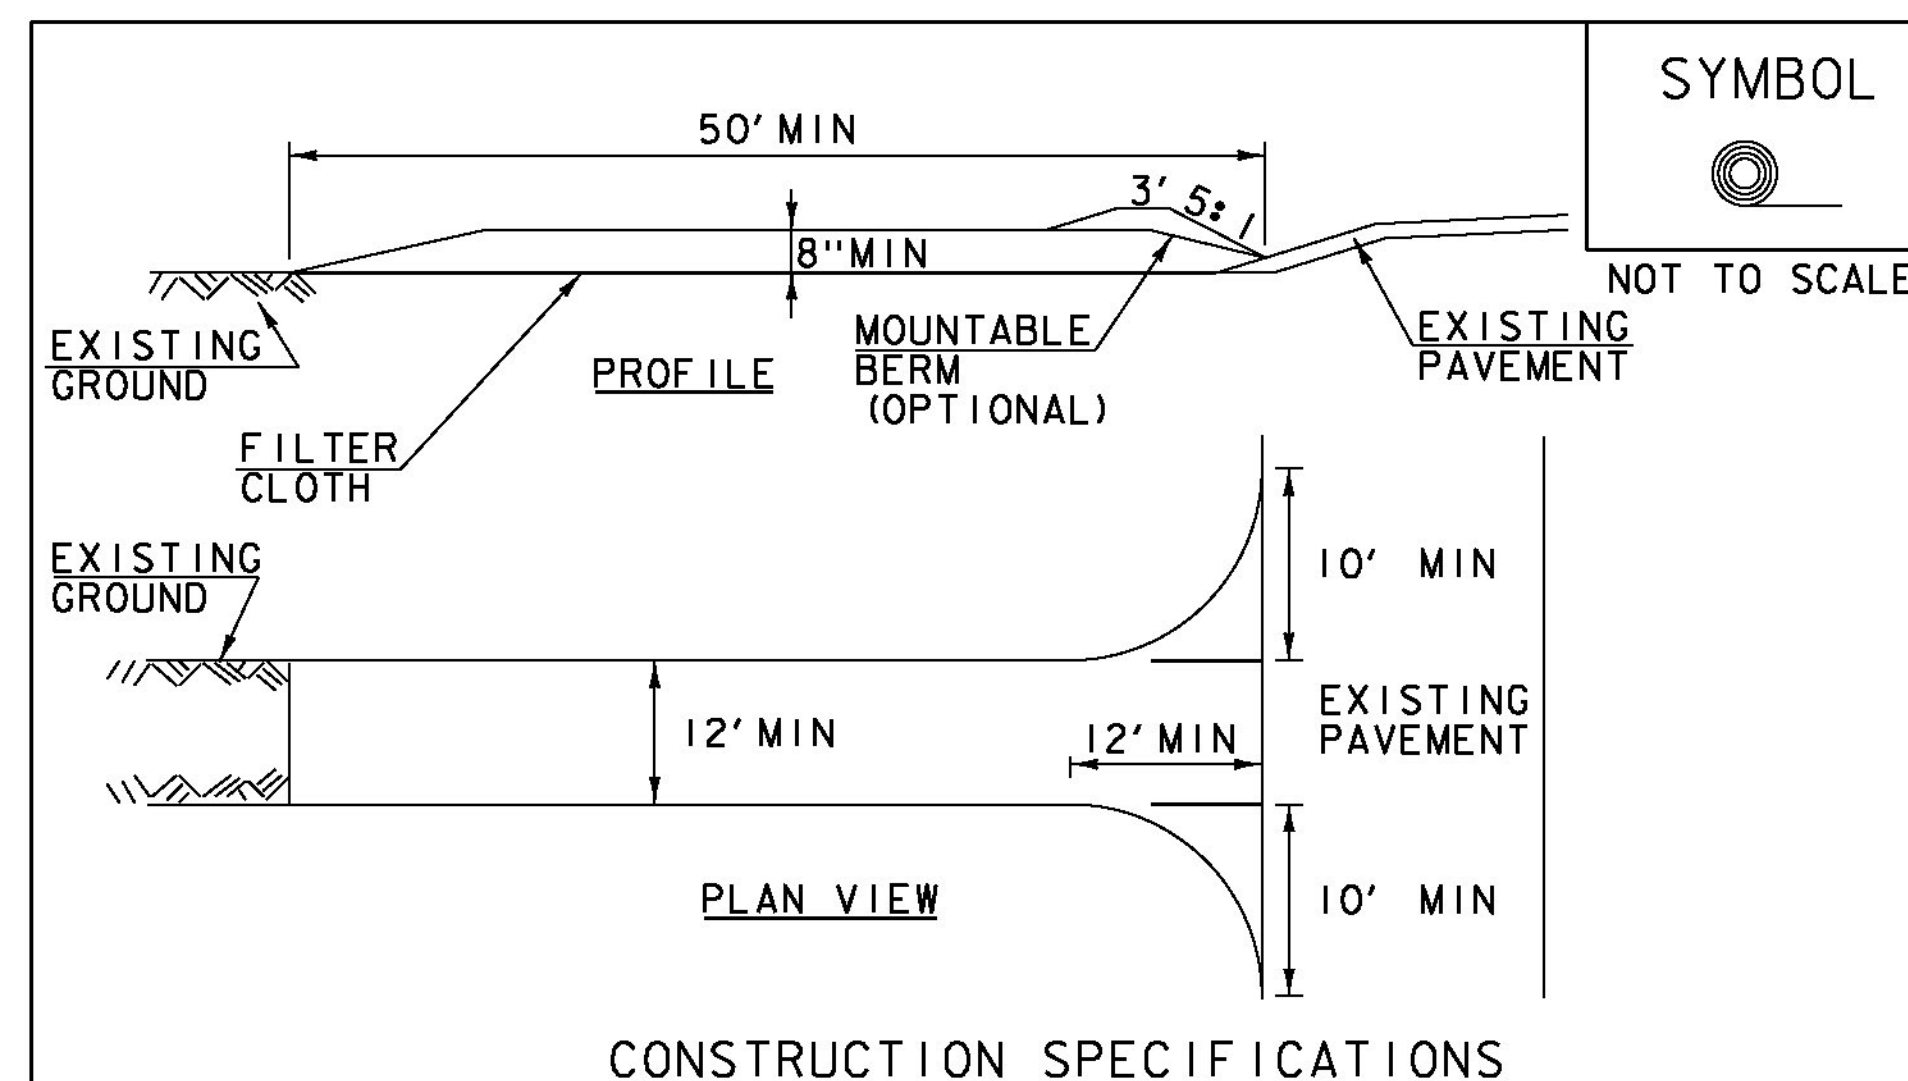

**CONSTRUCTION SPECIFICATIONS**

- STONE SIZE- USE 1-4" STONE, RECLAIMED OR RECYCLED CONCRETE EQUIVALENT.
- LENGTH- NOT LESS THAN 50' (EXCEPT ON A SINGLE RESIDENCE LOT WHERE A 30' MINIMUM LENGTH APPLIES).
- THICKNESS- NOT LESS THAN 8".
- WIDTH- 12' MINIMUM, BUT NOT LESS THAN THE FULL WIDTH AT POINTS WHERE INGRESS OR EGRESS OCCURS. 24' IF SINGLE ENTRANCE TO SITE.
- GEOTEXTILE MUST BE PLACED OVER THE ENTIRE AREA PRIOR TO PLACING STONE.
- SURFACE WATER- ALL SURFACE WATER FLOWING OR DIVERTED TOWARD CONSTRUCTION ENTRANCES SHALL BE PIPED BENEATH THE ENTRANCE. IF PIPING IS IMPRACTICAL, A MOUNTABLE BERM WITH 5:1 SLOPES WILL BE PERMITTED.
- MAINTENANCE- THE ENTRANCE SHALL BE MAINTAINED IN A CONDITION WHICH WILL PREVENT TRACKING OR FLOWING OF SEDIMENT ONTO PUBLIC RIGHTS-OF-WAY, ALL SEDIMENT SPILLED, DROPPED, WASHED OR TRACKED ONTO PUBLIC RIGHTS-OF-WAY MUST BE REMOVED IMMEDIATELY.
- WHEN WASHING IS REQUIRED, IT SHALL BE DONE ON AN AREA STABILIZED WITH STONE AND WHICH DRAINS INTO AN APPROVED SEDIMENT TRAPPING DEVICE.
- PERIODIC INSPECTION AND NEEDED MAINTENANCE SHALL BE PROVIDED ACCORDING TO PERMIT REQUIREMENTS.


ADAPTED FROM DETAILS PROVIDED BY: NEW YORK STATE DEC  
ORIGINALLY DEVELOPED BY USDA-NRCS  
VERMONT DEPARTMENT OF ENVIRONMENTAL CONSERVATION

**STABILIZED CONSTRUCTION ENTRANCE**

NOTES:  
REFER TO "THE VERMONT STANDARDS & SPECIFICATIONS FOR EROSION PREVENTION & SEDIMENT CONTROL -2006- "FROM THE VT AGENCY OF NATURAL RESOURCES FOR ADDITIONAL GUIDANCE.

THIS WORK SHALL BE PERFORMED IN ACCORDANCE WITH SECTION 653 FOR VEHICLE TRACKING PAD (PAY ITEM 653.35) OR AS SPECIFIED IN THE CONTRACT.

REVISIONS		
MARCH 24, 2008	WHF	
JANUARY 13, 2009	WHF	

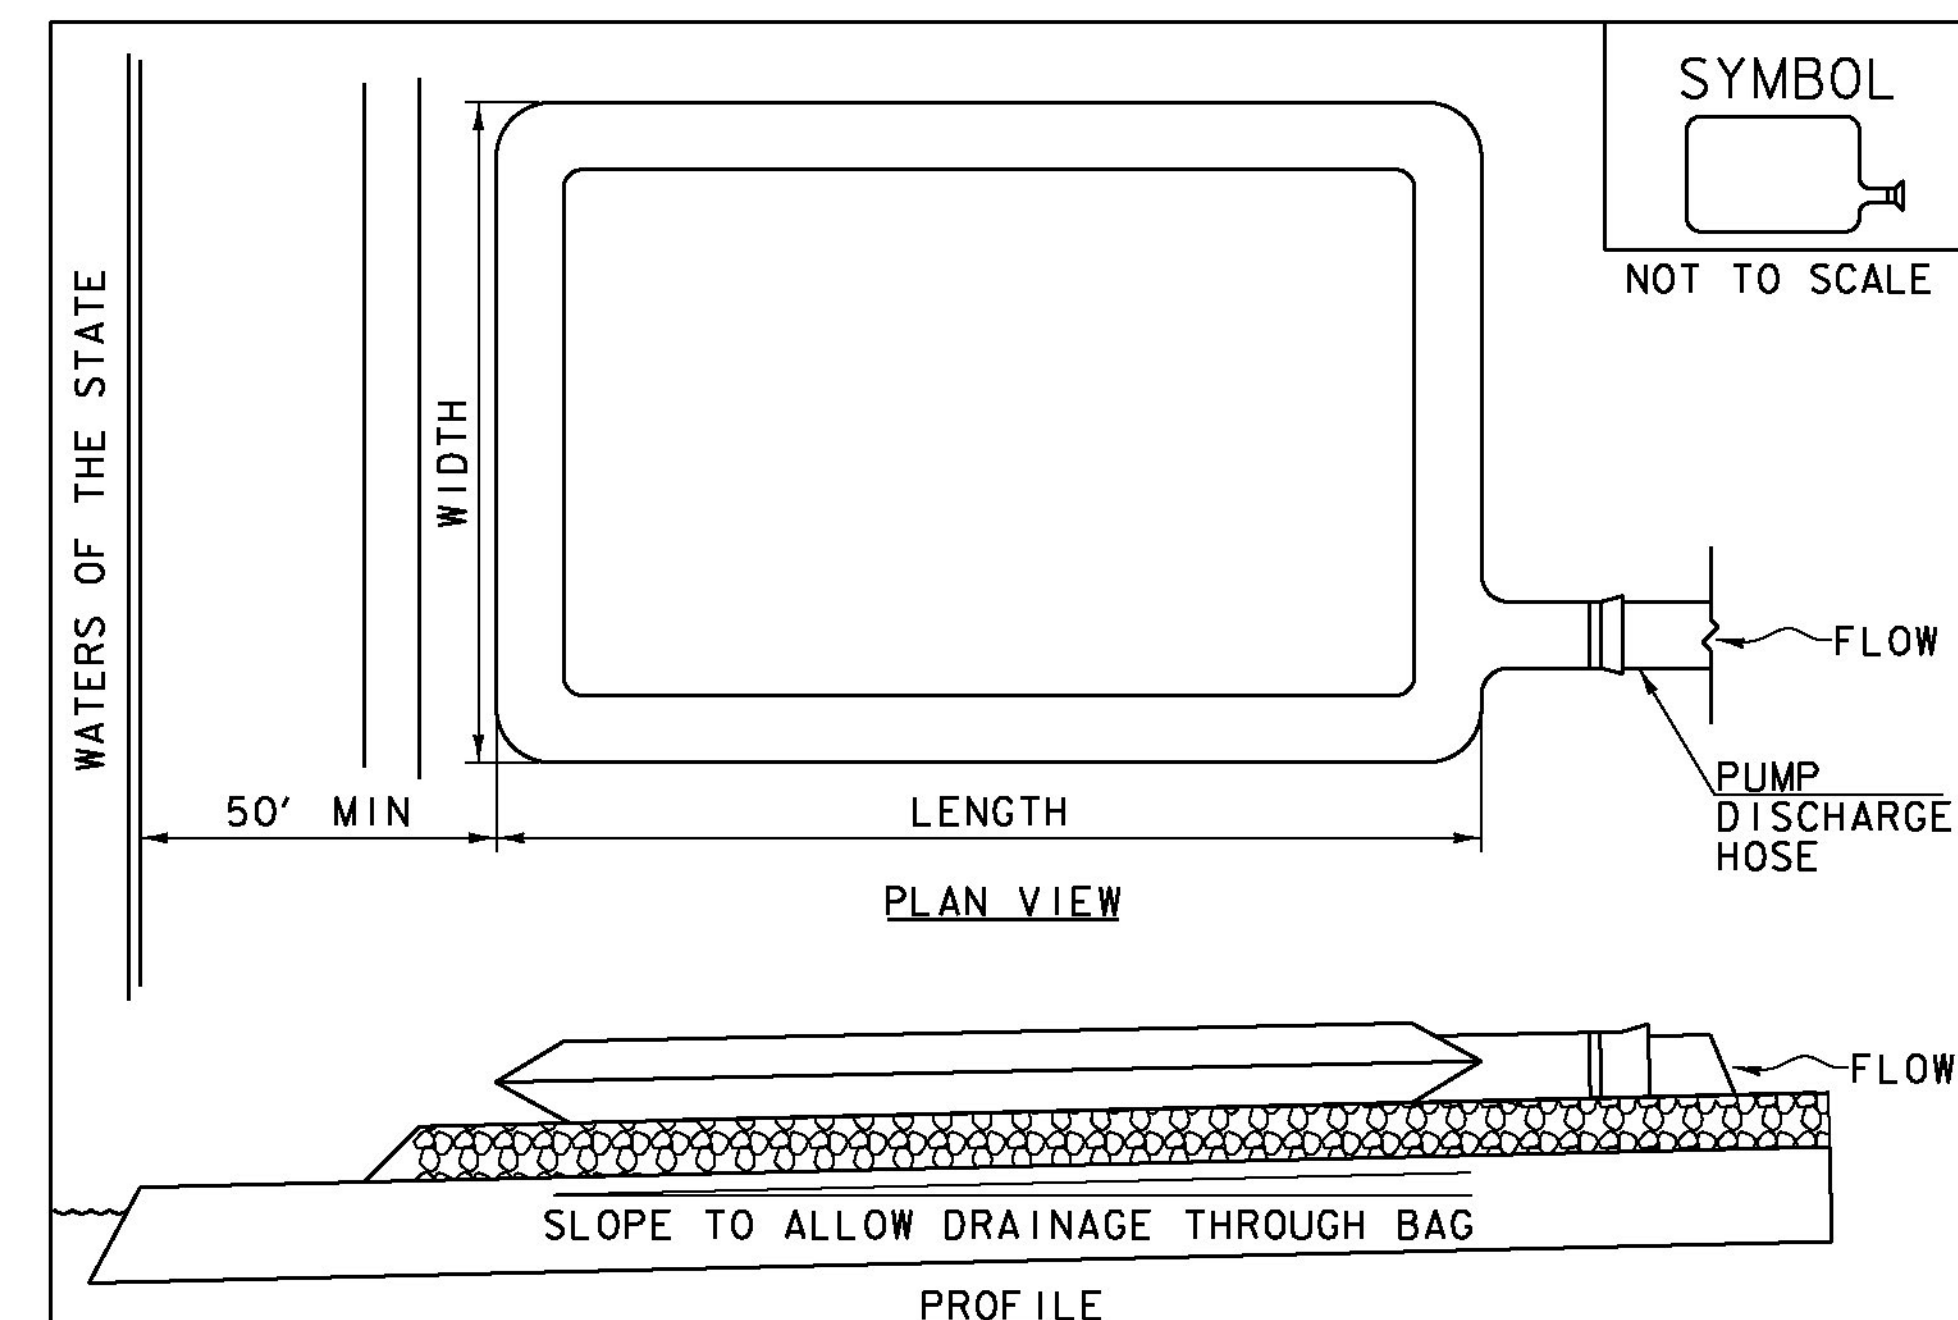

**CONSTRUCTION SPECIFICATIONS**

- THE PRIMARY PURPOSE OF FILTER BAG IS TO RETAIN SILT, SAND, AND FINES DURING DEWATERING OPERATIONS.
- FILTER BAGS SHALL BE INSTALLED ON A VEGETATED SLOPE GRADED TO ALLOW INCOMING WATER TO FLOW THROUGH THE BAG.
- FILTER BAGS MAY ALSO BE PLACED ON COARSE AGGREGATE, STONE, OR HAYBALES TO INCREASE FILTRATION EFFICIENCY.
- FILTER BAGS SHALL BE LOCATED A MINIMUM OF 50' FROM WATERS OF THE STATE UNLESS OTHERWISE APPROVED BY THE ENGINEER.
- THE NECK OF THE FILTER BAG SHALL BE STRAPPED TIGHTLY TO THE DISCHARGE HOSE.
- A FILTER BAG IS FULL WHEN IT NO LONGER CAN EFFICIENTLY FILTER SEDIMENT OR ALLOW WATER TO PASS AT A REASONABLE RATE.
- FILTER BAG SHALL BE DISPOSED OF AS APPROVED IN THE EPSC PLAN OR AS DIRECTED BY THE ENGINEER.

NOTES:  
REFER TO "THE VERMONT STANDARDS & SPECIFICATIONS FOR EROSION PREVENTION & SEDIMENT CONTROL -2006- "FROM THE VT AGENCY OF NATURAL RESOURCES FOR ADDITIONAL GUIDANCE.

THIS WORK SHALL BE PERFORMED IN ACCORDANCE WITH SECTION 653 FOR FILTER BAG (PAY ITEM 653.45) AND AS SPECIFIED IN THE CONTRACT.

REVISIONS		
MARCH 24, 2008	WHF	
JANUARY 13, 2009	WHF	



PROJECT NAME: BRIDPORT  
PROJECT NUMBER: STP CULV(29)

FILE NAME: zllc264epsc det_br2.dgn  
PROJECT LEADER: M. CHENETTE  
DESIGNED BY: J. HUNGERFORD  
EROSION CONTROL DETAILS - ECD 2 - BR2



PLOT DATE: 8/22/2014  
DRAWN BY: L. BUXTON  
CHECKED BY: M. CHENETTE  
SHEET 34 OF 57




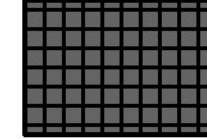
IMPACTS BELOW ORDINARY HIGH WATER

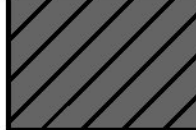	TEMPORARY IMPACTS BELOW OHW:	1391 SF
	PERMANENT IMPACTS BELOW OHW:	1146 SF

TOTAL IMPACTS: 2537 SF

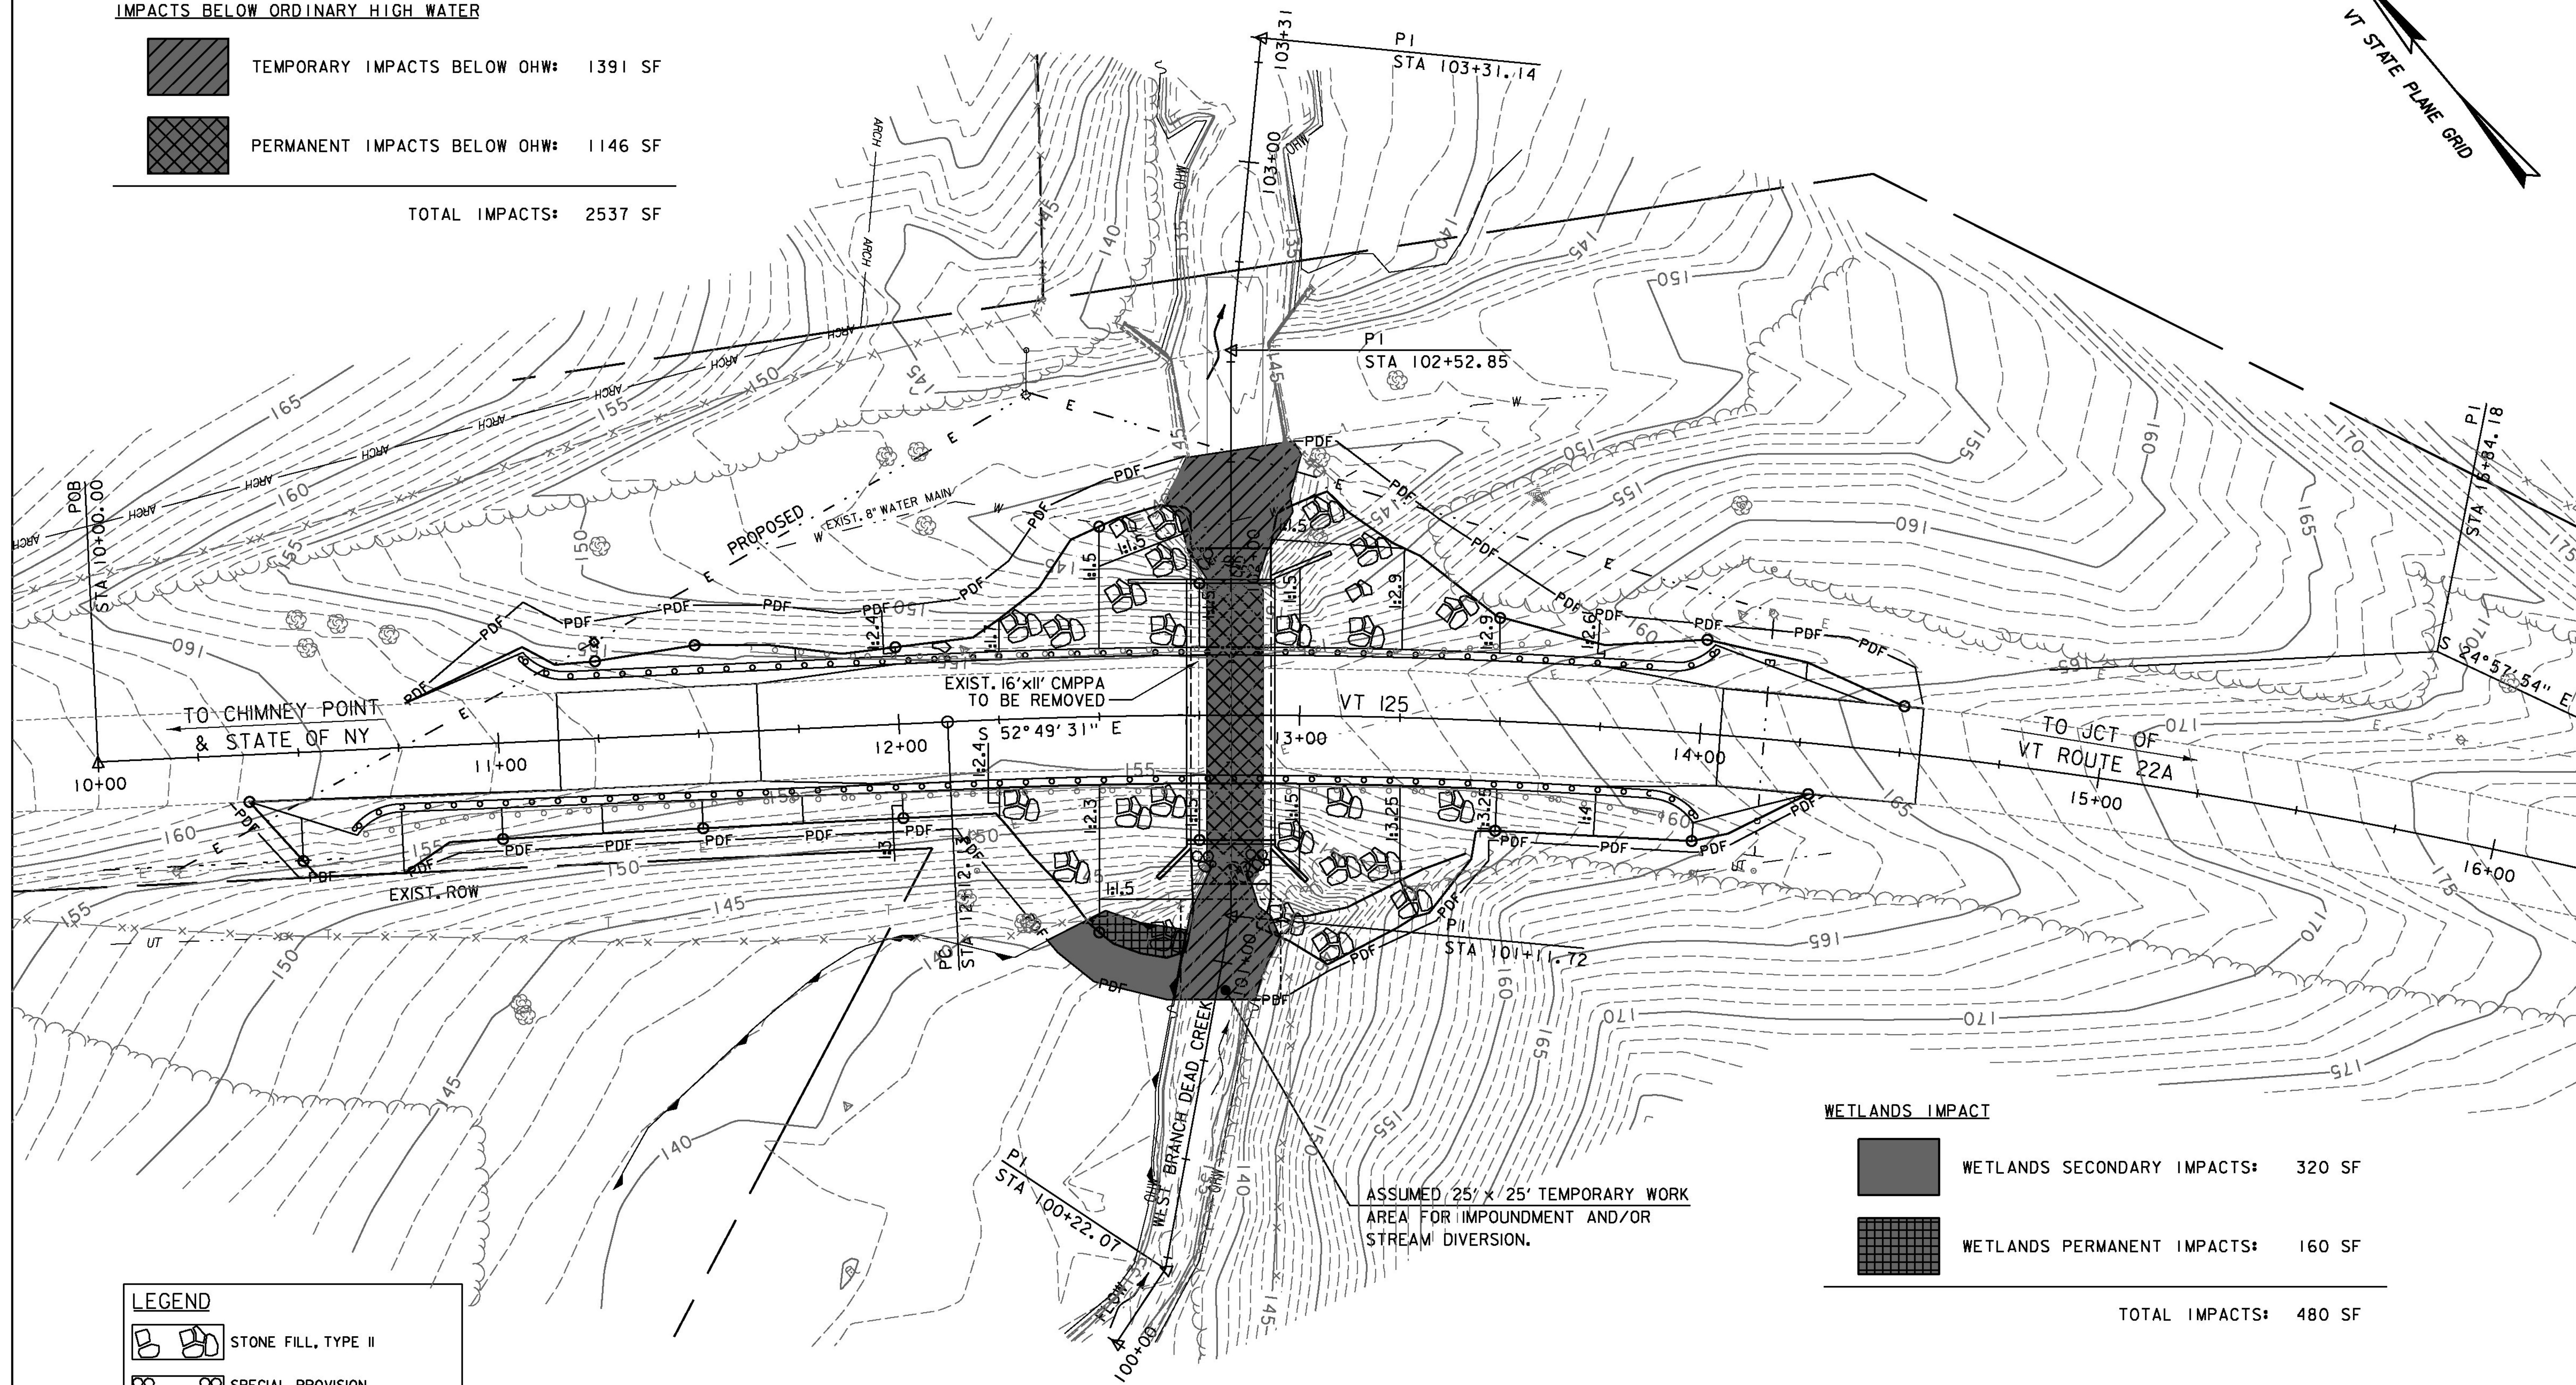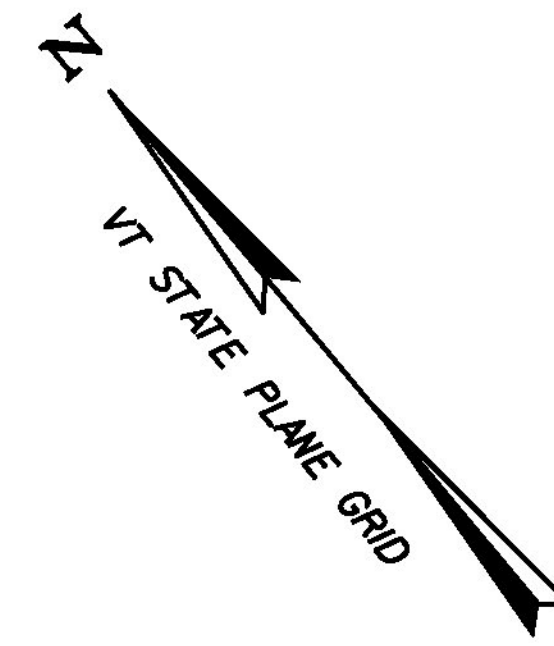




WETLANDS IMPACT

	WETLANDS SECONDARY IMPACTS:	320 SF
	WETLANDS PERMANENT IMPACTS:	160 SF

TOTAL IMPACTS: 480 SF

**LEGEND**

	STONE FILL, TYPE II
	SPECIAL PROVISION (STONE FILL, CULVERT LINING)


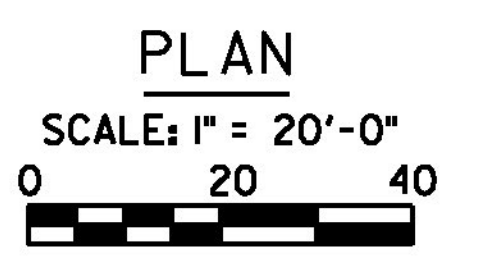


ASSUMED 25' x 25' TEMPORARY WORK AREA FOR IMPOUNDMENT AND/OR STREAM DIVERSION.

PROJECT NAME:	BRIDPORT	FILE NAME:	z1lc264bdr_impacts_br2.l.dgn	PLOT DATE:	8/22/2014
PROJECT NUMBER:	STP CULV(29)	PROJECT LEADER:	M. CHENETTE	DRAWN BY:	L. BUXTON
		DESIGNED BY:	J. HUNGERFORD	CHECKED BY:	M. CHENETTE
		PROJECT IMPACTS PLAN I - BR2		SHEET	35 OF 57





**WETLANDS BUFFER IMPACTS**

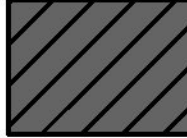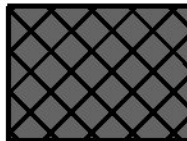

	WETLANDS BUFFER SECONDARY IMPACTS:	1340 SF
	WETLANDS BUFFER PERMANENT IMPACTS:	2708 SF


TOTAL IMPACTS: 4048 SF

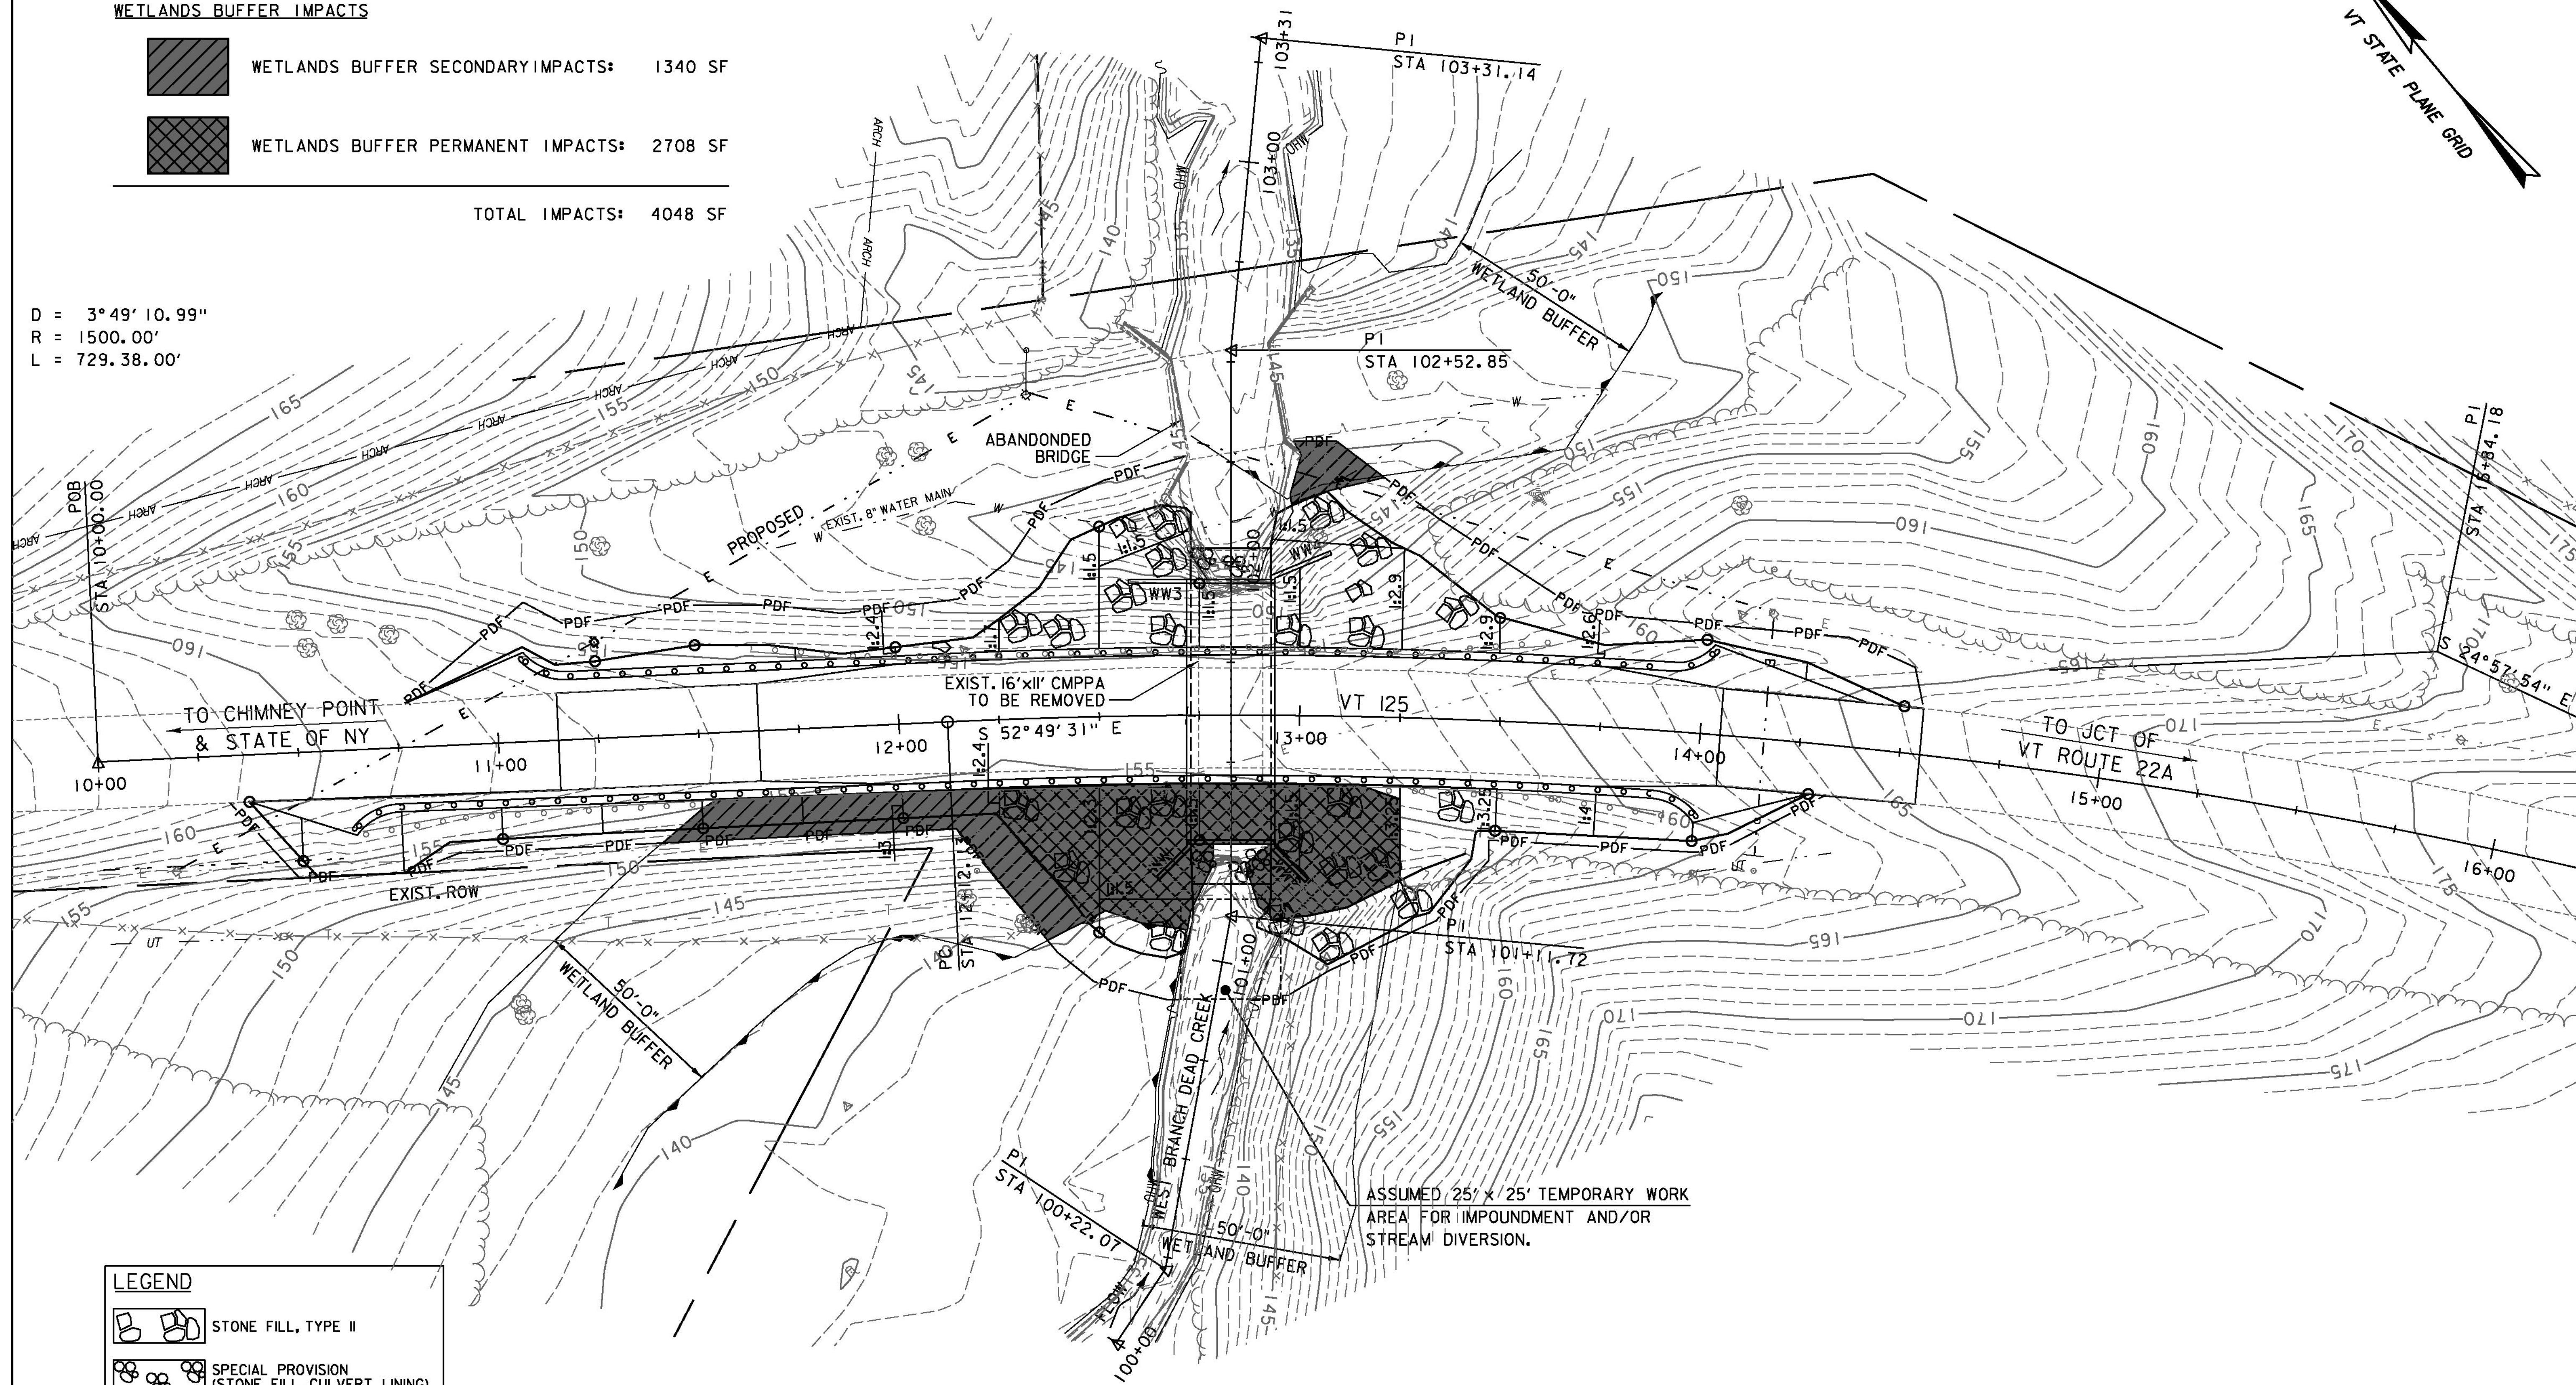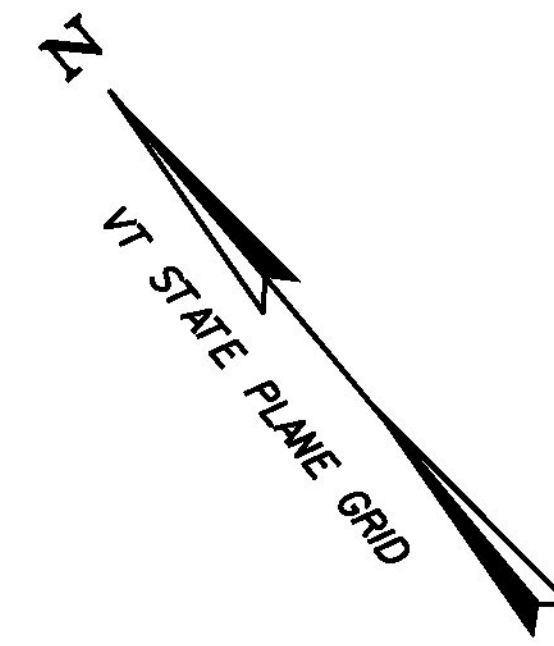D = 3° 49' 10.99"  
 R = 1500.00'  
 L = 729.38.00'




**LEGEND**

	STONE FILL, TYPE II
	SPECIAL PROVISION (STONE FILL, CULVERT LINING)

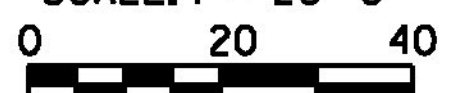**PLAN**  
 SCALE: 1" = 20'-0"  


PROJECT NAME:	BRIDPORT	FILE NAME:	z1lc264bdr_impacts_br2.2.dgn	PLOT DATE:	8/22/2014
PROJECT NUMBER:	STP CULV(29)	PROJECT LEADER:	M. CHENETTE	DRAWN BY:	L. BUXTON
		DESIGNED BY:	J. HUNGERFORD	CHECKED BY:	M. CHENETTE
		PROJECT IMPACTS PLAN 2 - BR2		SHEET	36 OF 57



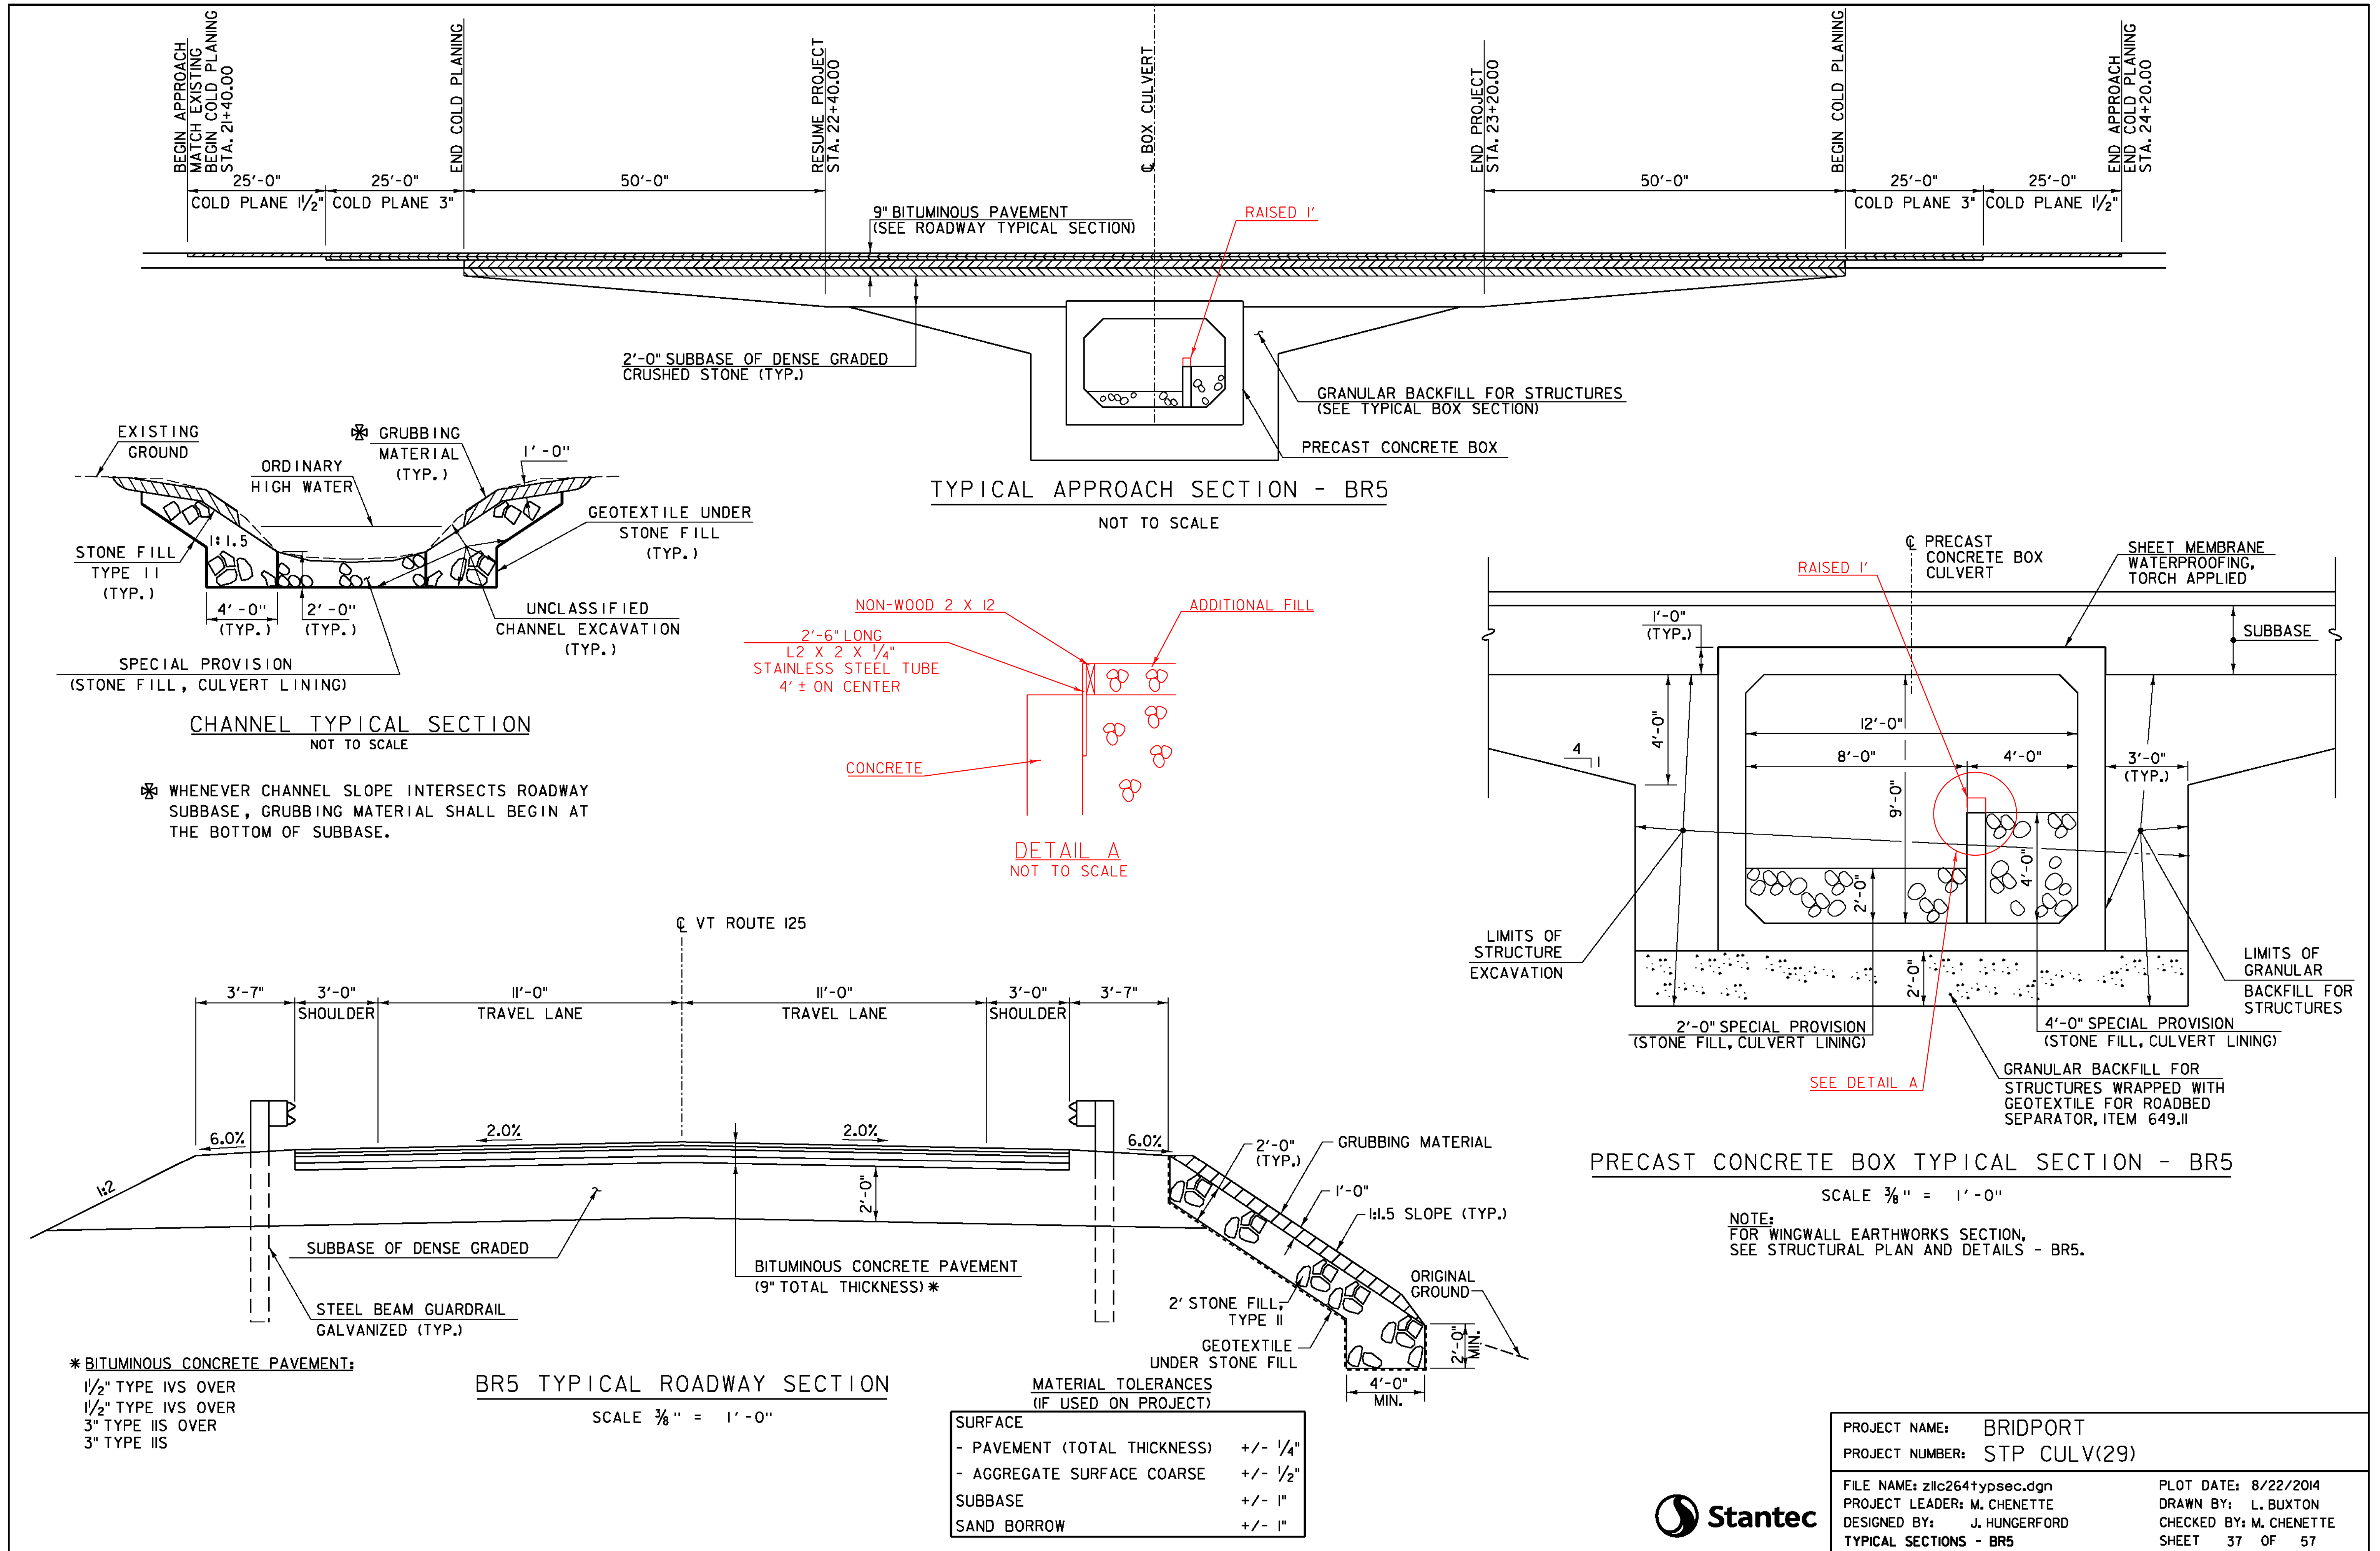

PROJECT NAME: BRIDPORT  
 PROJECT NUMBER: STP CULV(29)  
 FILE NAME: zllc264typsec.dgn  
 PROJECT LEADER: M. CHENETTE  
 DESIGNED BY: J. HUNGERFORD  
 TYPICAL SECTIONS - BR5

PLOT DATE: 8/22/2014  
 DRAWN BY: L. BUXTON  
 CHECKED BY: M. CHENETTE  
 SHEET 37 OF 57

GPS CONTROL POINTS

HVCTRL #1

LEMON FAIR  
 NORTH = 542755.824  
 EAST = 1442527.781  
 ELEV. = 207.150

GENERAL LOCATION, 5 MI (8.0 KM) WEST OF MIDDLEBURY.  
 TO REACH FROM THE JUNCTION OF VT ROUTE 30 AND VT ROUTE 125 IN MIDDLEBURY, PROCEED WEST ON ROUTE 125 FOR 4.7 MI (7.6 KM) TO A SIDE ROAD LEFT CALLED WEST ST. PROCEED SOUTH ON WEST ST FOR 0.3 MI (0.5 KM) TO A GRAVEL DRIVE AND THE MARK ON THE LEFT AND EAST. THE MARK IS LOCATED 25 FT (7.6 M) EAST OF THE CENTERLINE OF THE ROAD, 18 FT (5.5 M) NORTH OF THE CENTERLINE OF THE GRAVEL DRIVE 4 FT (1.2 M) WEST OF A FENCE CORNER, AND 2 FT (0.6 M) WEST OF A FIBERGLASS WITNESS POST.

HVCTRL #2


LEMON FAIR AZ MK  
 NORTH = 546363.025  
 EAST = 1440861.554  
 ELEV. = 196.000

GENERAL LOCATION, 5 MI (8.0 KM) WEST OF MIDDLEBURY.  
 TO REACH, FROM THE JUNCTION OF VT ROUTE 30 AND VT ROUTE 125 IN MIDDLEBURY, PROCEED WEST ON ROUTE 125 FOR 5.3 MI (8.5 KM) TO THE MARK ON THE LEFT. THE MARK IS LOCATED 315 FT (96.0 M) WEST OF THE CORNWALL/BRIDPORT TOWN LINE, 96.1 FT (29.3 M) SOUTHEAST OF UTILITY POLE NUMBER 49, 25.6 FT (7.8 M) SOUTH OF THE CENTERLINE OF ROUTE 125, AND 1 FT (0.3 M)

TRAVERSE TIES


HVCTRL #6

NORTH = 544413.018  
 EAST = 1435945.282  
 ELEV. = 287.859

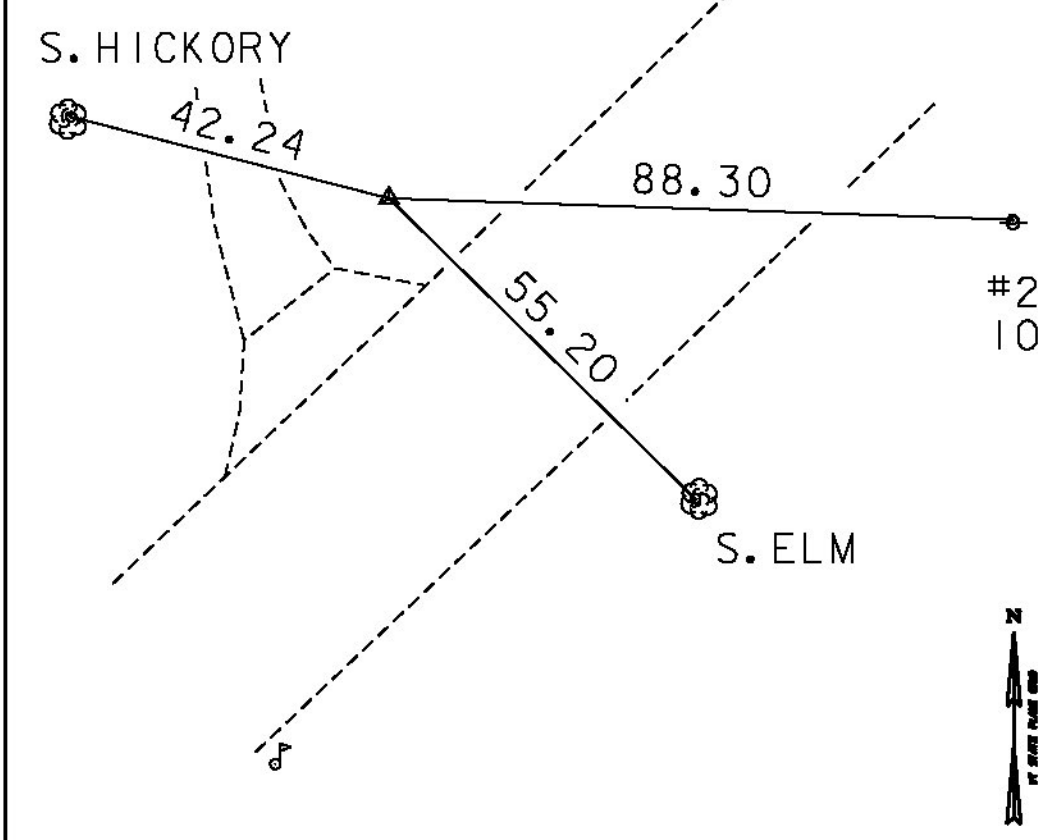


HVCTRL #7

NORTH = 544074.008  
 EAST = 1435635.369  
 ELEV. = 293.485

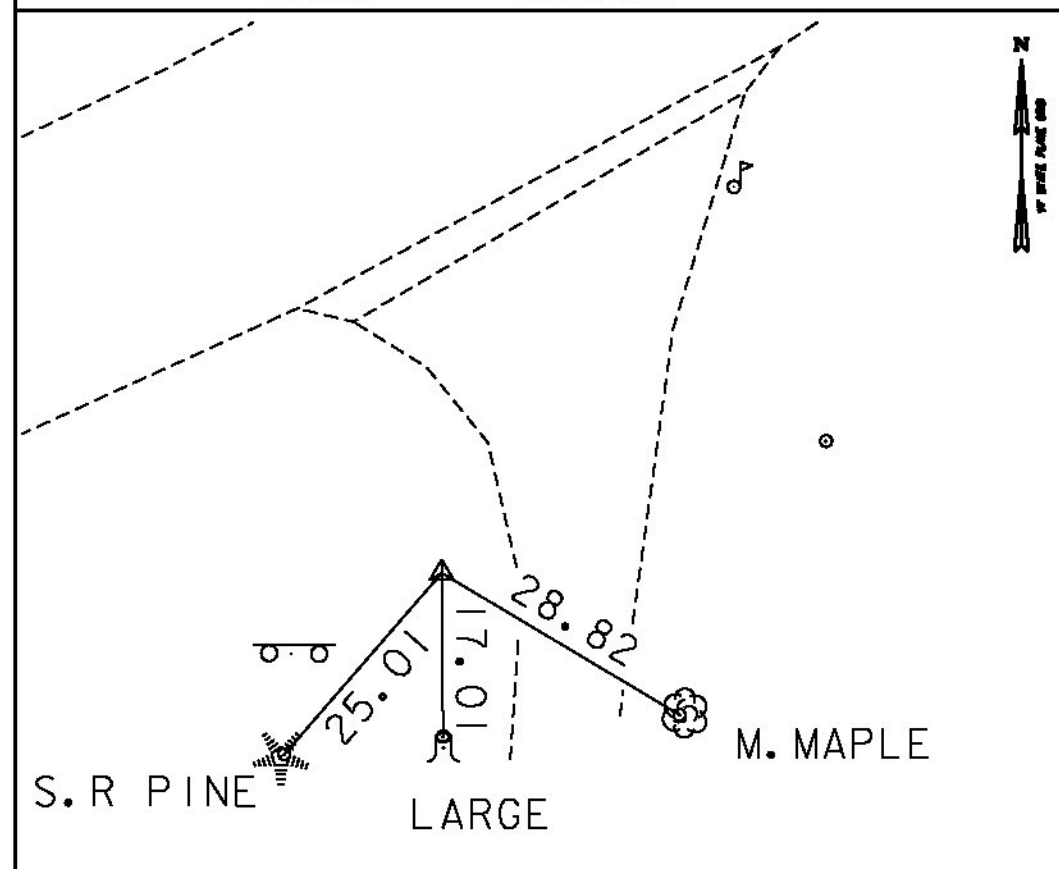

HVCTRL #8

NORTH = 543807.963  
 EAST = 1434393.362  
 ELEV. = 251.763

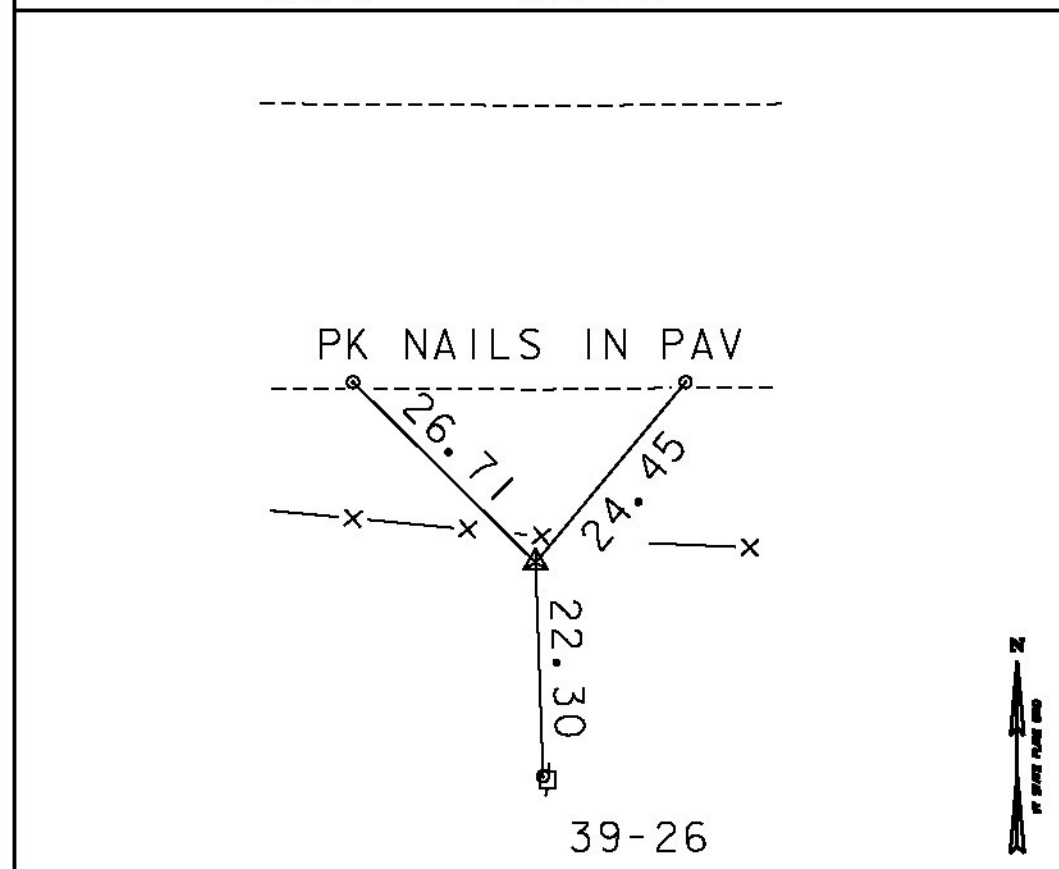

NORTH =  
 EAST =  
 ELEV. =


NORTH =  
 EAST =  
 ELEV. =

*MAIN TRAVERSE COMPLETED 1/23/2012 BY L. ORVIS P.C & G. HITCHCOCK

ALIGNMENT TIES


POB STA. 20+00.00

NORTH = 543881.306  
 EAST = 1434702.227  
 ELEV. =

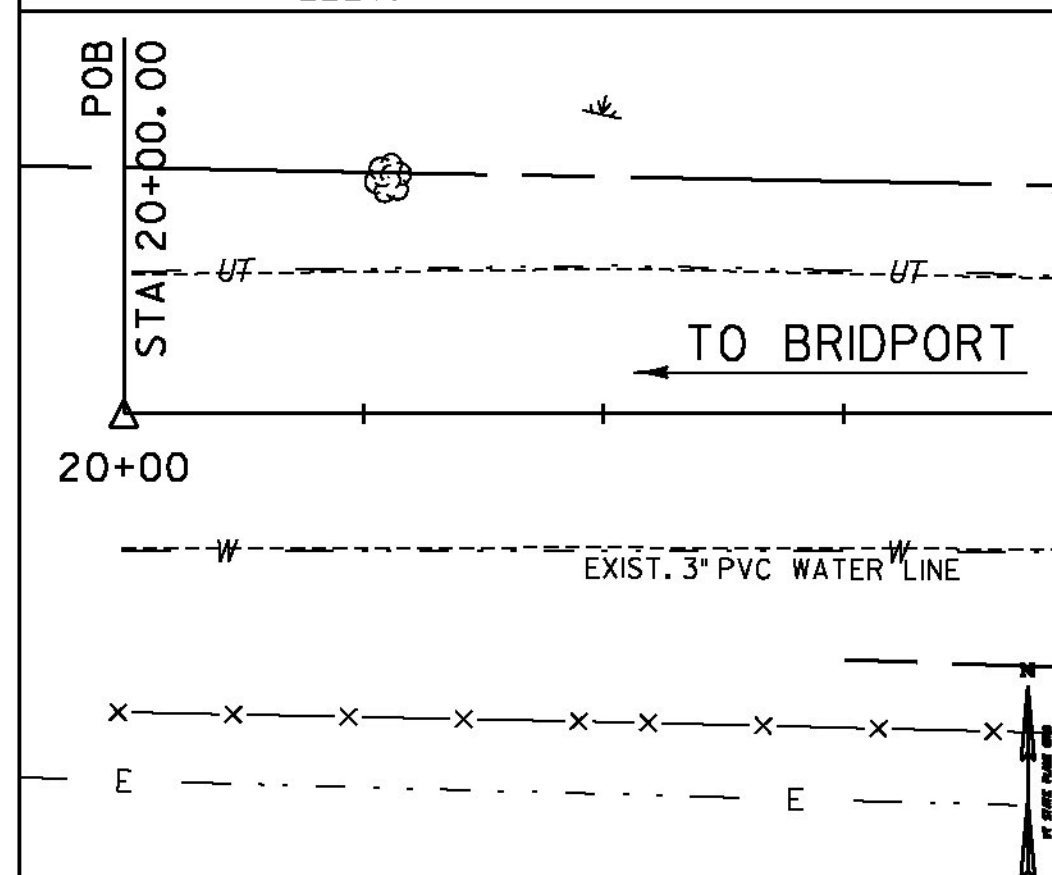


VT STA. 22+80.02

NORTH = 543941.912  
 EAST = 1434975.611  
 ELEV. =

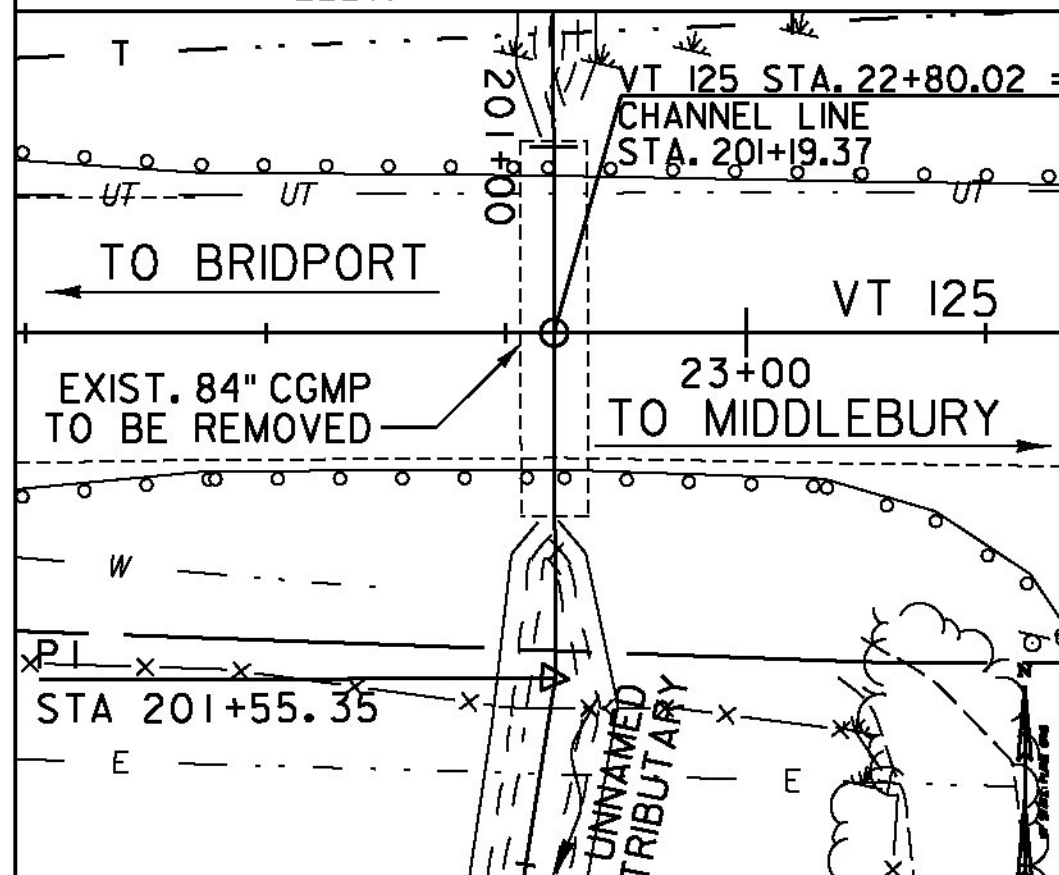

POE STA. 25+58.81

NORTH = 544002.252  
 EAST = 1435247.795  
 ELEV. =

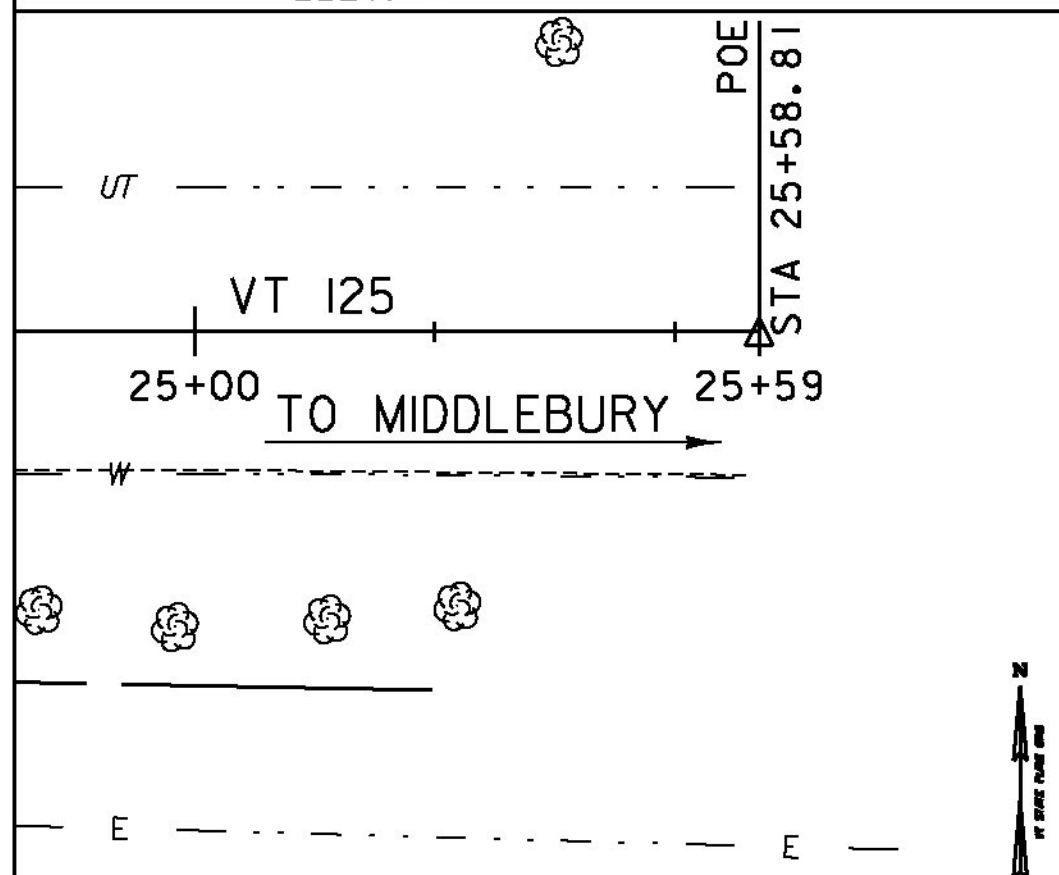

NORTH =  
 EAST =  
 ELEV. =

NORTH =  
 EAST =  
 ELEV. =


DATUM	
VERTICAL	NAVD 88
HORIZONTAL	NAD 83(92)
ADJUSTMENT	COMPASS




PROJECT NAME: BRIDPORT  
 PROJECT NUMBER: STP CULV(29)

FILE NAME: zllc2641te_br5.dgn  
 PROJECT LEADER: M. CHENETTE  
 DESIGNED BY: J. HUNGERFORD  
 SURVEY CONTROL AND TIES - BR5

PLOT DATE: 8/22/2014  
 DRAWN BY: L. BUXTON  
 CHECKED BY: M. CHENETTE  
 SHEET 38 OF 57

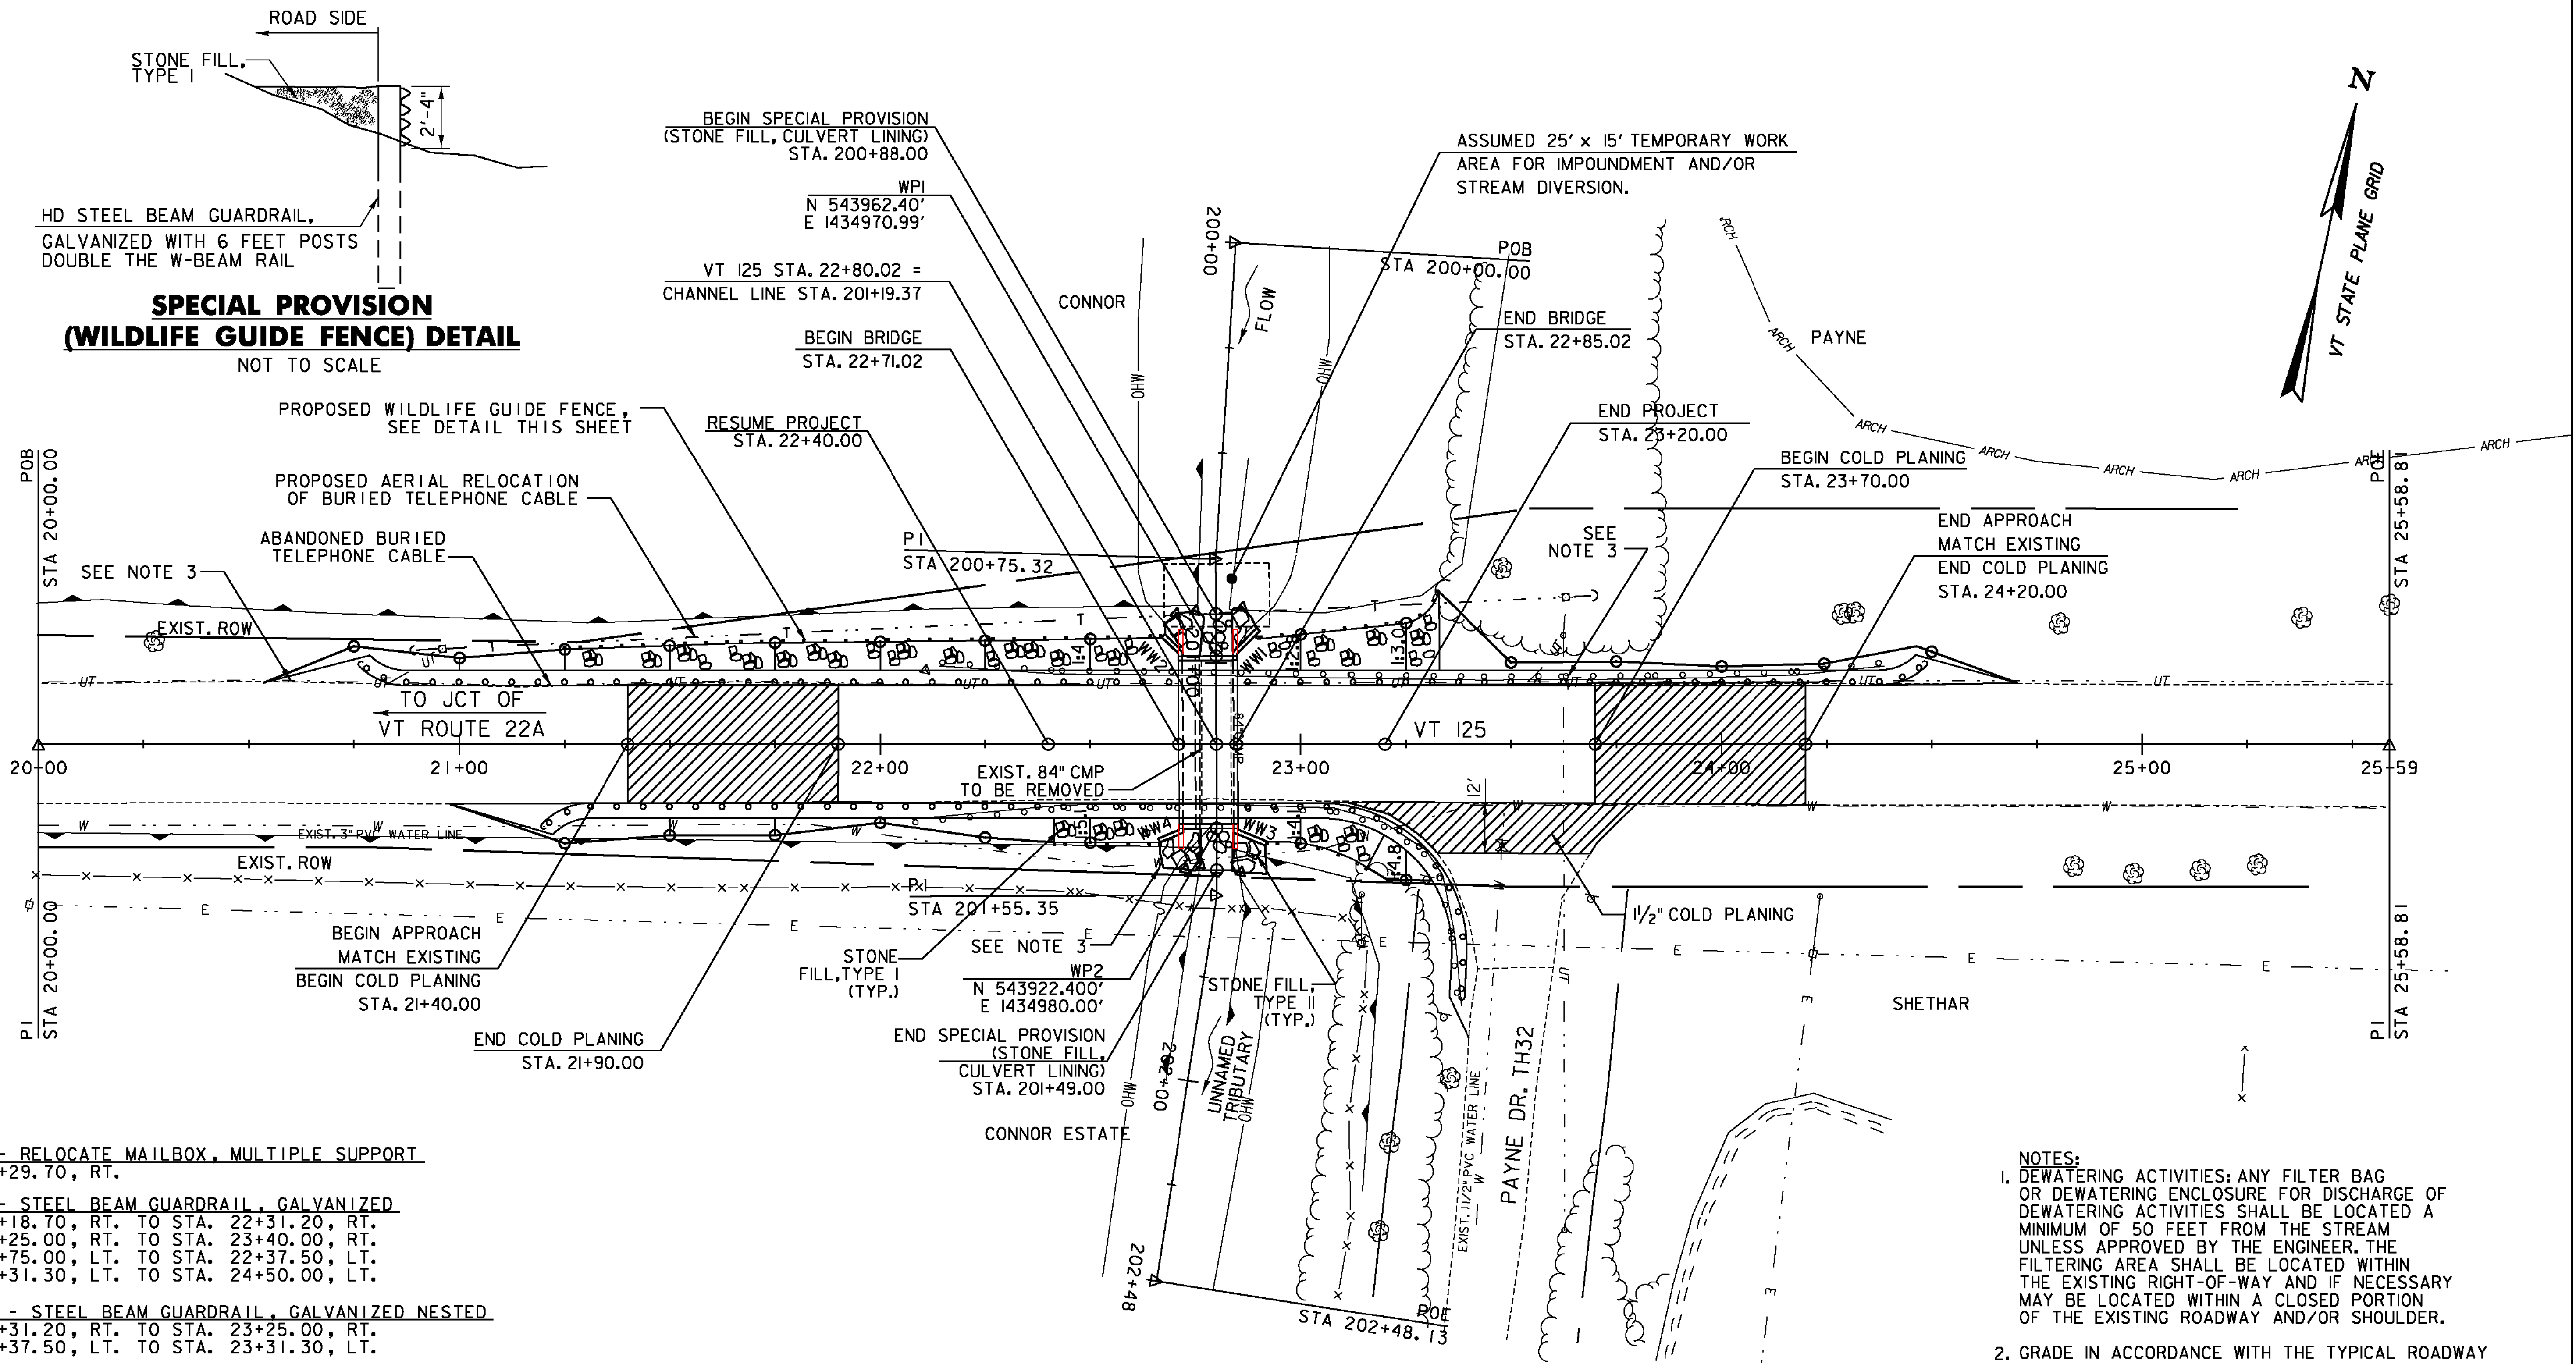

**SPECIAL PROVISION  
(WILDLIFE GUIDE FENCE) DETAIL**  
NOT TO SCALE

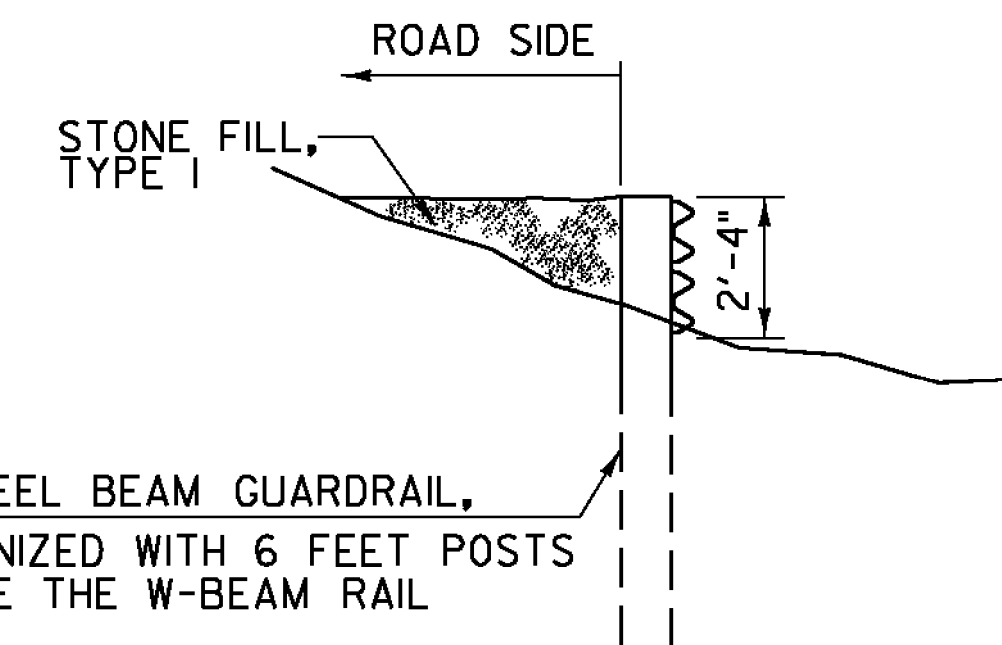

**PLAN**  
SCALE: 1" = 20'-0"  
0 20 40

LEGEND	
	STONE FILL, TYPE I
	STONE FILL, TYPE II
	SPECIAL PROVISION (STONE FILL, CULVERT LINING)
	SPECIAL PROVISION (WILDLIFE GUIDE FENCE)

- NOTES:**
- DEWATERING ACTIVITIES: ANY FILTER BAG OR DEWATERING ENCLOSURE FOR DISCHARGE OF DEWATERING ACTIVITIES SHALL BE LOCATED A MINIMUM OF 50 FEET FROM THE STREAM UNLESS APPROVED BY THE ENGINEER. THE FILTERING AREA SHALL BE LOCATED WITHIN THE EXISTING RIGHT-OF-WAY AND IF NECESSARY MAY BE LOCATED WITHIN A CLOSED PORTION OF THE EXISTING ROADWAY AND/OR SHOULDER.
  - GRADE IN ACCORDANCE WITH THE TYPICAL ROADWAY SECTION AND ROADWAY CROSS SECTIONS UNLESS NOTED OTHERWISE.
  - THE LOCATION OF UNDERGROUND UTILITIES SHOWN ON THE PLANS IS APPROXIMATE. THE CONTRACTOR SHALL PERFORM EXPLORATORY EXCAVATIONS TO VERIFY THE DEPTH AND LOCATIONS OF UNDERGROUND UTILITIES, AS DIRECTED BY THE ENGINEER. THE EXPLORATORY WORK SHALL BE PAID FOR UNDER ITEM 204.22 TRENCH EXCAVATION OF EARTH, EXPLORATORY. SEE THE UTILITY SPECIAL PROVISIONS FOR ADDITIONAL INFORMATION AND REQUIREMENTS.

- 617.12 - RELOCATE MAILBOX, MULTIPLE SUPPORT  
STA. 23+29.70, RT.
- 621.20 - STEEL BEAM GUARDRAIL, GALVANIZED  
STA. 21+18.70, RT. TO STA. 22+31.20, RT.  
STA. 23+25.00, RT. TO STA. 23+40.00, RT.  
STA. 20+75.00, LT. TO STA. 22+37.50, LT.  
STA. 23+31.30, LT. TO STA. 24+50.00, LT.
- 621.206 - STEEL BEAM GUARDRAIL, GALVANIZED NESTED  
STA. 22+31.20, RT. TO STA. 23+25.00, RT.  
STA. 22+37.50, LT. TO STA. 23+31.30, LT.
- 621.60 - ANCHOR FOR STEEL BEAM GUARDRAIL  
STA. 21+18.70, RT.  
STA. 20+75.00, LT.  
STA. 23+40.00, RT.  
STA. 24+50.00, LT.
- 621.80 - REMOVAL AND DISPOSAL OF GUARDRAIL  
STA. 22+07.79, RT. TO STA. 23+38.17, RT.  
STA. 22+14.18, LT. TO STA. 24+38.64, LT.
- 646.400 - DURABLE 4 INCH WHITE LINE  
STA. 21+40.00, RT. TO STA. 24+20.00, RT.  
STA. 21+40.00, LT. TO STA. 24+20.00, LT.
- 646.410 - DURABLE 4 INCH YELLOW LINE  
STA. 21+40.00, CL. TO STA. 24+20.00, CL. (DYEL)
- 900.640 - SPECIAL PROVISION (WILDLIFE GUIDE FENCE)  
STA. 22+41.50, RT. TO STA. 22+66.50, RT.  
STA. 22+92.00, RT. TO STA. 23+17.00, RT.  
STA. 21+25.00, LT. TO STA. 22+62.50, LT.  
STA. 22+90.00, LT. TO STA. 23+27.50, LT.


PROJECT NAME: BRIDPORT  
PROJECT NUMBER: STP CULV(29)

FILE NAME: zllc264bdr_br5.dgn  
PROJECT LEADER: M. CHENETTE  
DESIGNED BY: J. HUNGERFORD  
PLAN LAYOUT SHEET - BR5

PLOT DATE: 8/22/2014  
DRAWN BY: L. BUXTON  
CHECKED BY: M. CHENETTE  
SHEET 39 OF 57



8/22/2014 10:45 PM V:\953\active\953069\Ttr\anaport\anaport\zllc264bdr_br5.dgn

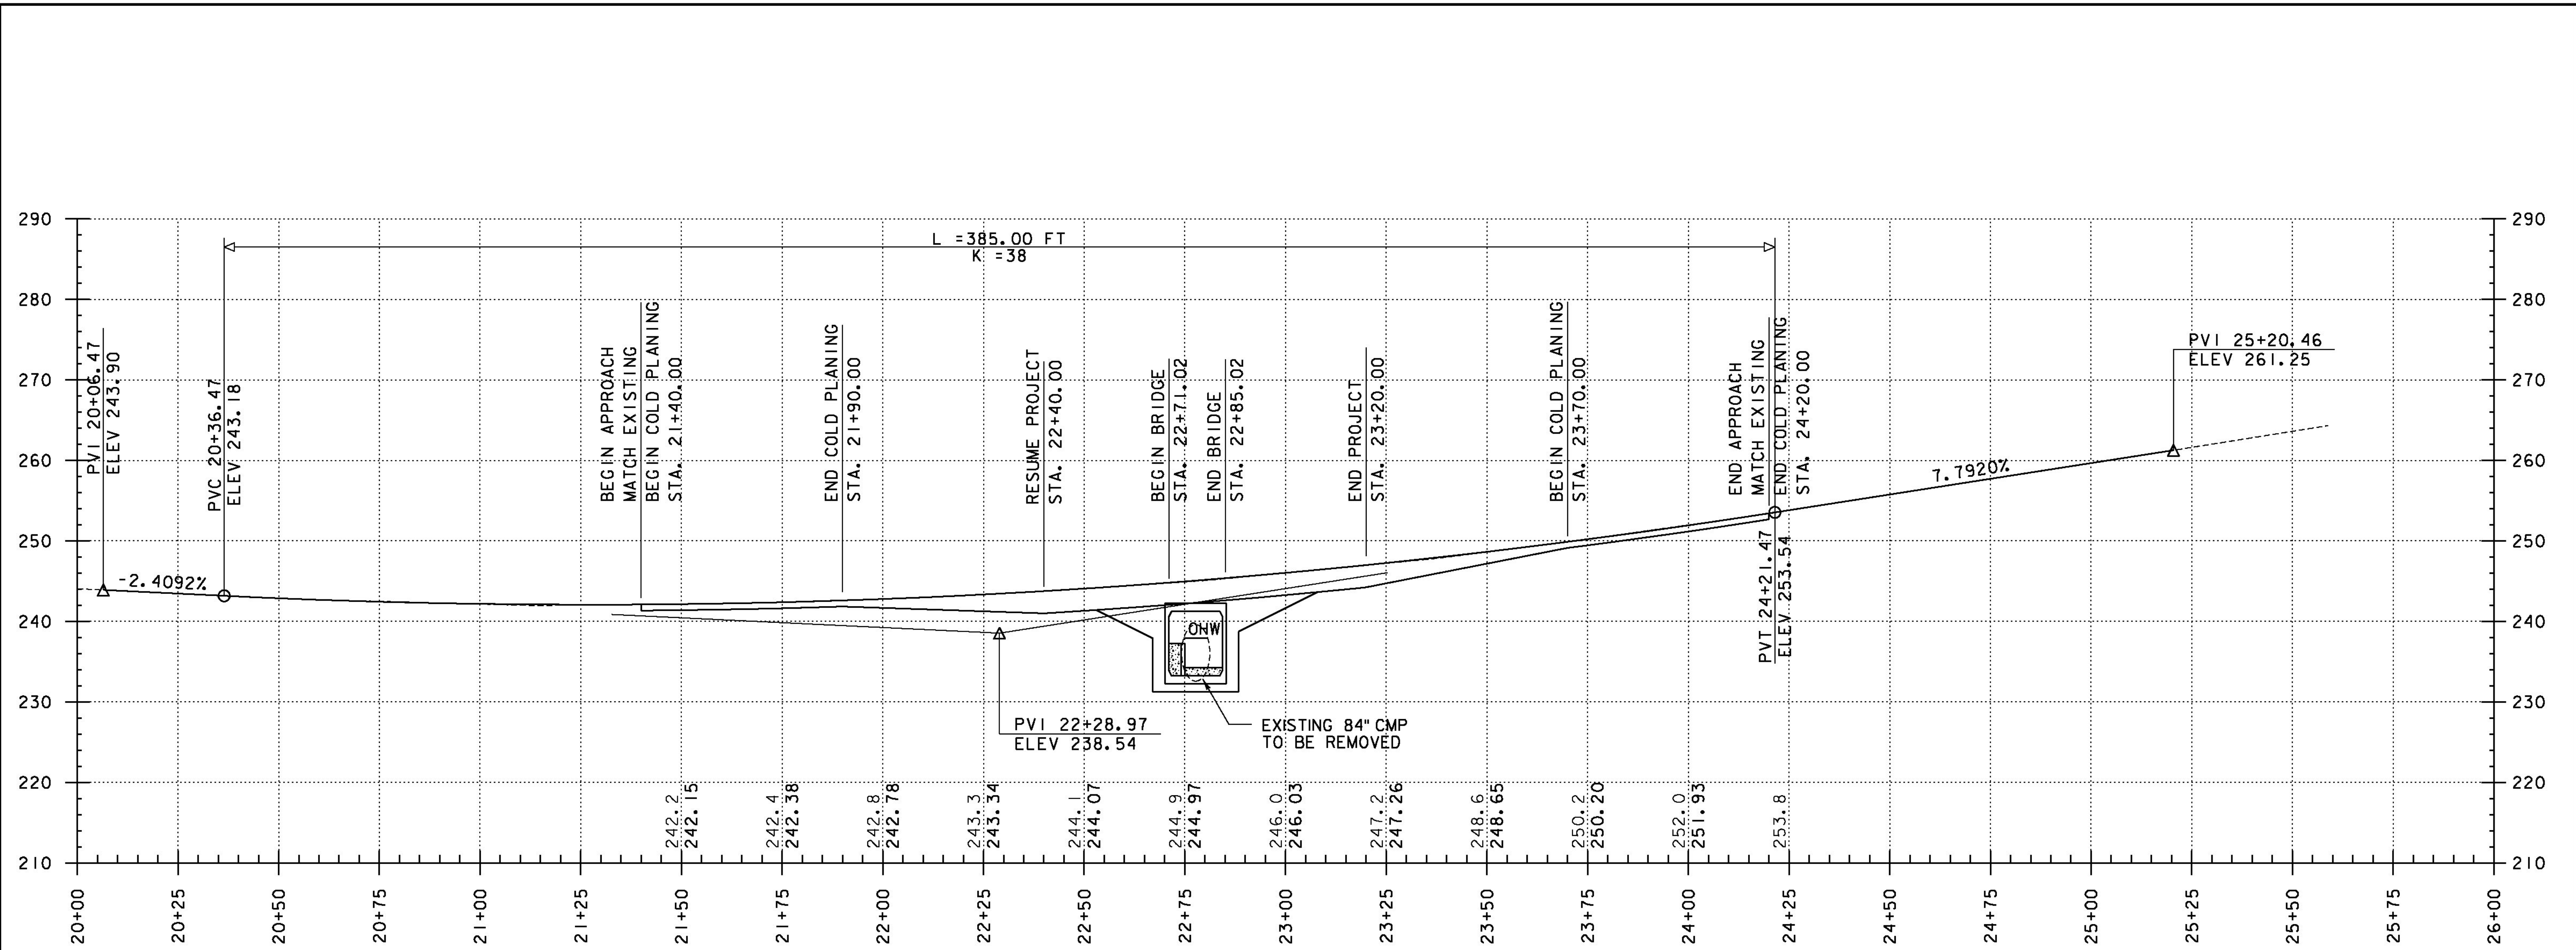

PROFILE ALONG VT ROUTE 125

HORIZONTAL SCALE: 1" = 20' VERTICAL SCALE: 1" = 10'

NOTE:  
ELEVATIONS SHOWN TO THE NEAREST TENTH ARE EXISTING GROUND ALONG PROPOSED CENTERLINE.


ELEVATIONS SHOW TO THE NEAREST HUNDREDTH ARE FINISHED GRADE ALONG PROPOSED CENTERLINE.

PROJECT NAME: BRIDPORT  
PROJECT NUMBER: STP CULV(29)

FILE NAME: zllc264pro.dgn  
PROJECT LEADER: M. CHENETTE  
DESIGNED BY: J. HUNGERFORD  
ROADWAY PROFILE - BR5


PLOT DATE: 8/22/2014  
DRAWN BY: L. BUXTON  
CHECKED BY: M. CHENETTE  
SHEET 40 OF 57



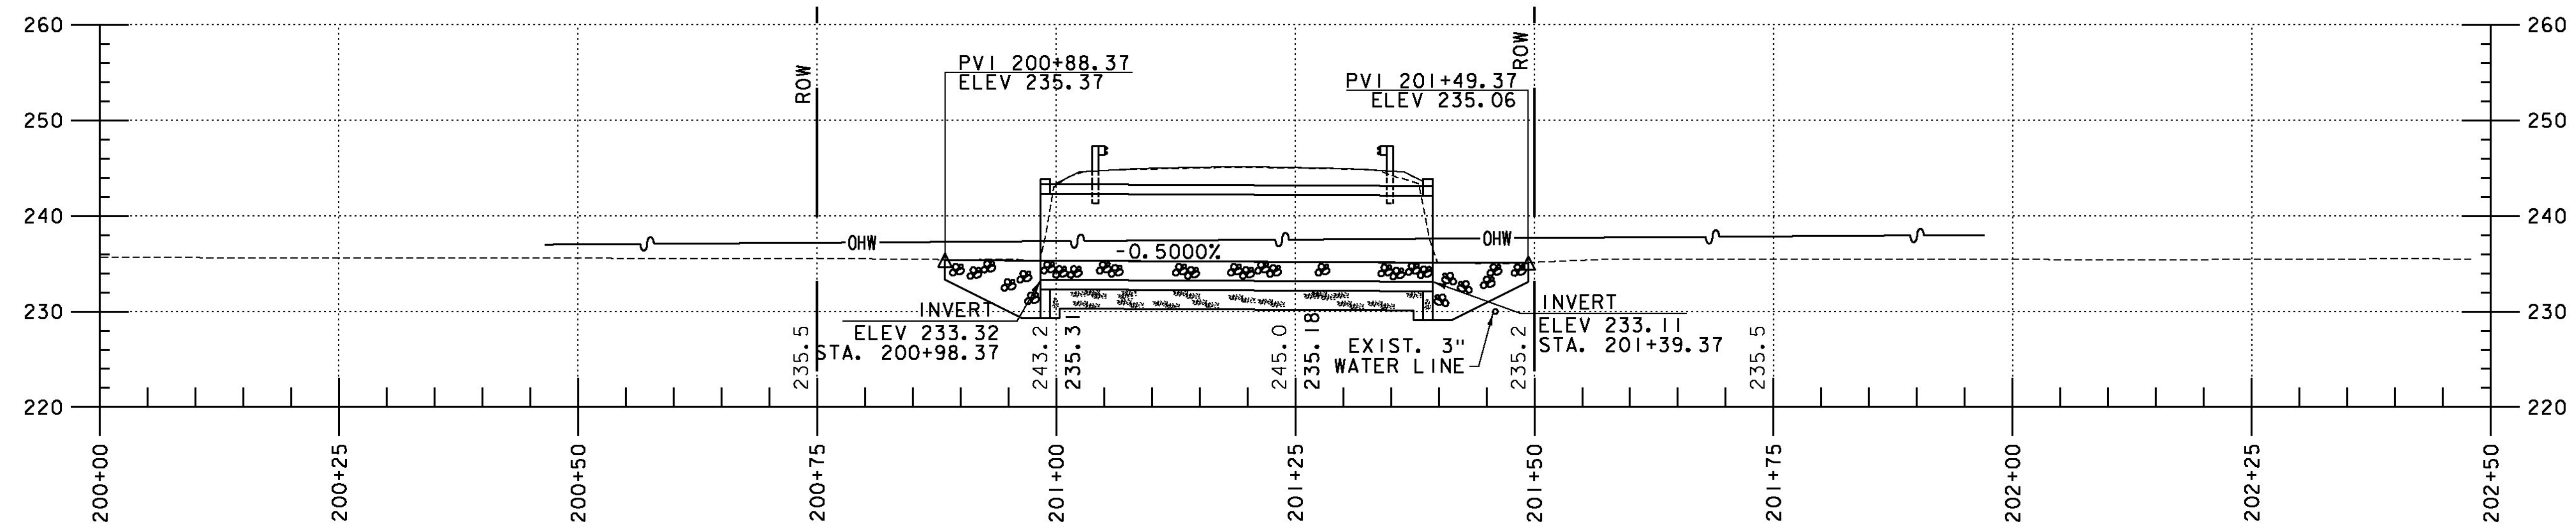

STREAM PROFILE  
 0 10 20  
 SCALE


NOTE:  
 ELEVATIONS SHOWN TO THE NEAREST TENTHS ARE EXISTING GROUND ALONG PROPOSED CENTERLINE.  
 ELEVATIONS SHOW TO THE NEAREST HUNDREDTHS ARE FINISHED GRADE ALONG PROPOSED CENTERLINE.

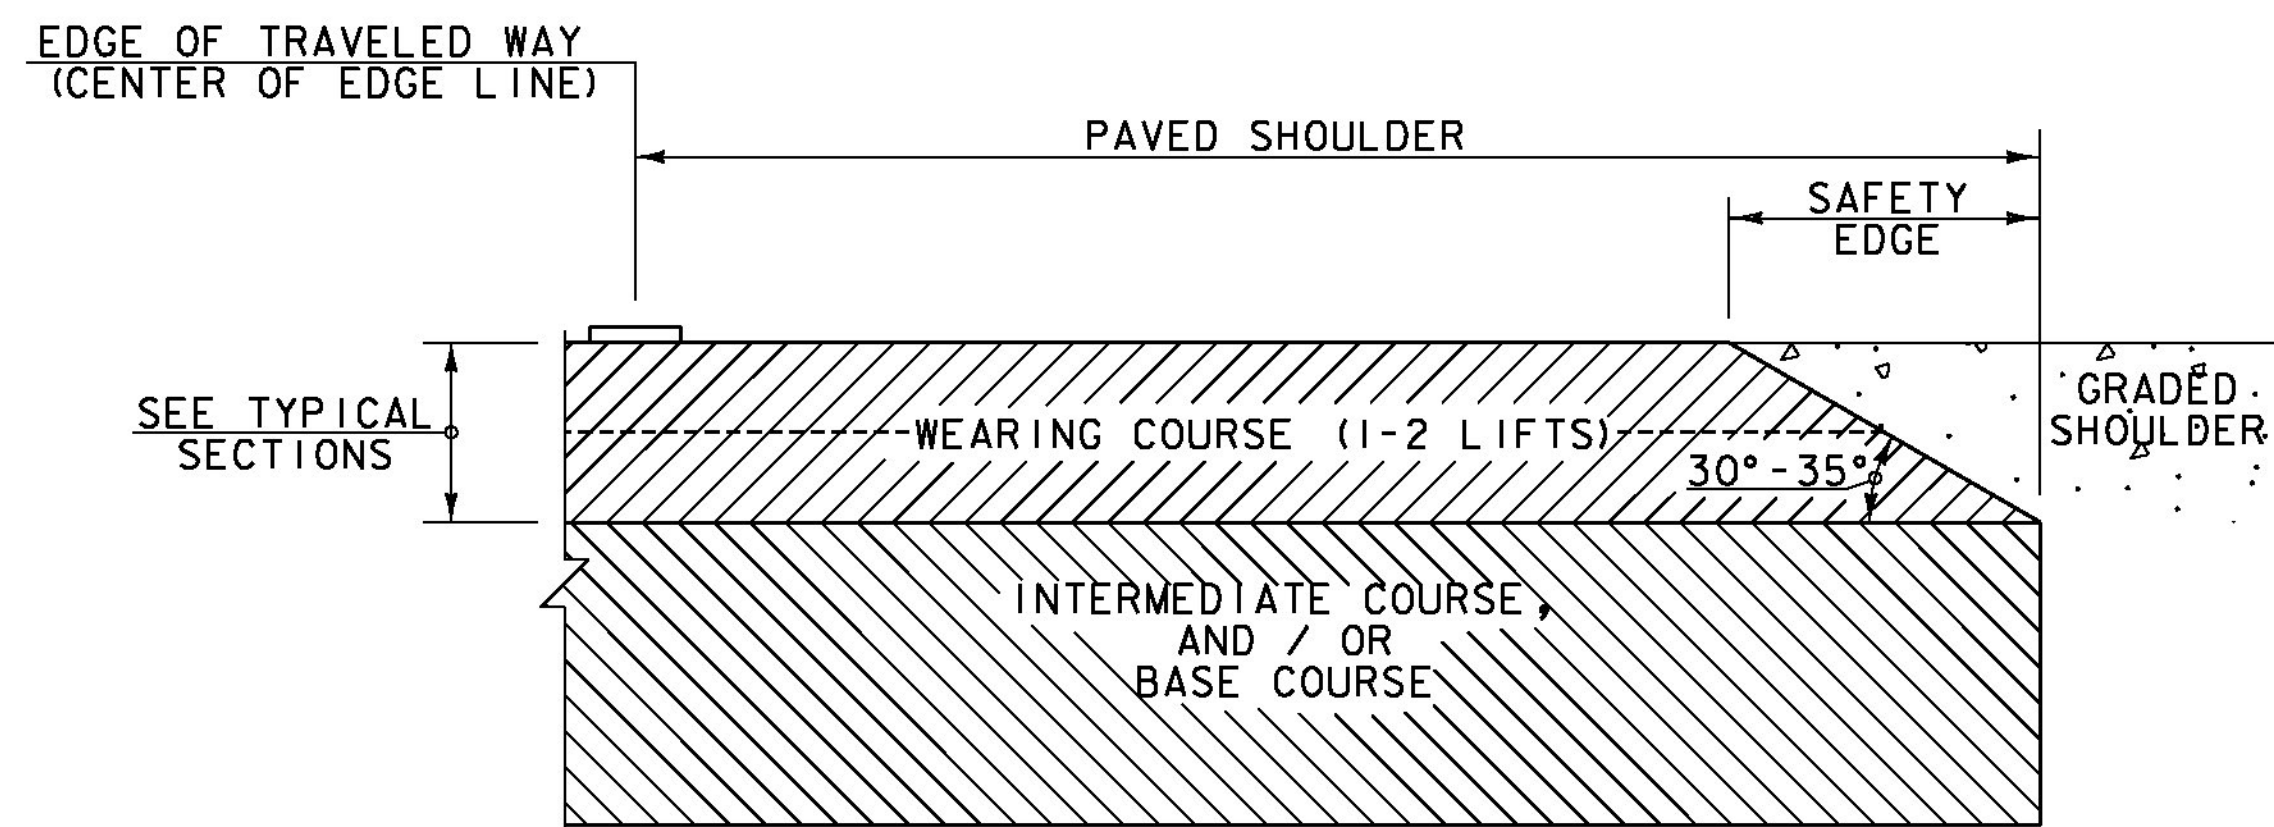

SAFETY EDGE DETAIL  
 NOT TO SCALE

NOTES:

1. THE EDGE OF PAVEMENT SHALL BE FORMED IN SUCH A WAY THAT THE BITUMINOUS CONCRETE PAVEMENT IS EXTRUDED OR COMPRESSED TO FORM THE 30 TO 35 DEGREE ANGLE. DEVICES THAT SIMPLY STRIKE-OFF THE MIX WITHOUT PROVIDING ANY COMPACTIVE EFFORT WILL NOT BE ALLOWED.
2. THE PAVED SHOULDER EXTENDS FROM THE EDGE OF TRAVELED WAY TO THE EDGE OF THE WEARING COURSE, INCLUDING THE "SAFETY EDGE".

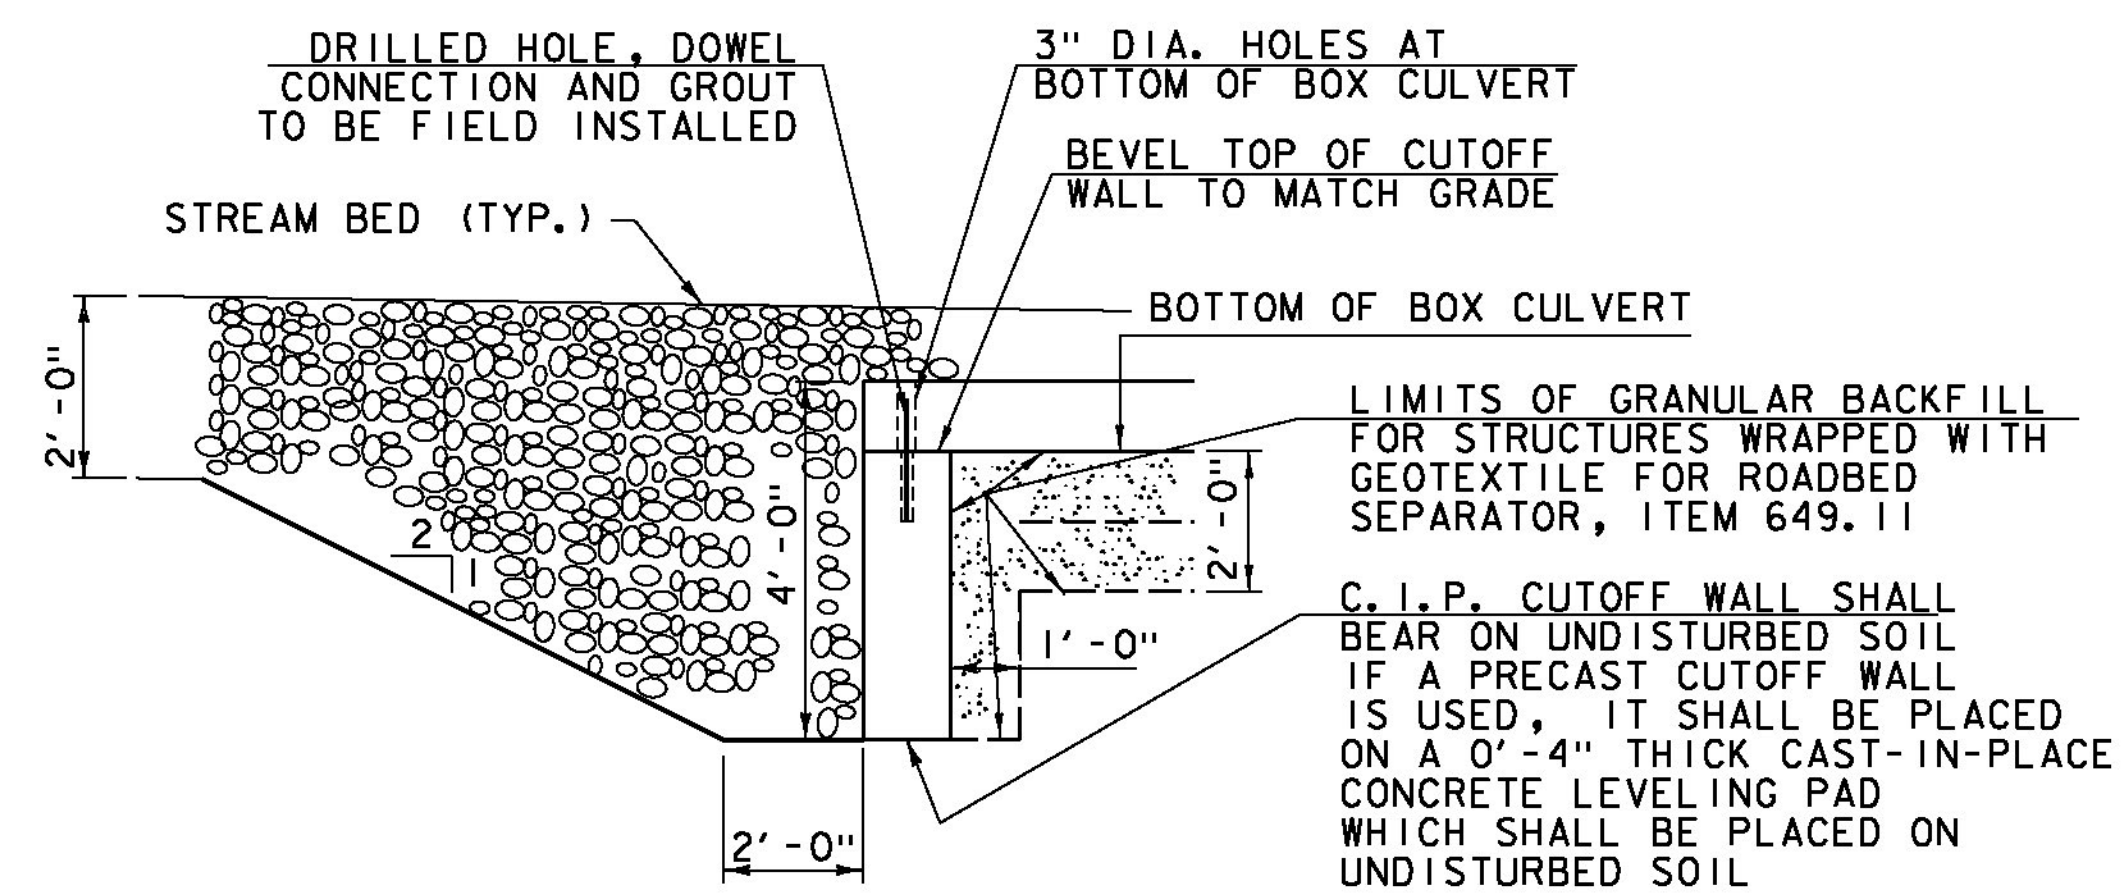


CUTOFF WALL DETAIL  
 NOT TO SCALE

PROJECT NAME: BRIDPORT  
 PROJECT NUMBER: STP CULV(29)



FILE NAME: zllc264xs_br5.dgn  
 PROJECT LEADER: M. CHENETTE  
 DESIGNED BY: J. HUNGERFORD  
 STREAM PROFILE - BR5

PLOT DATE: 8/22/2014  
 DRAWN BY: L. BUXTON  
 CHECKED BY: M. CHENETTE  
 SHEET 41 OF 57



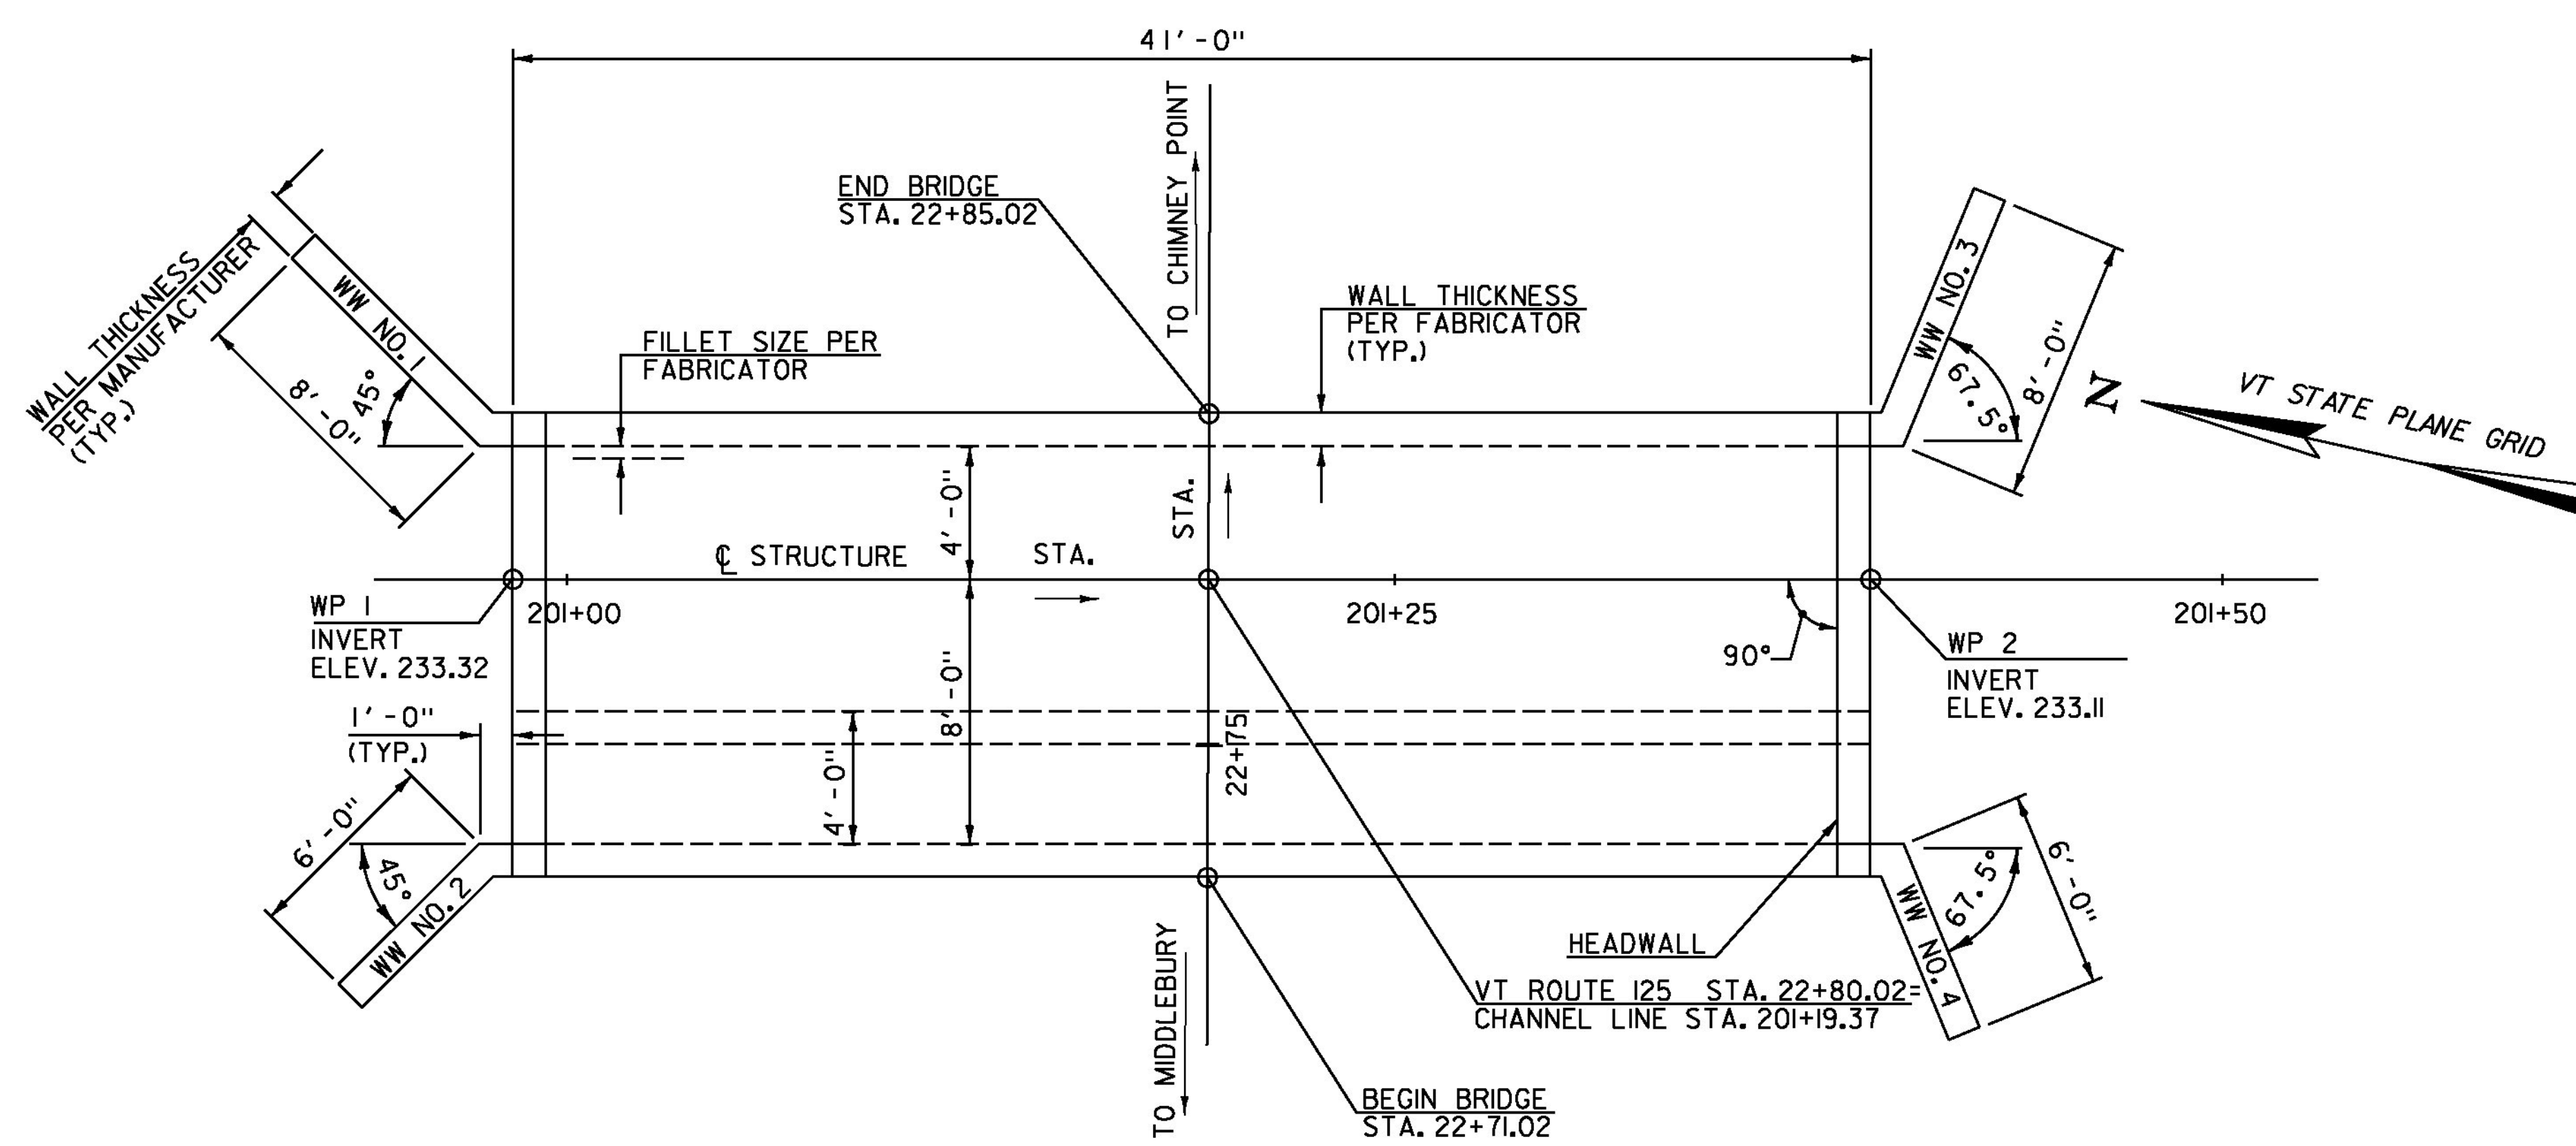


PRECAST CONCRETE STRUCTURE PLAN  
SCALE: 1/4" = 1'-0"

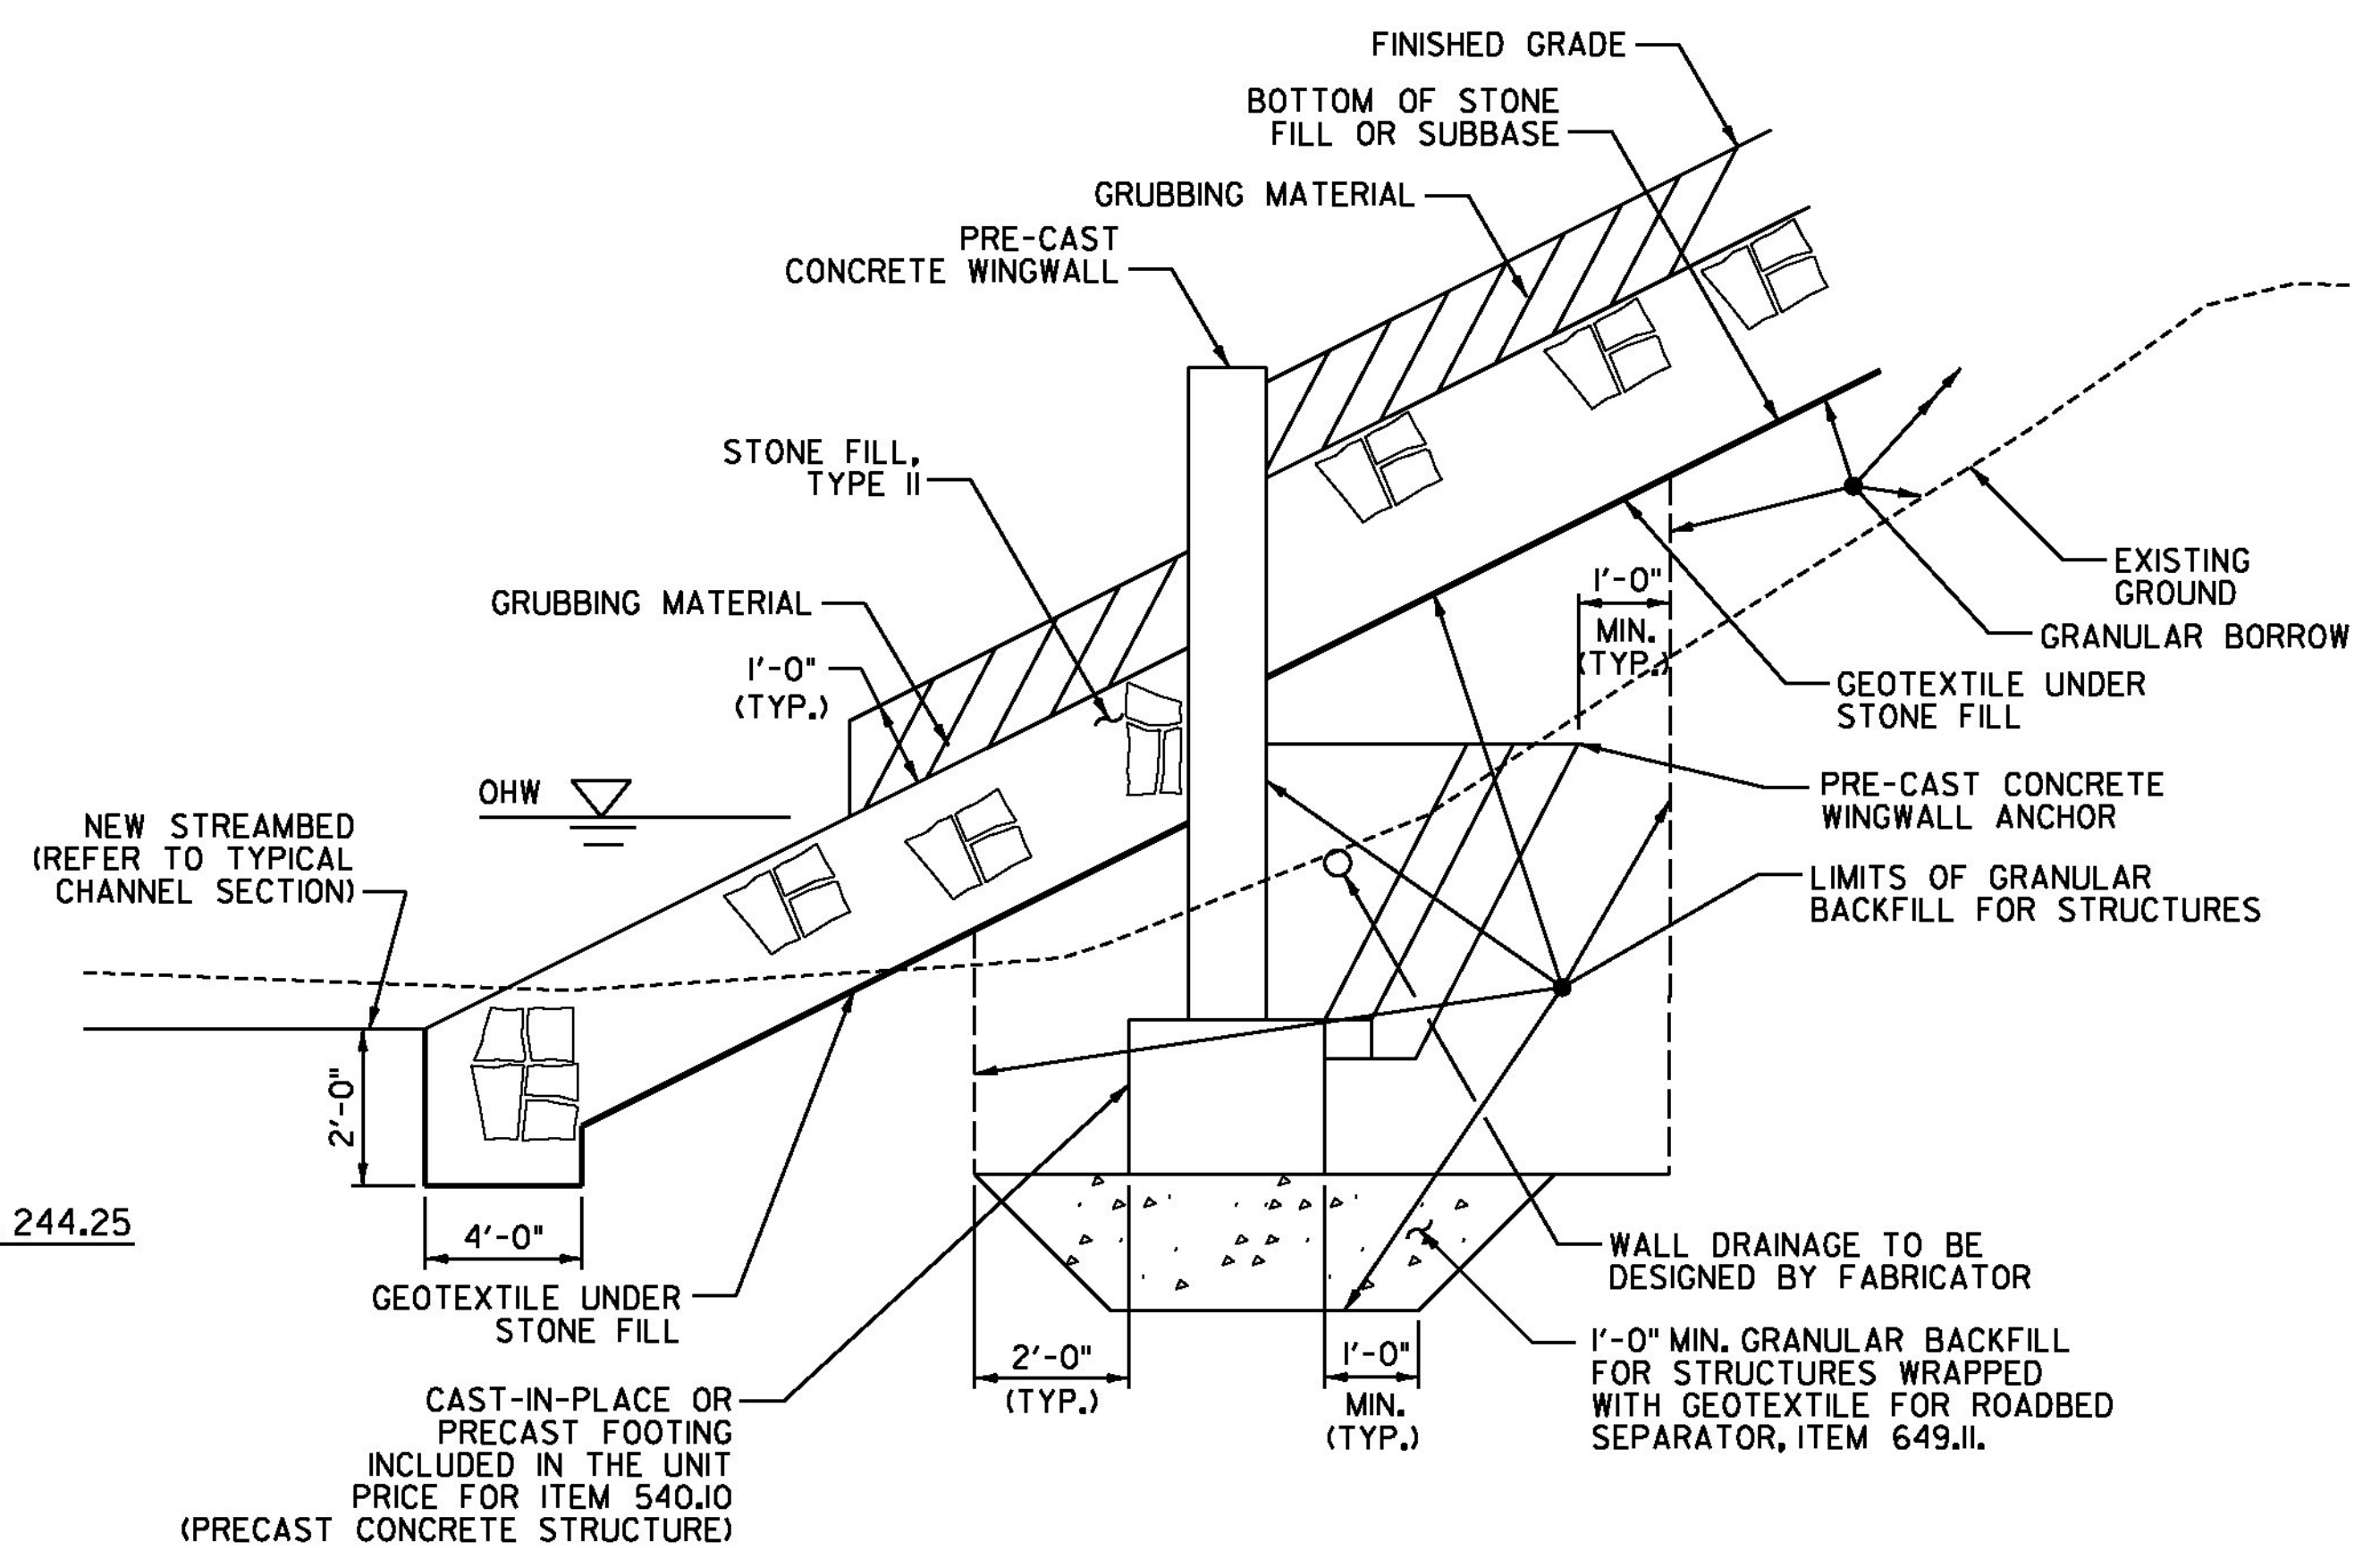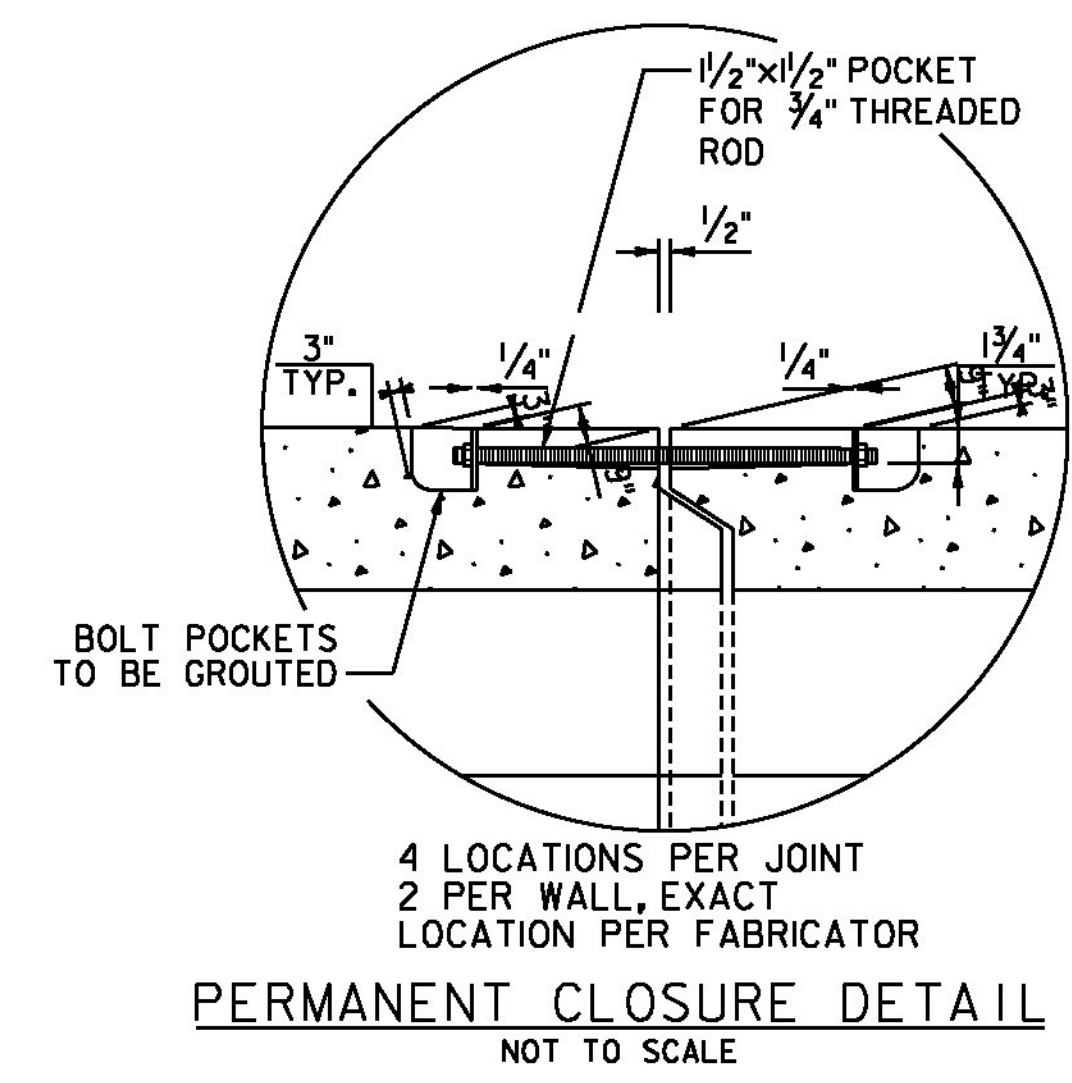


NOTE:  
ANCHOR TYPE WALLS SHOWN, OTHER APPROVED WALL SYSTEM MAY BE USED, SEE SPECIAL PROVISIONS.

WINGWALL EARTHWORK SECTION  
NOT TO SCALE

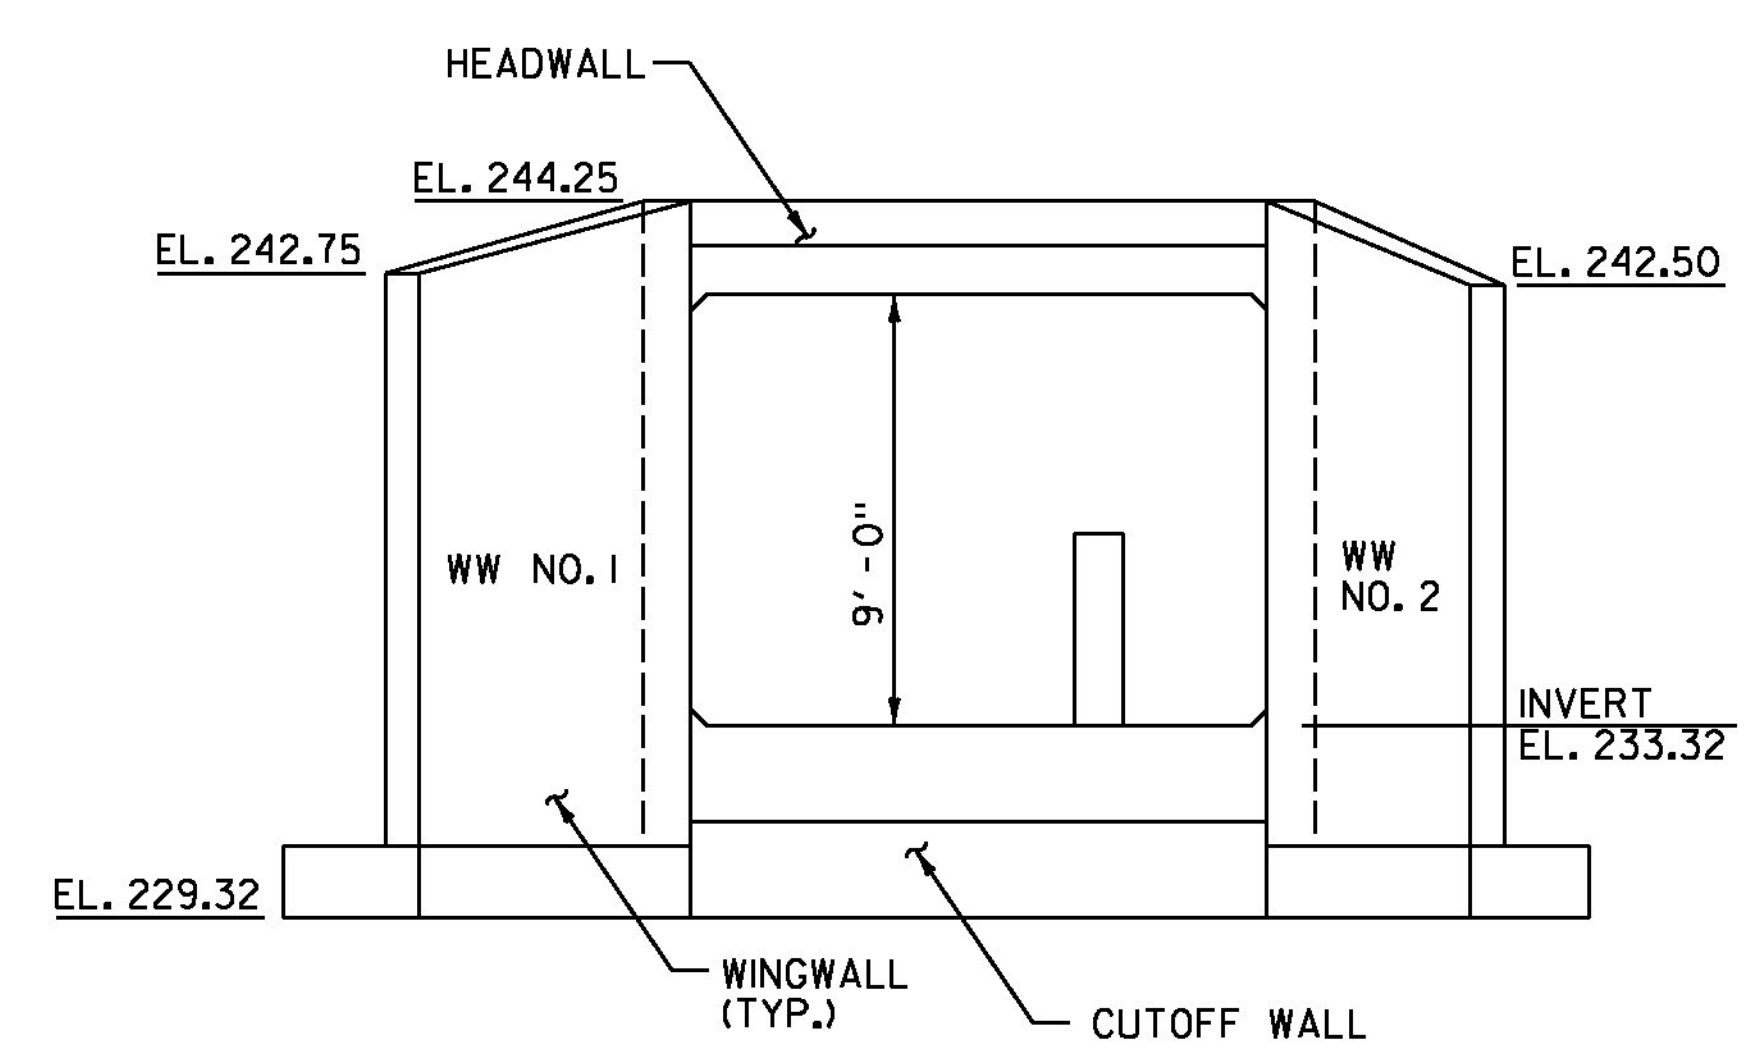


INLET ELEVATION  
SCALE: 1/4" = 1'-0"

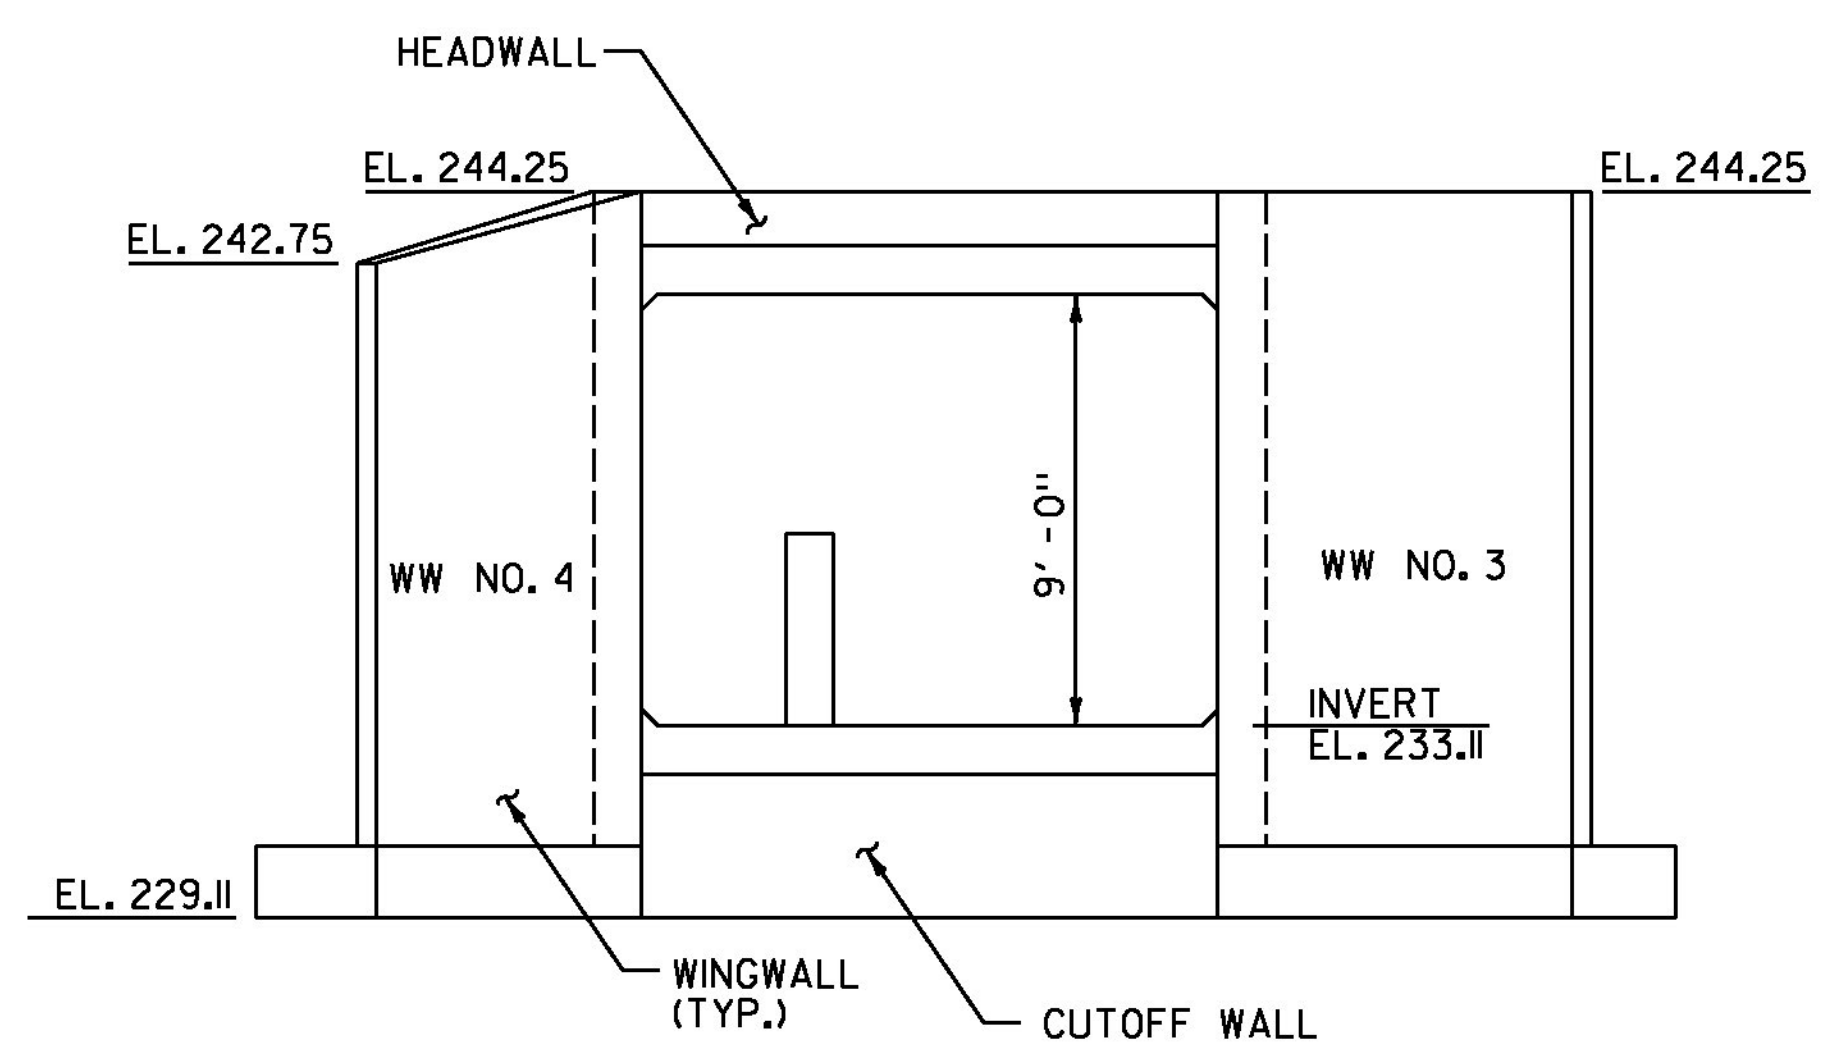

OUTLET ELEVATION  
SCALE: 1/4" = 1'-0"




PROJECT NAME:	BRIDPORT	FILE NAME:	z1lc264strpl.br5.dgn	PLOT DATE:	8/22/2014
PROJECT NUMBER:	STP CULV(29)	PROJECT LEADER:	M. CHENETTE	DRAWN BY:	L. BUXTON
		DESIGNED BY:	J. HUNGERFORD	CHECKED BY:	M. CHENETTE
		STRUCTURAL PLAN AND DETAILS - BR5			SHEET 42 OF 57

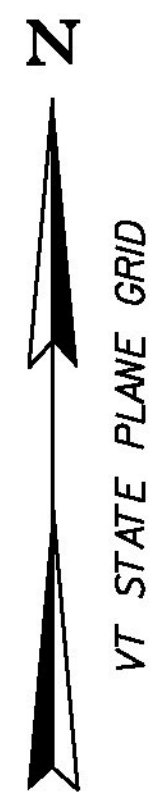

# REGIONAL TRAFFIC DETOUR PLAN - BR5

NOT TO SCALE

-----DETOUR ROUTE

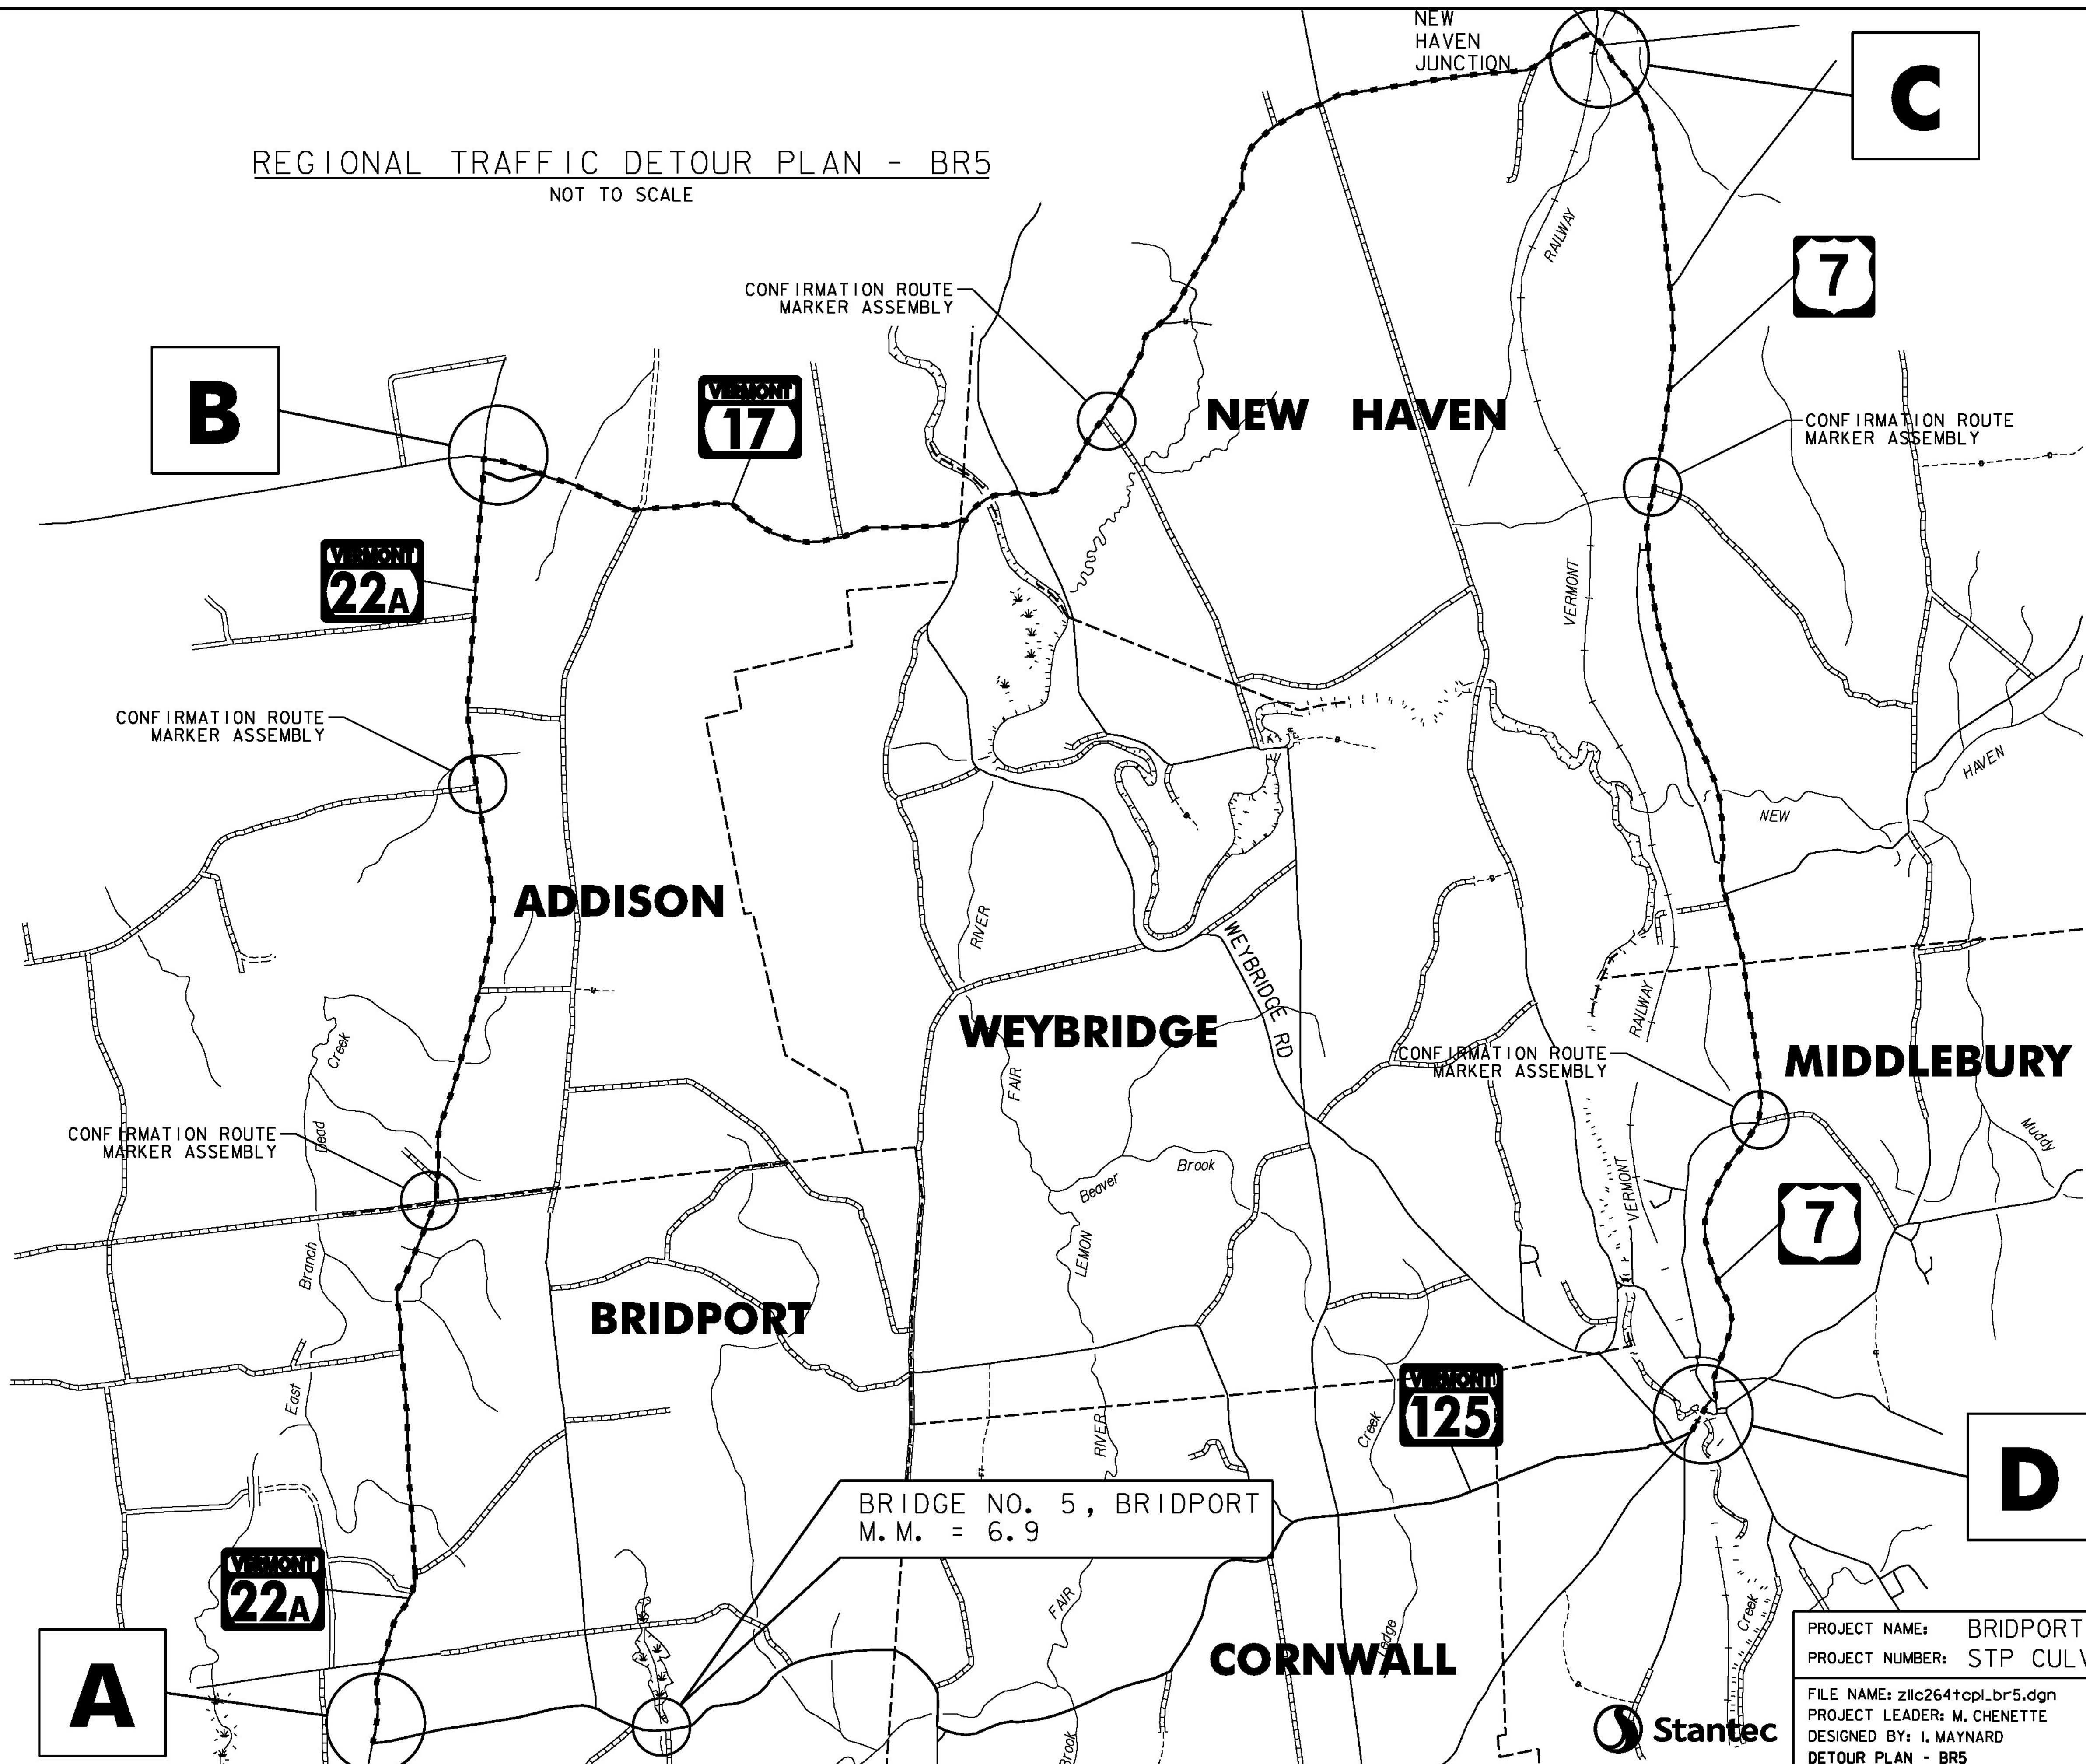

**A**

**B**


**C**

**D**


BRIDGE NO. 5, BRIDPORT  
M.M. = 6.9

PROJECT NAME:	BRIDPORT	PLLOT DATE:	8/22/2014
PROJECT NUMBER:	STP CULV(29)	DRAWN BY:	I. MAYNARD
FILE NAME:	z1lc264+tpl_br5.dgn	CHECKED BY:	J. HUNGERFORD
PROJECT LEADER:	M. CHENETTE	SHEET	43 OF 57
DESIGNED BY:	I. MAYNARD		
DETOUR PLAN - BR5			




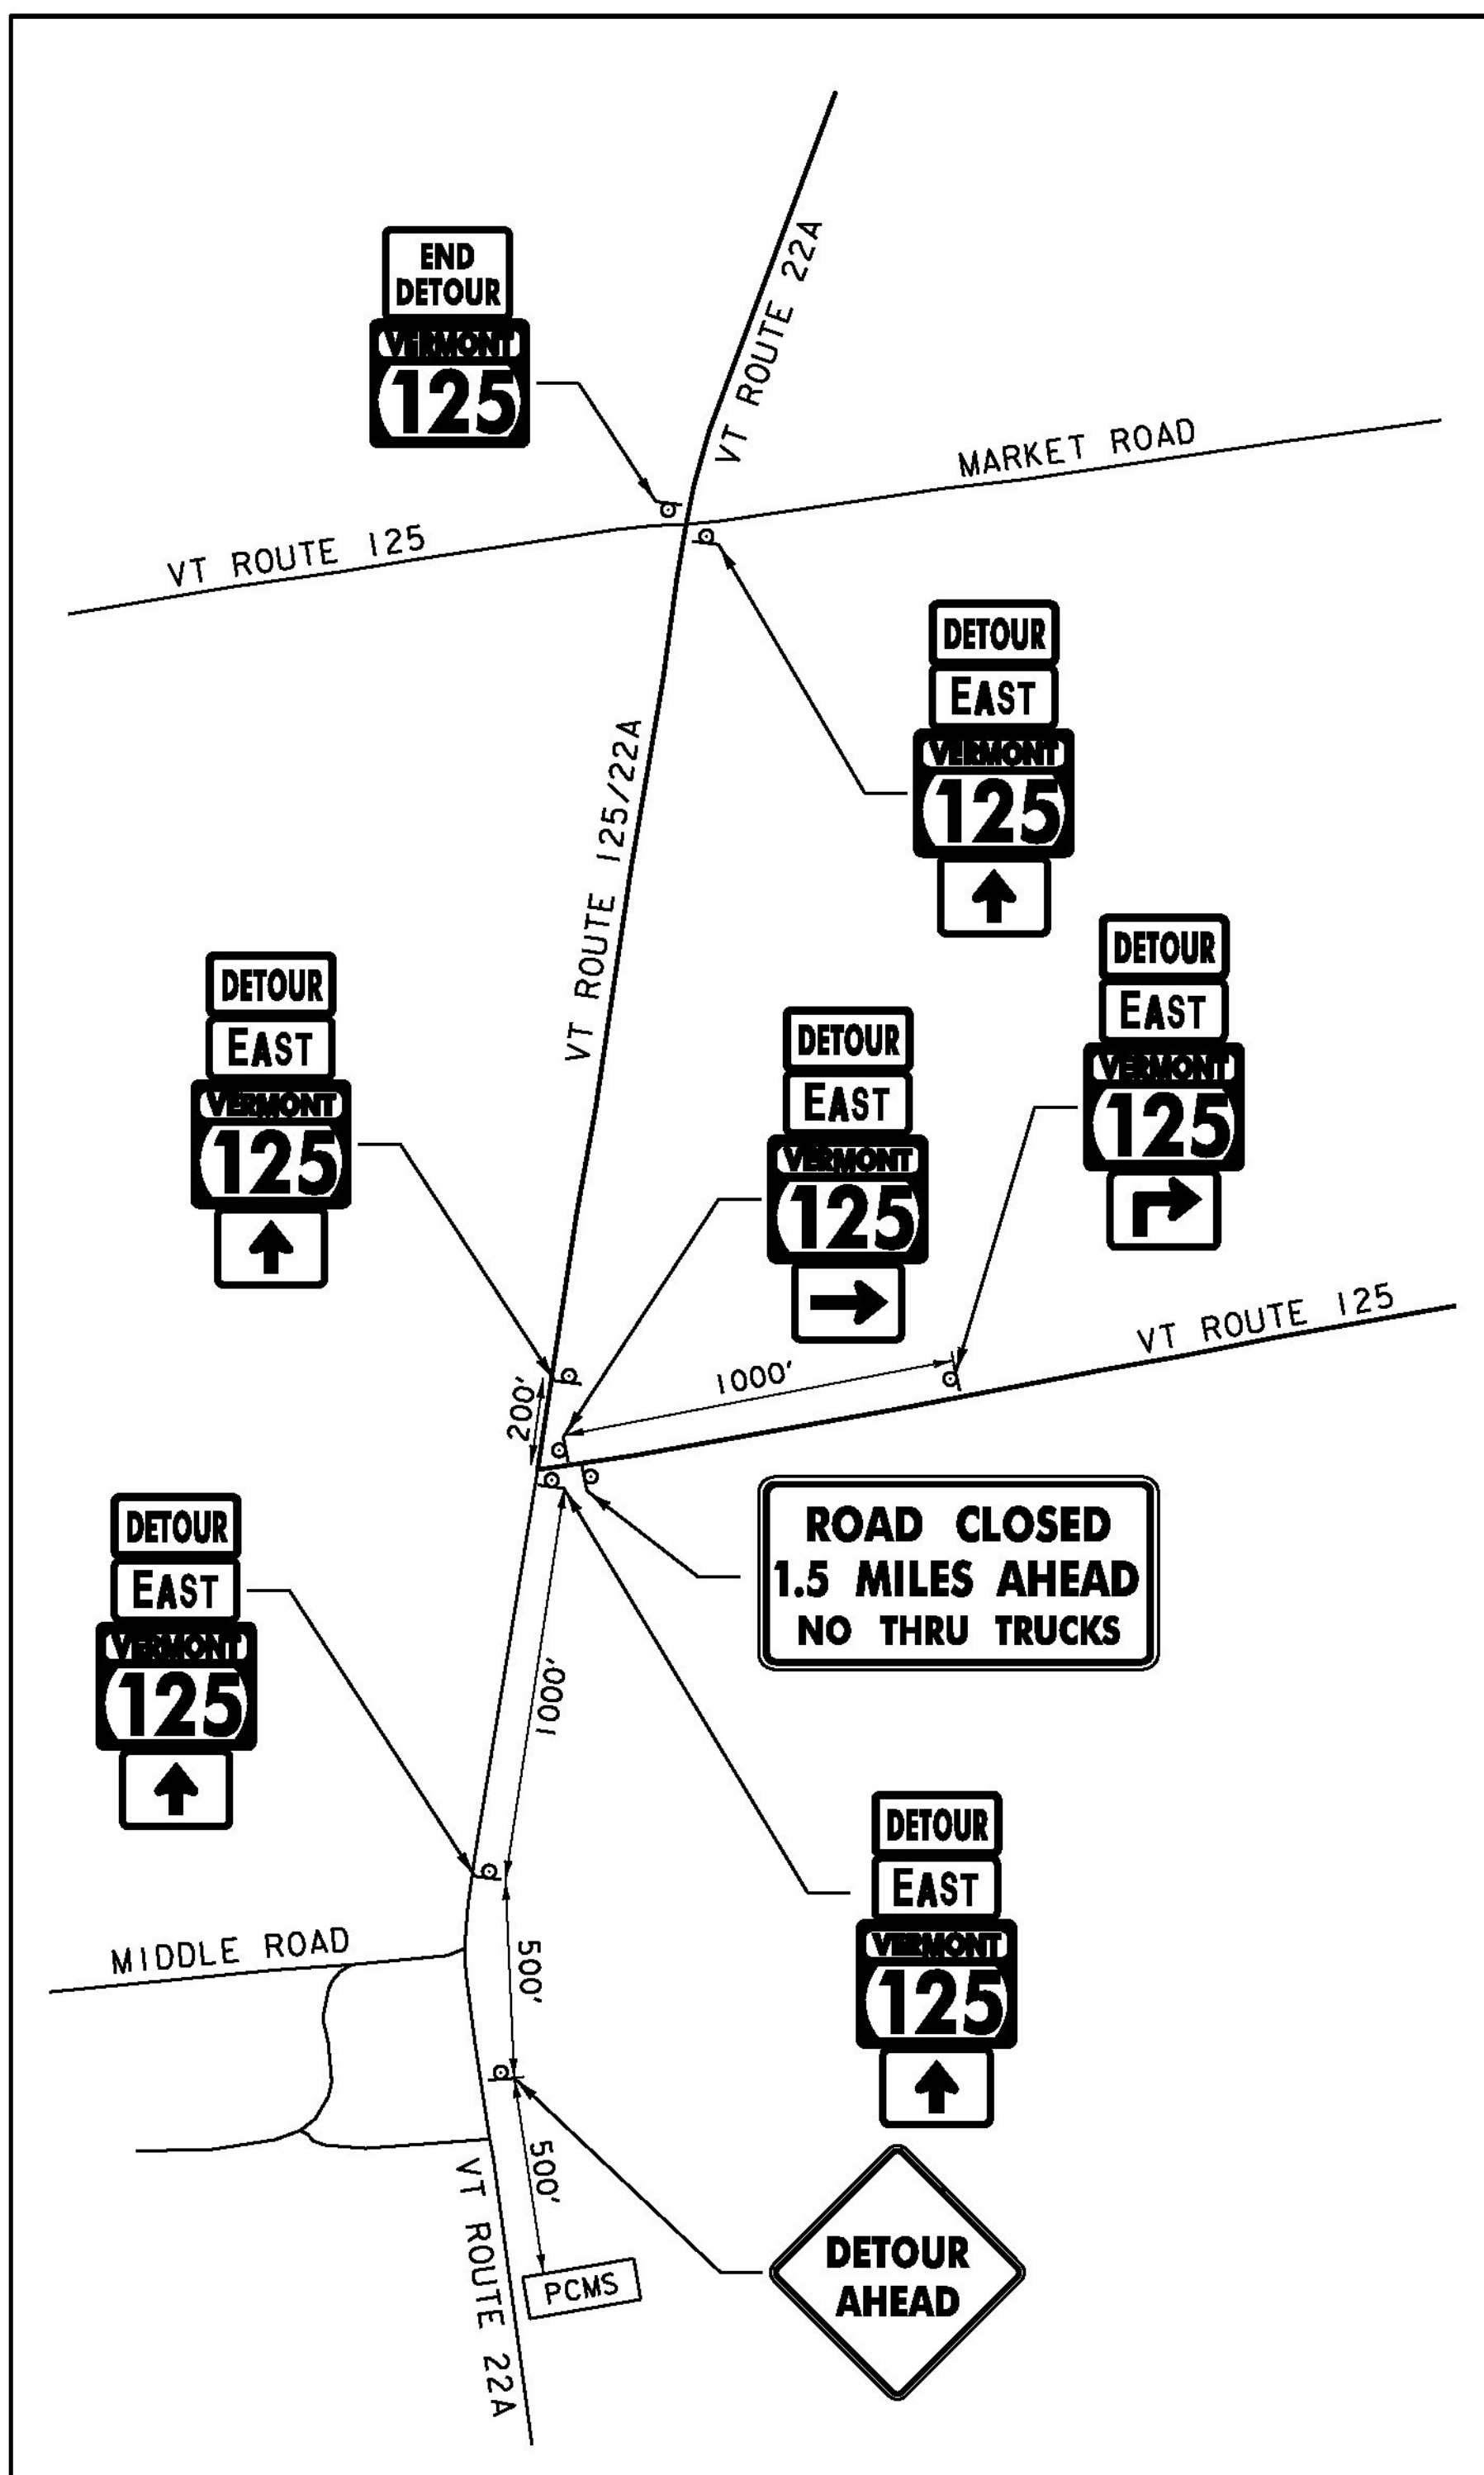


DETAIL A  
NOT TO SCALE

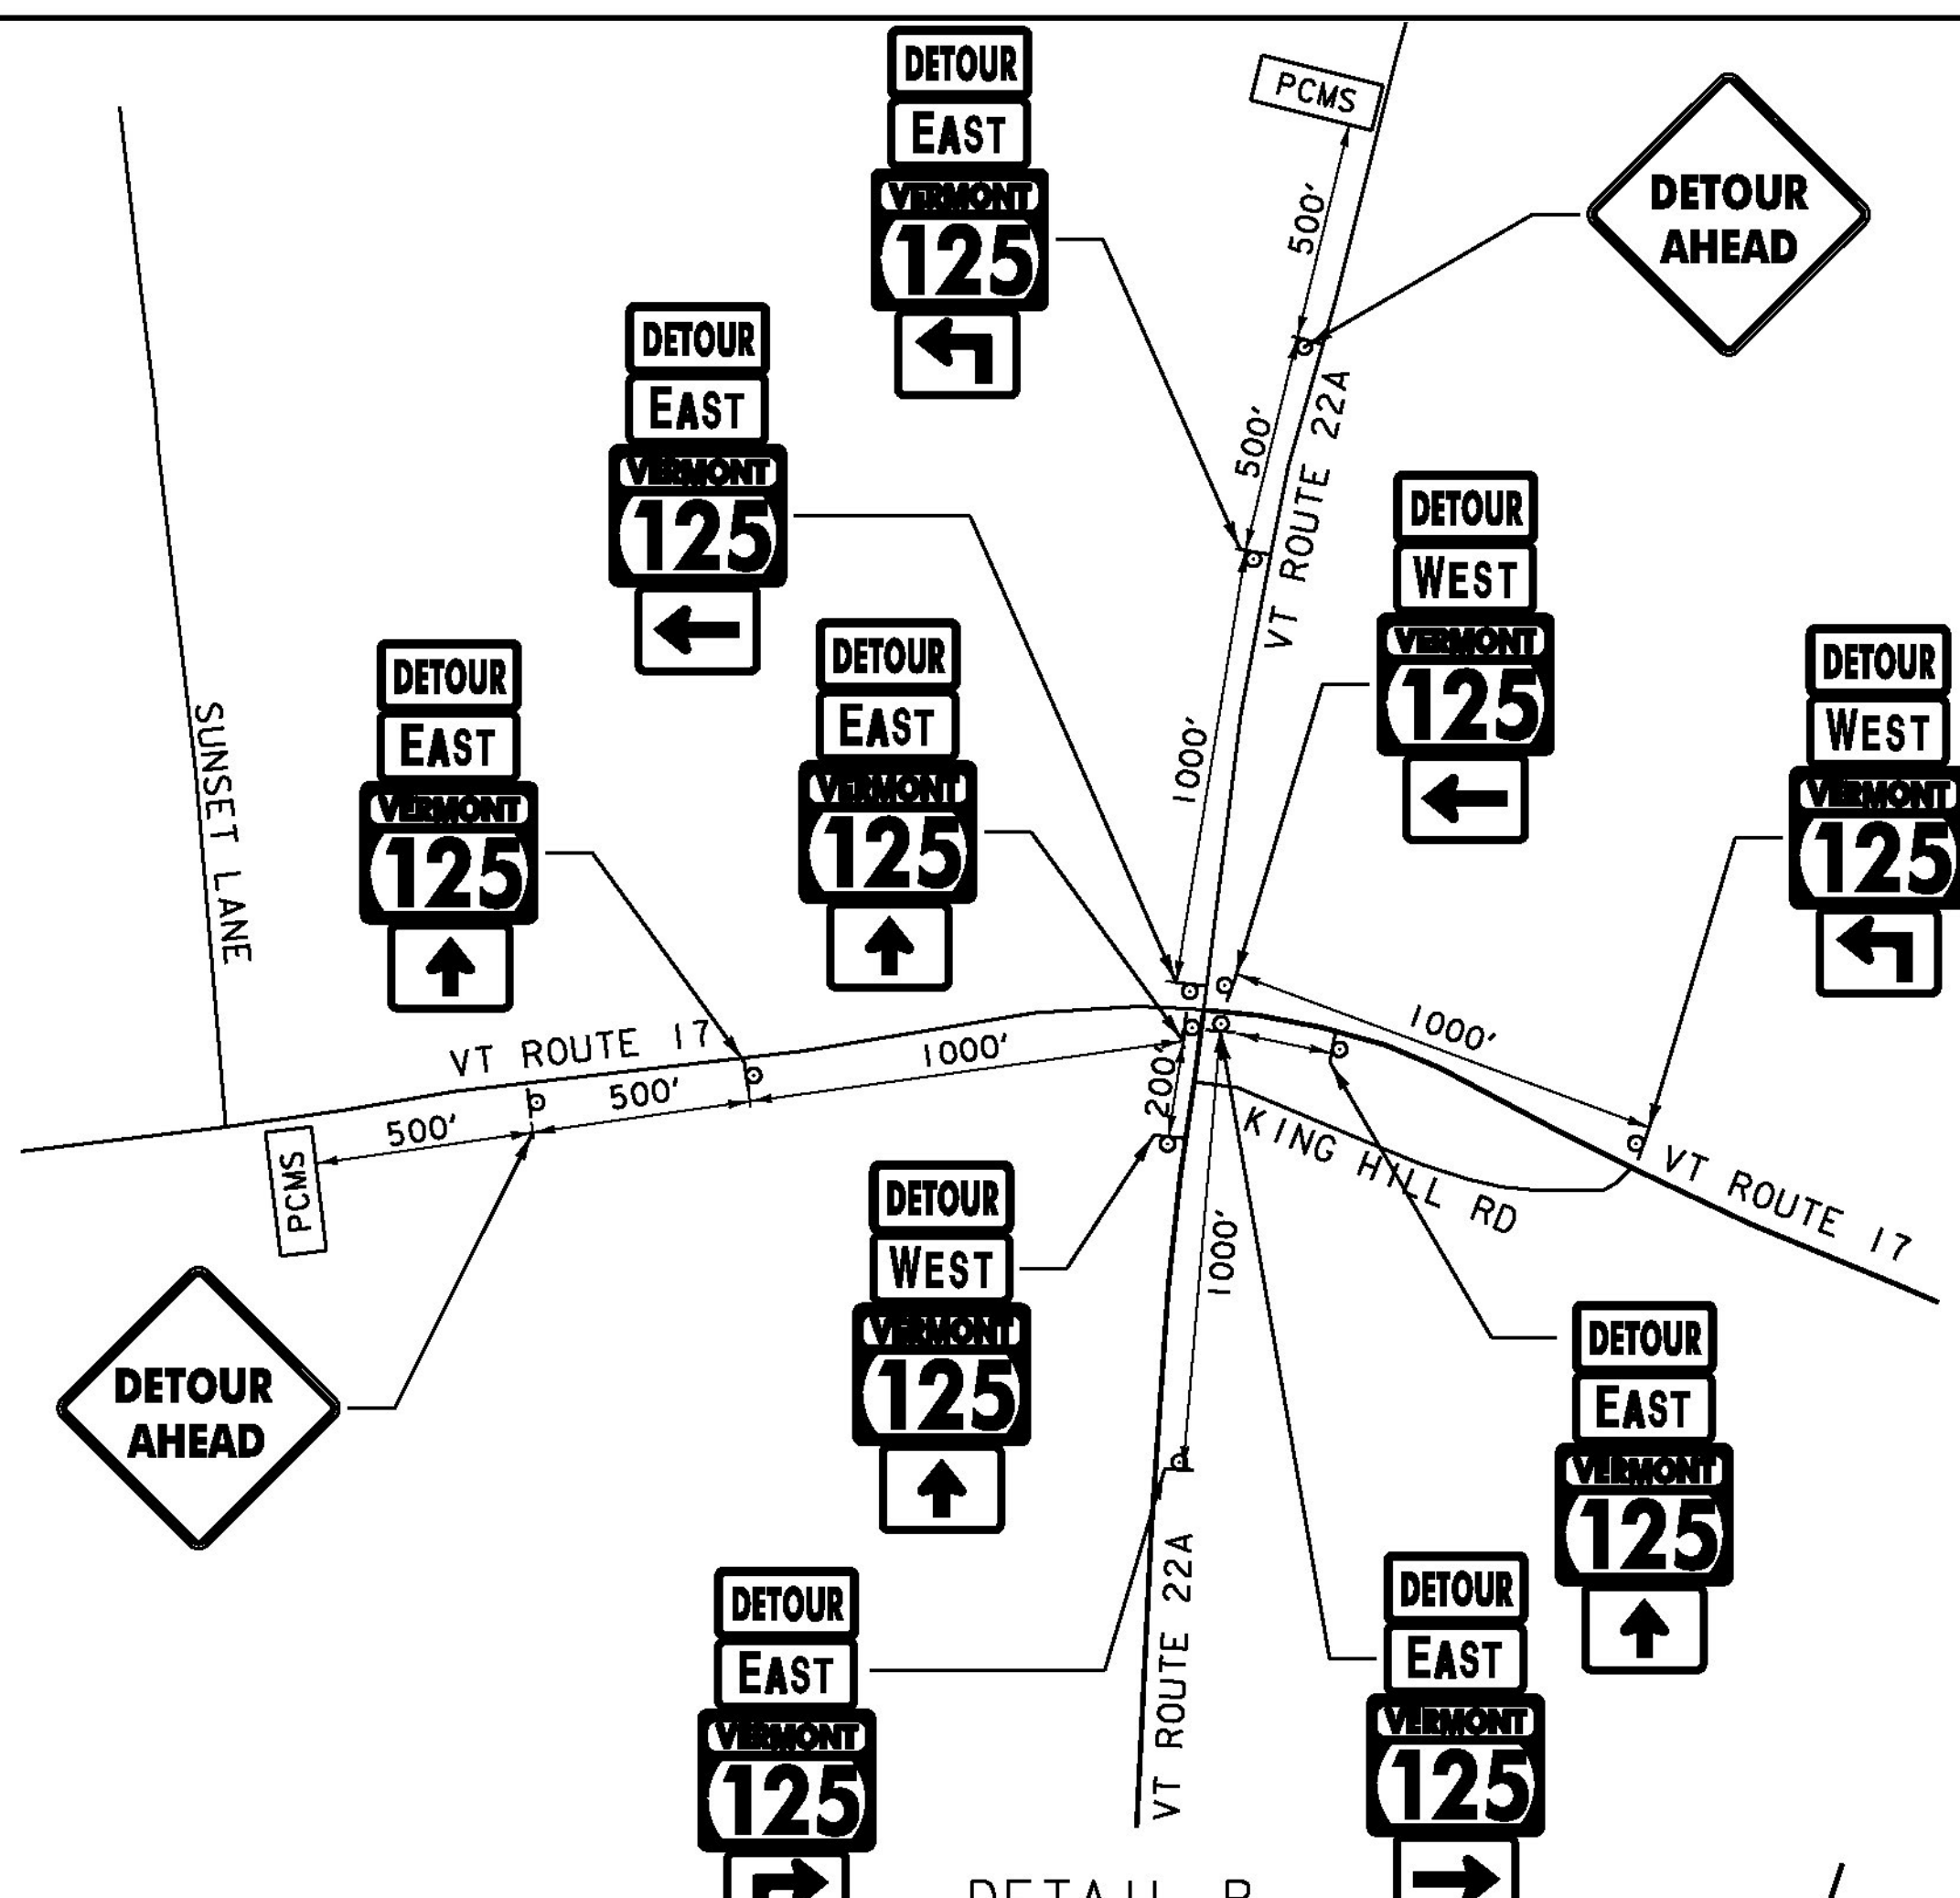

DETAIL B  
NOT TO SCALE

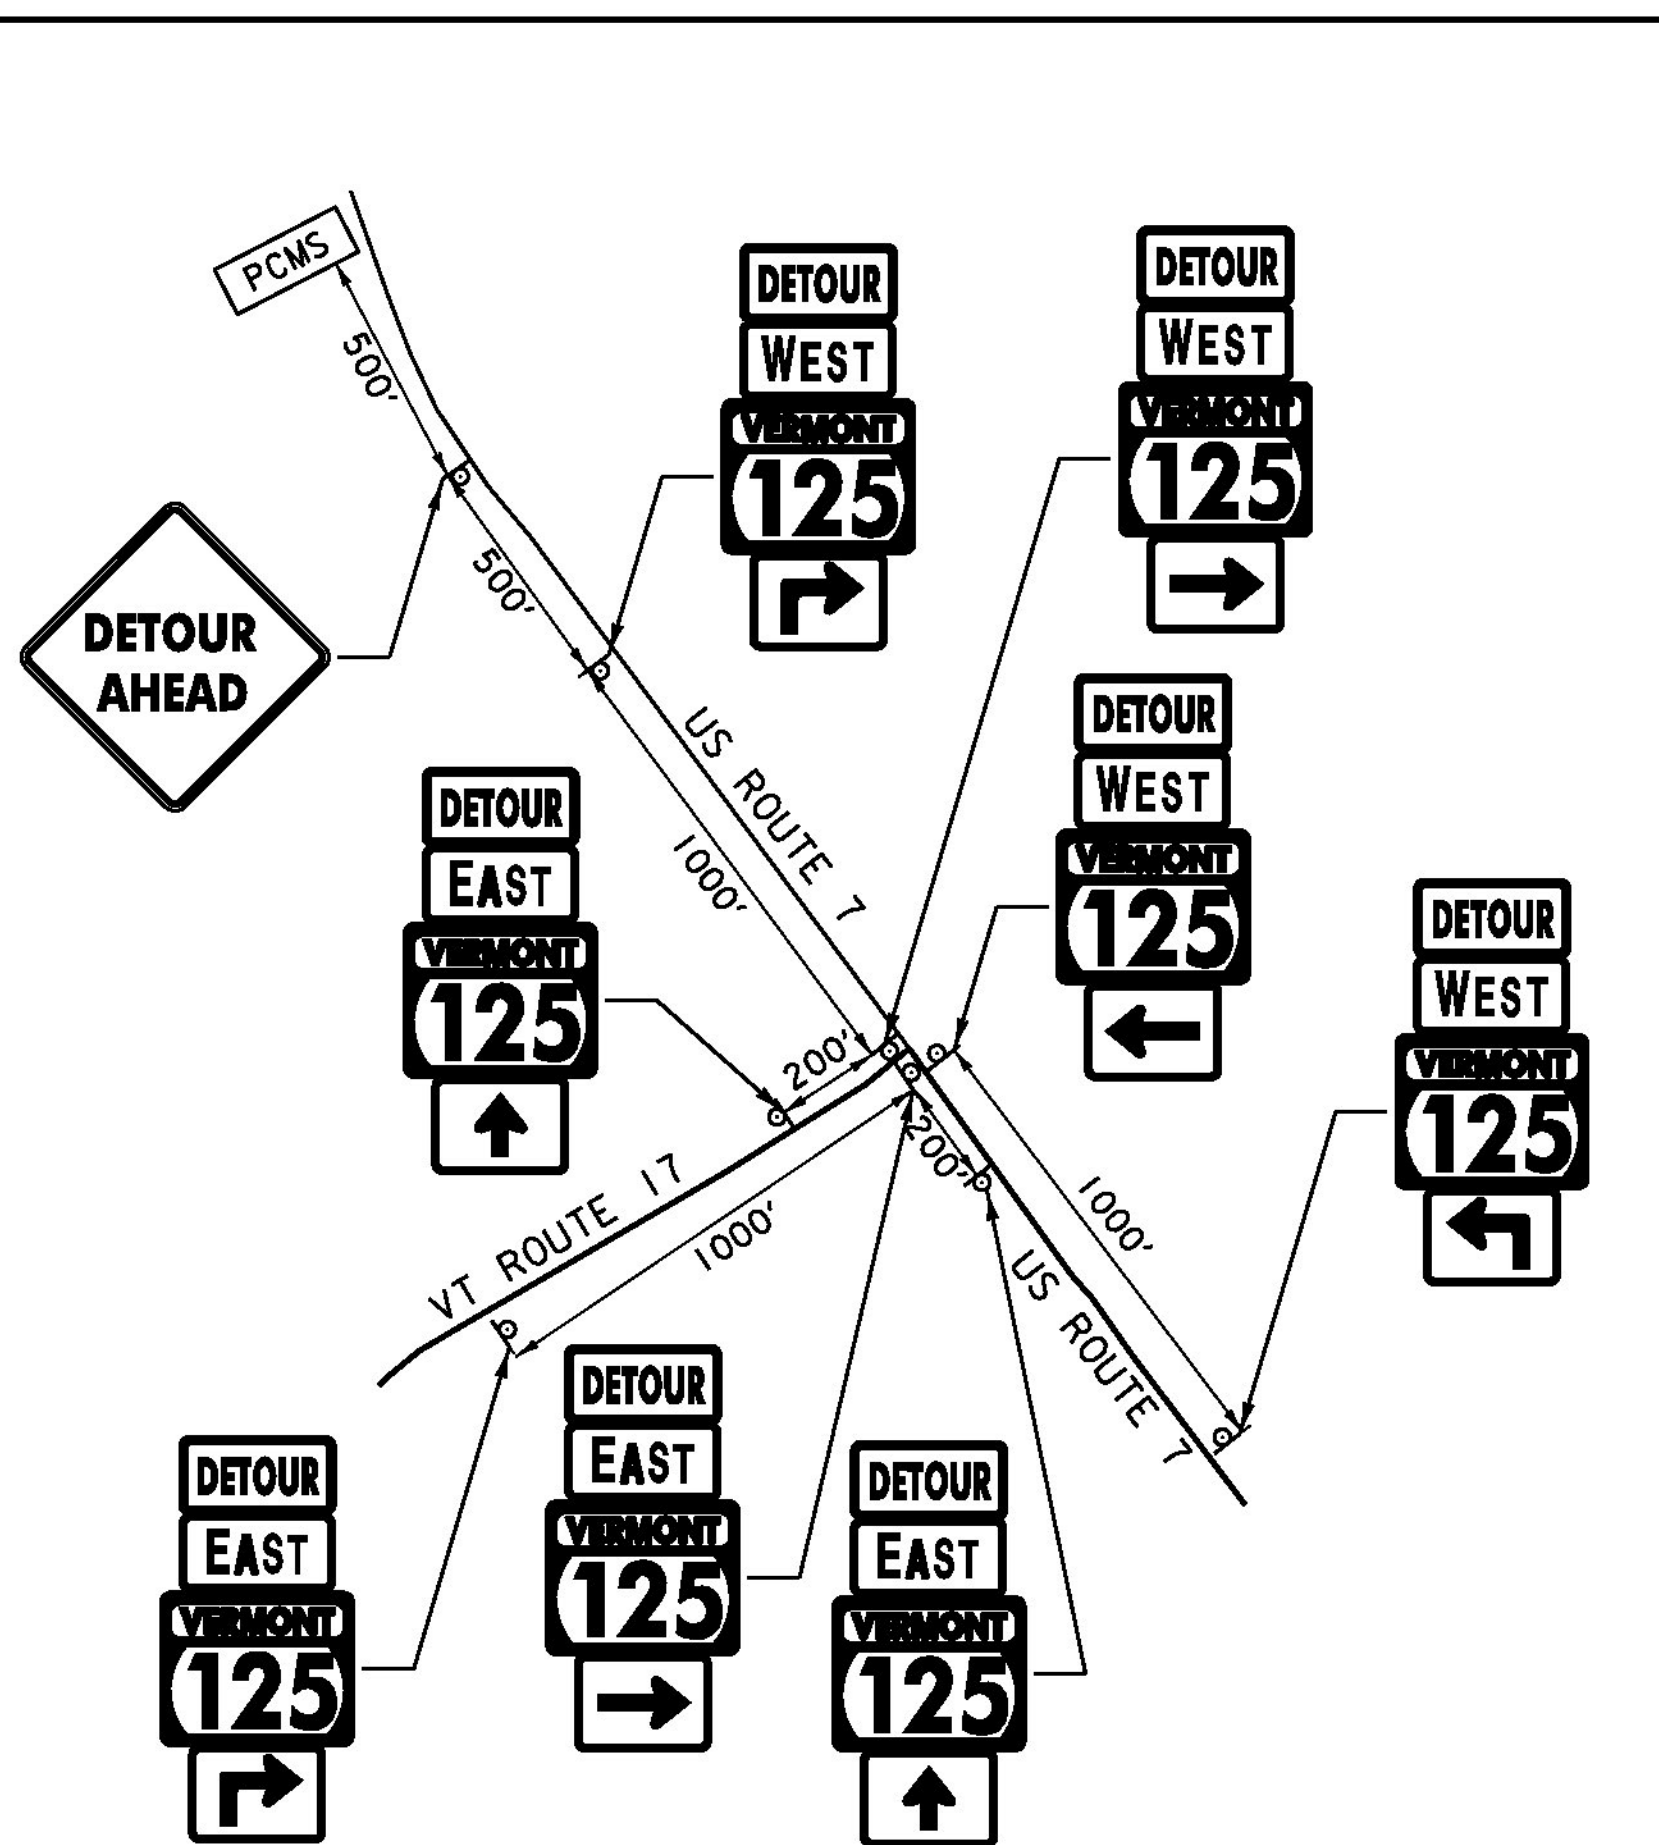



DETAIL C  
NOT TO SCALE

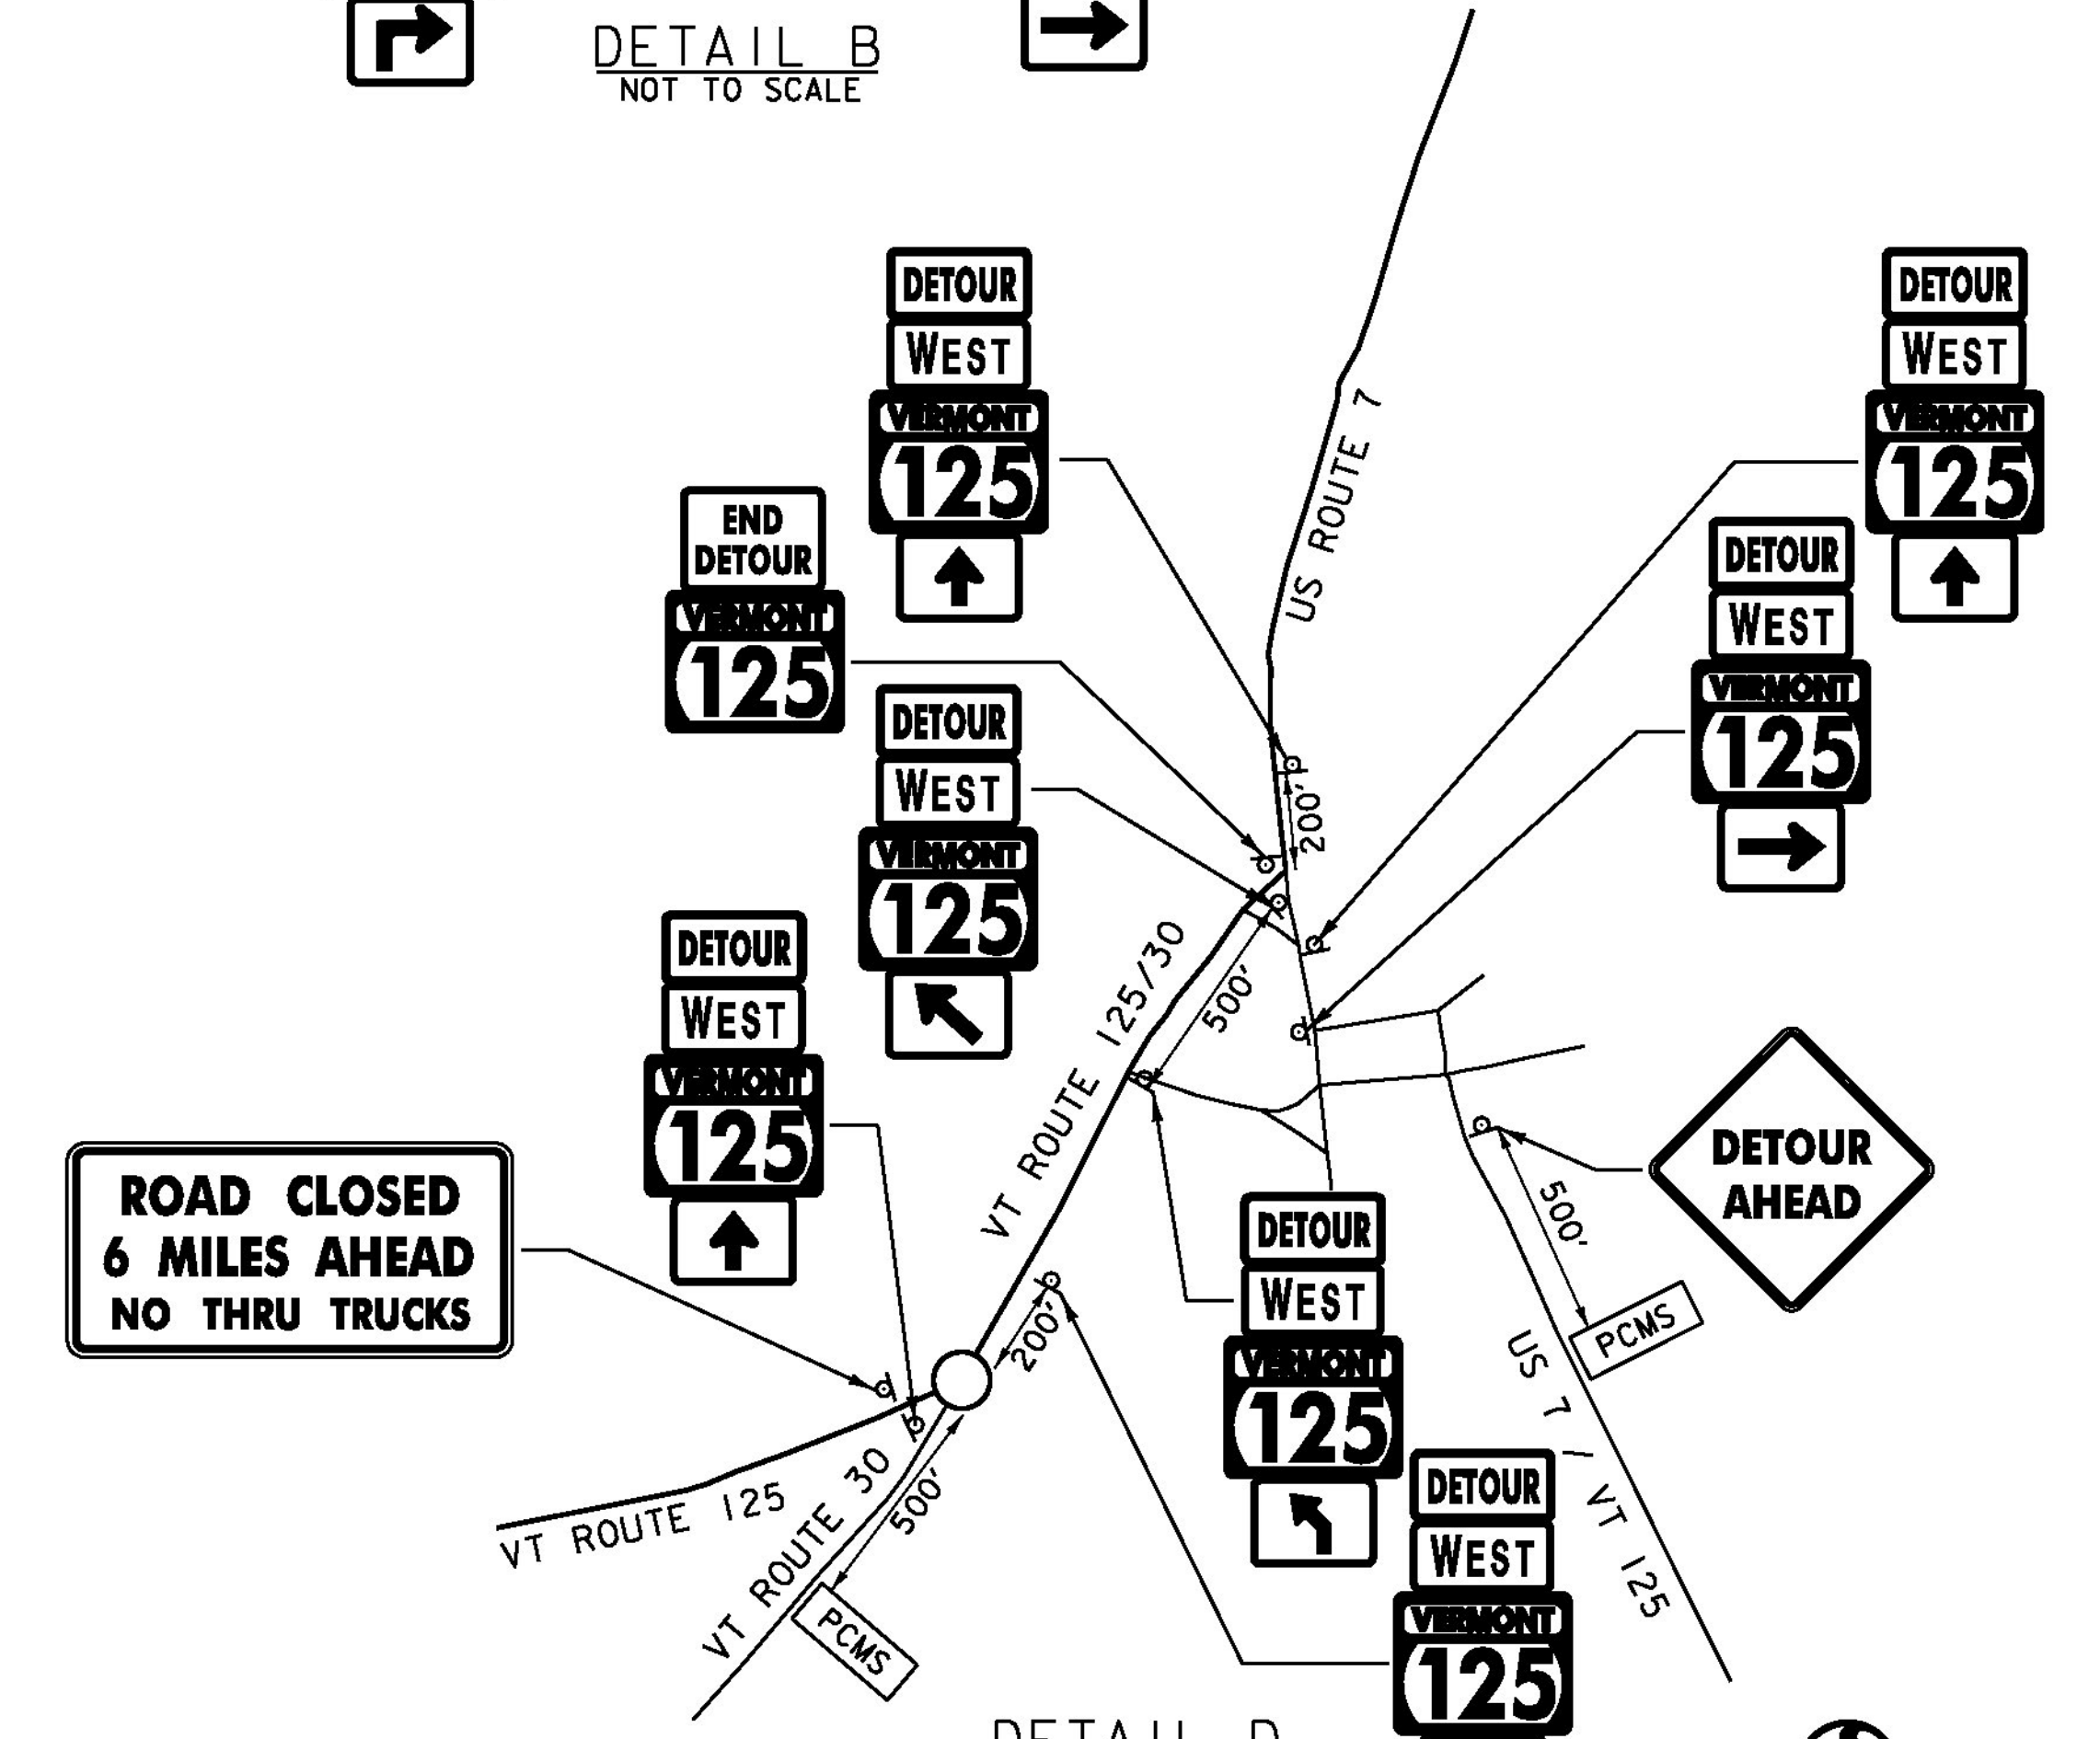

DETAIL D  
NOT TO SCALE

PROJECT NAME: BRIDPORT	PLOT DATE: 8/22/2014
PROJECT NUMBER: STP CULV(29)	DRAWN BY: I. MAYNARD
FILE NAME: zllc264+cdet_br5.l.dgn	CHECKED BY: J. HUNGERFORD
PROJECT LEADER: M. CHENETTE	SHEET 44 OF 57
DESIGNED BY: I. MAYNARD	
TRAFFIC CONTROL DETAILS I - BR5	



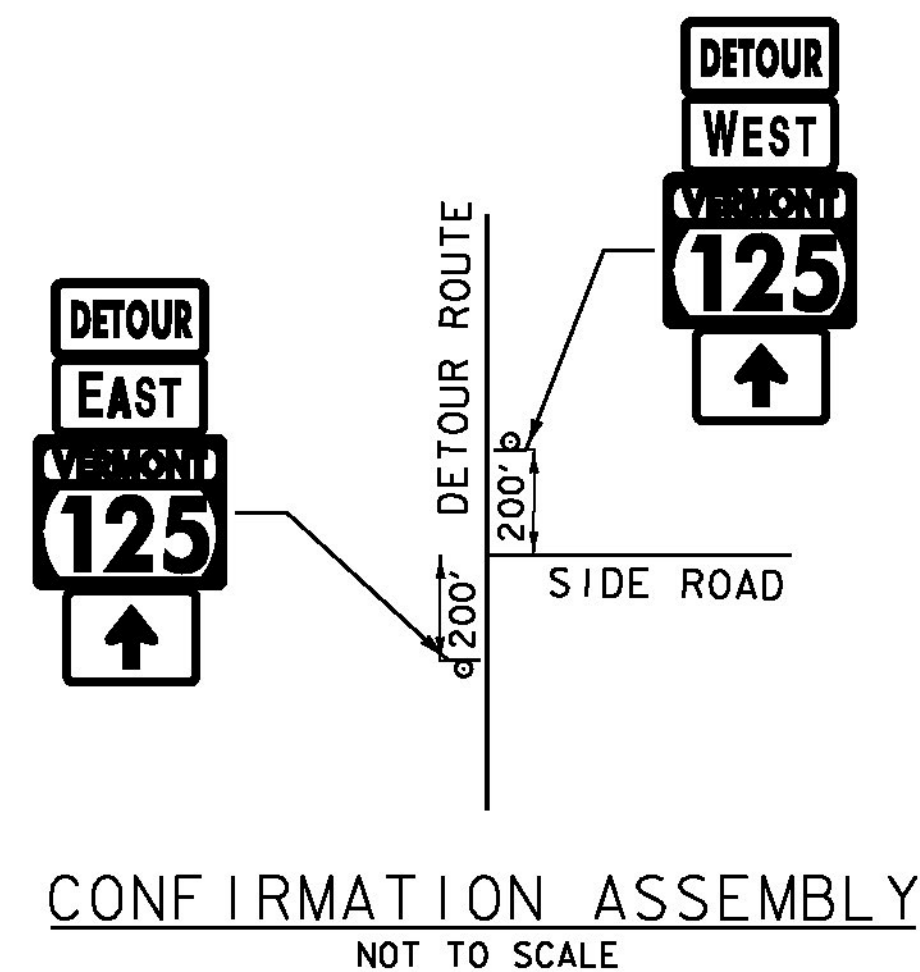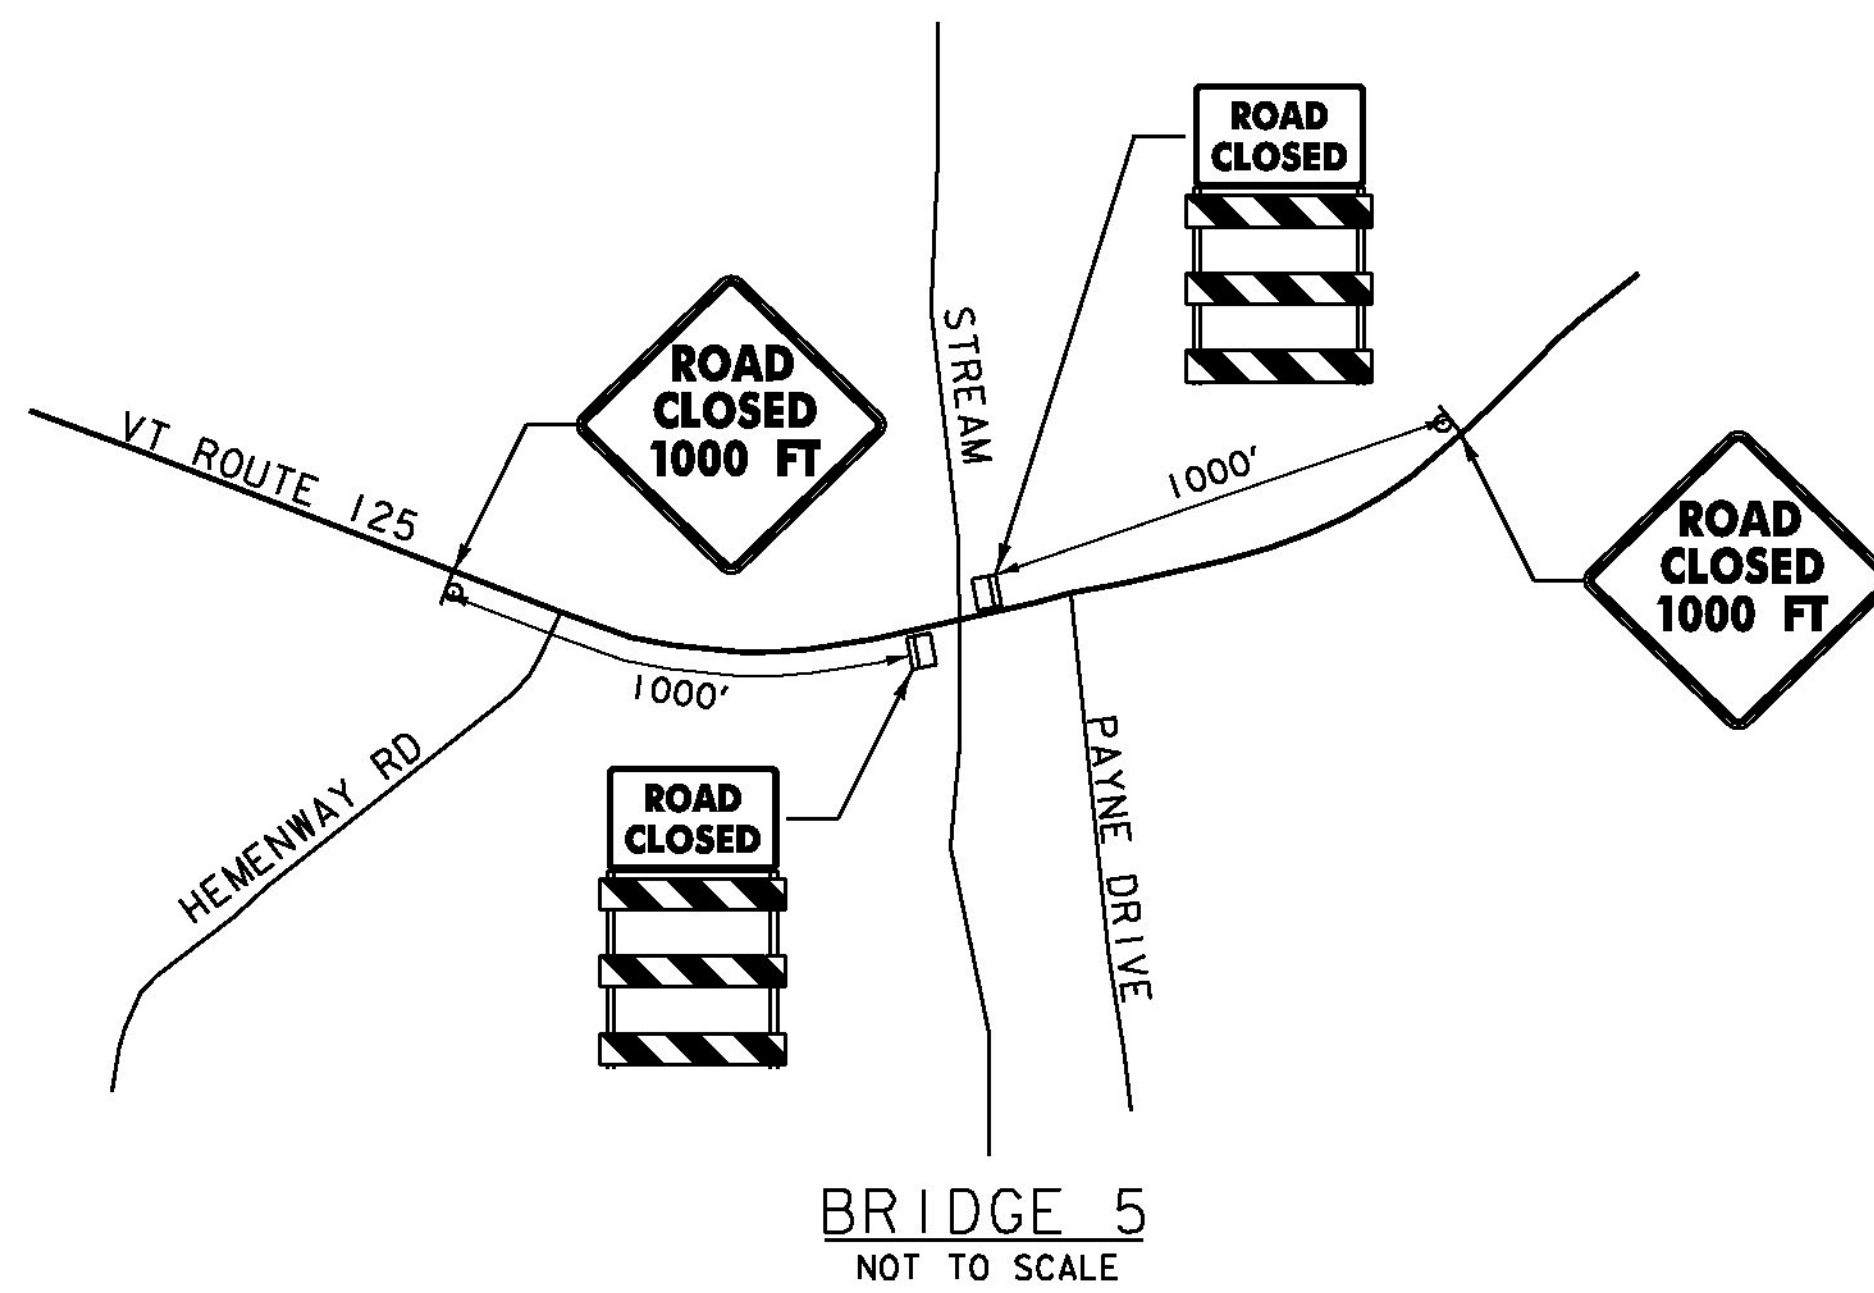

MESSAGES FOR PORTABLE CHANGEABLE MESSAGE SIGNS (PCMS) - REGIONAL DETOUR

- NOTES:
- ALL COSTS OF INSTALLING, MAINTAINING, AND REMOVING THE SIGNS AND BARRICADES IN THIS TRAFFIC CONTROL PLAN AS NECESSARY TO MEET PROJECT CONDITIONS SHALL BE INCLUDED IN ITEM 900.645 SPECIAL PROVISION (TRAFFIC CONTROL, ALL-INCLUSIVE). SEE SPECIAL PROVISIONS.
  - ALL TRAFFIC SIGNS SHALL CONFORM TO THE MANUAL ON UNIFORM TRAFFIC CONTROL DEVICES (MUTCD) 2009 EDITION.
  - "ROAD CLOSED" SIGNS SHALL BE MOUNTED AND MAINTAINED ON RETROREFLECTIVE TYPE III BARRICADES.
  - TYPE III CONSTRUCTION BARRICADES SHALL BE PLACED SO AS TO PHYSICALLY EXCLUDE TRAFFIC FROM THE ENTIRE ROADWAY WIDTH OR AT THE DISCRETION OF THE ENGINEER.
  - WHEN POSSIBLE LOCATE THE "ROAD CLOSED 1000 FT" SIGN NEAR A LOCATION WHERE DRIVERS CAN TURN AROUND.
  - THE MI-6B, THE M3-2 AND THE M3-4 SIGNS SHALL BECOME THE PROPERTY OF THE STATE AFTER THEY ARE REMOVED FROM THE DETOUR. THE CONTRACTOR SHALL DELIVER THE SIGNS TO THE STATE AT THE DISTRICT #5 GARAGE.
  - WHERE POSSIBLE LOCATE DETOUR ROUTE MARKER ASSEMBLIES ADJACENT TO EXISTING ROUTE MARKER ASSEMBLIES.
  - SIGN SPACING IS FOR REFERENCE ONLY, FIELD ADJUSTMENTS AS APPROVED BY THE ENGINEER.
  - EXISTING SIGNS IN CONFLICT WITH THIS DETOUR PLAN SHALL BE COVERED WHEN NECESSARY, AS APPROVED BY THE ENGINEER.

STARTING 2 WEEKS PRIOR TO CLOSURE

(ROUTE) **	MESSAGE 1 <b>VT 125 ROAD CLOSED</b>	MESSAGE 2 <b>MMMM DD TO MMMM DD</b>	(DATE) *
------------	------------------------------------------------	------------------------------------------------	----------

DURING CLOSURE

(ROUTE) **	MESSAGE 1 <b>VT 125 ROAD CLOSED</b>	MESSAGE 2 <b>BRIDPORT 1 MILE E OF VT 22A</b>
------------	------------------------------------------------	---------------------------------------------------------

* - DATE SHALL BE SPELLED OUT (I.E. JUNE 10 NOT 6/10)  
 ** - ROUTE 125 SHALL SPECIFY E (EAST) OR W (WEST) AS APPROPRIATE FOR THE DETOUR.

PCMS = PORTABLE CHANGEABLE MESSAGE SIGN

ID NUMBER	SIGN TEXT	SIZE OF SIGN		NUMBER OF SIGNS REQ'D.	AREA OF EACH SIGN (SF)	COLOR	REMARKS
		WIDTH	HEIGHT				
W20-2	DETOUR AHEAD	48"	48"	5	16.00	B/F0	
W20-3	ROAD CLOSED 1000 FT	48"	48"	2	16.00	B/F0	
M6-3	↑	21"	15"	16	2.19	B/F0	MOUNT BELOW MI-6A
M6-1R	→	21"	15"	5	2.19	B/F0	MOUNT BELOW MI-6A
M6-1L	←	21"	15"	3	2.19	B/F0	MOUNT BELOW MI-6A
M5-1L	↙	21"	15"	3	2.19	B/F0	MOUNT BELOW MI-6A
M5-1R	↘	21"	15"	4	2.19	B/F0	MOUNT BELOW MI-6A
M5-2L	↖	21"	15"	1	2.19	B/F0	MOUNT BELOW MI-6A
M6-2L	↗	21"	15"	1	2.19	B/F0	MOUNT BELOW MI-6A
M4-8	DETOUR	24"	12"	33	2.00	B/F0	MOUNT ABOVE M3-2 OR M3-4
M4-8A	END DETOUR	24"	18"	2	3.00	B/F0	MOUNT BELOW MI-6A
M3-2	EAST	24"	12"	18	2.00	G/W	
M3-4	WEST	24"	12"	15	2.00	G/W	
MI-6B	VERMONT 125	30"	24"	35	5.00	G/W	
R11-2C	ROAD CLOSED	48"	30"	2	10.00	B/W	
R11-3B	ROAD CLOSED 1.5 MILES AHEAD NO THRU TRUCKS	60"	30"	1	12.50	B/W	
R11-3B	ROAD CLOSED 6 MILES AHEAD NO THRU TRUCKS	60"	30"	1	12.50	B/W	

B/F0 = BLACK ON RETROREFLECTIVE ORANGE BACKGROUND  
 G/W = GREEN ON RETROREFLECTIVE WHITE BACKGROUND  
 B/W = BLACK ON RETROREFLECTIVE WHITE BACKGROUND



PROJECT NAME: BRIDPORT  
 PROJECT NUMBER: STP CULV(29)  
 FILE NAME: zllc264+cdet_br5.2.dgn  
 PROJECT LEADER: M. CHENETTE  
 DESIGNED BY: I. MAYNARD  
 TRAFFIC CONTROL DETAILS 2 - BR5  
 PLOT DATE: 8/22/2014  
 DRAWN BY: I. MAYNARD  
 CHECKED BY: J. HUNGERFORD  
 SHEET 45 OF 57

**SOIL CLASSIFICATION**

AASHTO

A1	Gravel and Sand
A3	Fine Sand
A2	Silty or Clayey Gravel and Sand
A4	Silty Soil - Low Compressibility
A5	Silty Soil - Highly Compressible
A6	Clayey Soil - Low Compressibility
A7	Clayey Soil - Highly Compressible

**ROCK QUALITY DESIGNATION**

R.Q.D. (%)	ROCK DESCRIPTION
<25	Very Poor
25 to 50	Poor
51 to 75	Fair
76 to 90	Good
>90	Excellent

**SHEAR STRENGTH**

UNDRAINED SHEAR STRENGTH IN P.S.F.	CONSISTENCY
<250	Very Soft
250-500	Soft
500-1000	Med. Stiff
1000-2000	Stiff
2000-4000	Very Stiff
>4000	Hard

**CORRELATION GUIDE OF "N" TO DENSITY/CONSISTENCY**

DENSITY (GRANULAR SOILS)		CONSISTENCY (COHESIVE SOILS)	
N	DESCRIPTIVE TERM	N	DESCRIPTIVE TERM
<5	Very Loose	<2	Very Soft
5-10	Loose	2-4	Soft
11-24	Med. Dense	5-8	Med. Stiff
25-50	Dense	9-15	Stiff
>50	Very Dense	16-30	Very Stiff
		31-60	Hard
		>60	Very Hard

**COMMONLY USED SYMBOLS**

▼	Water Elevation
⊕	Standard Penetration Boring
⊗	Auger Boring
⊙	Rod Sounding
S	Sample
N	Standard Penetration Test Blow Count Per Foot For: 2" O.D. Sampler 1 3/8" I.D. Sampler Hammer Weight Of 140 Lbs. Hammer Fall Of 30"
VS	Field Vane Shear Test
US	Undisturbed Soil Sample
B	Blast
DC	Diamond Core
MD	Mud Drill
WA	Wash Ahead
HSA	Hollow Stem Auger
AX	Core Size 1 1/8"
BX	Core Size 1 3/8"
NX	Core Size 2 1/8"
M	Double Tube Core Barrel Used
LL	Liquid Limit
PL	Plastic Limit
PI	Plasticity Index
NP	Non Plastic
w	Moisture Content (Dry Wgt. Basis)
D	Dry
M	Moist
MTW	Moist To Wet
W	Wet
Sat	Saturated
Bo	Boulder
Gr	Gravel
Sa	Sand
SI	Silt
Cl	Clay
HP	Hardpan
Le	Ledge
NLTD	No Ledge To Depth
CNPF	Can Not Penetrate Further
TLOB	To Ledge Or Boulder
NR	No Recovery
Rec.	Recovery
%Rec.	Percent Recovery
RQD	Rock Quality Designation
CBR	California Bearing Ratio
<	Less Than
>	Greater Than
R	Refusal (N > 100)

**COLOR**

blk	Black	pnk	Pink
bl	Blue	pu	Purple
brn	Brown	rd	Red
dk	Dark	tn	Tan
gry	Gray	wh	White
gn	Green	yel	Yellow
lt	Light	mltc	Multicolored
or	Orange		

**DEFINITIONS (AASHTO)**

**BEDROCK (LEDGE)** - Rock in its native location of indefinite thickness.

**BOULDER** - A rock fragment with an average dimension > 12 inches.

**COBBLE** - Rock fragments with an average dimension between 3 and 12 inches.

**GRAVEL** - Rounded particles of rock < 3" and > 0.075" (#10 sieve).

**SAND** - Particles of rock < 0.075" (#10 sieve) and > 0.0029" (#200 sieve).

**SILT** - Soil < 0.0029" (#200 sieve), non or slightly plastic and exhibits no strength when air-dried.

**CLAY** - Fine grained soil, exhibits plasticity when moist and considerable strength when air-dried.

**VARVED** - Alternate layers of silt and clay.

**HARDPAN** - Extremely dense soil, cemented layer, not softened when wet.


**MUCK** - Soft organic soil (containing > 10% organic material).

**MOISTURE CONTENT** - Weight of water divided by dry weight of soil.

**FLOWING SAND** - Granular soil so saturated (loose) that it flows into drill casing during extraction of wash rod.

**STRIKE** - Angle from magnetic north to line of intersection of bed with a horizontal plane.

**DIP** - Inclination of bed with a horizontal plane.

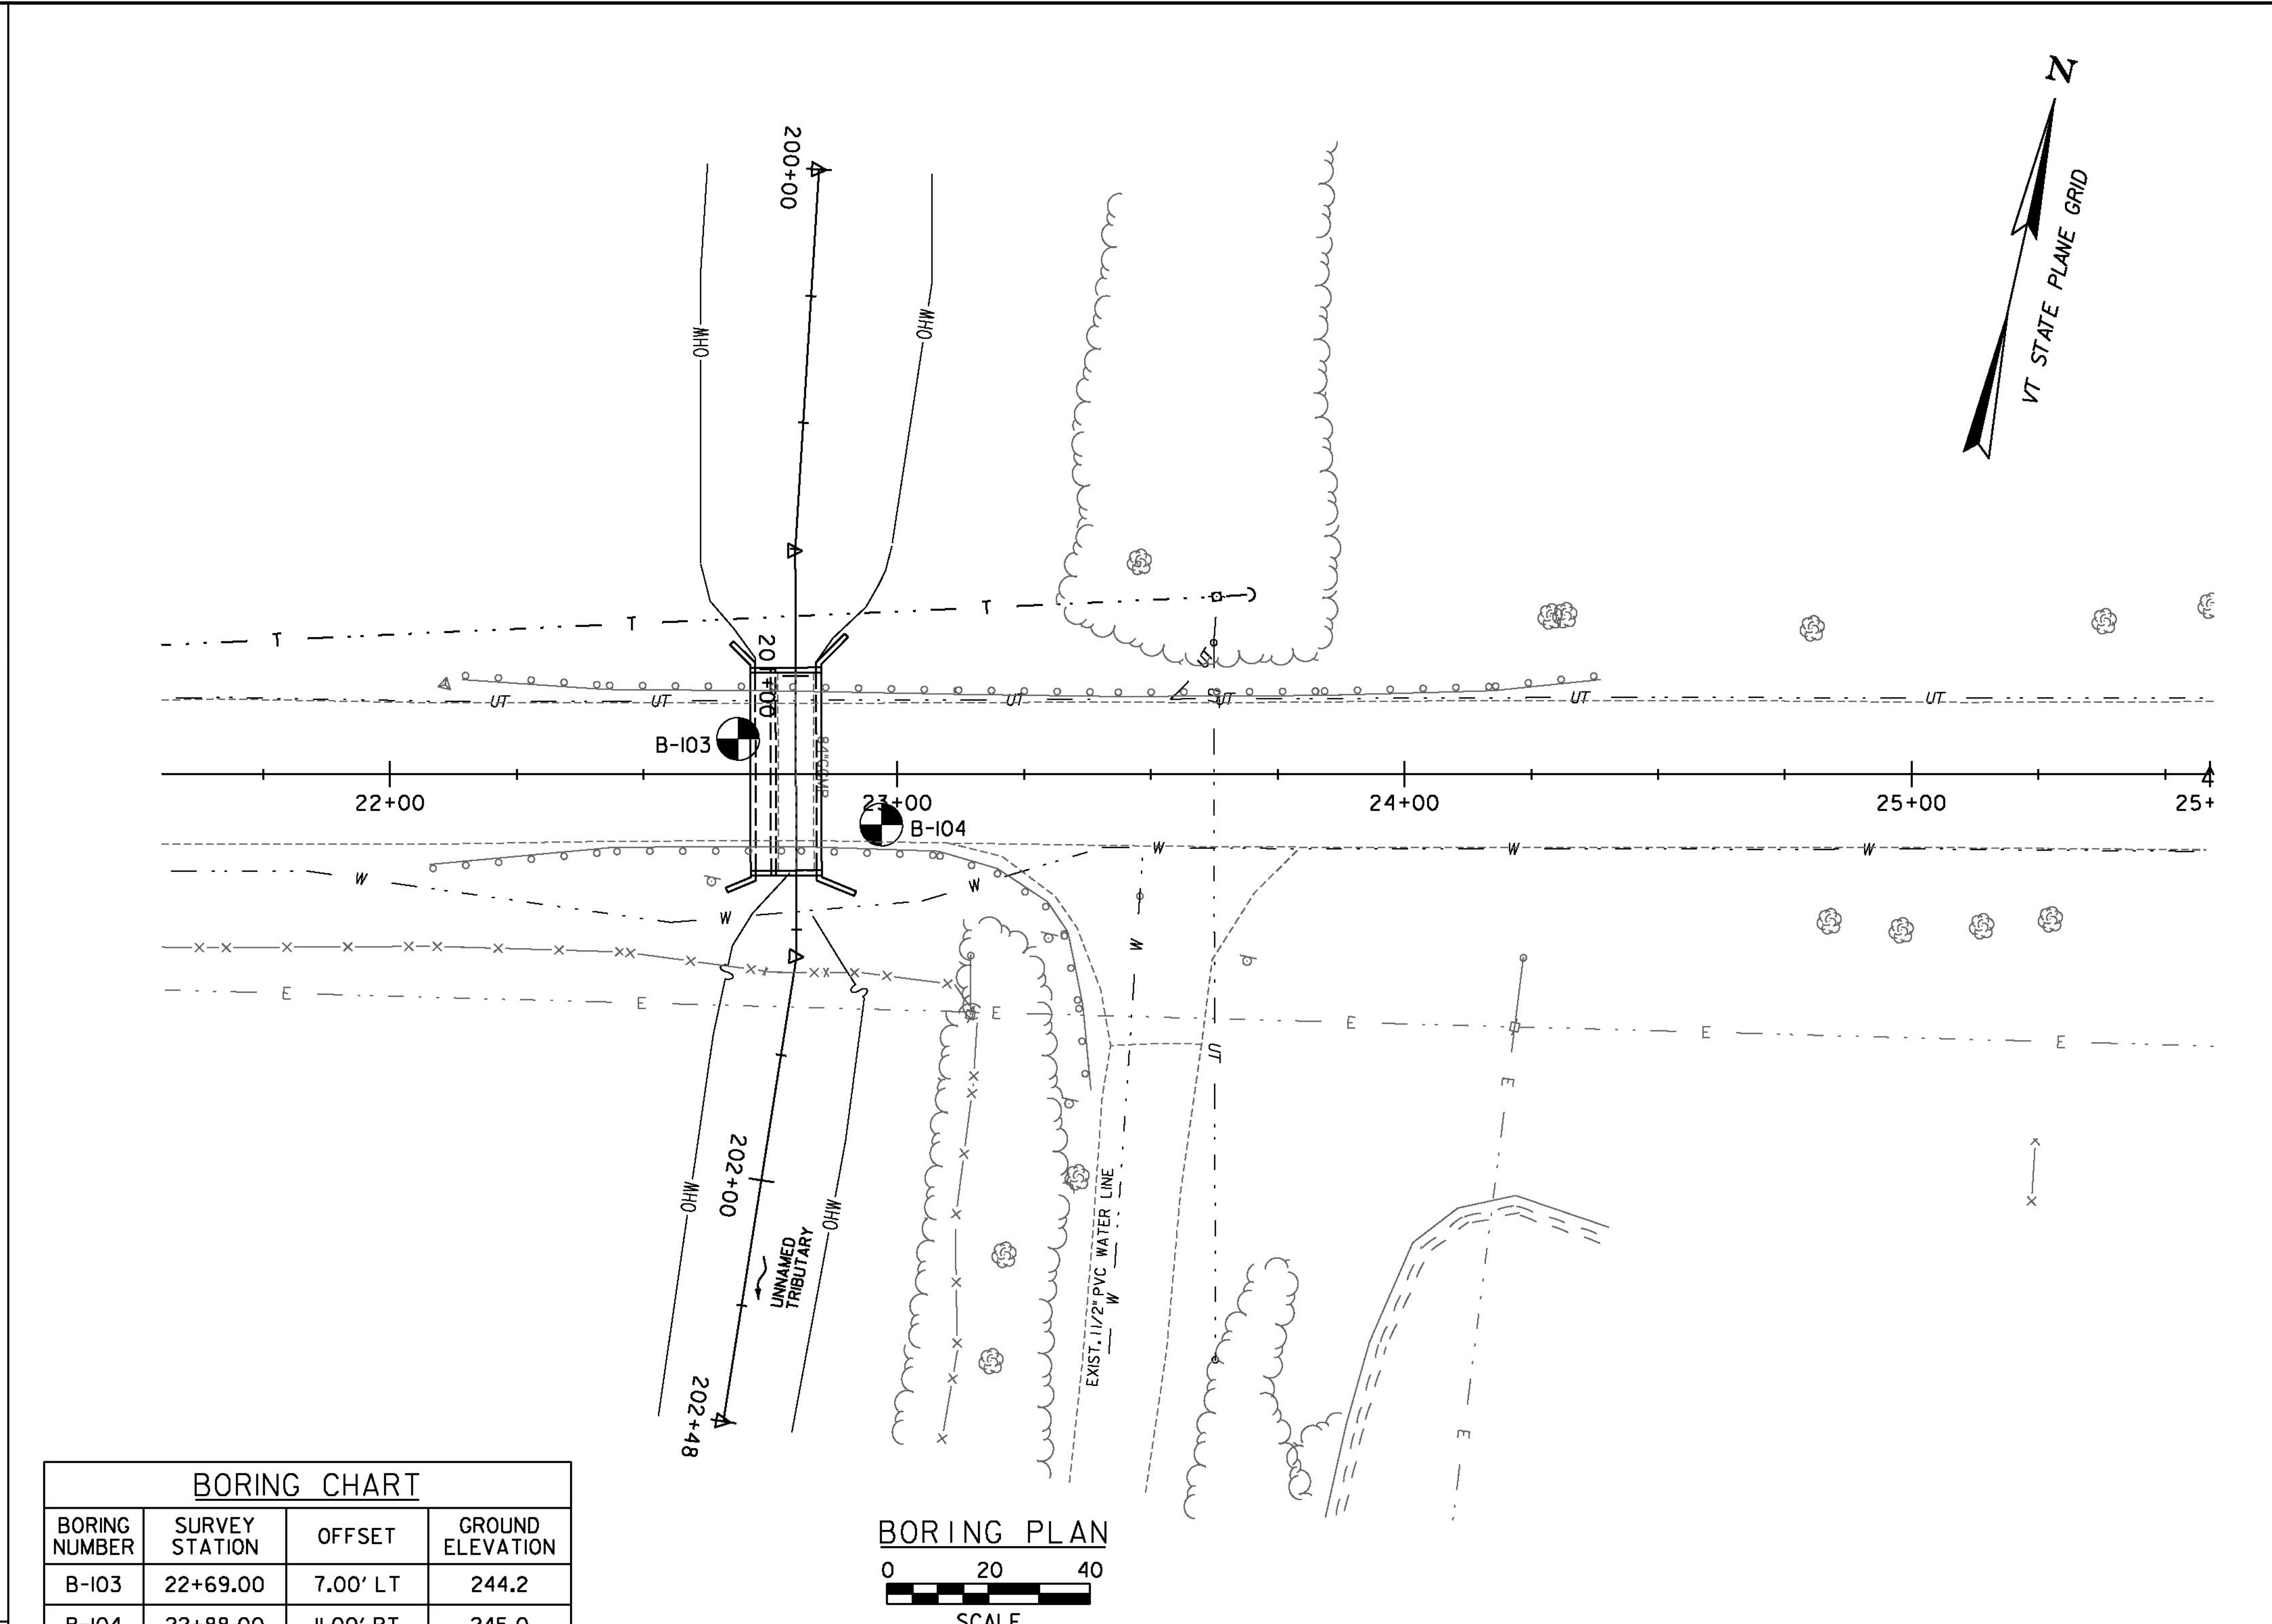

**GENERAL NOTES**

- The subsurface explorations shown herein were made on Oct. 25, 2012 by N.H. Boring.
- Soil and rock classifications, properties and descriptions are based on engineering interpretation from available subsurface information and may not necessarily reflect actual variations in subsurface conditions that may be encountered between individual boring or sample locations.
- Observed water levels and/or conditions indicated are as recorded at the time of exploration and may vary according to the prevailing rainfall, methods of exploration and other factors.
- Engineering judgement was exercised in preparing the subsurface information presented herein. Analysis and interpretation of subsurface data was performed and interpreted for Agency design and estimating purposes. Presentation of the information in the Contract is intended to provide the Contractor access to the same data available to the Agency. The subsurface information is presented in good faith and is not intended as a substitute for personal investigation, independent interpretation, independent analysis or judgement by the Contractor.
- Pictorial structure details shown on the boring plan layout or soils profile are for illustrative purposes only and may not accurately portray final contract details.
- Terminology used on boring logs to describe the hardness, degree of weathering, and spacing of fractures, joints and other discontinuities in the bedrock is defined in the AASHTO Manual on Subsurface Investigations, 1988.

**LEGEND:**

⊕ BRIDGE BORING

PROJECT NAME: BRIDPORT  
PROJECT NUMBER: STP CULV(29)

FILE NAME: zllc264bdr_bor_pl_br5.dgn  
PROJECT LEADER: M. CHENETTE  
DESIGNED BY: J. HUNGERFORD  
BORING PLAN - BR5

PLOT DATE: 8/22/2014  
DRAWN BY: L. BUXTON  
CHECKED BY: M. CHENETTE  
SHEET 46 OF 57



STATE OF VERMONT AGENCY OF TRANSPORTATION MATERIALS & RESEARCH SECTION SUBSURFACE INFORMATION		BORING LOG		Boring No.: B-103						
		BRIDPORT STP CULV(29) VT-125 BR-2&5		Page No.: 1 of 1						
				Pin No.: 11C264						
				Checked By: LAR						
Boring Crew: GARROW, WHITLOCK, JUDKINS		Casing Type: WB	Sampler Type: SS	Groundwater Observations						
Date Started: 9/26/12 Date Finished: 9/28/12		I.D.: 4 in	1.5 in	Date	Depth (ft)					
VTSPG NAD83: N 543946.30 ft E 1434962.90 ft		Hammer Wt: N.A.	140 lb.	Notes						
Station: 22+69 Offset: -7.00		Hammer Fall: N.A.	30 in.	None taken.						
Ground Elevation: 244.2 ft		Hammer/Rod Type: Auto/AWJ								
		Rig: CME 45C SKID	CE = 1.33							
Depth (ft)	Strata (f)	CLASSIFICATION OF MATERIALS (Description)		Blows/s (N Value)	Moisture Content %	Gravel %	Sand %	Fines %	LL %	PI %
		Asphalt Pavement, 0.0 ft - 0.7 ft								
5		A-4, SaSi, gry, Moist, Rec. = 0.2 ft, Lab Note: Clay was noticeable. Insufficient sample for extra testing.		2-2-2-3 (4)	33.8	8.5	38.3	53.2		
10		A-7-6, Cl, gry, Moist, Rec. = 1.9 ft		WH-WH-2-2 (2)	47.2	1.4	1.7	96.9	68	42
		A-7-6, Cl, gry, Moist, Rec. = 1.3 ft, Shelby Tube sample U1			38.9				67	42
15		Cl Shelby Tube, gry, Moist, Rec. = 1.9 ft, 14.0 ft - 16.0 ft								
		A-7-6, Cl, gry, Moist, Rec. = 2.0 ft		2-2-3-2 (5)	42.4		1.2	98.8	60	36
		Visual Description: Cl, gry, Moist, Rec. = 1.9 ft, Material similar to 16-18 ft.		WH-1-2-WH (3)	47.2					
20		Visual Description: Cl, gry, Moist, Rec. = 2.0 ft, Material similar to 16-18 ft.		(WH)	45.8					
		A-7-6, Cl, gry, Moist, Rec. = 2.0 ft		(WH)	57.9		0.8	99.2	53	31
25		Visual Description: Cl, gry, Moist, Rec. = 2.0 ft, Material similar to 22-24 ft.		(WH)	51.5					
		Visual Description: Cl, gry, Moist, Rec. = 2.0 ft, Material similar to 28-30 ft.		(WH)	65.6					
		A-7-6, Cl, gry, Moist, Rec. = 2.0 ft		(WH)	51.7		0.7	99.3	52	30
30		Visual Description: Cl, gry, Moist, Rec. = 2.0 ft, Material similar to 38-40 ft.		WR-WR-WH-WH (WH)	47.9					
35		A-7-6, Cl, gry, Moist, Rec. = 2.0 ft		(WH)	71.6		0.5	99.5	54	32
40		Hole stopped @ 40.0 ft								
45		Remarks: Hole collapsed at 26.0 ft.								
Notes: 1. Stratification lines represent approximate boundary between material types. Transition may be gradual. 2. N Values have not been corrected for hammer energy. CE is the hammer energy correction factor. 3. Water level readings have been made at times and under conditions stated. Fluctuations of groundwater may occur due to other factors than those present at the time measurements were made.										

BOTTOM OF CULVERT  
APPROX. EL. 232.2

STATE OF VERMONT AGENCY OF TRANSPORTATION MATERIALS & RESEARCH SECTION SUBSURFACE INFORMATION		BORING LOG		Boring No.: B-104						
		BRIDPORT STP CULV(29) VT-125 BR-2&5		Page No.: 1 of 1						
				Pin No.: 11C264						
				Checked By: LAR						
Boring Crew: GARROW, JUDKINS		Casing Type: WB	Sampler Type: SS	Groundwater Observations						
Date Started: 9/27/12 Date Finished: 9/27/12		I.D.: 4 in	1.5 in	Date	Depth (ft)					
VTSPG NAD83: N 543935.50 ft E 1434996.60 ft		Hammer Wt: N.A.	140 lb.	Notes						
Station: 22+88 Offset: 11.00		Hammer Fall: N.A.	30 in.	None taken.						
Ground Elevation: 245.0 ft		Hammer/Rod Type: Auto/AWJ								
		Rig: CME 45C SKID	CE = 1.33							
Depth (ft)	Strata (f)	CLASSIFICATION OF MATERIALS (Description)		Blows/s (N Value)	Moisture Content %	Gravel %	Sand %	Fines %	LL %	PI %
		Asphalt Pavement, 0.0 ft - 0.9 ft								
5		A-2-4, SiSaGr, gry, Moist, Rec. = 0.7 ft		6-4-4-4 (8)	13.6	36.7	36.3	27.0		
10		A-7-6, Cl, brn-gry, Moist, Rec. = 1.3 ft		2-2-3-3 (5)	38.2	0.1	6.1	93.8	59	30
		A-7-6, Cl, brn-gry, Moist, Rec. = 1.2 ft, Shelby Tube sample U1			36.2				65	38
15		Cl Shelby Tube, gry, Moist, Rec. = 1.9 ft, 14.0 ft - 16.0 ft								
		A-7-6, Cl, gry, Moist, Rec. = 2.0 ft		2-2-2-3 (4)	43.8		1.2	98.8	70	42
		A-7-6, Cl, gry, Wet, Rec. = 2.0 ft, Lab Note: Very wet sample.		(WH)	59.0	2.1	1.9	96.0	68	38
20		Visual Description: Cl, gry, Moist, Rec. = 1.7 ft, Material similar to 22-24 ft.		WH-WH-2-2 (2)	56.6					
		A-7-6, Cl, gry, Moist, Rec. = 2.0 ft		(WH)	53.4		0.6	99.4	68	38
25		Visual Description: Cl, gry, Moist, Rec. = 2.0 ft, Material similar to 22-24 ft.		(WH)	59.1					
		Visual Description: Cl, gry, MTW, Rec. = 2.0 ft, Material similar to 28-30 ft.		(WH)	56.6					
		A-7-5, Cl, gry, Moist, Rec. = 2.0 ft		(WH)	68.6		0.5	99.5	72	42
30		Visual Description: Cl, gry, MTW, Rec. = 2.0 ft, Material similar to 28-30 ft.		(WH)	70.9					
35		Visual Description: Cl, gry, MTW, Rec. = 2.0 ft, Material similar to 28-30 ft.		WR-WR-WH-WH (WH)	72.3					
40		Hole stopped @ 40.0 ft								
45		Remarks: Hole collapsed at 26.0 ft.								
Notes: 1. Stratification lines represent approximate boundary between material types. Transition may be gradual. 2. N Values have not been corrected for hammer energy. CE is the hammer energy correction factor. 3. Water level readings have been made at times and under conditions stated. Fluctuations of groundwater may occur due to other factors than those present at the time measurements were made.										


BOTTOM OF CULVERT  
APPROX. EL. 232.2

PROJECT NAME: BRIDPORT  
PROJECT NUMBER: STP CULV(29)


FILE NAME: zllc264bor_log_br5.dgn  
PROJECT LEADER: M. CHENETTE  
DESIGNED BY: VTRANS  
BORING LOG I - BR5

PLOT DATE: 8/22/2014  
DRAWN BY: L. BUXTON  
CHECKED BY: VTRANS  
SHEET 47 OF 57



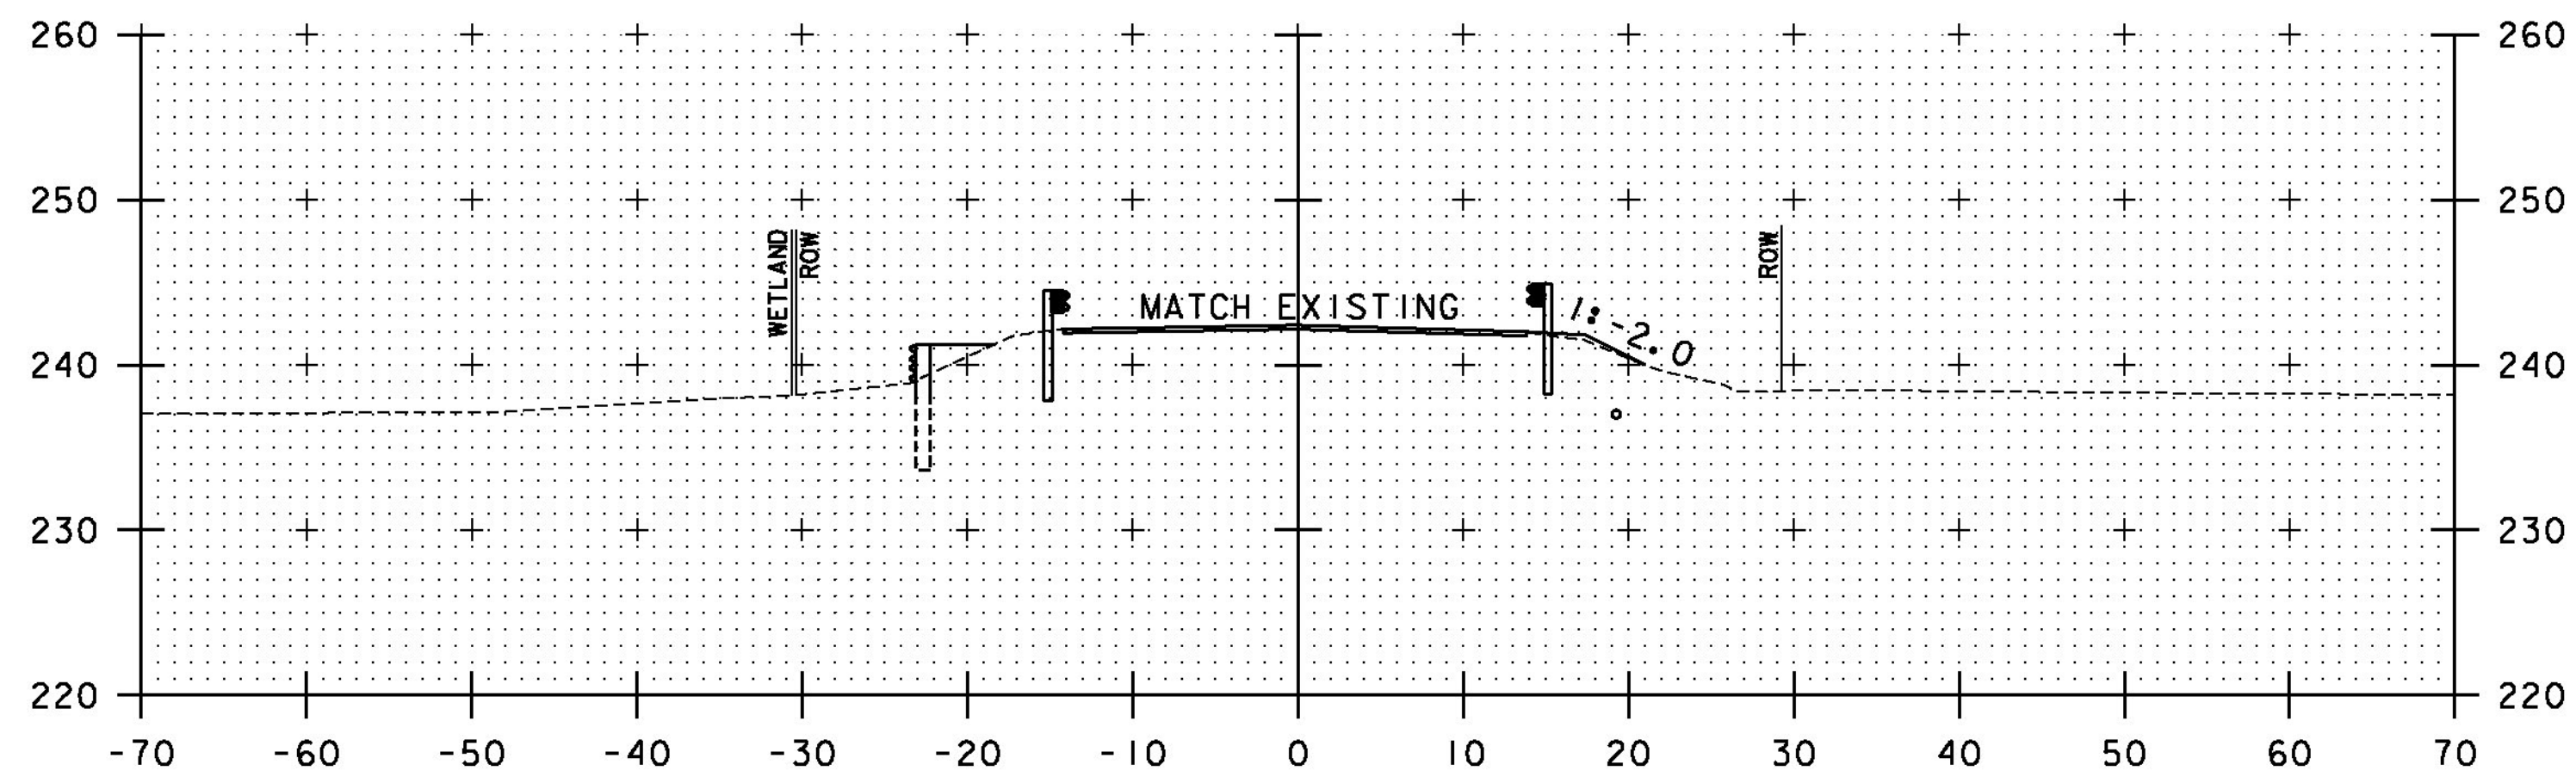


21+75

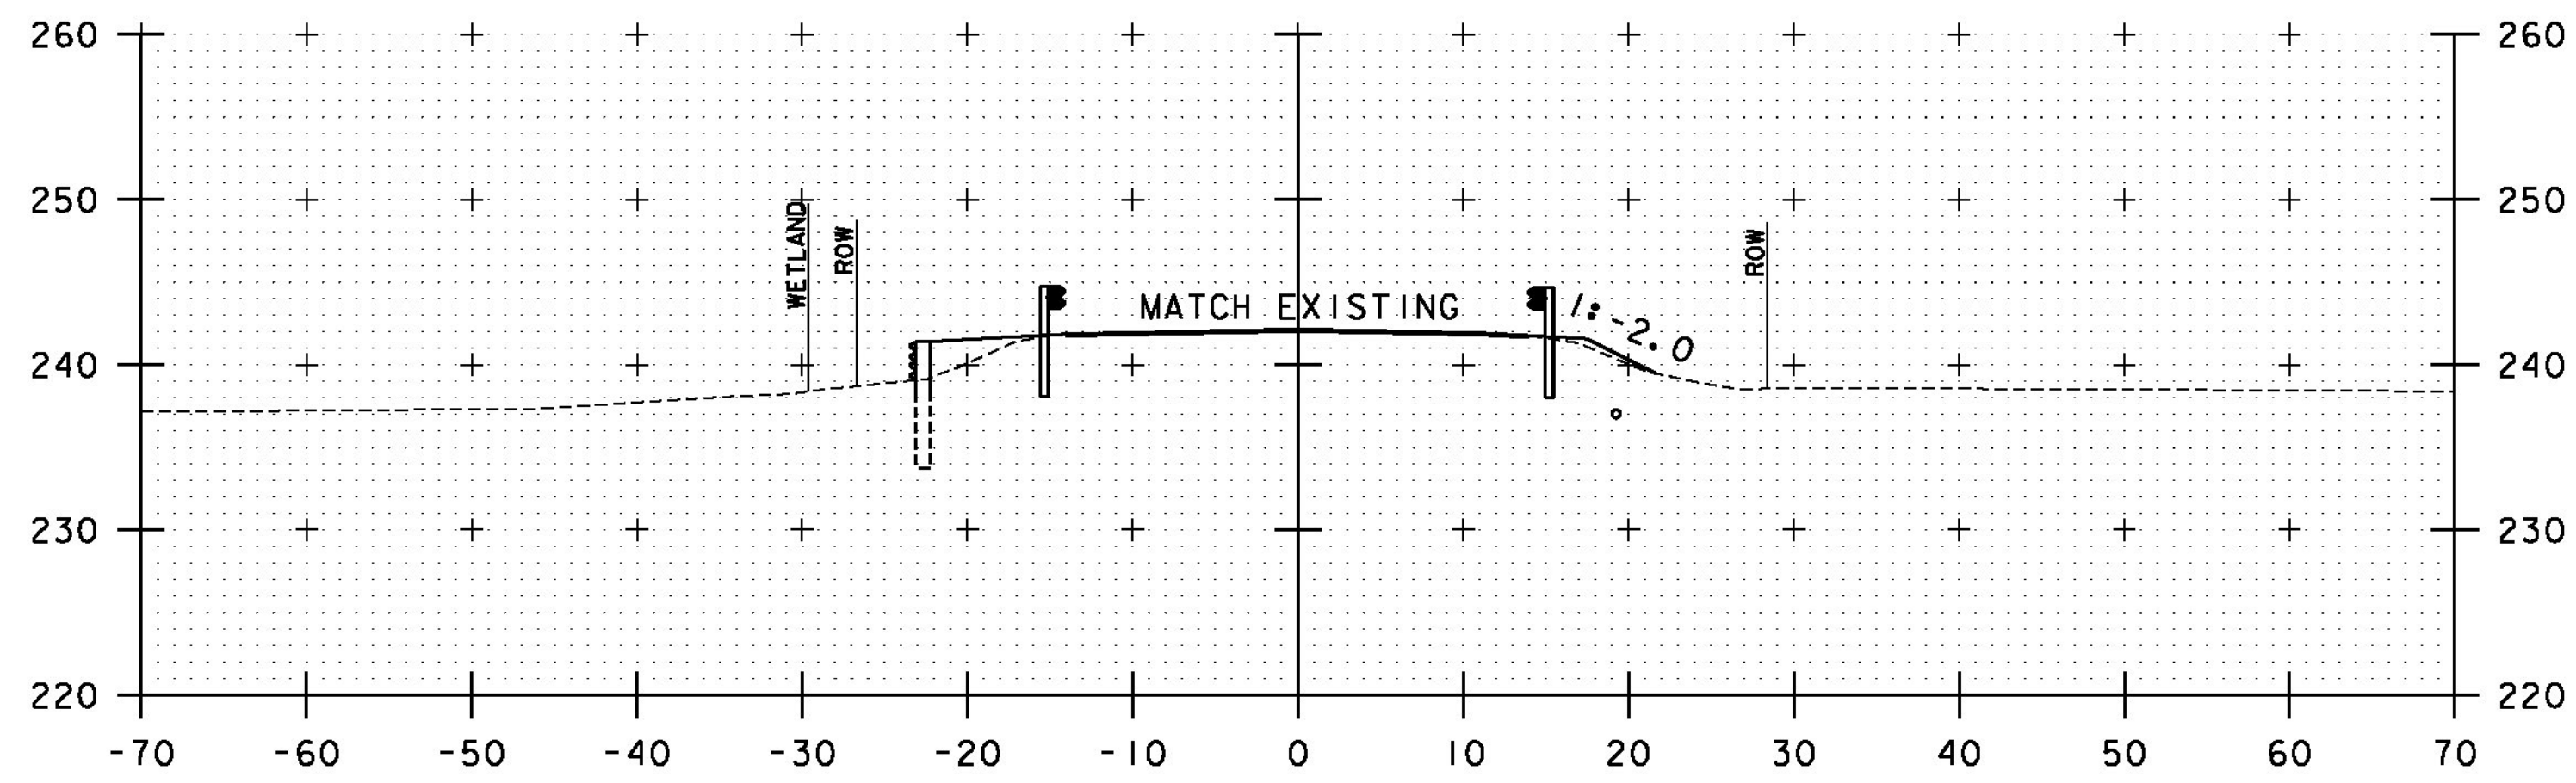


21+40  
BEGIN APPROACH

21+50

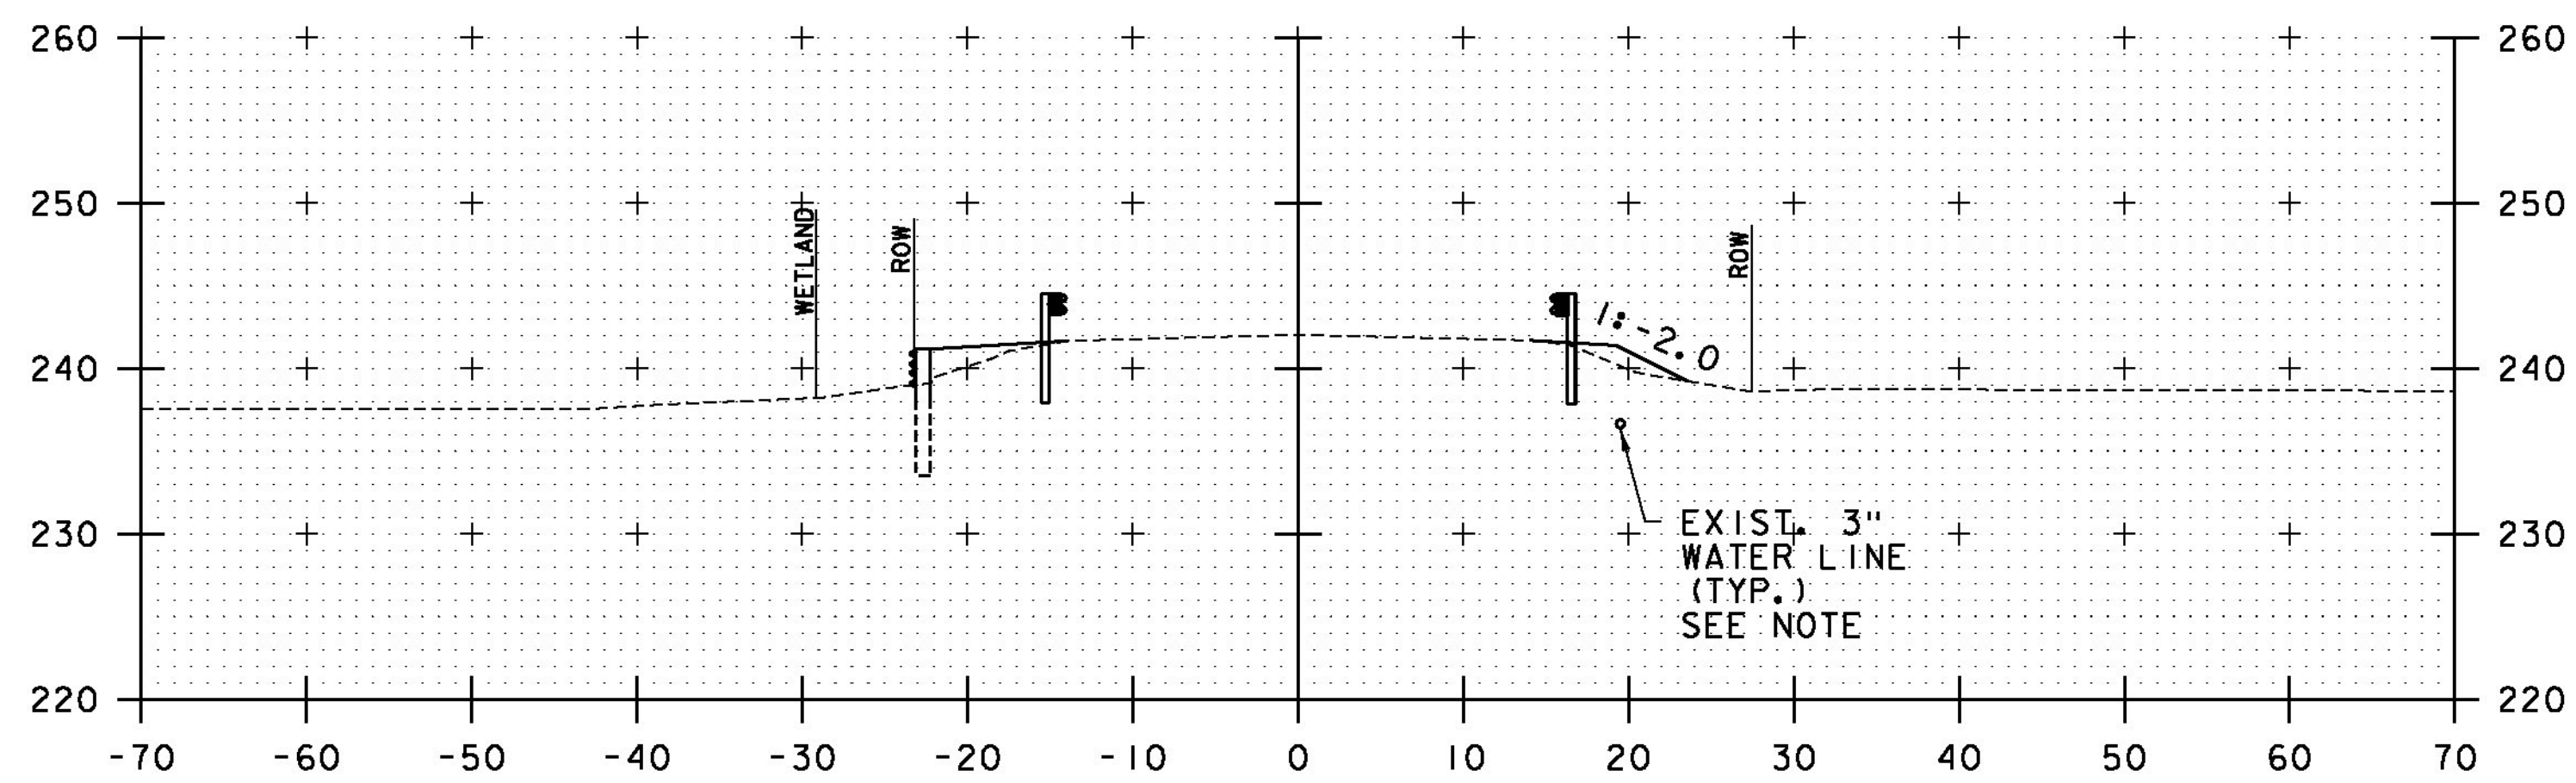


21+25

NOTE:  
EXISTING 3" WATERLINE  
LOCATION IS APPROXIMATE.  
TO BE VERIFIED IN THE  
FIELD AND POST LOCATIONS  
MODIFIED, IF NEEDED.

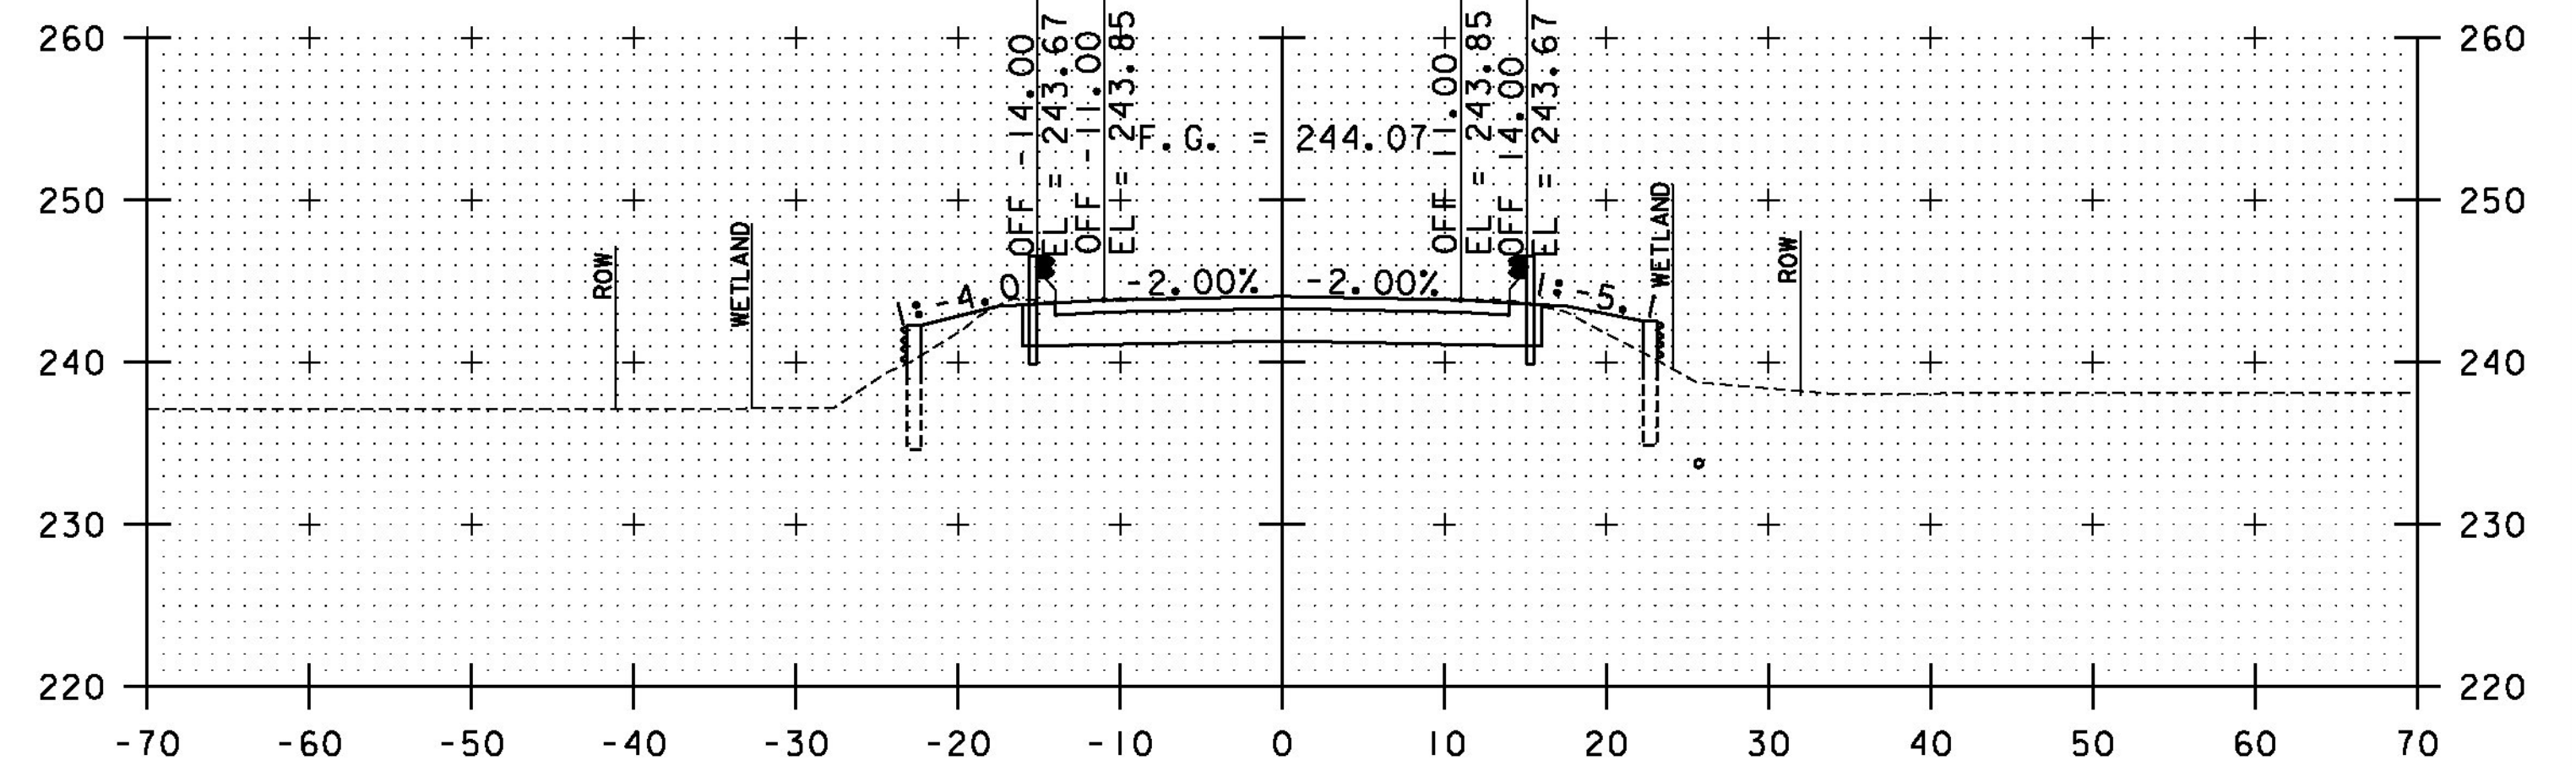


22+40  
RESUME PROJECT

22+50

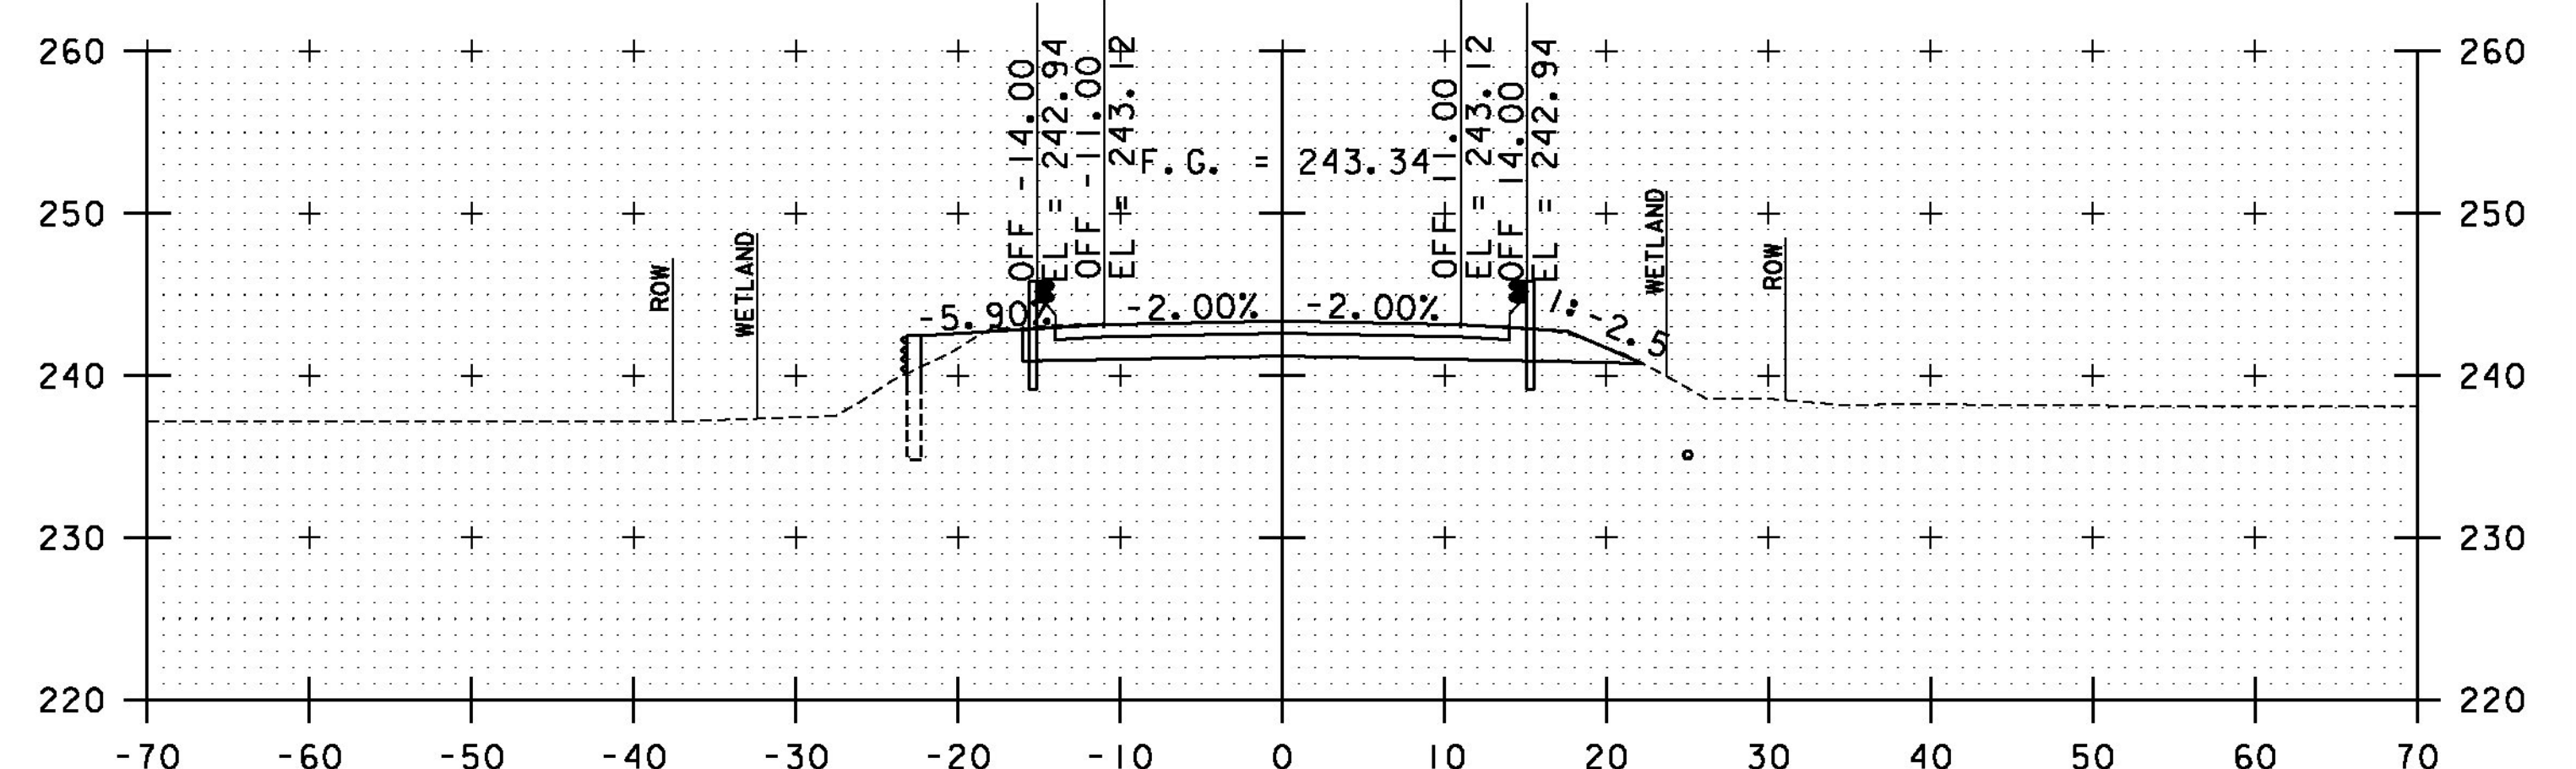


22+25

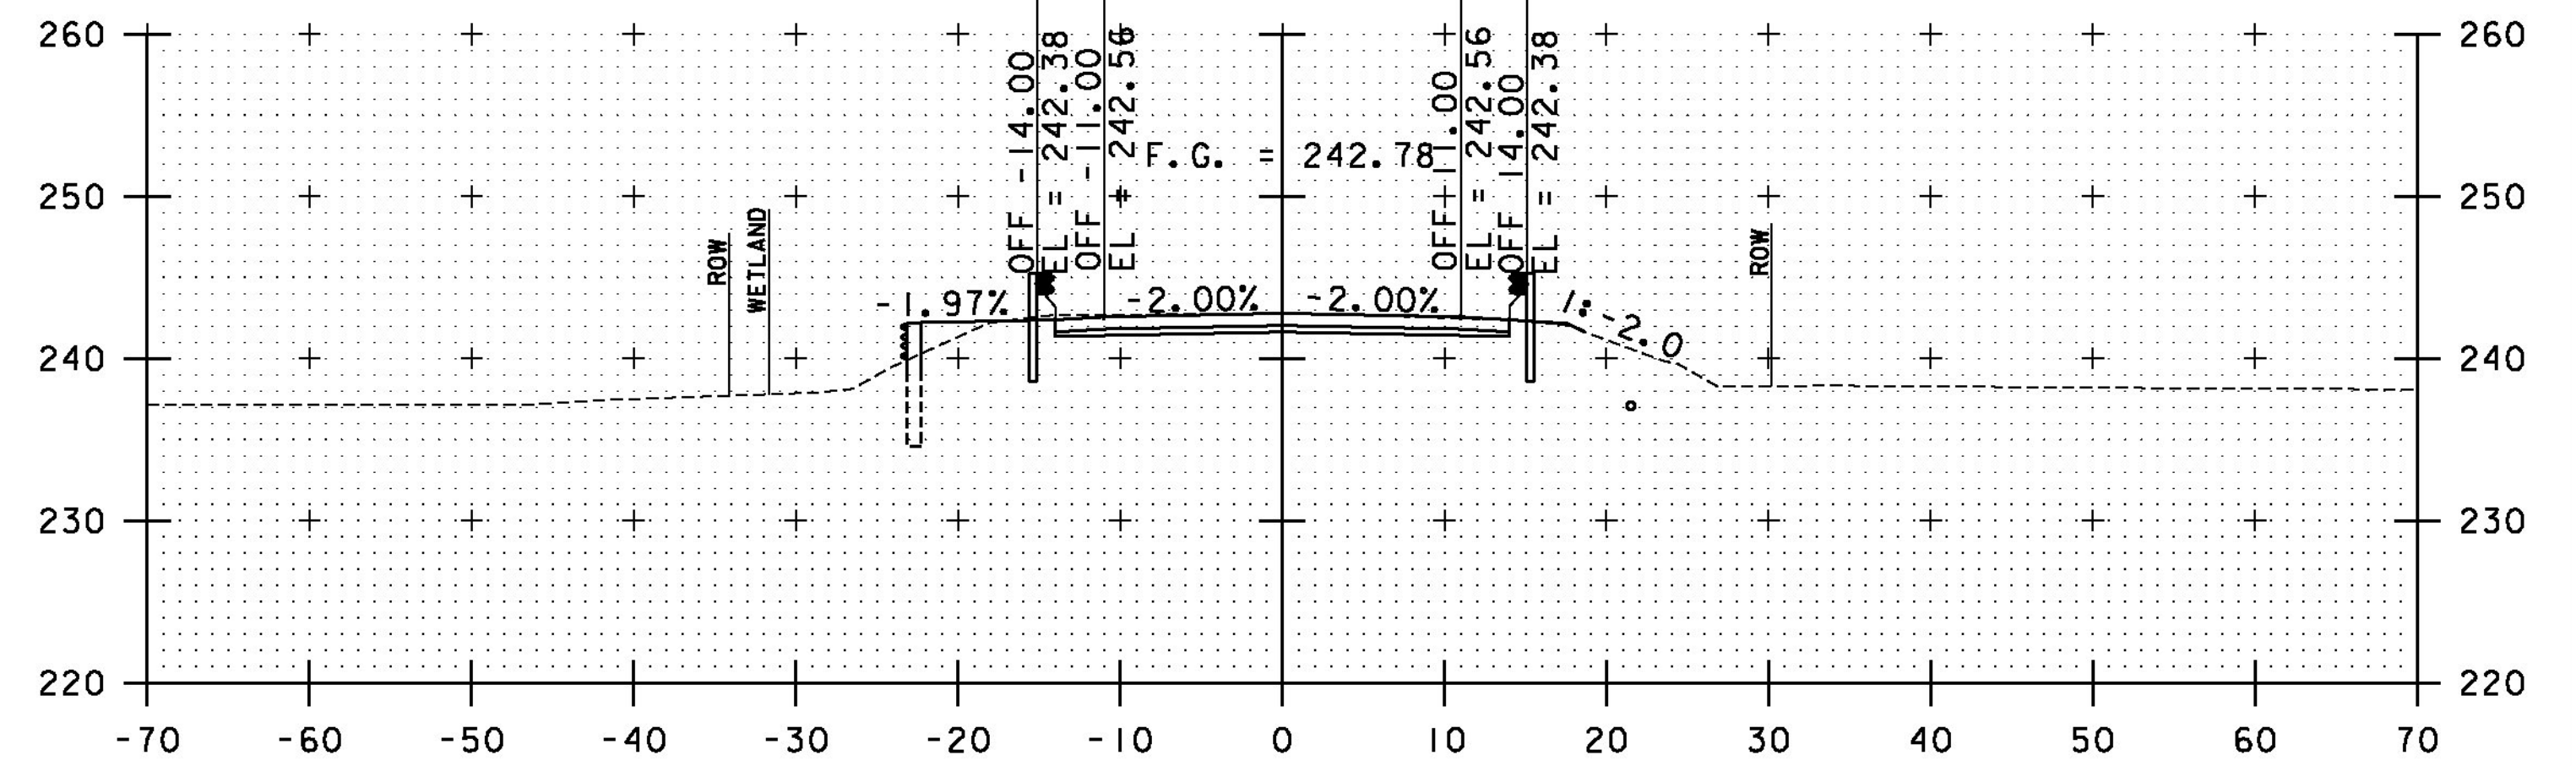

22+00


STA. 21+25 TO STA. 22+50

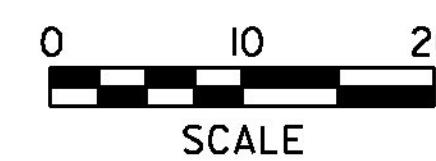

PROJECT NAME: BRIDPORT  
PROJECT NUMBER: STP CULV(29)


FILE NAME: zllc264xs_br5.dgn  
PROJECT LEADER: M. CHENETTE  
DESIGNED BY: J. HUNGERFORD  
ROADWAY CROSS SECTIONS - RXSI - BR5

PLOT DATE: 8/22/2014  
DRAWN BY: L. BUXTON  
CHECKED BY: M. CHENETTE  
SHEET 48 OF 57

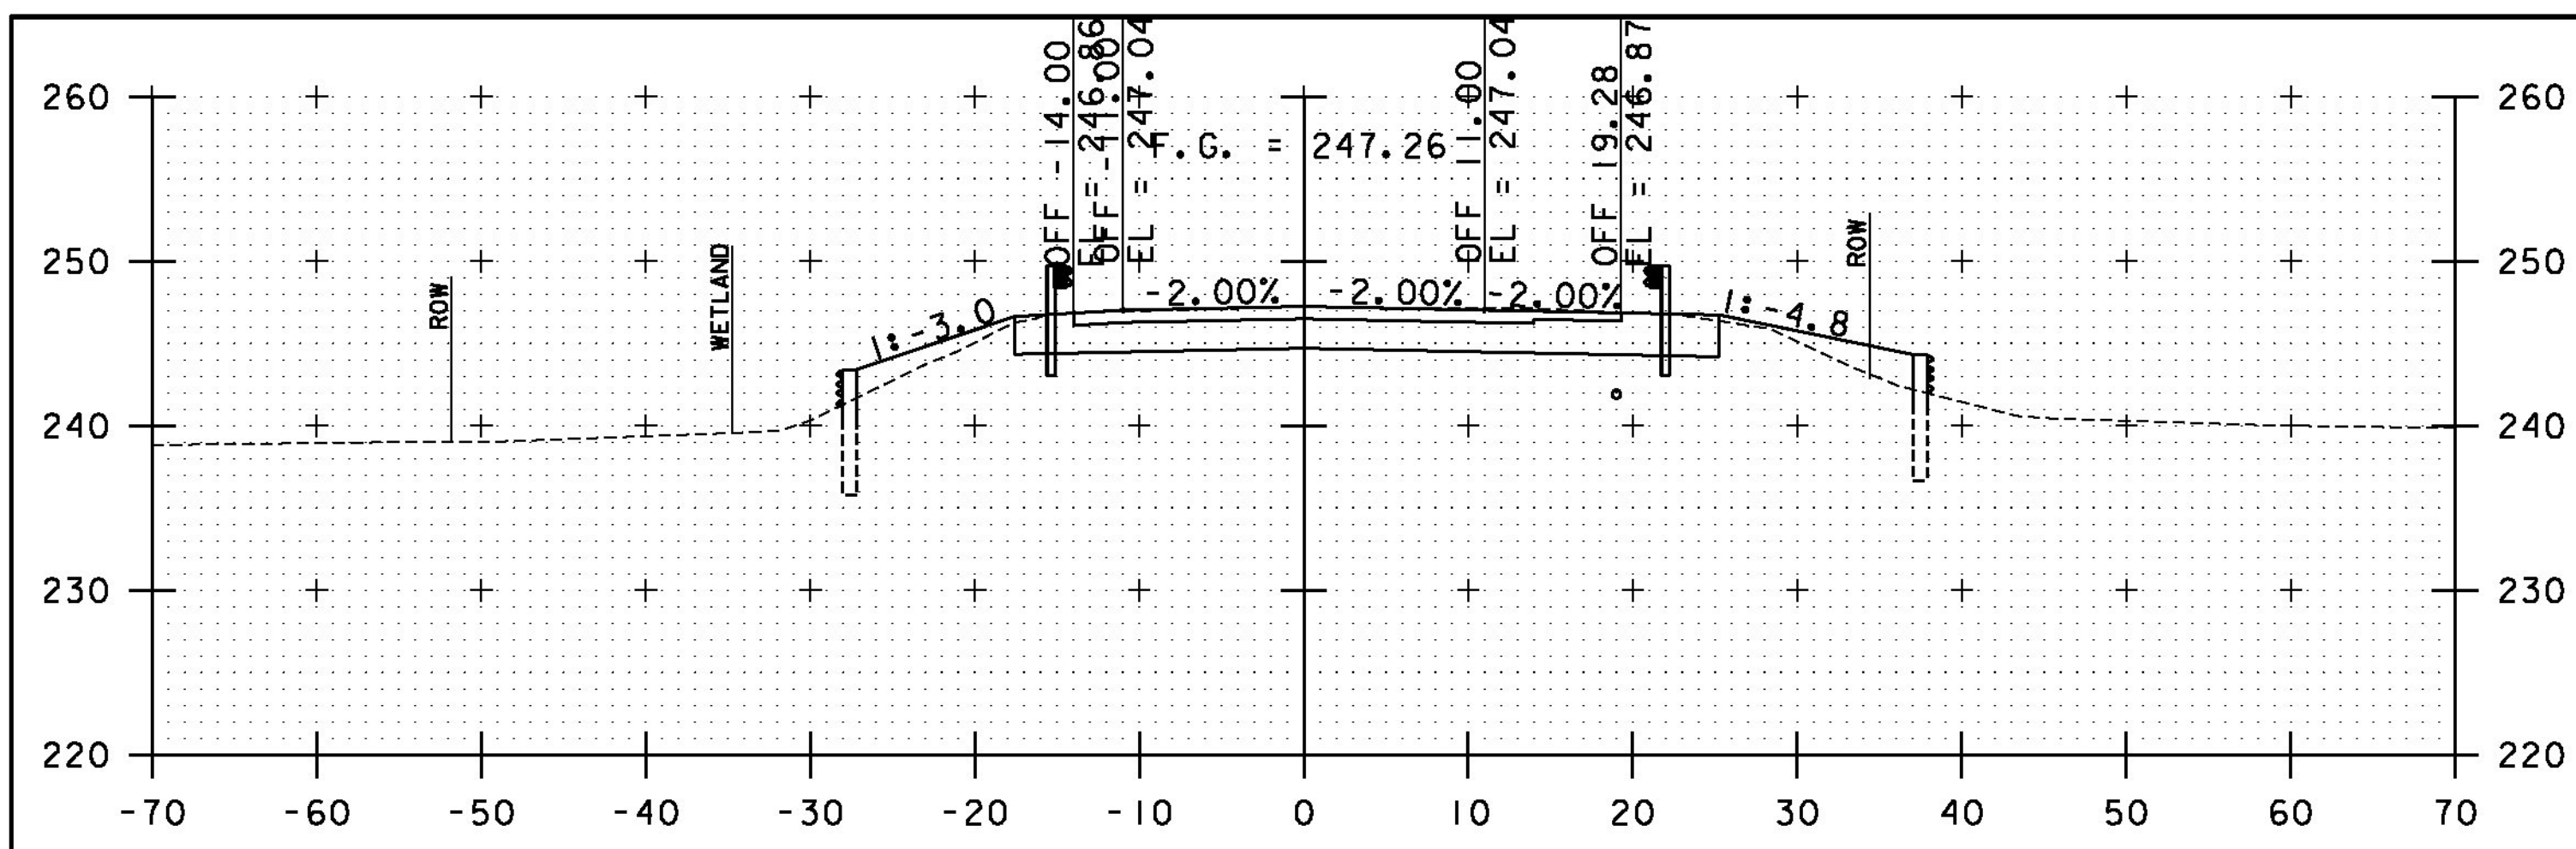


23+20  
END PROJECT

23+25

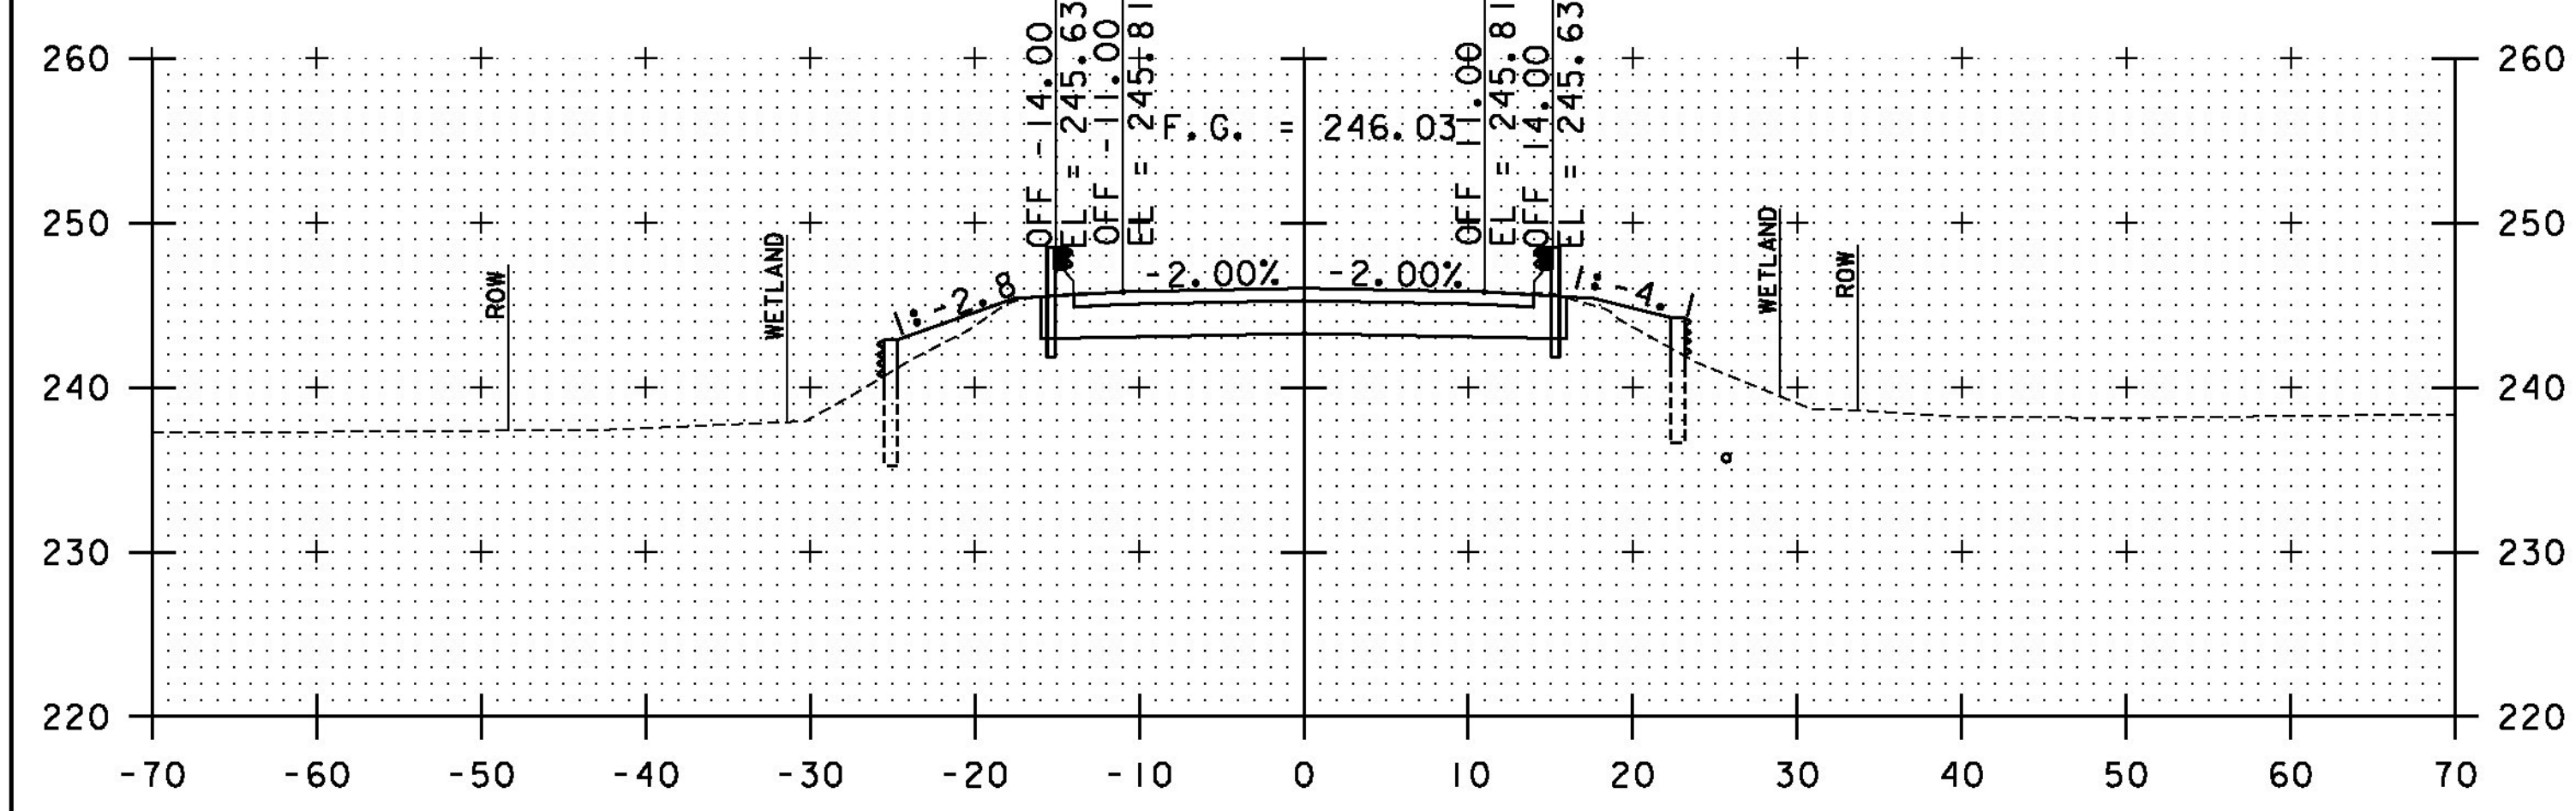

22+85.02  
END BRIDGE


23+00

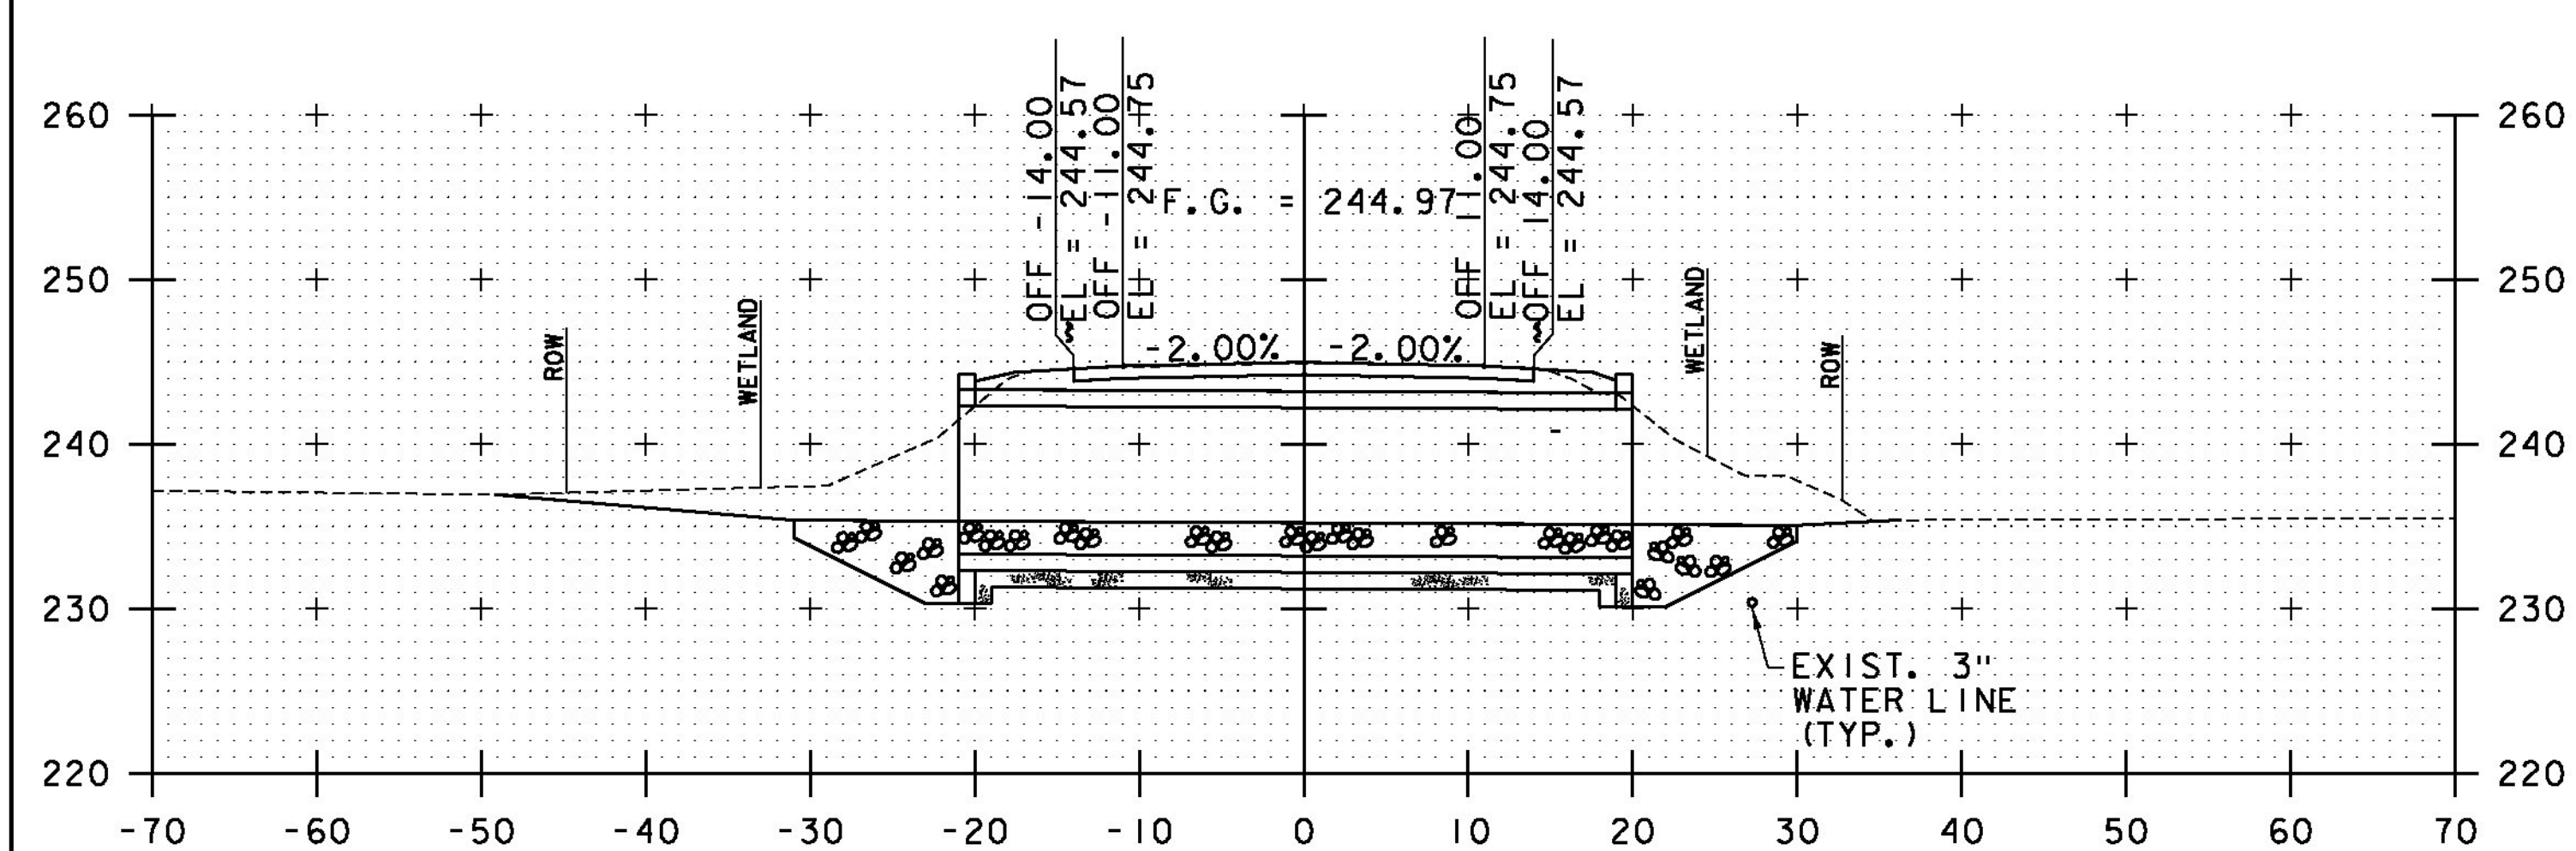


22+71.02  
BEGIN BRIDGE

22+75


24+20  
END APPROACH

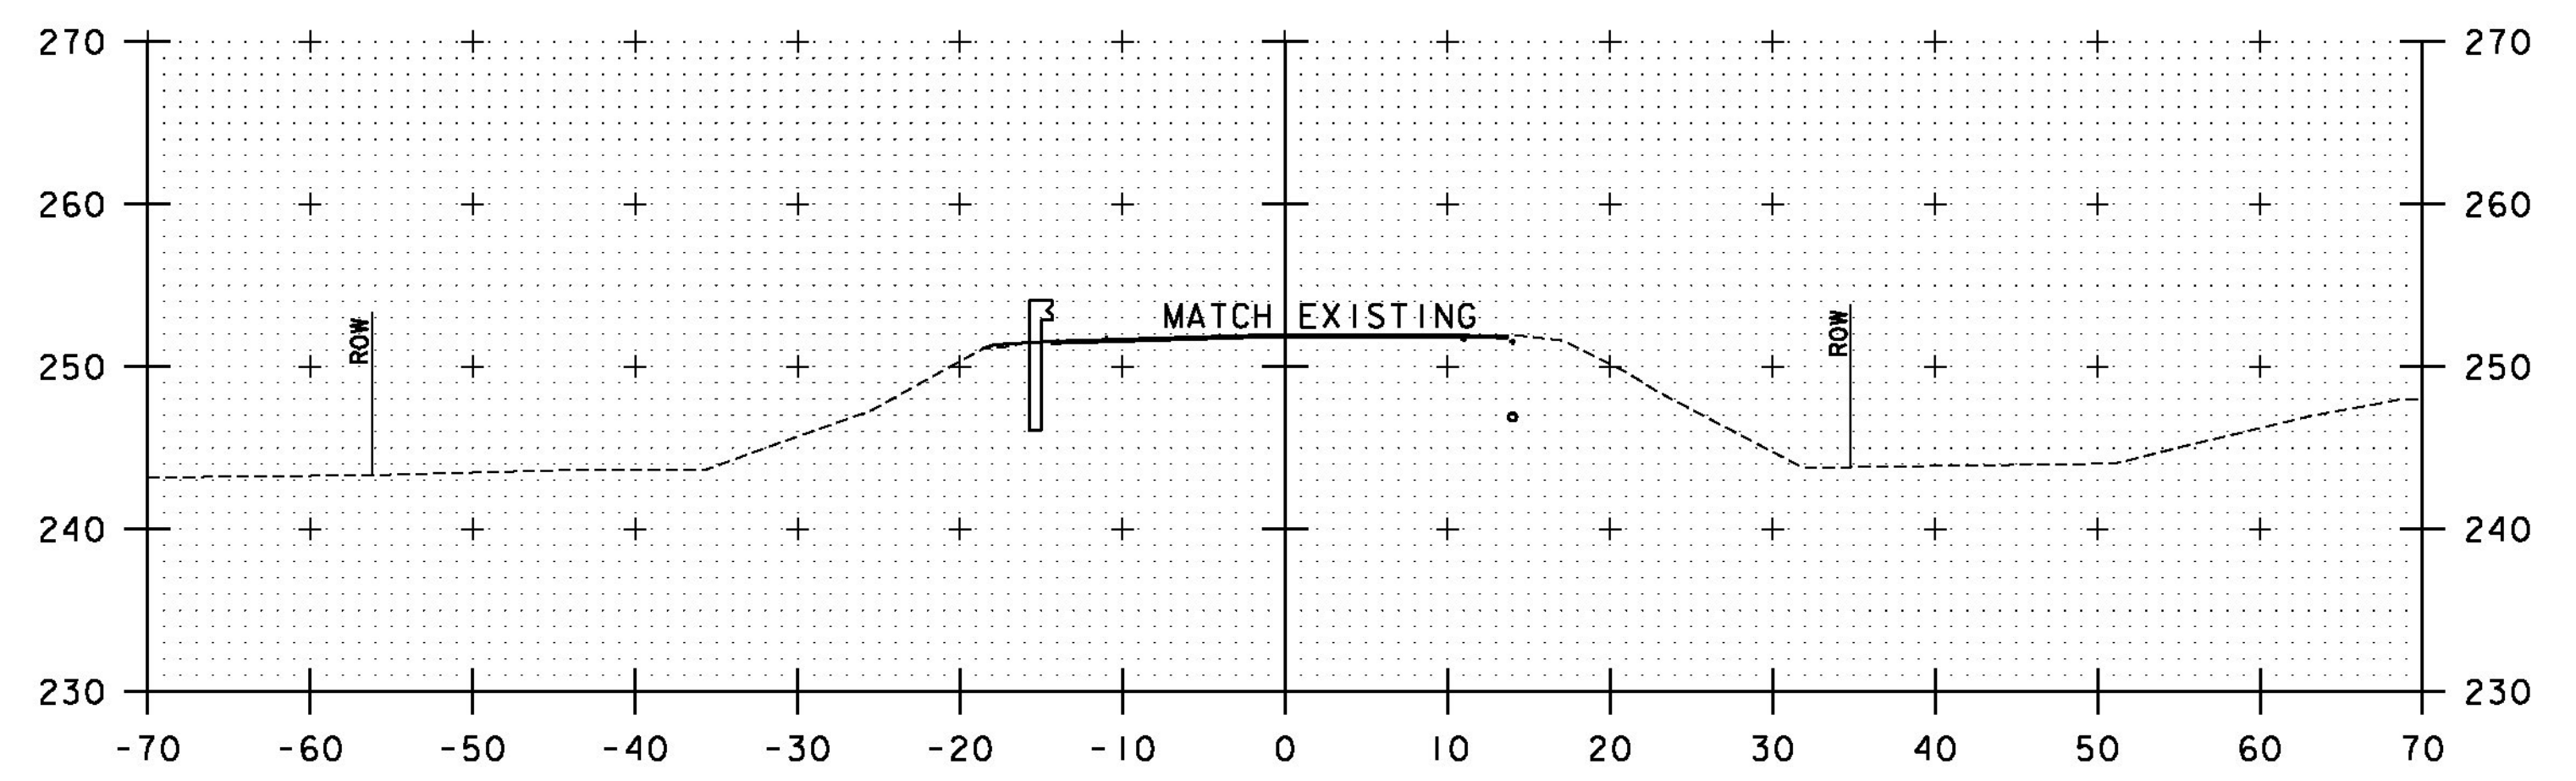

24+00

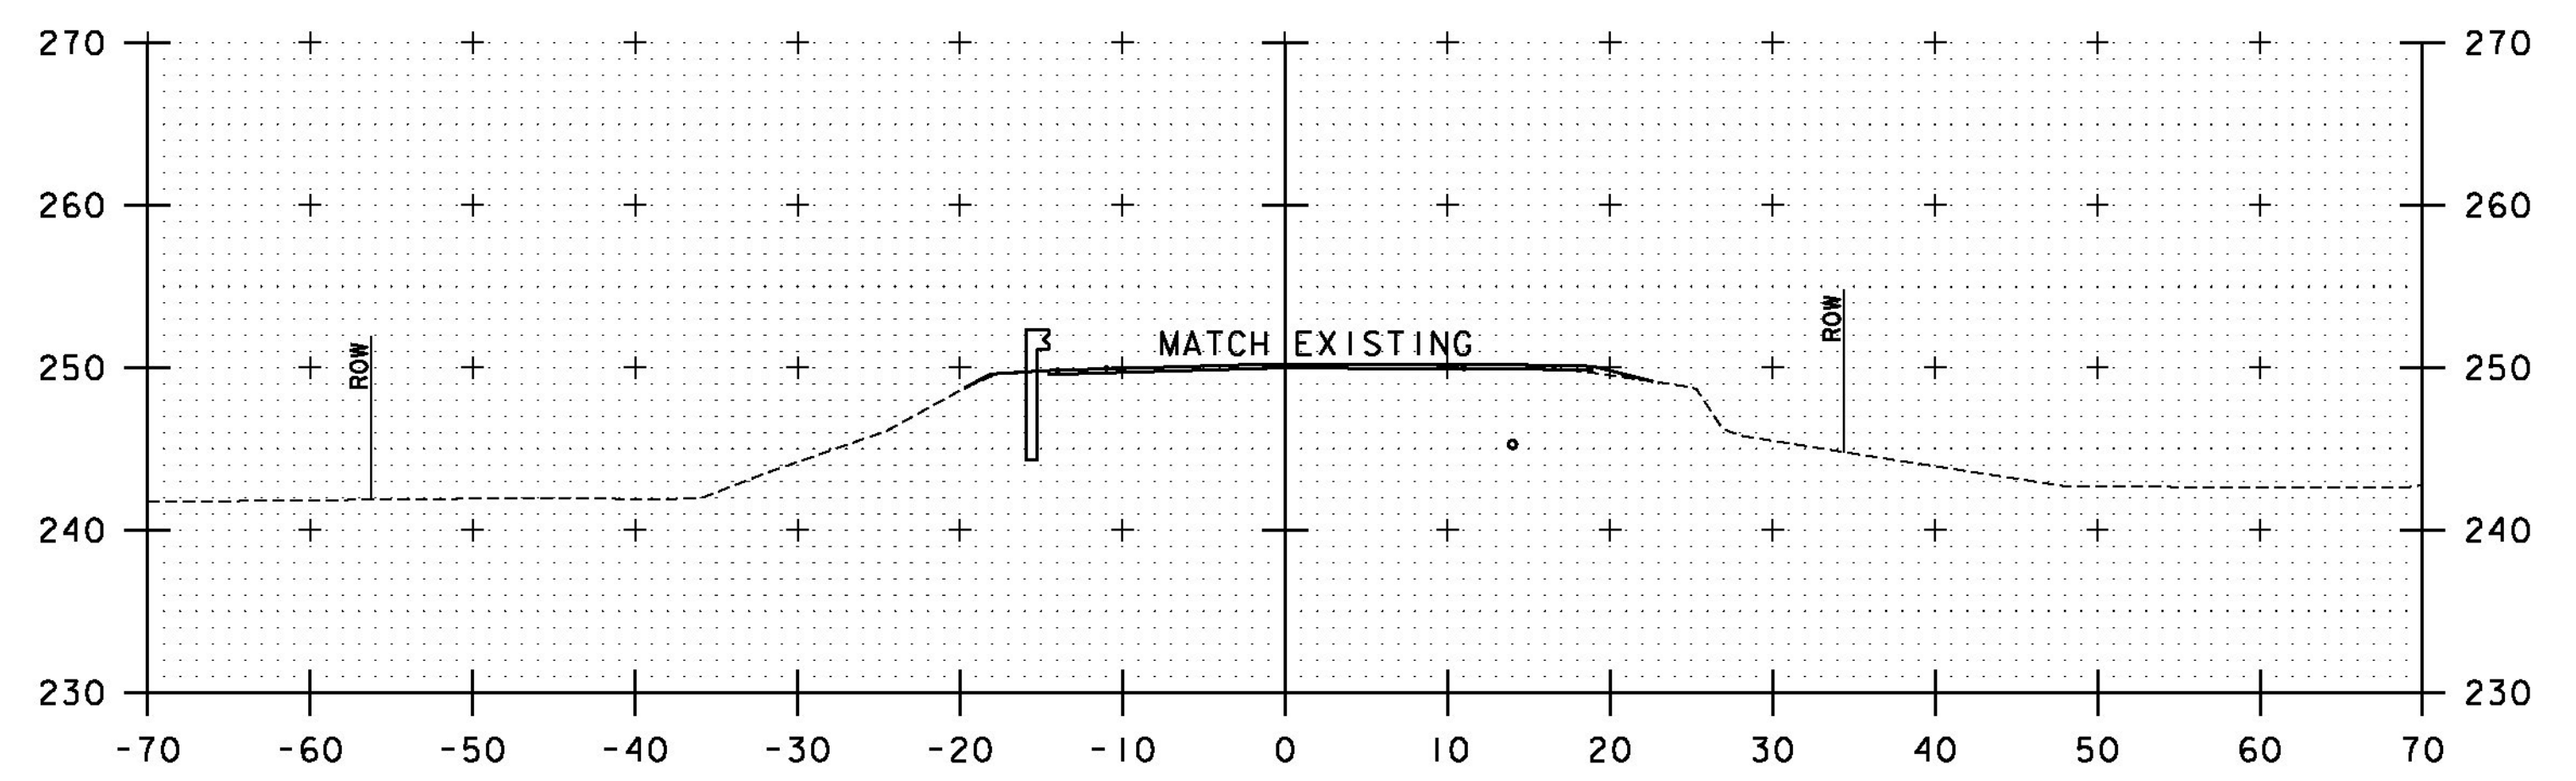


23+75






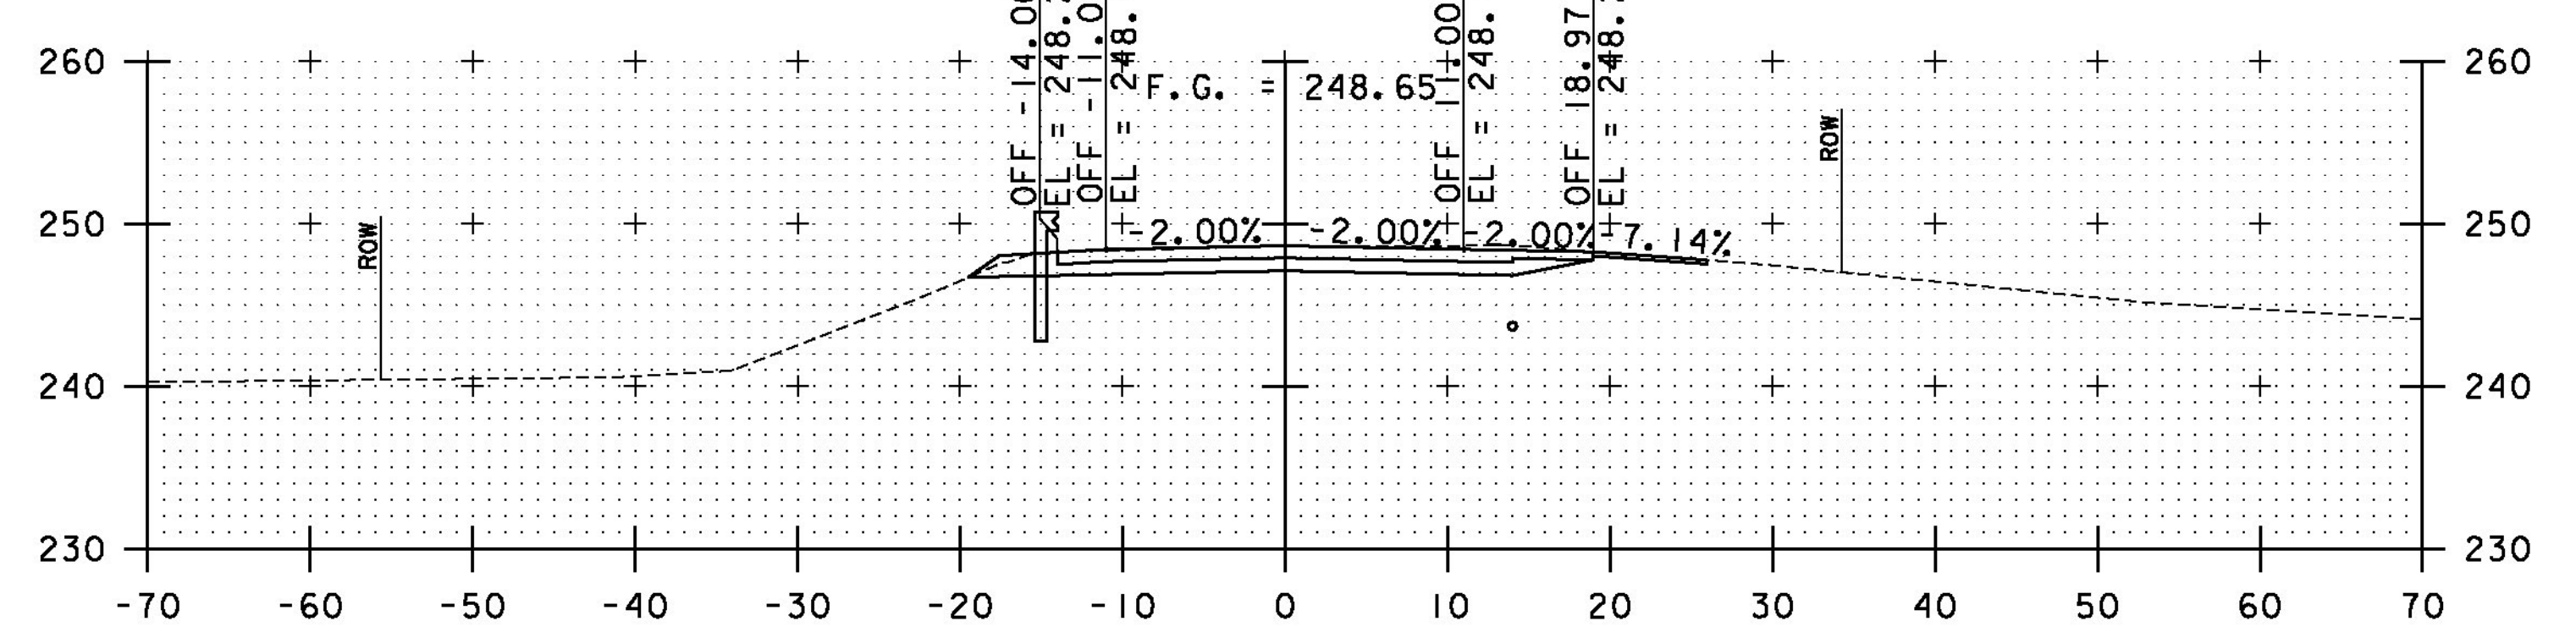


STA. 22+75 TO STA. 24+00

23+50

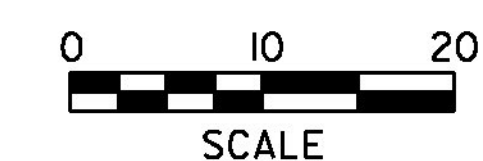





PROJECT NAME:	BRIDPORT	FILE NAME:	zlic264xs_br5.dgn	PLOT DATE:	8/22/2014
PROJECT NUMBER:	STP CULV(29)	PROJECT LEADER:	M. CHENETTE	DRAWN BY:	L. BUXTON
		DESIGNED BY:	J. HUNGERFORD	CHECKED BY:	M. CHENETTE
		ROADWAY CROSS SECTIONS -	RXS2 - BR5	SHEET	49 OF 57

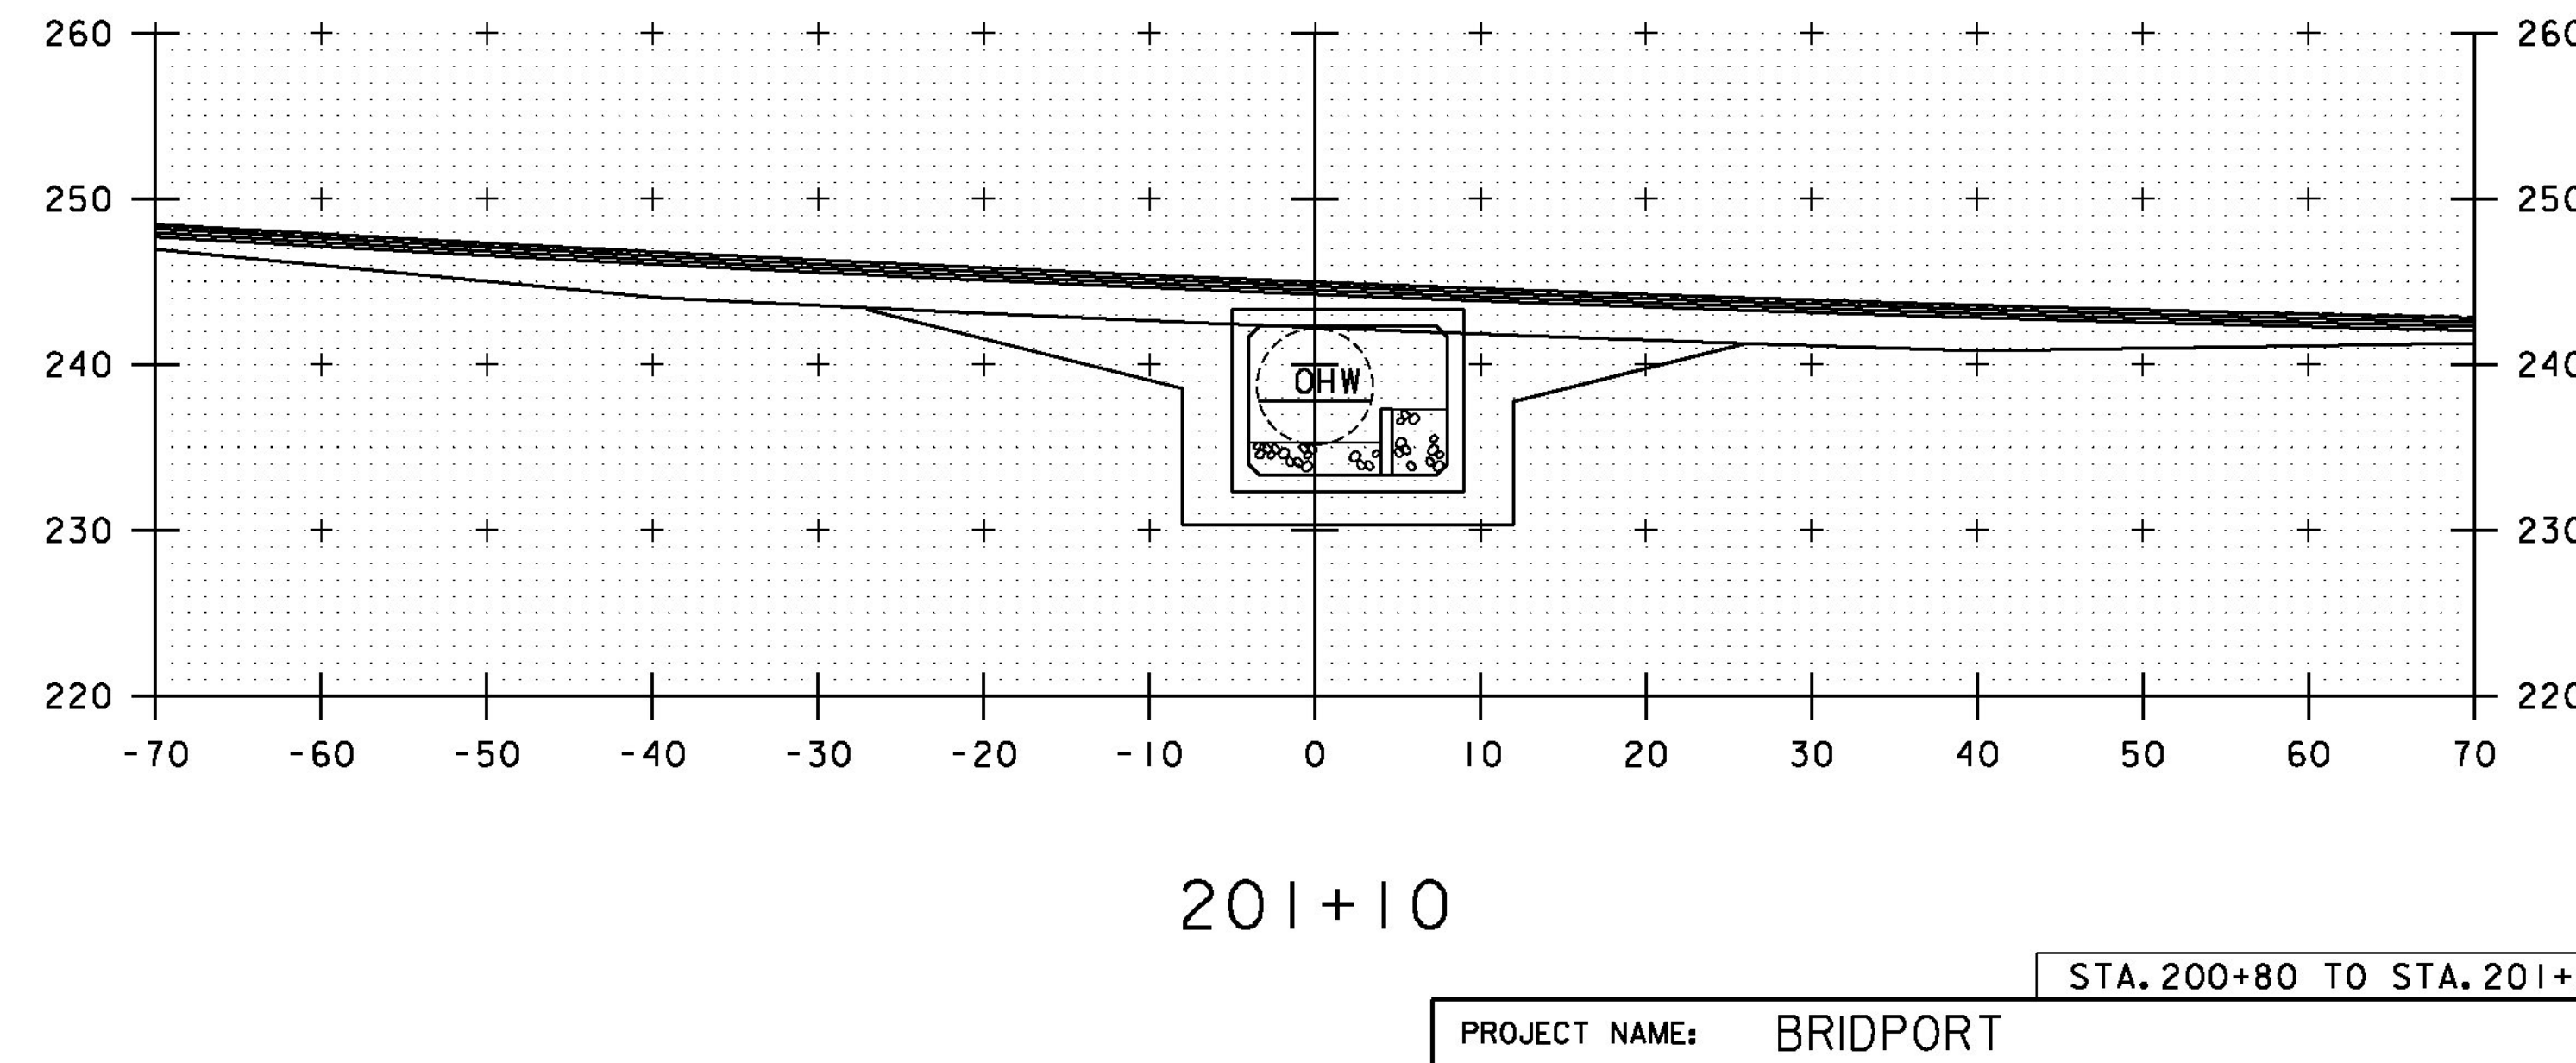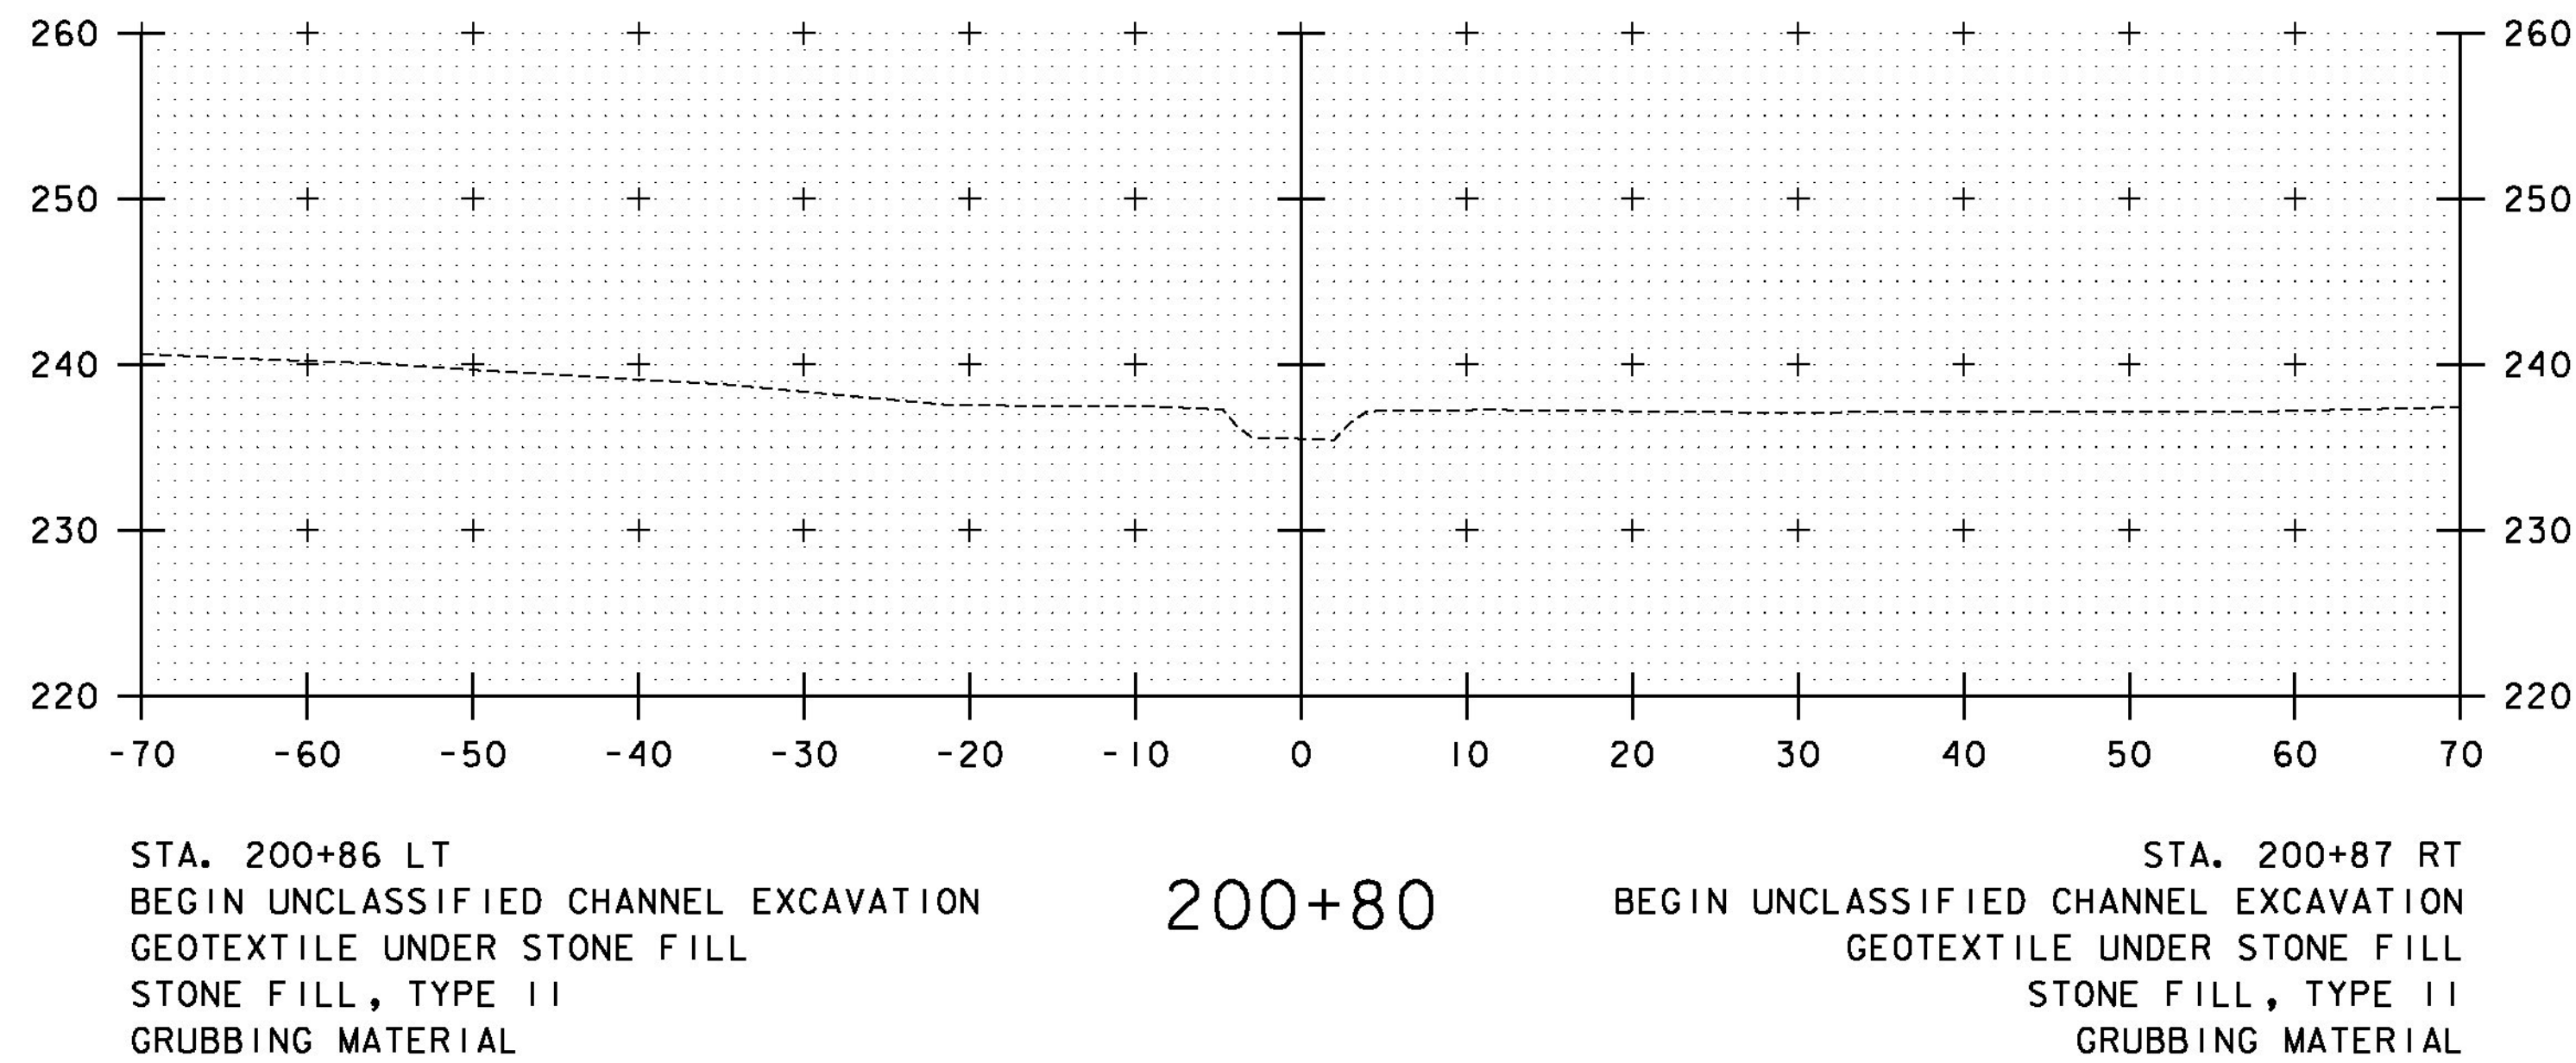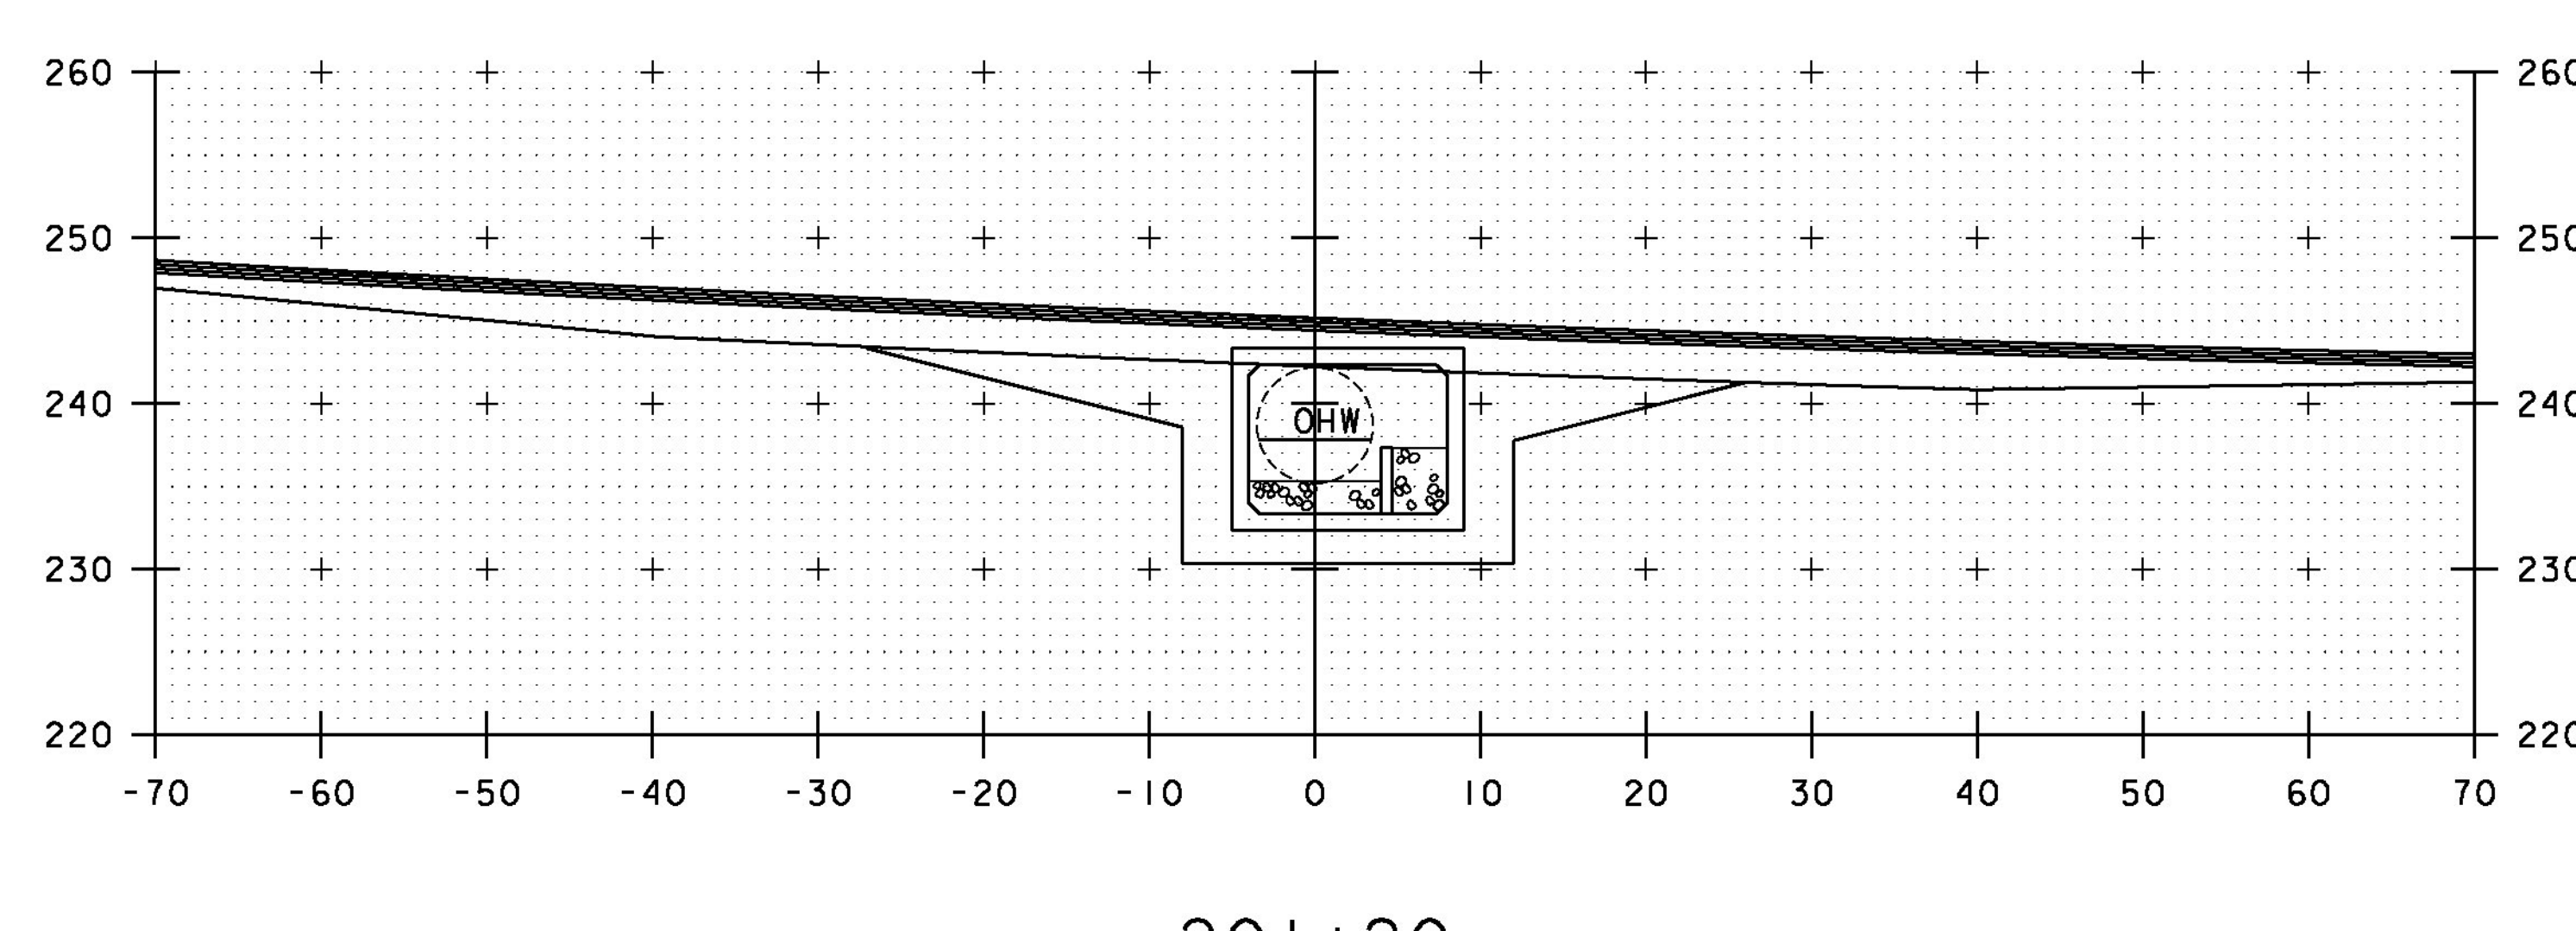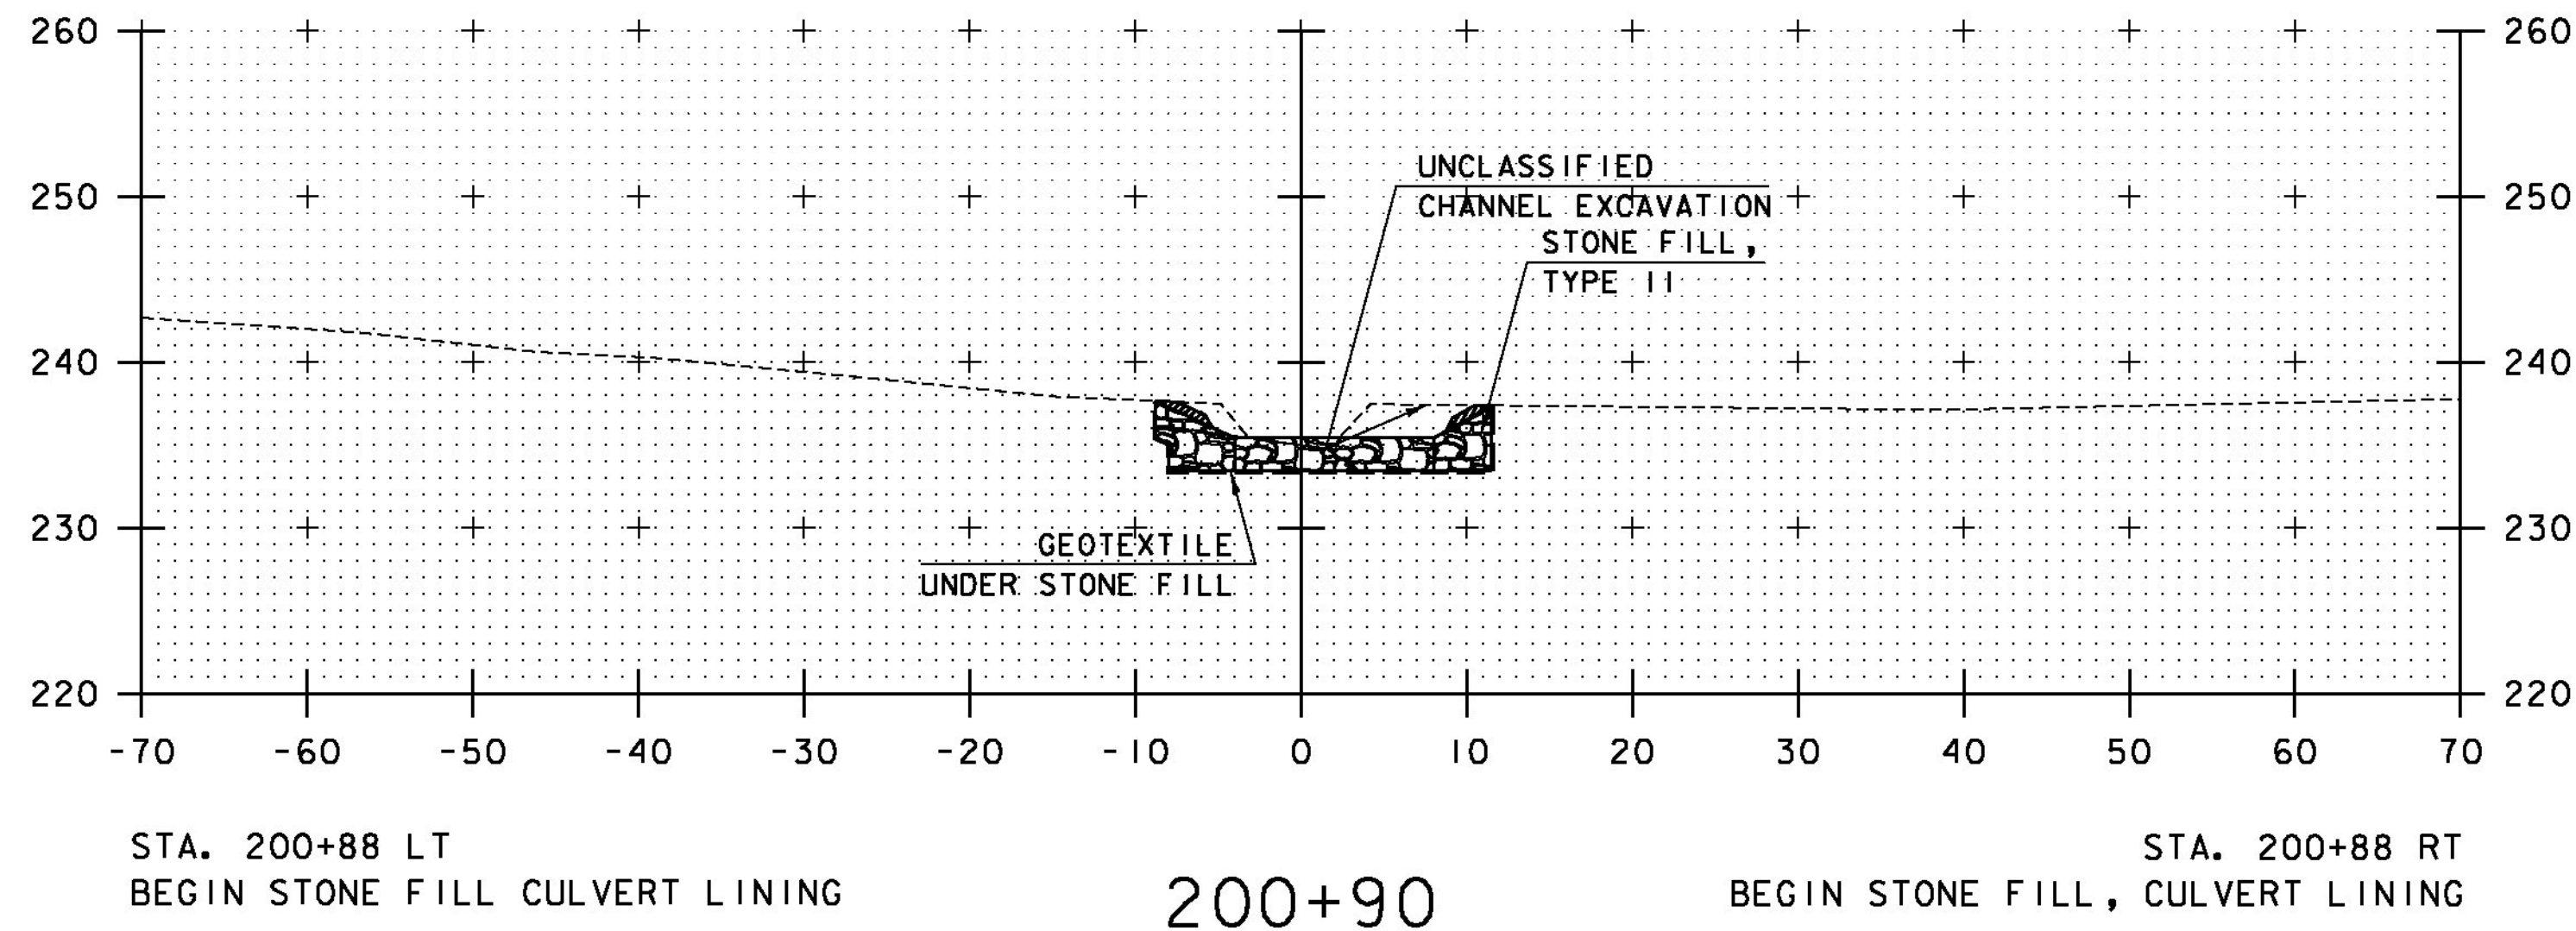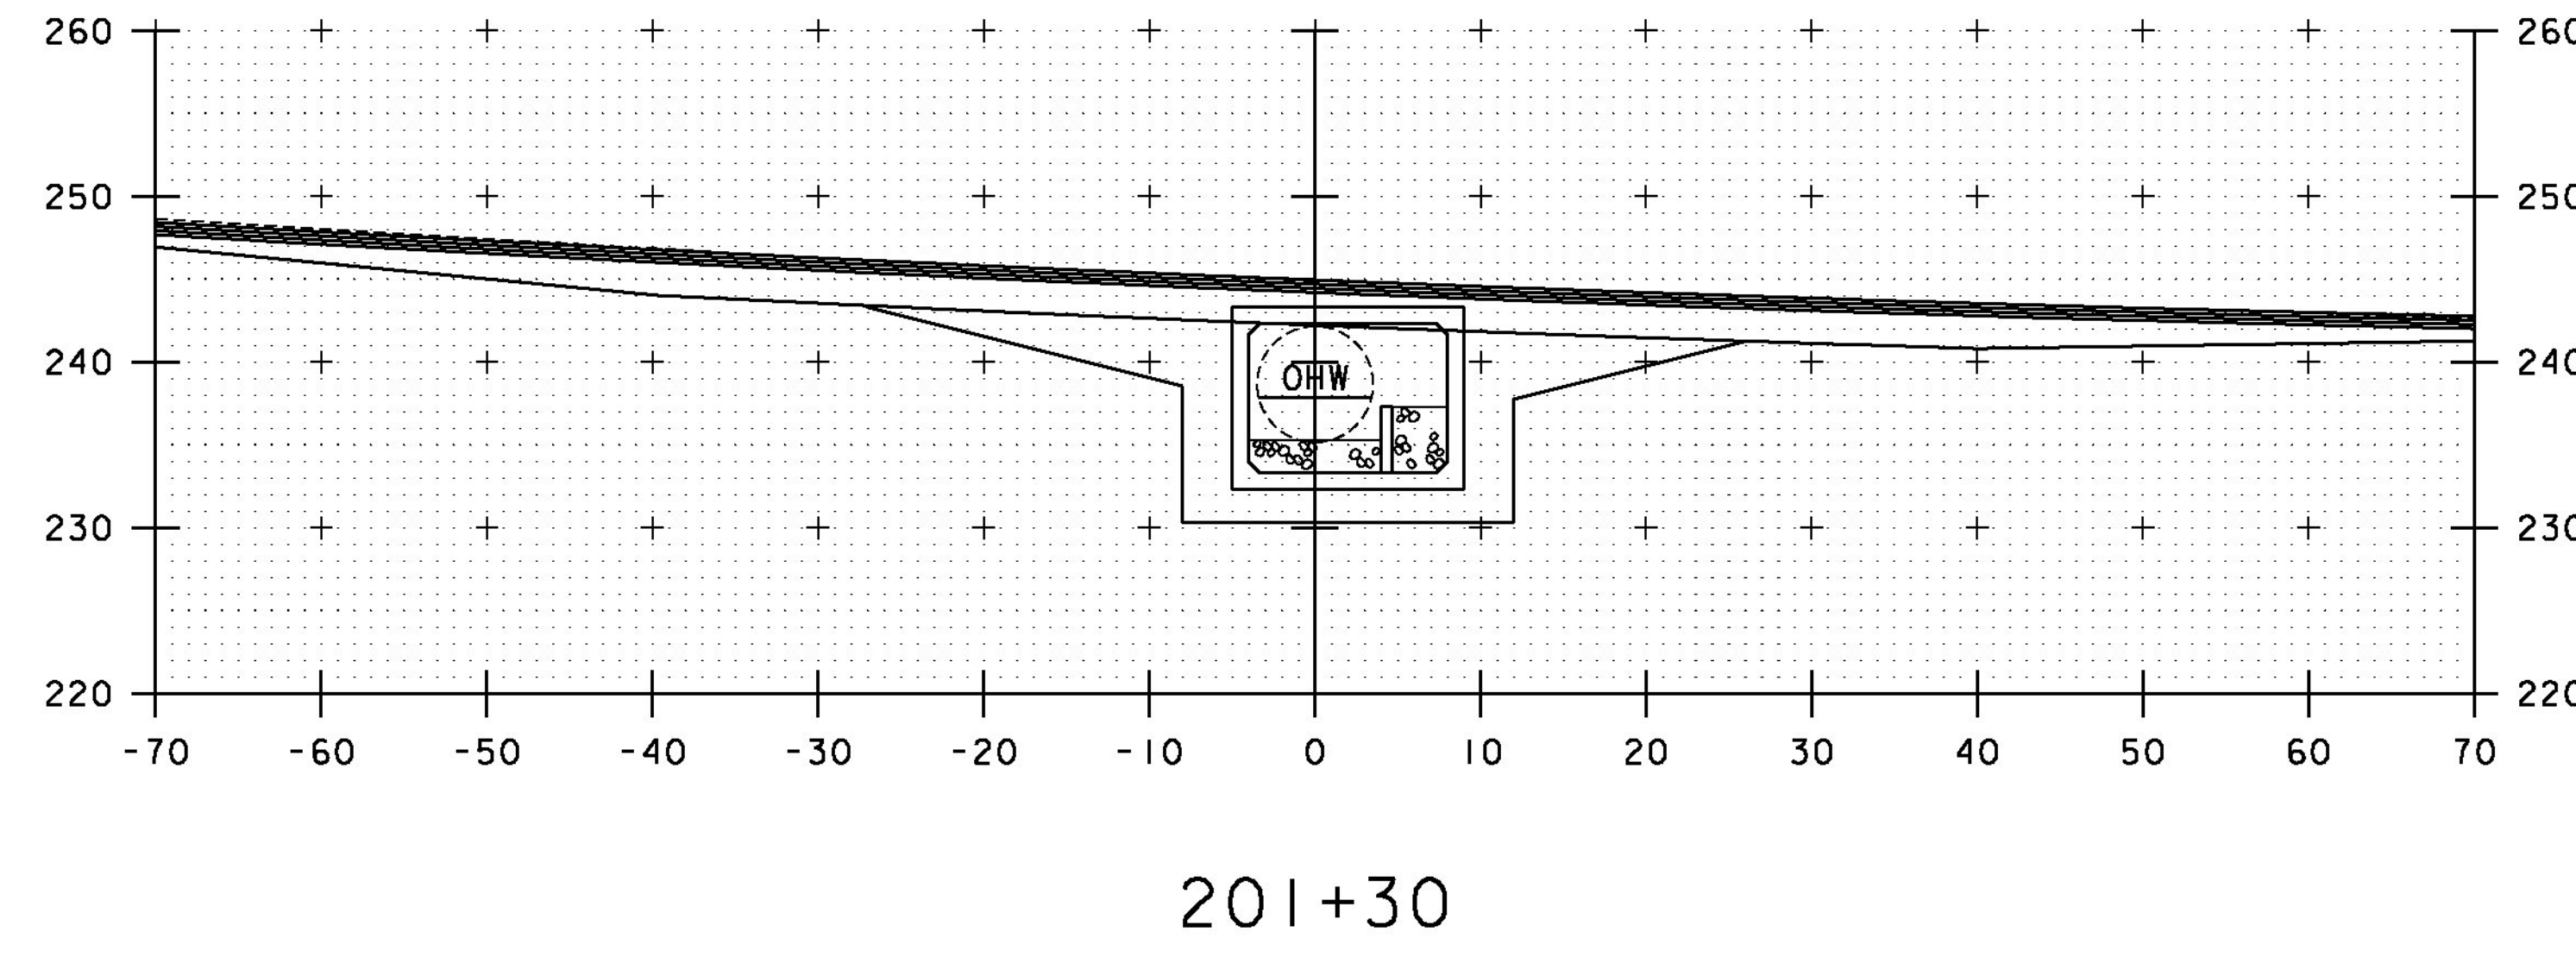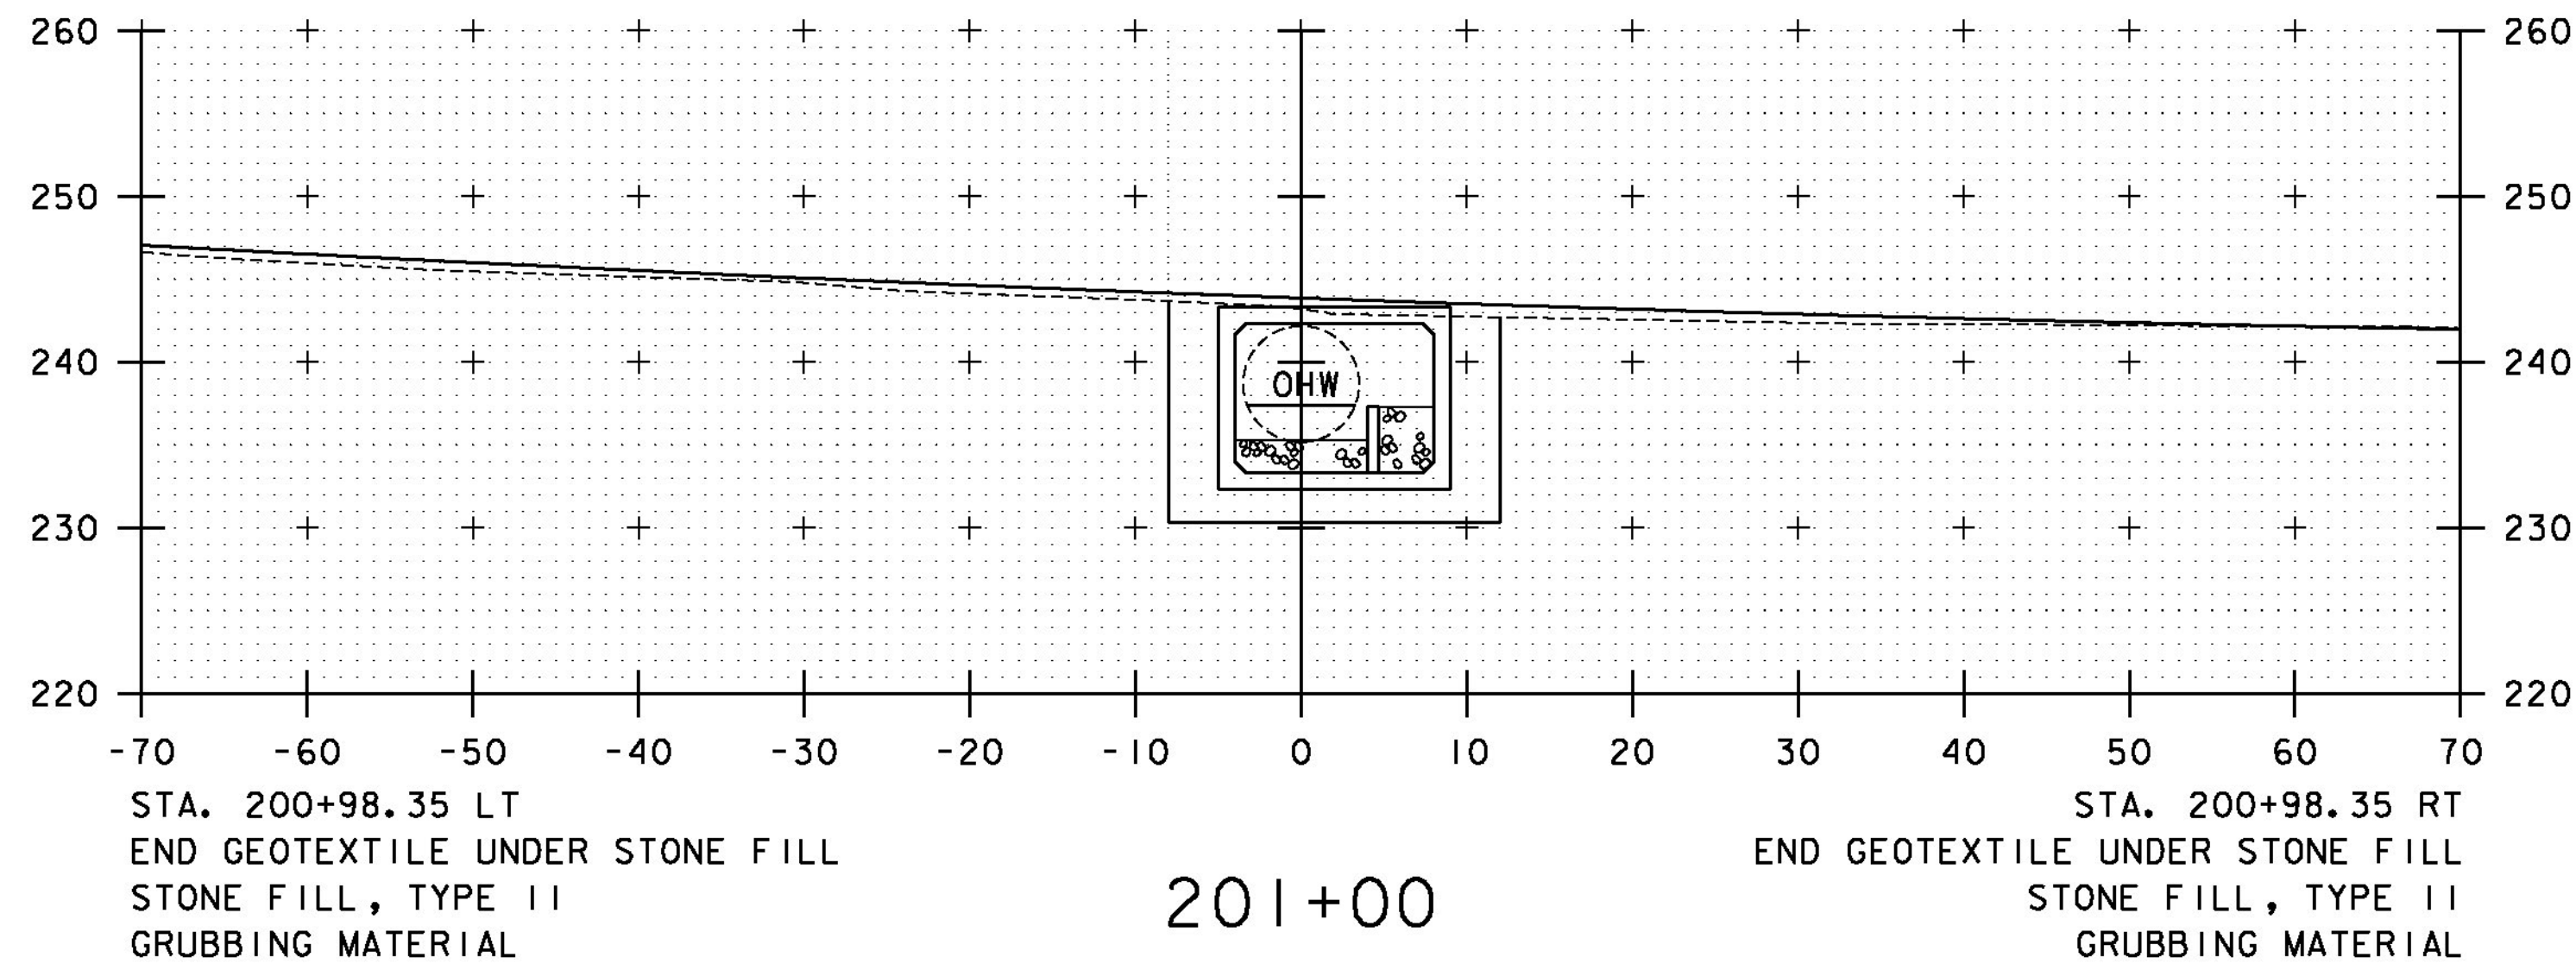

STA. 200+80 TO STA. 201+30

PROJECT NAME:	BRIDPORT	FILE NAME:	z1lc264xs_br5.dgn	PLOT DATE:	8/22/2014
PROJECT NUMBER:	STP CULV(29)	PROJECT LEADER:	M. CHENETTE	DRAWN BY:	L. BUXTON
		DESIGNED BY:	J. HUNGERFORD	CHECKED BY:	M. CHENETTE
		CHANNEL CROSS SECTIONS - CXSI - BR5		SHEET	50 OF 57

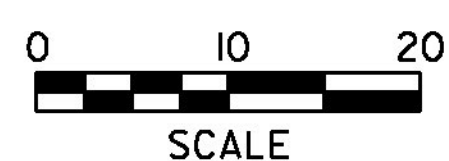

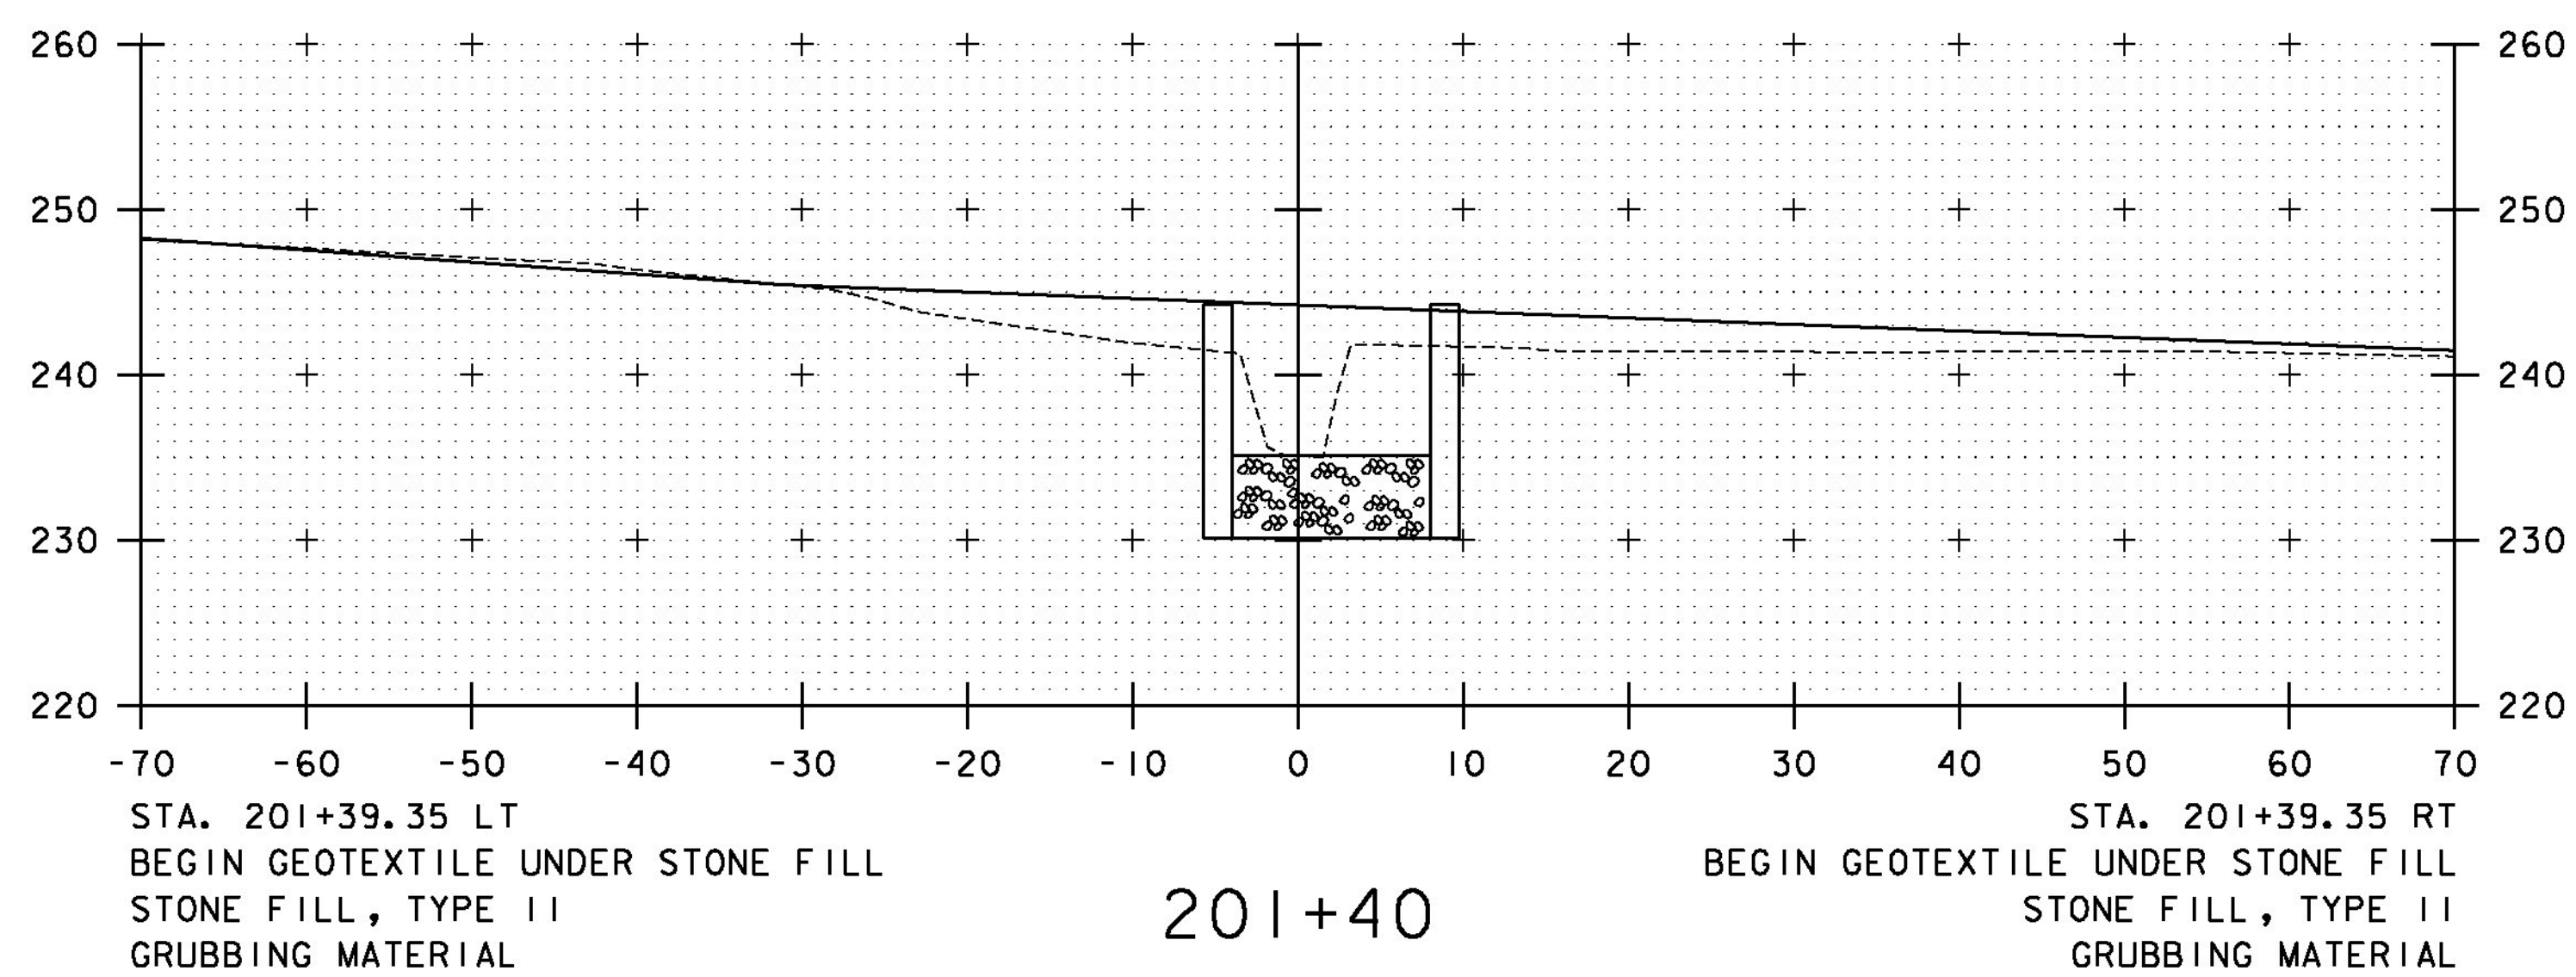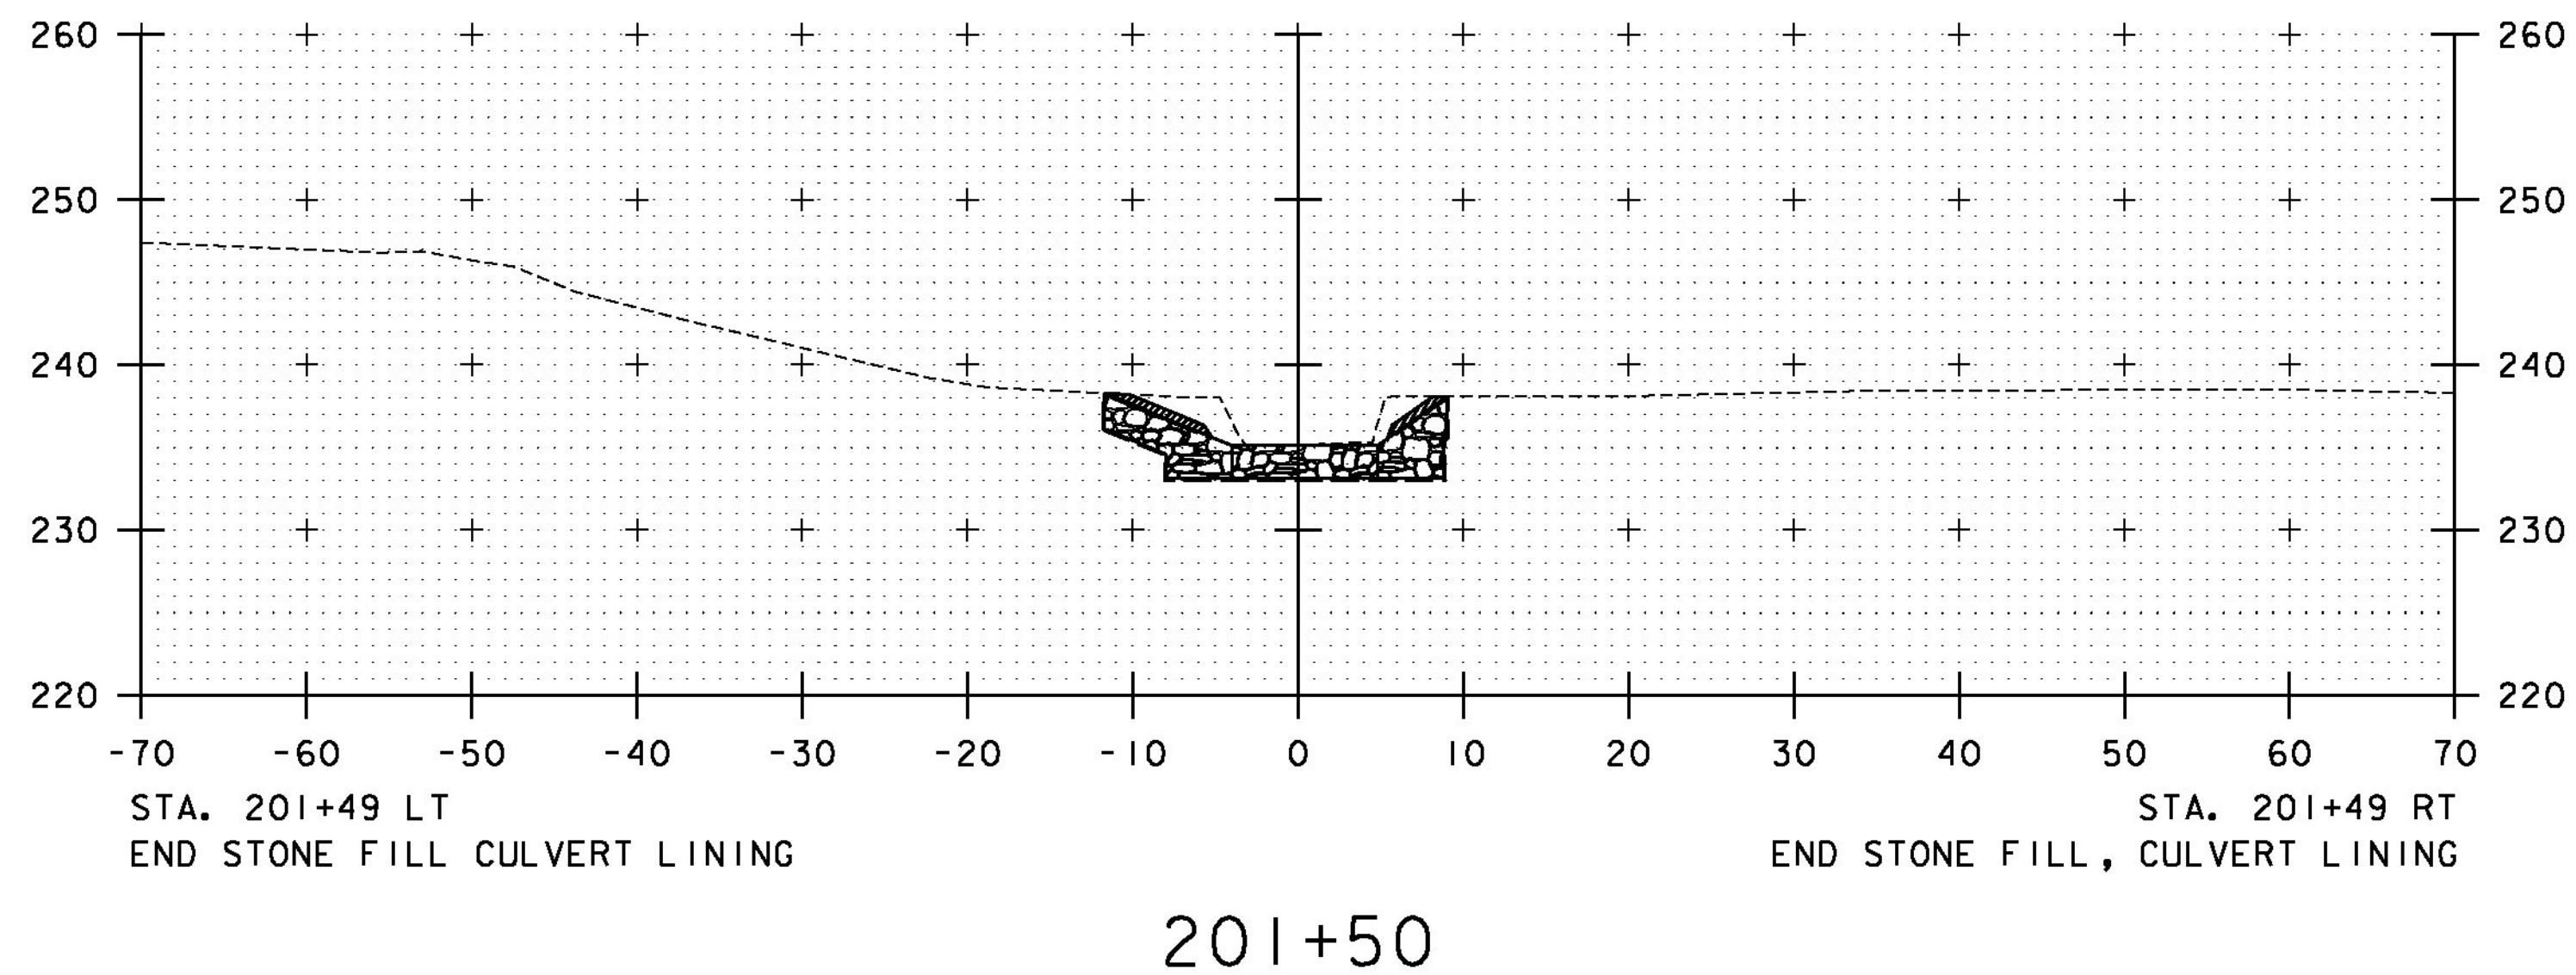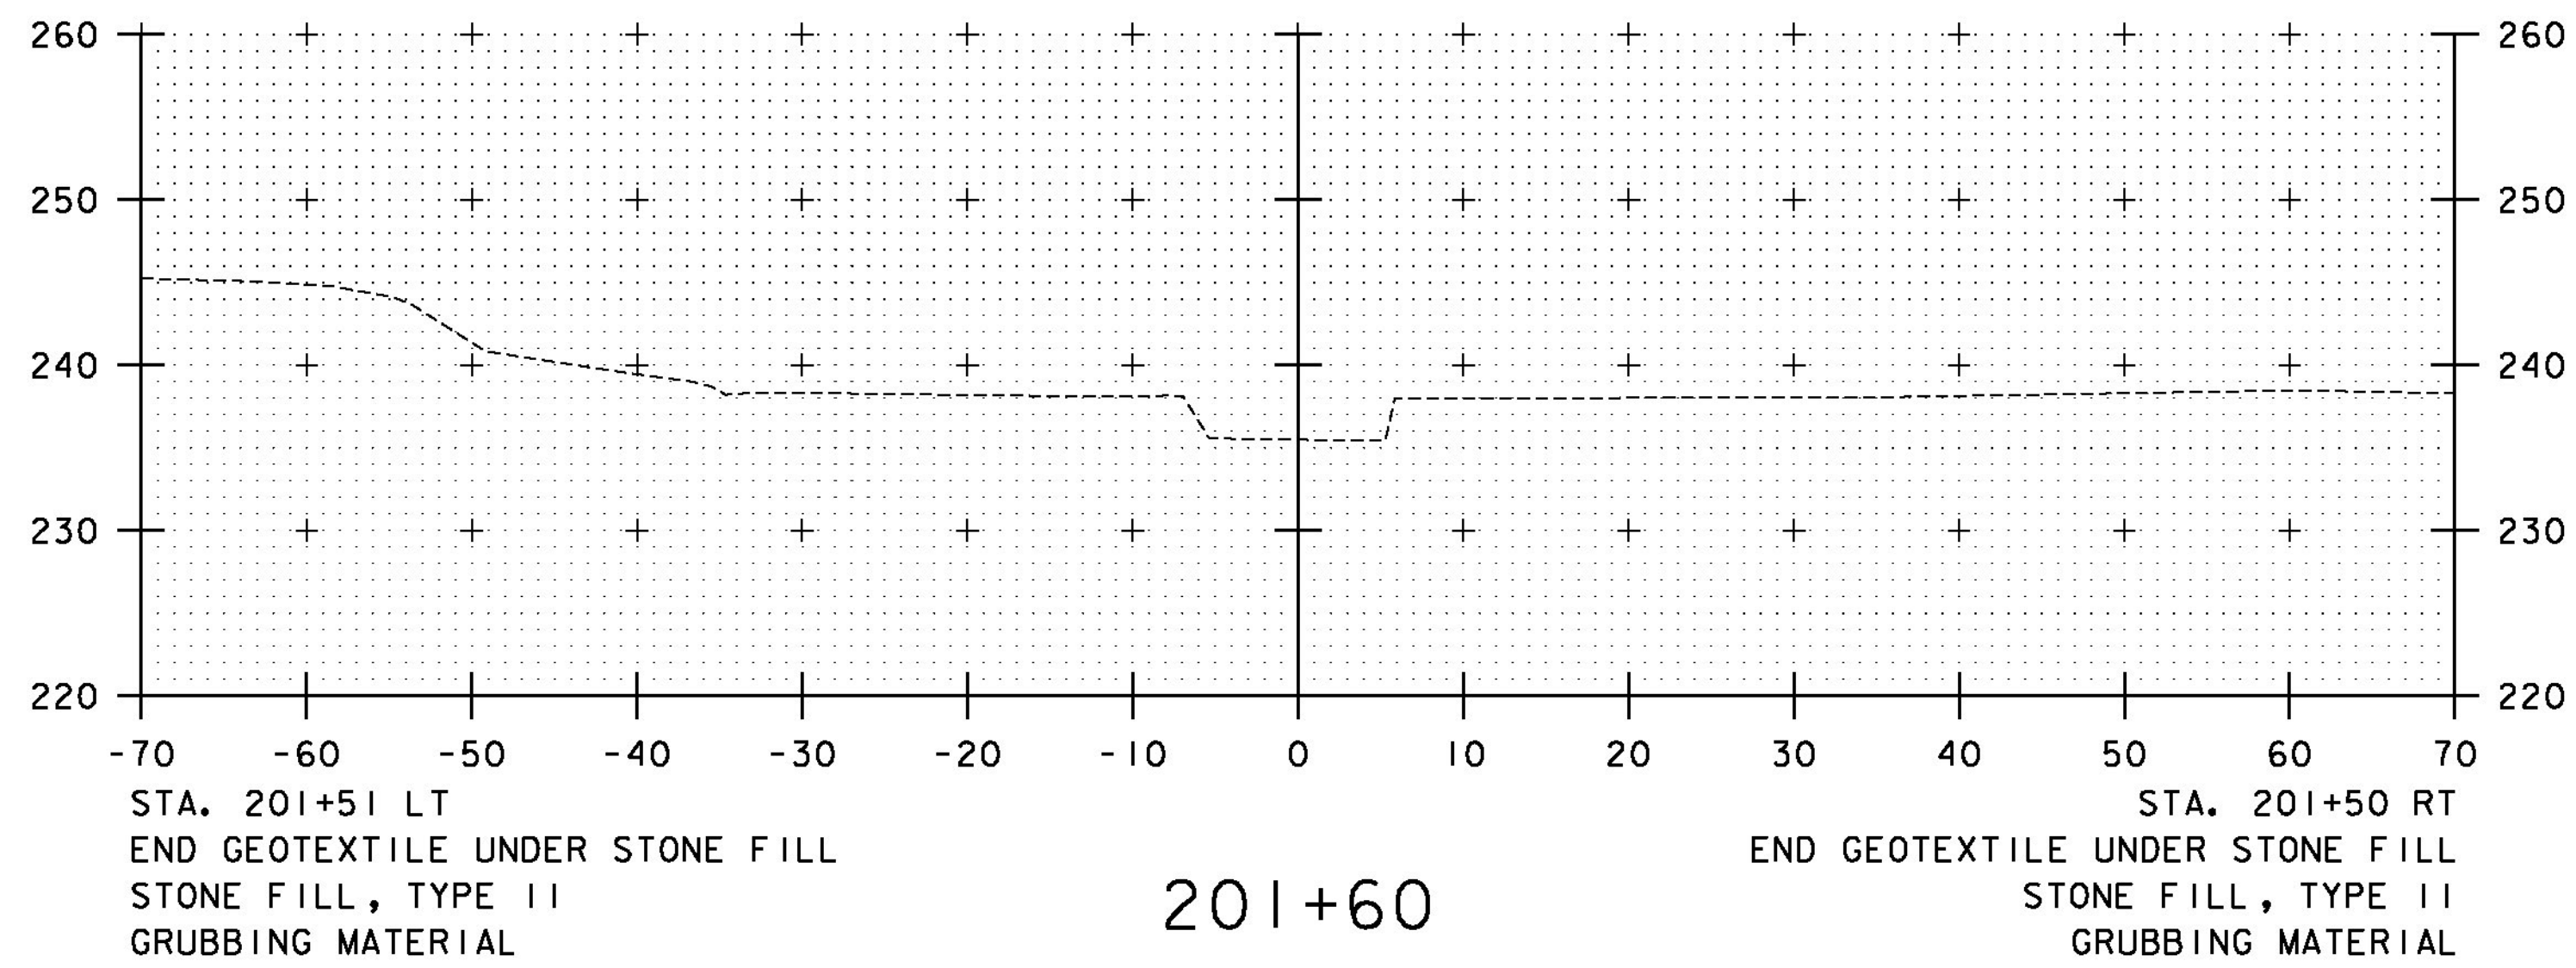


STA. 201+40 TO STA. 201+60

PROJECT NAME: BRIDPORT  
PROJECT NUMBER: STP CULV(29)

FILE NAME: zllc264xs_br5.dgn  
PROJECT LEADER: M. CHENETTE  
DESIGNED BY: J. HUNGERFORD  
CHANNEL CROSS SECTIONS - CXS2 - BR5

PLOT DATE: 8/22/2014  
DRAWN BY: L. BUXTON  
CHECKED BY: M. CHENETTE  
SHEET 51 OF 57

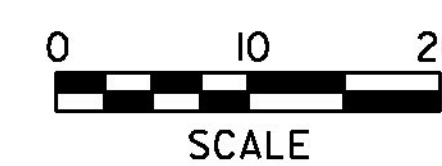

## EPSC PLAN NARRATIVE

### 1.1 PROJECT DESCRIPTION

THIS PROJECT INVOLVES THE REPLACEMENT OF BRIDGE #5, RELATED CHANNEL WORK AND INCIDENTALS. BRIDGE #5 IS AN EXISTING 84" CORRUGATED METAL PIPE CULVERT, WHICH WILL BE REPLACED WITH A 12' SPAN PRECAST CONCRETE CULVERT TO CONVEY AN UNNAMED TRIBUTARY TO THE LEMON FAIR RIVER BENEATH VT ROUTE 125. BRIDGE #5 IS LOCATED IN THE TOWN OF BRIDPORT ON VT ROUTE 125, 1.6 MILES EAST OF THE JUNCTION WITH VERMONT ROUTE 22A.

NOTE: AREA OF DISTURBANCE INCLUDES LIMITS OF EARTH DISTURBANCE WITHIN THE PROJECT AREA, AS WELL AS WASTE, BORROW AND STAGING AREAS, AND OTHER EARTH DISTURBING ACTIVITIES WITHIN OR DIRECTLY ADJACENT TO THE PROJECT LIMITS AS SHOWN ON THE ATTACHED EPSC PLAN.

TOTAL AREA OF DISTURBANCE AS SHOWN ON THE ATTACHED EPSC PLAN IS APPROXIMATELY 0.43 ACRES.

IT IS ANTICIPATED THAT THIS PROJECT WILL LAST ONE CONSTRUCTION SEASON.

### 1.2 SITE INVENTORY

#### 1.2.1 TOPOGRAPHY

THE TOPOGRAPHY OF PROJECT SITE IS A LOW LYING WETLAND / MARSHY AREA WITH GRASSY UNDERGROWTH. THE SURROUNDING LAND IS MOSTLY LOW LYING AGRICULTURAL LANDS WITH SOME WOODED AREAS. VT ROUTE 125 AND THE INTERSECTION OF TH-32 PAYNE ROAD ARE WITHIN THE PROJECT SITE. THERE IS A CULVERT BENEATH TH-32 PAYNE ROAD 950' DOWNSTREAM OF BRIDGE #5. THE LOW AREA BETWEEN THE CULVERTS HAS STANDING WATER IN NORMAL CONDITIONS.

#### 1.2.2 DRAINAGE, WATERWAYS, BODIES OF WATER, AND PROXIMITY TO NATURAL OR MAN-MADE WATER FEATURES

THE WATER SOURCE ON THE PROJECT SITE IS AN UNNAMED TRIBUTARY TO THE LEMON FAIR RIVER. THE PROJECT IS IN THE OTTER CREEK DRAINAGE BASIN. THE TOTAL CONTRIBUTING DRAINAGE AREA IS 0.76 SQ. MI. DUE TO THE NATURE OF THE SURROUNDING TERRAIN THE PROJECT SITE COULD RECEIVE RUNOFF FROM THE SURROUNDING SLOPES, ROADWAY DITCHES, AND THE ROADWAY OVERTOP THE CULVERT. THERE ARE CLASS II WETLANDS ON THE NORTH AND SOUTH SIDES OF THE PROJECT. SEE THE PROJECT IMPACTS PLANS.

#### 1.2.3 VEGETATION

THE VEGETATION IN THE PROJECT AREA CONSISTS OF GRASSY FARMLAND AND MARSHY AREA. THE IMPACT TO VEGETATION WILL BE LIMITED TO THAT WHICH IS RELATED TO THE EXCAVATION REQUIRED FOR THE INSTALLATION OF THE CULVERT, HEADWALLS, WINGWALLS, STONE FILL, AND TEMPORARY ACCESS. UPON PROJECT COMPLETION, THE CHANNEL AND DISTURBED AREAS WITH SLOPES GREATER THAN 2:1 WILL BE ARMORED WITH STONE FILL TYPE II AS SPECIFIED ON THE PLANS. DISTURBED VEGETATION WILL BE REESTABLISHED WITH STANDARD SEED AND MULCH PRACTICES.

#### 1.2.4 SOILS

ALL SOIL DATA CAME FROM THE U.S. DEPARTMENT OF AGRICULTURE SOIL CONSERVATION SERVICE FOR THE COUNTY OF ORLEANS, VERMONT. SOILS ON THE PROJECT SITE ARE LIVINGSTON CLAY, "K FACTOR" = 0.49. THE SOIL IS CONSIDERED HIGHLY ERODIBLE DUE TO K-VALUE.

NOTE: K-VALUES GENERALLY INDICATE THE FOLLOWING:

0.0-0.23 = LOW EROSION POTENTIAL  
0.24-0.36 = MODERATE EROSION POTENTIAL  
0.37 AND HIGHER = HIGH EROSION POTENTIAL

#### 1.2.5 SENSITIVE RESOURCE AREAS

CRITICAL HABITATS: YES, FRESHWATER MUSSELS PRESENT, AOP REQUESTED, INDIANA BAT TERRITORY  
HISTORICAL OR ARCHEOLOGICAL AREAS: NO  
PRIME AGRICULTURAL LAND: NO  
THREATENED AND ENDANGERED SPECIES: YES, FRESHWATER MUSSELS PRESENT, AOP REQUESTED, INDIANA BAT TERRITORY  
WATER RESOURCE: UNNAMED TRIBUTARY TO THE LEMON FAIR RIVER  
WETLANDS: YES, THERE ARE WETLANDS AT THE INLET AND OUTLET OF THE STRUCTURE. SEE THE PROJECT IMPACTS PLANS.

### 1.3 RISK EVALUATION

THIS PROJECT DOES NOT FALL UNDER THE JURISDICTION OF GENERAL PERMIT 3-9020 FOR STORMWATER RUNOFF FROM CONSTRUCTION SITES. SHOULD CHANGES PRIOR TO OR DURING CONSTRUCTION RESULT IN ONE OR MORE ACRES OF EARTH DISTURBANCE OR SHOULD THE PROJECT BECOME PART OF A LARGER PLAN OF DEVELOPMENT, THE CONTRACTOR WILL BE RESPONSIBLE FOR ANY ADDITIONAL PERMITTING.

### 1.4 EROSION PREVENTION AND SEDIMENT CONTROL

THE EROSION CONTROL PLANS ARE MEANT AS A GUIDELINE FOR PREVENTING EROSION AND CONTROLLING SEDIMENT TRANSPORT. THE PRINCIPLES OUTLINED IN THIS NARRATIVE CONSIST OF APPLYING MEASURES THROUGHOUT CONSTRUCTION OF THE PROJECT IN ORDER TO MINIMIZE SEDIMENT TRANSPORT TO THE RECEIVING WATERS. THE MEASURES INCLUDE STABILIZATION AND STRUCTURAL PRACTICES, STORM WATER CONTROLS AND OTHER POLLUTION PREVENTION PRACTICES. THEY HAVE BEEN PROPOSED BY THE DESIGNER AS A BASIS FOR PROTECTING RESOURCES AND WILL NEED TO BE BUILT UPON BASED ON THE SPECIFIC MEANS AND METHODS OF THE CONTRACTOR. REFER TO THE LOW RISK SITE HANDBOOK AND APPROPRIATE DETAIL SHEETS FOR SPECIFIC GUIDANCE AND CONSTRUCTION DETAILING. THE CONTRACTOR IS RESPONSIBLE FOR DEVELOPING AND SUBMITTING AN EPSC PLAN IN ACCORDANCE WITH SECTION 105 OF THE STANDARD SPECIFICATIONS.

IN ADDITION, THE CONTRACTOR SHALL DESIGN AND IMPLEMENT A TEMPORARY STREAM DIVERSION, INCLUDING EPSC MEASURES IN ACCORDANCE WITH ITEM 900.645, SPECIAL PROVISION (TEMPORARY RELOCATION OF STREAM).

ALL MEASURES SHALL BE REGULARLY MAINTAINED AND SHALL BE CHECKED FOR SEDIMENT BUILD-UP. SEDIMENT SHALL BE DISPOSED OF AT AN APPROVED SITE WHERE IT WILL NOT BE SUBJECT TO EROSION.

#### 1.4.1 MARK SITE BOUNDARIES

SITE BOUNDARIES AND AREAS CONSTRUCTION EQUIPMENT CAN ACCESS SHALL BE DELINEATED.

PROJECT DEMARCATION FENCING (PDF) SHALL BE USED TO PHYSICALLY MARK SITE BOUNDARIES.

#### 1.4.2 LIMIT DISTURBANCE AREA

PREVENTING INITIAL SOIL EROSION BY MINIMIZING THE EXPOSED AREA IS MUCH MORE EFFECTIVE THAN TREATING ERODED SEDIMENT. EARTH DISTURBANCE CAN BE MINIMIZED THROUGH CONSTRUCTION PHASING BY ONLY OPENING UP EARTH AS NECESSARY. THIS CAN LIMIT THE AREA THAT WILL BE DISTURBED AND EXPOSED TO EROSION. EMPLOY TEMPORARY CONSTRUCTION STABILIZATION PRACTICES IN INCREMENTAL STAGES AS PHASES CHANGE. FOR PROJECTS WHICH FALL UNDER THE CONSTRUCTION GENERAL PERMIT, ONLY THE ACREAGE LISTED ON THE PERMIT AUTHORIZATION MAY BE EXPOSED AT ANY GIVEN TIME.

MAINTAINING VEGETATED BUFFERS ALONG STREAM BANKS, WETLANDS OR OTHER SENSITIVE AREAS IS A CRUCIAL EROSION AND SEDIMENT CONTROL MEASURE THAT SHOULD BE ESTABLISHED WHEREVER POSSIBLE.

#### 1.4.3 SITE ENTRANCE/EXIT STABILIZATION

TRACKING OF SEDIMENT ONTO PUBLIC HIGHWAYS SHALL BE MINIMIZED TO REDUCE THE POTENTIAL FOR RUNOFF ENTERING RECEIVING WATERS. INSTALLATION SHALL COINCIDE WITH THE CONTRACTOR'S PROGRESS SCHEDULE.

STABILIZED CONSTRUCTION ENTRANCES SHALL BE INSTALLED AS PROPOSED ON THE EPSC PLAN AND ANYWHERE EQUIPMENT WILL BE GOING FROM AREAS OF EXPOSED SOILS TO PAVED SURFACES.

#### 1.4.4 INSTALL SEDIMENT BARRIERS

SEDIMENT BARRIERS SHALL BE UTILIZED TO INTERCEPT RUNOFF AND ALLOW SUSPENDED SEDIMENT TO SETTLE OUT. THEY SHALL BE INSTALLED PRIOR TO ANY UP SLOPE WORK.

SILT FENCE WILL BE INSTALLED AS SHOWN ON THE EPSC PLAN.

#### 1.4.5 DIVERT UPLAND RUNOFF

DIVERSIONARY MEASURES SHALL BE USED TO INTERCEPT RUNOFF FROM ABOVE THE CONSTRUCTION AND DIRECT IT AROUND THE DISTURBED AREA SO THAT CLEAN WATER DOES NOT BECOME MUDDIED WHILE TRAVELING OVER EXPOSED SOILS ON THE CONSTRUCTION SITE.

THE PROJECT AREA IS RELATIVELY FLAT WITH MINIMAL OFF-SITE RUNOFF FLOWING THROUGH THE SITE. THEREFORE DIVERSION MEASURES WILL NOT BE NECESSARY.

#### 1.4.6 SLOW DOWN CHANNELIZED RUNOFF

CHECK STRUCTURES SHALL BE UTILIZED TO REDUCE THE VELOCITY, AND THUS THE EROSION POTENTIAL, OF CONCENTRATED FLOW IN CHANNELS.

#### 1.4.7 CONSTRUCT PERMANENT CONTROLS

THERE ARE NO PERMANENT STORMWATER TREATMENT DEVICES TO BE INSTALLED WITH THIS PROJECT.

#### 1.4.8 STABILIZE EXPOSED SOILS DURING CONSTRUCTION

ALL AREAS OF DISTURBANCE MUST HAVE TEMPORARY STABILIZATION IN PLACE WITHIN 48 HOURS OF DISTURBANCE OR IN ACCORDANCE WITH THE CONSTRUCTION GENERAL PERMIT 3-9020 AUTHORIZATION.

SURFACE ROUGHENING OF ALL EXPOSED SLOPES, COMBINED WITH TEMPORARY MULCHING, SHALL BE UTILIZED ON A REGULAR BASIS. BIODEGRADABLE EROSION CONTROL MATTING OR AN EQUIVALENT SHALL BE USED TO STABILIZE ALL SLOPES STEEPER THAN 1:3.

THE FORECAST OF RAINFALL EVENTS SHALL TRIGGER IMMEDIATE PROTECTION OF EXPOSED SOILS.

#### 1.4.9 WINTER STABILIZATION

VARIOUS MEASURES SPECIFIC TO WINTER MAY BE NECESSARY SHOULD THE PROJECT EXTEND INTO WINTER (OCTOBER 15 THROUGH APRIL 15). REFER TO THE LOW RISK SITE HANDBOOK FOR GUIDANCE.

#### 1.4.10 STABILIZE SOIL AT FINAL GRADE

EXPOSED SOIL MUST BE STABILIZED WITHIN 48 HOURS OF REACHING FINAL GRADE.

SEED, MULCH, FERTILIZER AND LIME SHALL BE USED TO ESTABLISH PERMANENT VEGETATION. FOR SLOPES STEEPER THAN 1:3, BIODEGRADABLE EROSION CONTROL MATTING OR AN EQUIVALENT SHALL BE USED INSTEAD OF MULCH.

#### 1.4.11 DE-WATERING ACTIVITIES

DISCHARGE FROM DEWATERING ACTIVITIES THAT FLOWS OFF OF THE CONSTRUCTION SITE MUST NOT CAUSE OR CONTRIBUTE TO A VIOLATION OF THE VERMONT WATER QUALITY STANDARDS.

SEDIMENT CONTAINMENT BAGS (FILTER BAGS) FOR HEADWALL WORK WILL BE USED AS NECESSARY AND AS DIRECTED BY THE ENGINEER. SEE SHEET 55 FOR DETAIL.

#### 1.4.12 INSPECT YOUR SITE

INSPECT THE PROJECT SITE BASED ON SPECIAL PROVISION REQUIREMENTS.

### 1.5 SEQUENCE AND STAGING

THIS SECTION WILL BE DEVELOPED BY THE CONTRACTOR USING THE GUIDANCE OUTLINED IN THE VTRANS EPSC PLAN CONTRACTOR CHECKLIST.

#### 1.5.2 OFF-SITE ACTIVITIES


IN ADDITION TO THE CONTRACTOR CHECKLIST ANY ACTIVITIES OUTSIDE THE CONSTRUCTION LIMITS SHALL FOLLOW SUBSECTIONS 105.25- 105.29 OF THE STANDARD SPECIFICATIONS FOR CONSTRUCTION.



PROJECT NAME: BRIDPORT  
PROJECT NUMBER: STP CULV(29)

FILE NAME: zllc264epsc nar_br5.dgn  
PROJECT LEADER: M. CHENETTE  
DESIGNED BY: J. HUNGERFORD  
EPSC NARRATIVE - ECN 1 - BR5

PLOT DATE: 8/22/2014  
DRAWN BY: L. BUXTON  
CHECKED BY: M. CHENETTE  
SHEET 52 OF 57

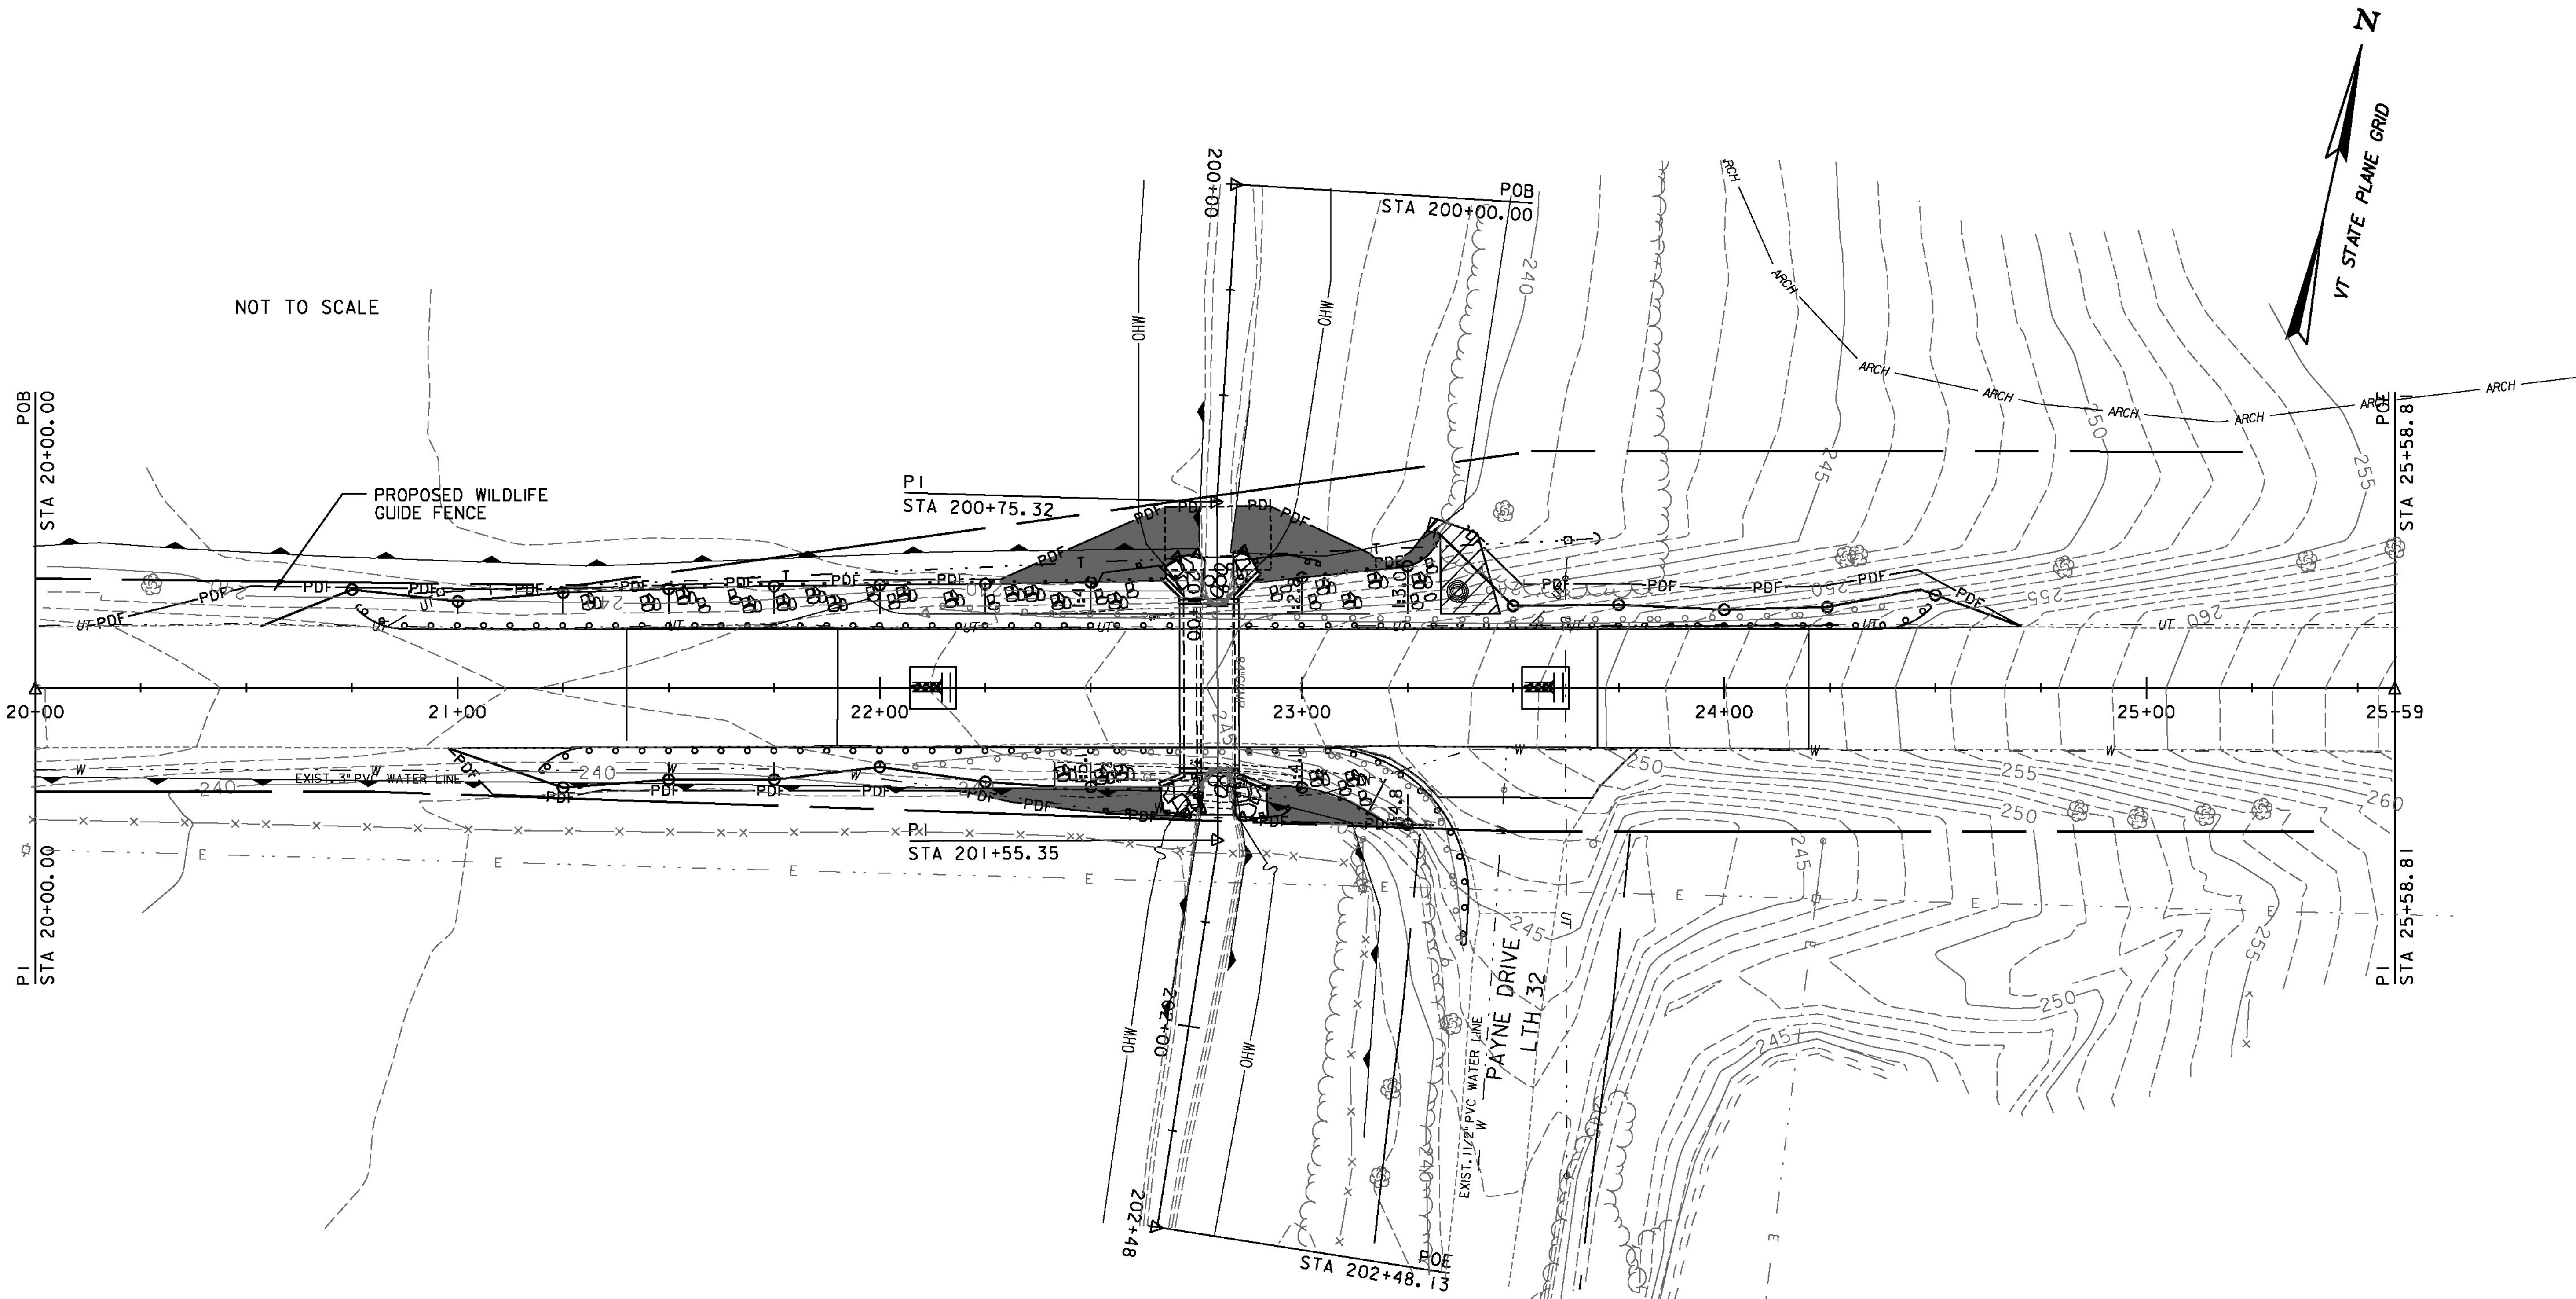


**LEGEND**

 STABILIZED CONSTRUCTION ENTRANCE

**ITEM 653.55 PROJECT DEMARCATION FENCE**  
 STA. 20+37.32 - 23+39.36, RT.  
 STA. 20+42.71 - 23+46.84, LT.


**ITEM 649.51 GEOTEXTILE FOR SILT FENCE**  
 SEE LOCATIONS, THIS SHEET.

**PLAN**  
 SCALE: 1" = 20'-0"  


**NOTE:**  
 THE CONTRACTOR IS RESPONSIBLE FOR DEVELOPING A TEMPORARY STREAM DIVERSION PLAN. THE PLAN SHALL INCLUDE EROSION CONTROL MEASURES AS NECESSARY TO PREVENT AND CONTROL SEDIMENT DISCHARGE. SEE SPECIAL PROVISION 900.645 (TEMPORARY RELOCATION OF STREAM).

PROJECT NAME: BRIDPORT	FILE NAME: zllc264bdr_ero_br5.dgn	PLOT DATE: 8/22/2014
PROJECT NUMBER: STP CULV(29)	PROJECT LEADER: M. CHENETTE	DRAWN BY: L. BUXTON
	DESIGNED BY: J. HUNGERFORD	CHECKED BY: M. CHENETTE
	EPSC CONST. SITE PLAN - ECP 1- BR5	SHEET 53 OF 57



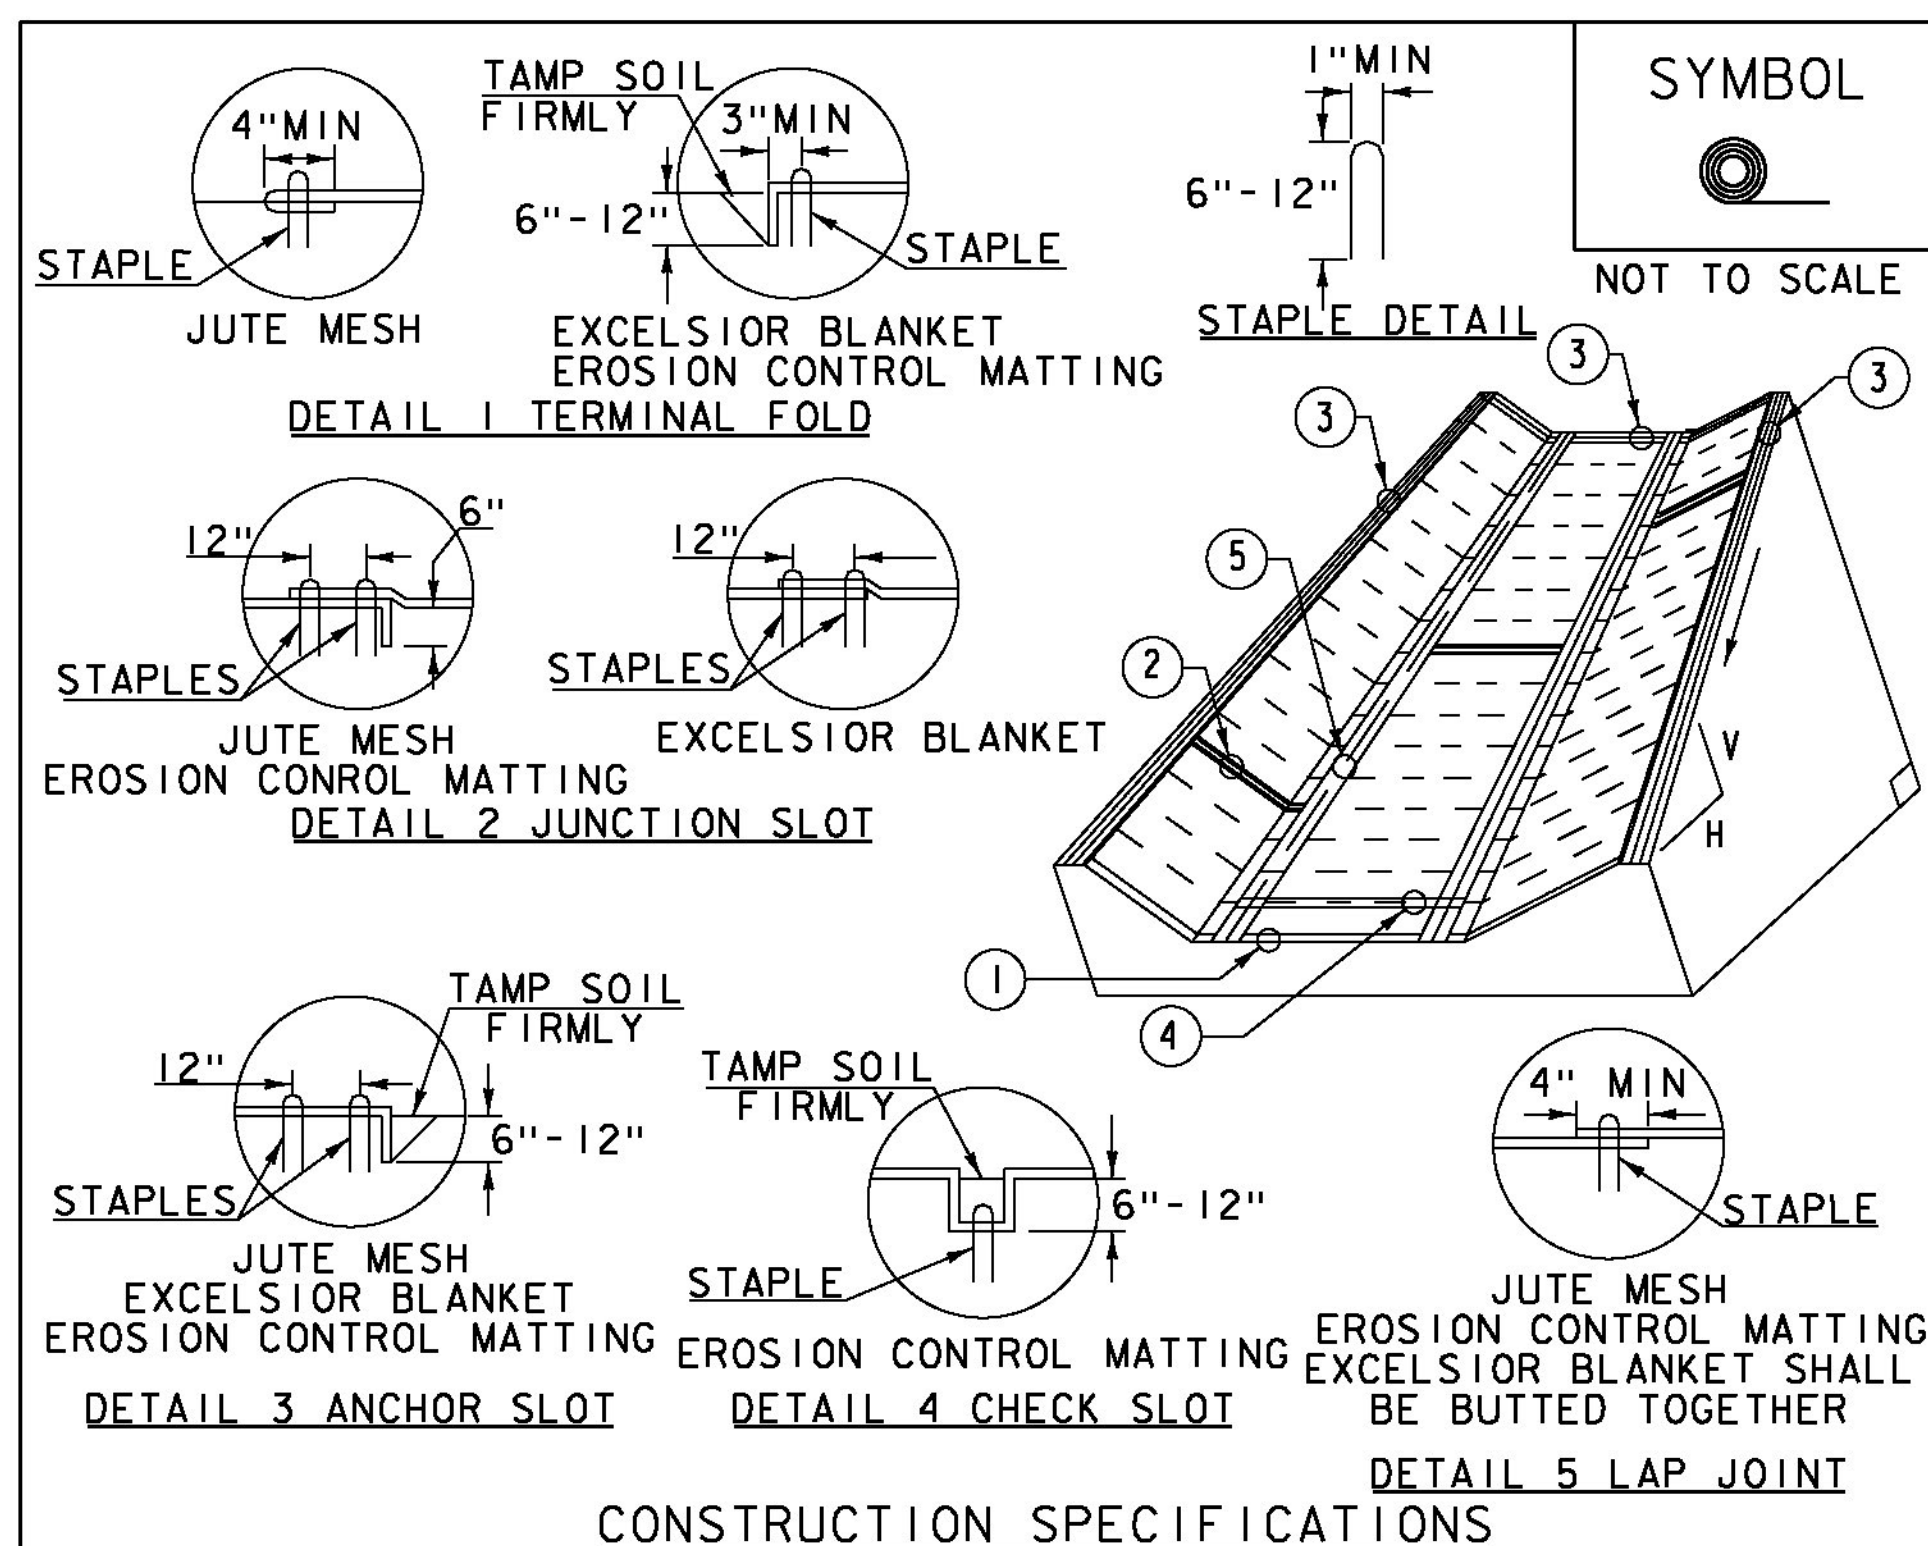


- CONSTRUCTION SPECIFICATIONS**
1. EROSION MATTING, CHECK SLOTS, SHALL BE SPACED IN DITCH CHANNEL SO THAT ONE OCCURS WITHIN EACH 50' ON SLOPES OF MORE THAN 4% AND LESS THAN 6%. ON SLOPES OF 6% OR MORE, THEY SHALL BE SPACED SO THAT ONE OCCURS WITHIN EACH 25'.
  2. APPLY FERTILIZER, LIME SEED PRIOR TO PLACING MATTING.
  3. STAPLES ARE TO BE PLACED ALTERNATELY, IN COLUMNS APPROXIMATELY 2' APART AND IN ROWS APPROXIMATELY 3' APART. APPROXIMATELY 175 STAPLES ARE REQUIRED PER 4' X 225' ROLL OF MATERIAL AND 125 STAPLES ARE REQUIRED PER 4' X 150' ROLL OF MATERIAL.
  4. DISTURBED AREAS SHALL BE SMOOTHLY GRADED. EROSION CONTROL MATERIAL SHALL BE PLACED LOOSELY OVER GROUND SURFACE. DO NOT STRETCH.
  5. ALL TERMINAL ENDS AND TRANSVERSE LAPS SHALL BE STAPLED AT APPROXIMATELY 12" INTERVALS.

ADAPTED FROM DETAILS PROVIDED BY: NEW YORK STATE DEC  
ORIGINALLY DEVELOPED BY USDA-NRCS  
VERMONT DEPARTMENT OF ENVIRONMENTAL CONSERVATION

**ROLLED EROSION CONTROL PRODUCT (RECP) DITCH**

NOTES:  
REFER TO "THE VERMONT STANDARDS & SPECIFICATIONS FOR EROSION PREVENTION & SEDIMENT CONTROL -2006- "FROM THE VT AGENCY OF NATURAL RESOURCES FOR ADDITIONAL GUIDANCE.  
THIS WORK SHALL BE PERFORMED IN ACCORDANCE WITH SECTION 653 AND AS SHOWN IN THE PLANS FOR TEMPORARY EROSION MATTING (PAY ITEM 653.20) OR PERMANENT EROSION MATTING (PAY ITEM 653.21).

REVISIONS		
MARCH 8, 2007	JMF	
APRIL 16, 2007	WHF	
JANUARY 13, 2009	WHF	

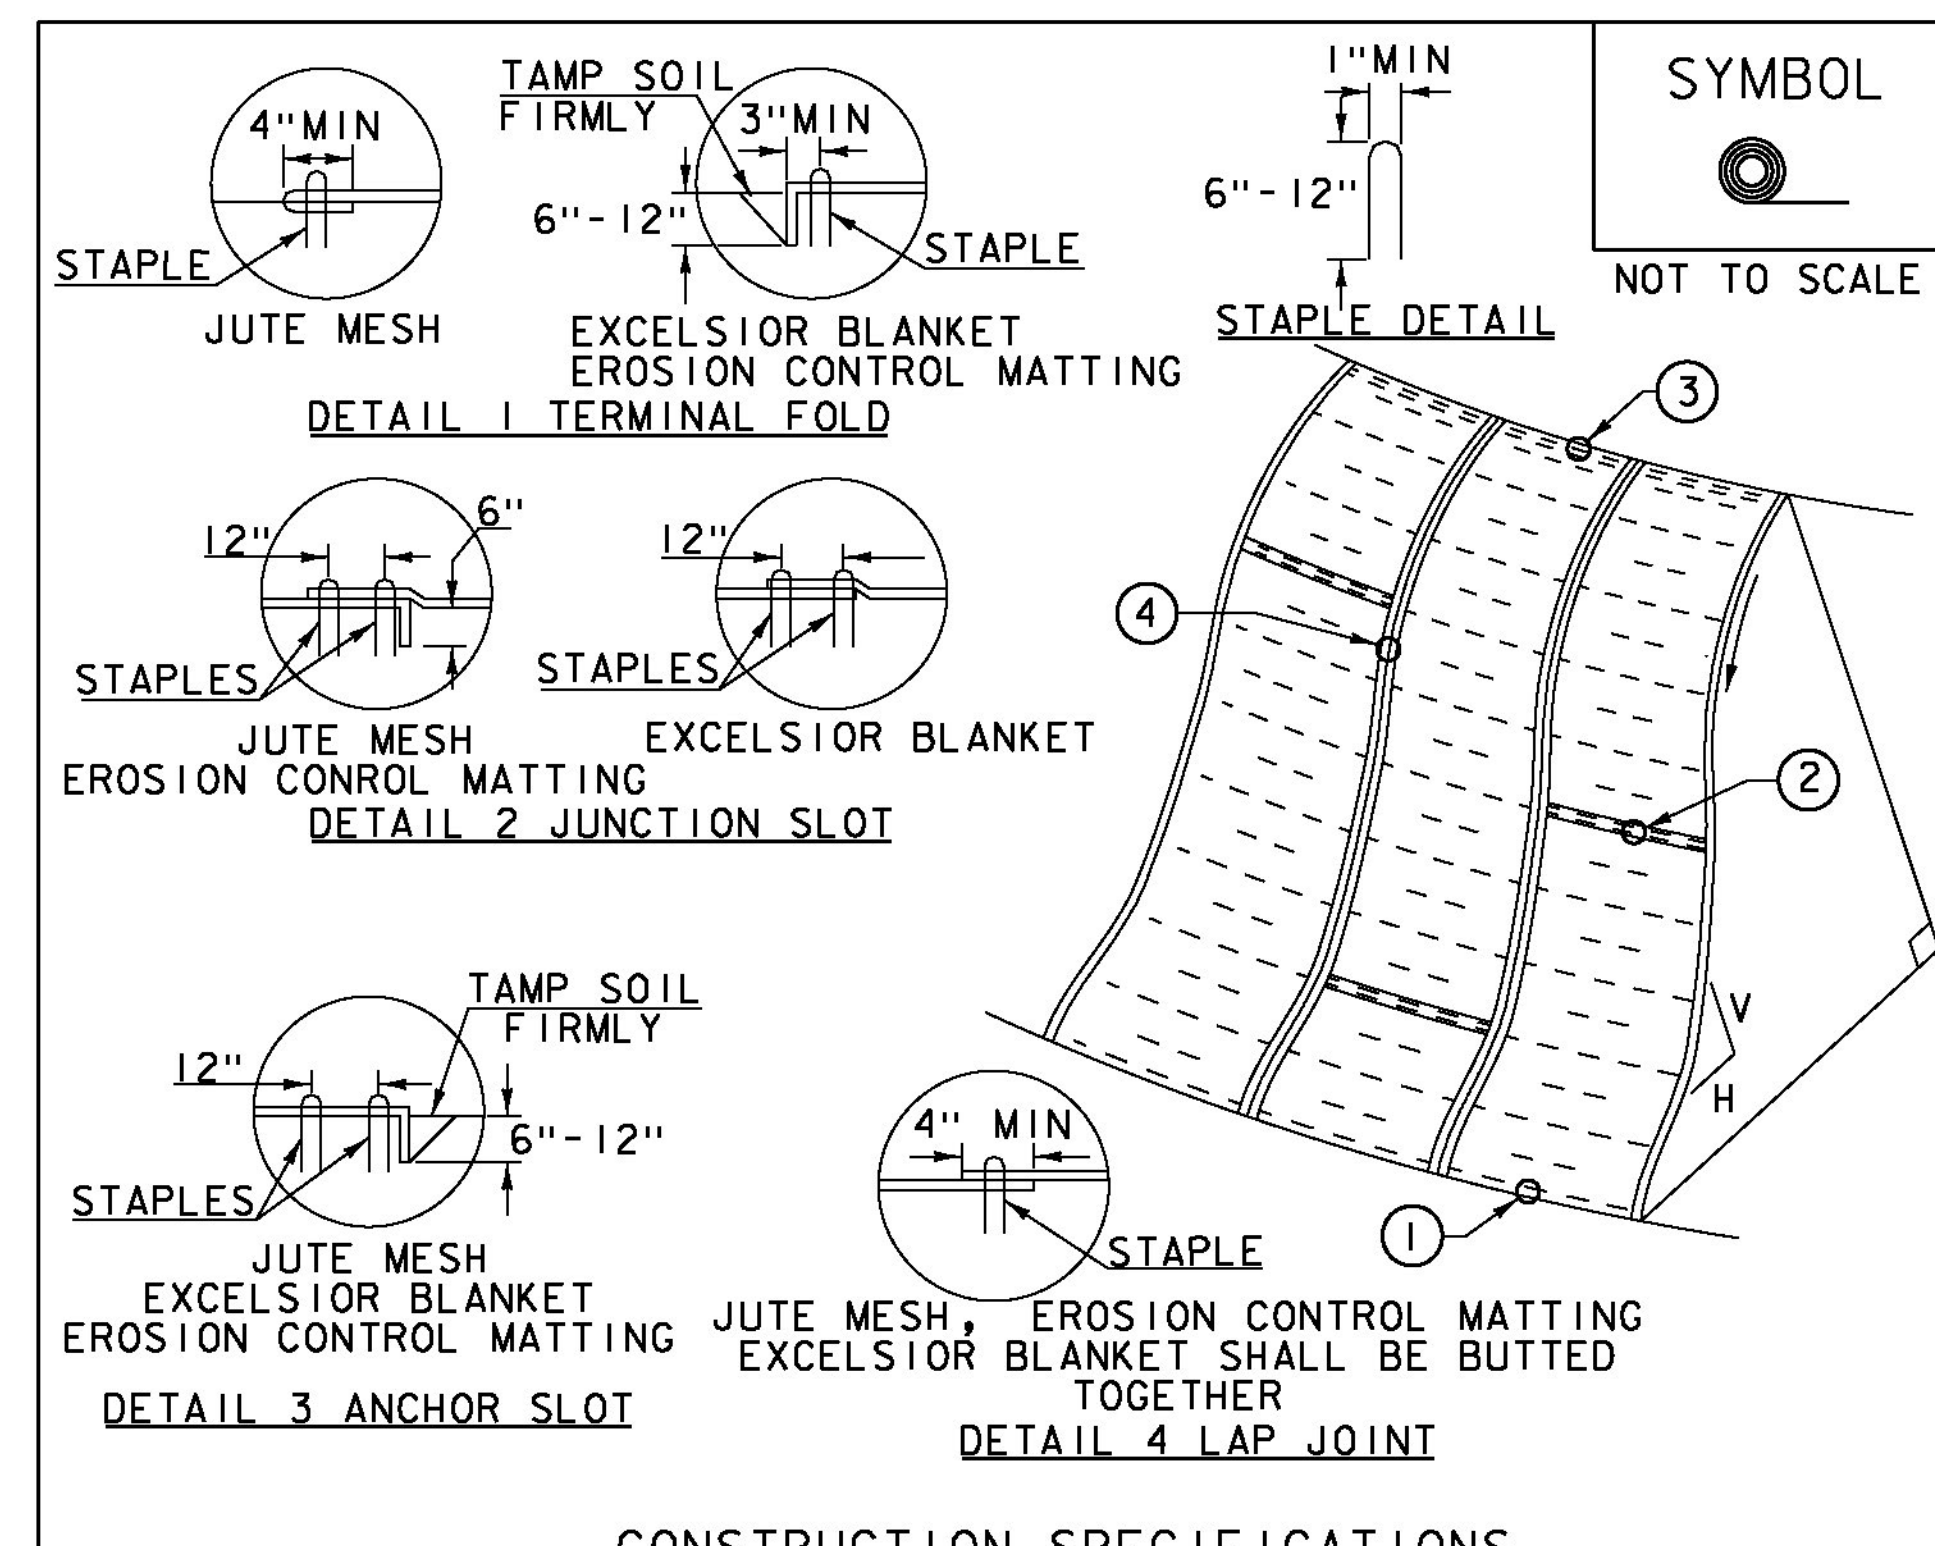


- CONSTRUCTION SPECIFICATIONS**
1. APPLY TO SLOPES GREATER THAN 3H:1V OR WHERE NECESSARY TO AID IN ESTABLISHING VEGETATION.
  2. APPLY FERTILIZER, LIME SEED PRIOR TO PLACING MATTING.
  3. STAPLES ARE TO BE PLACED ALTERNATELY, IN COLUMNS APPROXIMATELY 2' APART AND IN ROWS APPROXIMATELY 3' APART. APPROXIMATELY 175 STAPLES ARE REQUIRED PER 4' X 225' ROLL OF MATERIAL AND 125 STAPLES ARE REQUIRED PER 4' X 150' ROLL OF MATERIAL.
  4. DISTURBED AREAS SHALL BE SMOOTHLY GRADED. EROSION CONTROL MATERIAL SHALL BE PLACED LOOSELY OVER GROUND SURFACE. DO NOT STRETCH.
  5. ALL TERMINAL ENDS AND TRANSVERSE LAPS SHALL BE STAPLED AT APPROXIMATELY 12" INTERVALS.

ADAPTED FROM DETAILS PROVIDED BY: NEW YORK STATE DEC  
ORIGINALLY DEVELOPED BY USDA-NRCS  
VERMONT DEPARTMENT OF ENVIRONMENTAL CONSERVATION

**ROLLED EROSION CONTROL PRODUCT (RECP) SIDE SLOPE**

NOTES:  
REFER TO "THE VERMONT STANDARDS & SPECIFICATIONS FOR EROSION PREVENTION & SEDIMENT CONTROL -2006- "FROM THE VT AGENCY OF NATURAL RESOURCES FOR ADDITIONAL GUIDANCE.  
THIS WORK SHALL BE PERFORMED IN ACCORDANCE WITH SECTION 653 AND AS SHOWN IN THE PLANS FOR TEMPORARY EROSION MATTING (PAY ITEM 653.20) OR PERMANENT EROSION MATTING (PAY ITEM 653.21).

REVISIONS		
APRIL 16, 2007	JMF	
JANUARY 13, 2009	WHF	

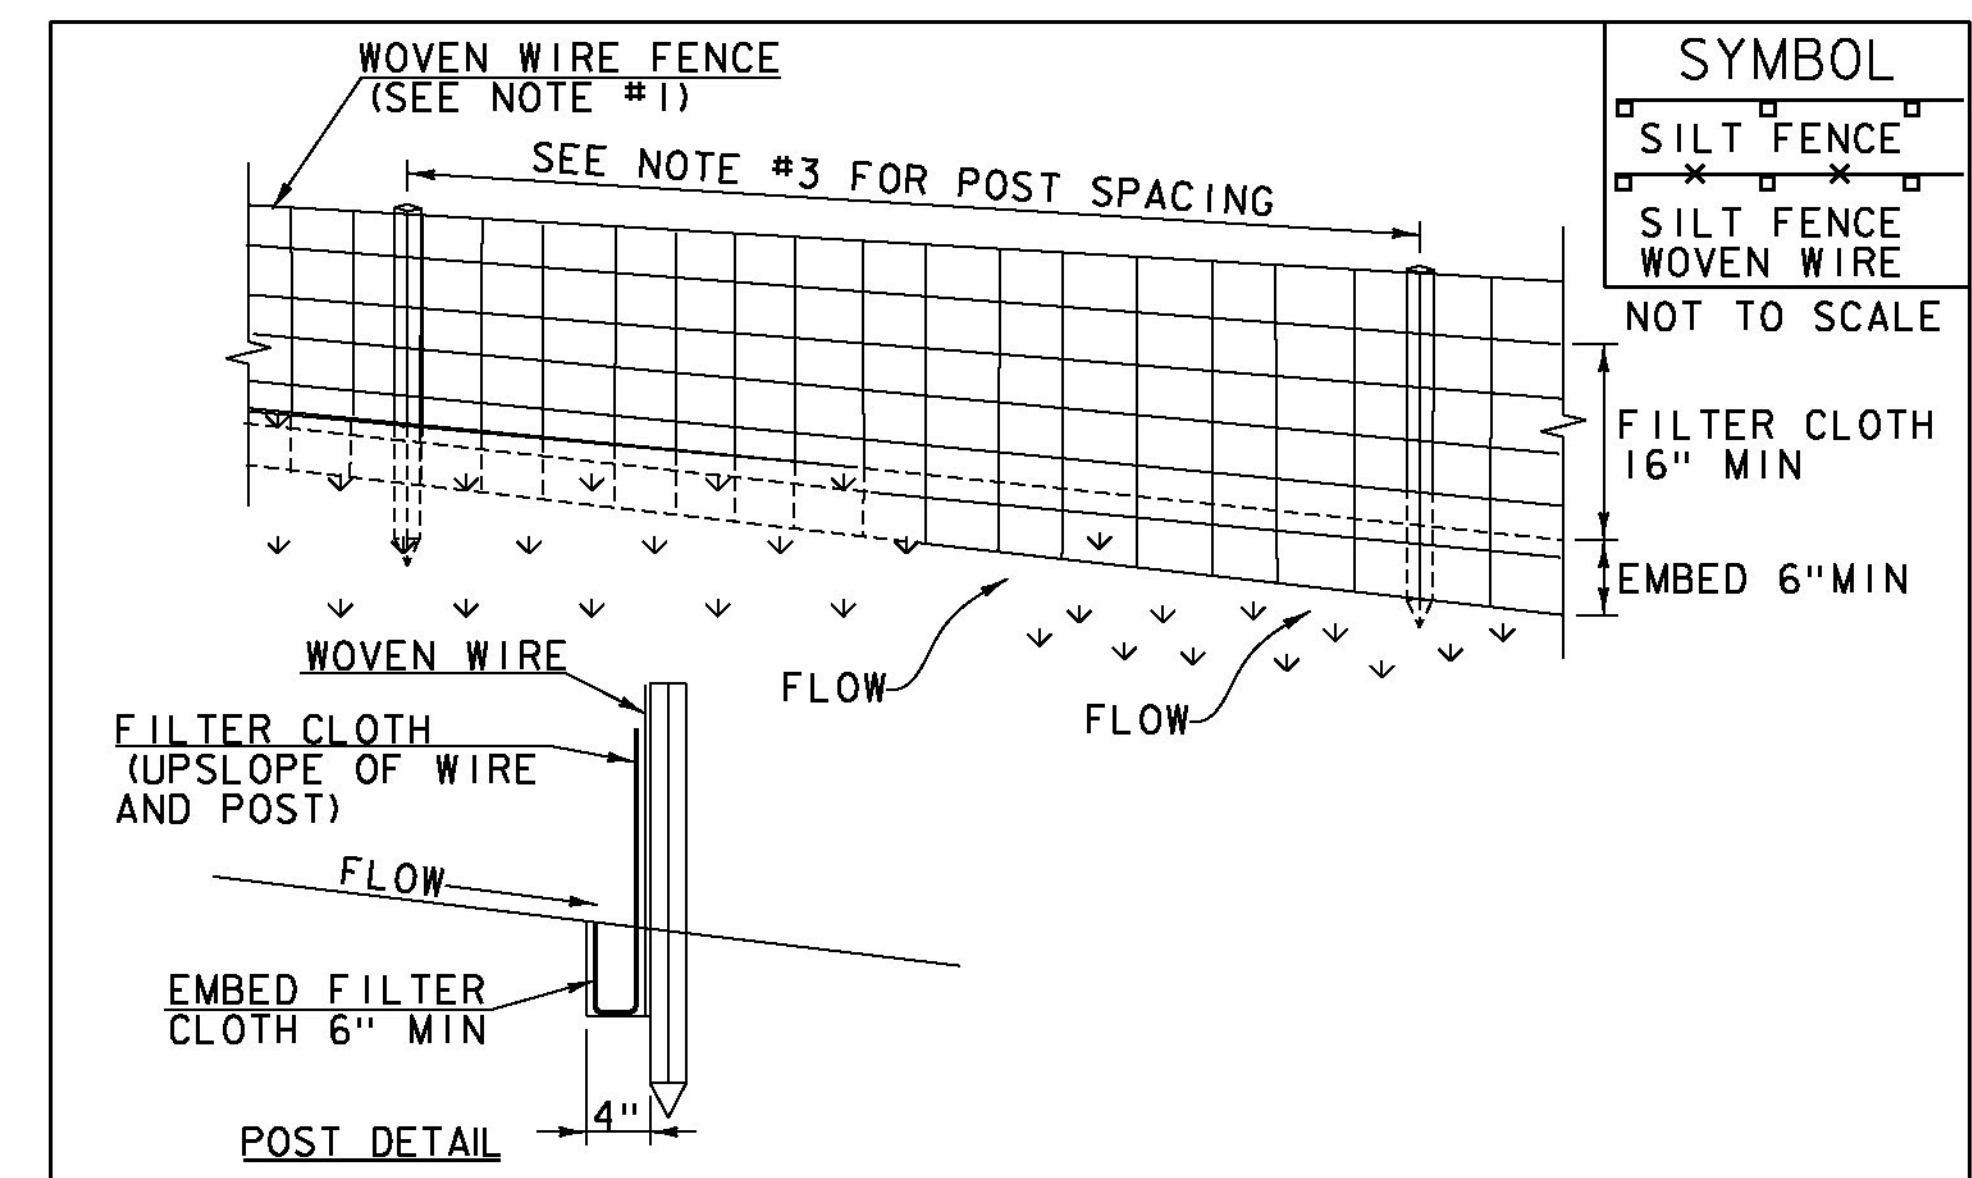

- CONSTRUCTION SPECIFICATIONS**
1. WOVEN WIRE REINFORCED FENCE IS REQUIRED WITHIN 100' UPSLOPE OF RECEIVING WATERS WHEN THE PROJECT FALLS UNDER A CONSTRUCTION STORMWATER PERMIT. WOVEN WIRE SHALL BE A MIN. 14 GAUGE WITH A 6" MAX. MESH OPENING.
  2. FILTER CLOTH SHALL BE EITHER FILTER X, MIRAF1100X, STABILINKA T140N OR APPROVED EQUIVALENT.
  3. POST SPACING FOR WIRE-BACKED FENCE SHALL BE 10' MAXIMUM. FOR FILTER-CLOTH FENCE, WHEN ELONGATION IS >50%, POST SPACING SHALL NOT EXCEED 4' AND WHEN ELONGATION IS <50%, POST SPACING SHALL NOT EXCEED 6'.
  4. WOVEN WIRE FENCE IS TO BE FASTENED SECURELY TO FENCE POSTS WITH WIRE TIES. FILTER CLOTH IS TO BE FASTENED SECURELY TO WOVEN WIRE FENCE WITH TIES SPACED EVERY 24" AT TOP AND MID SECTION.
  5. WHEN TWO SECTIONS OF FILTER CLOTH ADJOIN EACH OTHER THEY SHALL BE OVER-LAPPED BY 6" AND FOLDED.
  6. MAINTENANCE SHALL BE PERFORMED AS NEEDED AND MATERIAL REMOVED WHEN SEDIMENT REACHES HALF OF FABRIC HEIGHT.

ADAPTED FROM DETAILS PROVIDED BY: NEW YORK STATE DEC  
ORIGINALLY DEVELOPED BY USDA-NRCS  
VERMONT DEPARTMENT OF ENVIRONMENTAL CONSERVATION

**SILT FENCE**

NOTES:  
REFER TO "THE VERMONT STANDARDS & SPECIFICATIONS FOR EROSION PREVENTION & SEDIMENT CONTROL -2006- "FROM THE VT AGENCY OF NATURAL RESOURCES FOR ADDITIONAL GUIDANCE.  
THIS WORK SHALL BE PERFORMED IN ACCORDANCE WITH SECTION 649 AND AS SHOWN IN THE PLANS FOR GEOTEXTILE FOR SILT FENCE (PAY ITEM 649.51) OR GEOTEXTILE FOR SILT FENCE, WOVEN WIRE REINFORCED (PAY ITEM 649.515).

REVISIONS		
MARCH 21, 2008	WHF	
DECEMBER 11, 2008	WHF	
JANUARY 13, 2009	WHF	

PROJECT NAME: BRIDPORT  
PROJECT NUMBER: STP CULV(29)

FILE NAME: zllc264epsc det_br5.dgn  
PROJECT LEADER: M. CHENETTE  
DESIGNED BY: J. HUNGERFORD  
EROSION CONTROL DETAILS - ECD 1- BR5

PLOT DATE: 8/22/2014  
DRAWN BY: L. BUXTON  
CHECKED BY: M. CHENETTE  
SHEET 54 OF 57



VAOT RURAL AREA MIX					
% WEIGHT	LBS/AC		NAME	GERM %	PURITY %
	BROADCAST	HYDROSEED			
37.5%	22.5	45	CREeping RED FESCUE	85%	98%
37.5%	22.5	45	TALL FESCUE	90%	95%
5.0%	3	6	RED TOP	90%	95%
15.0%	9	18	BIRDSFOOT TREFOIL	85%	98%
5.0%	3	6	ANNUAL RYE GRASS	85%	95%
100%	60	120			

VAOT URBAN AREA MIX					
% WEIGHT	LBS/AC		NAME	GERM %	PURITY %
	BROADCAST	HYDROSEED			
42.5%	34	68	CREeping RED FESCUE	85%	98%
10.0%	8	16	PERENNIAL RYE GRASS	90%	95%
42.5%	34	68	KENTUCKY BLUE GRASS	85%	85%
5.0%	4	8	ANNUAL RYE GRASS	85%	95%
100%	80	160			

SOIL AMENDMENT GUIDANCE			
FERTILIZER		LIME	
BROADCAST	HYDROSEED	BROADCAST	HYDROSEED
10-20-10	FOLLOW	PELLETIZED	FOLLOW
500 LBS/AC	MANUFACTURER	2 TONS/AC	MANUFACTURER


**CONSTRUCTION GUIDANCE**

- RURAL SEED MIX: USE AS INDICATED IN THE PLANS AND/OR FOR ALL ESTABLISHED UPLAND (NON WETLAND) AREAS DISTURBED BY THE CONTRACTOR.
- URBAN SEED MIX: USE AS INDICATED IN THE PLANS AND/OR FOR ALL ESTABLISHED LAWN AREAS DISTURBED BY THE CONTRACTOR.
- ALL SEED MIXTURES: SHALL NOT HAVE A WEED CONTENT EXCEEDING 0.40% BY WEIGHT AND SHALL BE FREE OF ALL NOXIOUS SEED.
- FERTILIZER AND LIMESTONE: SHALL FOLLOW RATES SHOWN ON PLAN OR AS DIRECTED BY THE ENGINEER
- HAY MULCH: TO BE PLACED ON EARTH SLOPES AT THE RATE OF 2 TONS/ACRE, ACHIEVE 90% GROUND COVER OR AS DIRECTED BY THE ENGINEER.
- TOPSOIL: TO BE USED WITH SEED AS INDICATED ON THE PLANS, OR AS DIRECTED BY THE ENGINEER.
- HYDROSEEDING: ALTHOUGH GUIDANCE IS GIVEN ABOVE THE SITE CONDITIONS AND THE TYPE OF HYDROSEED WILL ULTIMATELY DICTATE THE AMOUNTS AND TYPES OF SOIL AMENDMENTS TO BE APPLIED
- TURF ESTABLISHMENT: PLACING SEED, FERTILIZER, LIME AND MULCH PRIOR TO SEPTEMBER 15 AND AFTER APRIL 15 CAN BETTER ENSURE A VIGOROUS GROWTH OF GRASS.

ADAPTED FROM VTRANS TECHNICAL LANDSCAPE MANUAL FOR ROADWAYS AND TRANSPORTATION FACILITIES

**TURF ESTABLISHMENT**

REVISIONS		
JUNE 23, 2009	WHF	
JANUARY 15, 2010	WHF	
FEBRUARY 16, 2011	WHF	

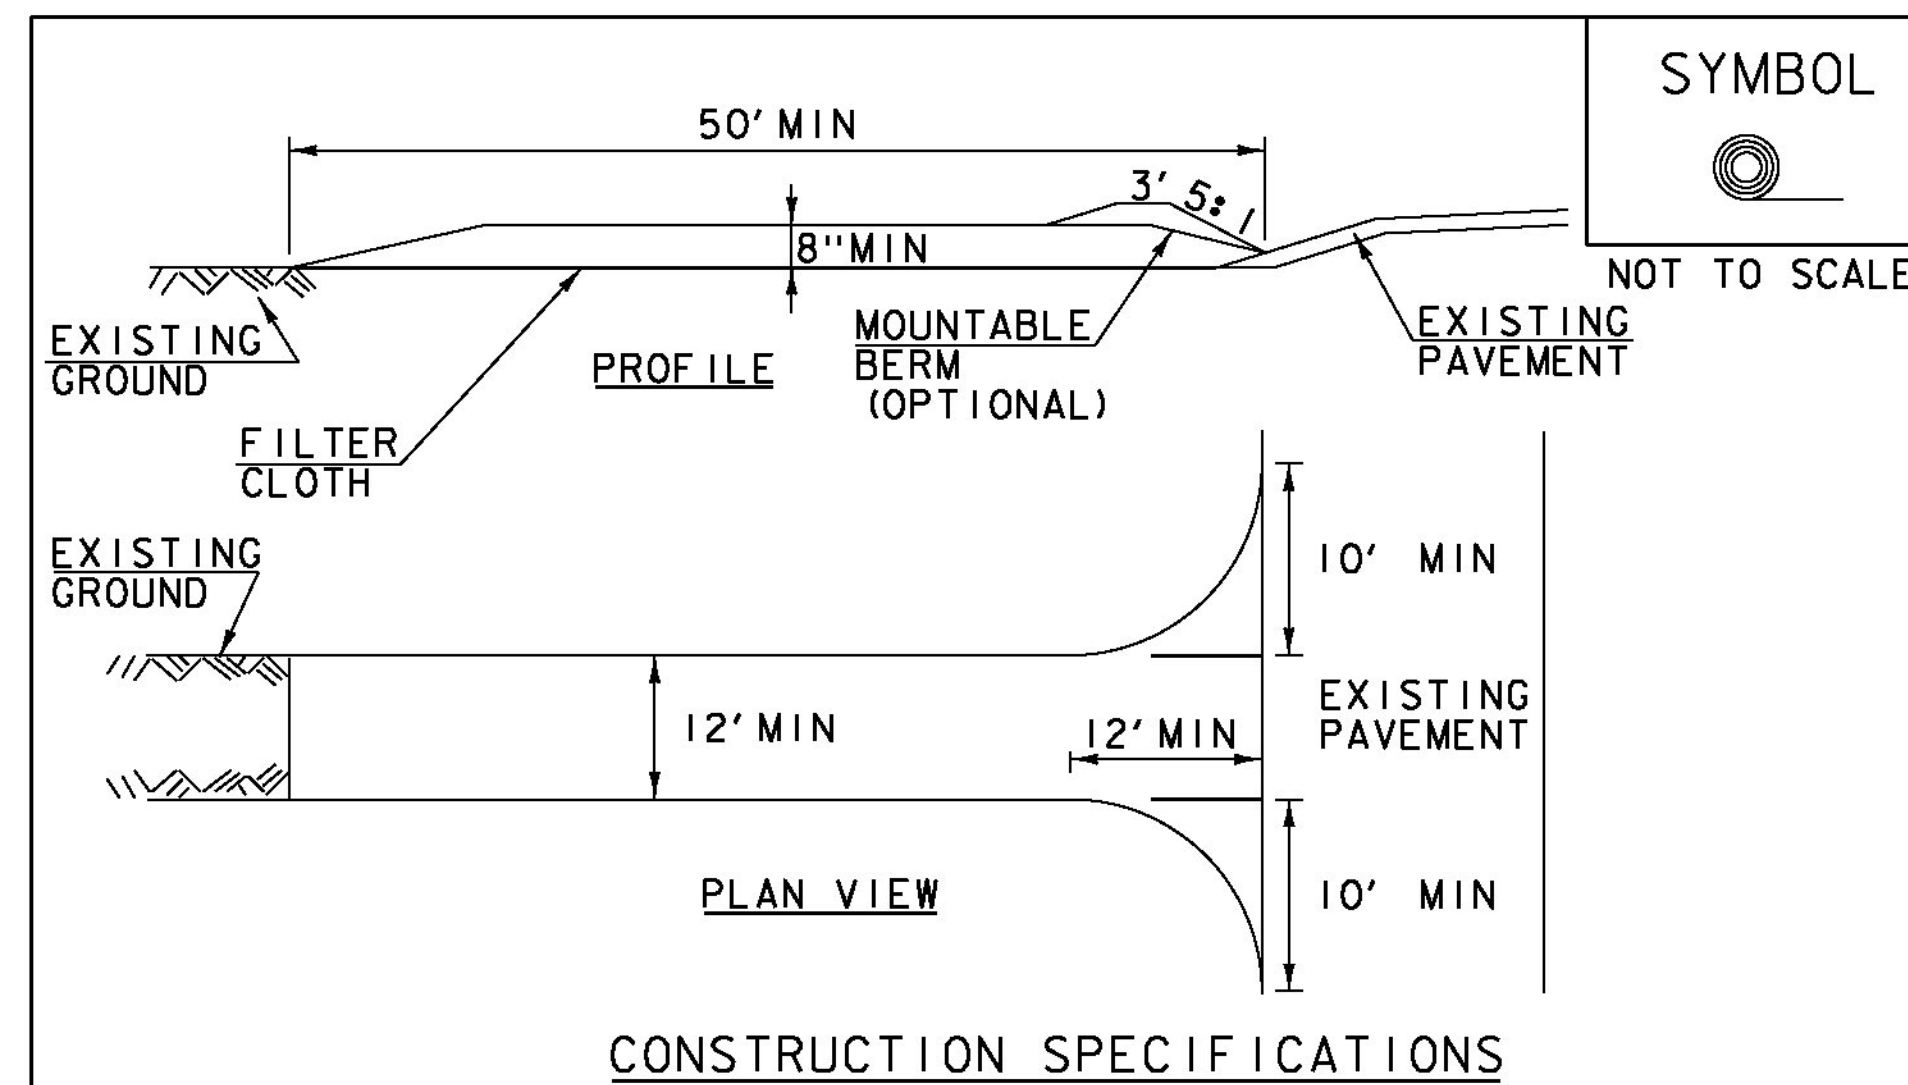

**CONSTRUCTION SPECIFICATIONS**

- STONE SIZE- USE 1-4" STONE, RECLAIMED OR RECYCLED CONCRETE EQUIVALENT.
- LENGTH- NOT LESS THAN 50' (EXCEPT ON A SINGLE RESIDENCE LOT WHERE A 30' MINIMUM LENGTH APPLIES).
- THICKNESS- NOT LESS THAN 8".
- WIDTH- 12' MINIMUM, BUT NOT LESS THAN THE FULL WIDTH AT POINTS WHERE INGRESS OR EGRESS OCCURS. 24' IF SINGLE ENTRANCE TO SITE.
- GEOTEXTILE MUST BE PLACED OVER THE ENTIRE AREA PRIOR TO PLACING STONE.
- SURFACE WATER- ALL SURFACE WATER FLOWING OR DIVERTED TOWARD CONSTRUCTION ENTRANCES SHALL BE PIPED BENEATH THE ENTRANCE. IF PIPING IS IMPRACTICAL, A MOUNTABLE BERM WITH 5:1 SLOPES WILL BE PERMITTED.
- MAINTENANCE- THE ENTRANCE SHALL BE MAINTAINED IN A CONDITION WHICH WILL PREVENT TRACKING OR FLOWING OF SEDIMENT ONTO PUBLIC RIGHTS-OF-WAY, ALL SEDIMENT SPILLED, DROPPED, WASHED OR TRACKED ONTO PUBLIC RIGHTS-OF-WAY MUST BE REMOVED IMMEDIATELY.
- WHEN WASHING IS REQUIRED, IT SHALL BE DONE ON AN AREA STABILIZED WITH STONE AND WHICH DRAINS INTO AN APPROVED SEDIMENT TRAPPING DEVICE.
- PERIODIC INSPECTION AND NEEDED MAINTENANCE SHALL BE PROVIDED ACCORDING TO PERMIT REQUIREMENTS.


ADAPTED FROM DETAILS PROVIDED BY: NEW YORK STATE DEC  
ORIGINALLY DEVELOPED BY USDA-NRCS  
VERMONT DEPARTMENT OF ENVIRONMENTAL CONSERVATION

**STABILIZED CONSTRUCTION ENTRANCE**

NOTES:  
REFER TO "THE VERMONT STANDARDS & SPECIFICATIONS FOR EROSION PREVENTION & SEDIMENT CONTROL -2006- "FROM THE VT AGENCY OF NATURAL RESOURCES FOR ADDITIONAL GUIDANCE.

THIS WORK SHALL BE PERFORMED IN ACCORDANCE WITH SECTION 653 FOR VEHICLE TRACKING PAD (PAY ITEM 653.35) OR AS SPECIFIED IN THE CONTRACT.

REVISIONS		
MARCH 24, 2008	WHF	
JANUARY 13, 2009	WHF	

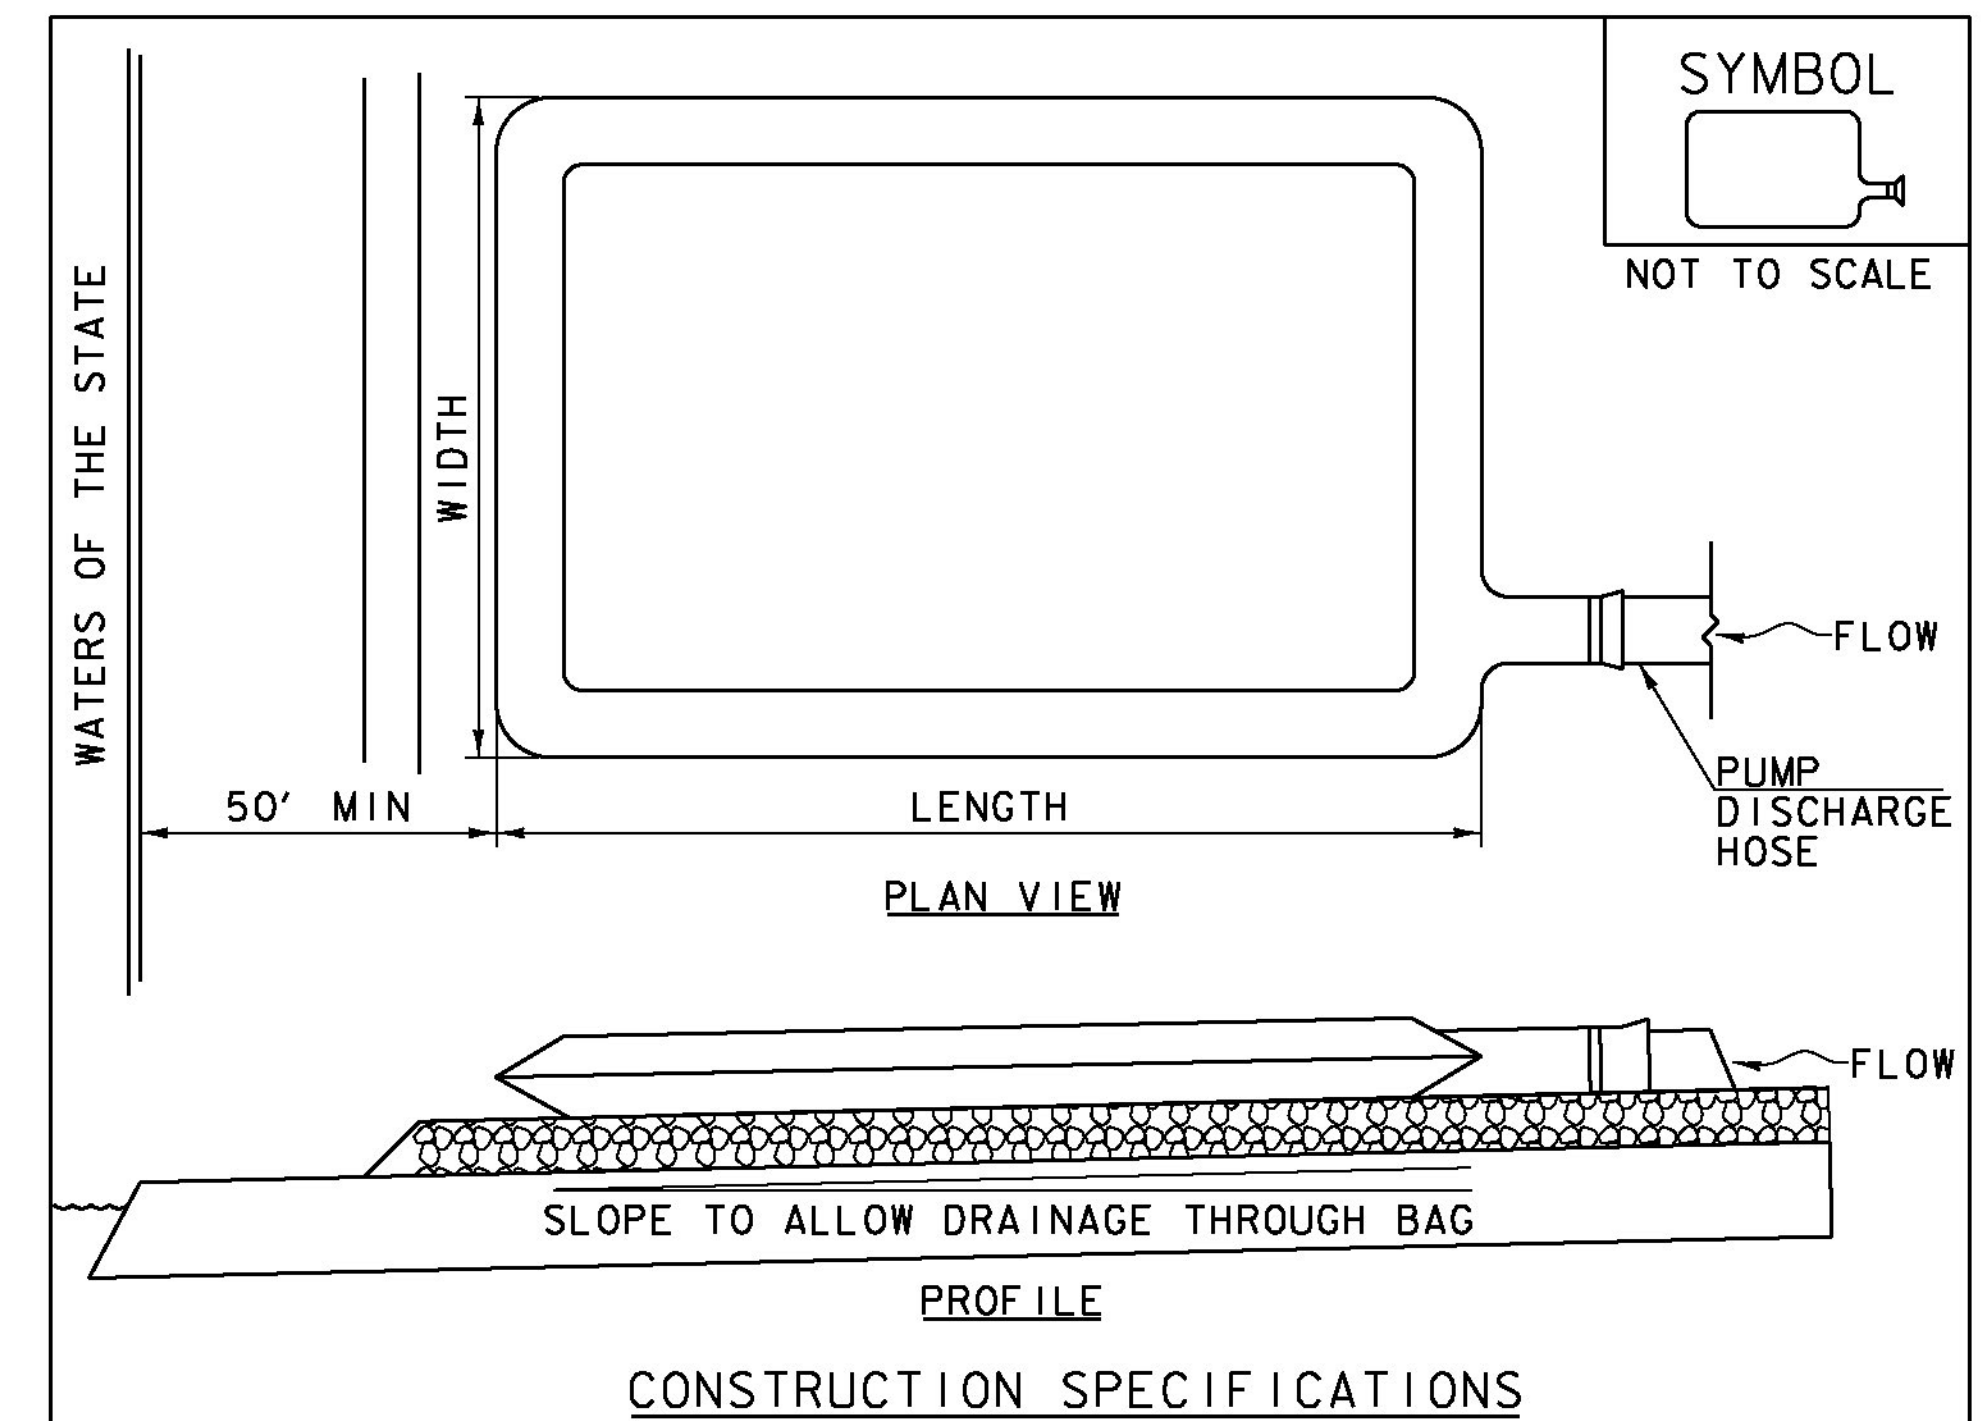

**CONSTRUCTION SPECIFICATIONS**

- THE PRIMARY PURPOSE OF FILTER BAG IS TO RETAIN SILT, SAND, AND FINES DURING DEWATERING OPERATIONS.
- FILTER BAGS SHALL BE INSTALLED ON A VEGETATED SLOPE GRADED TO ALLOW INCOMING WATER TO FLOW THROUGH THE BAG.
- FILTER BAGS MAY ALSO BE PLACED ON COARSE AGGREGATE, STONE, OR HAYBALES TO INCREASE FILTRATION EFFICIENCY.
- FILTER BAGS SHALL BE LOCATED A MINIMUM OF 50' FROM WATERS OF THE STATE UNLESS OTHERWISE APPROVED BY THE ENGINEER.
- THE NECK OF THE FILTER BAG SHALL BE STRAPPED TIGHTLY TO THE DISCHARGE HOSE.
- A FILTER BAG IS FULL WHEN IT NO LONGER CAN EFFICIENTLY FILTER SEDIMENT OR ALLOW WATER TO PASS AT A REASONABLE RATE.
- FILTER BAG SHALL BE DISPOSED OF AS APPROVED IN THE EPSC PLAN OR AS DIRECTED BY THE ENGINEER.

NOTES:  
REFER TO "THE VERMONT STANDARDS & SPECIFICATIONS FOR EROSION PREVENTION & SEDIMENT CONTROL -2006- "FROM THE VT AGENCY OF NATURAL RESOURCES FOR ADDITIONAL GUIDANCE.

THIS WORK SHALL BE PERFORMED IN ACCORDANCE WITH SECTION 653 FOR FILTER BAG (PAY ITEM 653.45) AND AS SPECIFIED IN THE CONTRACT.



REVISIONS		
MARCH 24, 2008	WHF	
JANUARY 13, 2009	WHF	

PROJECT NAME: BRIDPORT  
PROJECT NUMBER: STP CULV(29)

FILE NAME: zllc264epsc det_br5.dgn PLOT DATE: 8/22/2014  
PROJECT LEADER: M. CHENETTE DRAWN BY: L. BUXTON  
DESIGNED BY: J. HUNGERFORD CHECKED BY: M. CHENETTE  
EROSION CONTROL DETAILS - ECD 2 - BR5 SHEET 55 OF 57




**IMPACTS BELOW ORDINARY HIGH WATER**

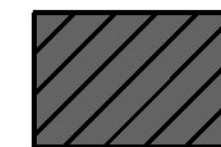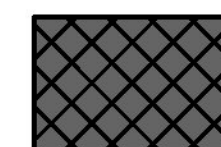
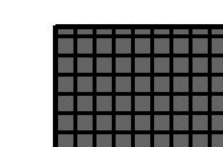
	TEMPORARY IMPACTS BELOW OHW#:	416 SF
	PERMANENT IMPACTS BELOW OHW#:	587 SF

TOTAL IMPACTS: 1003 SF

ASSUMED 25' x 25' TEMPORARY WORK AREA FOR IMPOUNDMENT AND/OR STREAM DIVERSION.

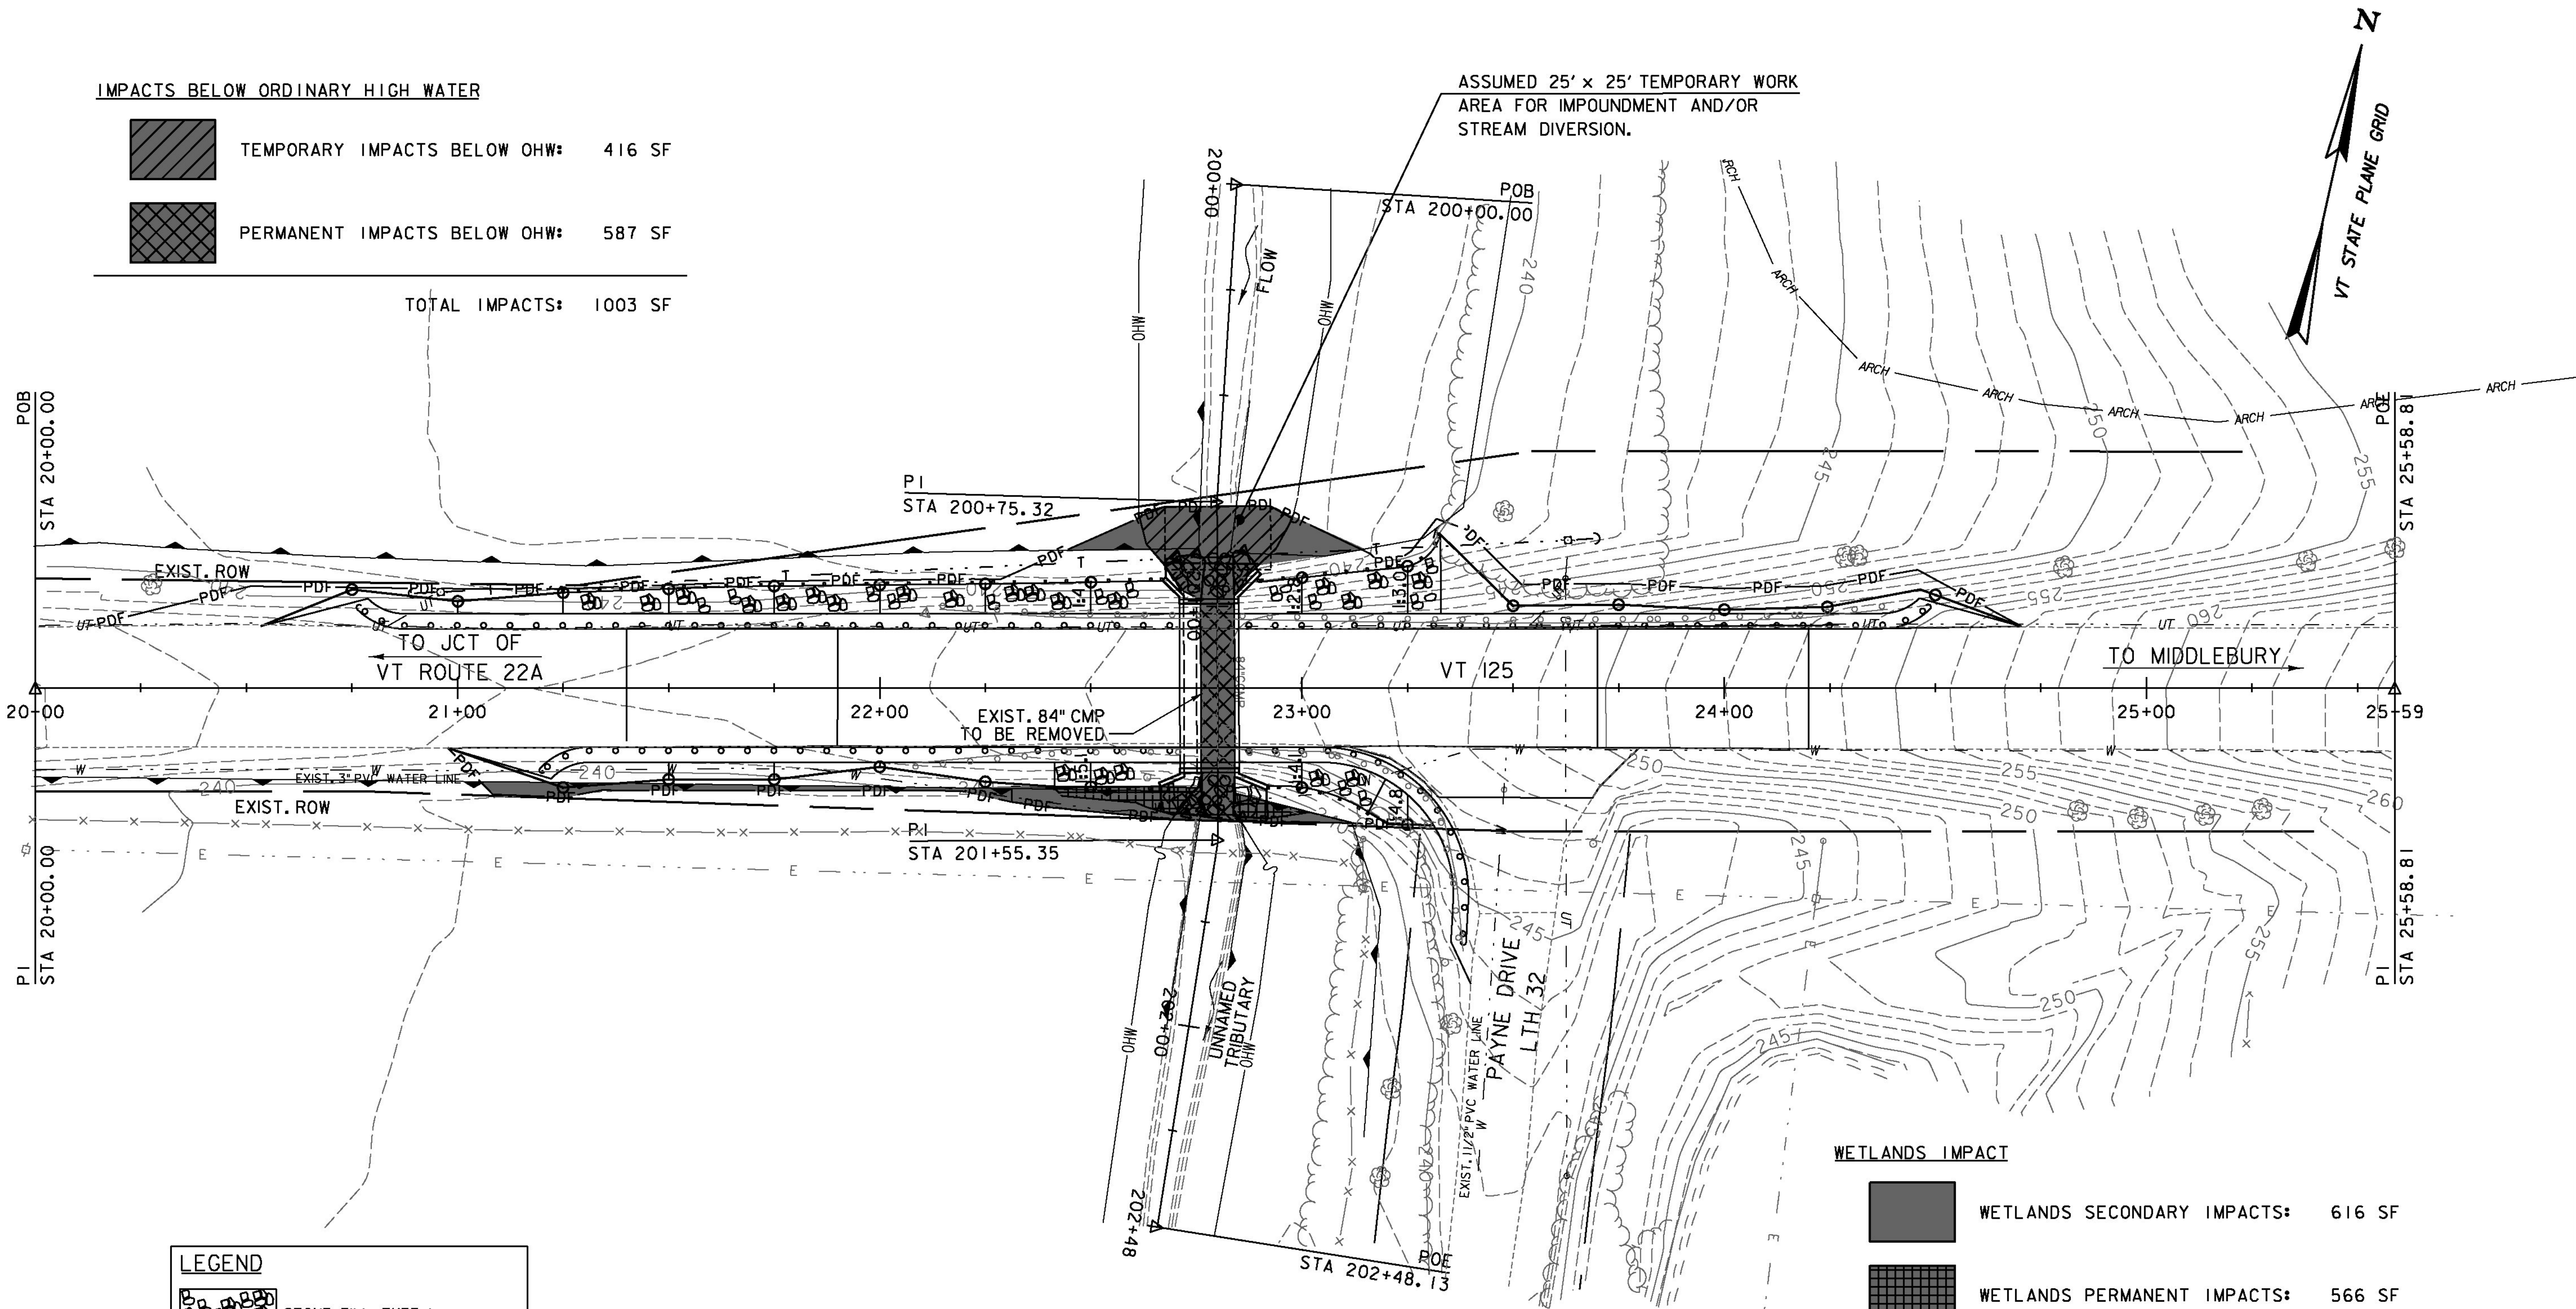


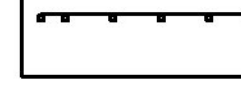



**WETLANDS IMPACT**

	WETLANDS SECONDARY IMPACTS#:	616 SF
	WETLANDS PERMANENT IMPACTS#:	566 SF

TOTAL IMPACTS: 1182 SF

**LEGEND**

	STONE FILL, TYPE I
	STONE FILL, TYPE II
	SPECIAL PROVISION (STONE FILL, CULVERT LINING)
	SPECIAL PROVISION (WILDLIFE GUIDE FENCE)

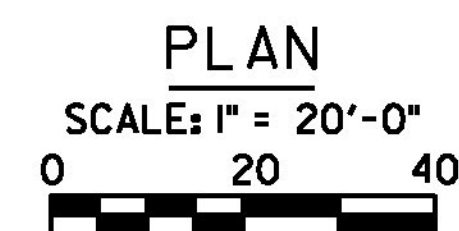


PROJECT NAME: BRIDPORT  
PROJECT NUMBER: STP CULV(29)

FILE NAME: zllc264bdr_impacts_br5.l.dgn  
PROJECT LEADER: M. CHENETTE  
DESIGNED BY: J. HUNGERFORD  
PROJECT IMPACTS PLAN I - BR5


PLOT DATE: 8/22/2014  
DRAWN BY: L. BUXTON  
CHECKED BY: M. CHENETTE  
SHEET 56 OF 57



**WETLANDS BUFFER IMPACTS**

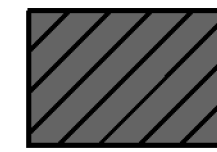


WETLANDS BUFFER SECONDARY IMPACTS: 2403 SF

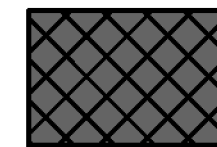

WETLANDS BUFFER PERMANENT IMPACTS: 2051 SF

TOTAL IMPACTS: 4454 SF

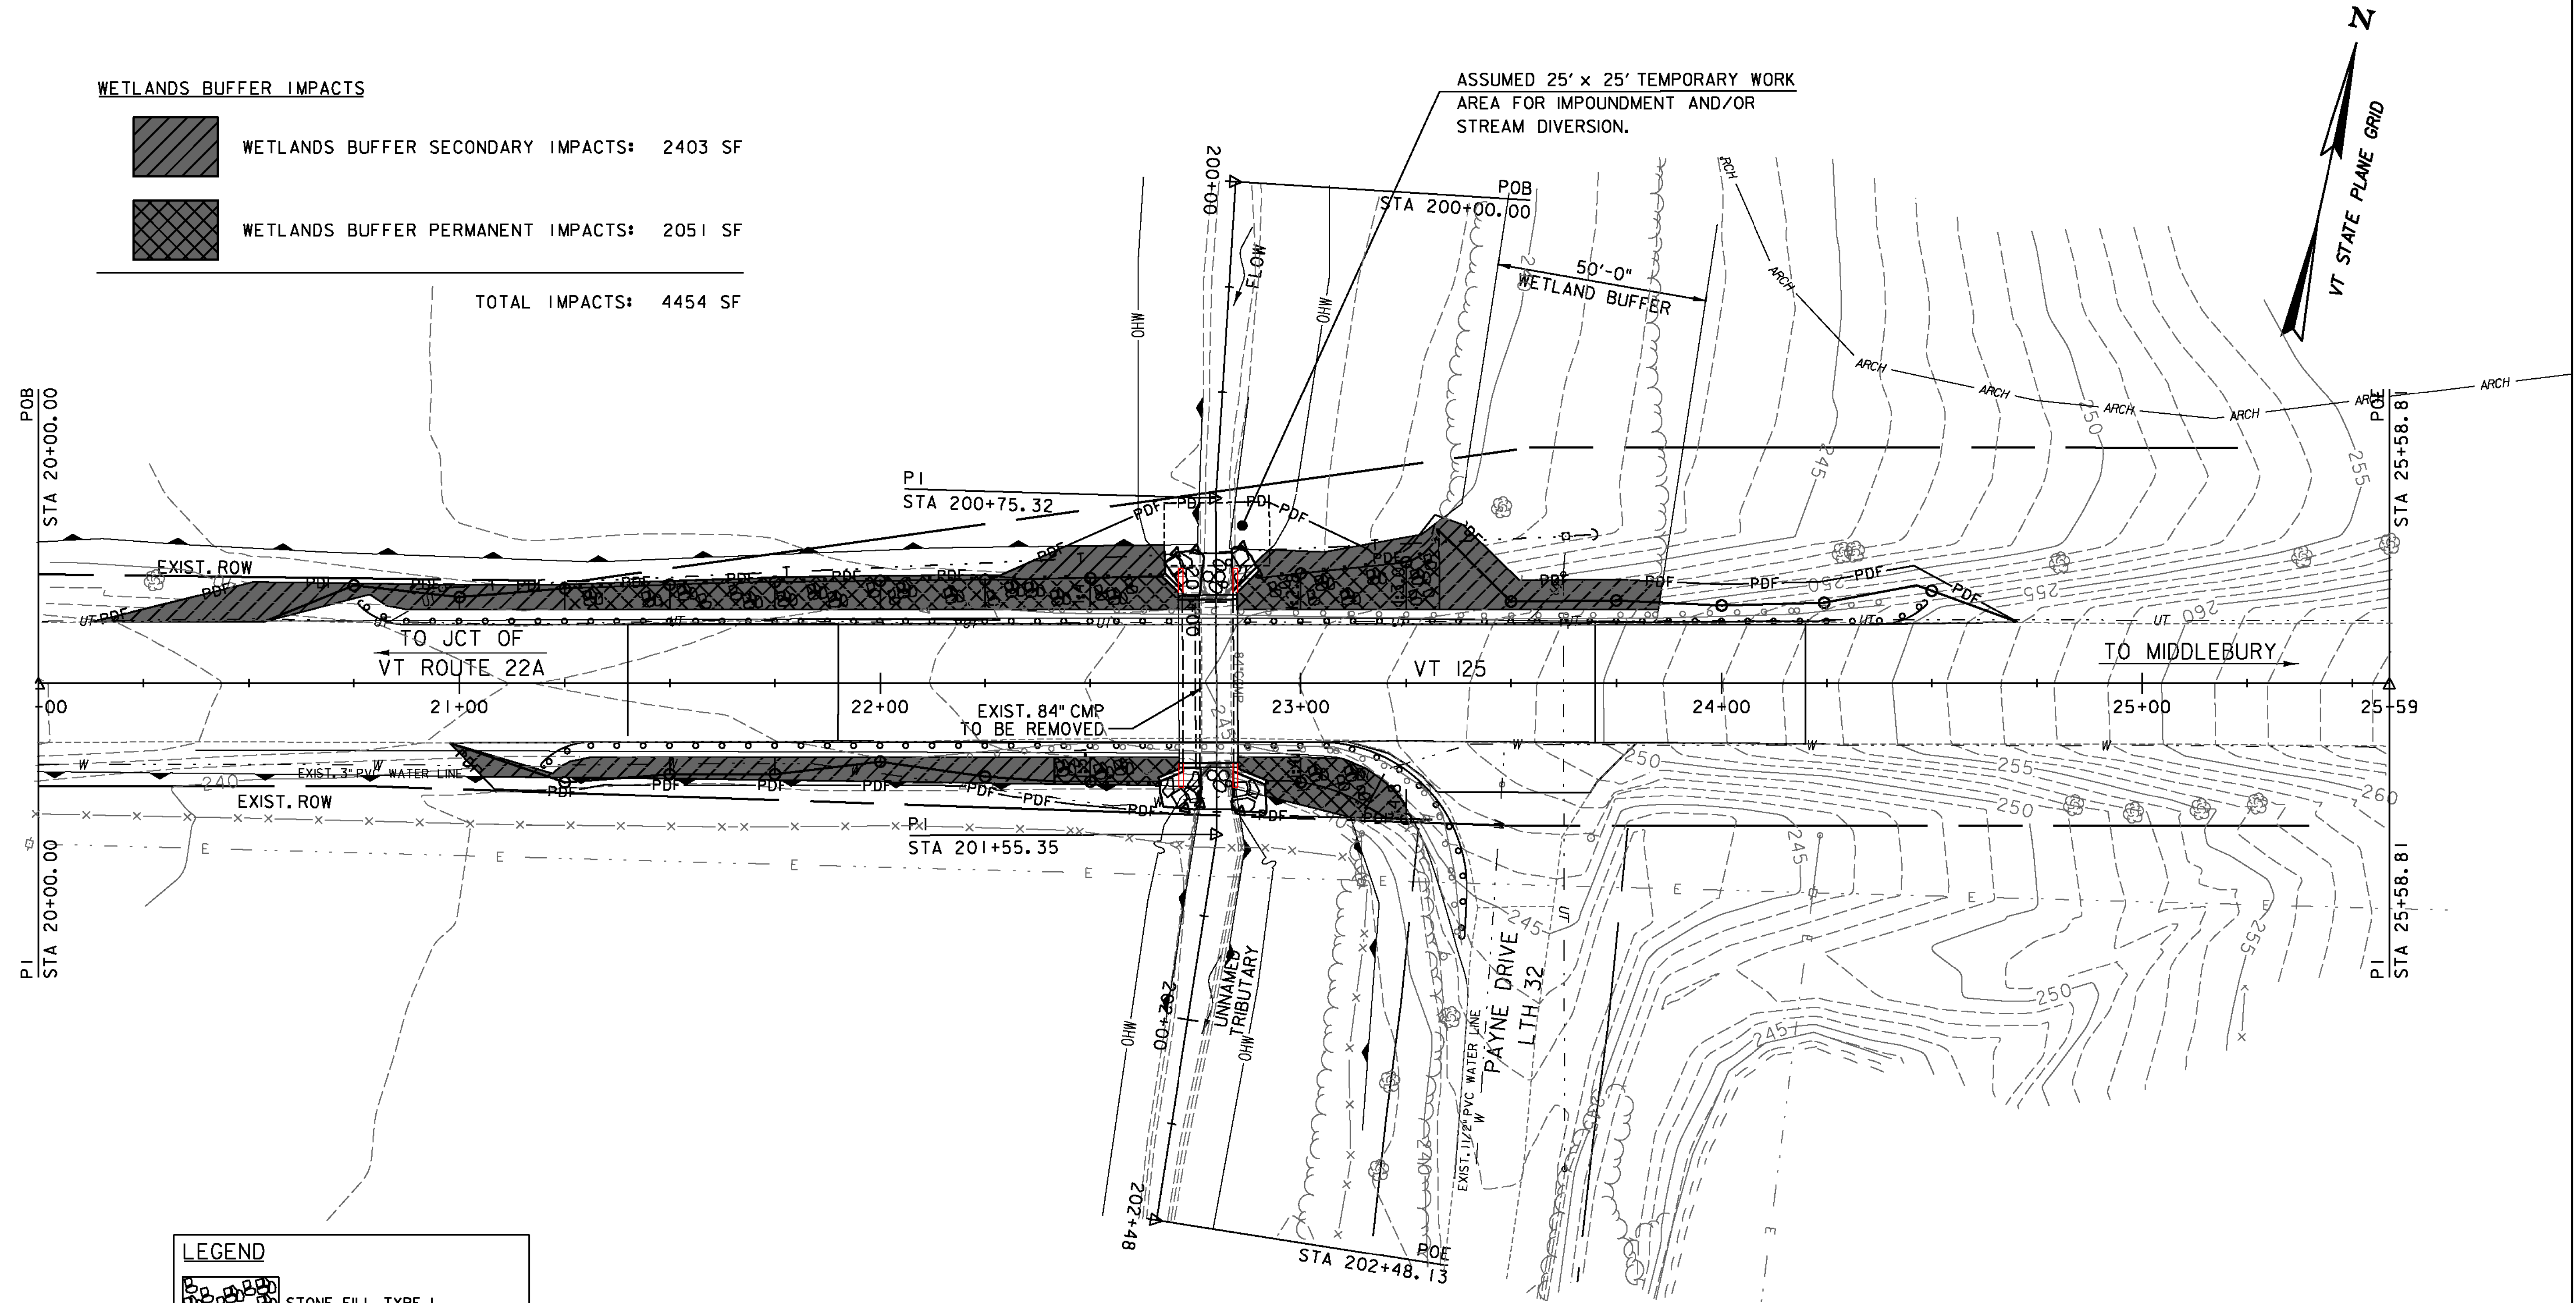


**LEGEND**

- STONE FILL, TYPE I
- STONE FILL, TYPE II
- SPECIAL PROVISION (STONE FILL, CULVERT LINING)
- SPECIAL PROVISION (WILDLIFE GUIDE FENCE)


**PLAN**  
 SCALE: 1" = 20'-0"

PROJECT NAME: BRIDPORT	PLOT DATE: 8/22/2014
PROJECT NUMBER: STP CULV(29)	DRAWN BY: L. BUXTON
FILE NAME: zllc264bdr_impacts_br5.2.dgn	CHECKED BY: M. CHENETTE
PROJECT LEADER: M. CHENETTE	SHEET 57 OF 57
DESIGNED BY: J. HUNGERFORD	
PROJECT IMPACTS PLAN 2 - BR5	




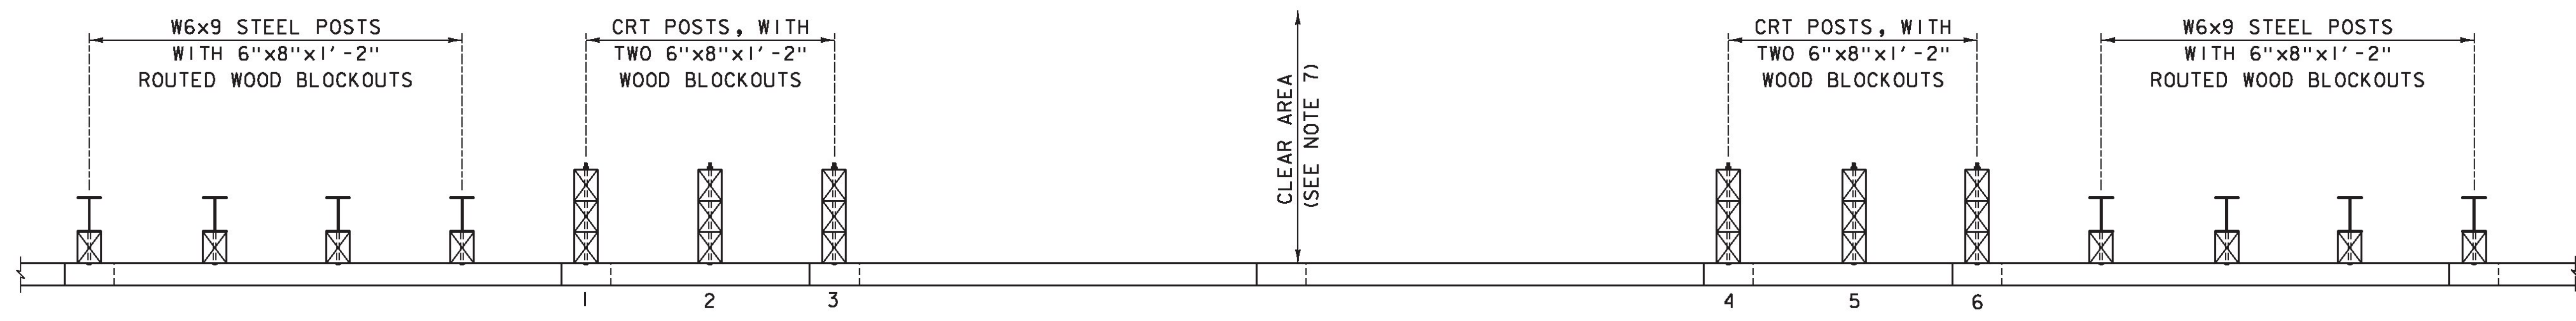

**LONGSPAN STEEL BEAM GUARDRAIL PLAN**

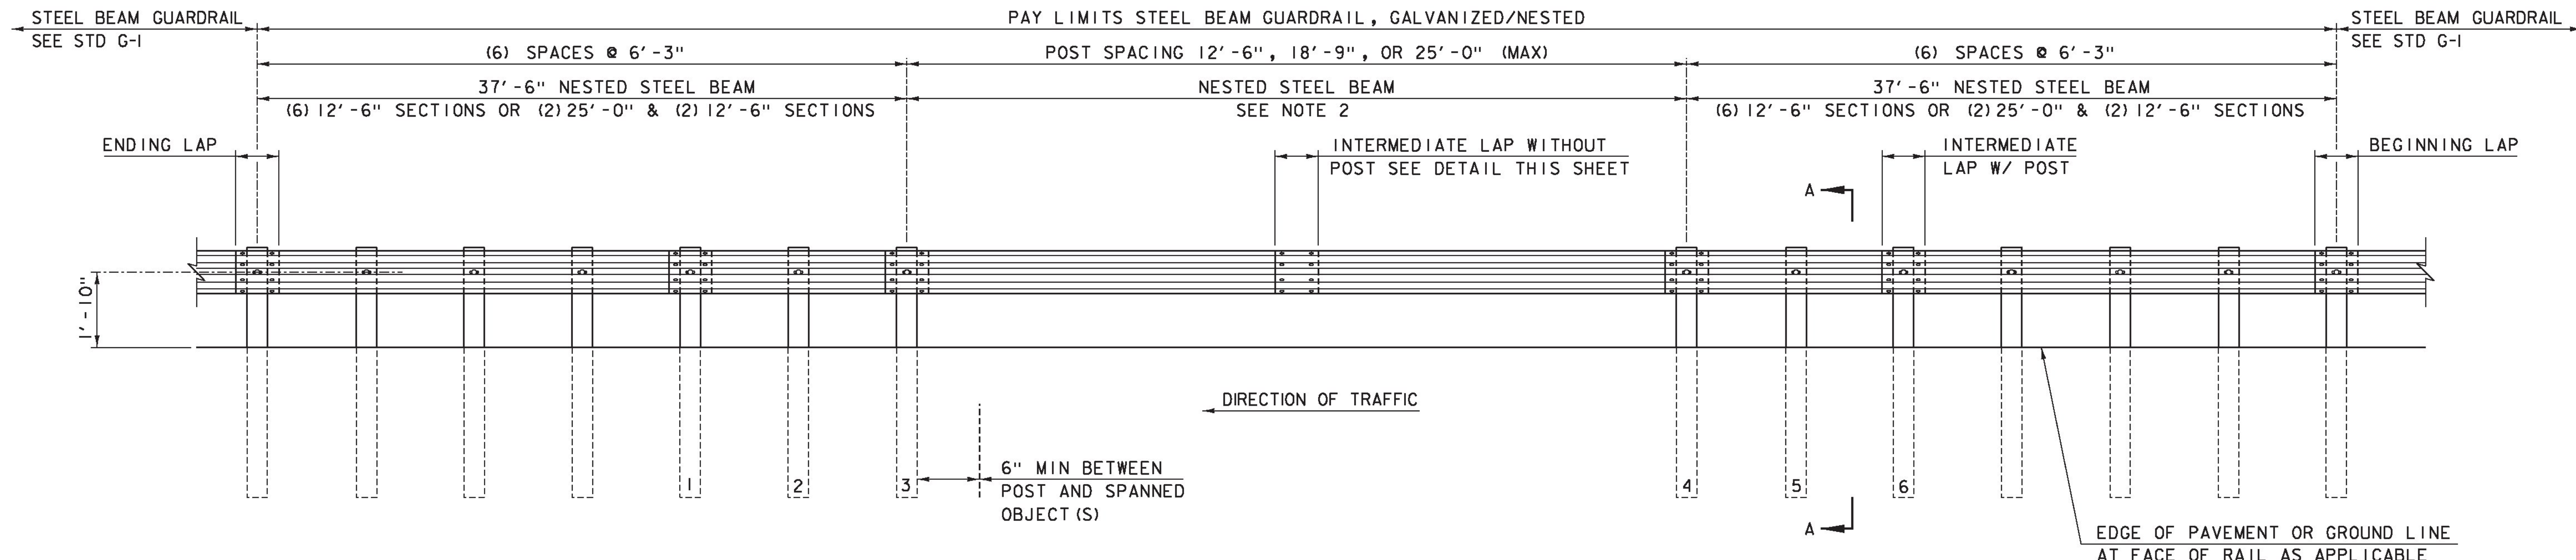


**LONGSPAN STEEL BEAM GUARDRAIL ELEVATION**

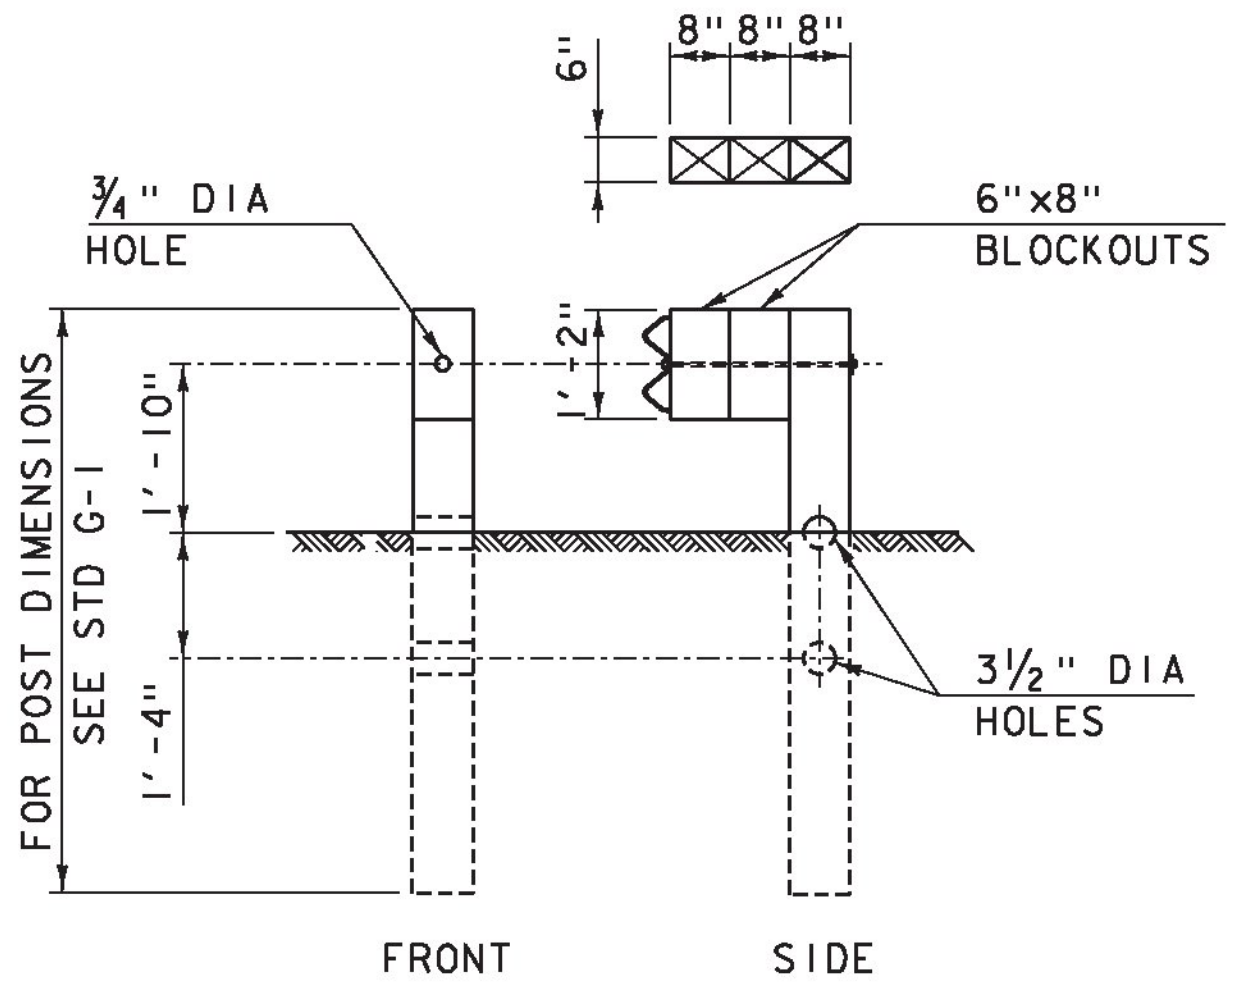

**SECTION A-A**

SECTION A-A TYPICAL FOR POST 1-6.  
SEE NOTES 3 AND 4

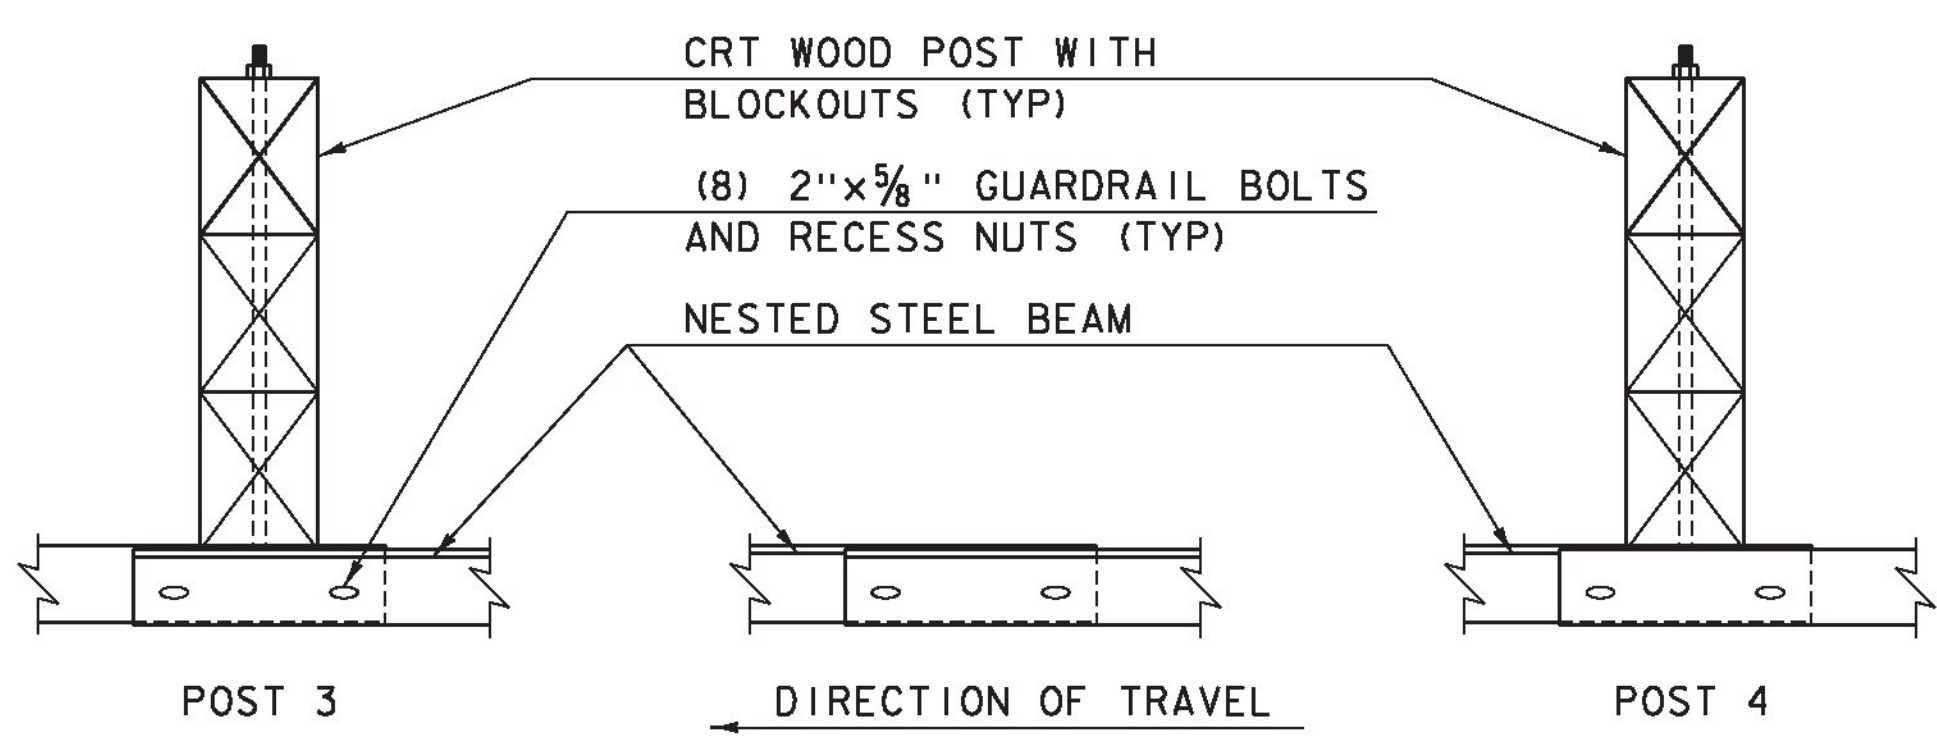


**INTERMEDIATE LAP WITHOUT POST**

**NOTES:**

1. RAIL MEETS TEST LEVEL 3 REQUIREMENTS OF NCHRP REPORT 350.
2. THERE SHALL BE NO MORE THAN ONE SPLICE IN THE LONGSPAN LOCATION.
3. POSTS 1 THRU 6 ARE BREAKAWAY CONTROLLED RELEASING TERMINAL (CRT) POSTS.
4. POSTS 1 THRU 6 HAVE TWO 6"x8" BLOCKOUTS.
5. ON POSTS 1 THRU 6, GUARDRAIL BOLT "D", AS SHOWN ON STD G1, SHALL BE 26" LONG.
6. ON ALL POSTS WHERE THE RAIL IS NESTED GUARDRAIL BOLT "A", AS SHOWN ON STD G1, SHALL BE 2" LONG.
7. CLEAR AREA BEHIND BACK OF RAIL SHALL BE: 5'-0" MINIMUM FOR OBSTRUCTIONS LESS THAN OR EQUAL TO THE HEIGHT OF RAIL. 6'-0" FOR OBSTRUCTIONS TALLER THAN THE TOP OF RAIL.
8. W6x9 STEEL POST MAY BE REPLACED WITH CRT WOOD POST WITH THE APPROVAL OF THE ENGINEER.
9. ALL MATERIALS NECESSARY FOR THE ASSEMBLY OF THE RAIL MUST MEET THE REQUIREMENTS OF STD G-1 UNLESS OTHERWISE NOTED.
10. GUARDRAIL SECTIONS SHALL BE LAPPED IN THE DIRECTION OF TRAFFIC FLOW FOR THE LANE NEAREST THE GUARDRAIL.

REVISIONS	
NOVEMBER 25, 2013	APPROVED FOR USE BY VAOT STRUCTURES SECTION
JANUARY 3, 2014	APPROVED FOR USE BY VAOT STRUCTURES SECTION

**LONGSPAN  
STEEL BEAM GUARDRAIL,  
GALVANIZED**

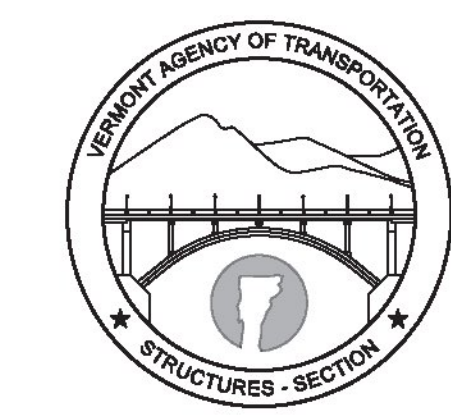

**STRUCTURES  
DETAIL  
SD-366.00**

# Proposed Bridge Improvement Project

## Bridport STP CULV(29)

### Bridge #2

Vermont Agency of Transportation

**RECEIVED**

ON: April 28, 2015

and Checked for

**CONFORMANCE**

BY: Mark Sargent DATE: 04/29/2015

**Concrete:**

Mix Designation: P60TER

1. Specified Mix Design - 5000 PSI
2. Proposed Mix Design - 6000 PSI
3. Striping Strength - 3000 PSI
4. Handling Strength - 3000 PSI
5. Shipping Strength - 5000 PSI
6. Install Strength - 5000 PSI
7. Traffic Loading - 5000 PSI

Fabrication Tolerances:

1. Width ±1/4"
2. Height ±1/4"
3. Length ±1/2"
4. Rebar Cover 2" Min. (Unless Noted Otherwise)
5. Rebar Spacing ±1"
6. Rebar Clearance ±1/4"
7. Insert Placement ±1/4"

Design Notes:

1. Design is in accordance w/ ASTM C1577, PCI MNL135, VAOT540 & AASHTO 2012 LRFD bridge design specs fifth edition
2. Any conflict between tolerances listed above shall result in the usage of the stricter tolerance
3. Design live load = HL-93
4. Materials and manufacturing shall conform to ASTM C1433
5. Earth Cover: ± 15'-0"

**Installation:**

1. Sub Base for Box Culvert / Cut Off Walls to be Compacted and Level
2. Precast Cut Off Walls + Wing Walls to be installed
3. All Elevations are to be Checked and Verified they Match Those of Plan Set
4. Begin Sequence of Installing All Box Culvert Sections
5. Clean Granular Backfill for structures used for Backfill of Footers & of Box Culvert so water can reach weep holes if applicable
6. Fill all Lifting Holes, Bolt Pockets and Box Culvert grooves and seams w/ non-shrink grout. Applied by Site Contractor.
7. ASTM C1675-11 Box culvert installation guidelines shall be followed.

**Reinforcing:**

General Notes:

1. Reinforcing Steel -
  - a. Precast box sections, headwalls, wing walls, & cut off walls shall be level I uncoated bar ASTM A615
2. Materials and manufacturing shall conform to ASTM C1433

Tolerances:

1. Spacing ±1"
2. Clearance ±1/4"

Lap Lengths:

1. Per AASHTO 5.11.2.1.1 & 5.11.5.3.1


**Joint Treatment:**

Vertical Seams:

- Per VTrans approved product list 780.02  
Overhead & vertical concrete repair mortar  
Applied by site contractor

Horizontal Seams / Grout:

- Per VTrans approved product list 707.03  
Mortar, type IV  
Applied by site contractor

REVIEWED	X	
REVIEWED AS MODIFIED		
REVISE AND RESUBMIT		
NOT REVIEWED		
Date: 4/24/2015		
By: Nathan Tirk		
This review by Stantec Consulting Services Inc. is for the sole purpose of ascertaining conformance with the general design concept. This review shall not mean that Stantec Consulting Services Inc. approves the detail design inherent in the shop drawings, responsibility for which shall remain with the Contractor. Submitting same, and such review shall not relieve the Contractor of his responsibility for errors or omissions in the shop drawing or of his responsibility for meeting all requirements of the Contract Documents. The contractor is responsible for dimensions to be confirmed and correlated at the job site, for information that pertains solely to the fabrication processes or to techniques of construction and installation and for coordination of the work of all subtrades.		

**Waterproofing:**

1. Silane sealer applied in precast yard on all exposed surfaces (headwalls and top of wingwalls.)

**Miscellaneous:**

1. All bolt pocket hardware & wingwall hardware to be uncoated, black steel & shall remain in place.
2. All exposed edges of concrete shall be chamfered.
3. Concrete leveling pad for the cutoff walls is to be poured on site by the site contractor.
4. All lift anchors and embedded items will be made in America.

**Legend:**

- (A) 3"Ø PVC Sleeve
- (B) 4"Ø PVC Sleeve
- (C) Mechanical Bolt Pocket (w/ 1"Ø Coil Rod)
- (D) Oxford A750-7 Lifting Device -Allow 6" movement to avoid rebar conflicts
- (E) 1"Ø x 5 1/2" F56 Coil Loop Insert
- (F) 1 1/2" x 3 1/2" Continuous Keyway
- (G) Solid Lines Indicate 3/4" Chamfer
- (H) 3/8" F64 Ferrule Loop Insert

**STRUCTURAL DESIGN ONLY**




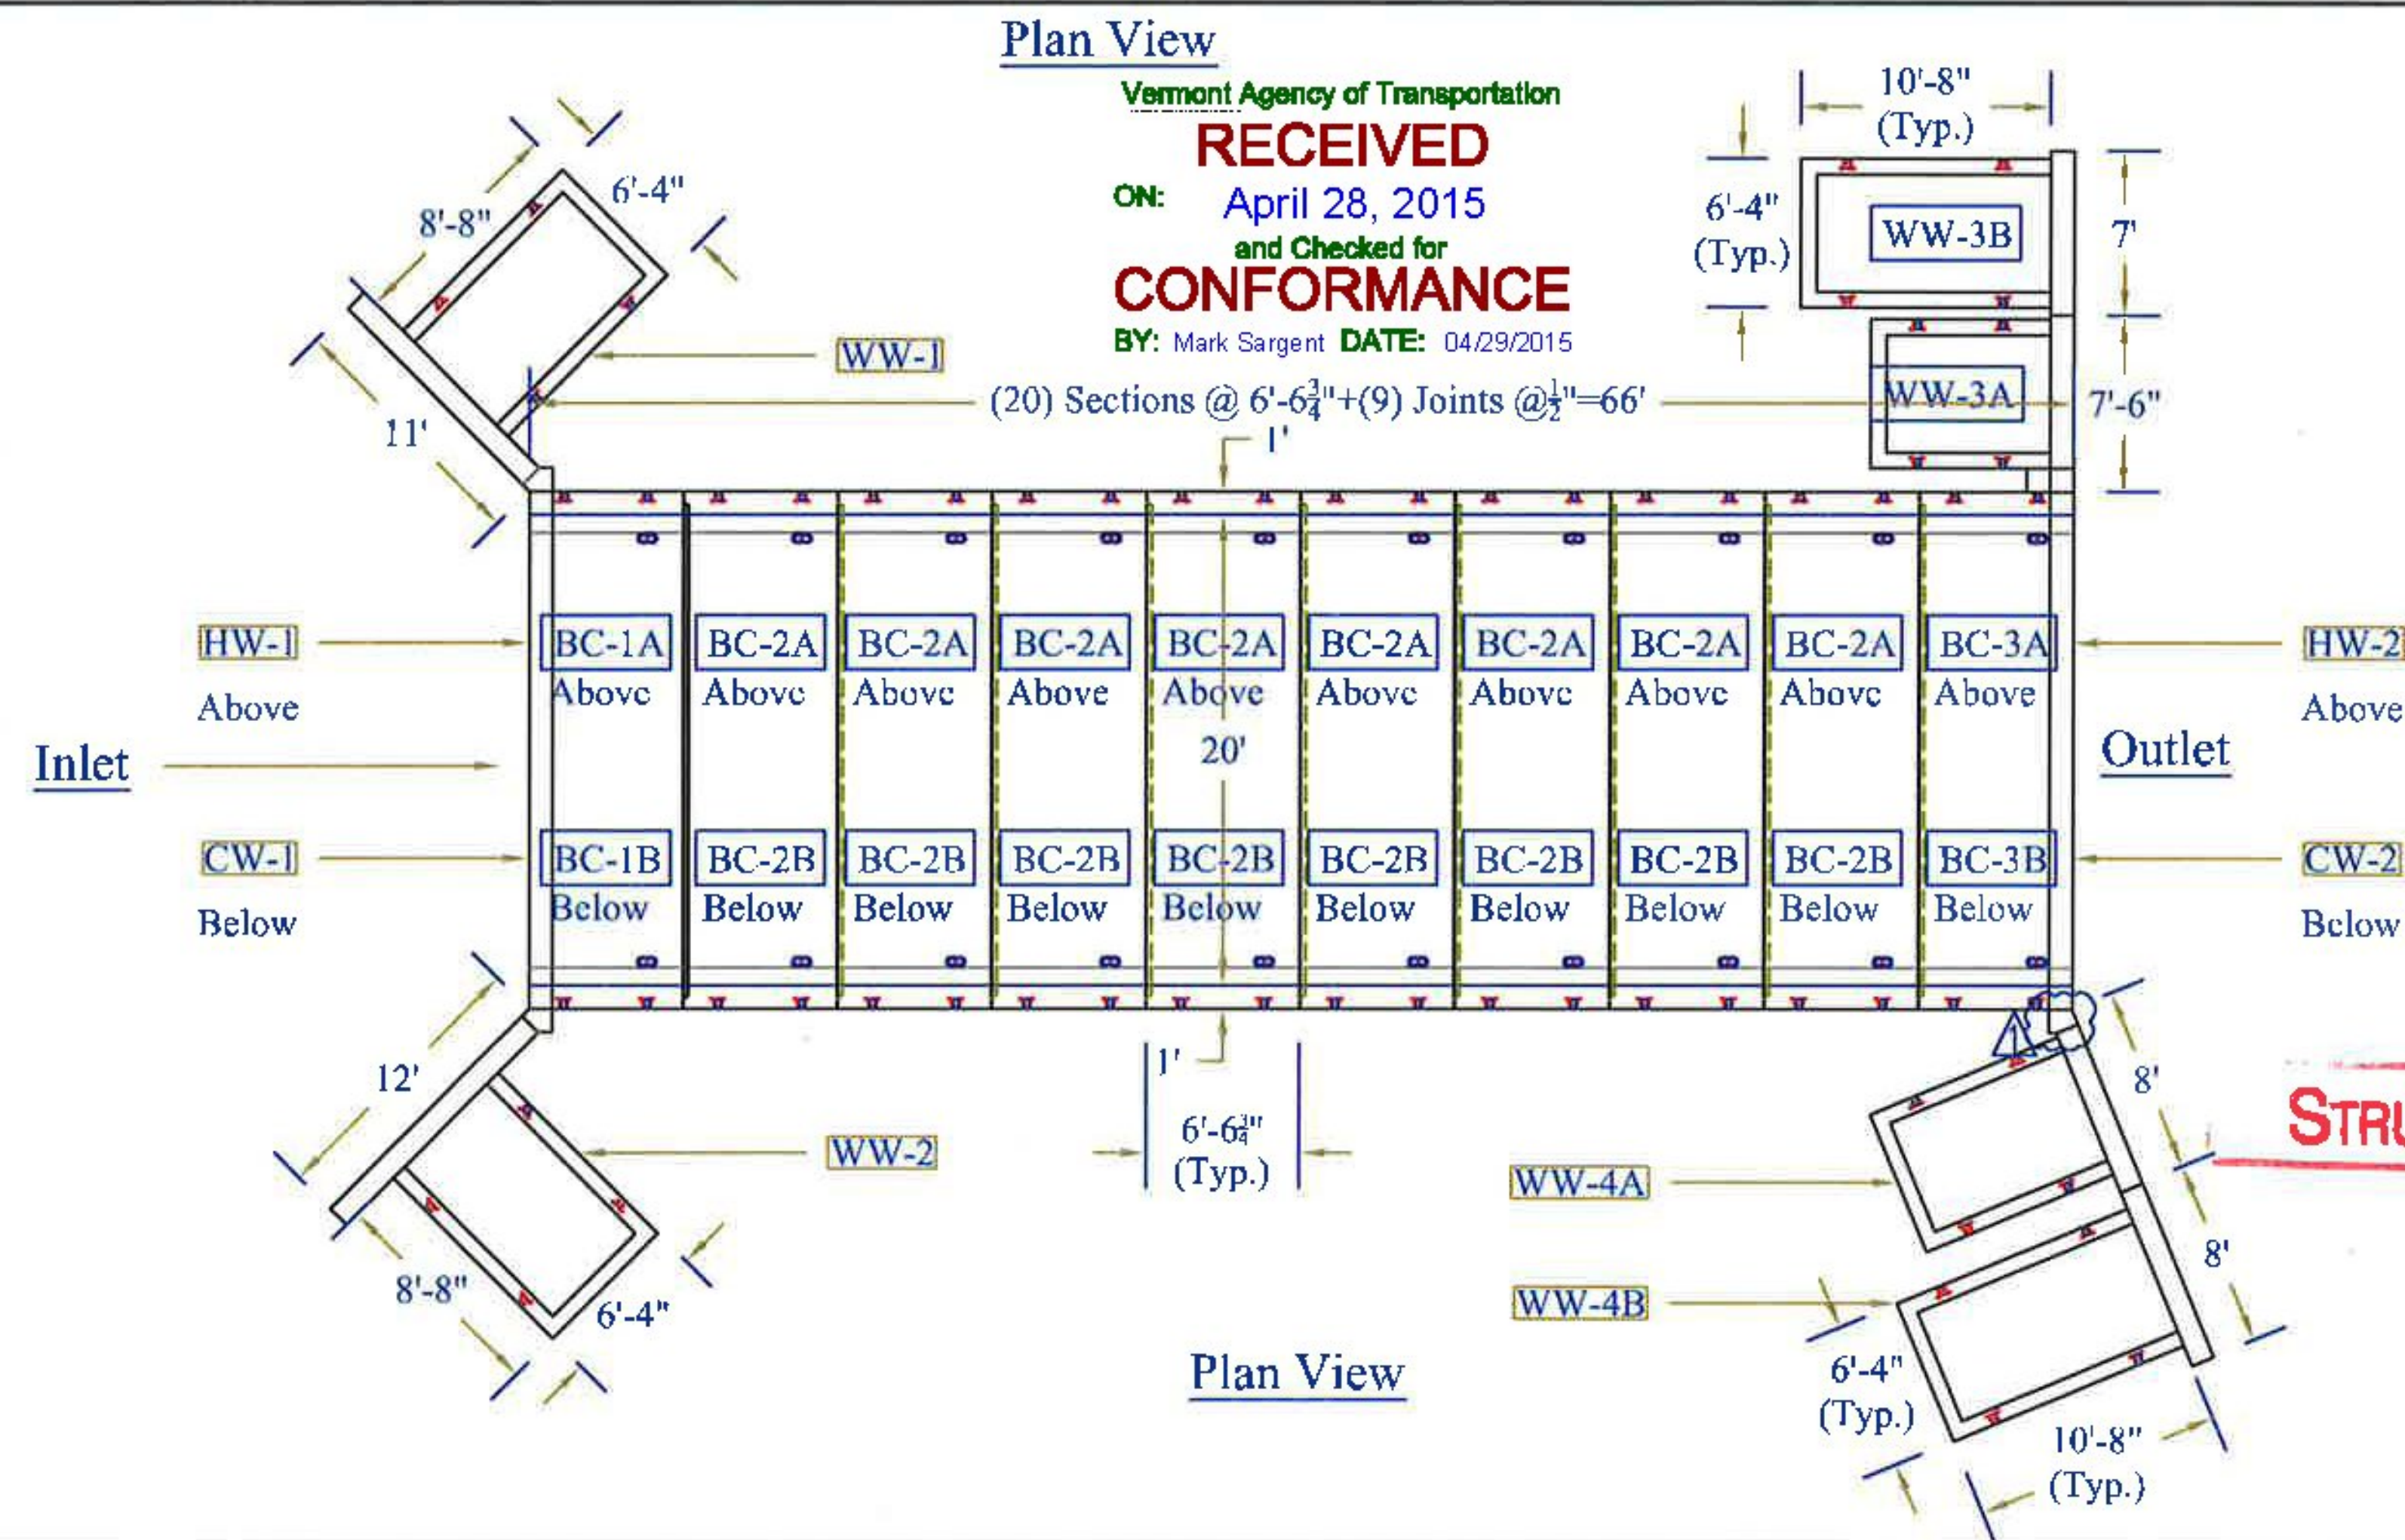
CONTRACTORS VISPE:		<table border="1" style="width: 100%; border-collapse: collapse;"> <tr> <th>Rev.</th> <th>Date</th> <th>By</th> <th>Description</th> </tr> <tr> <td>1</td> <td>03/25/15</td> <td>IBA</td> <td>Changes per Stantec &amp; State Review</td> </tr> <tr> <td>2</td> <td>04/23/15</td> <td>IBA</td> <td>Changes for Production Purposes</td> </tr> </table>	Rev.	Date	By	Description	1	03/25/15	IBA	Changes per Stantec & State Review	2	04/23/15	IBA	Changes for Production Purposes	PRECAST CONCRETE BOX CULVERT SHOP DRAWINGS (SDI JOB #15428) SUPERVISOR: E. Barendse DETAILER: I. ADAMS CHECKER: E. Barendse ENGINEER: G. K. Munkelt	PROJECT NAME: Bridport PROJECT #: CULV(29) Br.#2 LOCATION: Bridport, VT	Peckham Road Corp. 1557 St. Rt. 9, #3 Lake George, NY 12845 Ph: (518) 747-3353	FABRICATOR: 193 INDUSTRIAL AVE. WILLISTON, VT 05495 Ph: (802) 658-0201	
Rev.	Date	By	Description																
1	03/25/15	IBA	Changes per Stantec & State Review																
2	04/23/15	IBA	Changes for Production Purposes																
02/12/15						COVER_PAGE	1_OF_8												

Table of Units				
Name	Qty	Length	Vol.(CY)	Wt.(lbs.)*
BC-1A*	1	6'-6 $\frac{3}{4}$ "	12.17	50,000
BC-1B	1	6'-6 $\frac{3}{4}$ "	9.11	37,500
BC-2A	8	6'-6 $\frac{3}{4}$ "	9.11	37,500
BC-2B	8	6'-6 $\frac{3}{4}$ "	9.11	37,500
BC-3A*	1	6'-6 $\frac{3}{4}$ "	12.17	50,000
BC-3B	1	6'-6 $\frac{3}{4}$ "	9.11	37,500
WW-1	1	11'-0"	10.94	45,000
WW-2	1	12'-0"	11.81	48,500
WW-3A	1	7'-6"	10.35	42,500
WW-3B	1	7'-0"	9.78	40,100
WW-4A	1	8'-0"	10.80	44,250
WW-4B	1	8'-0"	10.38	42,600
CW-1	1	22'-0"	2.24	9,000
CW-2	1	22'-0"	2.24	9,000

* Headwall Included in BC-1A and BC-3A



REVIEWED	X
REVIEWED AS MODIFIED	
REVISE AND RESUBMIT	
NOT REVIEWED	

**Stantec**

Date: 4/24/2015

By: Nathan Tirk


This review by Stantec Consulting Services Inc. is for the sole purpose of ascertaining conformance with the general design concept. This review shall not constitute an approval of the design or construction. The Contractor shall remain responsible for the design and construction. The Contractor shall be responsible for meeting all requirements of the Contract Documents. The Contractor is responsible for dimensions to be confirmed and correlated at the job site, for information that pertains solely to the fabrication process or to techniques of construction and installation and for coordination of the work of all subcontractors.

Culvert Specifications	
Inside Dimensions	10'-0" x 20'-0"
Waterway Area	160 Sq. Ft.
Top Slab Thickness	15"
Side Wall Thickness	12"
Bottom Slab Thickness	15"

**STRUCTURAL DESIGN ONLY**

STATE OF VERMONT  
GARY K. MUNKELT  
REGISTERED PROFESSIONAL ENGINEER  
NO. 6291


Gary K. Munkelt  
4/28/15

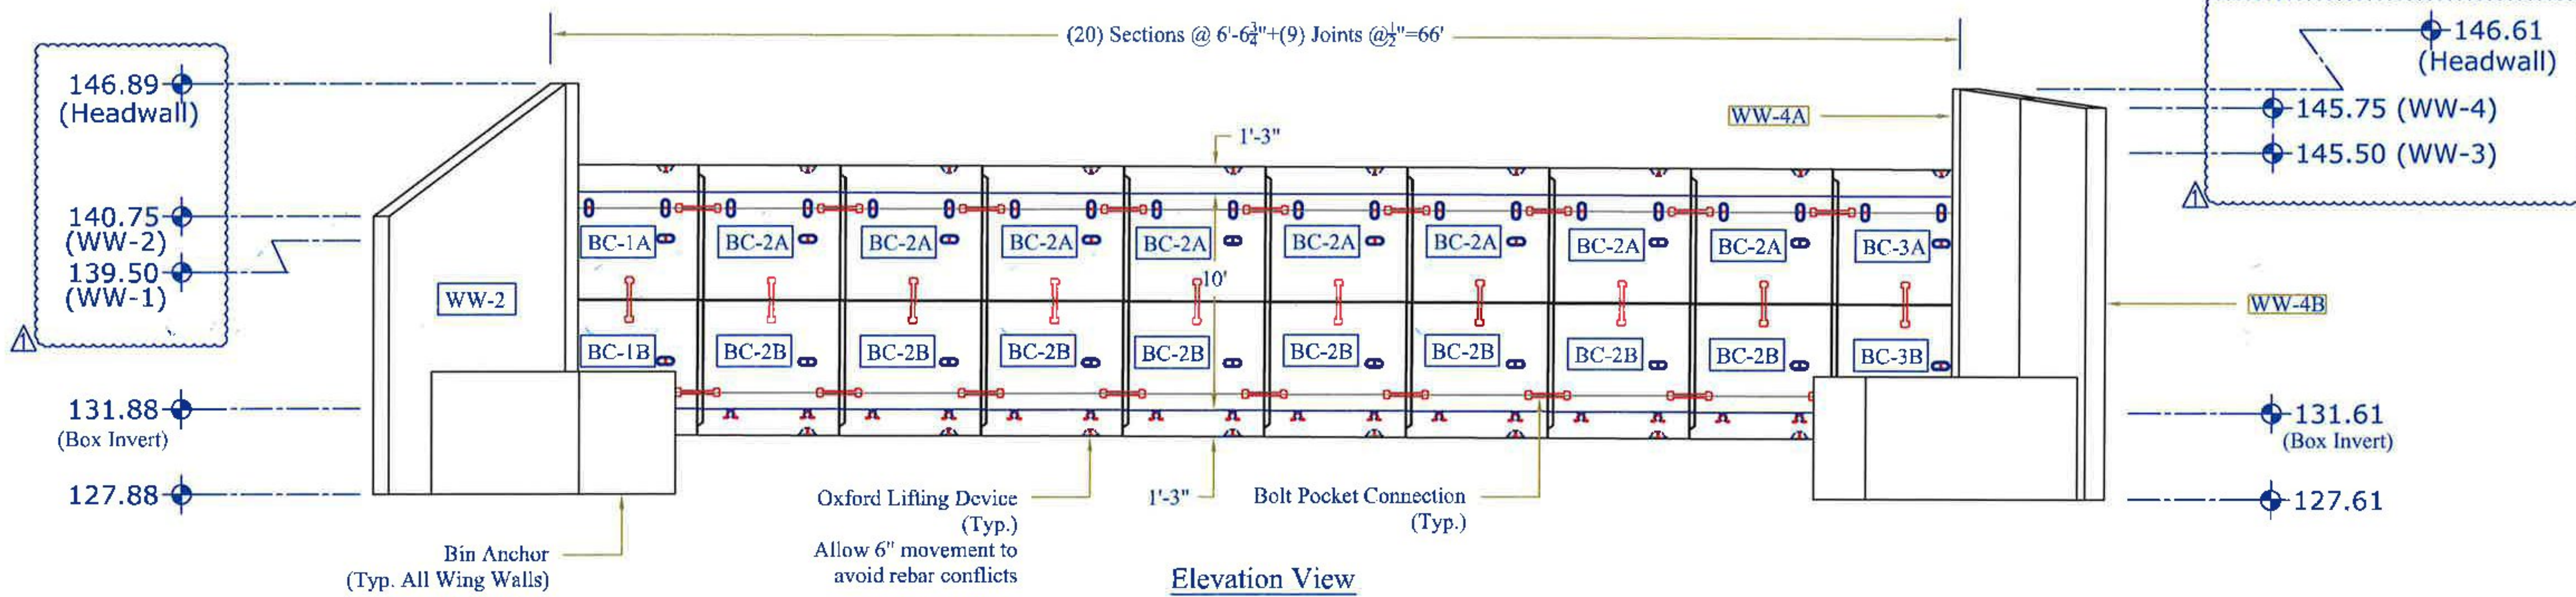

CONTRACTORS VISPE:	Rev.	Date	By	Description	PRECAST CONCRETE BOX CULVERT SHOP DRAWINGS (SDI JOB #15428)	Peckham Road Corp. 1557 St. Rt. 9, #3 Lake George, NY 12845 Ph: (518) 747-3353	FABRICATOR: 193 INDUSTRIAL AVE. WILLISTON, VT 05495 Ph: (802) 658-0201
	1	03/25/15	IBA	Changes per Stantec & State Review			
	2	04/23/15	IBA	Changes for Production Purposes	DETAILER: I. ADAMS	PROJECT #: CULV(29) Br.#2	<b>SD Ireland PRECAST</b>
					CHECKER: E. Barendse	LOCATION: Bridport, VT	
					ENGINEER: G. K. Munkelt	02/12/15	PLAN_ELEVATION


BC-1A Detail

Note: See Sh. 8 for Additional Details

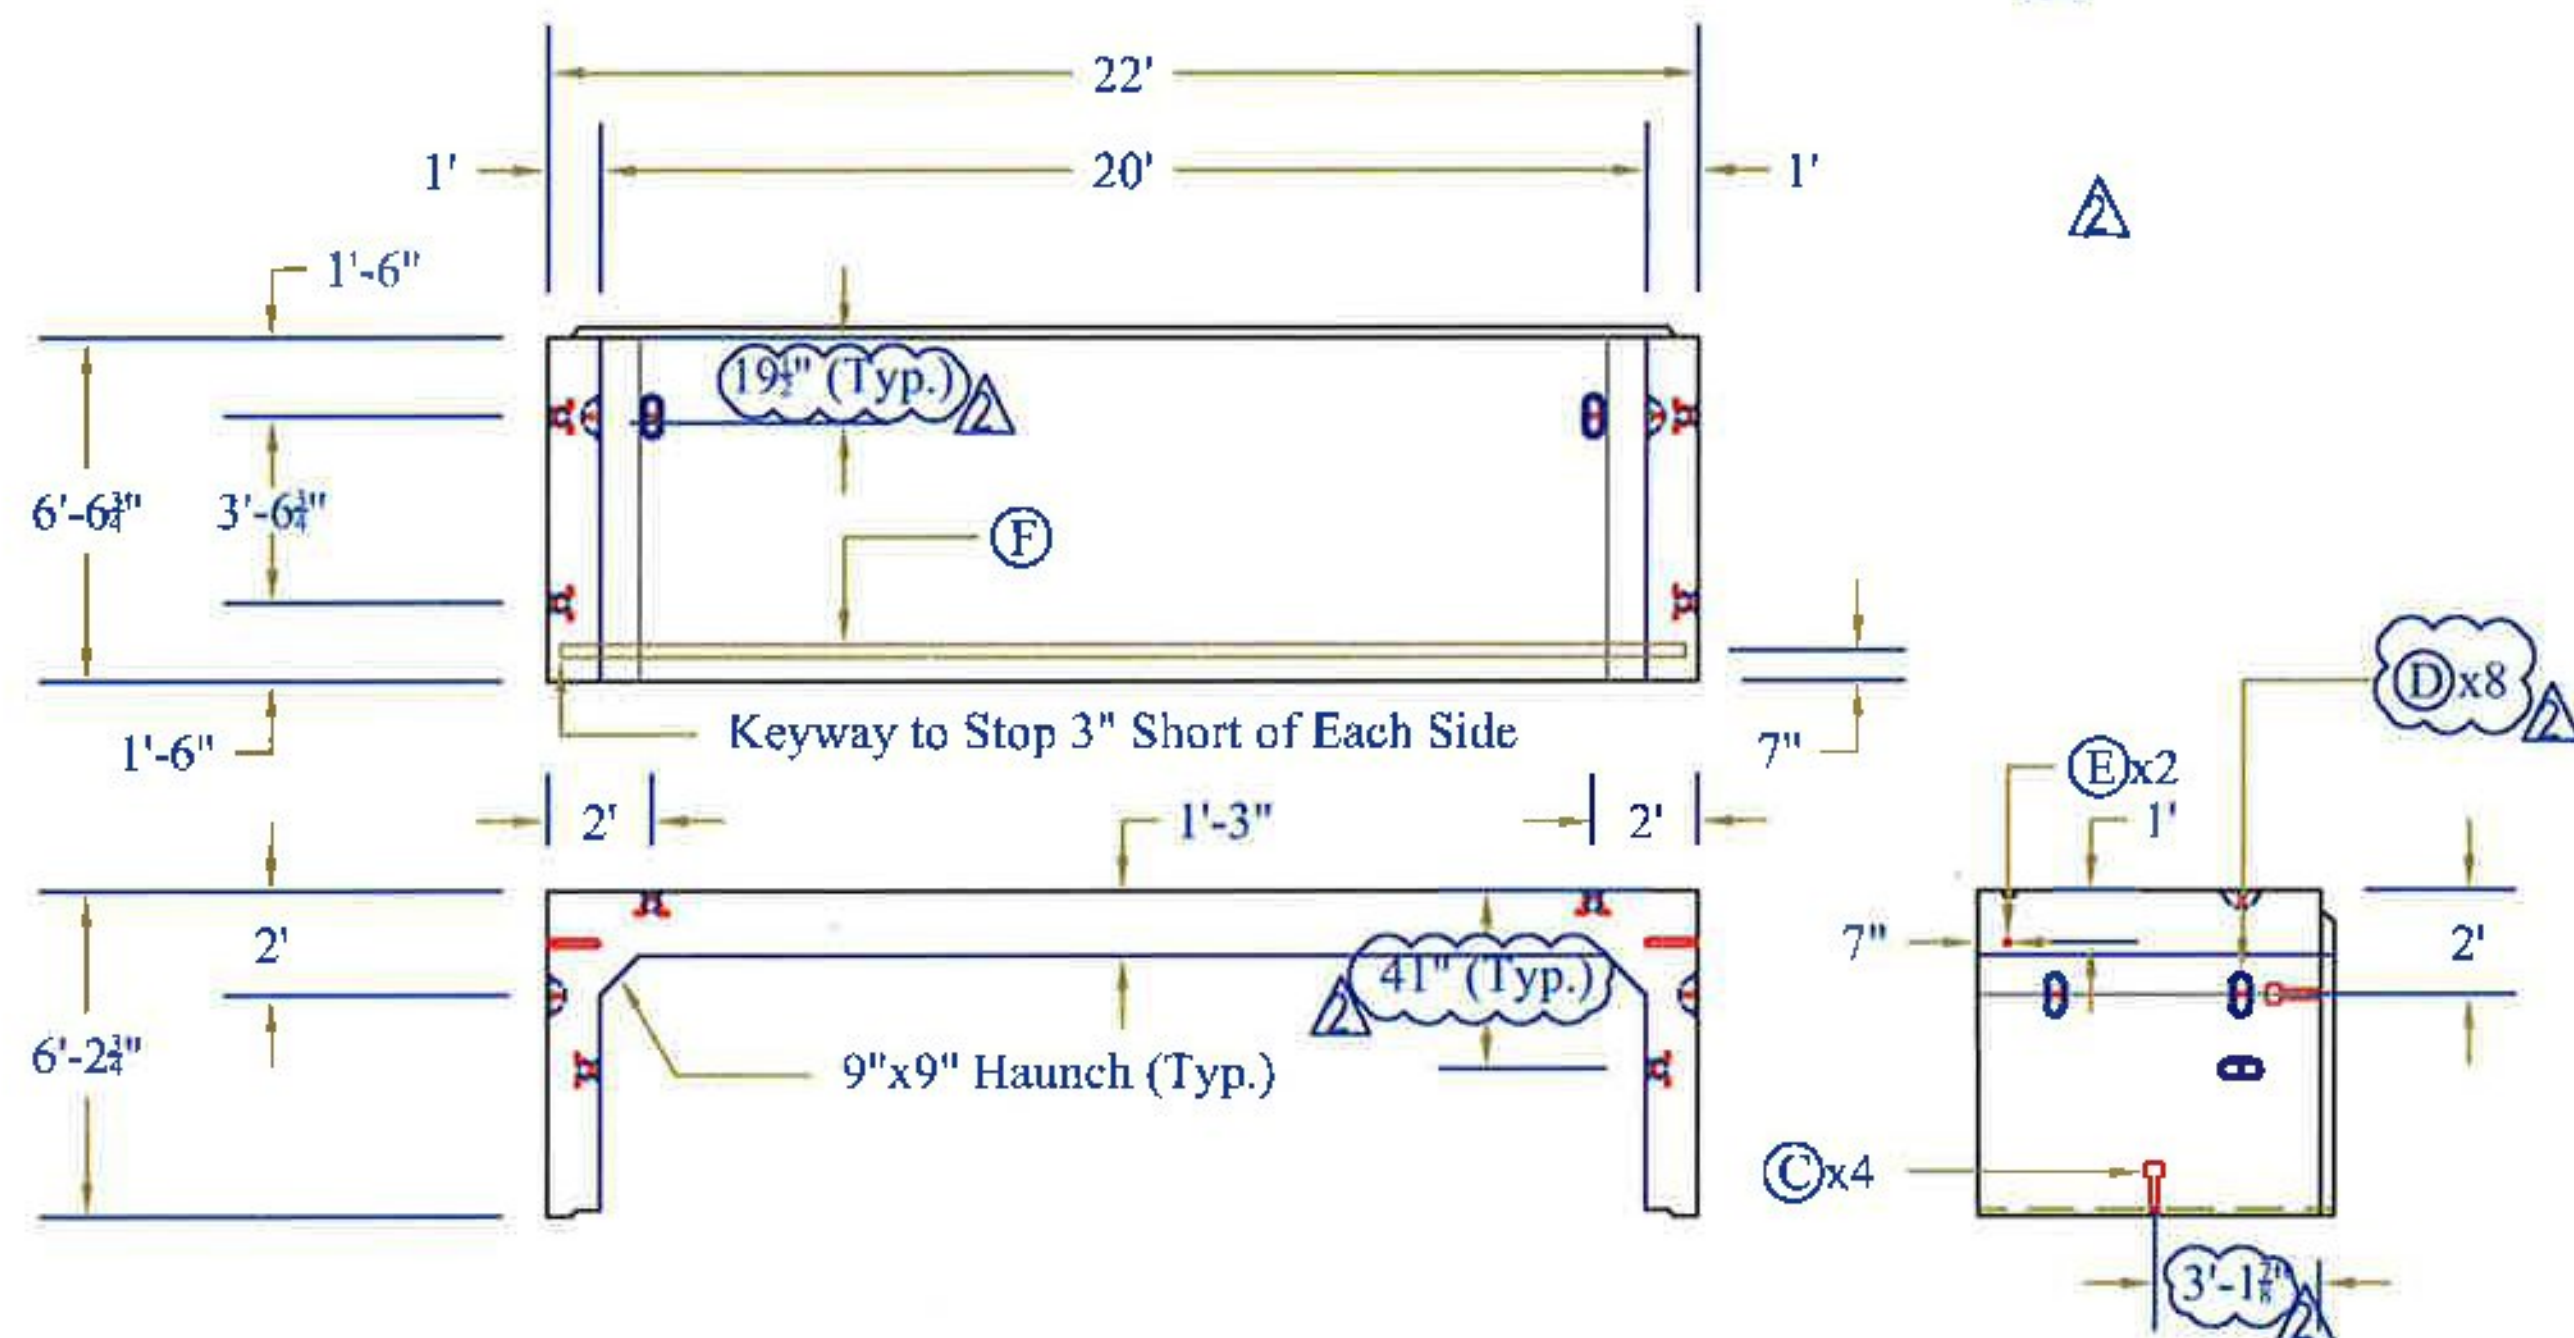

BC-2A Detail


Note: See Sh. 8 for Additional Details

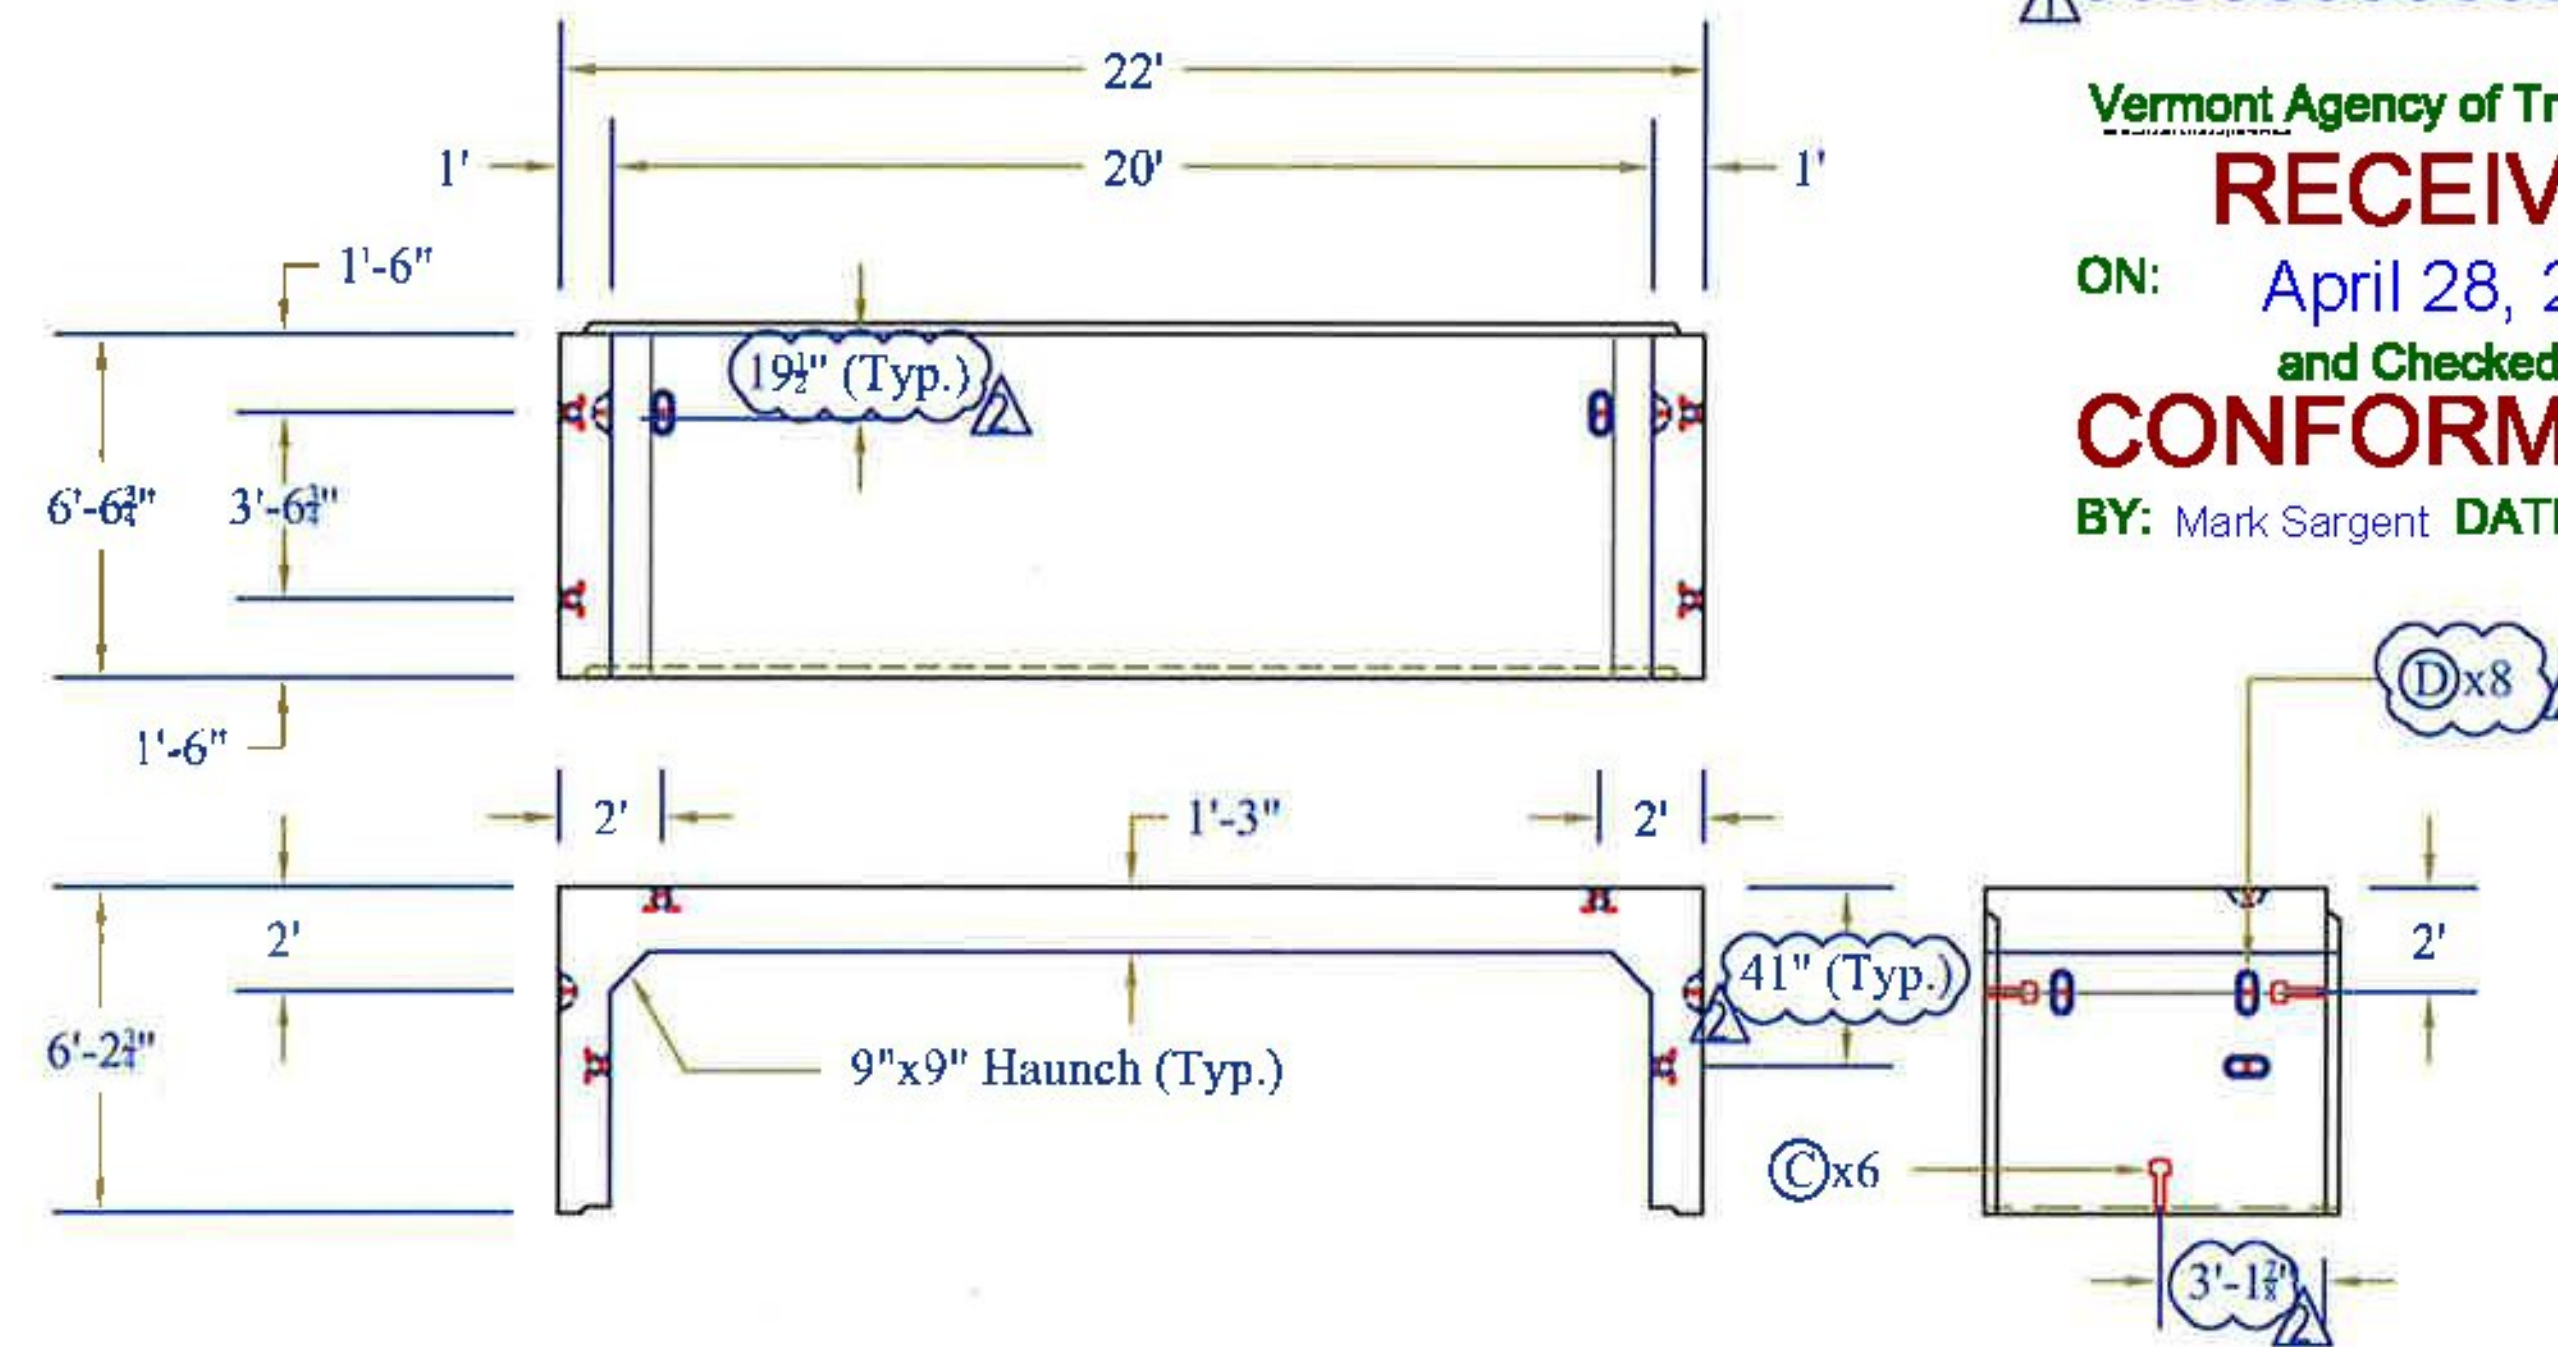

Vermont Agency of Transportation  
**RECEIVED**  
 ON: April 28, 2015  
 and Checked for  
**CONFORMANCE**  
 BY: Mark Sargent DATE: 04/29/2015

BC-3A Detail

Note: See Sh. 8 for Additional Details

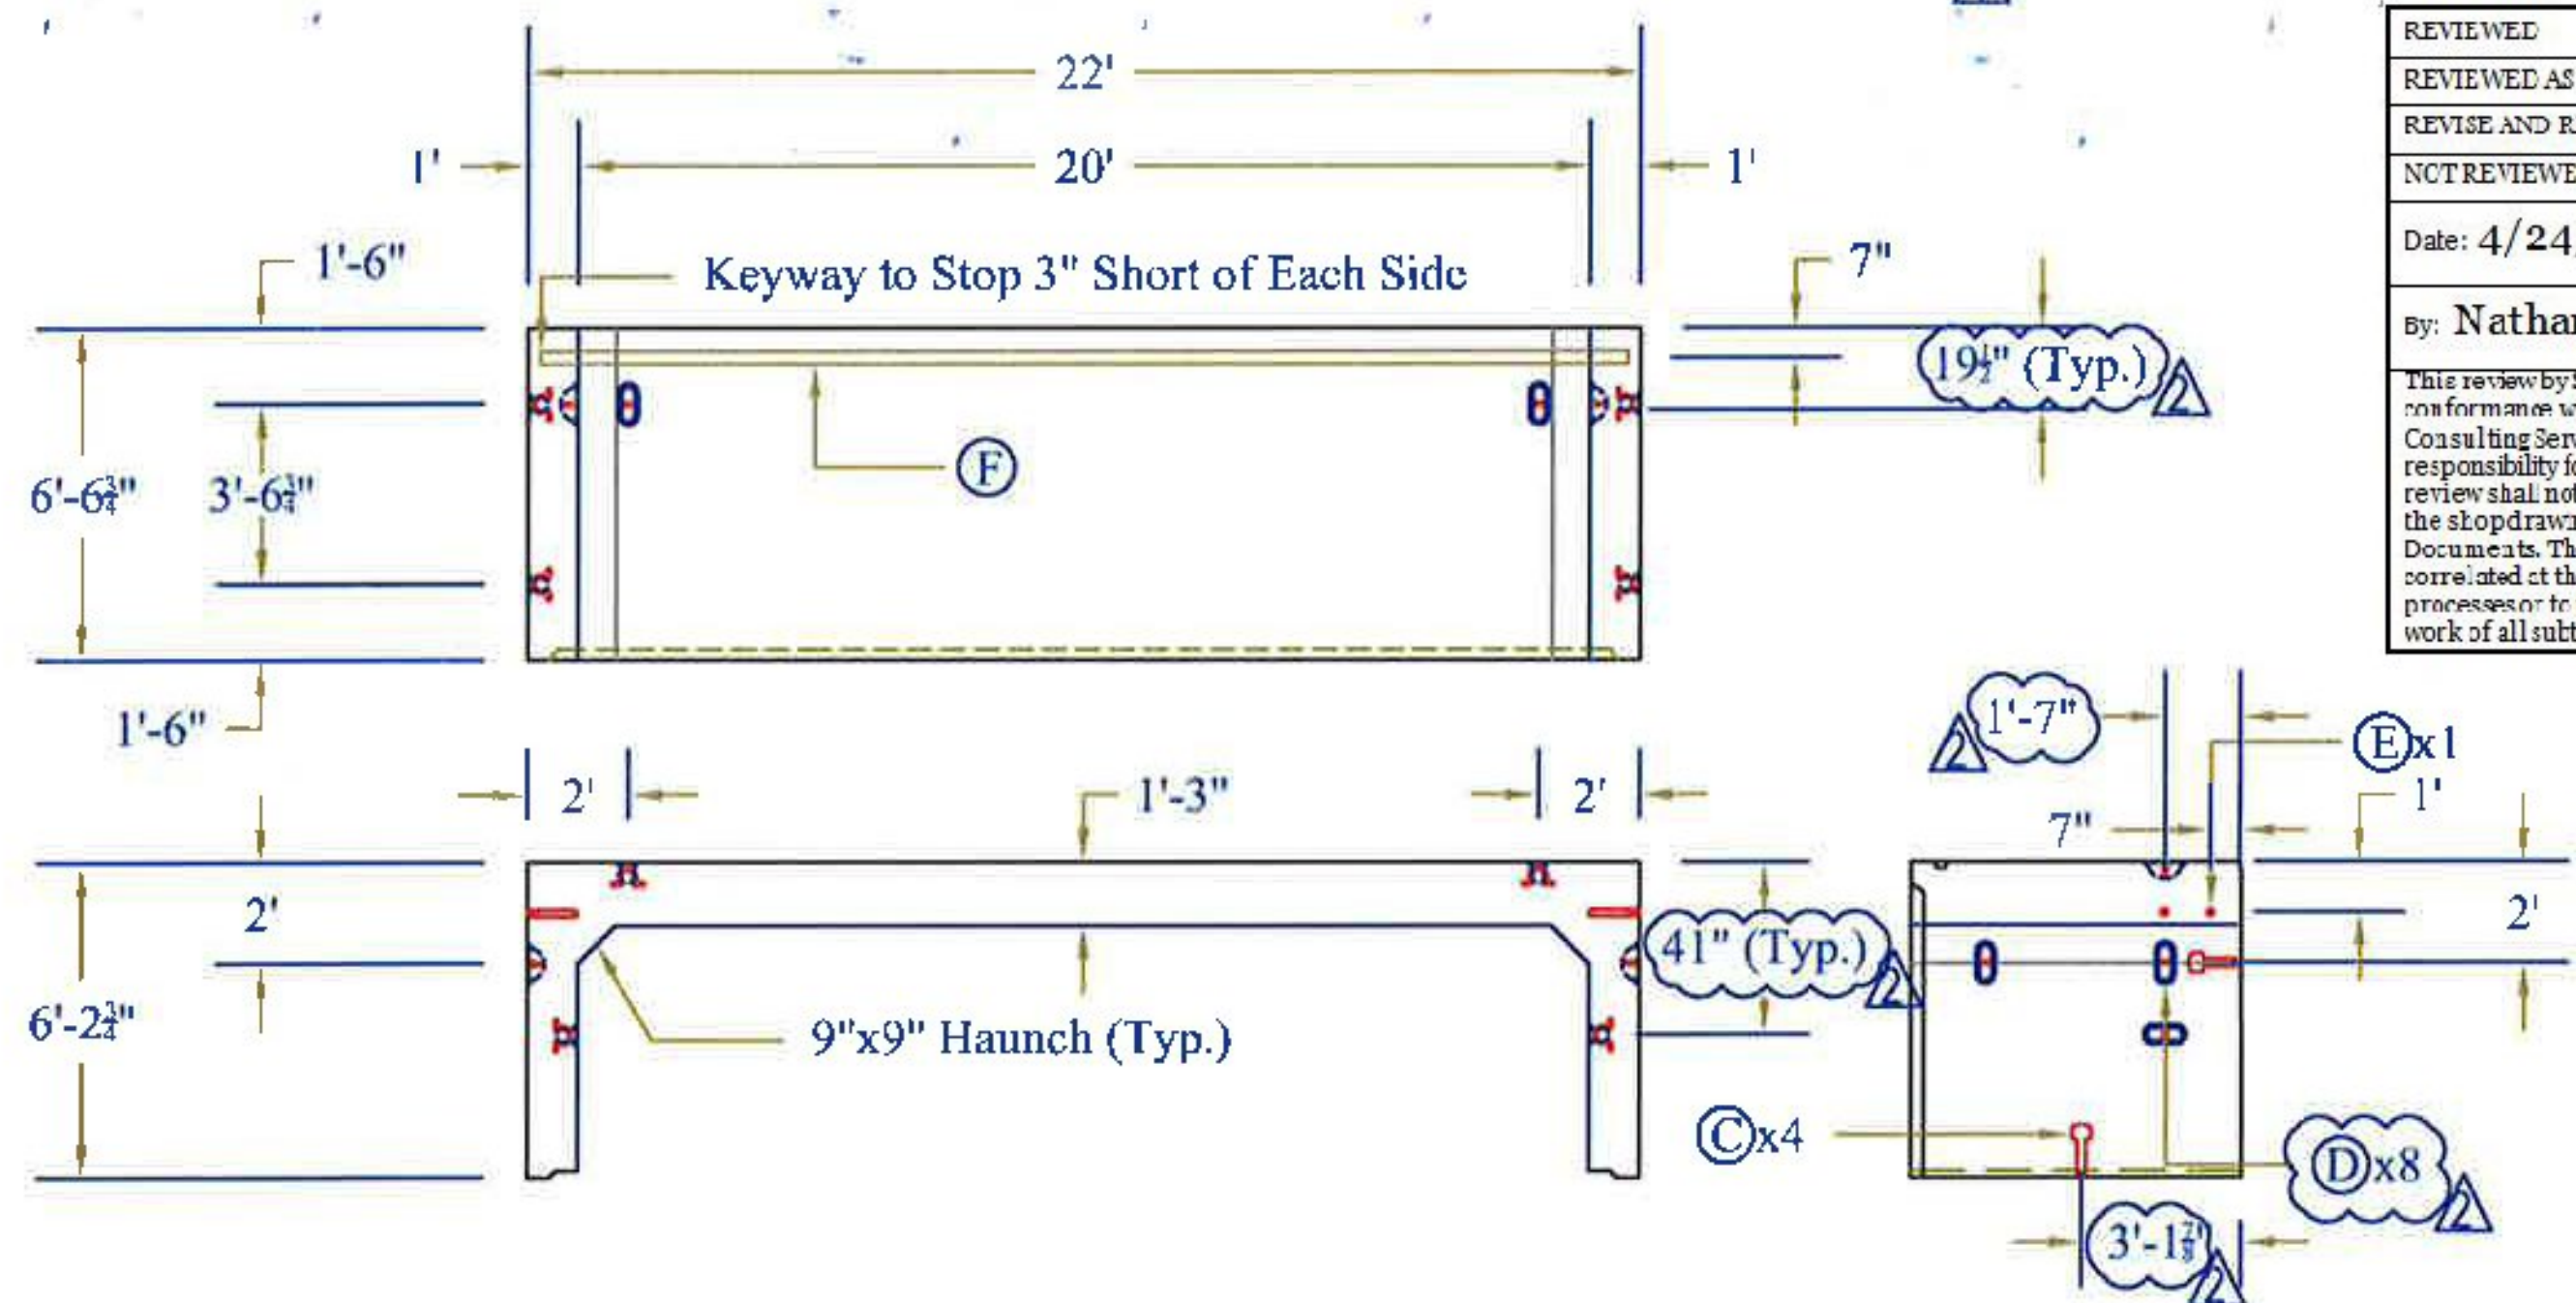

Notes: -2" Clear Typical Unless Noted Otherwise Box Section Reinforcement Detail


REVIEWED	X
REVIEWED AS MODIFIED	
REVISE AND RESUBMIT	
NOT REVIEWED	

Date: 4/24/2015  
 by: Nathan Tirk

**Stantec**

This review by Stantec Consulting Services Inc. is for the sole purpose of ascertaining conformance with the general design concept. This review shall not mean that Stantec Consulting Services Inc. approves the detail design inherent in the shop drawings responsibility for which shall remain with the Contractor. Submitting same, and such review shall not relieve the Contractor of his responsibility for errors or omissions in the shop drawings or his responsibility for meeting all requirements of the Contract Documents. The contractor is responsible for dimensions to be confirmed and correlated at the job site, for information that pertains solely to the fabrication processes or techniques of construction and installation and for coordination of the work of all trades.

Mark	Size	Max Spacing	Length	Type	A	B
As1	#4	6"	94 3/4"	Bent	24"	70 3/4"
As2	#7	4"	260"	Str	260"	
As4	#4	8"	70 3/4"	Str	70 3/4"	
As5	#5	8"	74 3/4"	Str	74 3/4"	
As6	#5	8"	74 3/4"	Str	74 3/4"	
As7	#4	6"	260"	Str	260"	
As8	#4	12"	74 3/4"	Str	74 3/4"	

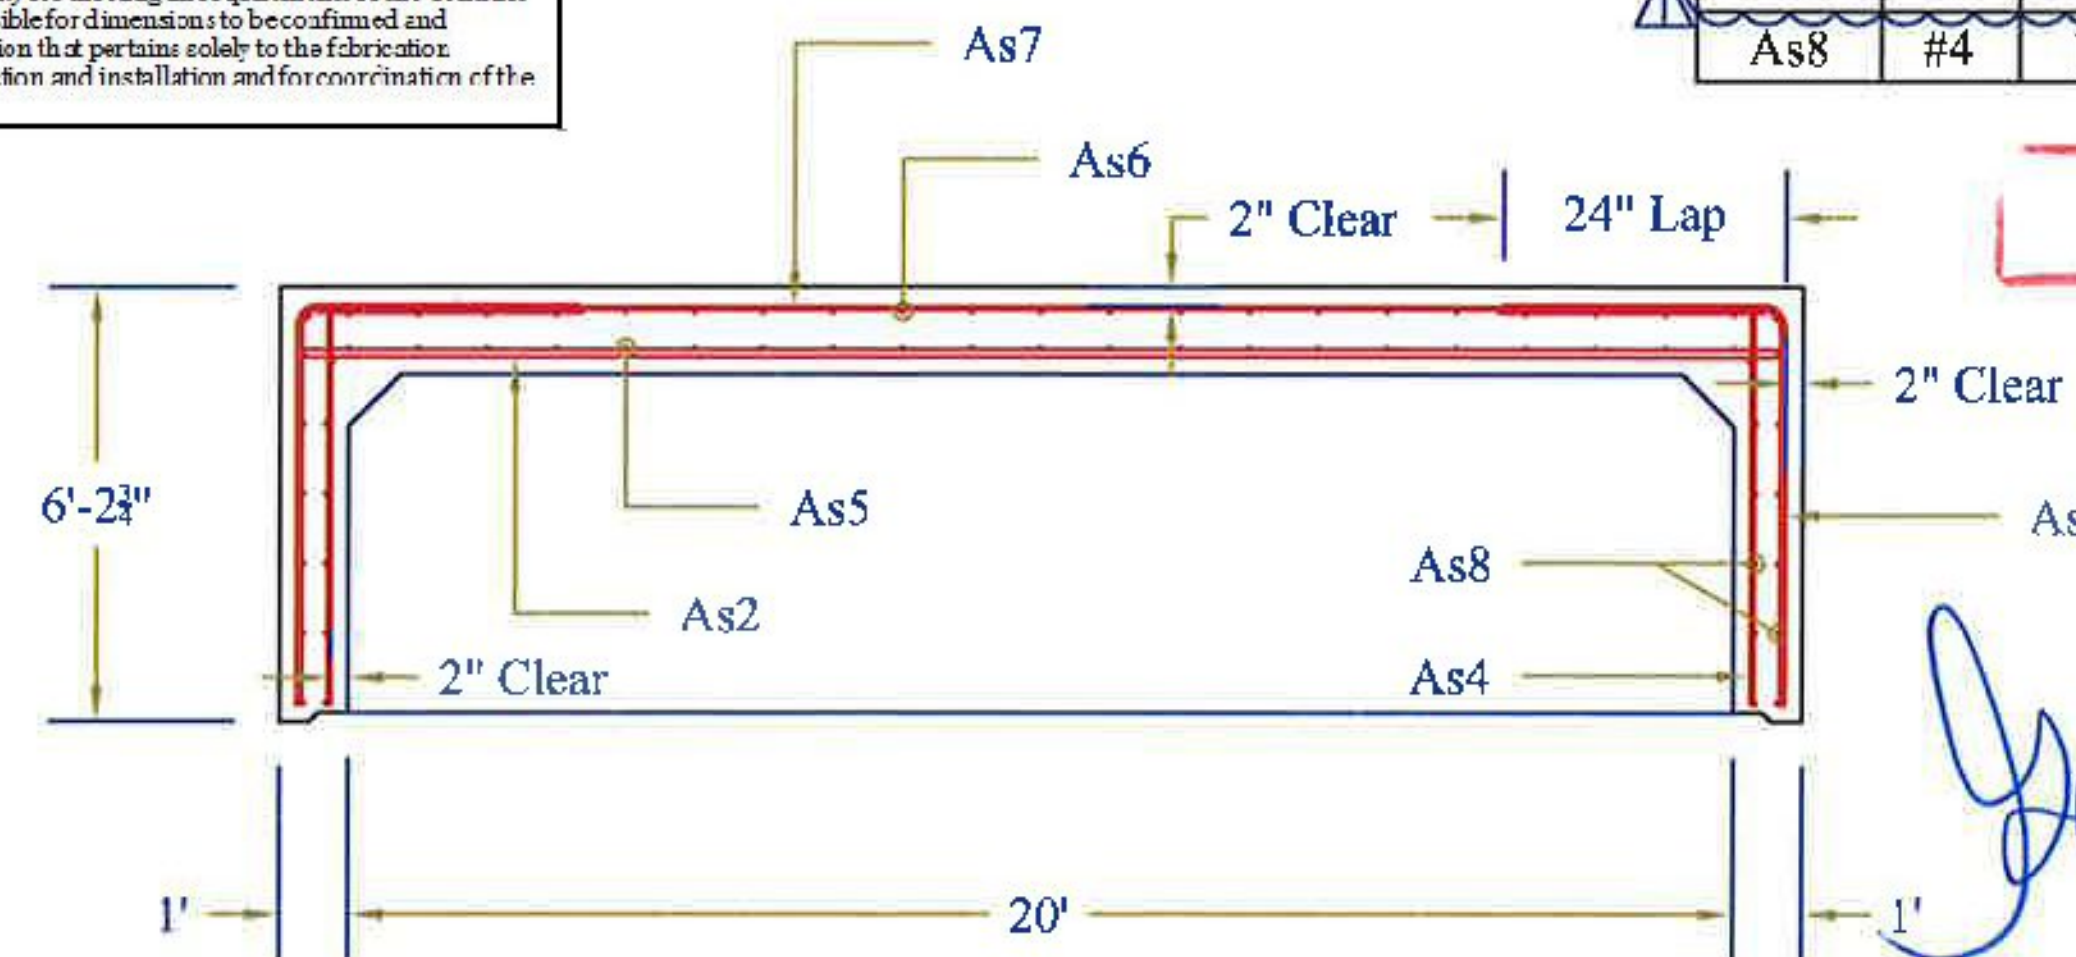


**STRUCTURAL DESIGN ONLY**

*Handwritten signature*  
 STATE OF VERMONT  
 BARRY K. MUNKETT  
 No. 18297  
 REGISTERED PROFESSIONAL ENGINEER

CONTRACTORS VISPE:	A 3"Ø PVC Sleeve	D Oxford A750-7 Lifting Device	C Solid Lines Indicate 1/2" Chamfer	Rev. 1	Date 03/25/15	By IBA	Description Changes per Stantec & State Review	PRECAST CONCRETE BOX CULVERT SHOP DRAWINGS (SDI JOB #15428) SUPERVISOR: E. Barendse DETAILER: I. ADAMS CHECKER: E. Barendse ENGINEER: G. K. Munkett	PROJECT NAME: Bridport PROJECT #: CULV(29) Br.#2 LOCATION: Bridport, VT	Peckham Road Corp. 1557 St. Rt. 9, #3 Lake George, NY 12845 Ph: (518) 747-3353	FABRICATOR: 193 INDUSTRIAL AVE. WILLISTON, VT 05495 Ph: (802) 658-0201	<b>SD Ireland PRECAST</b>
	B 4"Ø PVC Sleeve	E 1"Ø x 5/8" F56 Coil Loop Insert	H 3/4" Female Loop Insert	Rev. 2	Date 04/23/15	By IBA	Description Changes for Production Purposes					


BC-1B Detail

Note: See Sh. 8 for Additional Details

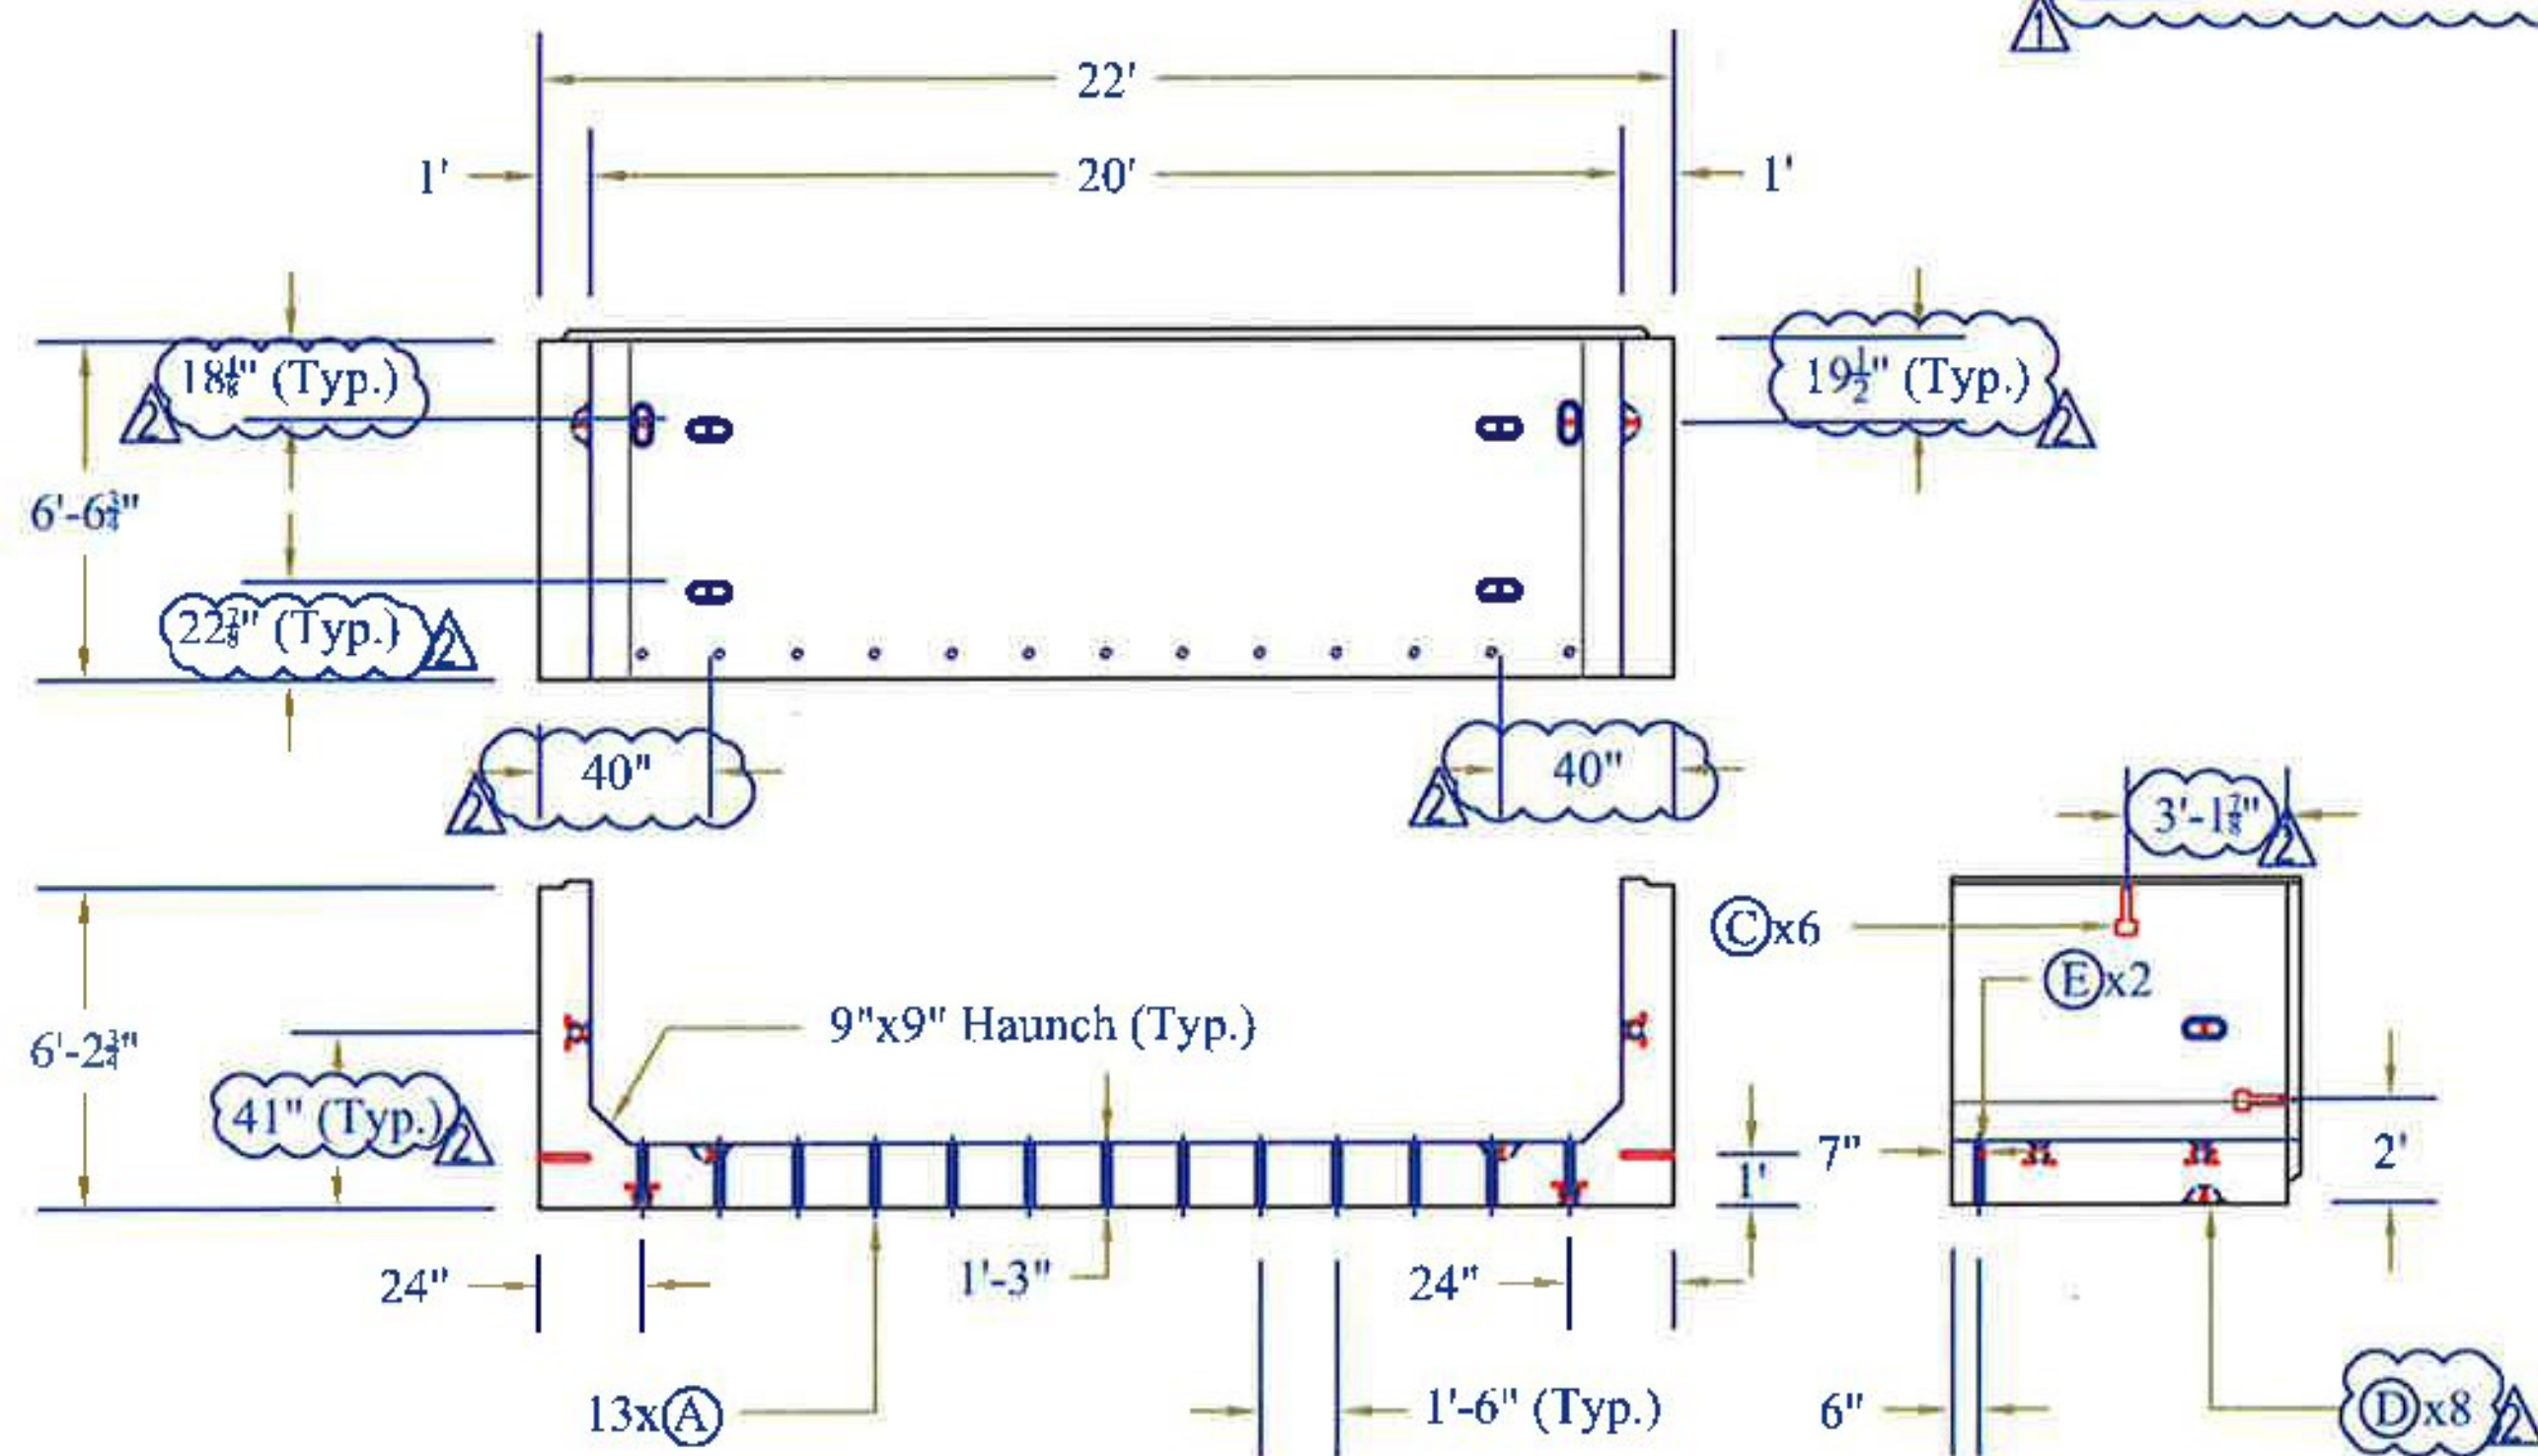

BC-2B Detail


Note: See Sh. 8 for Additional Details

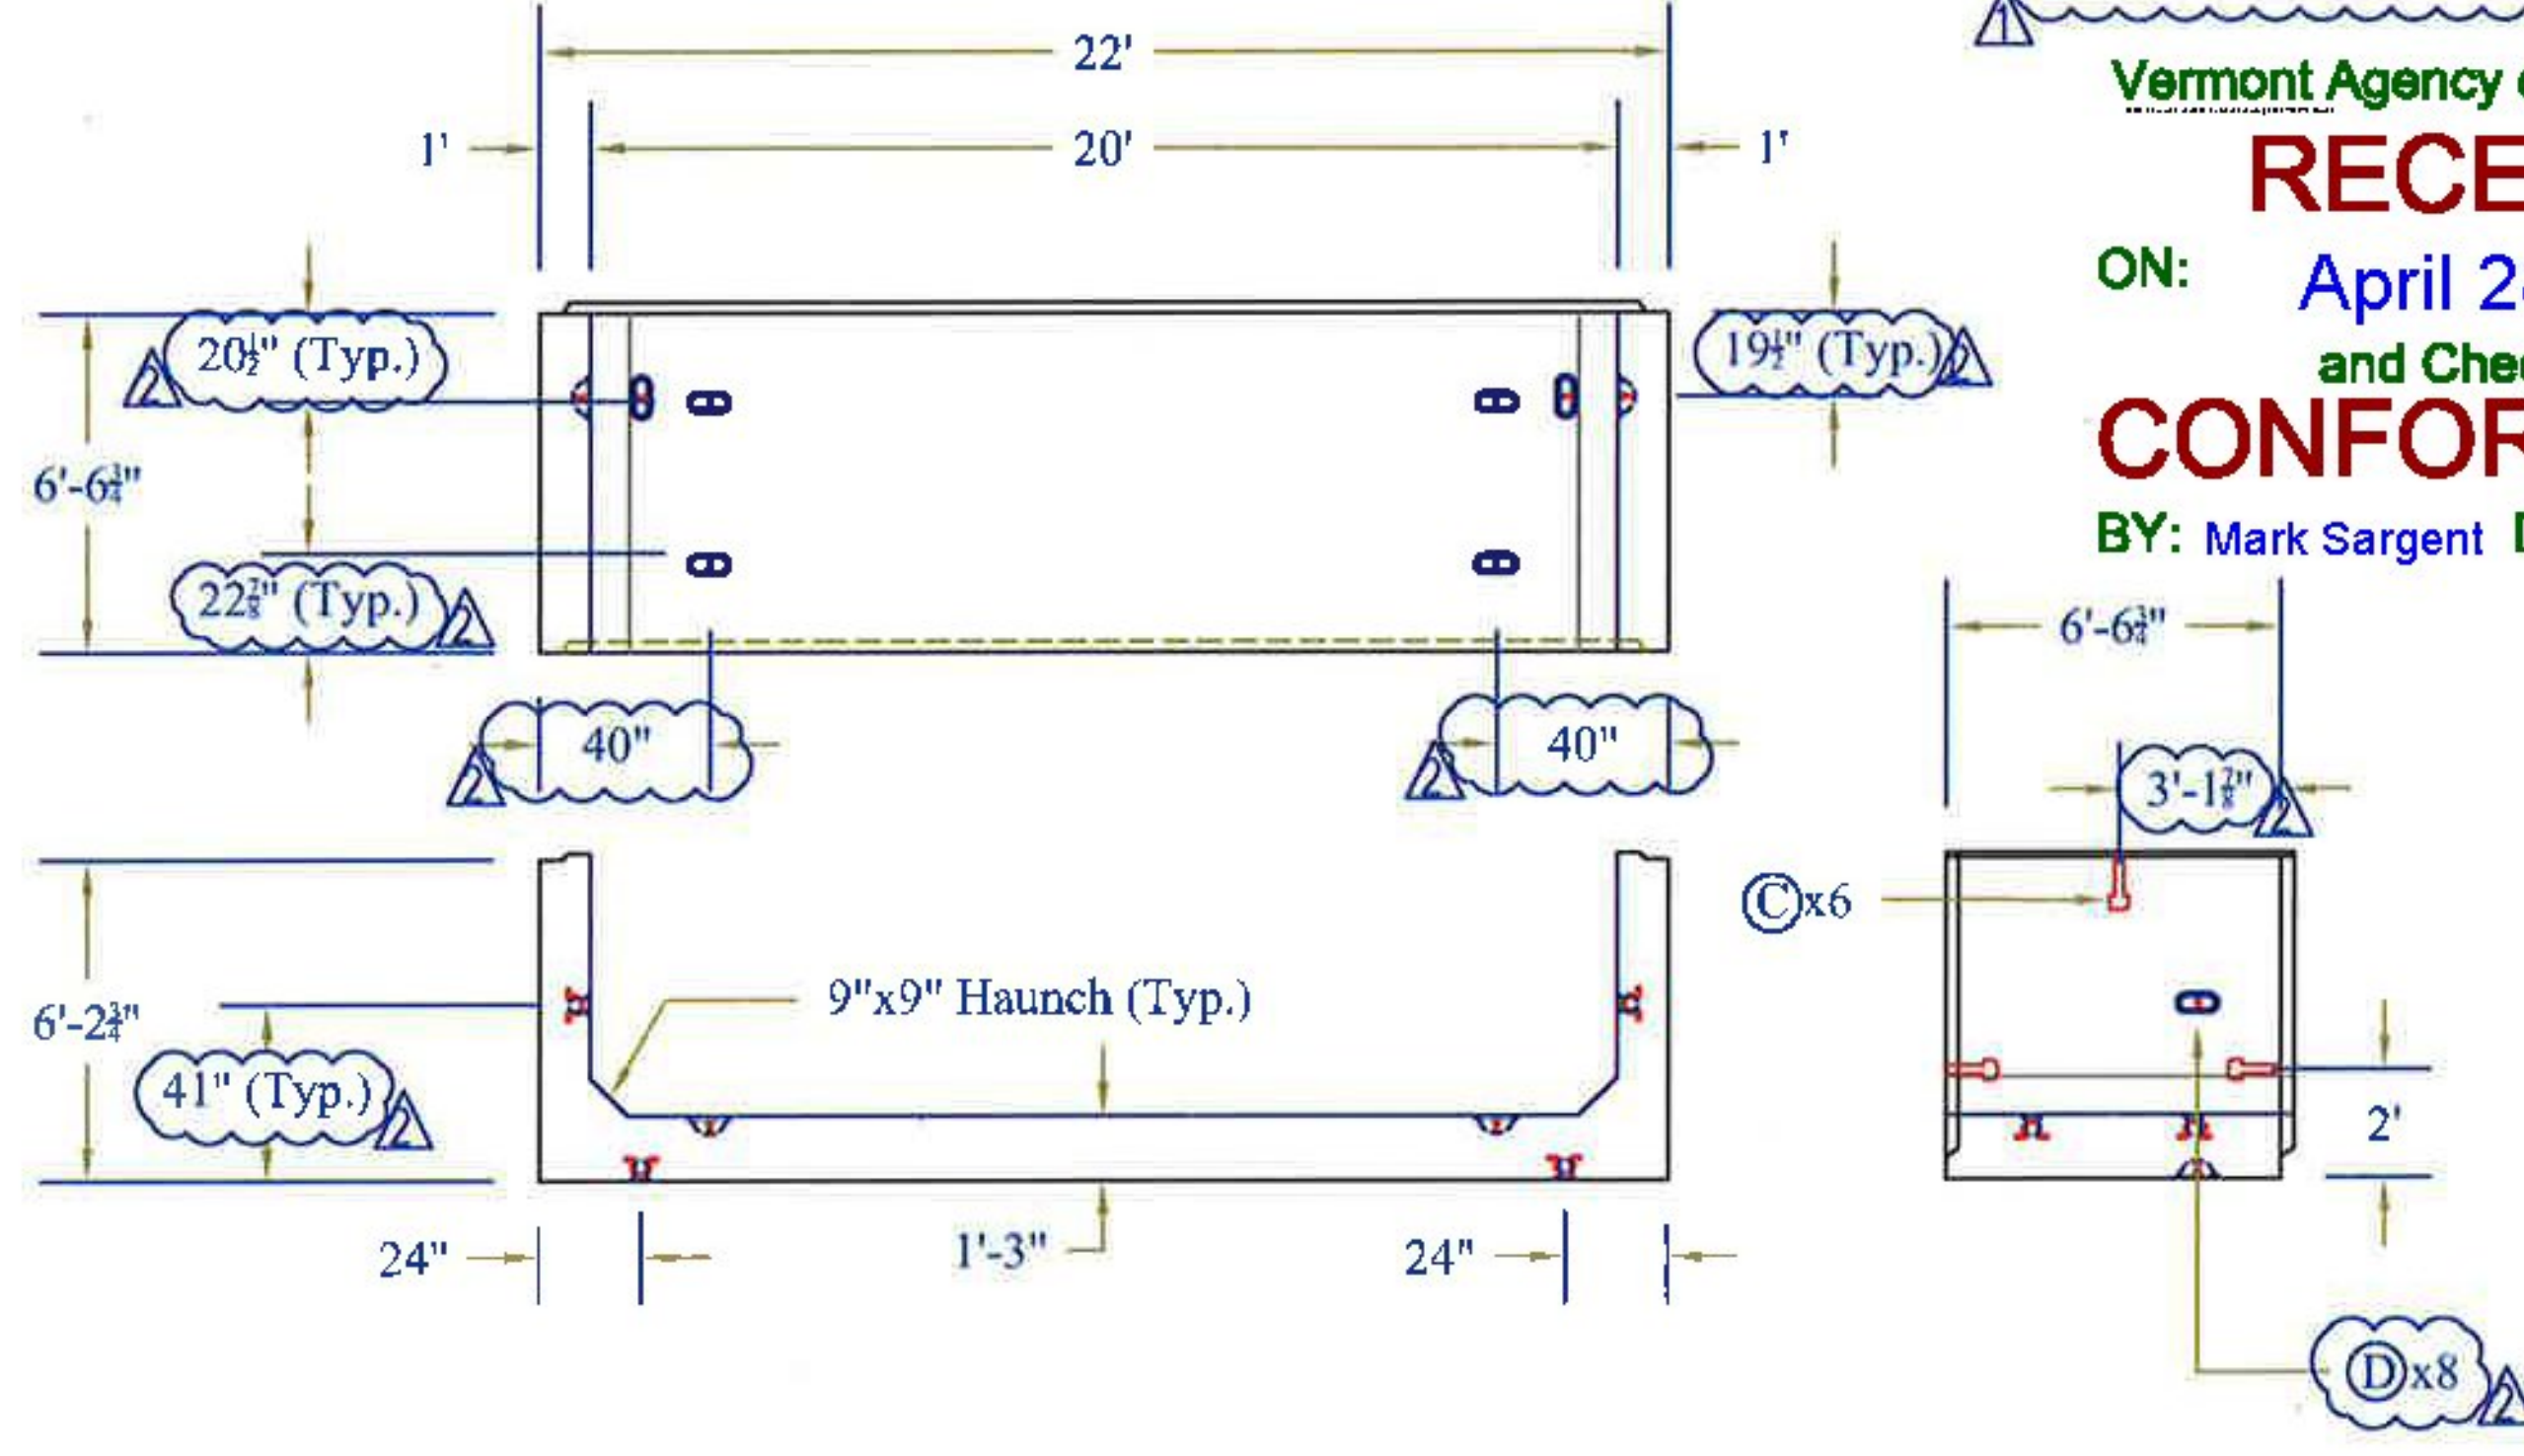

Vermont Agency of Transportation  
**RECEIVED**  
 ON: April 28, 2015  
 and Checked for  
**CONFORMANCE**  
 BY: Mark Sargent DATE: 04/29/2015


BC-3B Detail

Note: See Sh. 8 for Additional Details

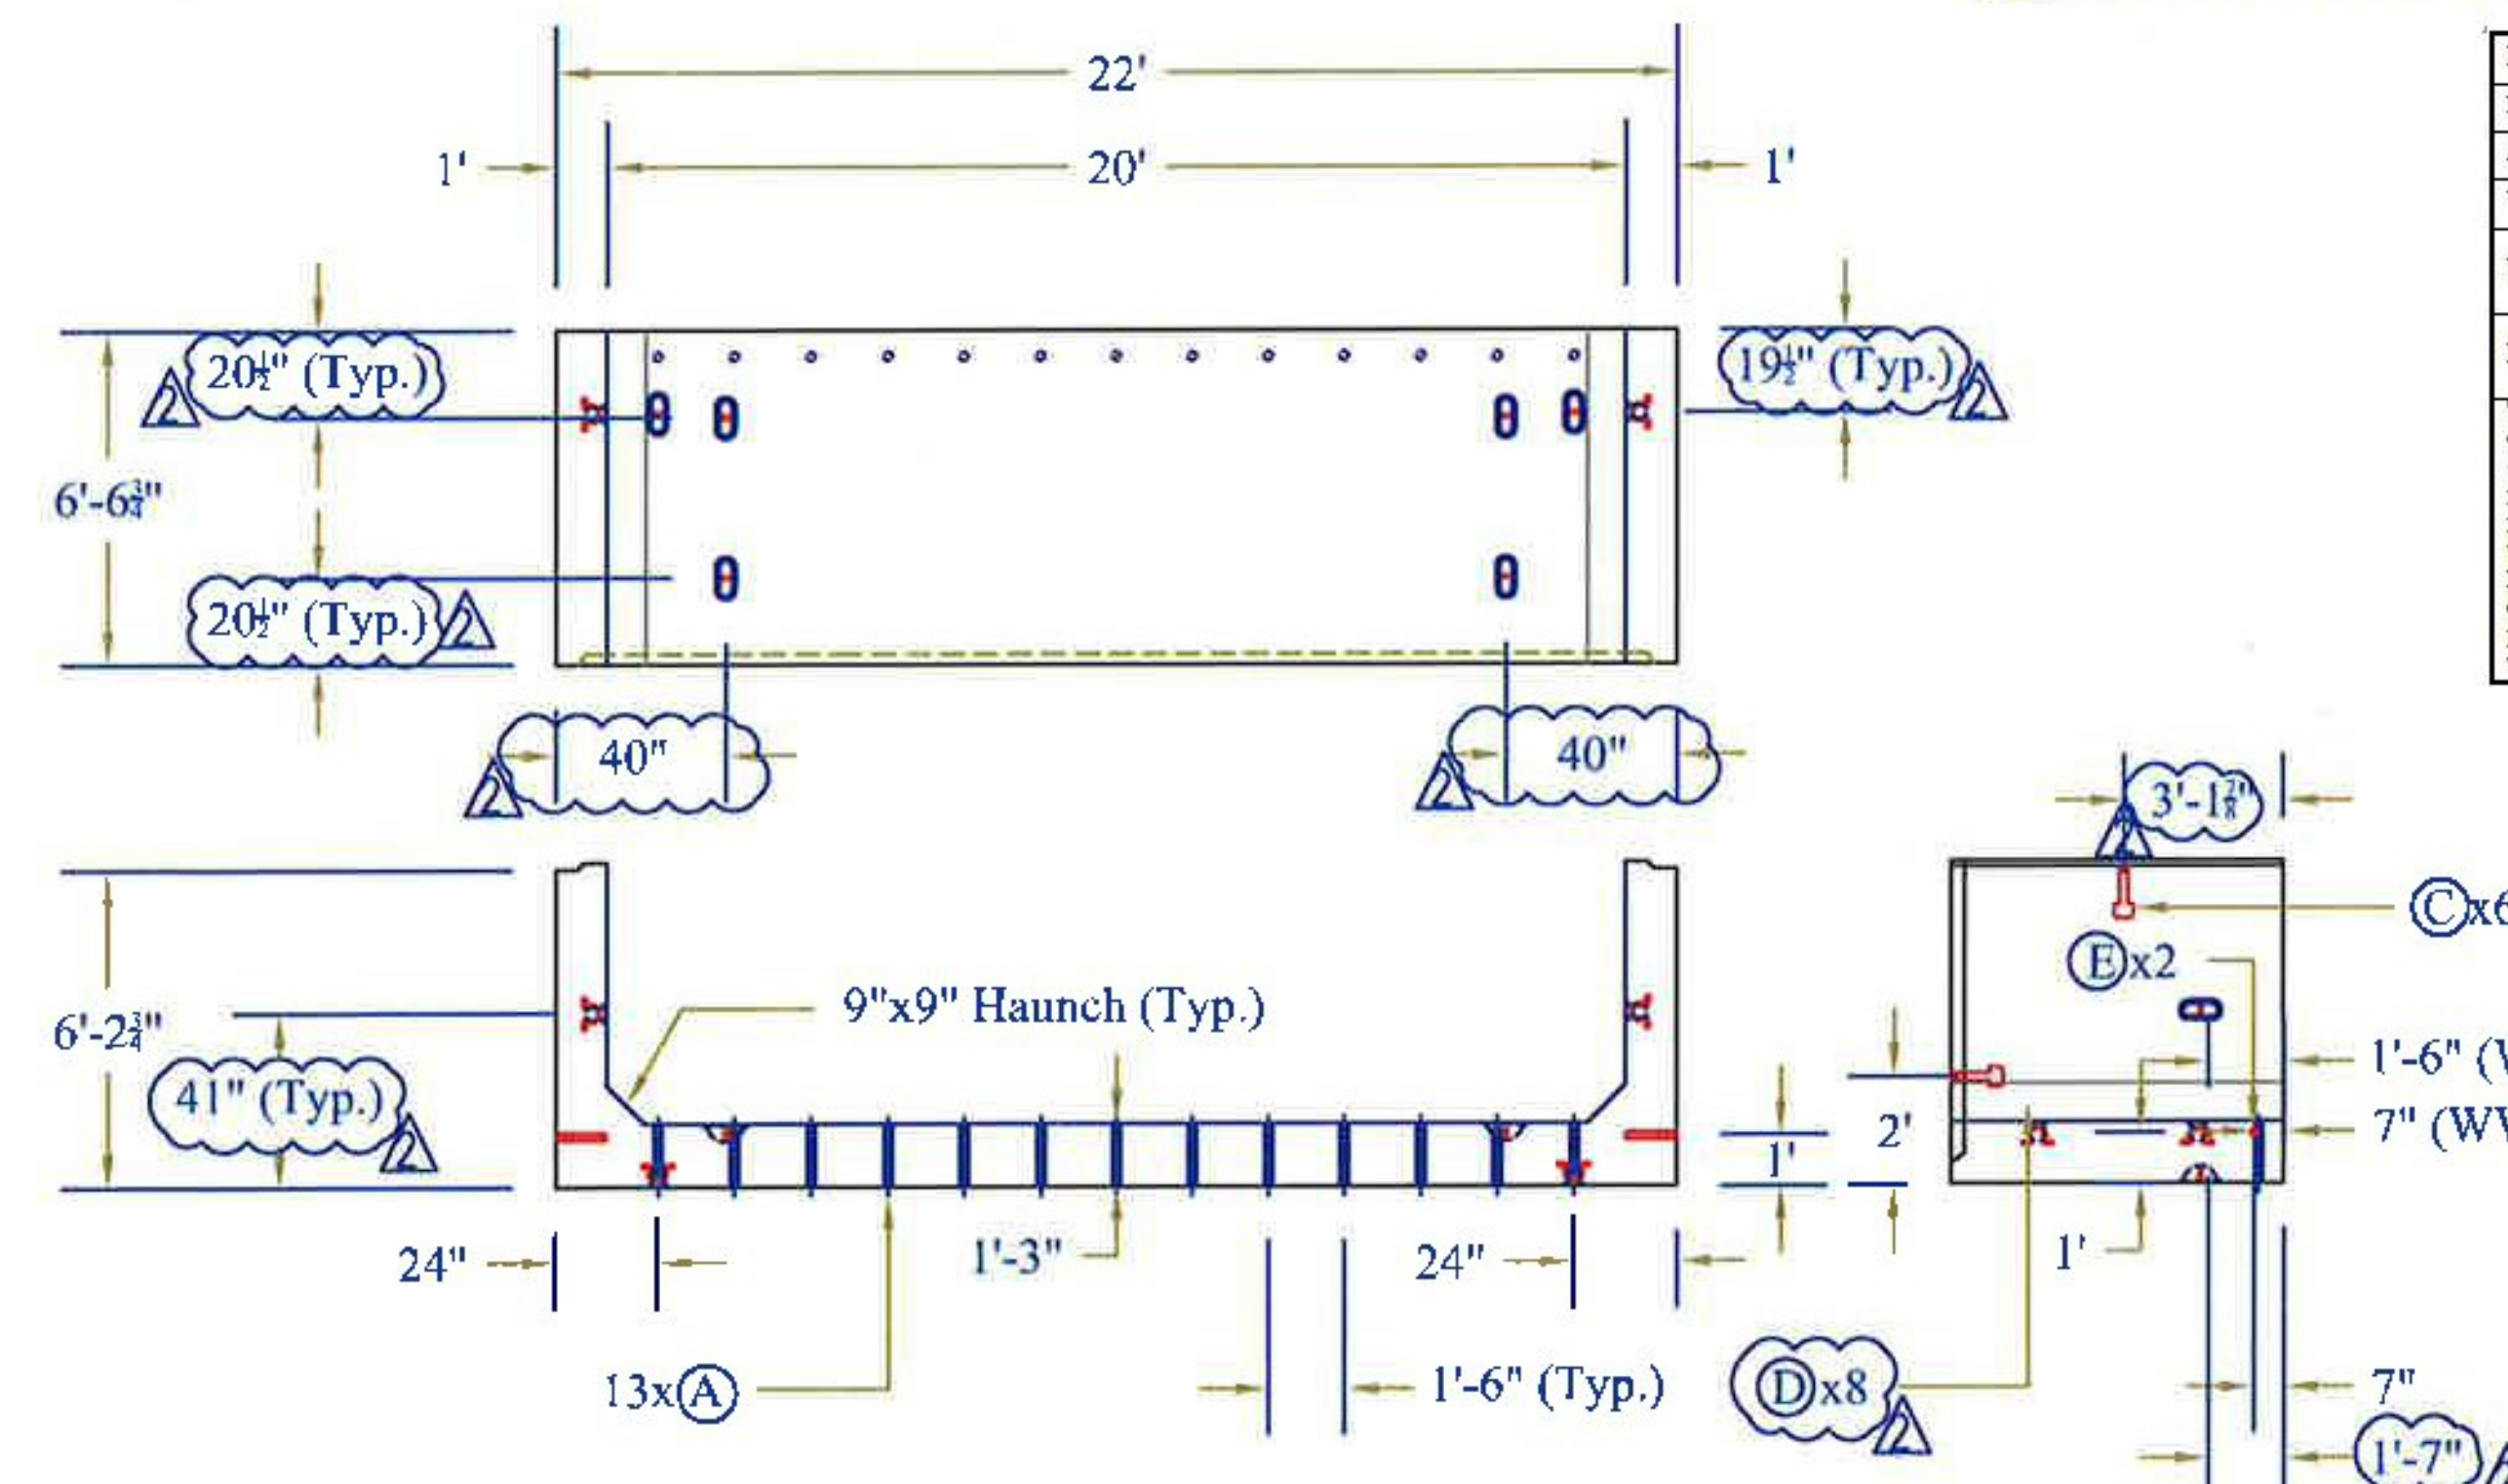

Box Section Reinforcement Detail

Notes: 2" Clear Typical Unless Noted Otherwise

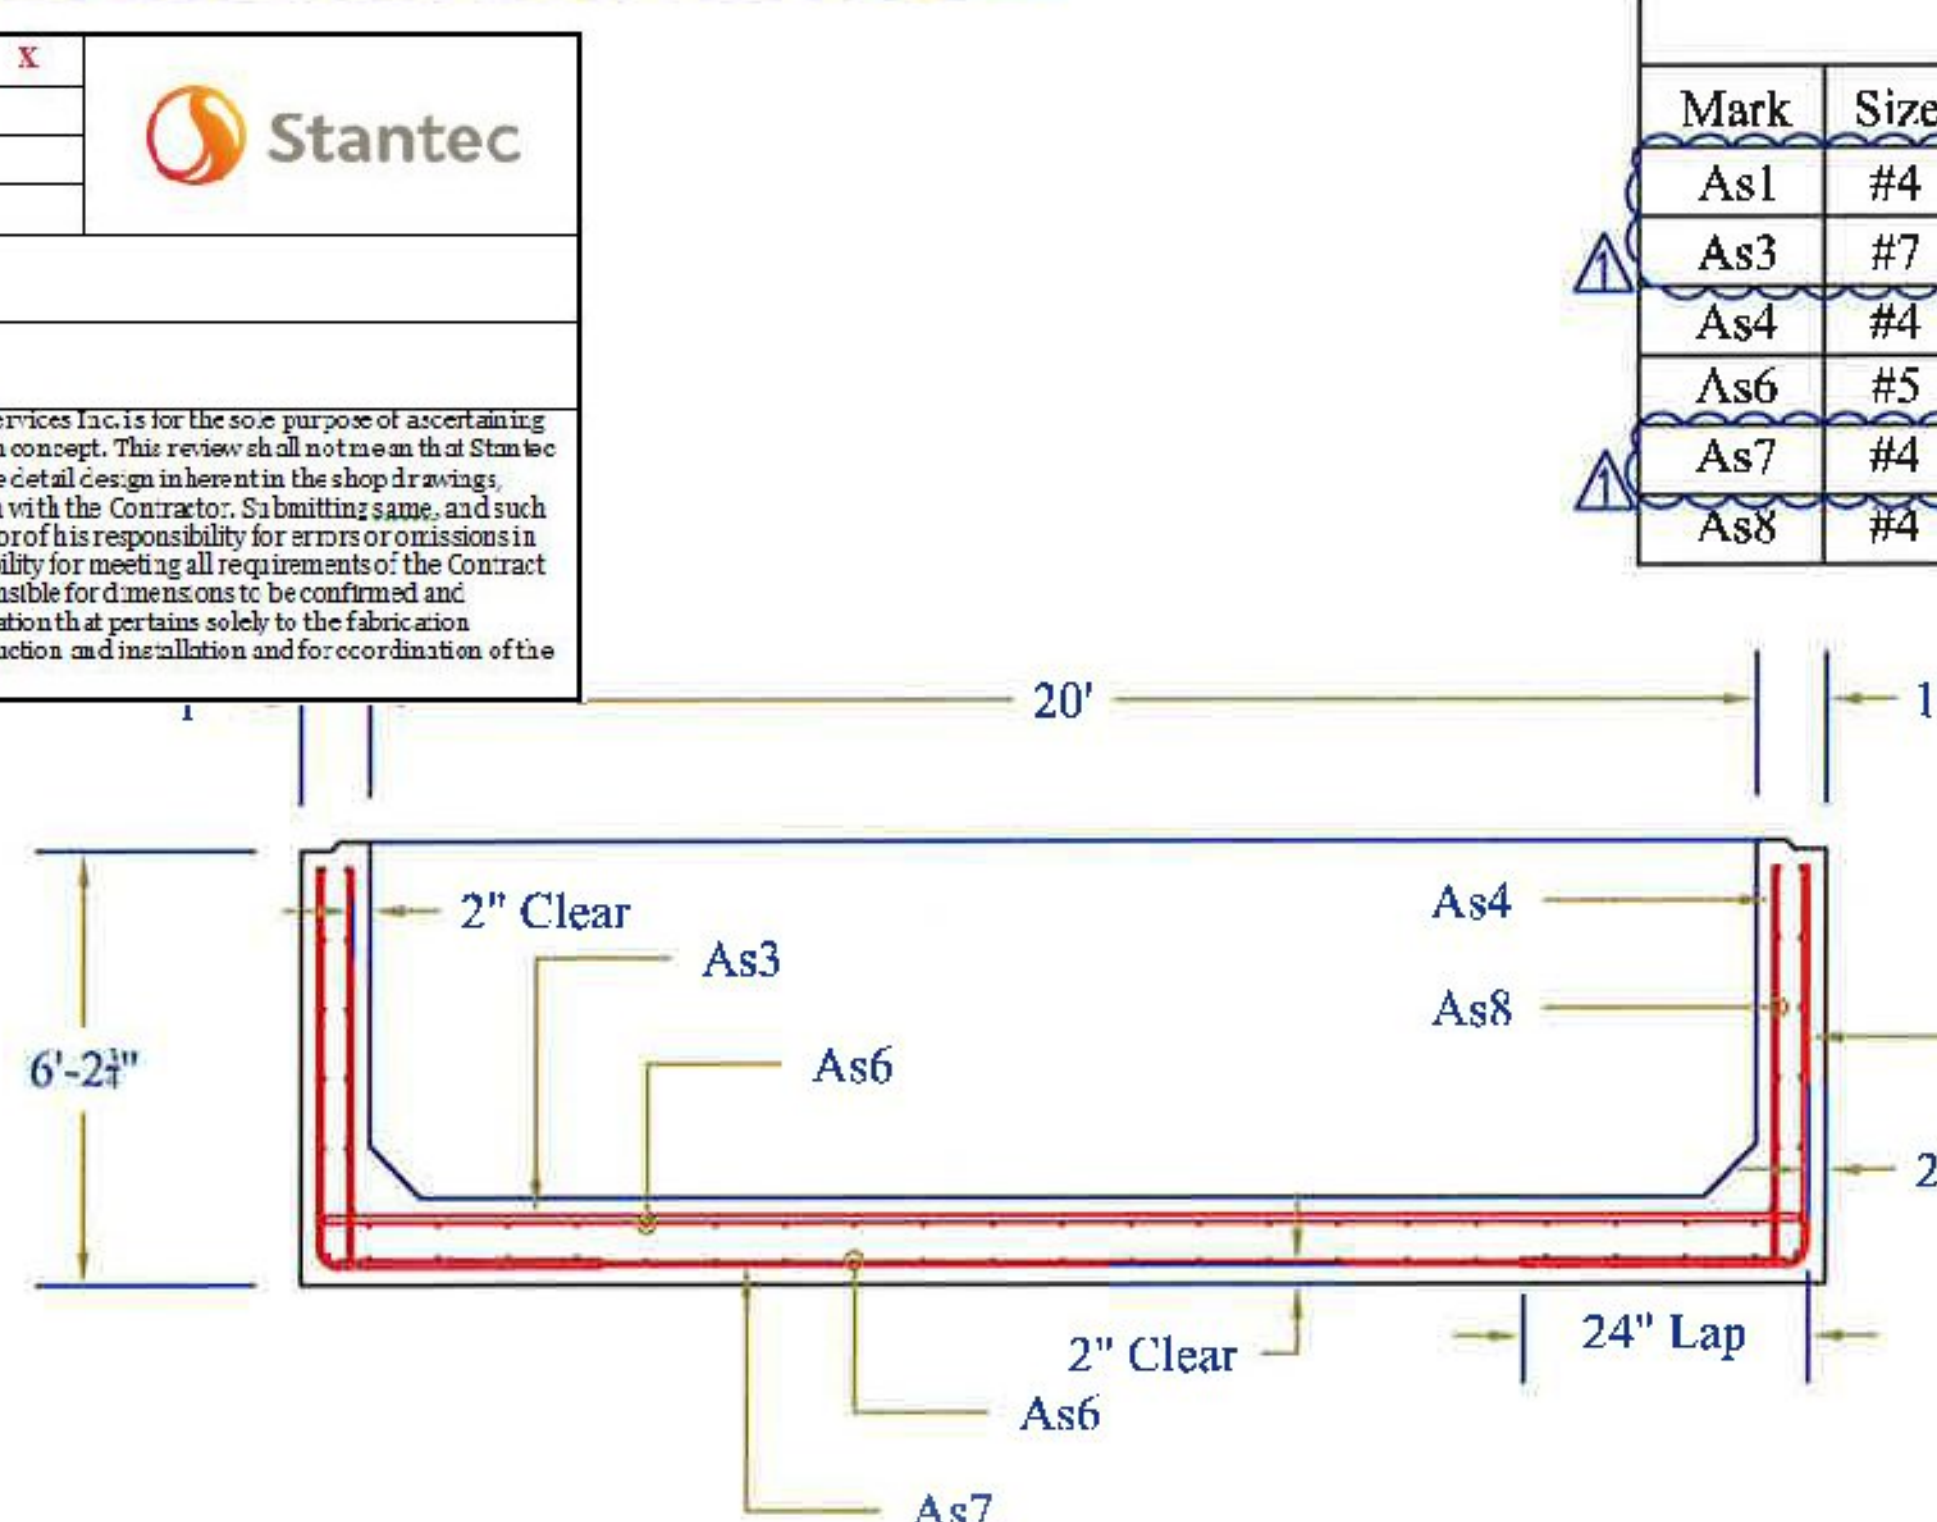

REVIEWED	X
REVIEWED AS MODIFIED	
REVISE AND RESUBMIT	
NOT REVIEWED	

**Stantec**

Date: 4/24/2015

By: Nathan Tirk

This review by Stantec Consulting Services Inc. is for the sole purpose of ascertaining conformance with the general design concept. This review shall not mean that Stantec Consulting Services Inc. approves the detail design inherent in the shop drawings, responsibility for which shall remain with the Contractor. Submitting same, and such review shall not relieve the Contractor of his responsibility for errors or omissions in the shop drawing or his responsibility for meeting all requirements of the Contract Documents. The contractor is responsible for dimensions to be confirmed and correlated at the job site, for information that pertains solely to the fabrication process or to techniques of construction and installation and for coordination of the work of all trades.


Mark	Size	Max Spacing	Length	Type	A	B
As1	#4	6"	94 1/2"	Bent	24"	70 1/2"
As3	#7	4"	260"	Str	260"	
As4	#4	8"	70 1/2"	Str	70 1/2"	
As6	#5	8"	74 1/2"	Str	74 1/2"	
As7	#4	6"	260"	Str	260"	
As8	#4	12"	74 1/2"	Str	74 1/2"	

**STRUCTURAL DESIGN ONLY**


STATE OF VERMONT  
 GAYL K. MUNKELT  
 NO. 8291  
 REGISTERED  
 PROFESSIONAL ENGINEER  
 42815

CONTRACTORS VISIT:	A 3"Ø PVC Sleeve	D Oxford A750-7 Lifting Device	G Solid Lines Indicate 1/4" Chamfer	Rev. 1	Date 03/25/15	By IBA	Description Changes per Stantec & State Review	PRECAST CONCRETE BOX CULVERT SHOP DRAWINGS (SDI JOB #15428)	SUPERVISOR: E. Barendse DETAILER: I. ADAMS CHECKER: E. Barendse ENGINEER: G. K. Munkelt	Peckham Road Corp. 1557 St. Rt. 9, #3 Lake George, NY 12845 Ph: (518) 747-3353	FABRICATOR: 193 INDUSTRIAL AVE. WILLISTON, VT 05495 Ph: (802) 658-0201	<b>SD Ireland</b> PRECAST
	B 4"Ø PVC Sleeve	E 1"Ø x 1/2" F56 Coil Loop Insert	H 1/2" F64 Ferrule Loop Insert	Rev. 2	Date 04/23/15	By IBA	Description Changes for Production Purposes					


WW-1 Detail

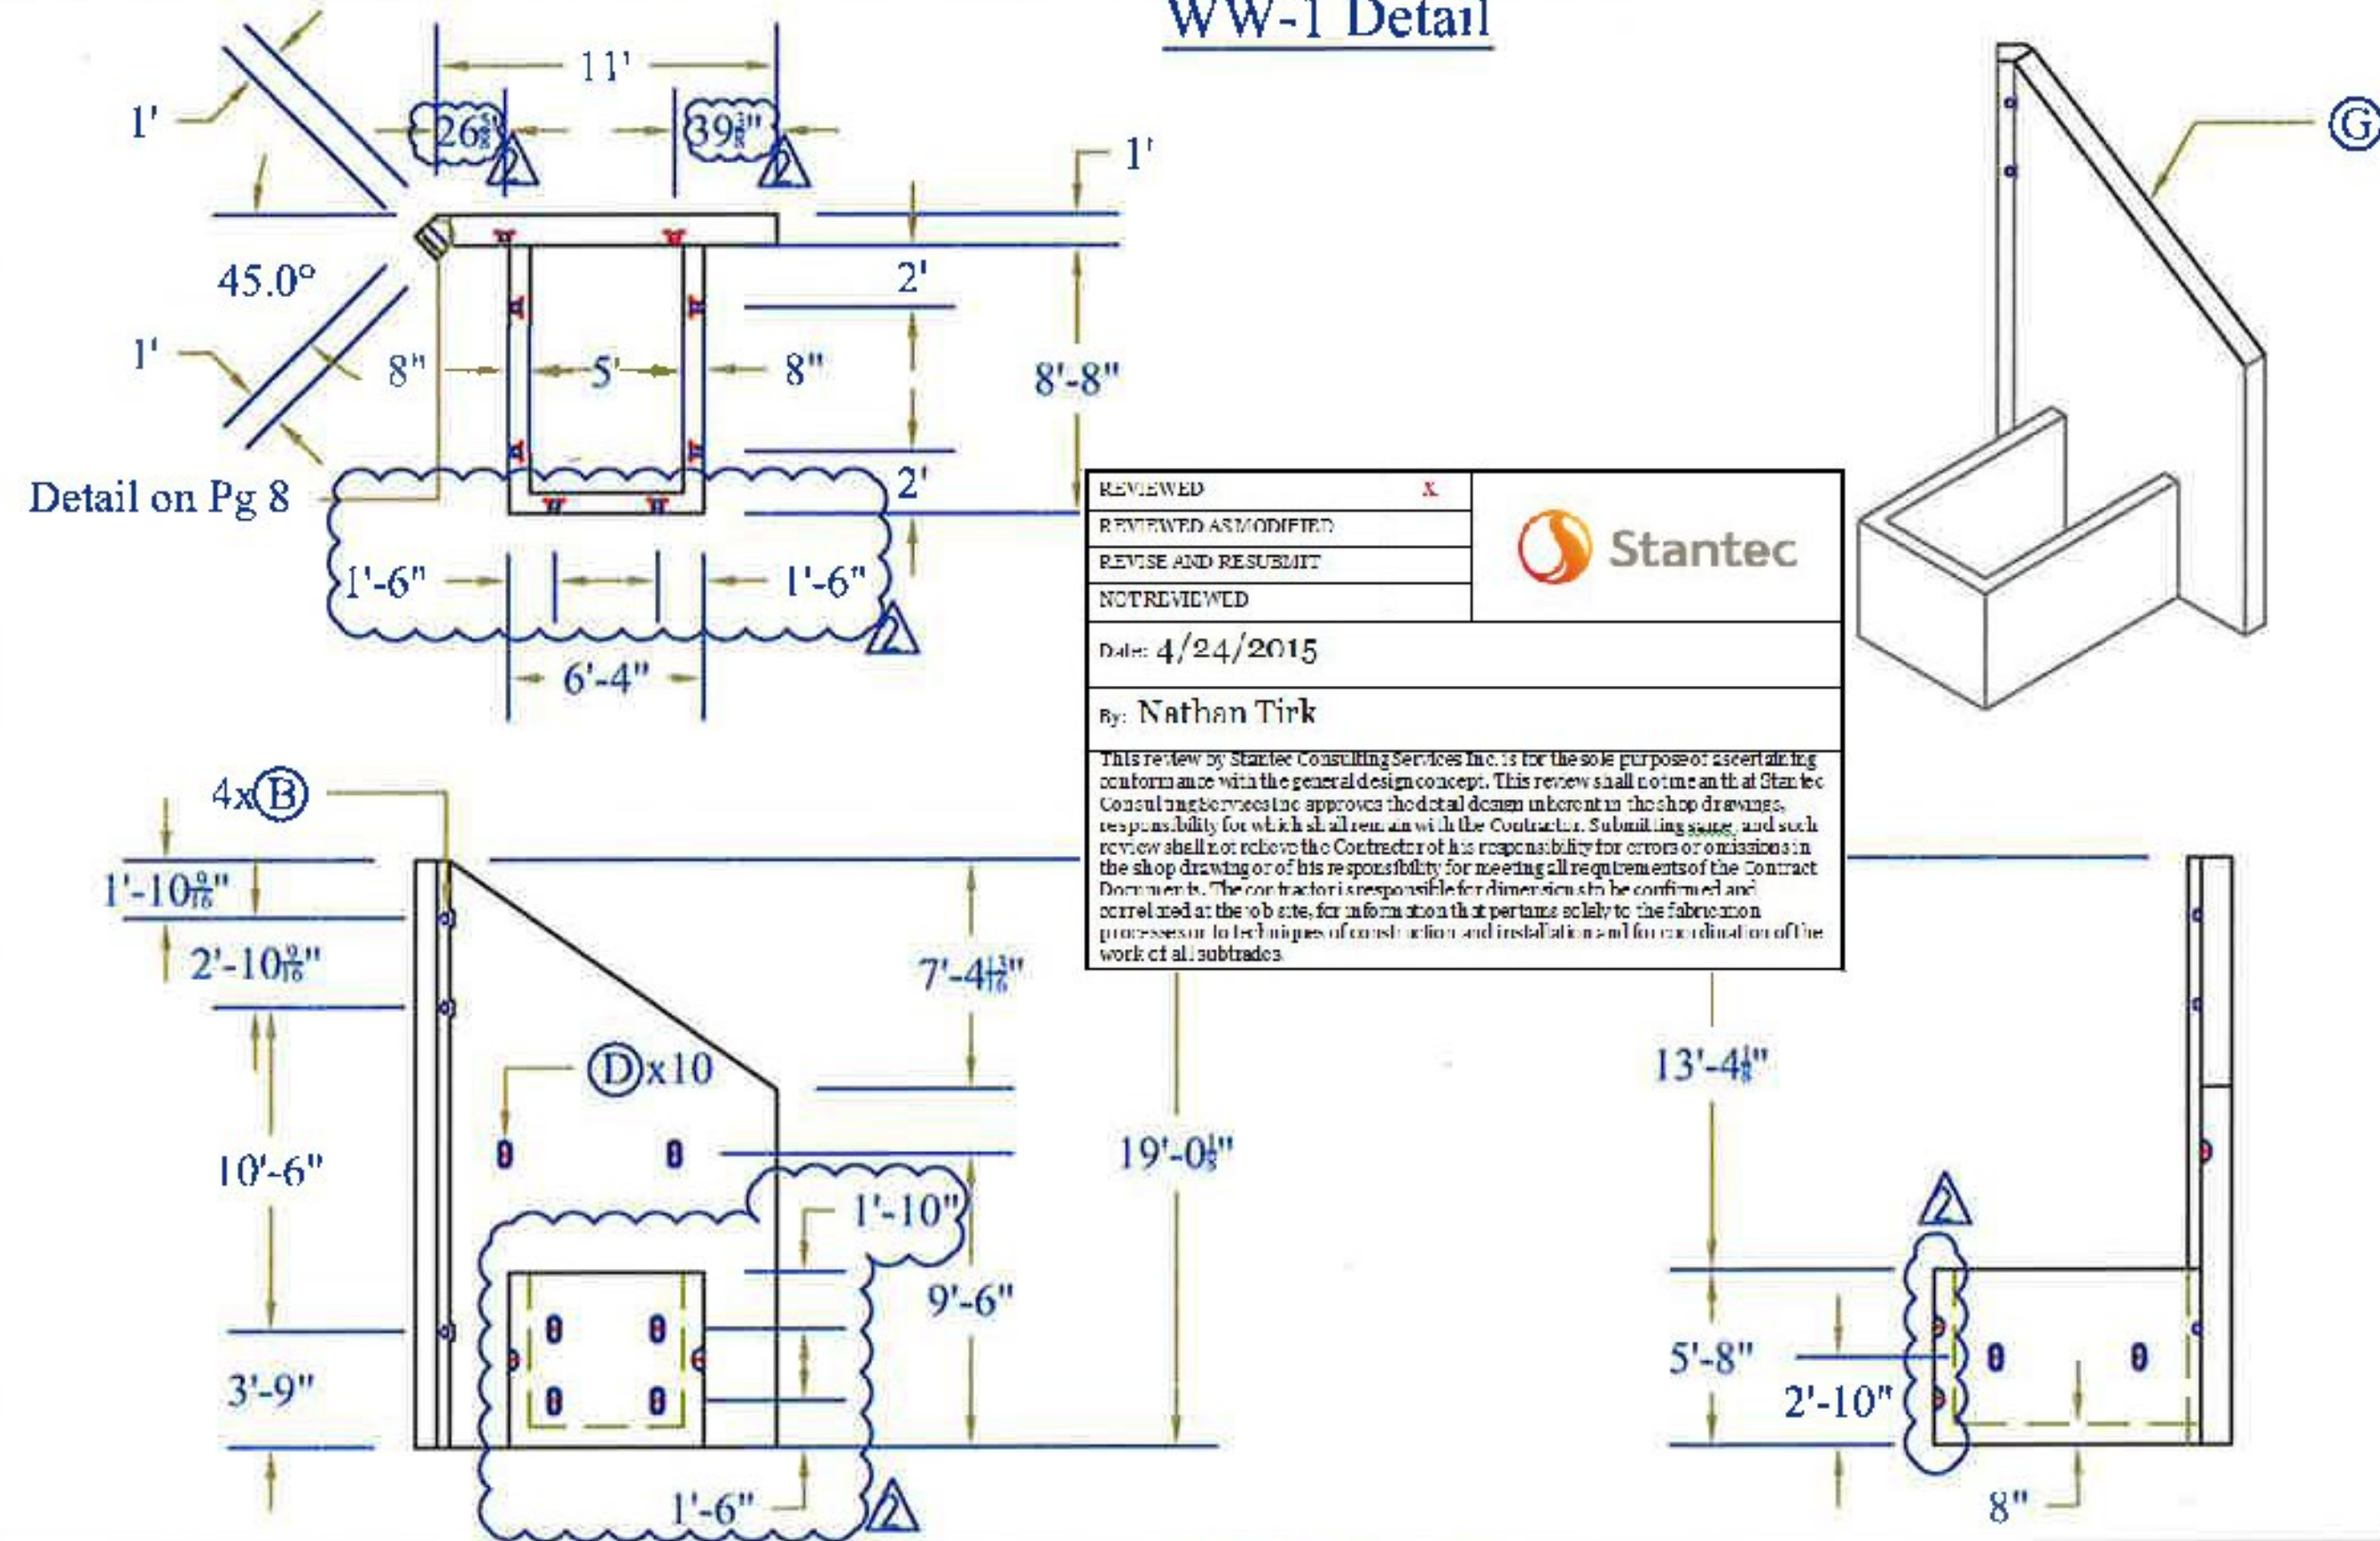


WW-3A Detail

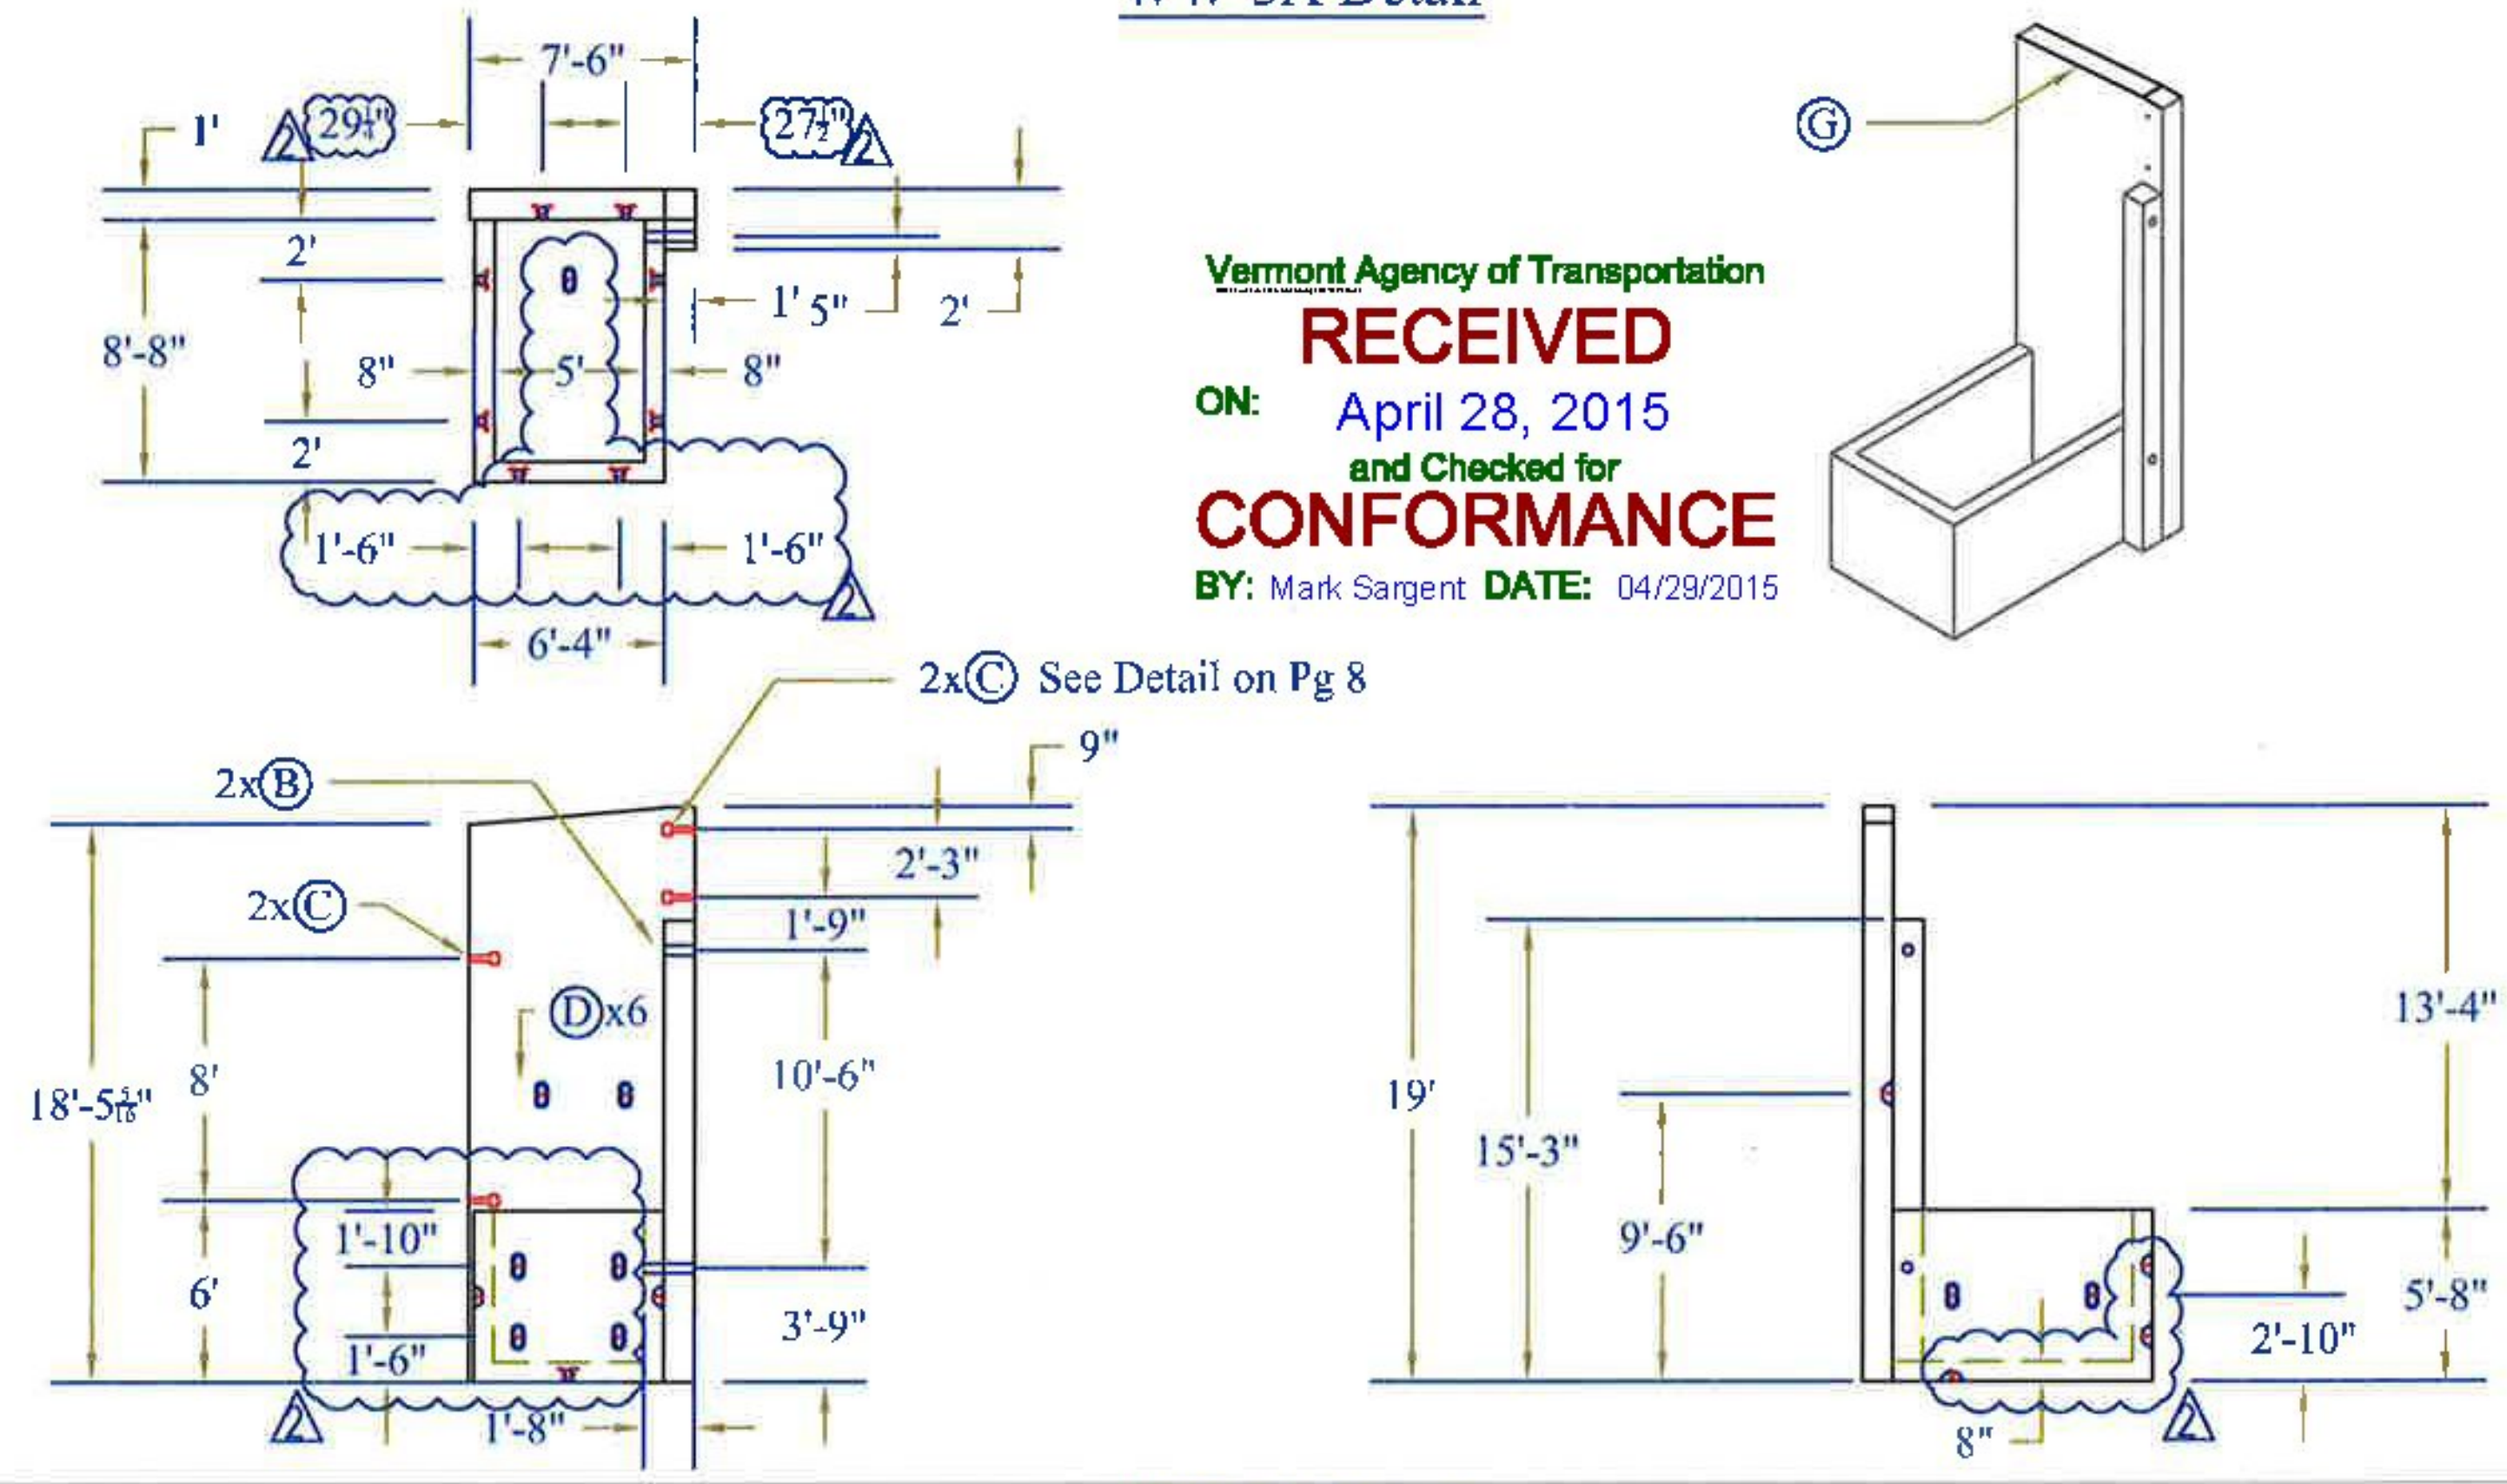

WW-2 Detail

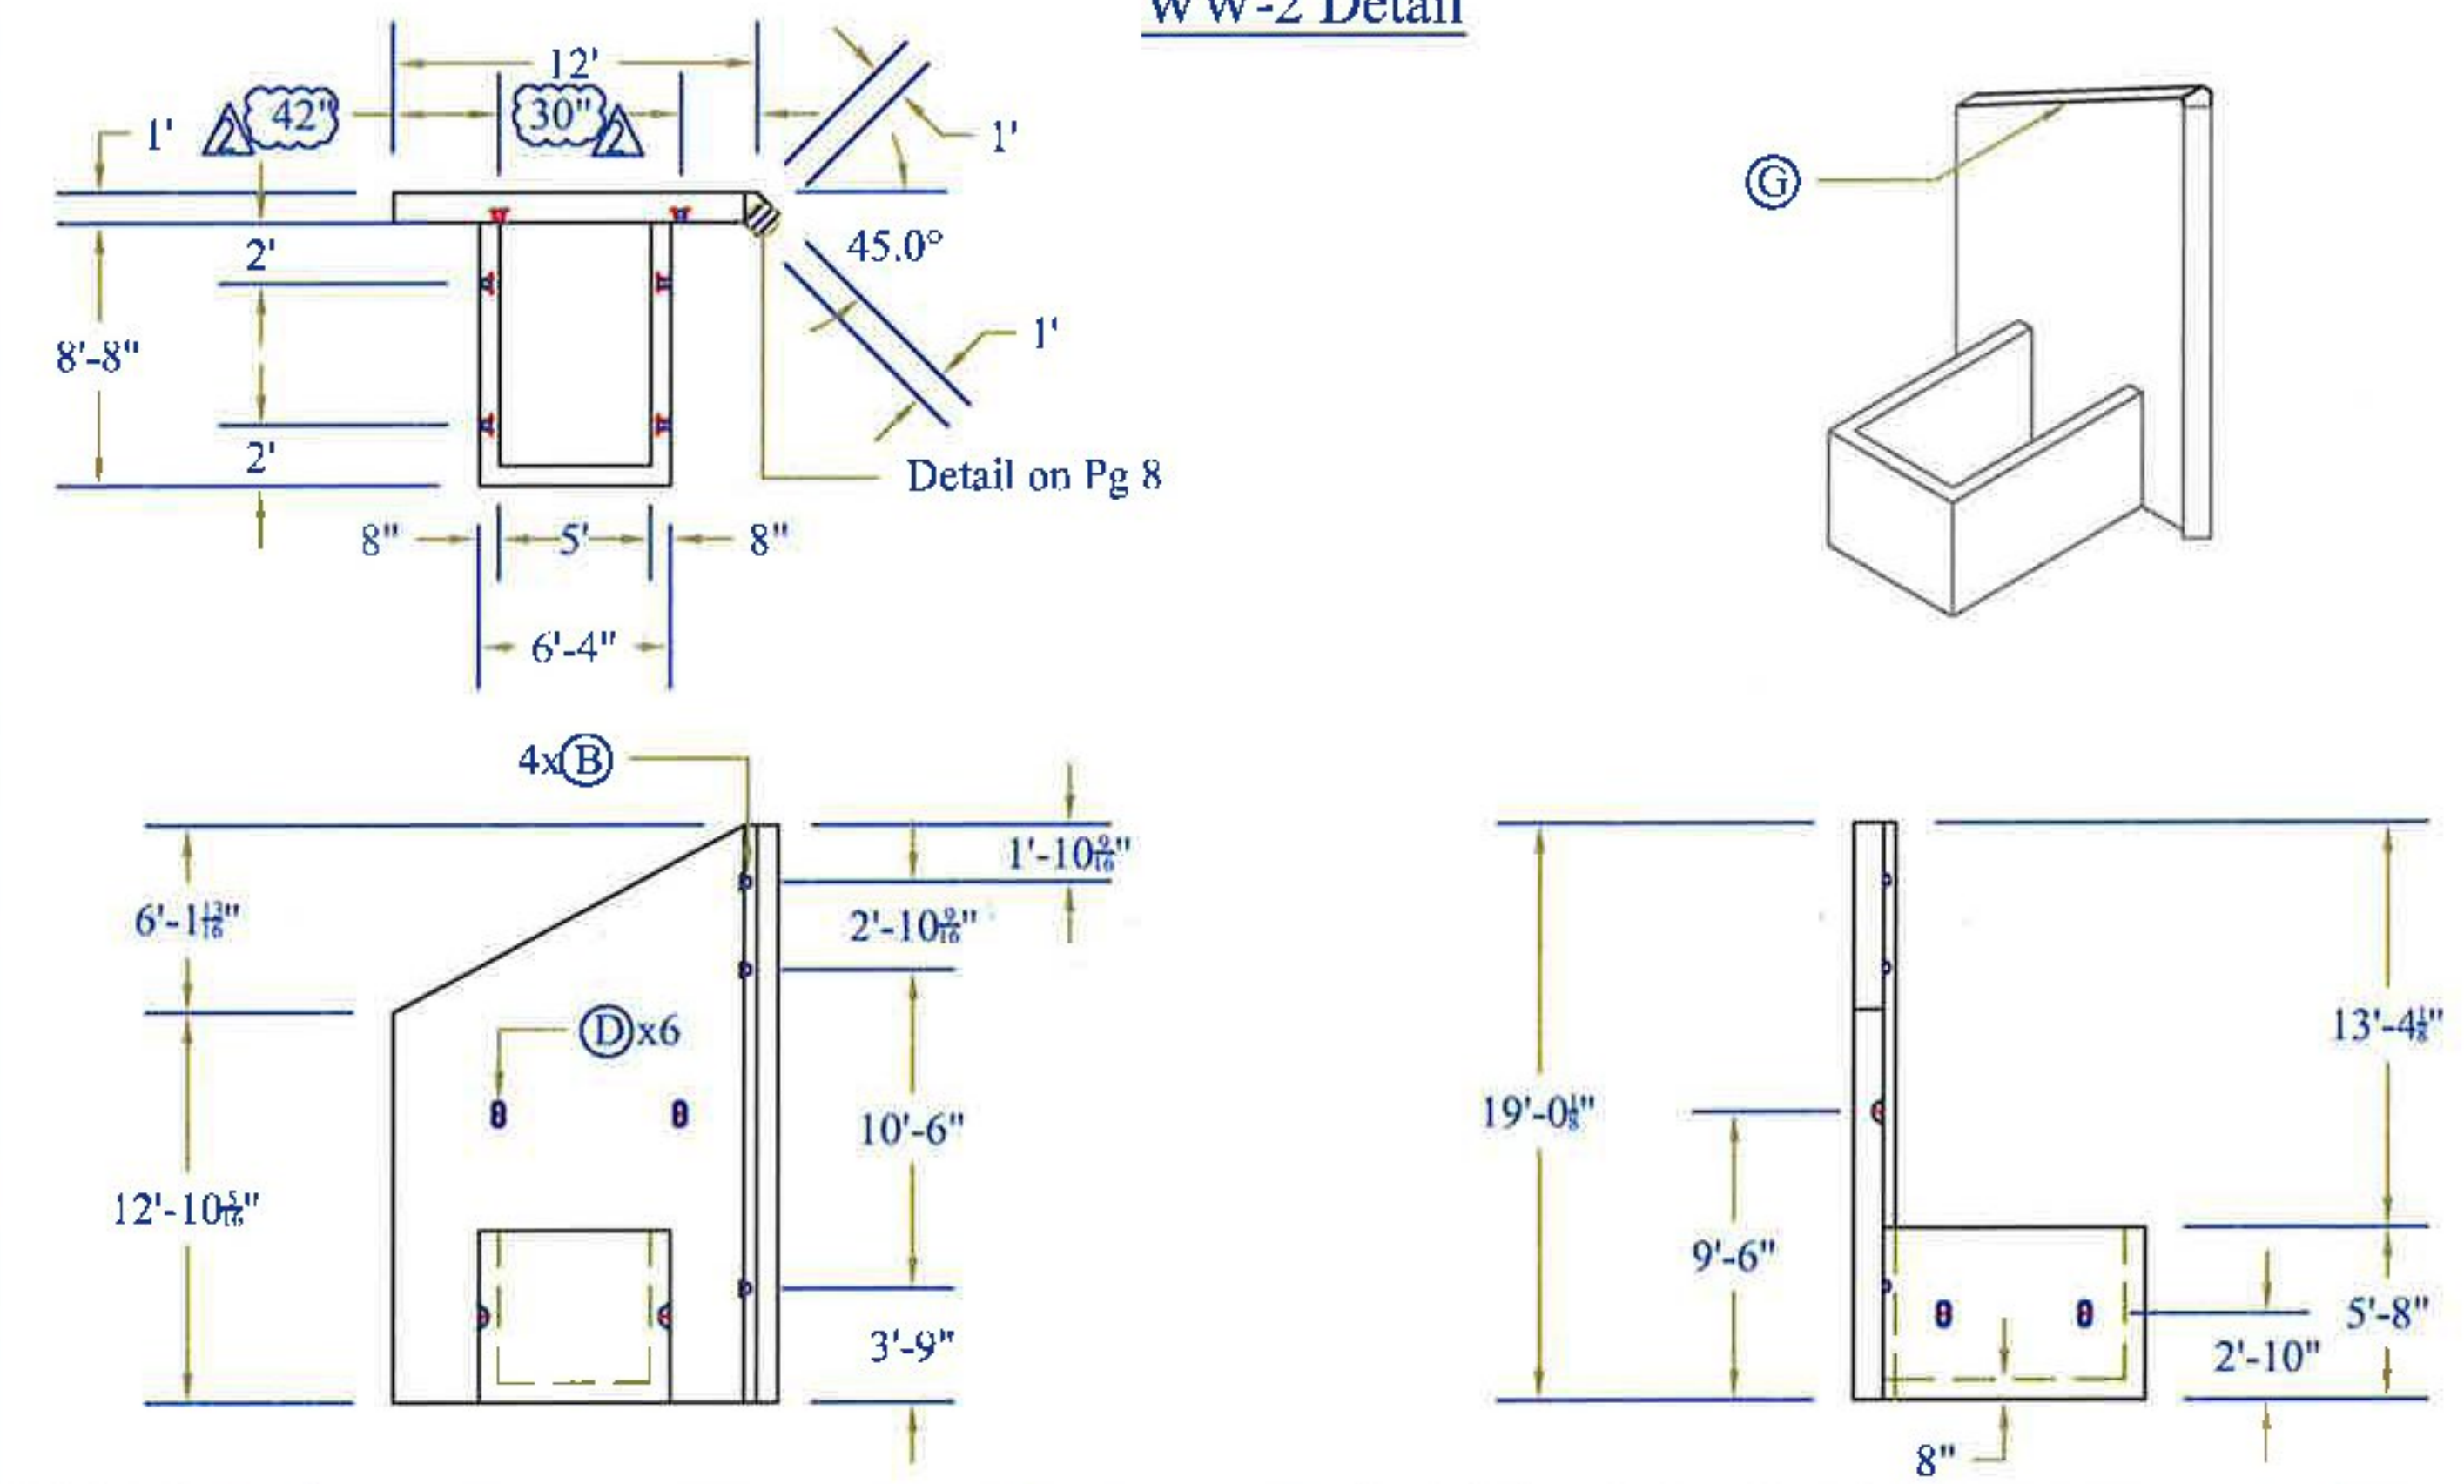


WW-3B Detail

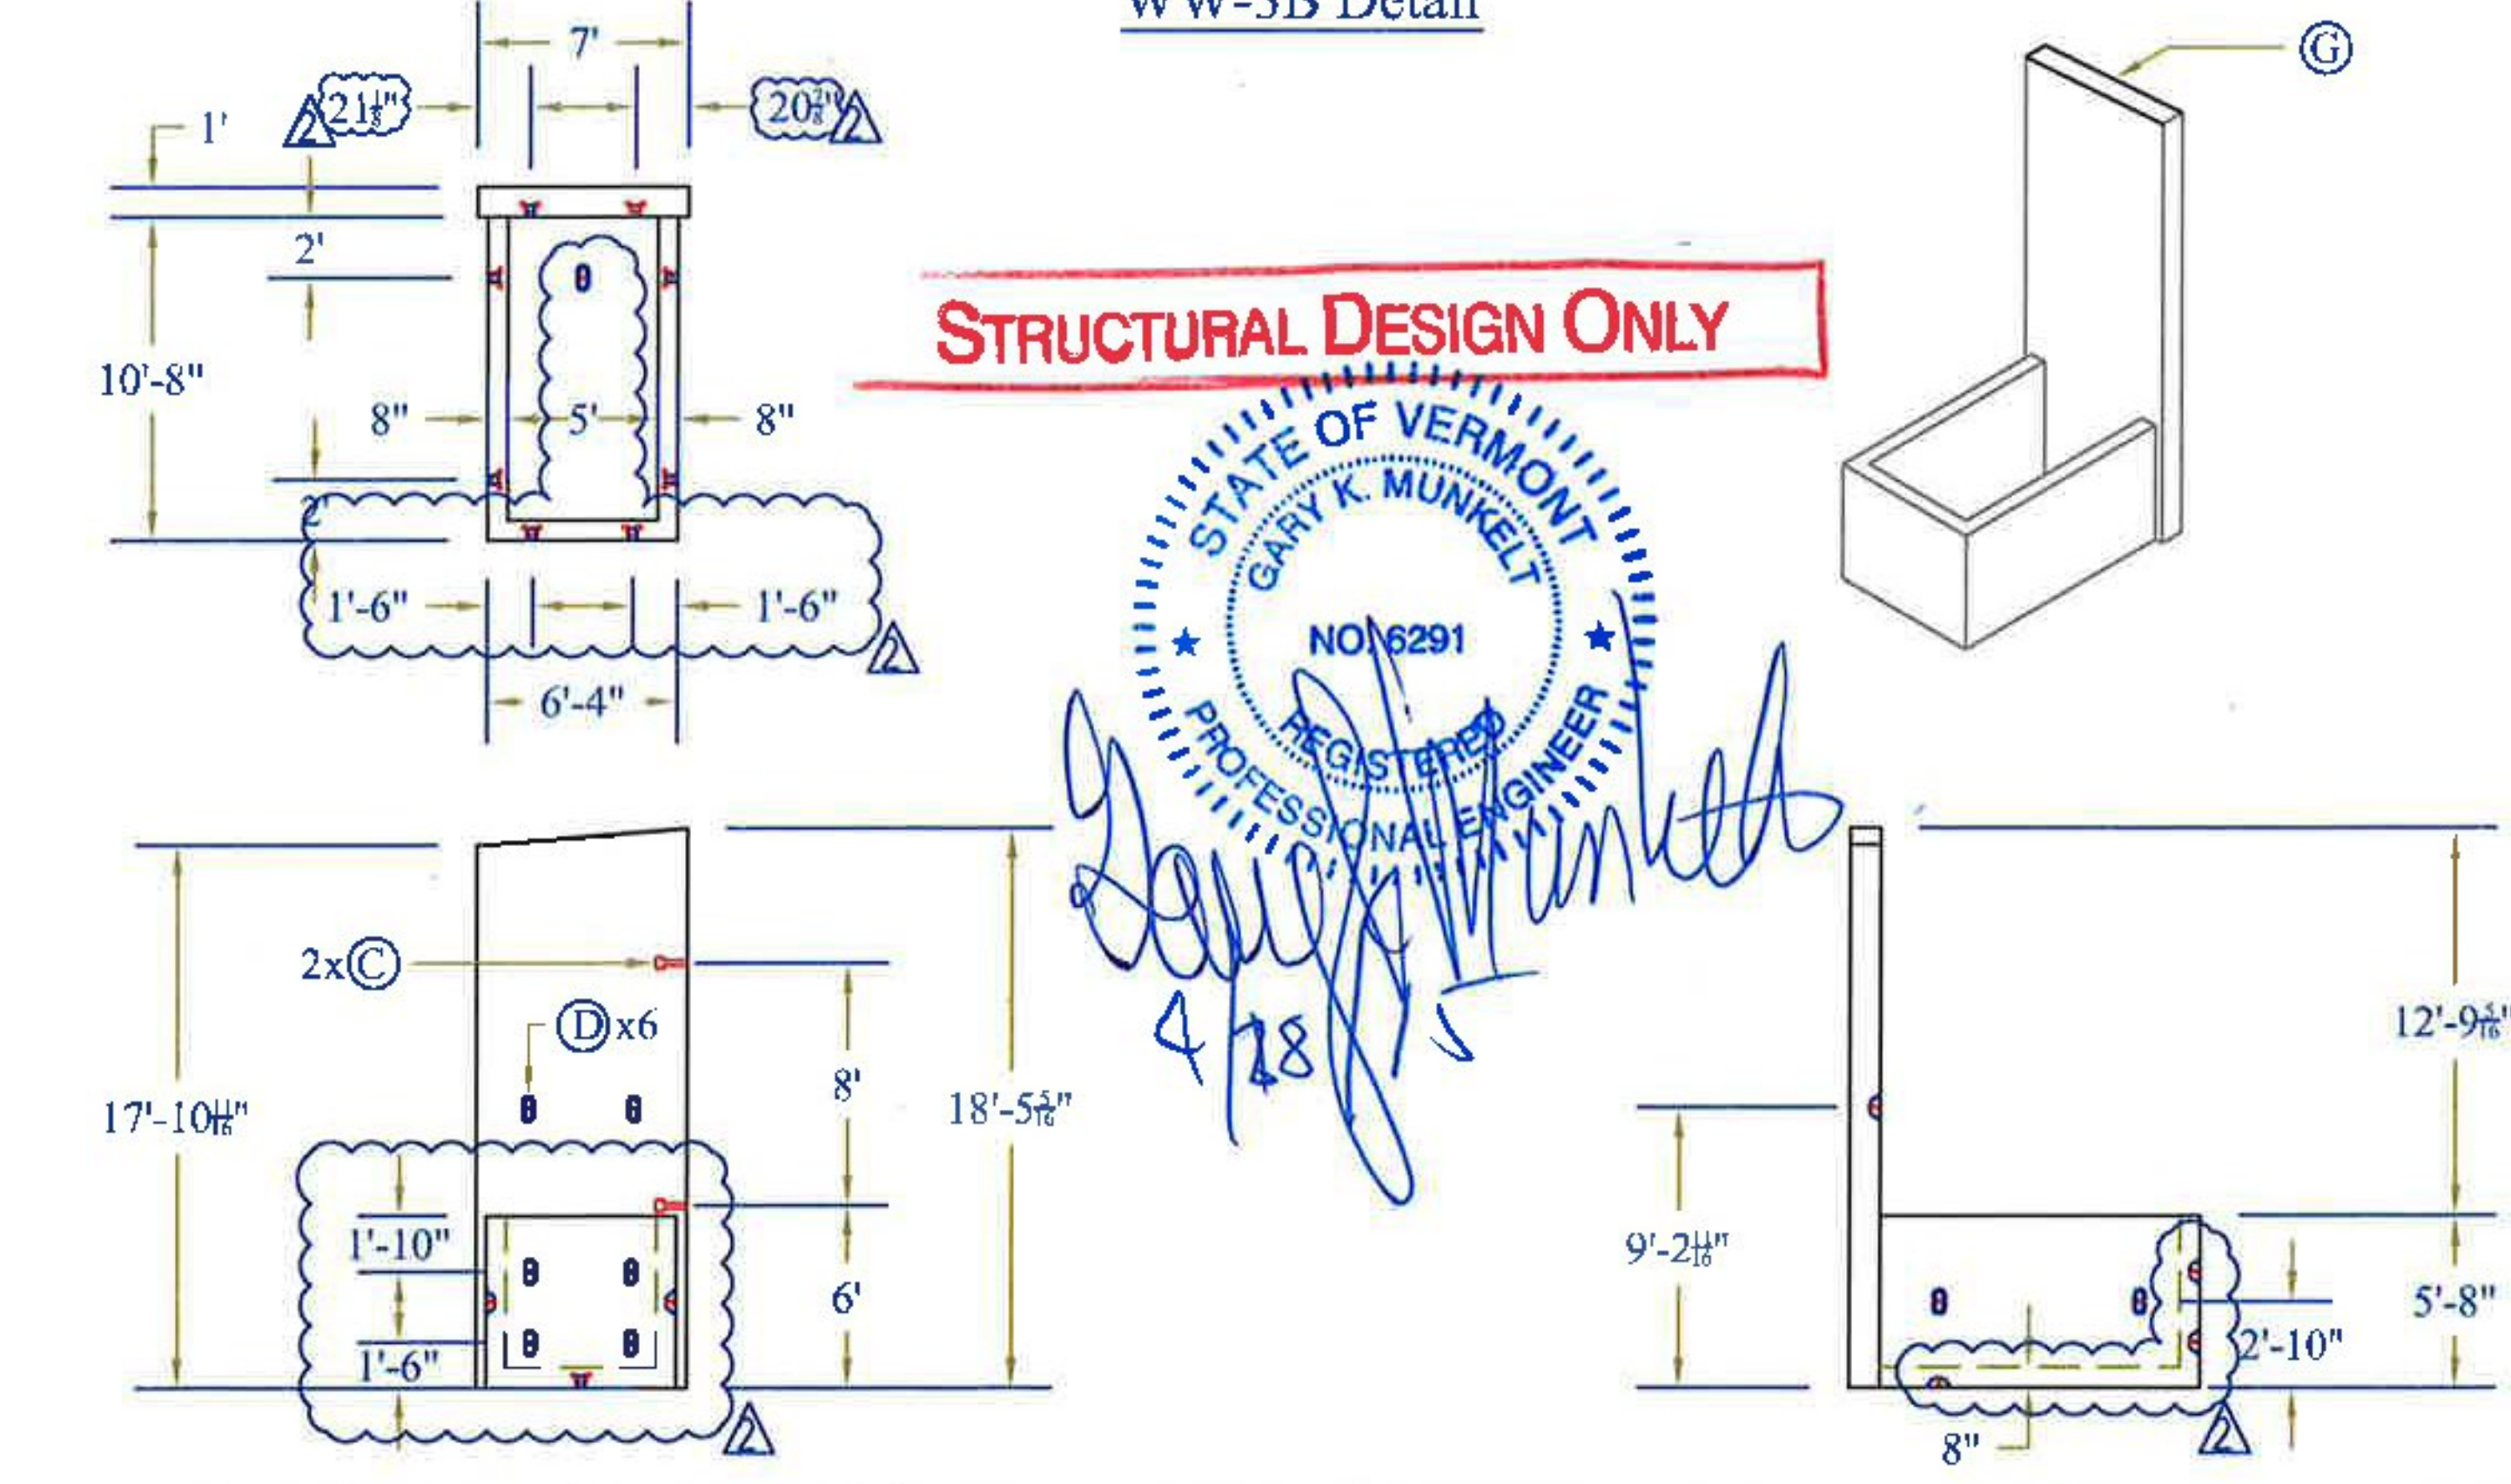


CONTRACTORS VISPE:	ⓐ 3"Ø PVC Sleeve	ⓐ Oxford A750-7 Lifting Device	ⓐ Solid Lines Indicate 1/2" Chamfer	Rev.	Date	By	Description	PRECAST CONCRETE BOX CULVERT SHOP DRAWINGS (SDI JOB #15428)	SUPERVISOR: E. Barendse DETAILER: I. ADAMS CHECKER: E. Barendse ENGINEER: G. K. Munkel	PROJECT NAME: Bridport PROJECT # CULV(29) Br.#2 LOCATION: Bridport, VT	Peckham Road Corp. 1557 St. Rt. 9, #3 Lake George, NY 12845 Ph: (518) 747-3353	FABRICATOR: 193 INDUSTRIAL AVE. WILLISTON, VT 05495 Ph: (802) 658-0201	<b>SD Ireland</b> PRECAST
	ⓑ 4"Ø PVC Sleeve	ⓑ 1"Øx5/8" F56 Coil Loop Insert	ⓑ 1/2" x 3 1/2" Continuous Keyway	1	03/25/15	IBA	Changes per Stantec & State Review						
	ⓒ Mechanical Bolt Pocket (w/ 1"Ø Coil Rod)	ⓒ 1/2" x 3 1/2" Continuous Keyway	ⓒ 5/8" Ferrule Loop Insert	2	04/23/15	IBA	Changes for Production Purposes						

**RECEIVED**  
 ON: April 28, 2015  
 and Checked for  
**CONFORMANCE**  
 BY: Mark Sargent DATE: 04/29/2015


**WW-4A Detail**

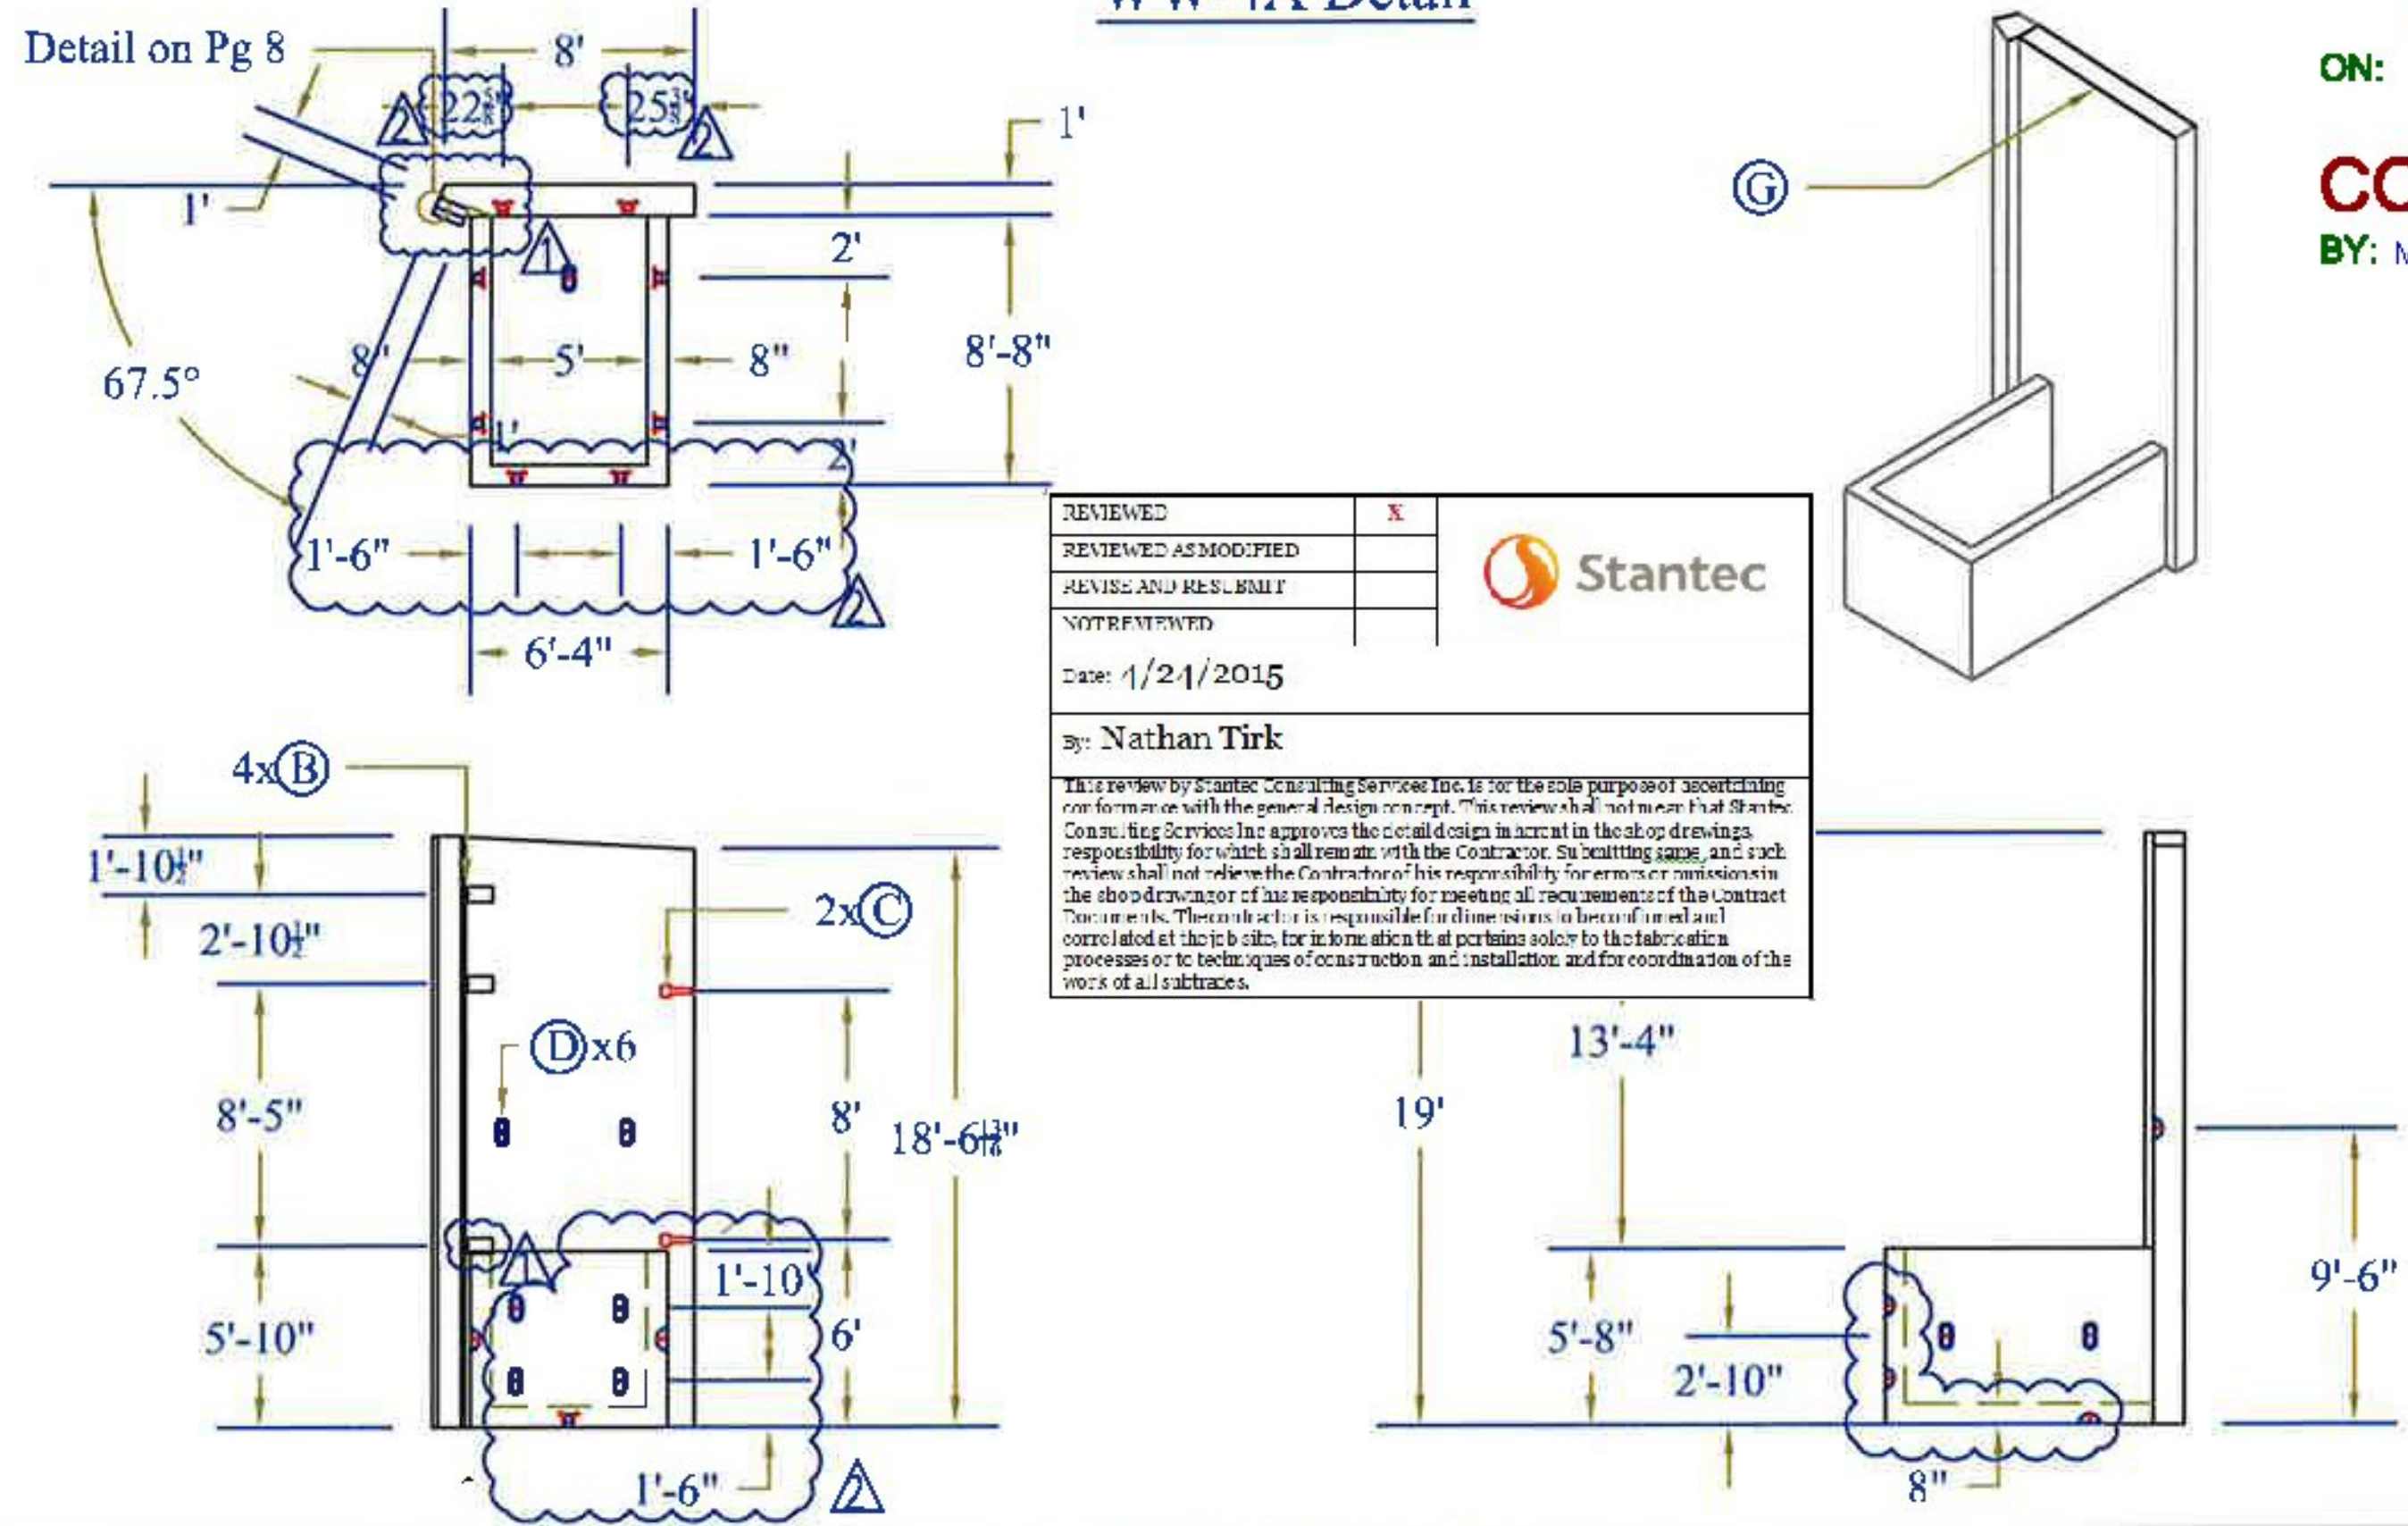

**WW-4B Detail**

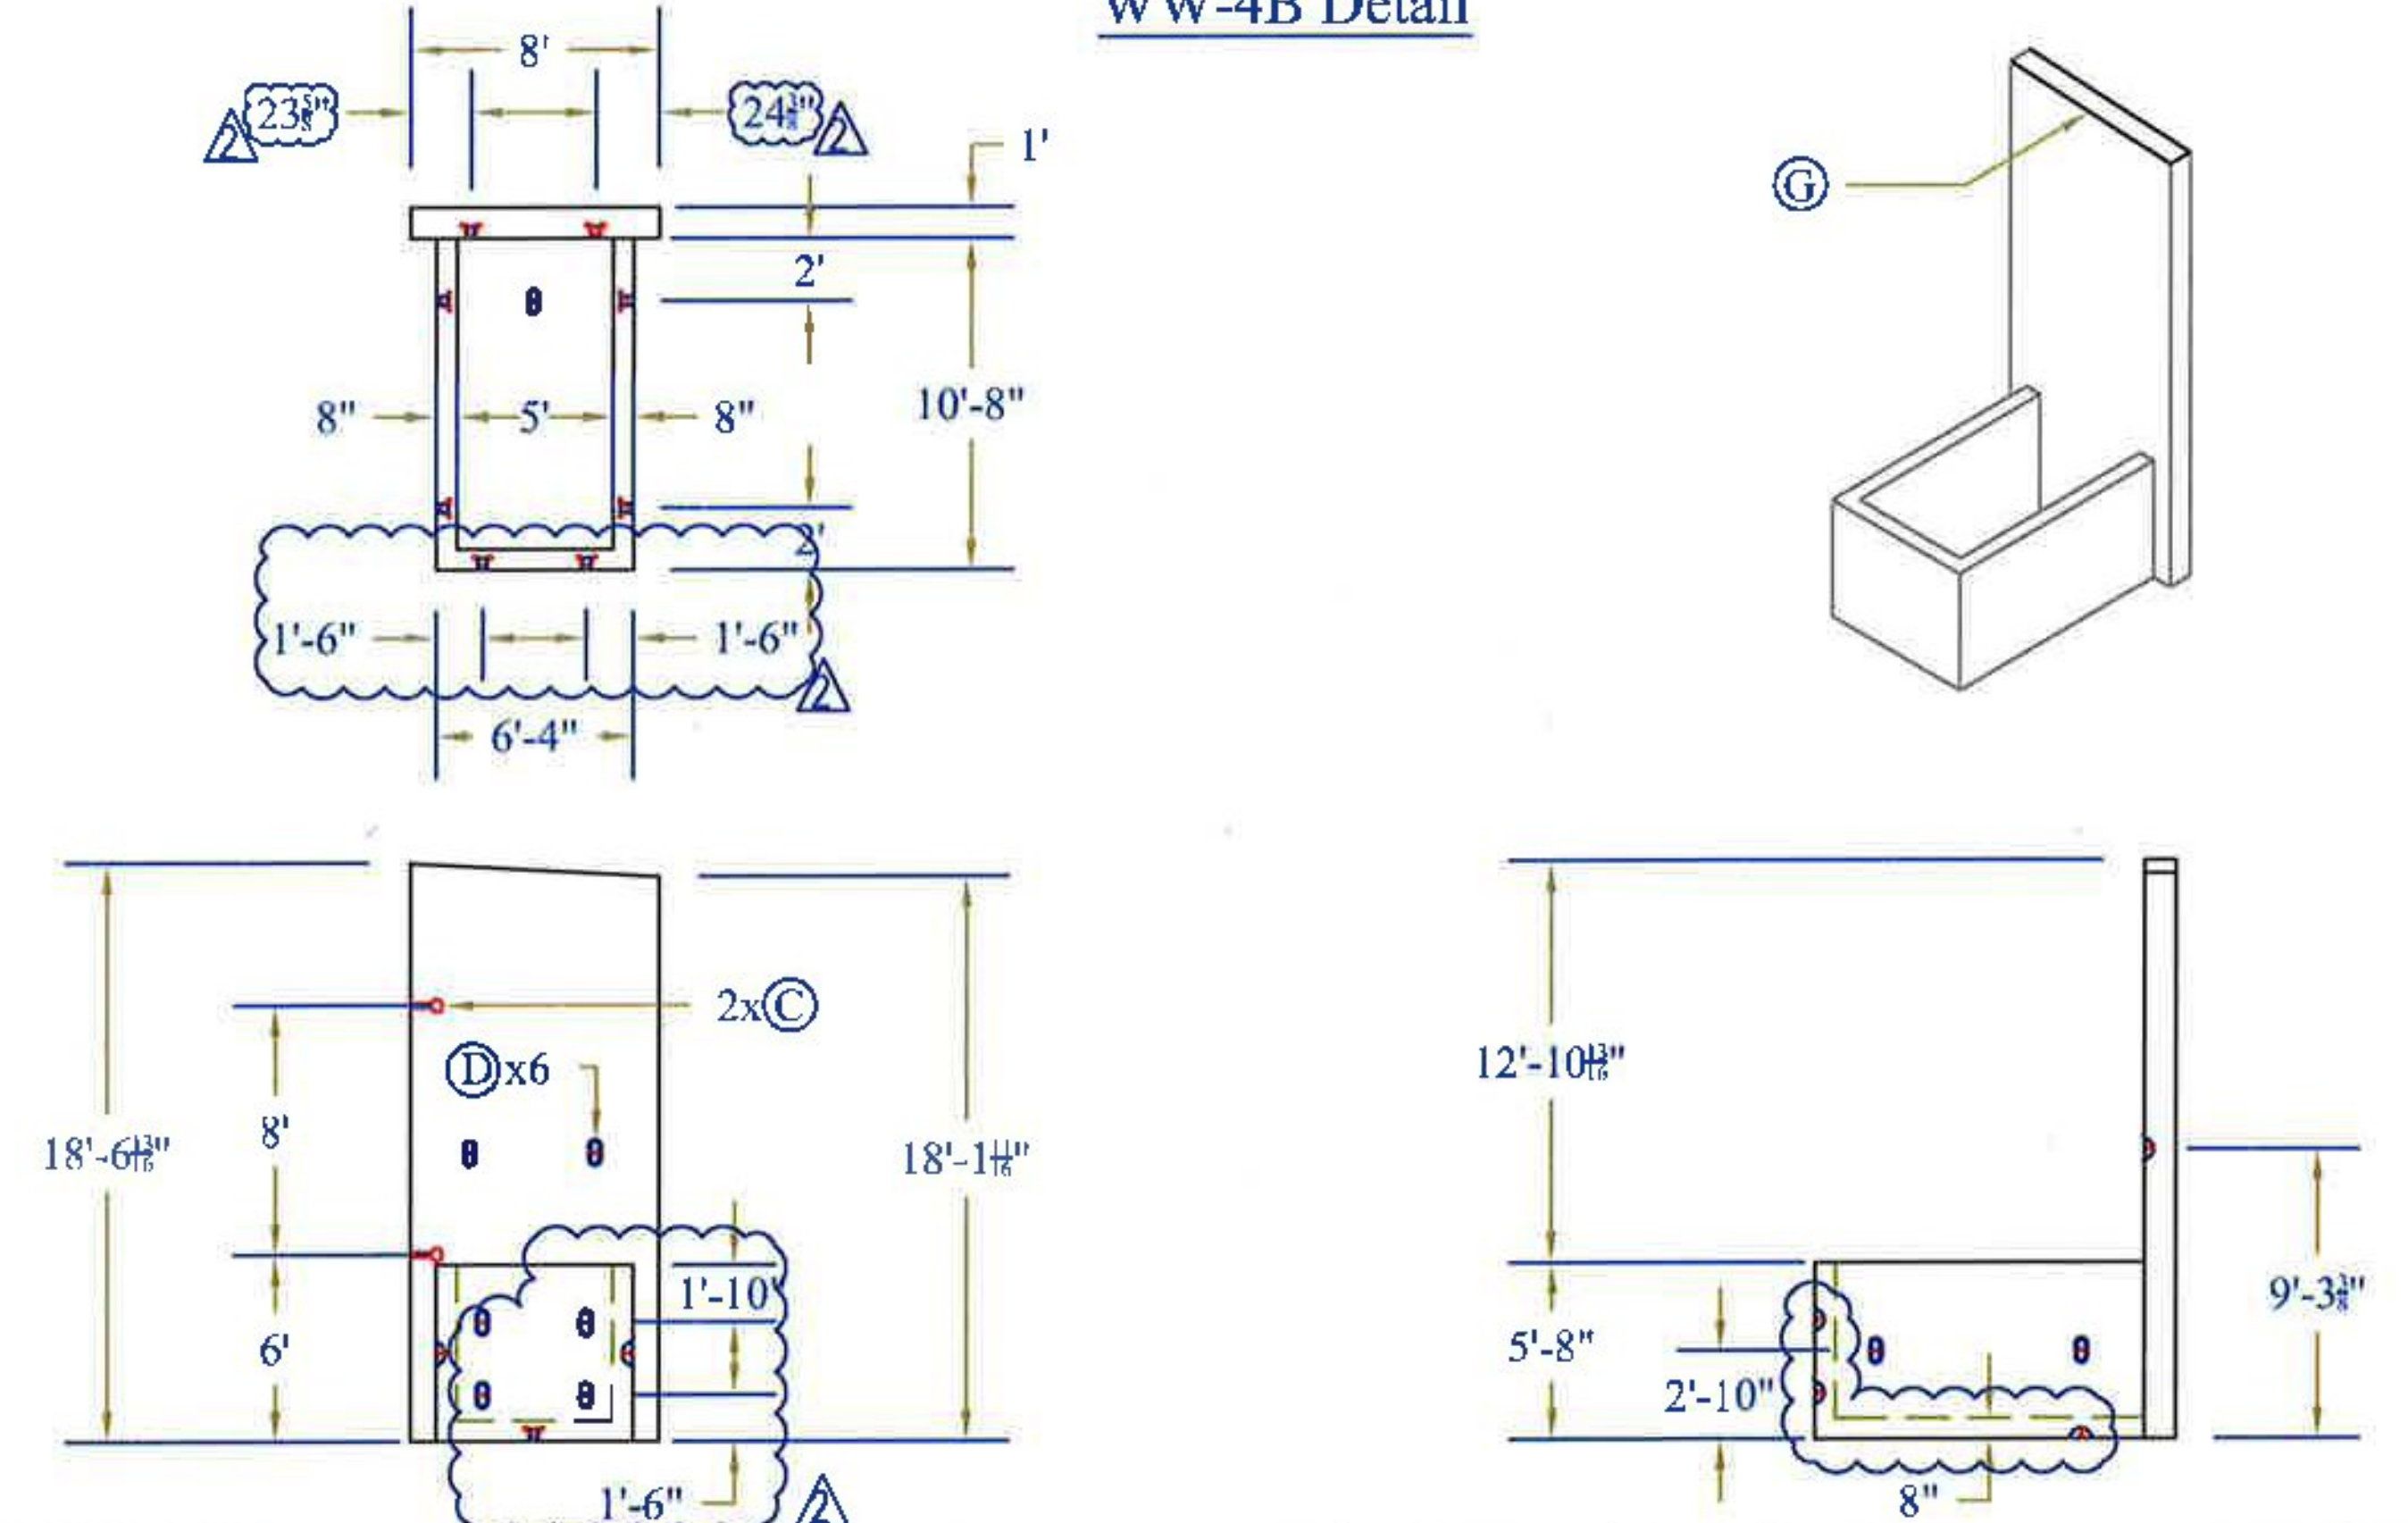



**WW-Reinforcing Detail**

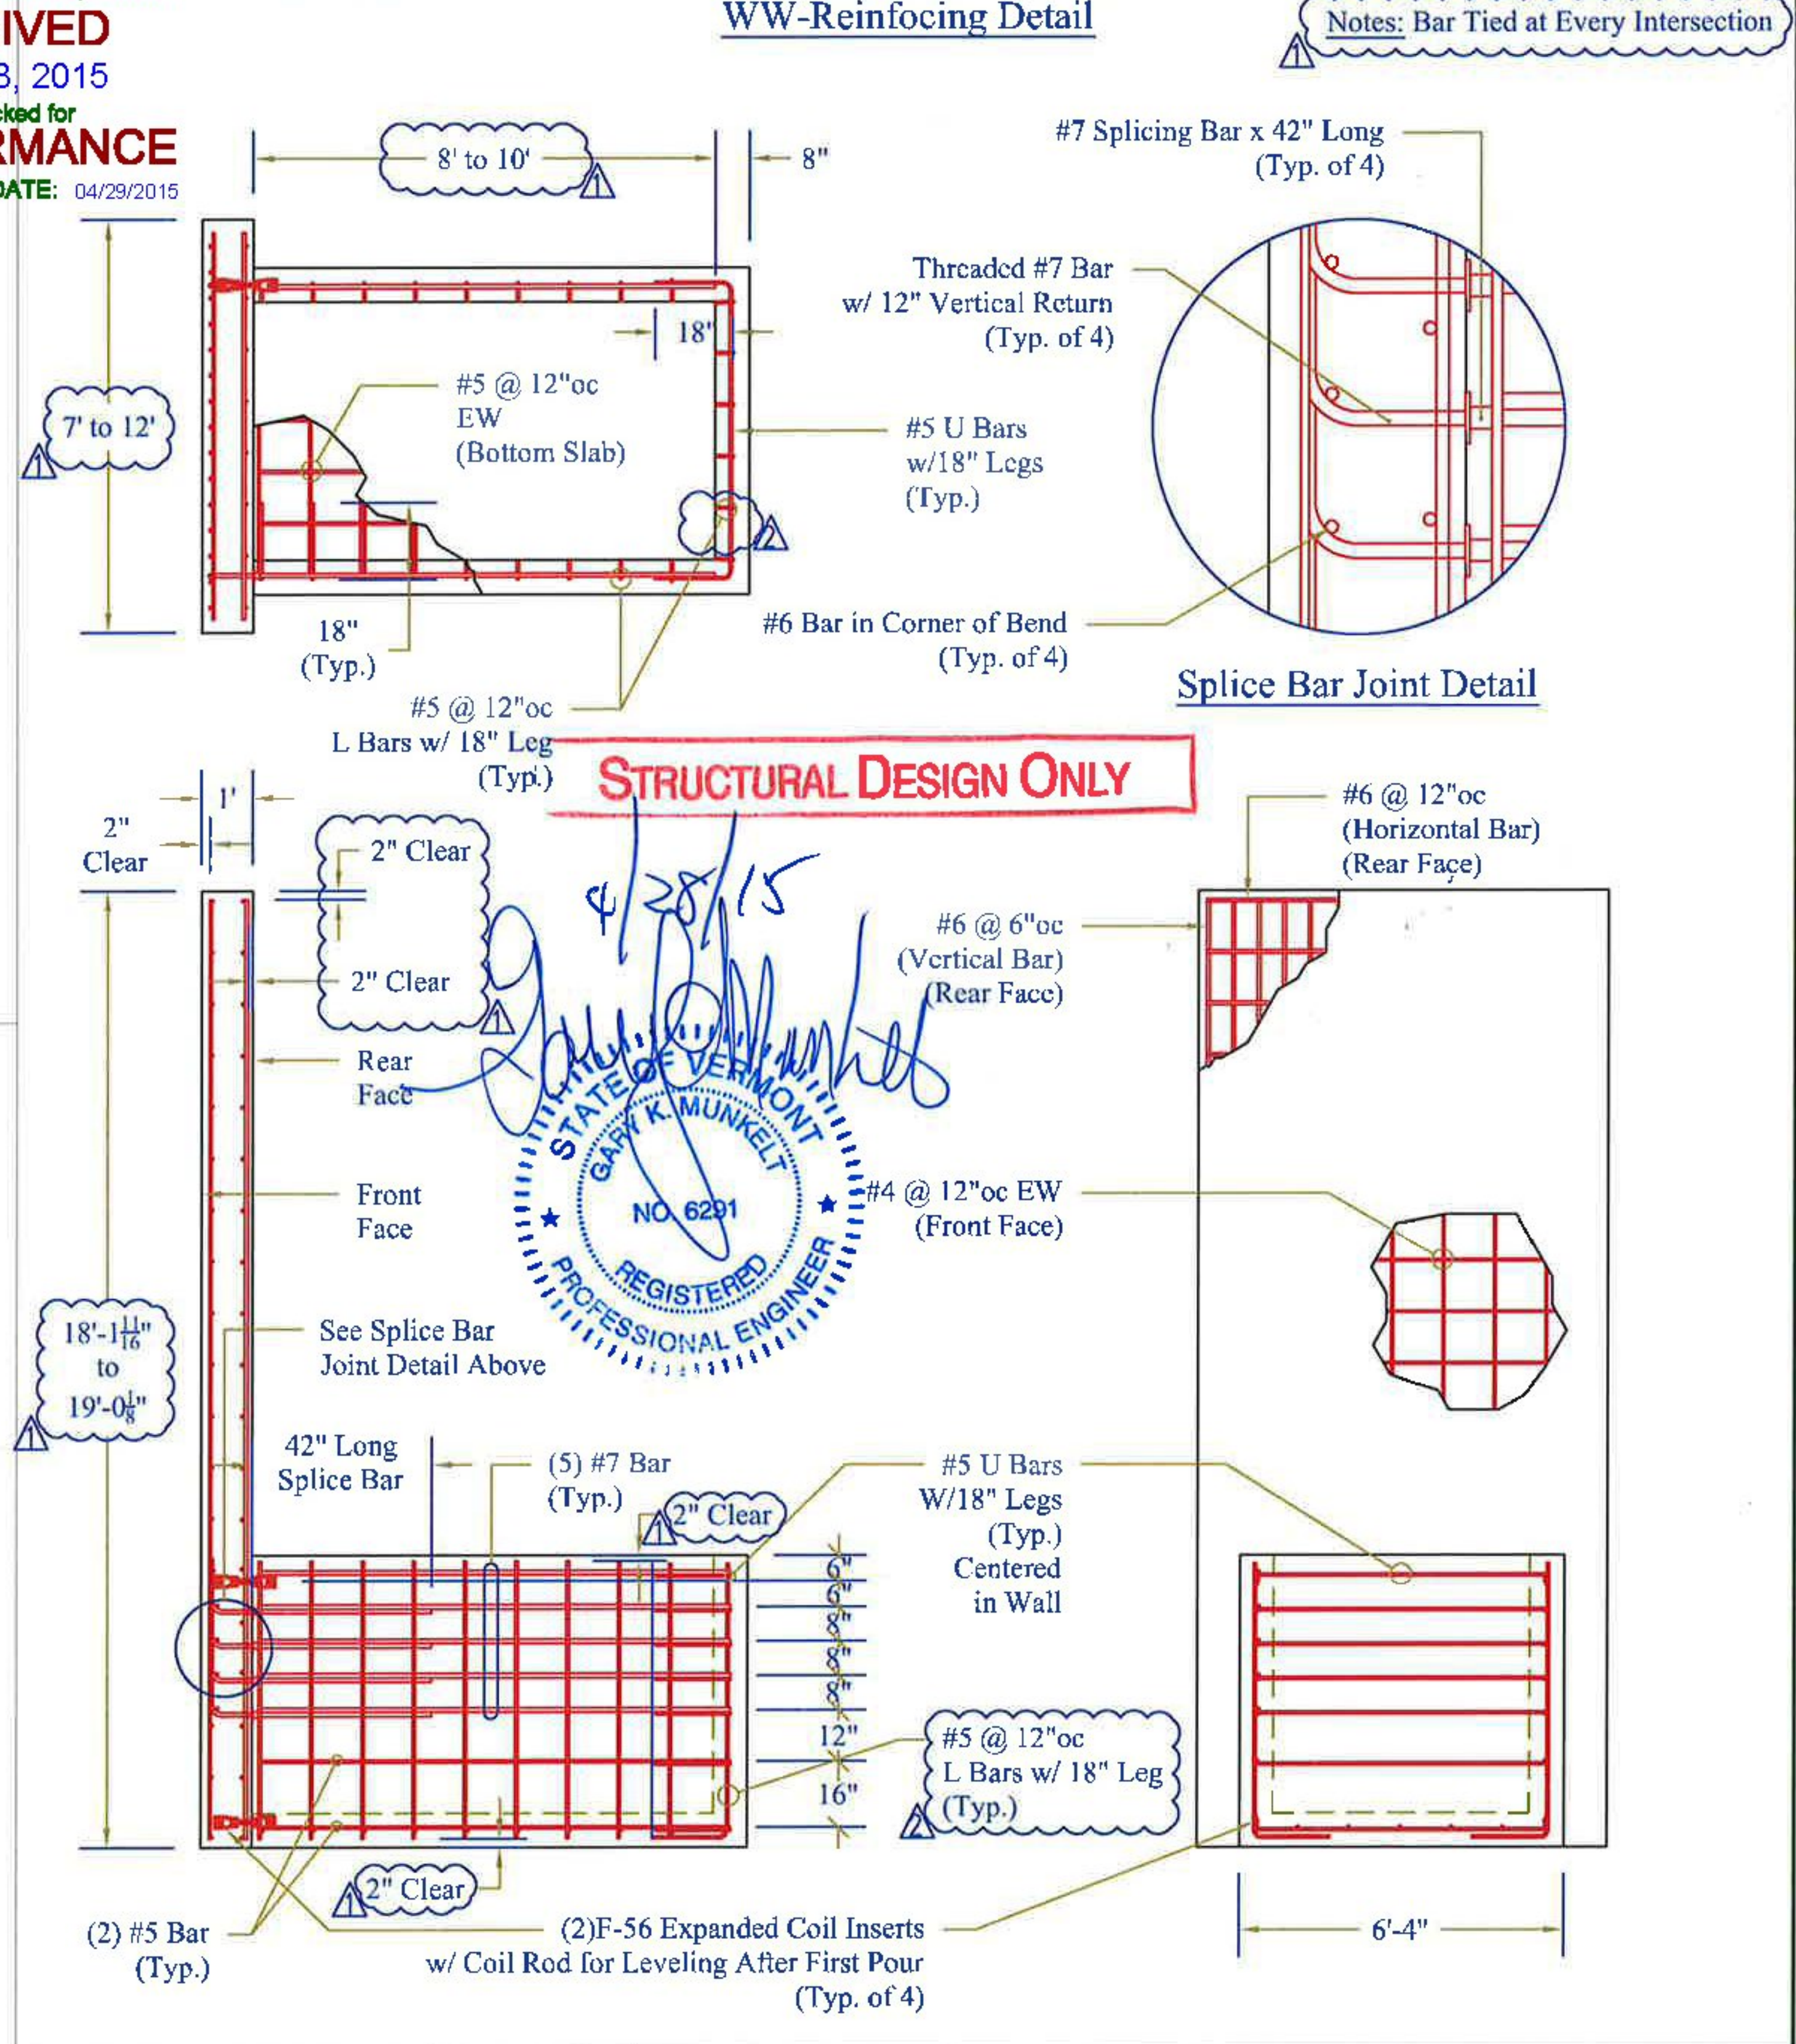

CONTRACTORS VISPE:	Rev.	Date	By	Description
(A) 3"Ø PVC Sleeve	1	03/25/15	IBA	Changes per Stantec & State Review
(B) 4"Ø PVC Sleeve	2	04/23/15	IBA	Changes for Production Purposes
(C) Mechanical Bull Pocket (w/ 1"Ø Coil Rod)				
(D) Oxford A750-7 Lifting Device				
(E) 1"Øx5 1/2" F56 Coil Loop Insert				
(F) 1 1/2" x 3 1/2" Continuous Keyway				
(G) Solid Lines Indicate 3/8" Chamfer				
(H) F64 Female Loop Insert				

PRECAST CONCRETE BOX CULVERT SHOP DRAWINGS (SDI JOB #15428)	Peckham Road Corp. 1557 St. Rt. 9, #3 Lake George, NY 12845 Ph: (518) 747-3353	FABRICATOR: 193 INDUSTRIAL AVE. WILLISTON, VT 05495 Ph: (802) 658-0201
SUPERVISOR: E. Barendse DETAILER: I. ADAMS CHECKER: E. Barendse ENGINEER: G. K. Munkelt	PROJECT NAME: Bridport PROJECT #: CULV(29) Br.#2 LOCATION: Bridport, VT	<b>SD Ireland PRECAST</b>
	02/12/15	WING_WALLS_2
		6_OF_8

**Headwall 1 Detail**

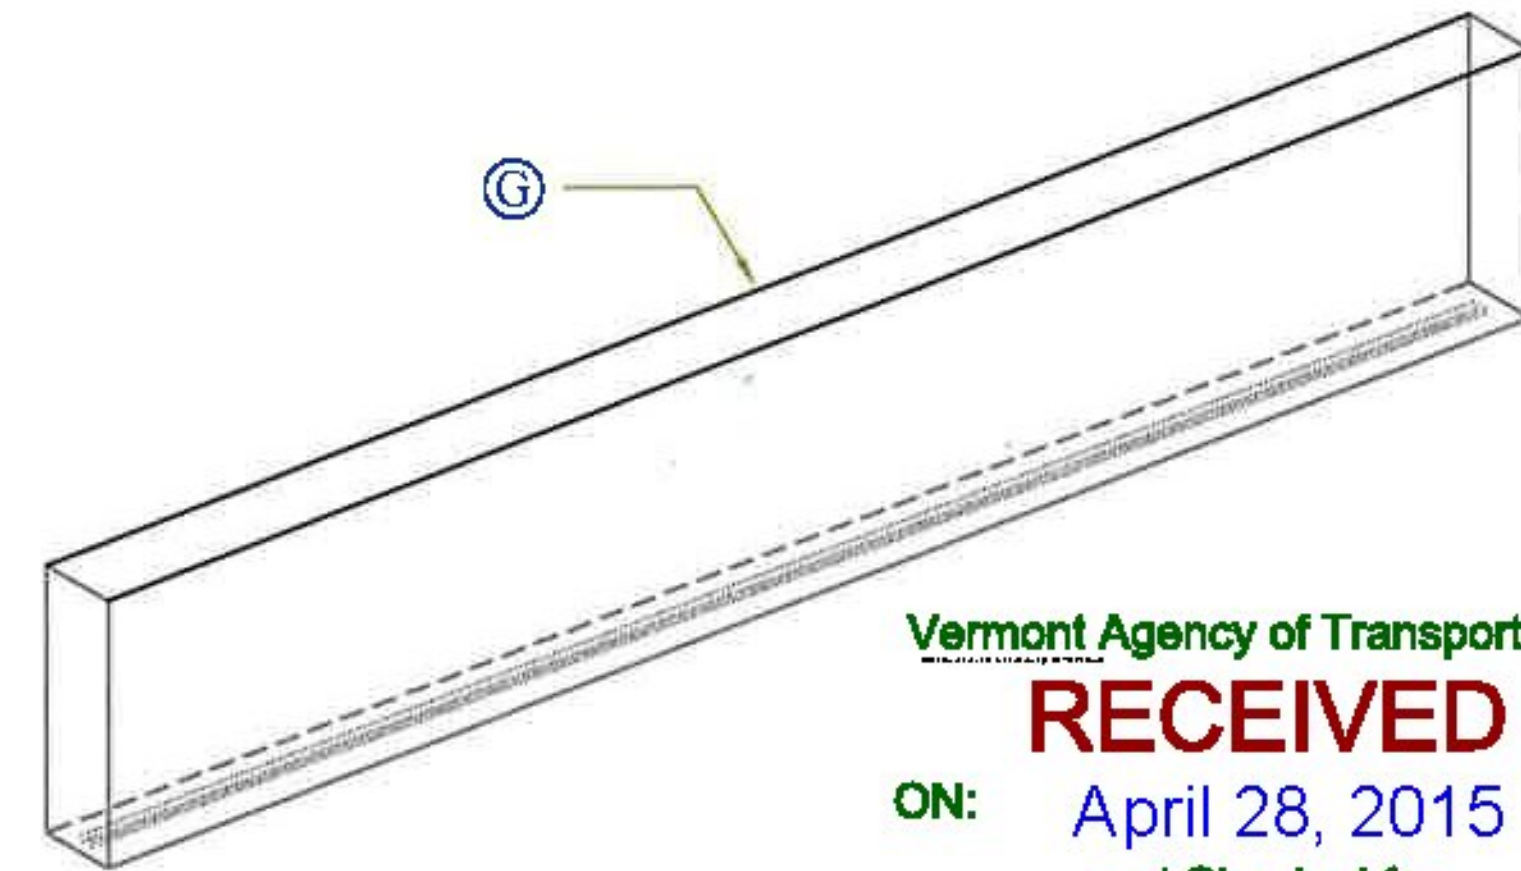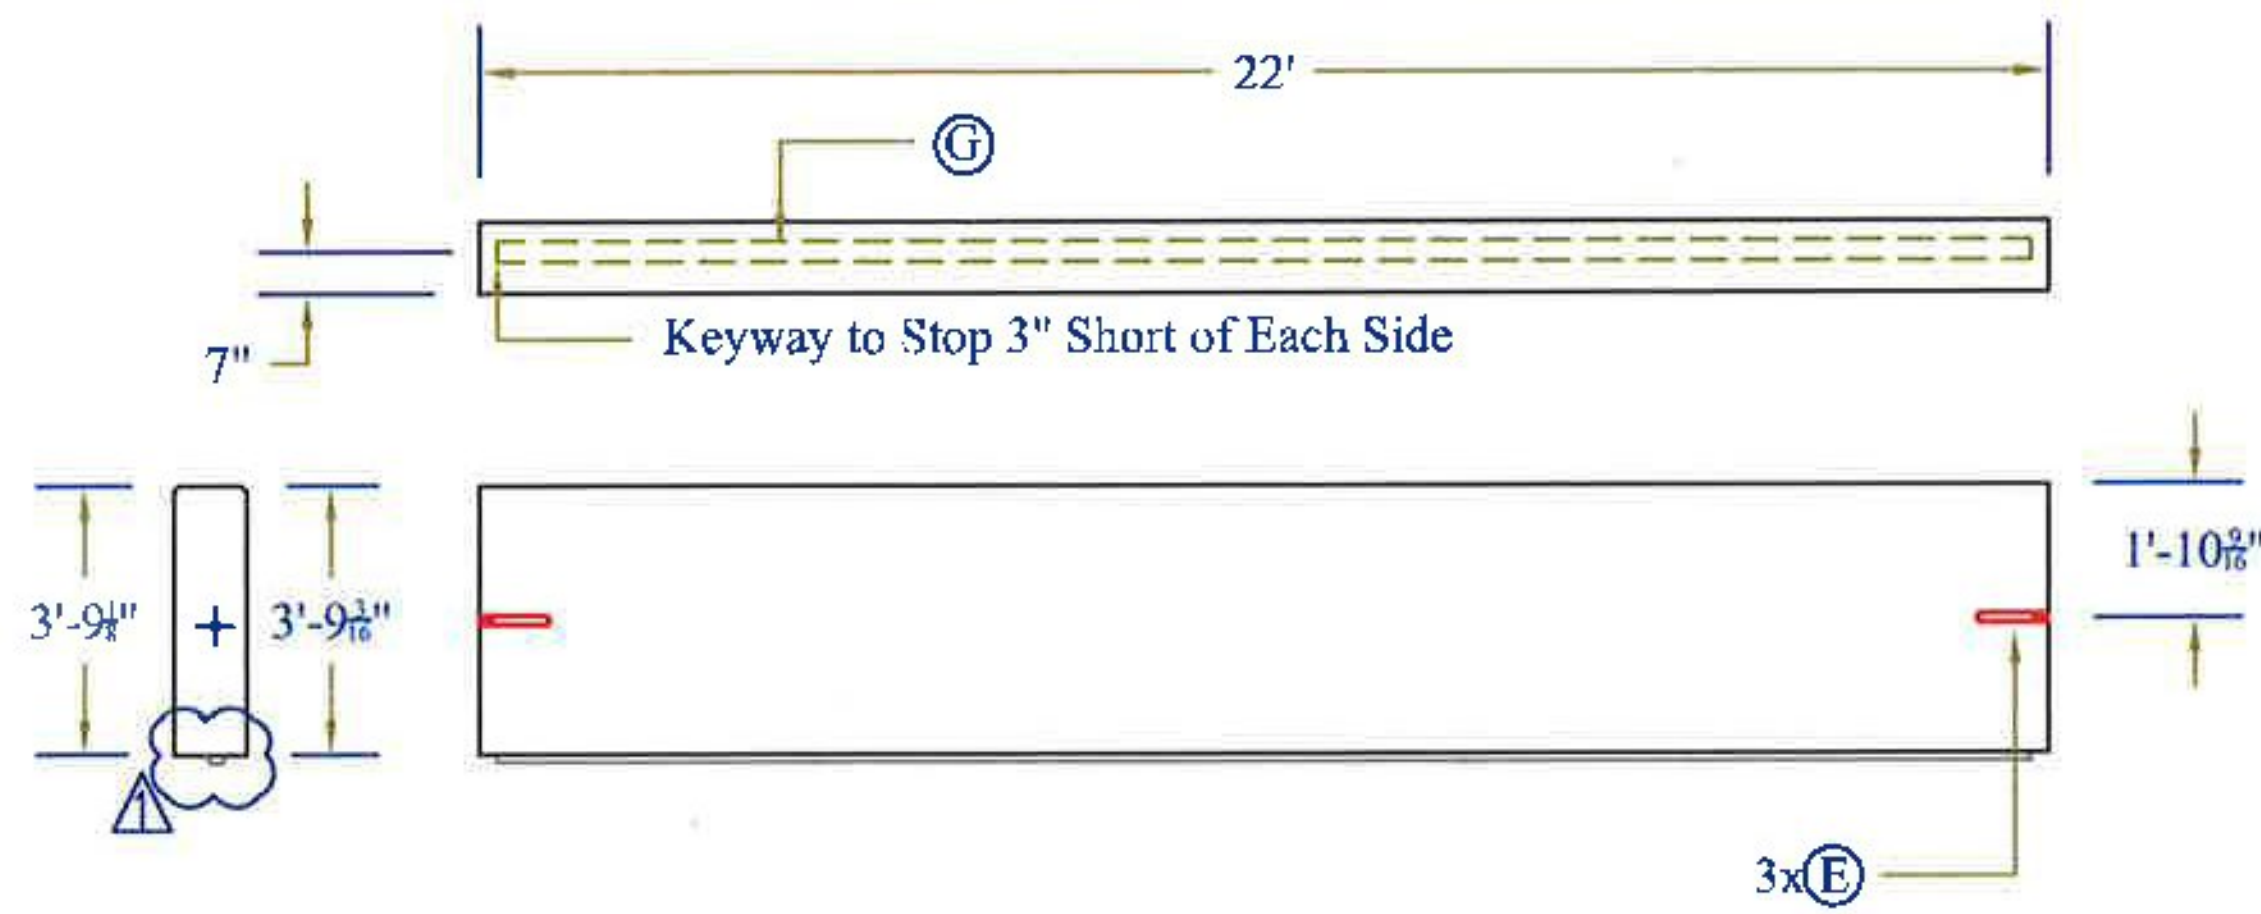

Vermont Agency of Transportation  
**RECEIVED**  
 ON: April 28, 2015  
 and Checked for  
**CONFORMANCE**  
 BY: Mark Sargent DATE: 04/29/2015

REVIEWED  
 DESIGNED AND CHECKED  
 REVIEW AND REVISIONS  
 NOT REVIEWED



Date: 4/24/2015

By: Nathan Tirk

This review by Stantec Consulting Services Inc. is for the sole purpose of ascertaining conformance with the general design concept. This review is not a guarantee of the design or construction. The contractor is responsible for ensuring all requirements of the Contract Documents. The contractor is responsible for maintaining the design and construction in accordance with the approved design and construction documents and for coordination of the work of all trades.

**Stantec**


**Headwall 2 Detail**

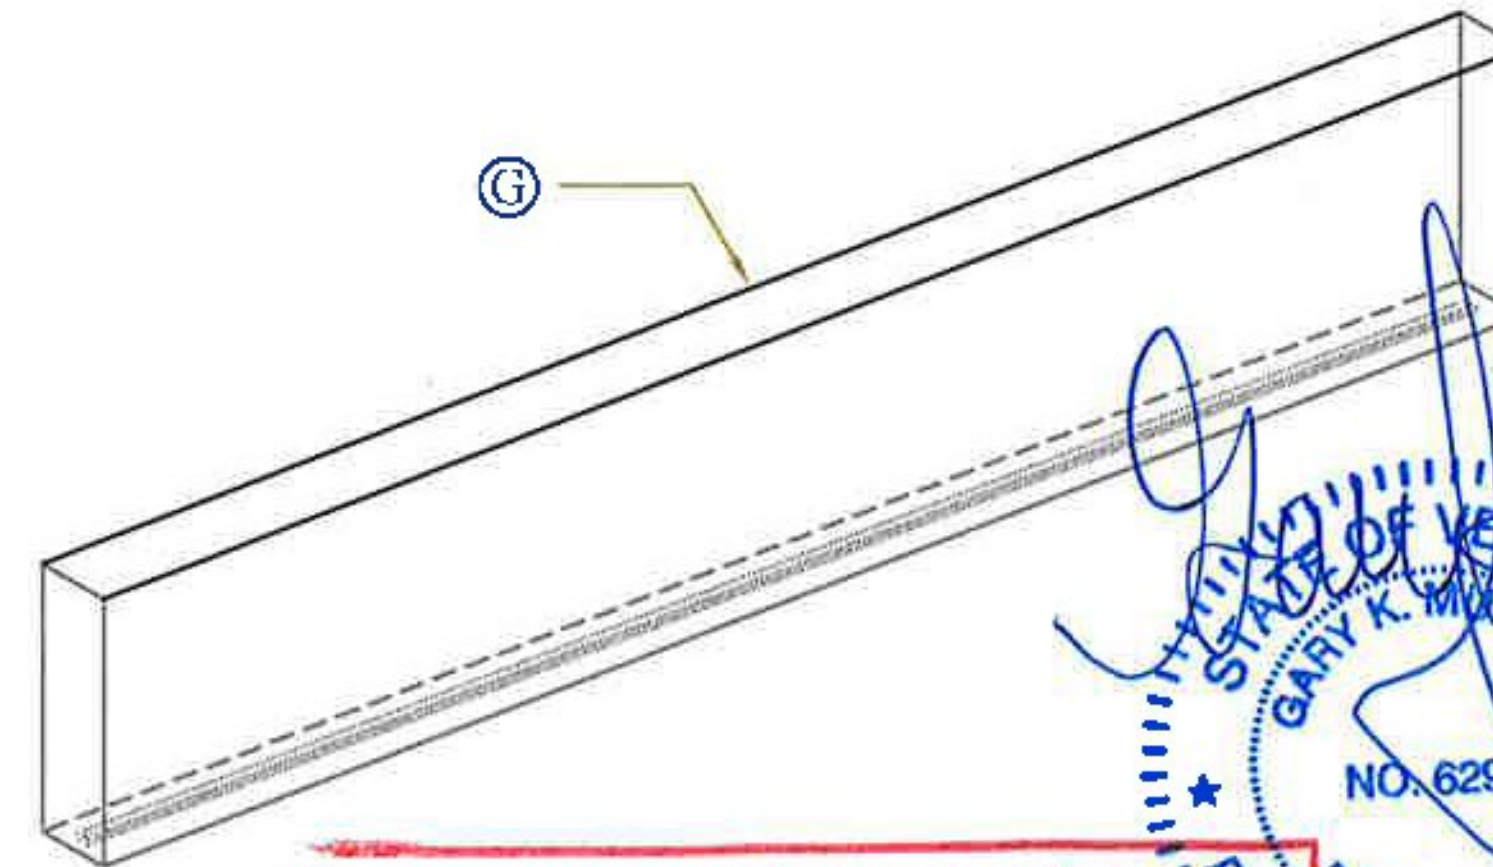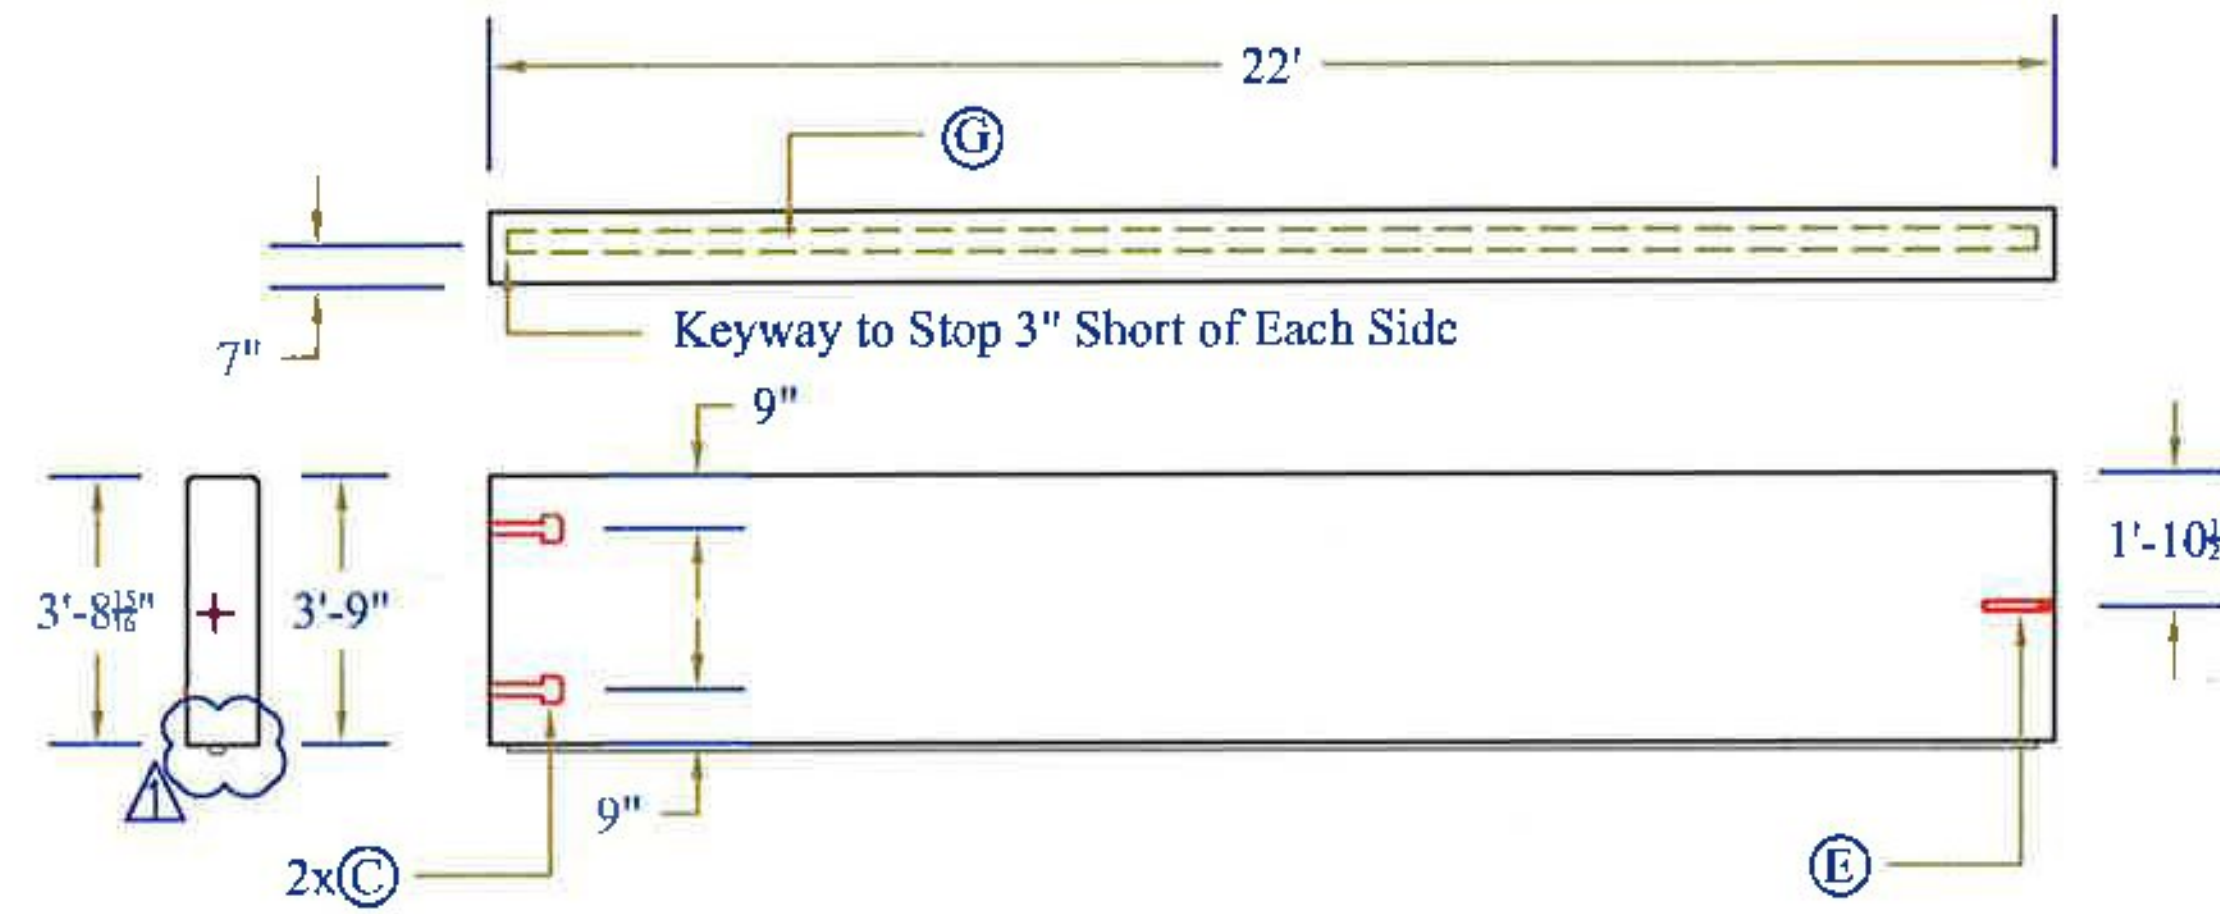


**STRUCTURAL DESIGN ONLY**

STATE OF VERMONT  
 GARY K. MUNKELT  
 NO. 629  
 REGISTERED PROFESSIONAL ENGINEER

**Headwall Reinforcing**

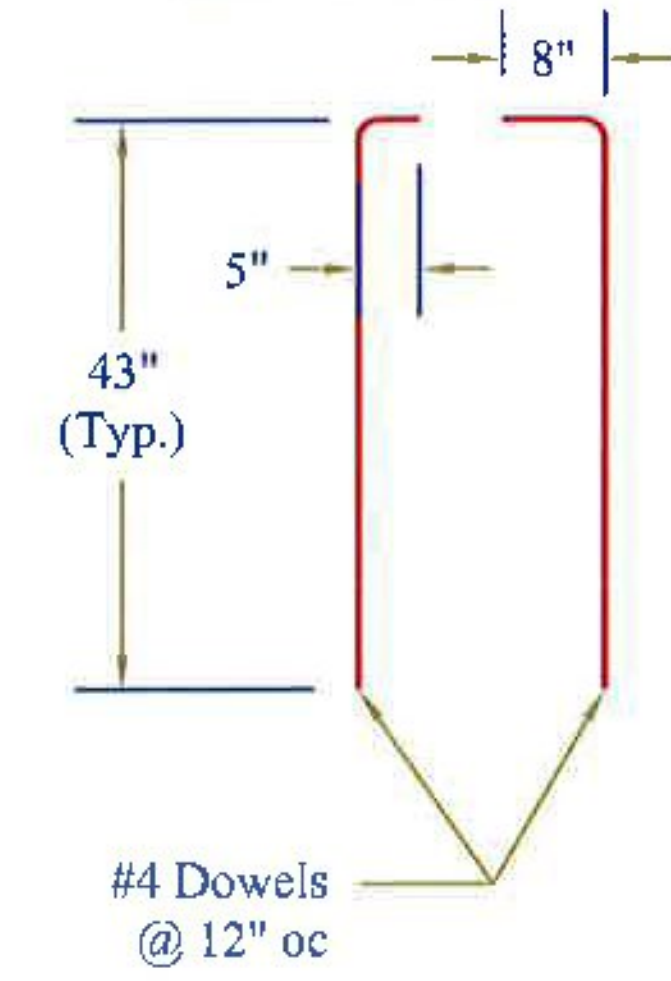


**Cutoff Wall Reinforcing**

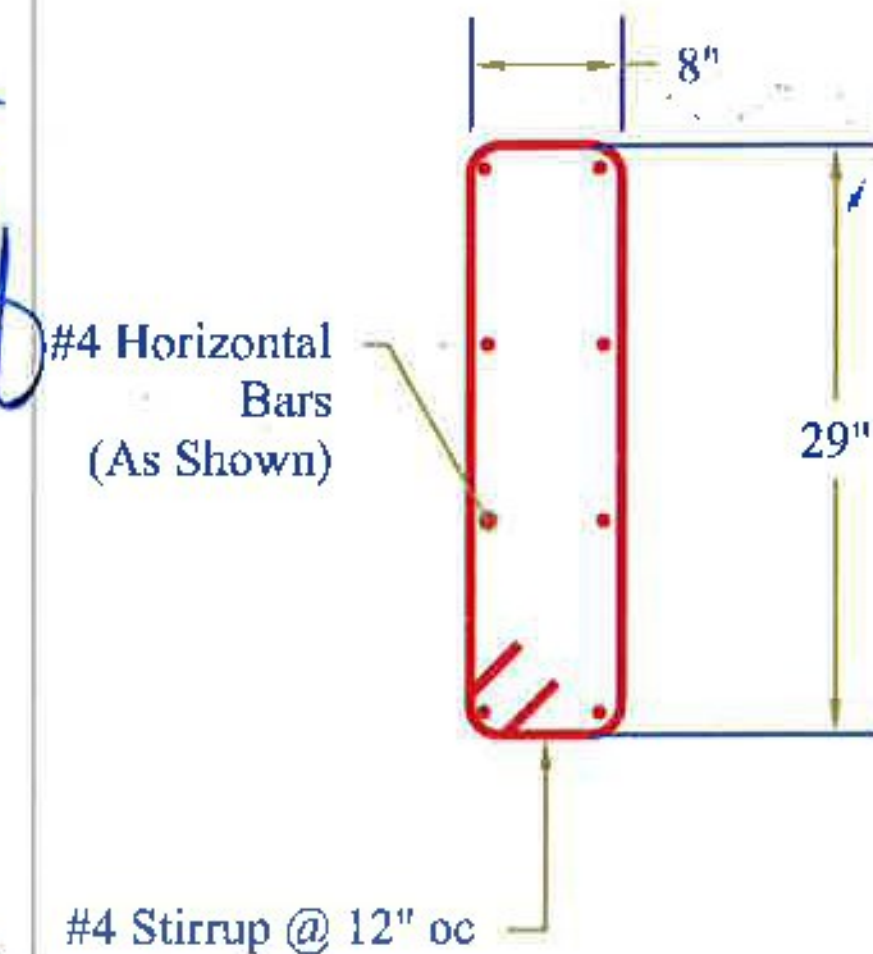


Note: Secondary Pour

Note: Secondary Pour


**CW-1/2 Detail**

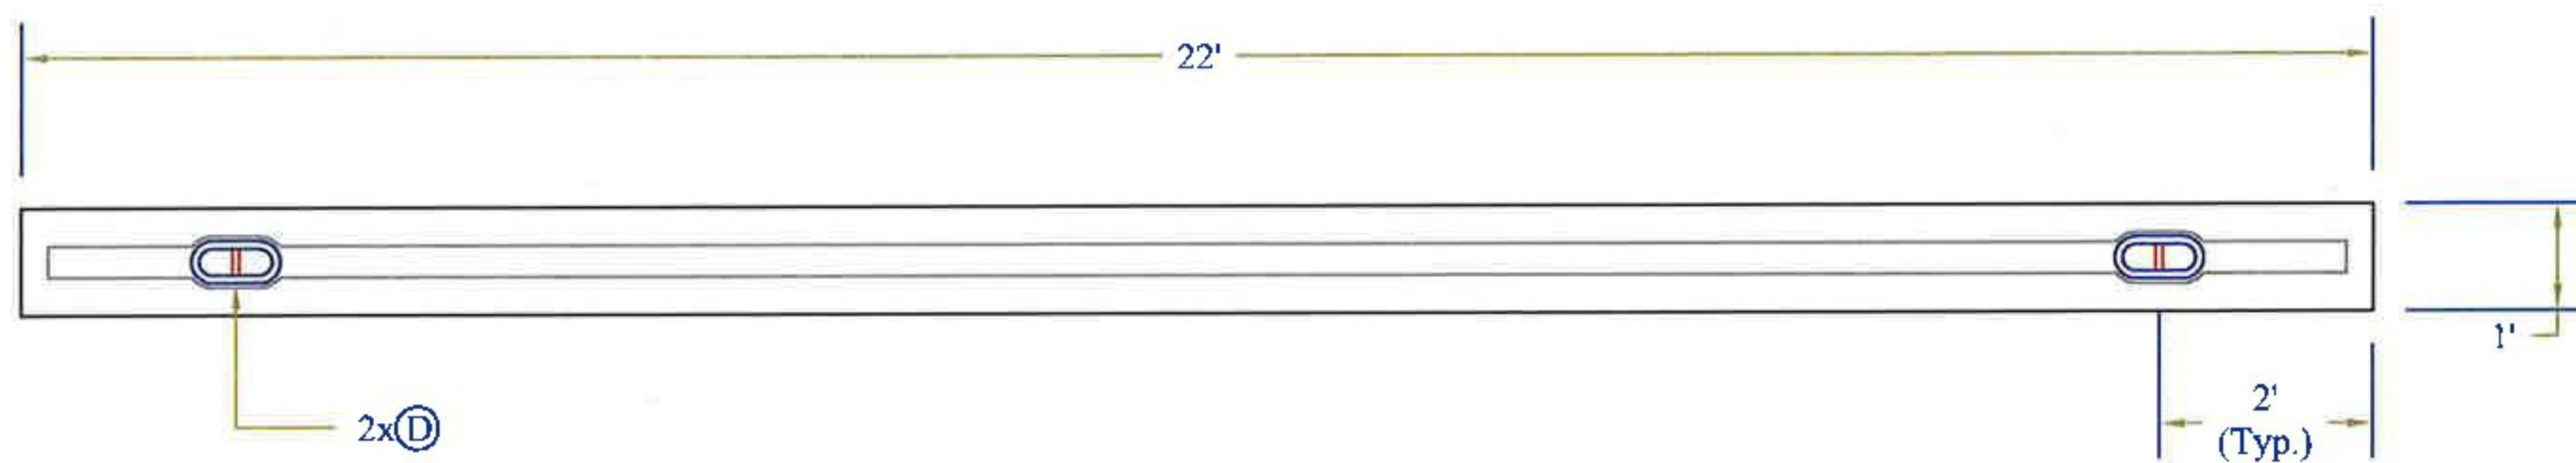

**CW-1 Detail**

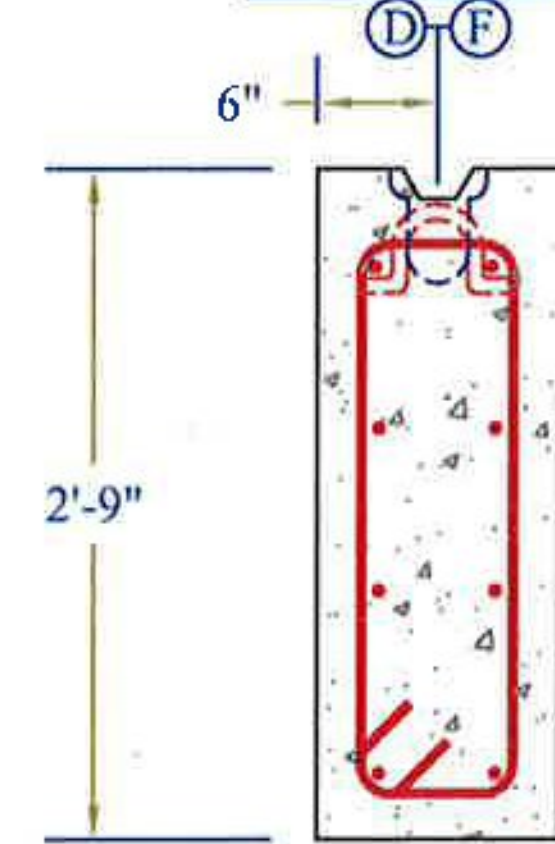

**CW-2 Detail**

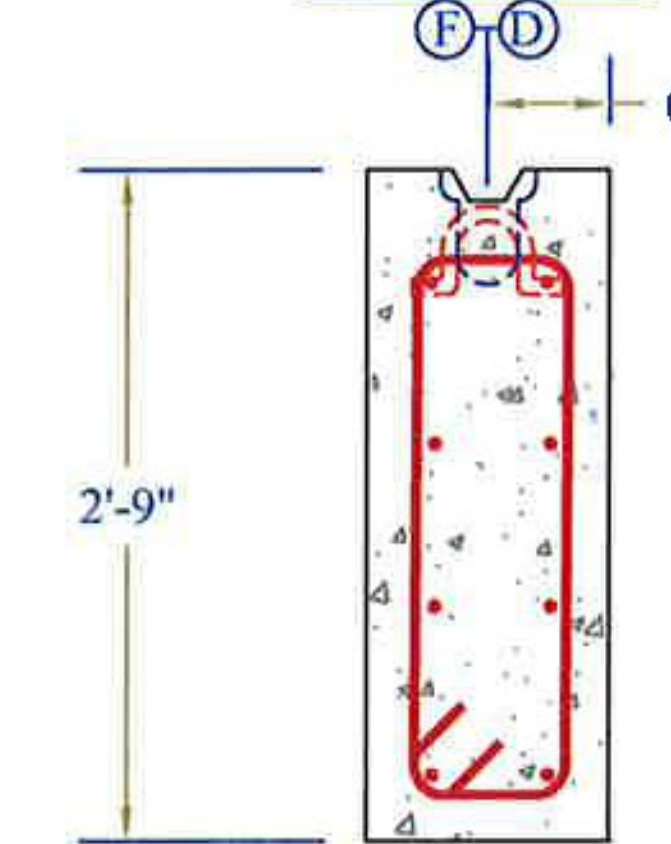

Note: 2" Clear Cover

Note: 2" Clear Cover

CONTRACTORS VISPE:

(A) 3" PVC Sleeve	(D) Oxford A750-7 Lifting Device	(G) Solid Lines Indicate 3/4" Chamfer
(B) 4" PVC Sleeve	(E) 1" x 5/8" F56 Coil Loop Insert	(H) #4 F64 Ferrule Loop Insert
(C) Mechanical Bolt Packet (w/ 1" Coil Rod)	(F) 1 1/2" x 3 1/2" Continuous Keyway	

Rev.	Date	By	Description
1	03/25/15	IBA	Changes per Stantec & State Review
2	04/23/15	IBA	Changes for Production Purposes

PRECAST CONCRETE BOX CULVERT SHOP DRAWINGS (SDI JOB #15428)

SUPERVISOR: E. Barendse  
 DETAILER: I. ADAMS  
 CHECKER: E. Barendse  
 ENGINEER: G. K. Munkelt

Peckham Road Corp.  
 1557 St. Rt. 9, #3  
 Lake George, NY 12845  
 Ph: (518) 747-3353


FABRICATOR:  
 193 INDUSTRIAL AVE.  
 WILLISTON, VT 05495  
 Ph: (802) 658-0201



02/12/15

HW_CW_DETAILS

7_OF_8

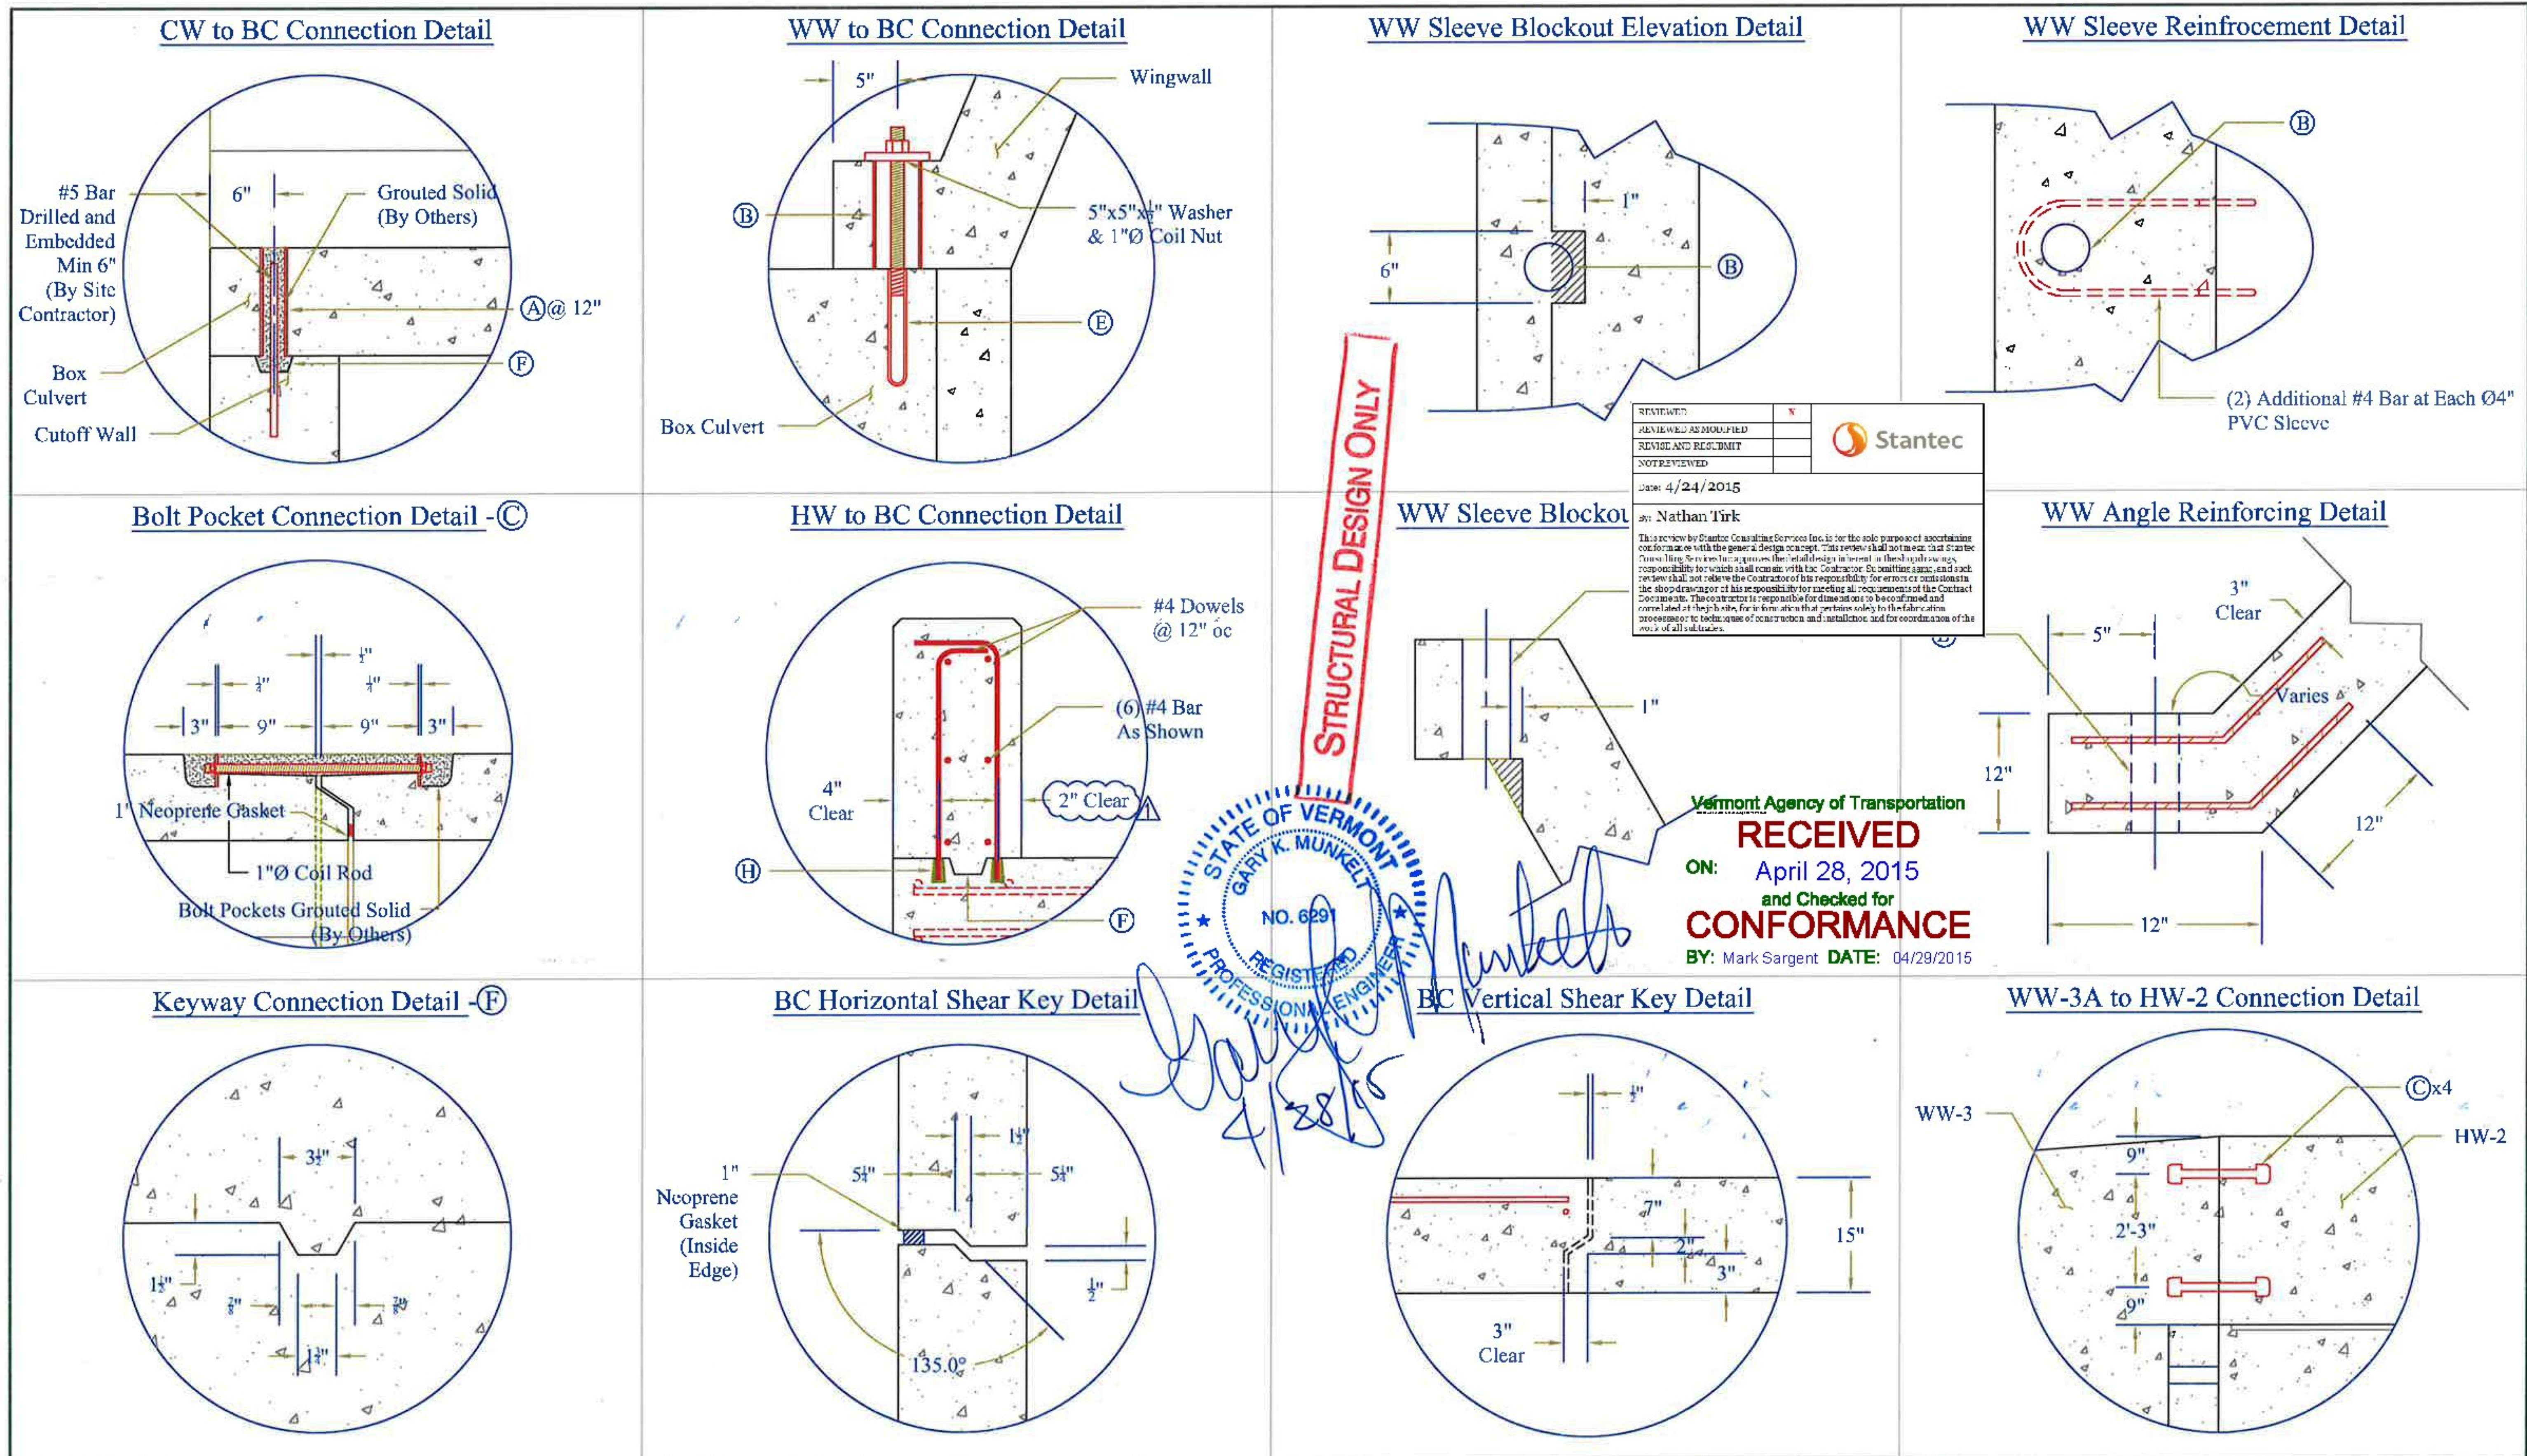

STRUCTURAL DESIGN ONLY



*Gary K. Munkelt*  
4/28/15

STATE/DT	✓
REVIEWED AS REQUIRED	
REVISED AND RESUBMIT	
NOT REVIEWED	

Date: 4/24/2015  
By: Nathan Tirk

**RECEIVED**  
ON: April 28, 2015  
and Checked for  
**CONFORMANCE**  
BY: Mark Sargent DATE: 04/29/2015

Vermont Agency of Transportation



CONTRACTORS VISPE:	Ⓐ 3"Ø PVC Sleeve	Ⓓ Oxford A750-7 Lining Device	Ⓔ Solid Lines Indicate X" Chamfer	Rev. 1	Date 03/25/15	By IBA	Description Changes per Stantec & State Review	PRECAST CONCRETE BOX CULVERT SHOP DRAWINGS (SDI JOB #15428)		Peckham Road Corp. 1557 St. Rt. 9, #3 Lake George, NY 12845 Ph: (518) 747-3353	FABRICATOR: 193 INDUSTRIAL AVE. WILLISTON, VT 05495 Ph: (802) 658-0201
	Ⓑ 4"Ø PVC Sleeve	Ⓔ 1"Øx5/8" F56 Coil Loop Insert	Ⓕ 1/2" x 3/4" F64 Ferrule Loop Insert					SUPERVISOR: E. Barendse DETAILER: I. ADAMS CHECKER: E. Barendse ENGINEER: G. K. Munkelt	PROJECT NAME: Bridport PROJECT #: CULV(29) Br.#2 LOCATION: Bridport, VT	02/12/15	CONNECTION_DETAILS



# Proposed Bridge Improvement Project

## Bridport STP CULV(29)

### Bridge #5

Vermont Agency of Transportation  
Output: 075_Precast_Boxes.dwg, 05/15/15.dwg

# RECEIVED

ON: **May 14, 2015**

and Checked for

# CONFORMANCE

BY: **Mark Sargent** DATE: **5/20/2015**

#### Waterproofing:

1. Silane sealer applied in precast yard on all exposed surfaces (headwalls and top of wingwalls.)

#### Miscellaneous:

1. All bolt pocket hardware & wingwall hardware to be uncoated, black steel & shall remain in place.
2. All exposed edges of concrete shall be chamfered.
3. Concrete leveling pad for the cutoff walls is to be poured on site by the site contractor.
4. All lift anchors and embedded items will be made in America.

#### Concrete:

Mix Designation: P60TER

1. Specified Mix Design - 5000 PSI
2. Proposed Mix Design - 6000 PSI
3. Striping Strength - 3000 PSI
4. Handling Strength - 3000 PSI
5. Shipping Strength - 5000 PSI
6. Install Strength - 5000 PSI
7. Traffic Loading - 5000 PSI

Fabrication Tolerances:

1. Width ±1/4"
2. Height ±1/4"
3. Length ±1/2"
4. Rebar Cover 2" Min. (Unless Noted Otherwise)
5. Rebar Spacing ±1"
6. Rebar Clearance ±1/4"
7. Insert Placement ±1/4"

Design Notes:

1. Design is in accordance w/ ASTM C1577, PCI MNL135, VAOT540 & AASHTO 2012 LRFD bridge design specs fifth edition
2. Any conflict between tolerances listed above shall result in the usage of the stricter tolerance
3. Design live load = HL-93
4. Materials and manufacturing shall conform to ASTM C1433
5. Earth Cover: ±1'-9" Soil Cover

#### Installation:

1. Sub Base for Box Culvert / Cut Off Walls to be Compacted and Level
2. Precast Cut Off Walls + Wing Walls to be installed
3. All Elevations are to be Checked and Verified they Match Those of Plan Set
4. Begin Sequence of Installing All Box Culvert Sections
5. Clean Granular Backfill for structures used for Backfill of Footers & of Box Culvert so water can reach weep holes if applicable
6. Fill all Lifting Holes, Bolt Pockets and Box Culvert grooves and seams w/ non-shrink grout. Applied by Site Contractor.
7. ASTM C1675-11 Box culvert installation guidelines shall be followed.

#### Reinforcing:

General Notes:

1. Reinforcing Steel -
  - a. Precast box sections, headwalls, wing walls, & cut off walls shall be level I uncoated bar ASTM A615
2. Materials and manufacturing shall conform to ASTM C1433

Tolerances:

1. Spacing ±1"
2. Clearance +1/4"

Lap Lengths:

1. Per AASHTO 5.11.2.1.1 & 5.11.5.3.1

#### Joint Treatment:

Vertical Seams:

- Per VTrans approved product list 780.02  
Overhead & vertical concrete repair mortar  
Applied by site contractor


Horizontal Seams / Grout:

- Per VTrans approved product list 707.03  
Mortar, type IV  
Applied by site contractor

REVIEWED	X	
REVIEWED AS MODIFIED		
REVISE AND RESUBMIT		
NOT REVIEWED		
Date: 5/15/15		
By: Michael J. Chenette		
This review by Stantec Consulting Services Inc. is for the sole purpose of ascertaining conformance with the general design concept. This review shall not mean that Stantec Consulting Services Inc. approves the detail design inherent in the shop drawings, responsibility for which shall remain with the Contractor. Submitting same, and such review shall not relieve the Contractor of his responsibility for errors or omissions in the shop drawing or of his responsibility for meeting all requirements of the Contract Documents. The contractor is responsible for dimensions to be confirmed and correlated at the job site, for information that pertains solely to the fabrication processes or to techniques of construction and installation and for coordination of the work of all subtrades.		

#### Legend:

- (A) 3"Ø PVC Sleeve
- (B) 4"Ø PVC Sleeve
- (C) Mechanical Bolt Pocket (w/ 1"Ø Coil Rod)
- (D) Oxford A750-7 Lifting Device - Allow 6" movement to avoid rebar conflict
- (E) 1 1/2" x 3 1/2" Continuous Keyway
- (F) Solid Lines Indicate 3/4" Chamfer
- (G) 1/2" FX-5 Ferrule Loop Insert

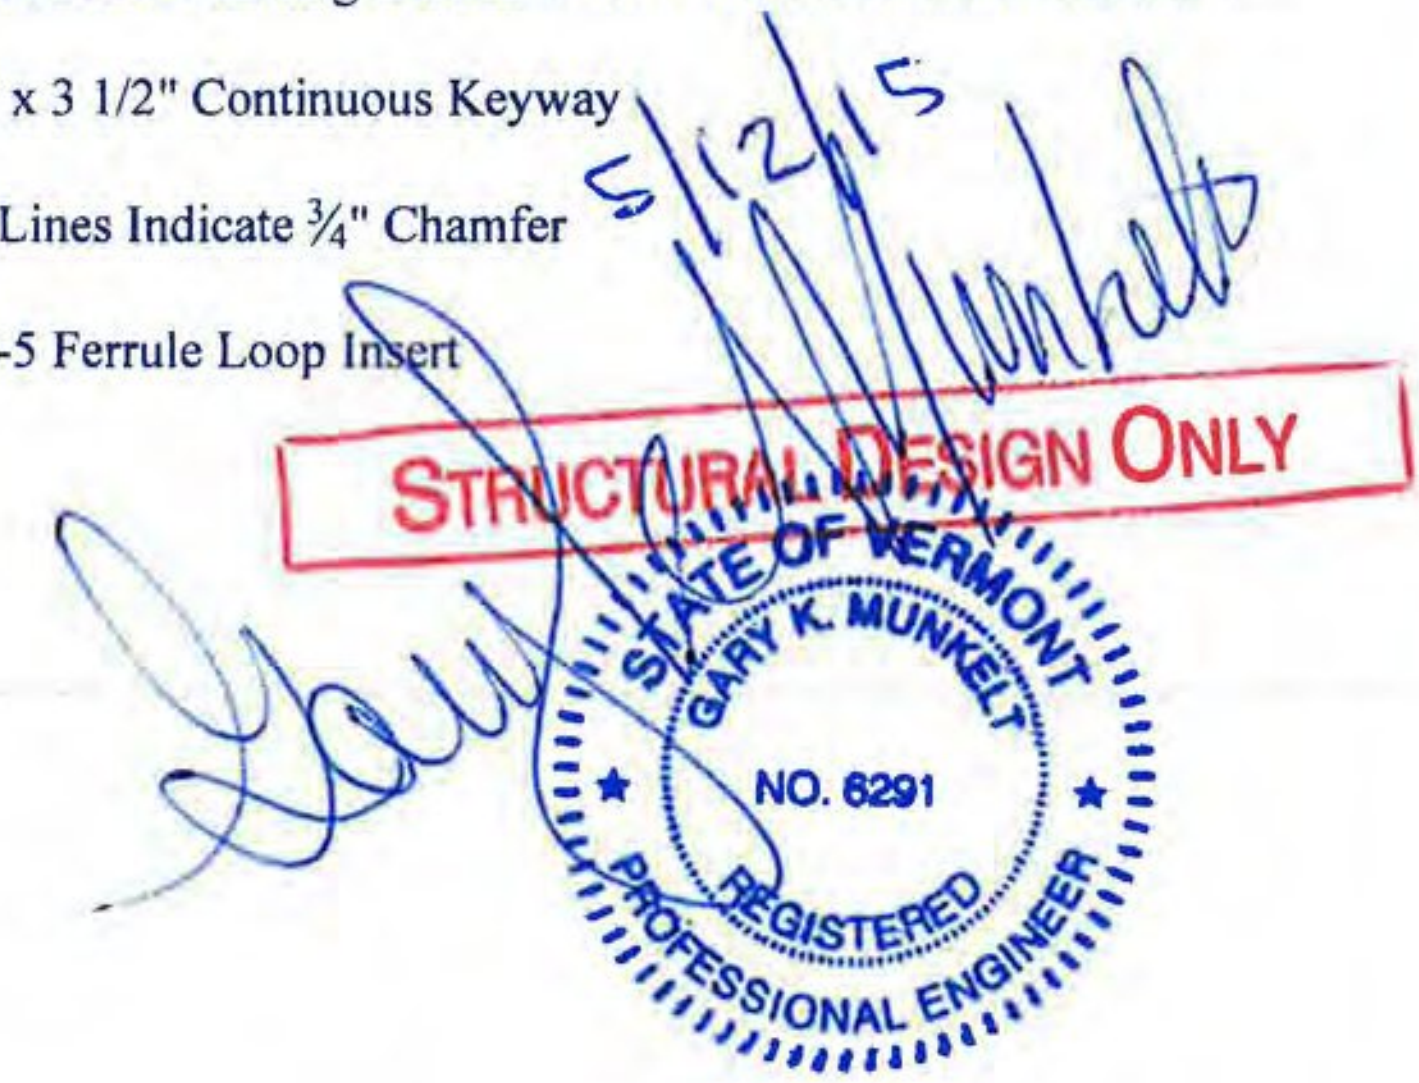

<b>CONTRACTORS VISPE:</b>							
	<b>Rev.</b>	<b>Date</b>	<b>By</b>	<b>Description</b>	<b>PRECAST CONCRETE BOX CULVERT SHOP DRAWINGS (SDI JOB #15428)</b>	<b>Peckham Road Corp.</b>	<b>FABRICATOR:</b>
	1	05/06/15	IBA	Changes per Redesign	SUPERVISOR: E. Barendse	1557 St. Rt. 9, #3	193 INDUSTRIAL AVE.
	2	05/11/15	IBA	Inlet/Outlet BC Change	DETAILER: I. ADAMS	Lake George, NY 12845	WILLISTON, VT 05495
					CHECKER: E. Barendse	Ph: (518) 747-3353	Ph: (802) 658-0201
					ENGINEER: G. K. Munkelt	04/20/15	COVER_PAGE
					PROJECT NAME: Bridport		
					PROJECT #: CULV(29) Br.#5		1_OF_6
					LOCATION: Bridport, VT		

Plan View

Vermont Agency of Transportation

**RECEIVED**

ON: May 14, 2015

and Checked for


**CONFORMANCE**

BY: Mark Sargent DATE: 5/20/2015

Table of Units				
Name	Qty	Length	Vol.(CY)	Wt.(lbs.)*
BC-1	1	5'-9 ⁷ / ₈ "	7.73	30,930
BC-2A*	1	5'-9 ⁷ / ₈ "	9.38	37,510
BC-2B	5	5'-9 ⁷ / ₈ "	8.82	35,285
BC-2C*	1	5'-9 ⁷ / ₈ "	9.38	37,510
BC-3	1	5'-9 ⁷ / ₈ "	7.73	30,930
CW-1	1	13'-8"	1.60	6,410
CW-2	1	13'-8"	1.60	6,410

* Headwall Included in BC-2A and BC-2C

Note: Baffle weight included in all BC sections

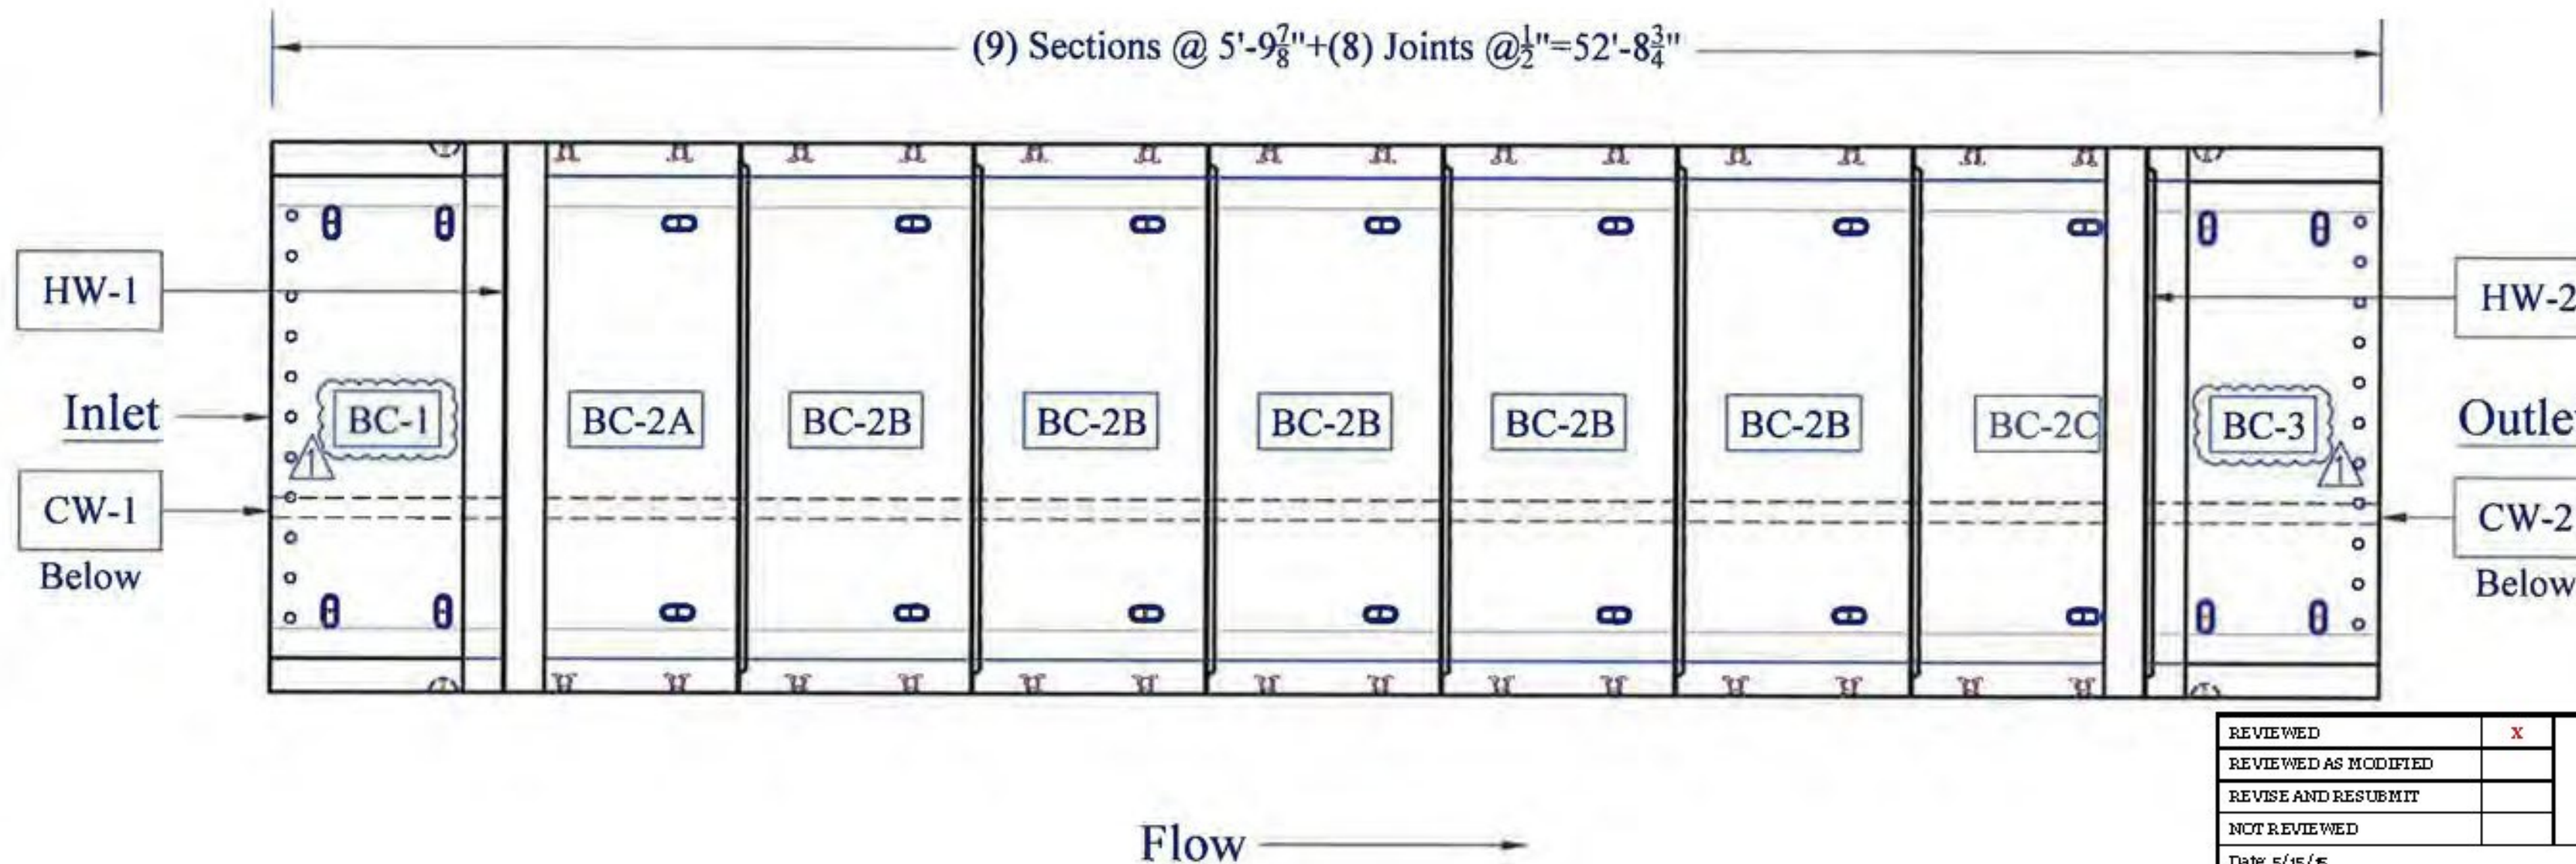


Culvert Specifications	
Inside Dimensions	12'-0"Wx9'-0"H
Waterway Area	76 Sq. Ft.
Top Slab Thickness	10"
Side Wall Thickness	10"
Bottom Slab Thickness	10"

REVIEWED	X	Stantec
REVIEWED AS MODIFIED		
REVISE AND RESUBMIT		
NOT REVIEWED		
Date	5/15/15	
By	Michael J. Chenette	

This review by Stantec Consulting Services Inc. is for the sole purpose of ascertaining conformance with the general design concept. The review shall not mean that Stantec Consulting Services Inc. approves the detail design inherent in the shop drawings, responsibility for which shall remain with the Contractor. Submitting same, and such review shall not release the Contractor of his responsibility for errors or omissions in the shop drawings or his responsibility for meeting all requirements of the Contract Documents. The contractor is responsible for dimensions to be confirmed and controlled at the job site, for information that pertains solely to the fabrication processes or to techniques of construction and installation and for coordination of the work of all subcontractors.

Section View

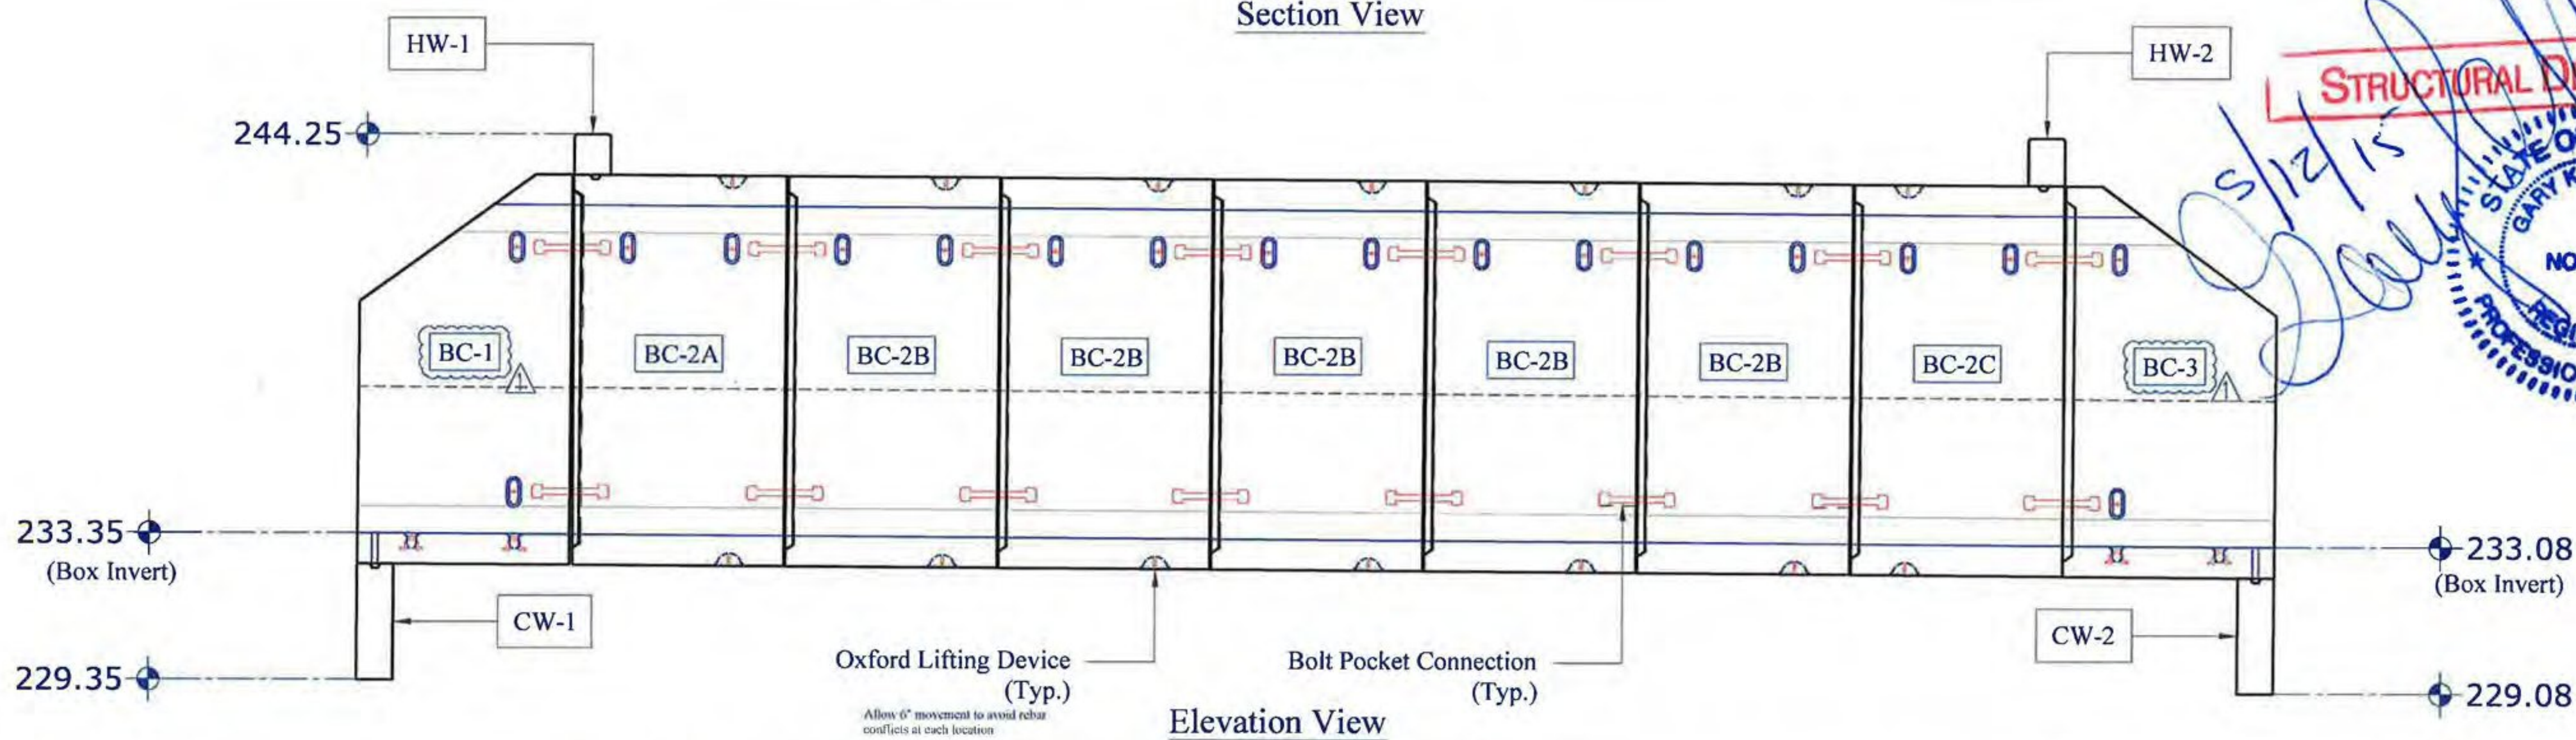

**STRUCTURAL DESIGN ONLY**

slz/15


STATE OF VERMONT  
GARY K. MUNKELT  
NO. 6291  
REGISTERED PROFESSIONAL ENGINEER

Elevation View

CONTRACTORS VISPE:	Rev.	Date	By	Description	PRECAST CONCRETE BOX CULVERT SHOP DRAWINGS (SDI JOB #15428)	Peckham Road Corp. 1557 St. Rt. 9, #3 Lake George, NY 12845 Ph: (518) 747-3353	FABRICATOR: 193 INDUSTRIAL AVE. WILLISTON, VT 05495 Ph: (802) 658-0201	<b>SD Ireland</b> PRECAST
	1	05/06/15	IBA	Changes per Redesign				
	2	05/11/15	IBA	Inlet/Outlet BC Change	DETAILER: I. ADAMS	PROJECT #: CULV(29) Br.#5		
					CHECKER: E. Barendse	LOCATION: Bridport, VT		
					ENGINEER: G. K. Munkelt			2_OF_6

BC-2A Detail


Note: See Sh. 8 for Additional Details

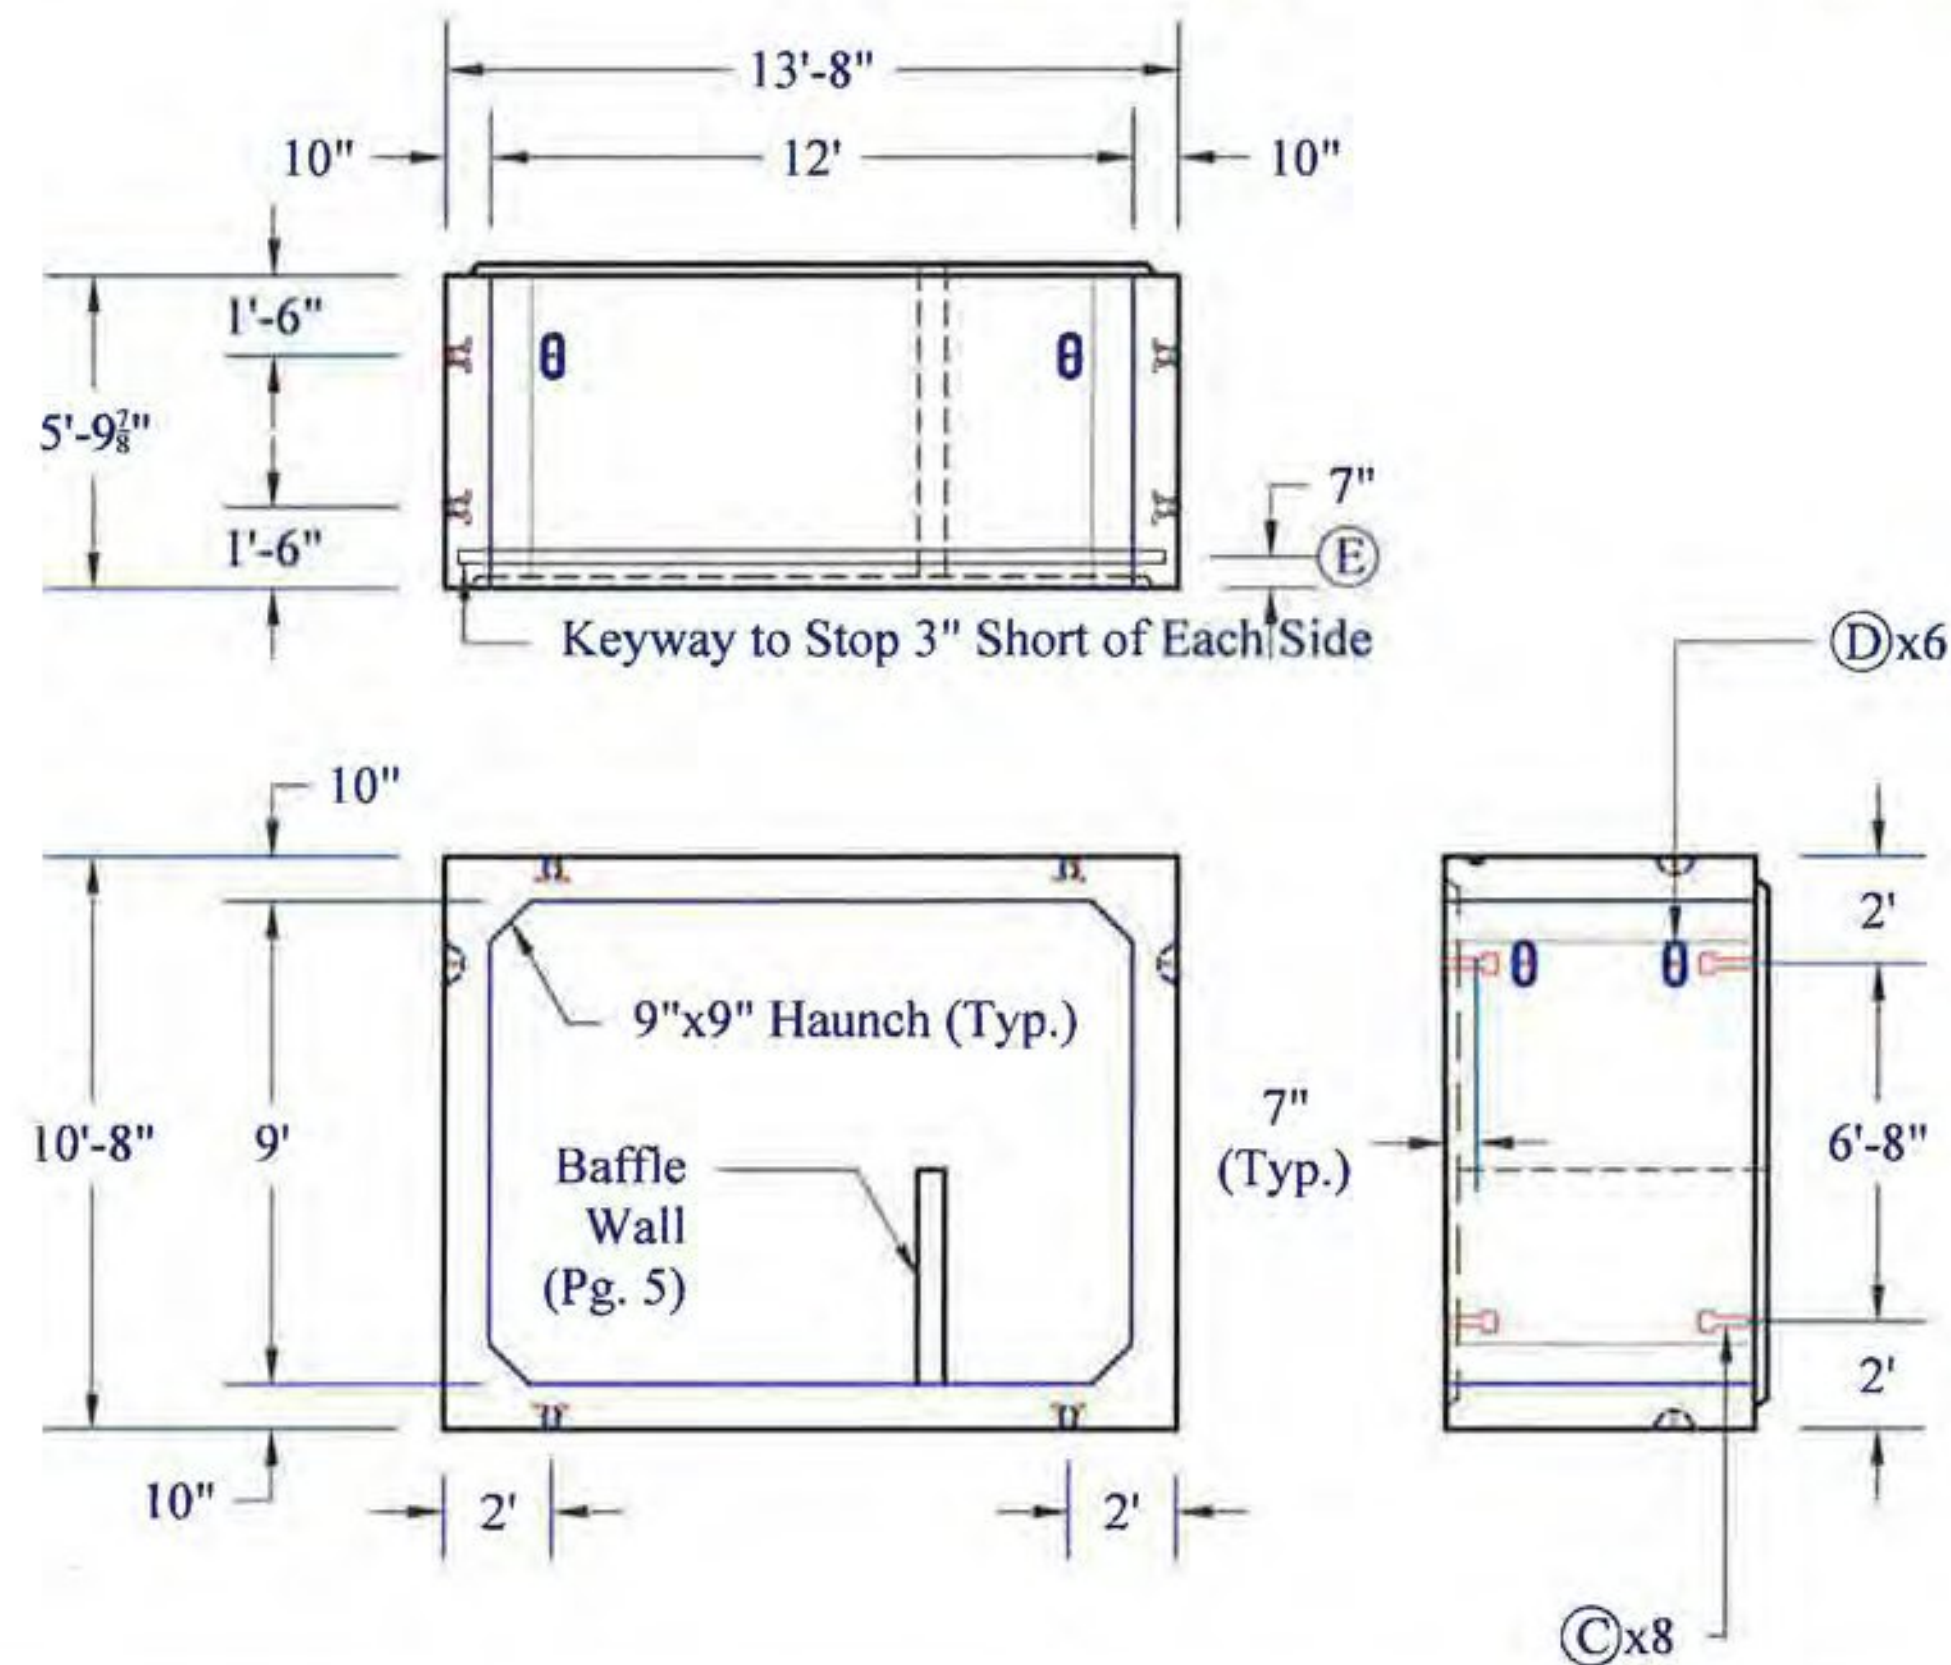

Vermont Agency of Transportation  
**RECEIVED**  
 ON: May 14, 2015  
 and Checked for  
**CONFORMANCE**  
 BY: Mark Sargent DATE: 5/20/2015

BC-2B Detail

Note: See Sh. 8 for Additional Details

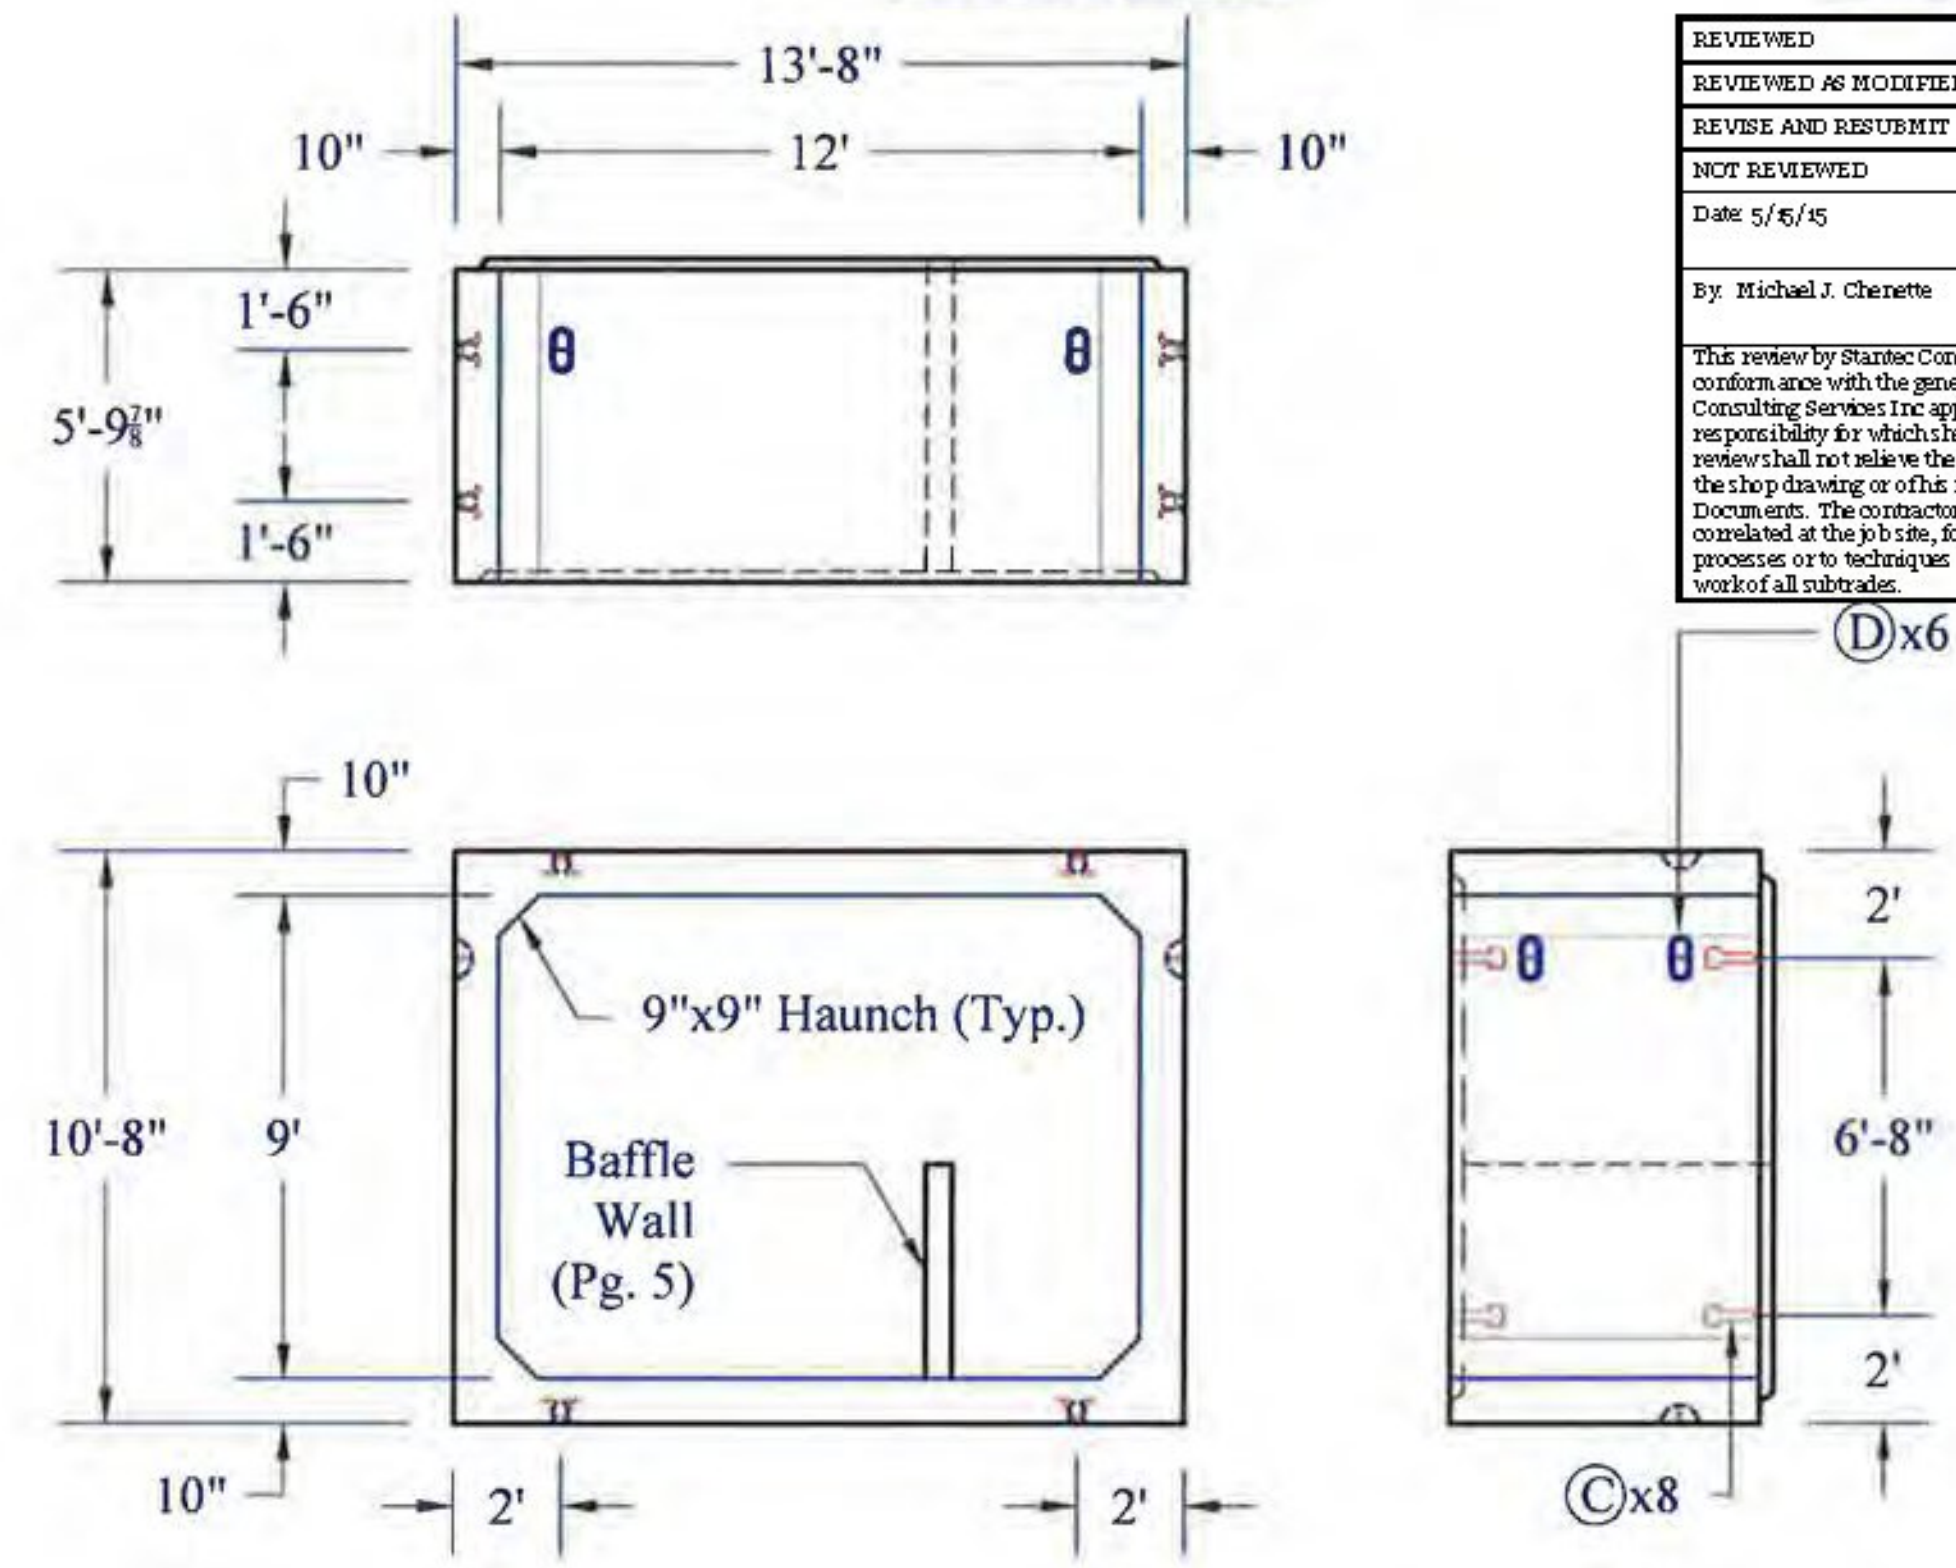


REVIEWED	X
REVIEWED AS MODIFIED	
REVISE AND RESUBMIT	
NOT REVIEWED	
Date: 5/6/15	
By: Michael J. Chenette	


This review by Stantec Consulting Services Inc. is for the sole purpose of ascertaining conformance with the general design concept. The review shall not mean that Stantec Consulting Services Inc. approves the detail design in these shop drawings, responsibility for which shall remain with the Contractor. Submitting same, and such review shall not relieve the Contractor of the responsibility for errors or omissions in the shop drawing or of its responsibility for meeting all requirements of the Contract Documents. The contractor is responsible for dimensions to be confirmed and controlled at the job site, for information that pertains solely to the fabrication, processing or to techniques of construction and installation and for coordination of the work of all subcontractors.

BC-2C Detail

Note: See Sh. 8 for Additional Details

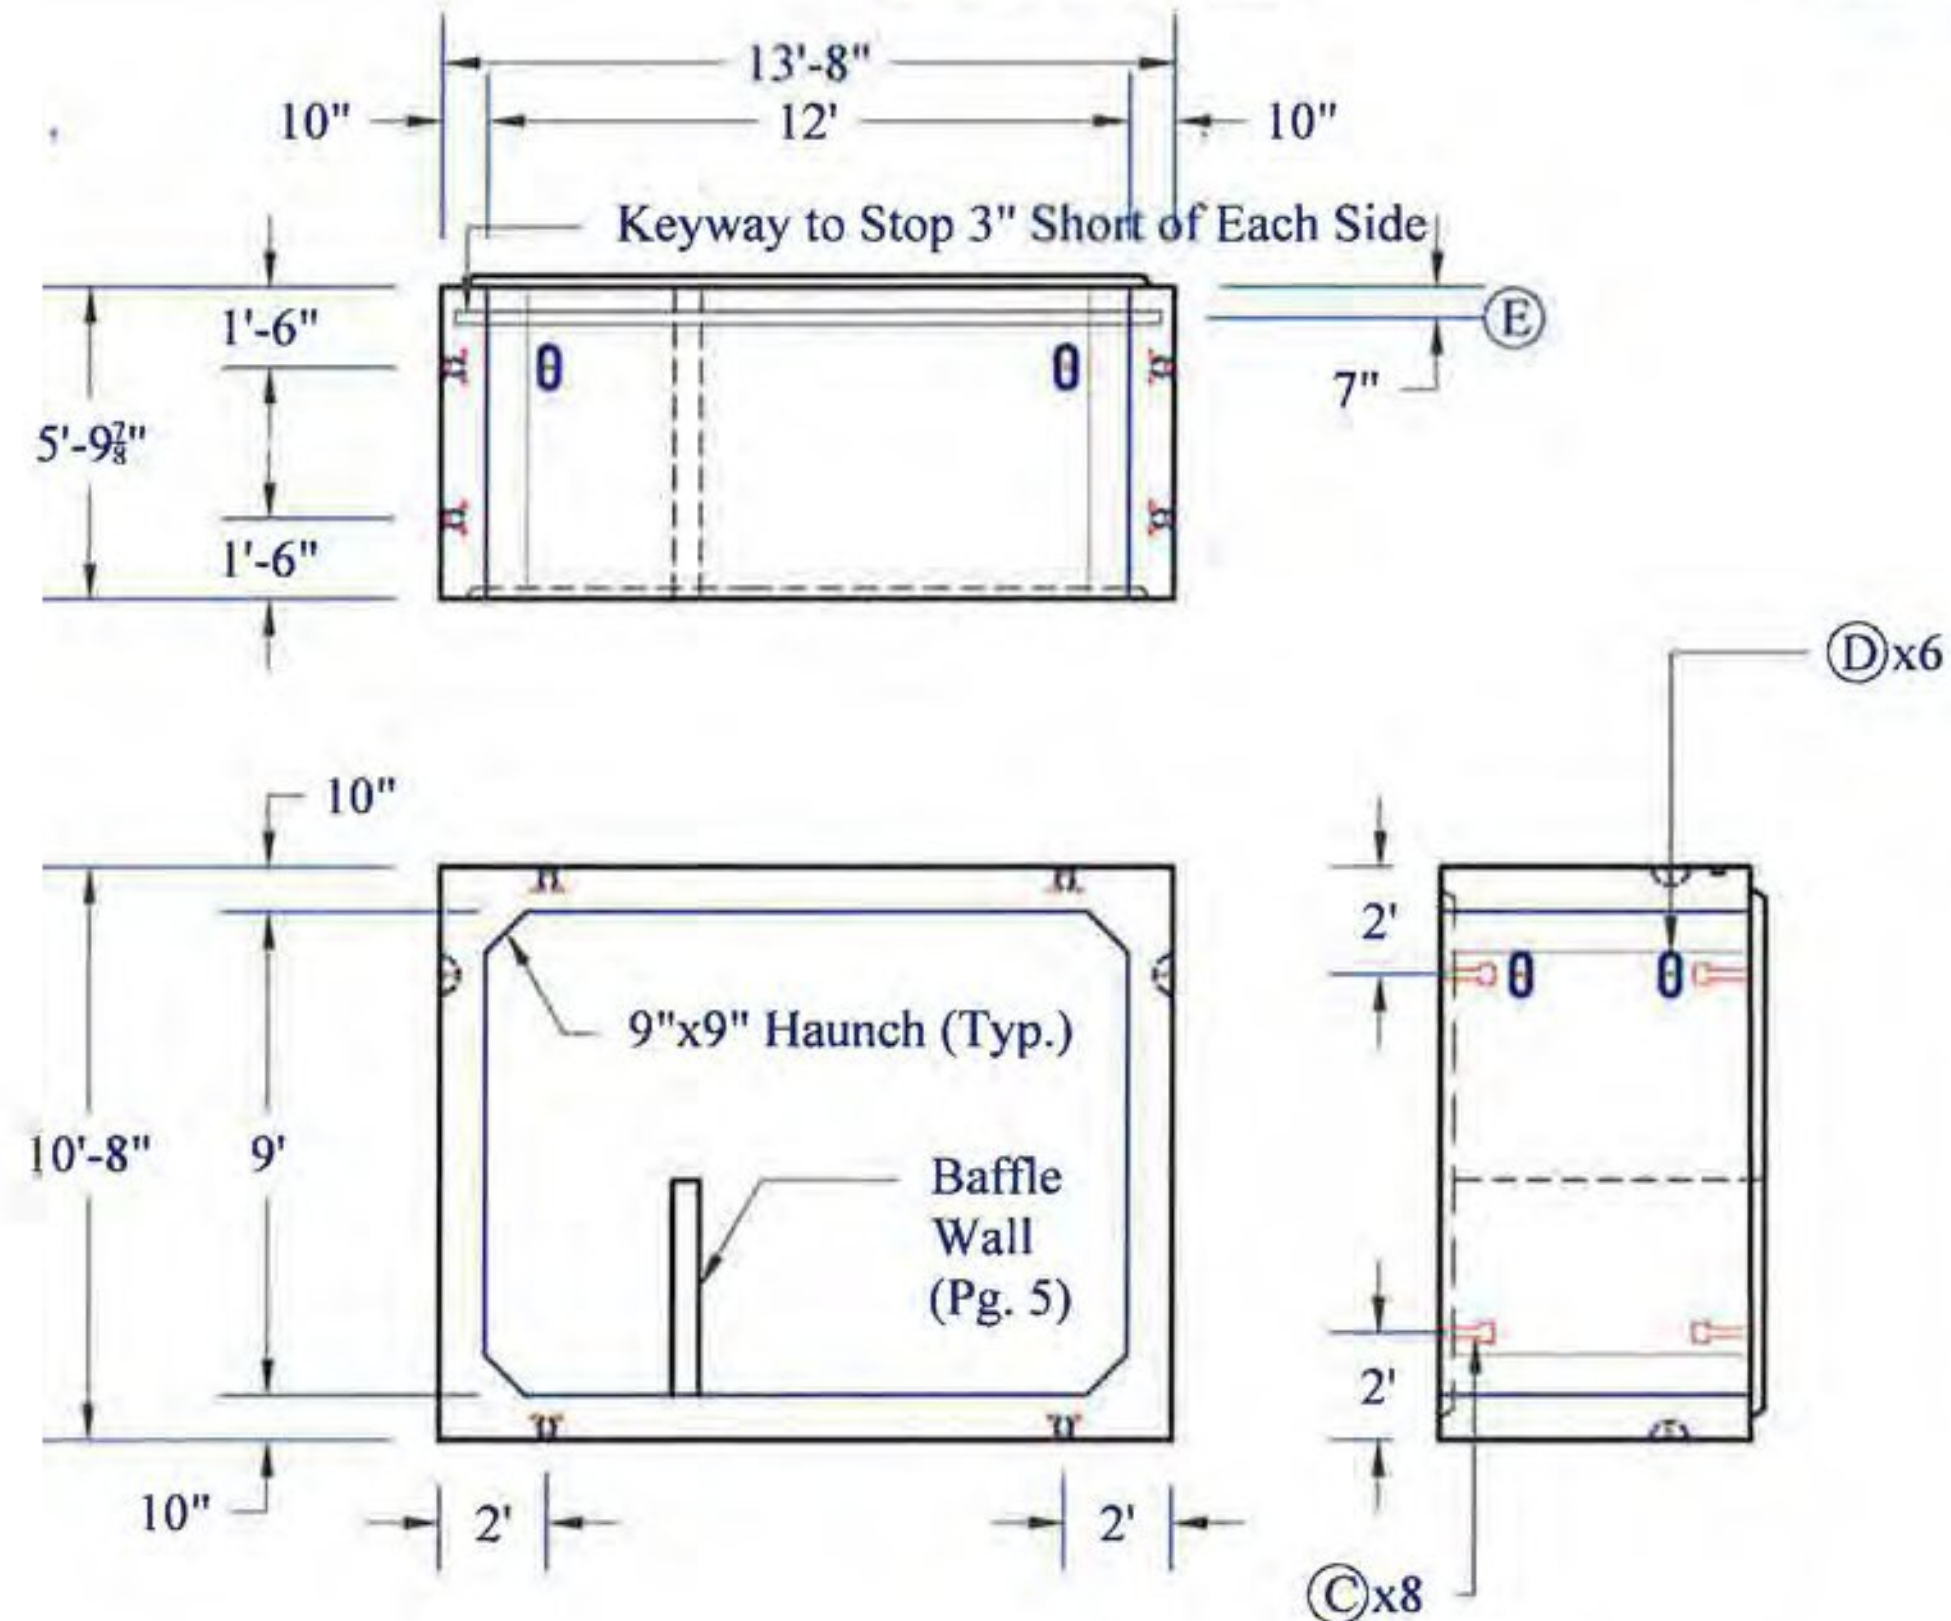

Box Section Reinforcement Detail

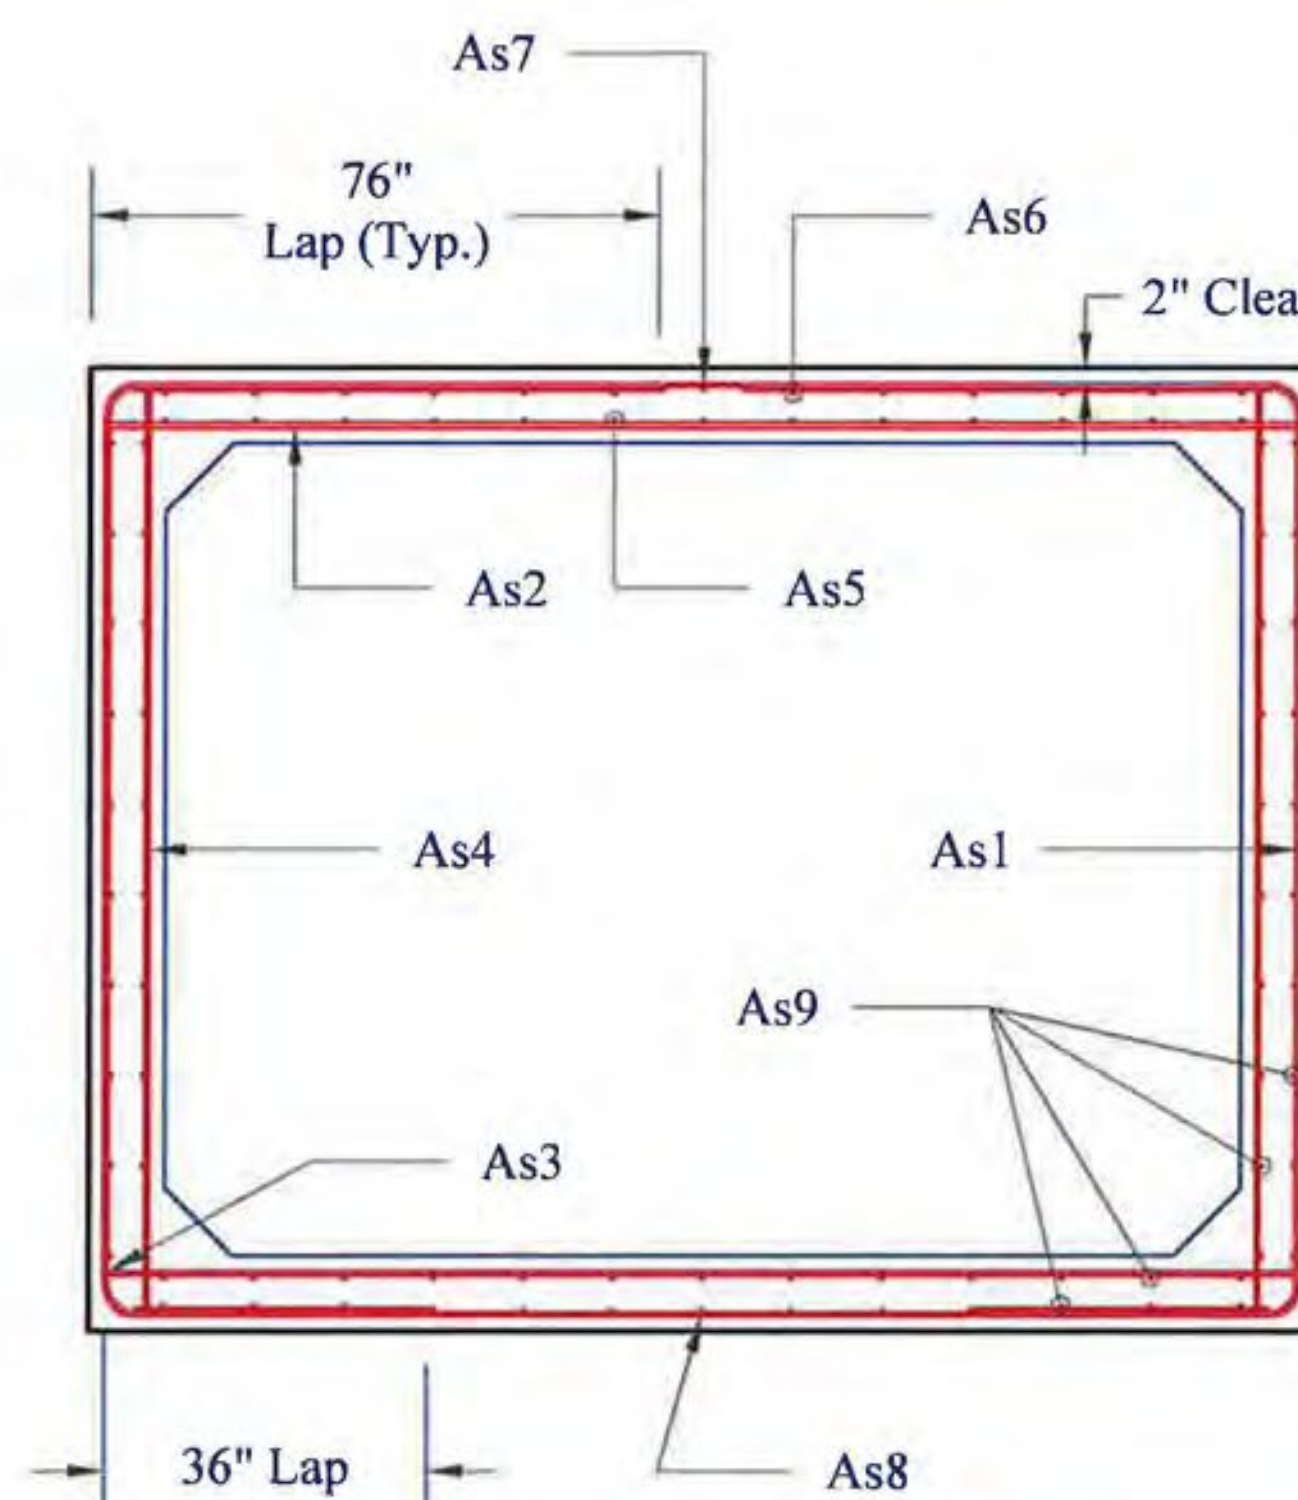

Mark	Size	Max Spacing	Length	Type	A	B
As1	#5	6"	236"	Bent	36"	124" 76"
As2	#5	5"	160"	Str	160"	
As3	#5	6"	160"	Str	160"	
As4	#4	9"	124"	Str	124"	
As5	#5	10"	65"	Str	65"	
As6	#4	9"	65"	Str	65"	
As7	#4	9"	160"	Str	160"	
As8	#4	9"	160"	Str	160"	
As9	#4	12"	65"	Str	65"	

Notes: 2" Clear Typical Unless Noted Otherwise  
**STRUCTURAL DESIGN ONLY**




CONTRACTORS VISPE:	(A) 3"Ø PVC Sleeve	(D) Oxford A750-7 Lifting Device	(G) 1" FX-5 Ferrule Loop Insert	Rev. 1	Date 05/06/15	By IBA	Description Changes per Redesign
	(B) 4"Ø PVC Sleeve	(E) 1 1/2" x 3 1/2" Continuous Keyway	(C) Mechanical Bolt Pocket (w/ 1"Ø Coil Rod)	Rev. 2	Date 05/11/15	By IBA	Description Inlet/Outlet BC Change


PRECAST CONCRETE BOX CULVERT SHOP DRAWINGS (SDI JOB #15428)		Peckham Road Corp. 1557 St. Rt. 9, #3 Lake George, NY 12845 Ph: (518) 747-3353	FABRICATOR: 193 INDUSTRIAL AVE. WILLISTON, VT 05495 Ph: (802) 658-0201
SUPERVISOR: E. Barendse	PROJECT NAME: Bridport	04/20/15	BOX_SECTIONS_1
DETAILER: I. ADAMS	PROJECT #: CULV(29) Br.#5		3_OF_6
CHECKER: E. Barendse	LOCATION: Bridport, VT		
ENGINEER: G. K. Munkelt			

Vermont Agency of Transportation

**RECEIVED**  
**ON: May 14, 2015**  
**and Checked for CONFORMANCE**  
**BY: Mark Sargent DATE: 5/20/2015**

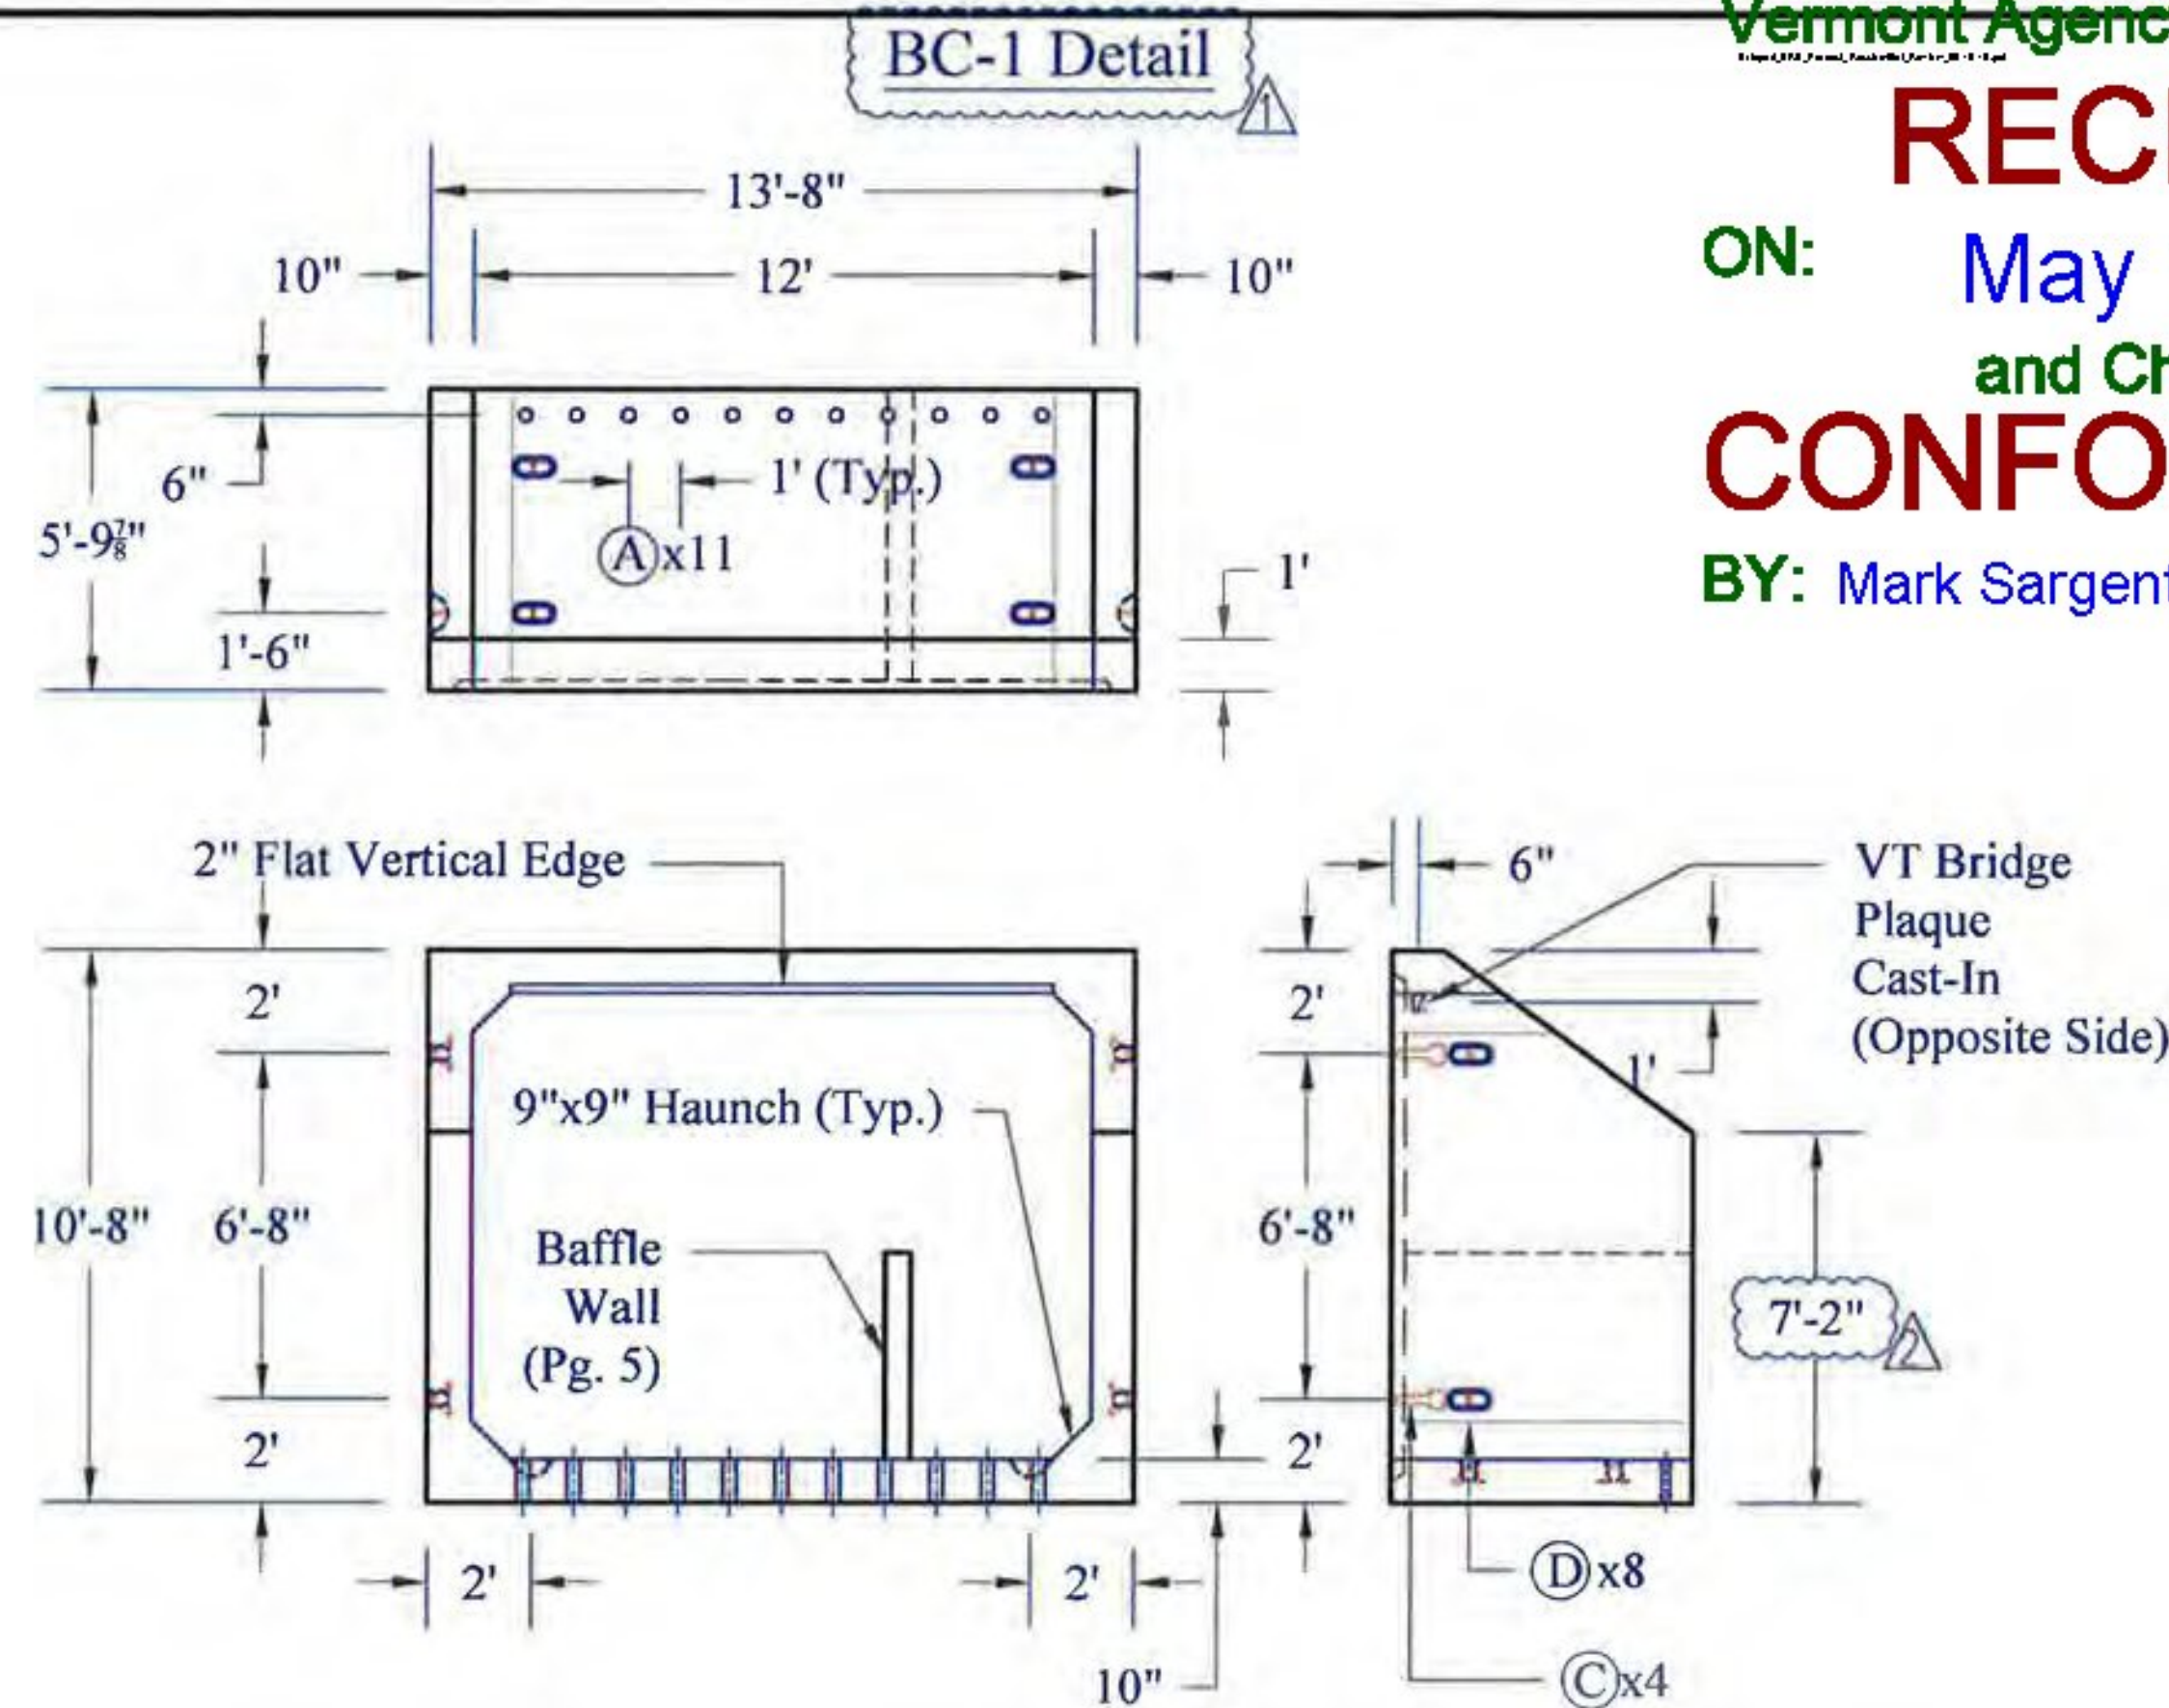

End Box Section Reinforcement Detail

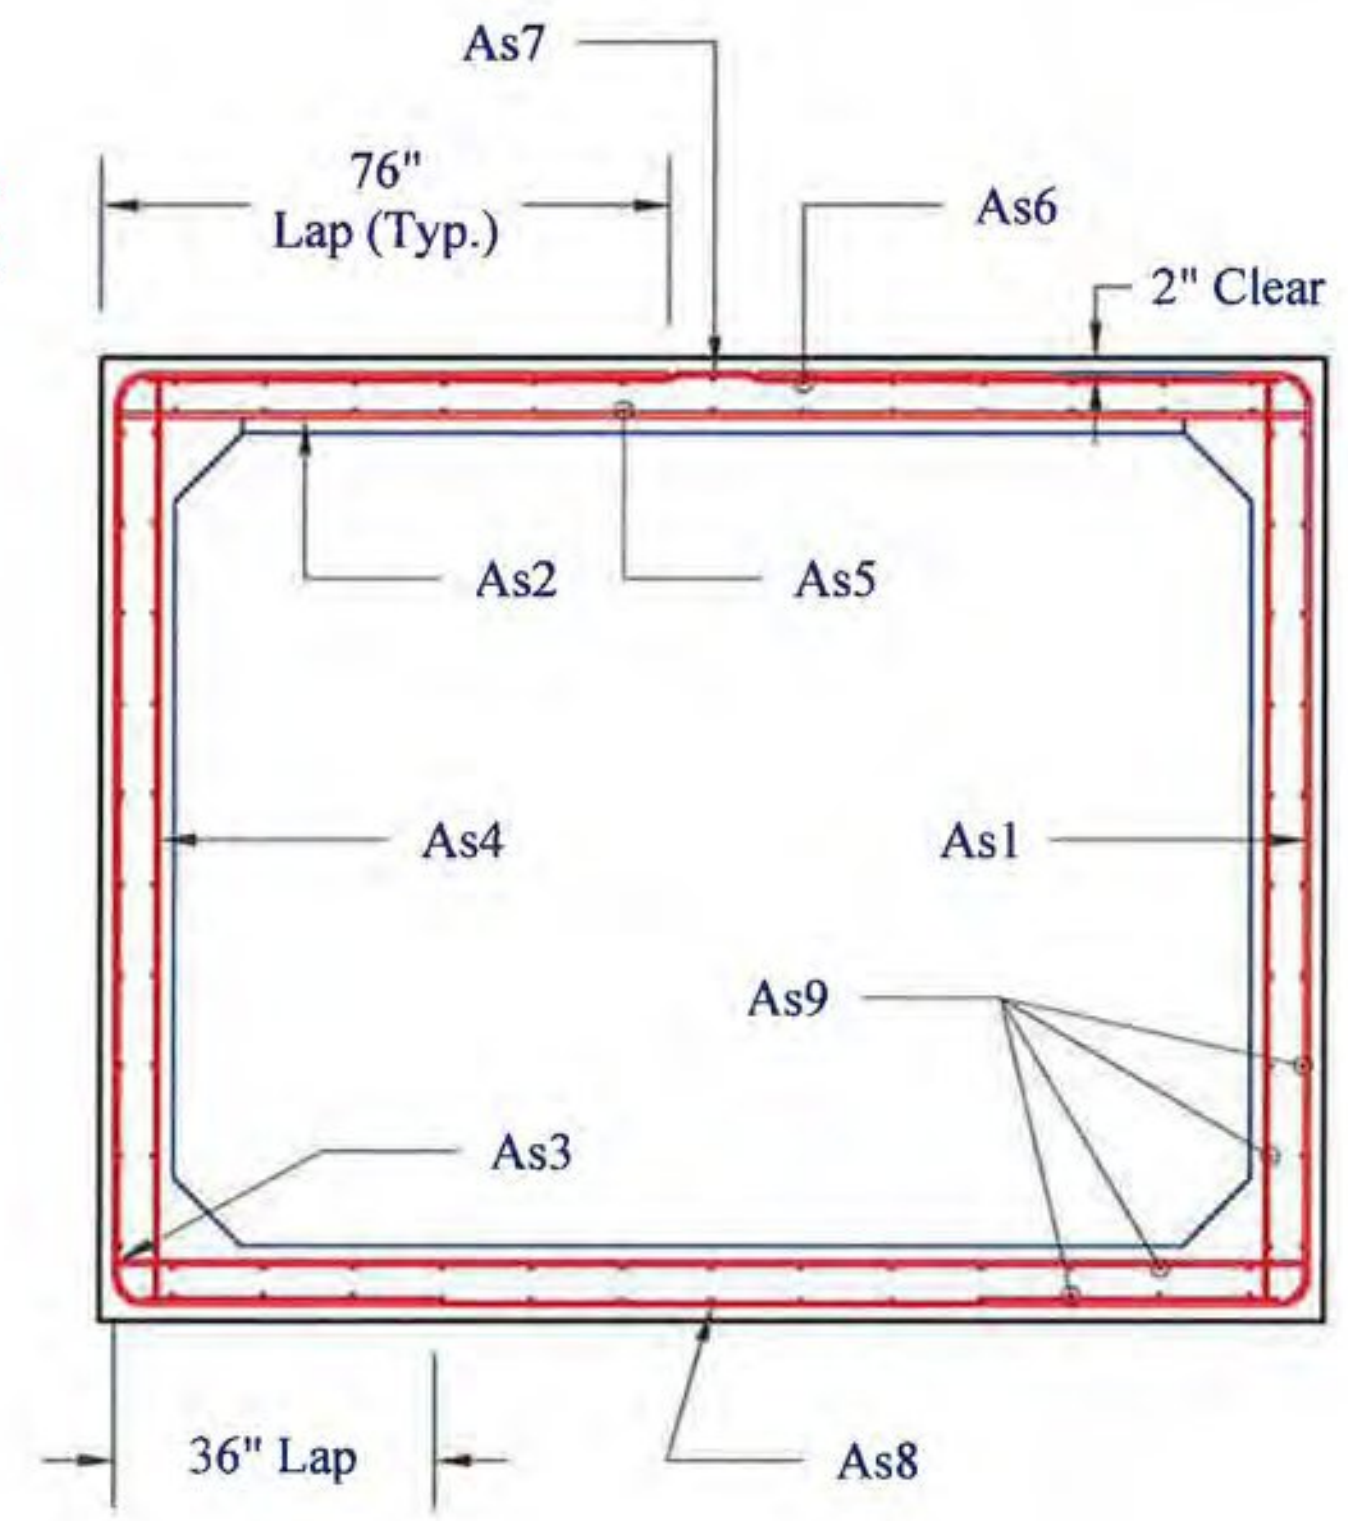

Rebar Schedule							
Mark	Size	Max Spacing	Length	Type	A	B	
As1	#5	6"	Varies	Bent	36"	Vrs	76"
As2	#5	5"	160"	Str	160"		
As3	#5	6"	160"	Str	160"		
As4	#4	9"	Varies	Str	Vrs		
As5	#5	10"	Varies	Str	Vrs		
As6	#4	9"	Varies	Str	Vrs		
As7	#4	9"	160"	Str	160"		
As8	#4	9"	160"	Str	160"		
As9	#4	12"	Varies	Str	Vrs		


Notes: 2" Clear Typical Unless Noted Otherwise

REVIEWED	X
REVIEWED AS MODIFIED	
REVISE AND RESUBMIT	
NOT REVIEWED	


Date: 5/15/15  
 By: Michael J. Chenette

This review by Stantec Consulting Services Inc. is for the sole purpose of ascertaining conformance with the general design concept. This review shall not mean that Stantec Consulting Services Inc. approves the detail design inherent in the shop drawings, responsibility for which shall remain with the Contractor. Substanting same, and such review shall not relieve the Contractor of his responsibility for meeting all requirements of the Contract Documents. The contractor is responsible for dimensions to be confirmed and correlated at the job site, for information that pertains solely to the fabrication processes or to techniques of construction and installation and for coordination of the work of all subtrades.

BC-3 Detail

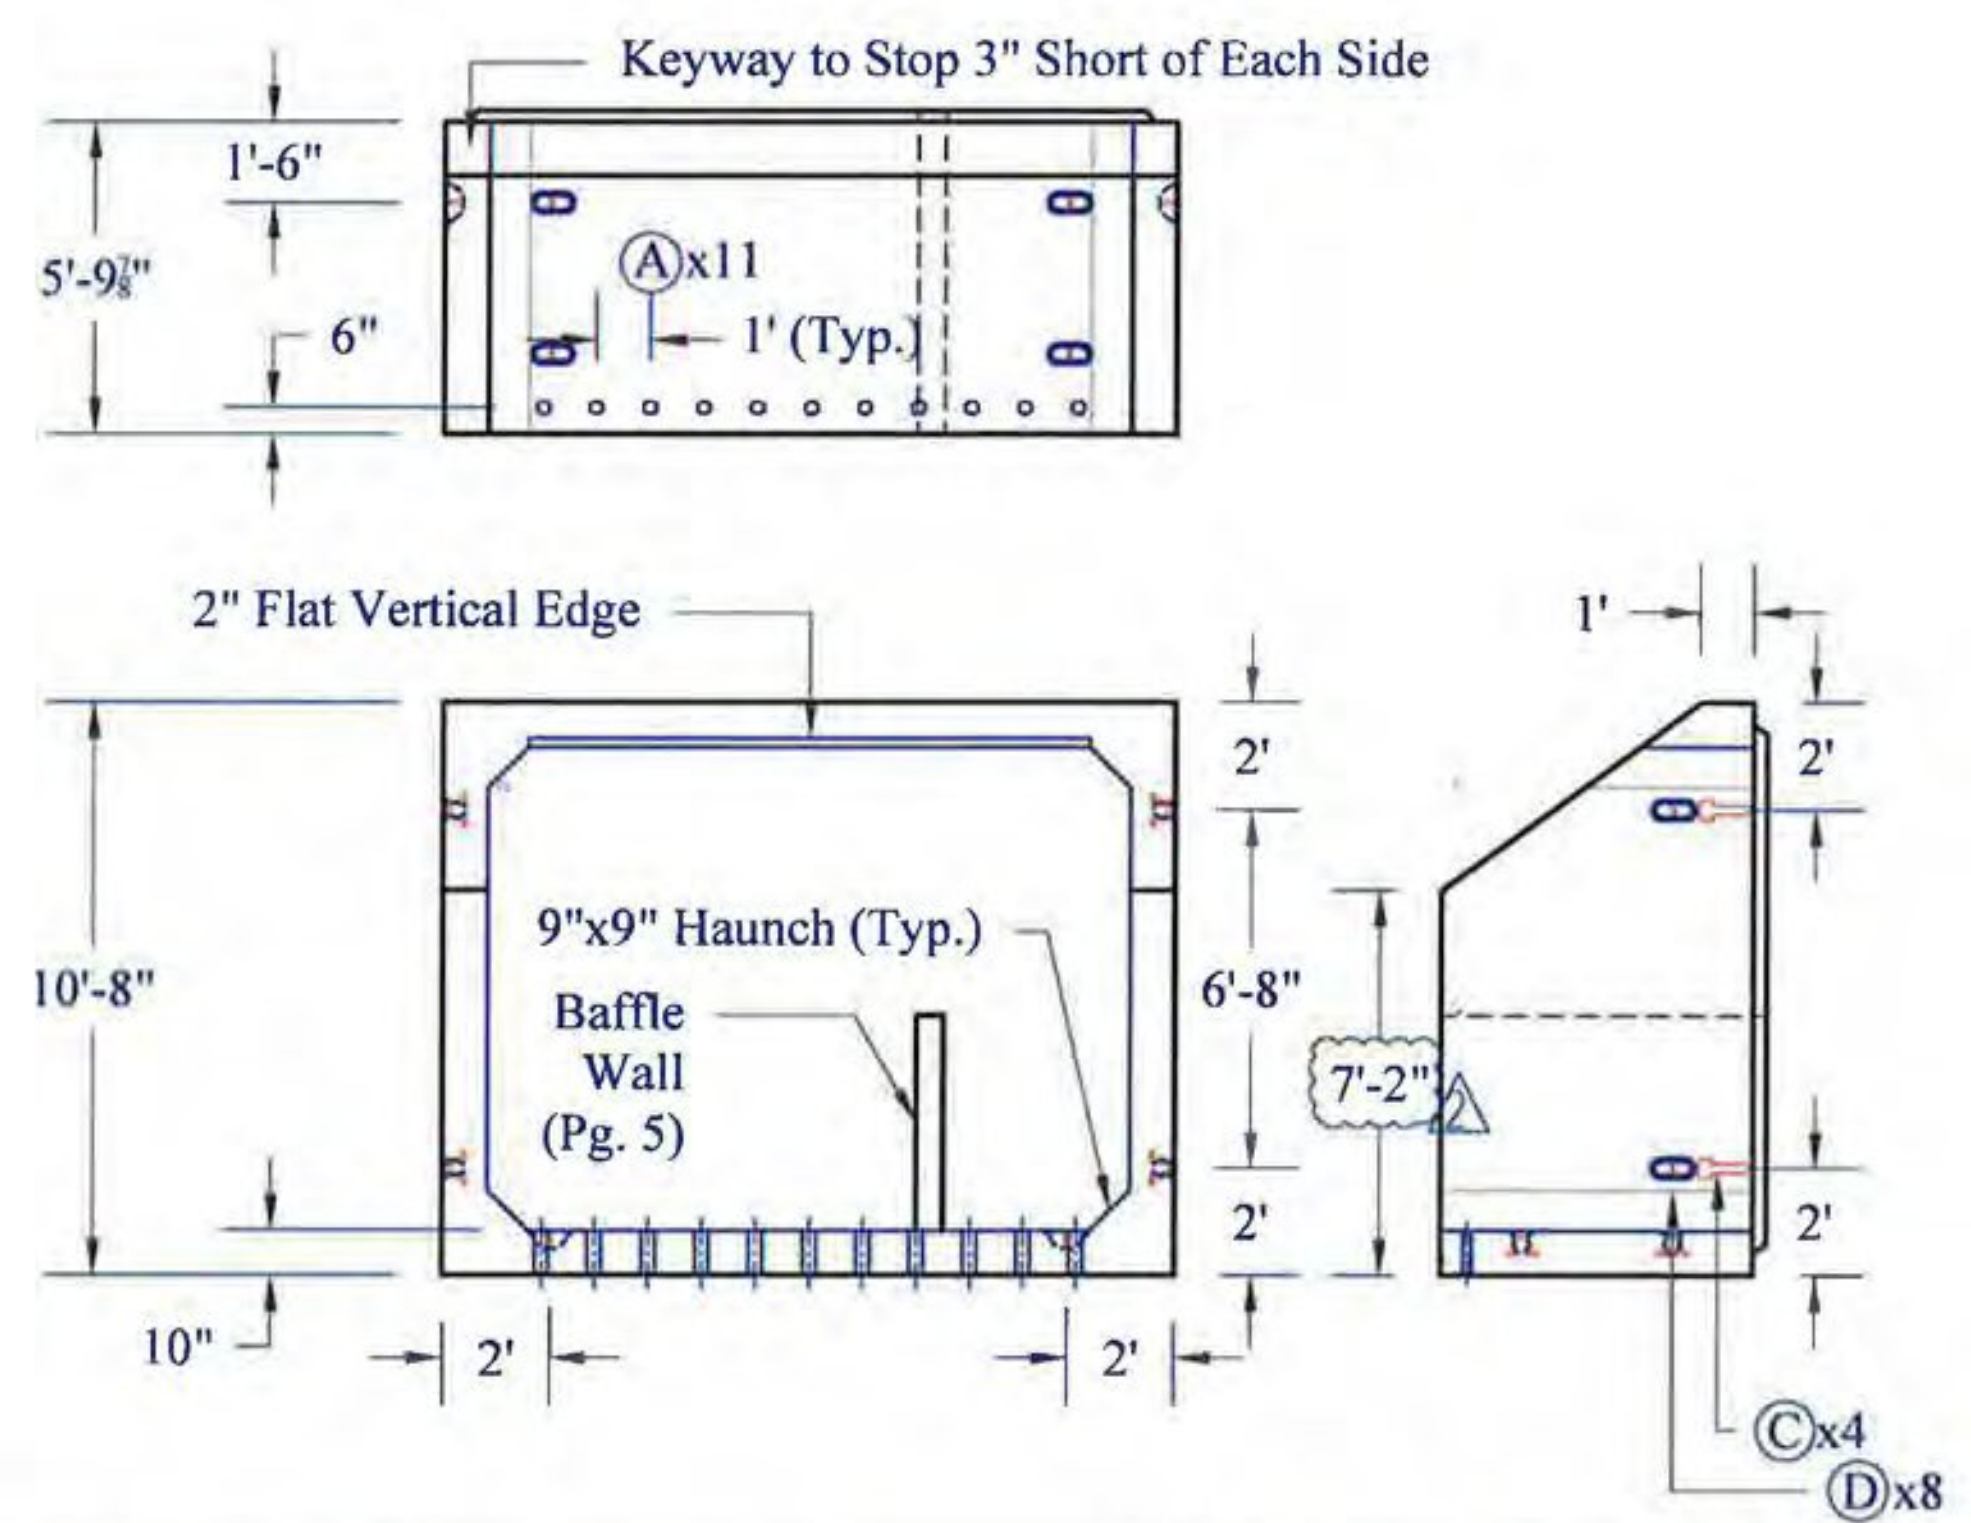

Baffle Wall Detail

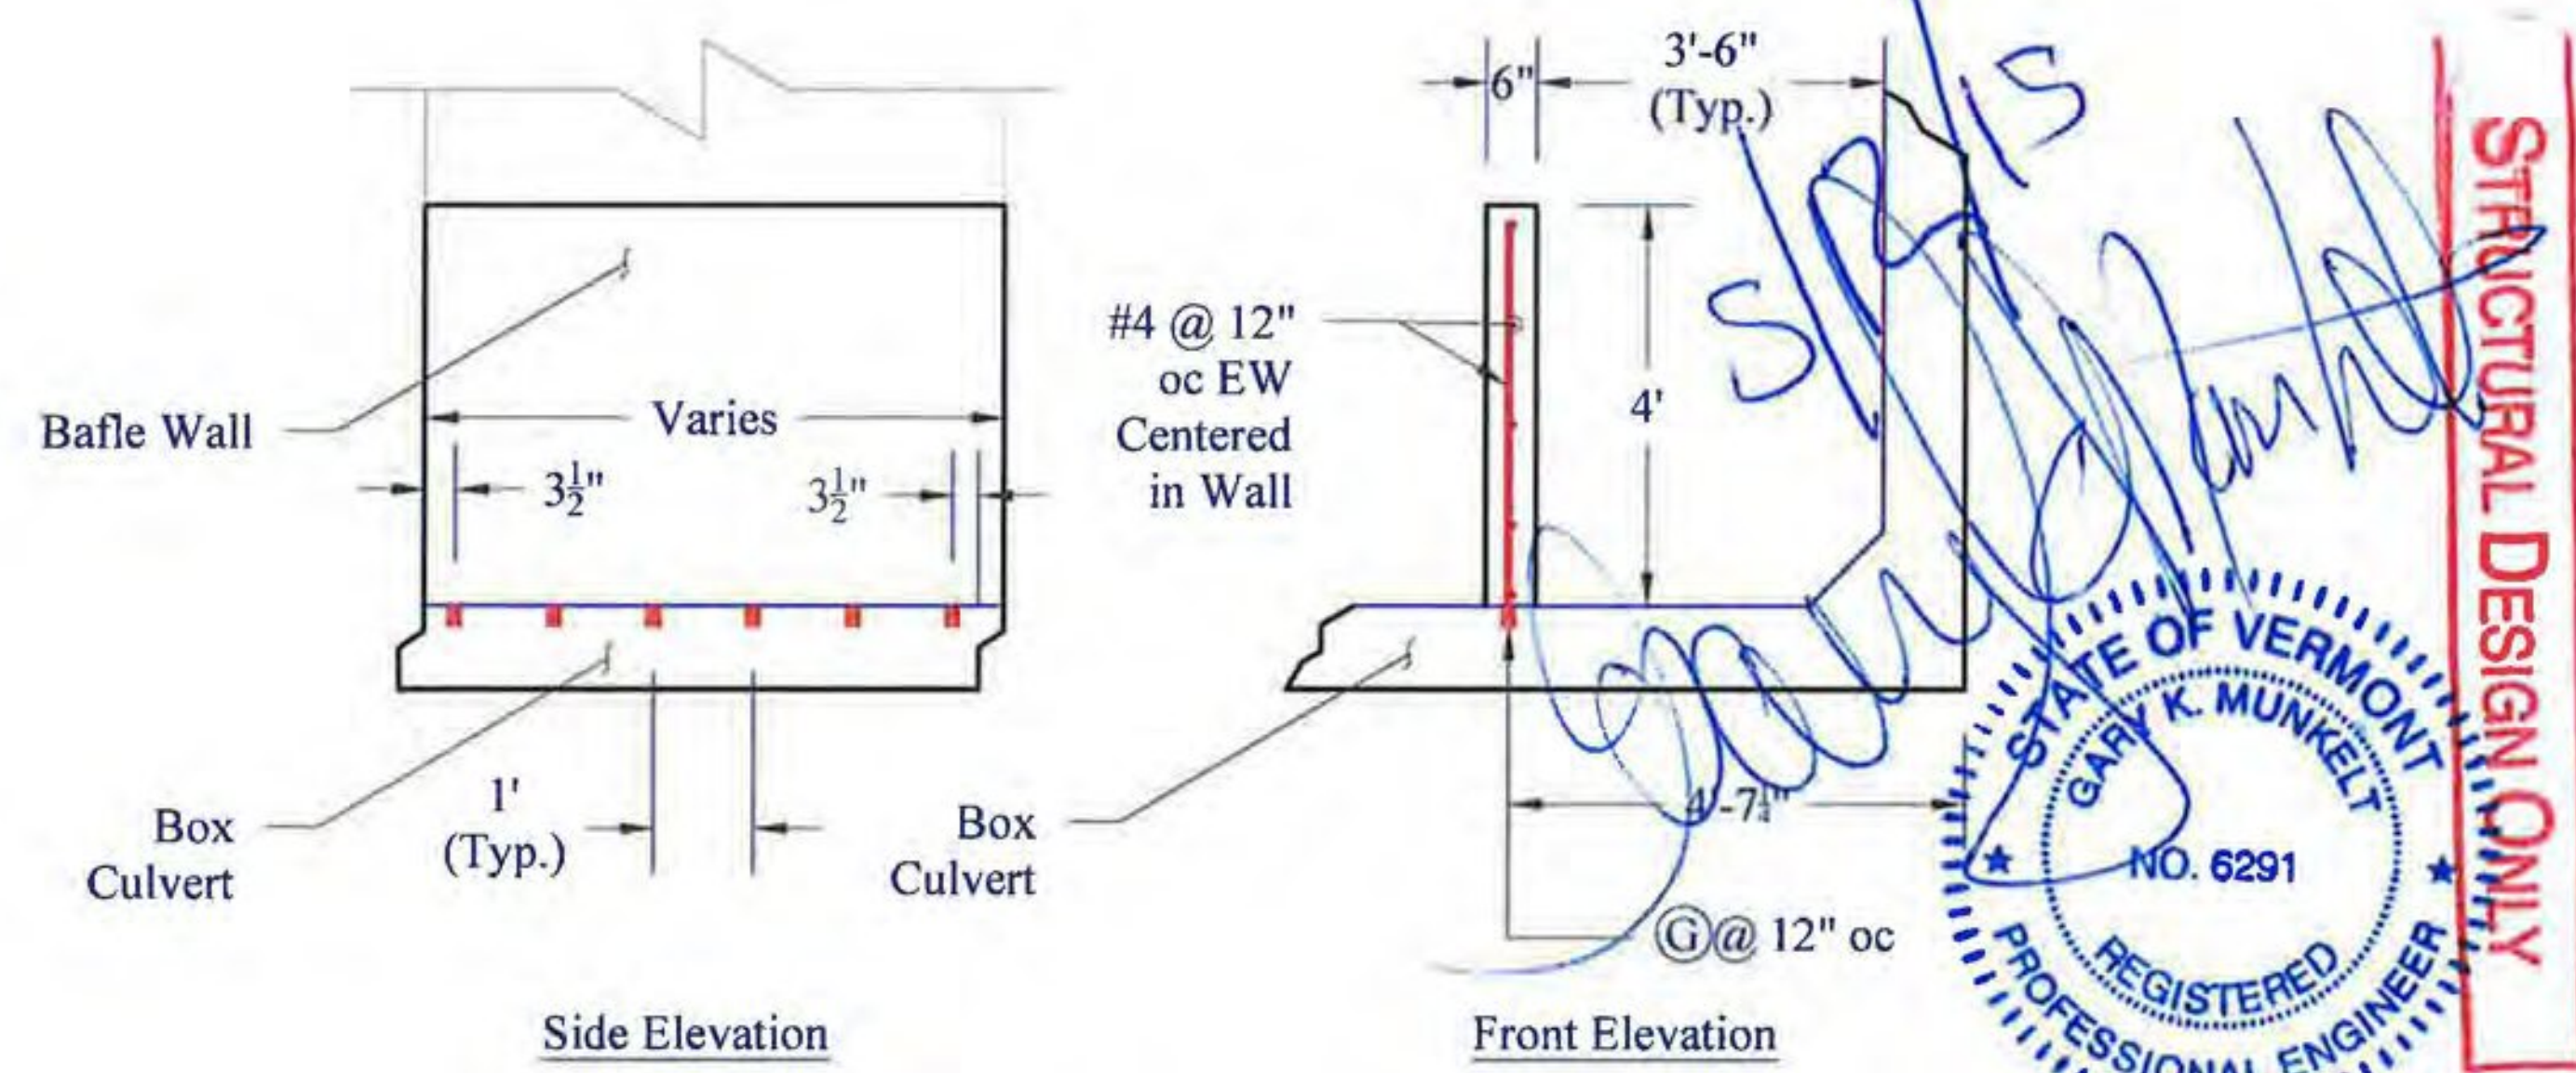

CONTRACTORS VISPE:	Rev.	Date	By	Description
(A) 3"Ø PVC Sleeve	1	05/06/15	IBA	Changes per Redesign
(B) 4"Ø PVC Sleeve	2	05/11/15	IBA	Inlet/Outlet BC Change
(C) Mechanical Bolt Pocket (w/ 1"Ø Coil Rod)				
(D) Oxford A750-7 Lifting Device				
(E) 1 1/2" x 3 1/2" Continuous Keyway				
(F) Solid Lines Indicate 3/4" Chamfer				
(G) 1/2" EX-5 Ferrule Loop Insert				

PRECAST CONCRETE BOX CULVERT SHOP DRAWINGS (SDI JOB #15428)

SUPERVISOR: E. Barendse  
 DETAILER: I. ADAMS  
 CHECKER: E. Barendse  
 ENGINEER: G. K. Munkelt

PROJECT NAME: Bridport  
 PROJECT #: CULV(29) Br.#5  
 LOCATION: Bridport, VT

Peckham Road Corp.  
 1557 St. Rt. 9, #3  
 Lake George, NY 12845  
 Ph: (518) 747-3353

FABRICATOR:  
 193 INDUSTRIAL AVE.  
 WILLISTON, VT 05495  
 Ph: (802) 658-0201

04/20/15 WING_WALLS_1 4_OF_6



