

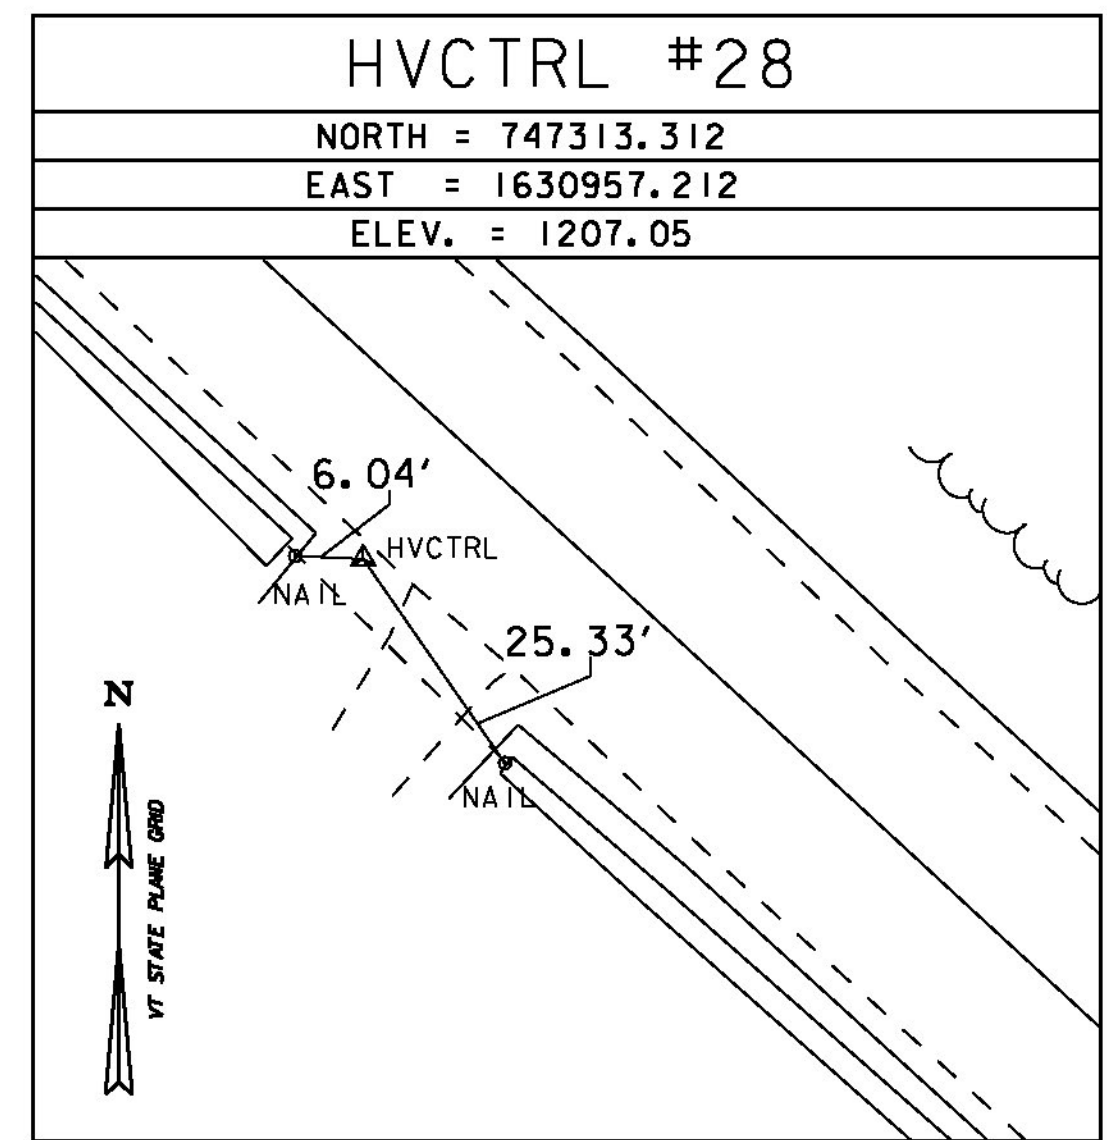
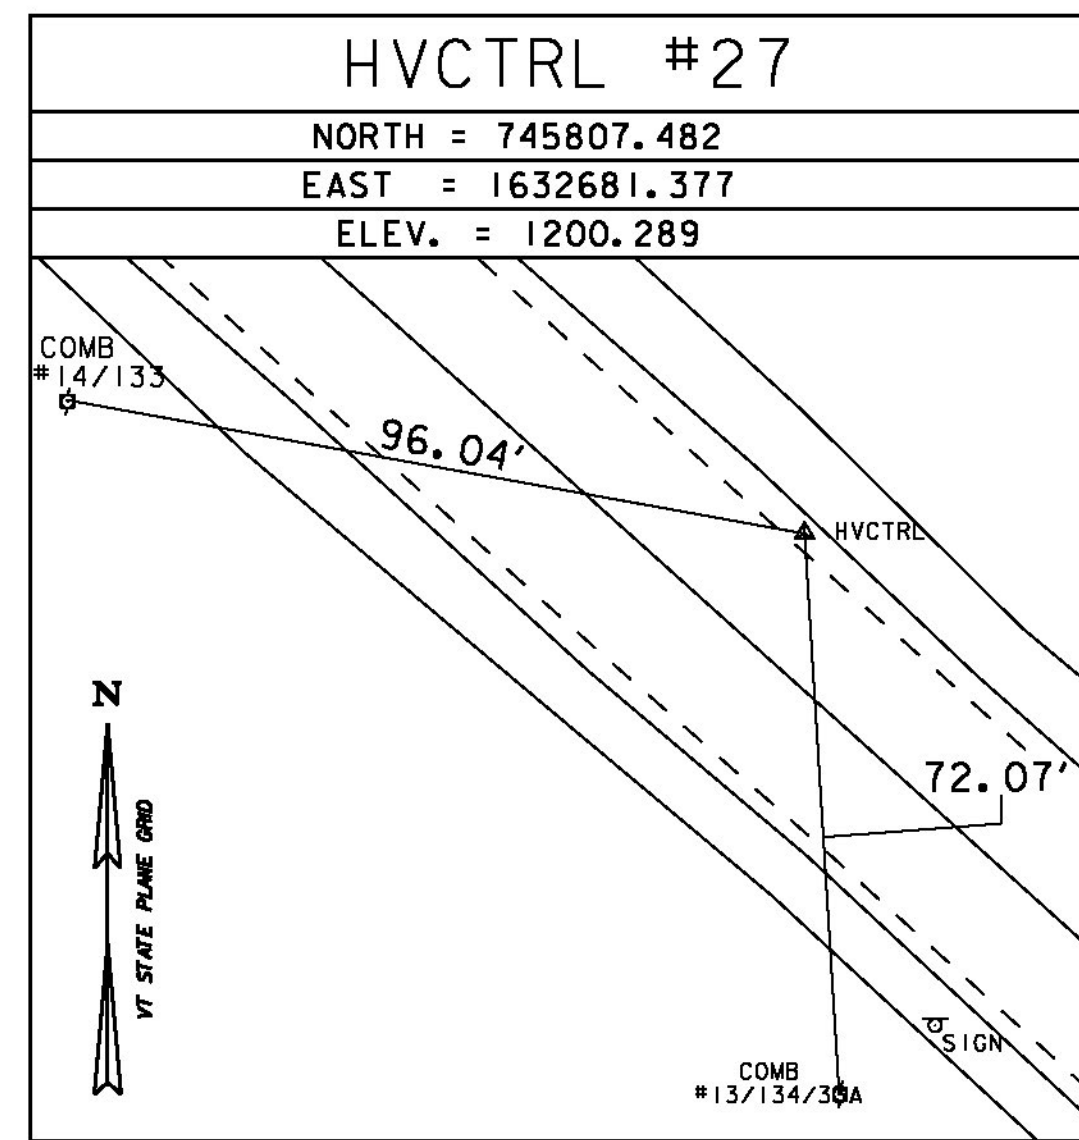
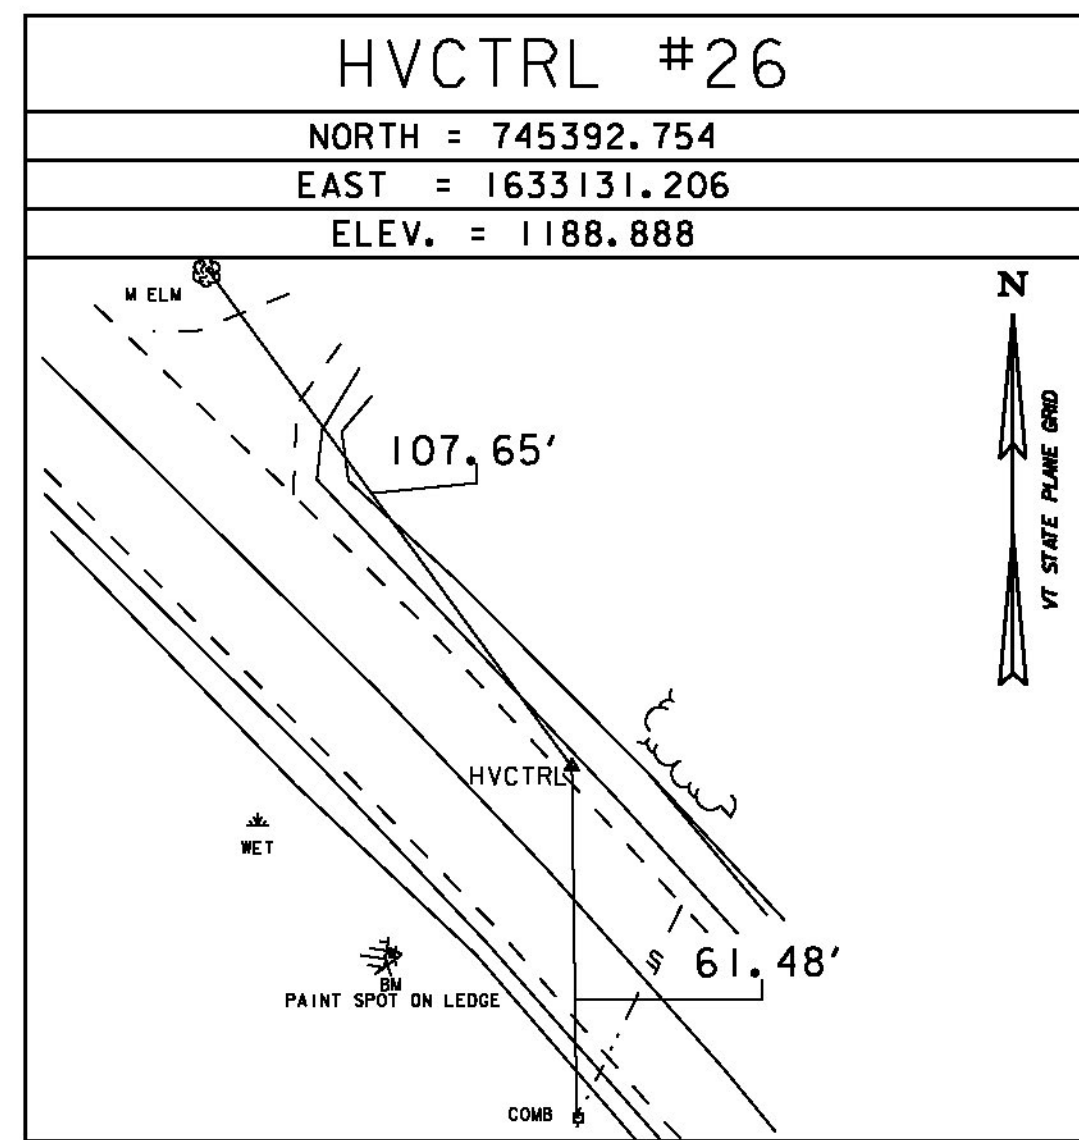
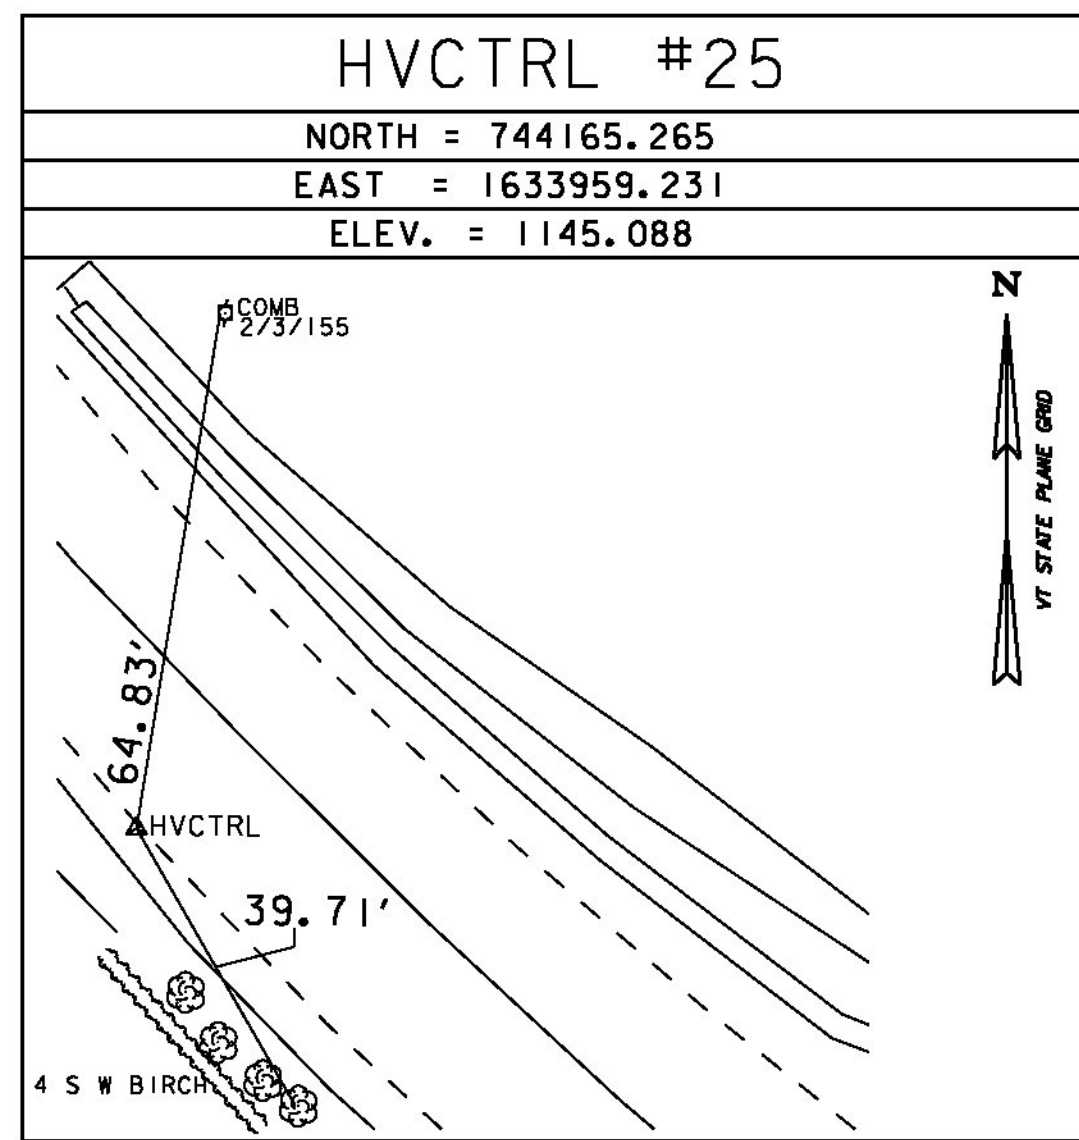
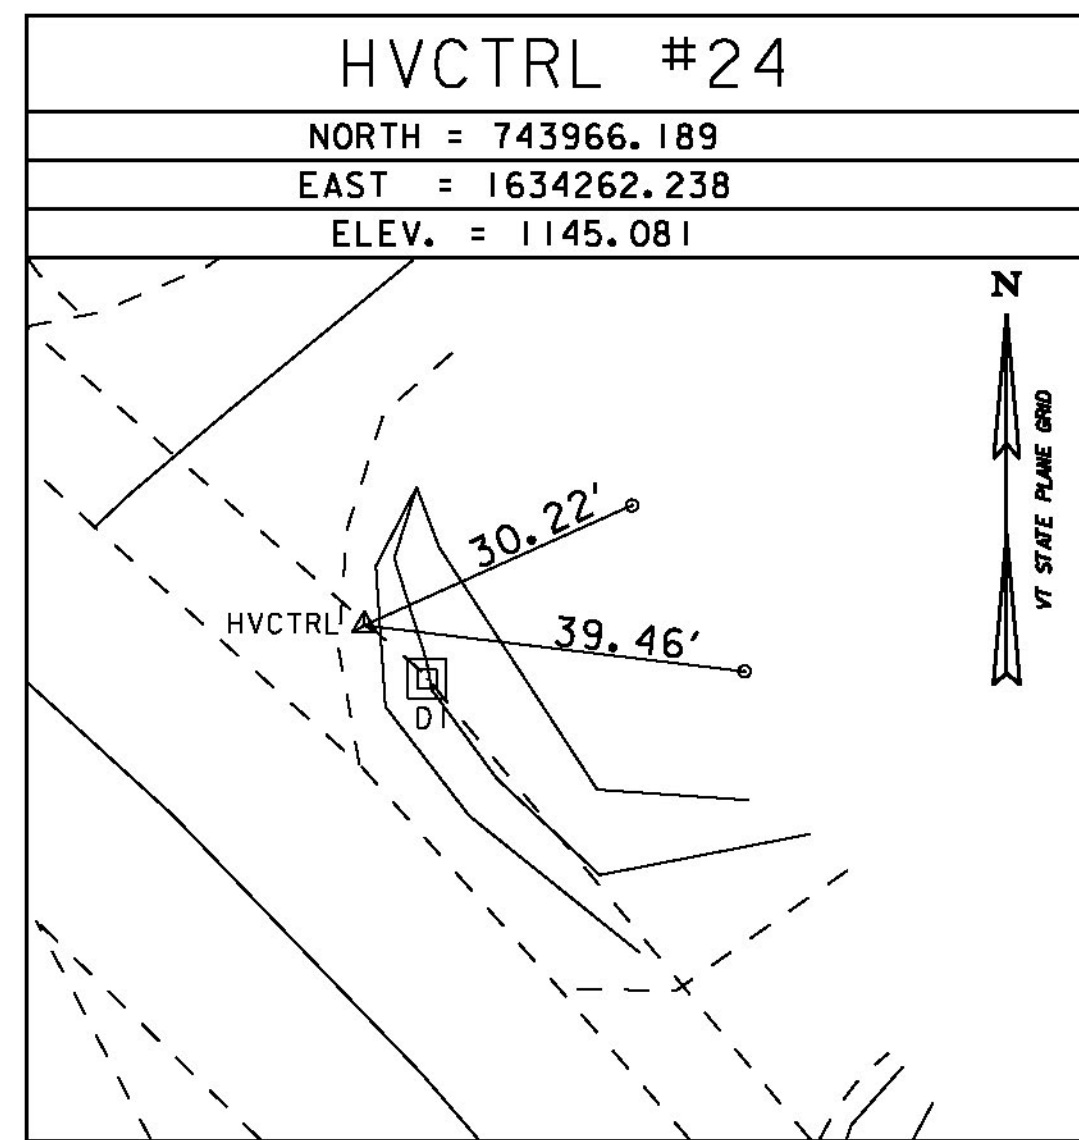
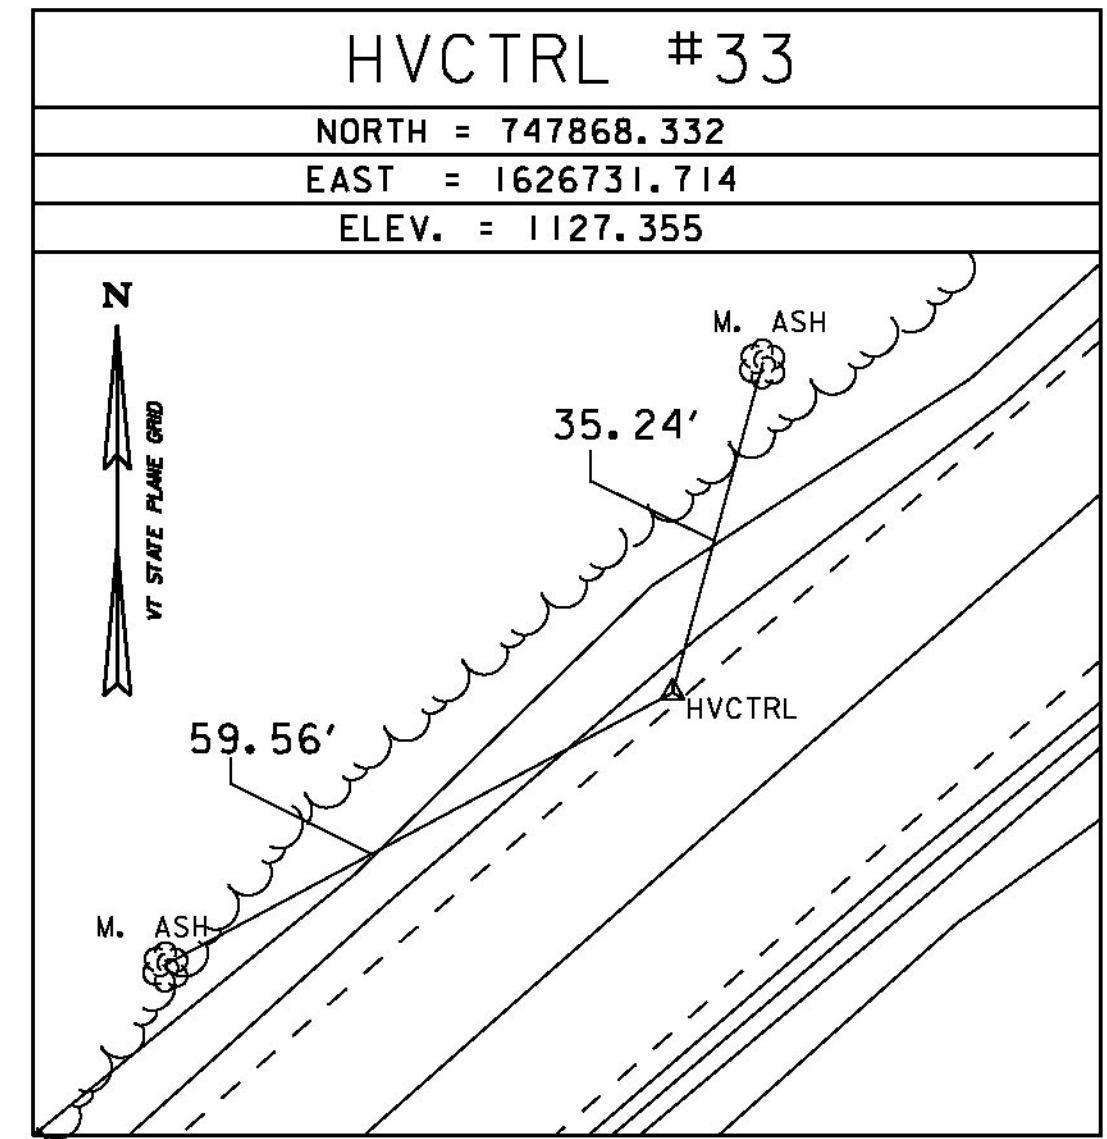
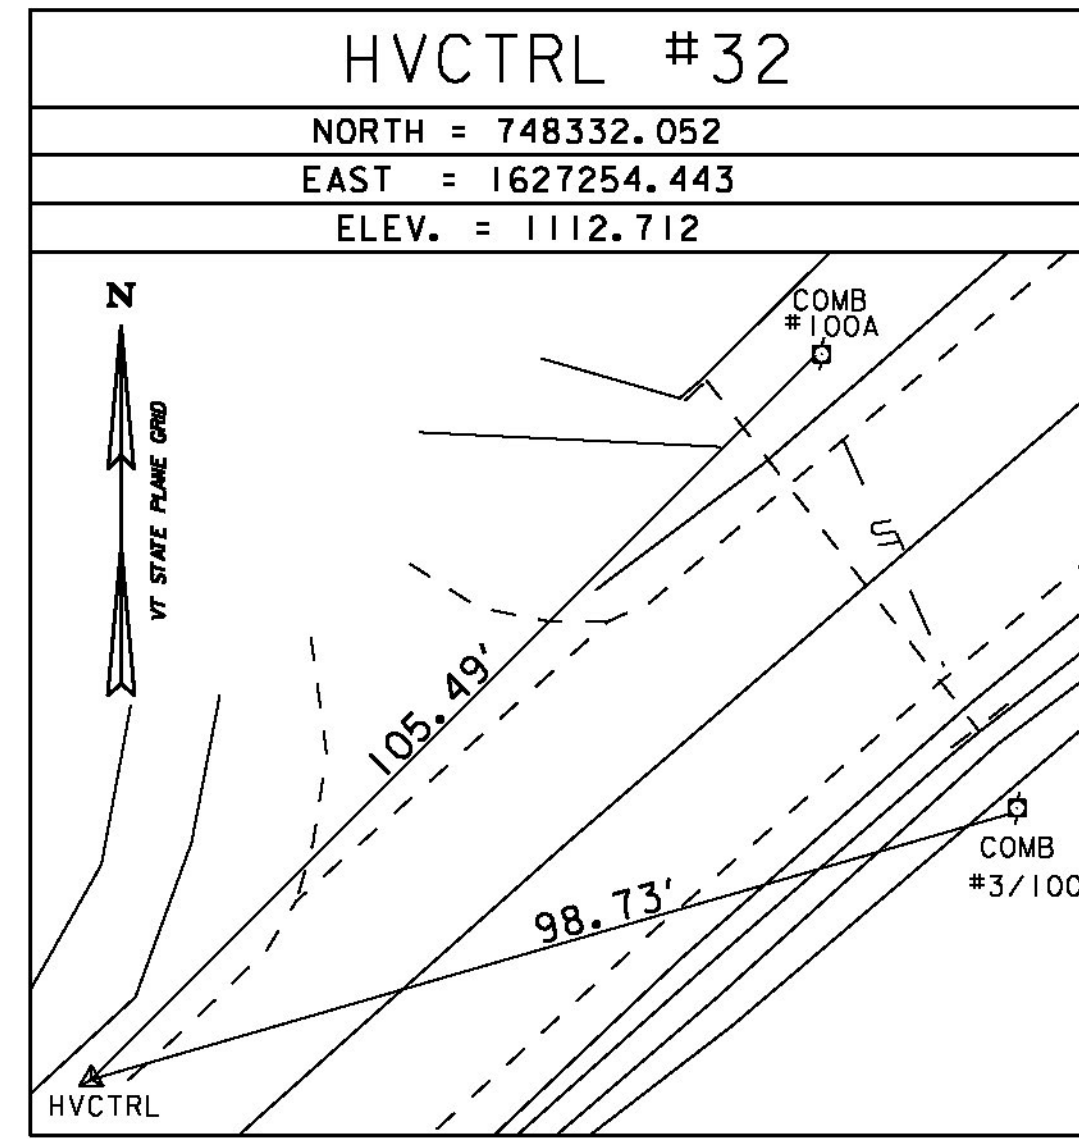
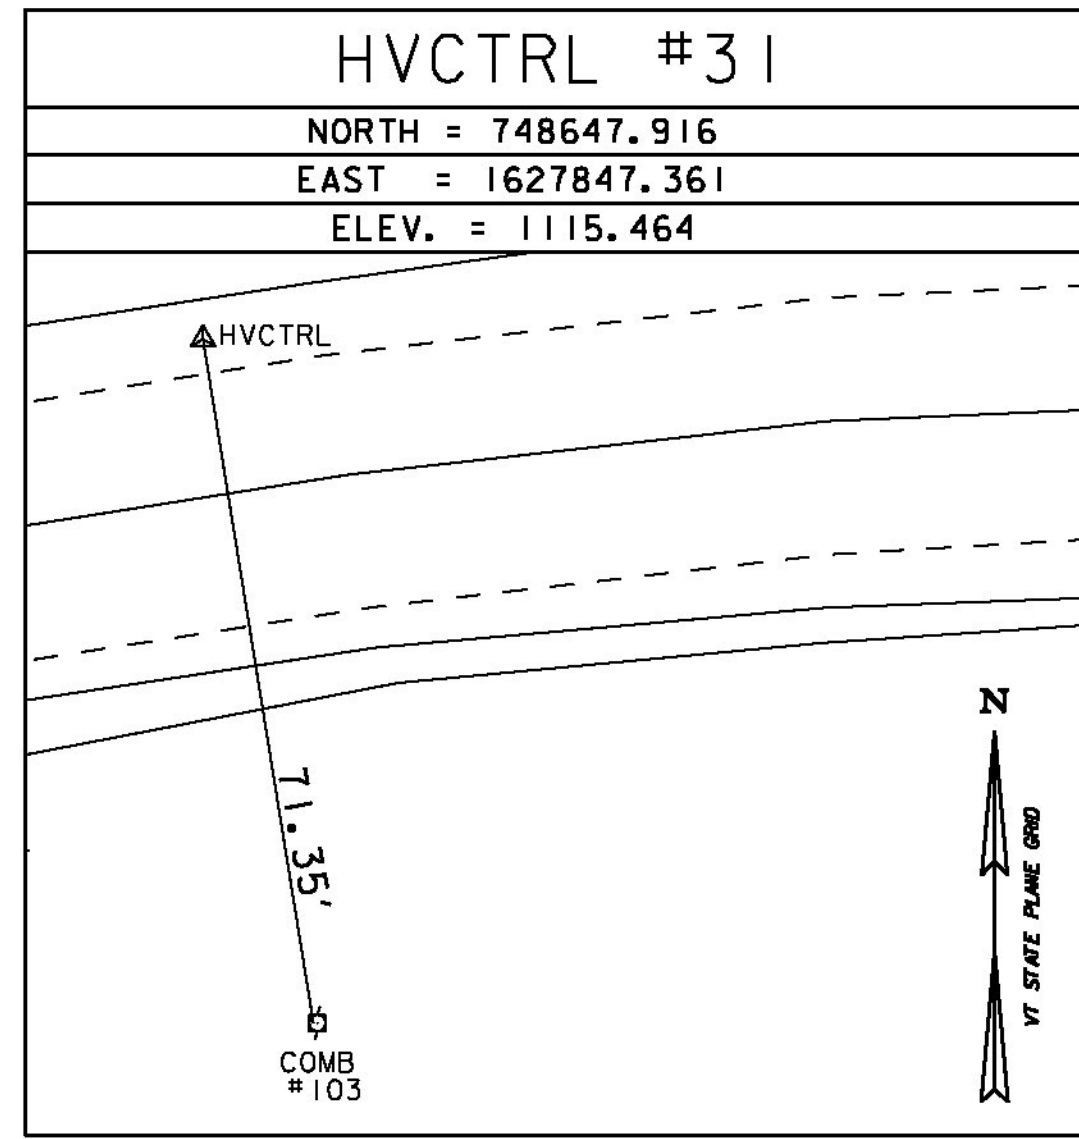







TRAVERSE TIES

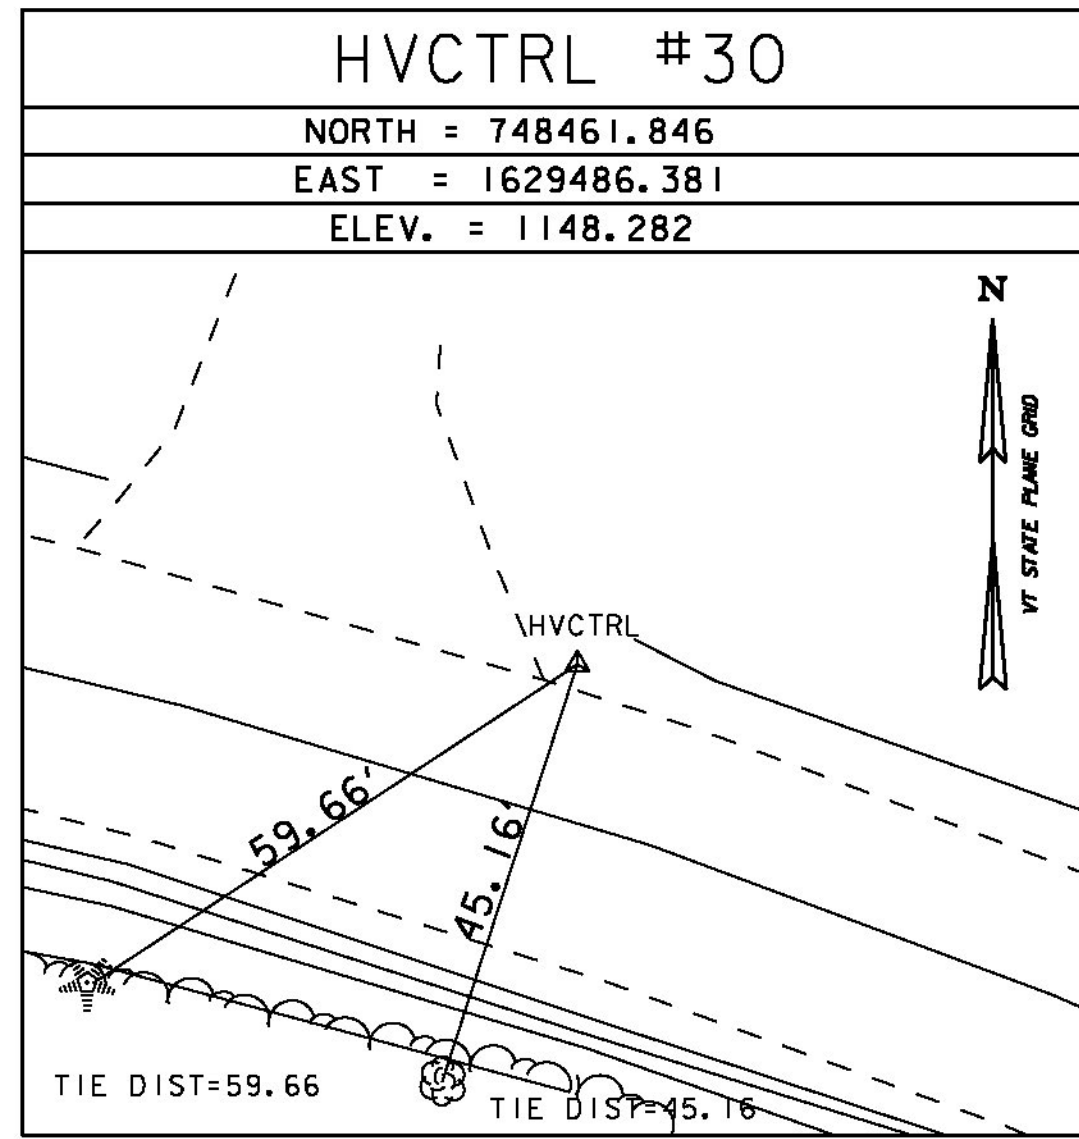

TRAVERSE TIES

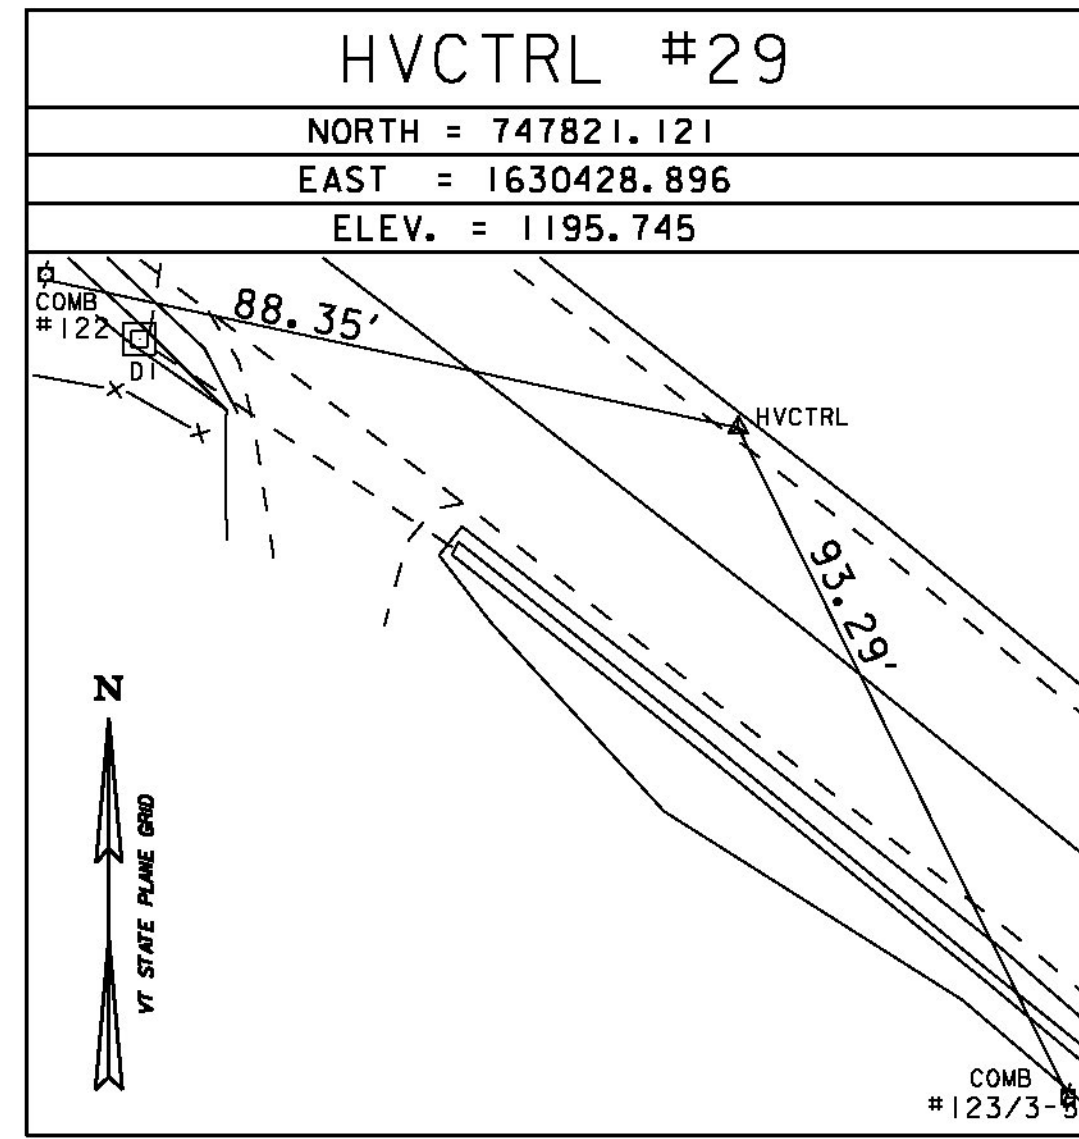

ALIGNMENT COORD

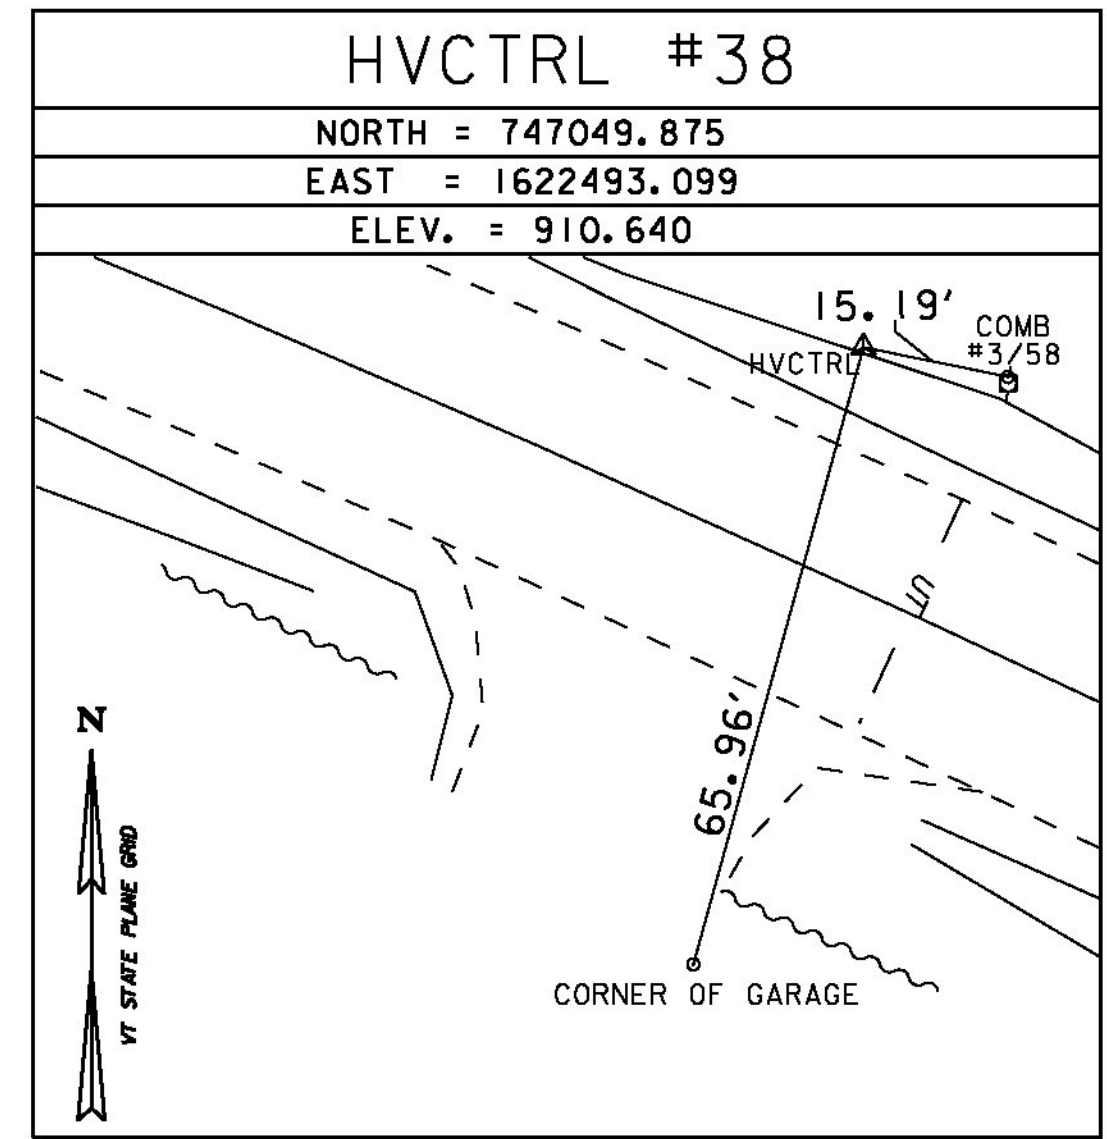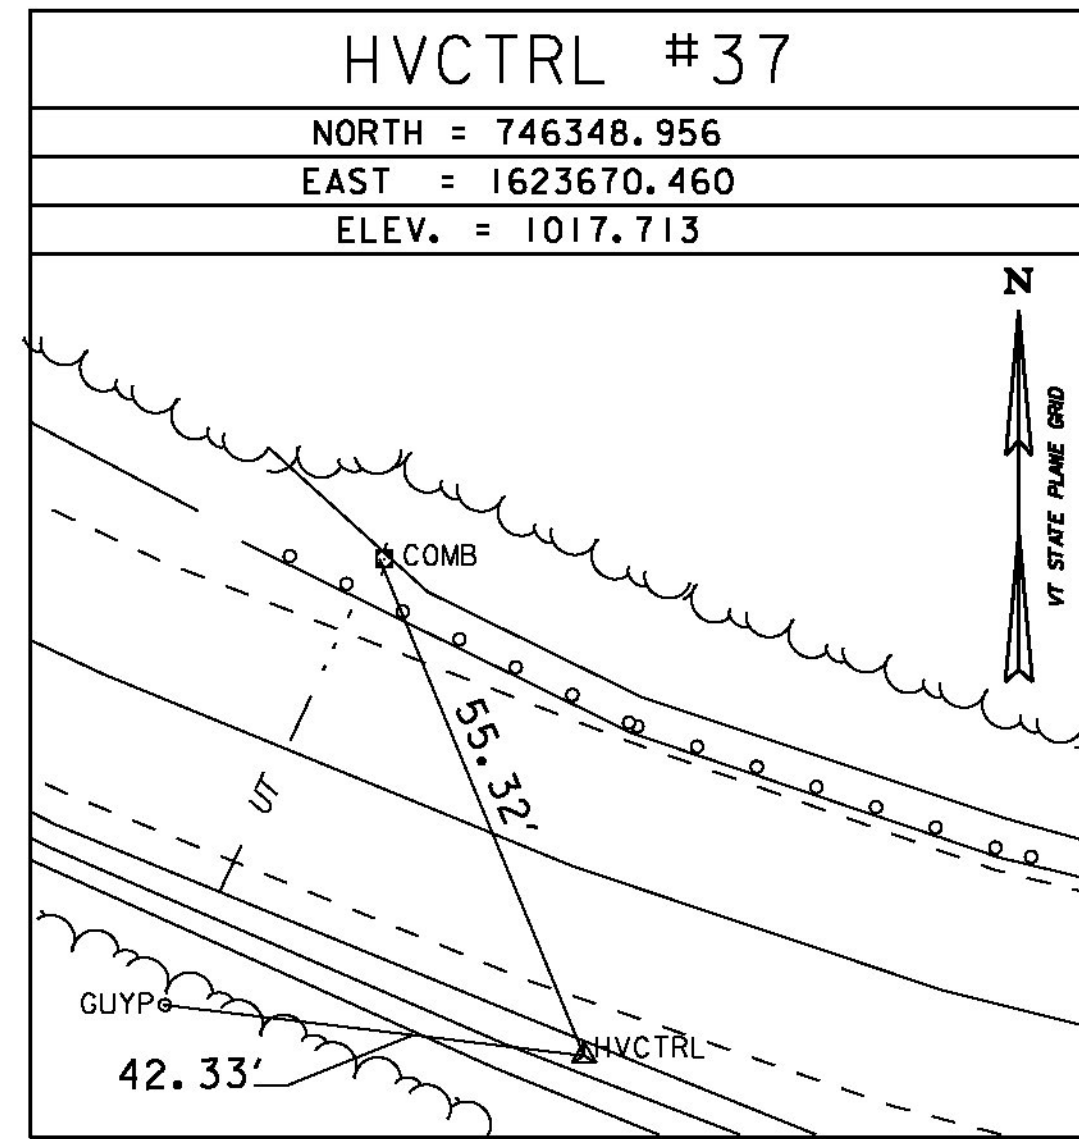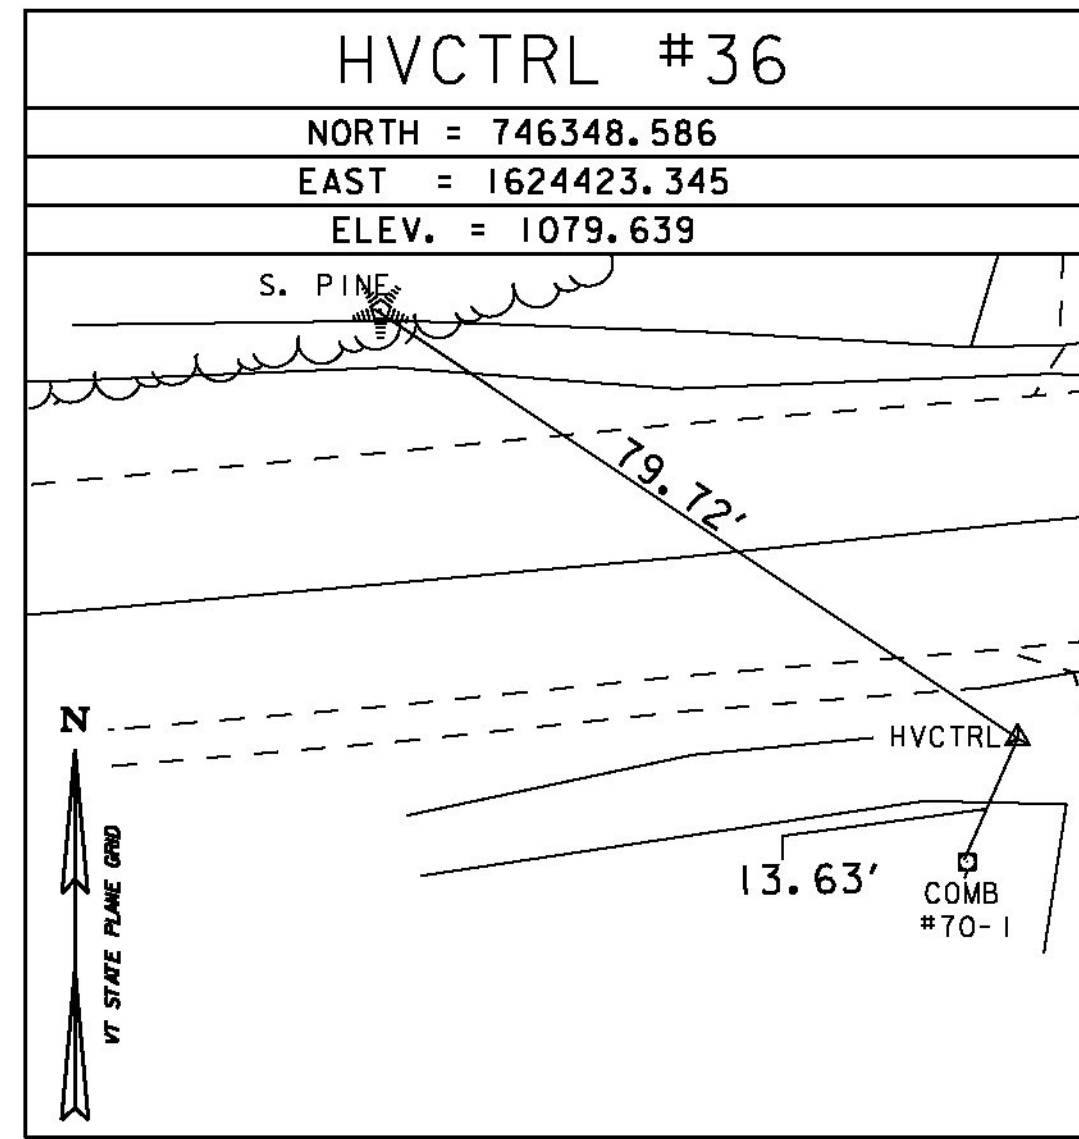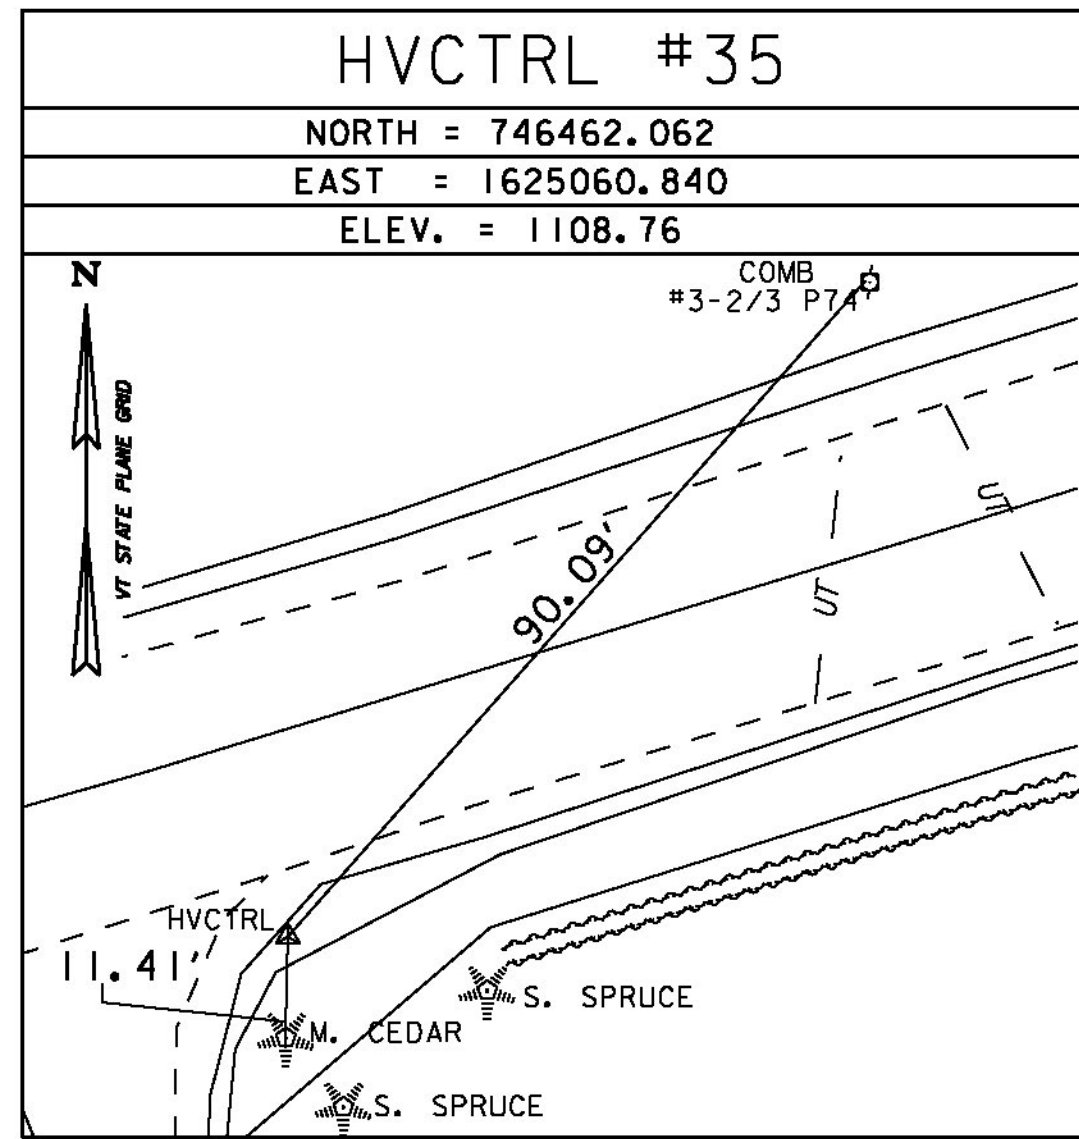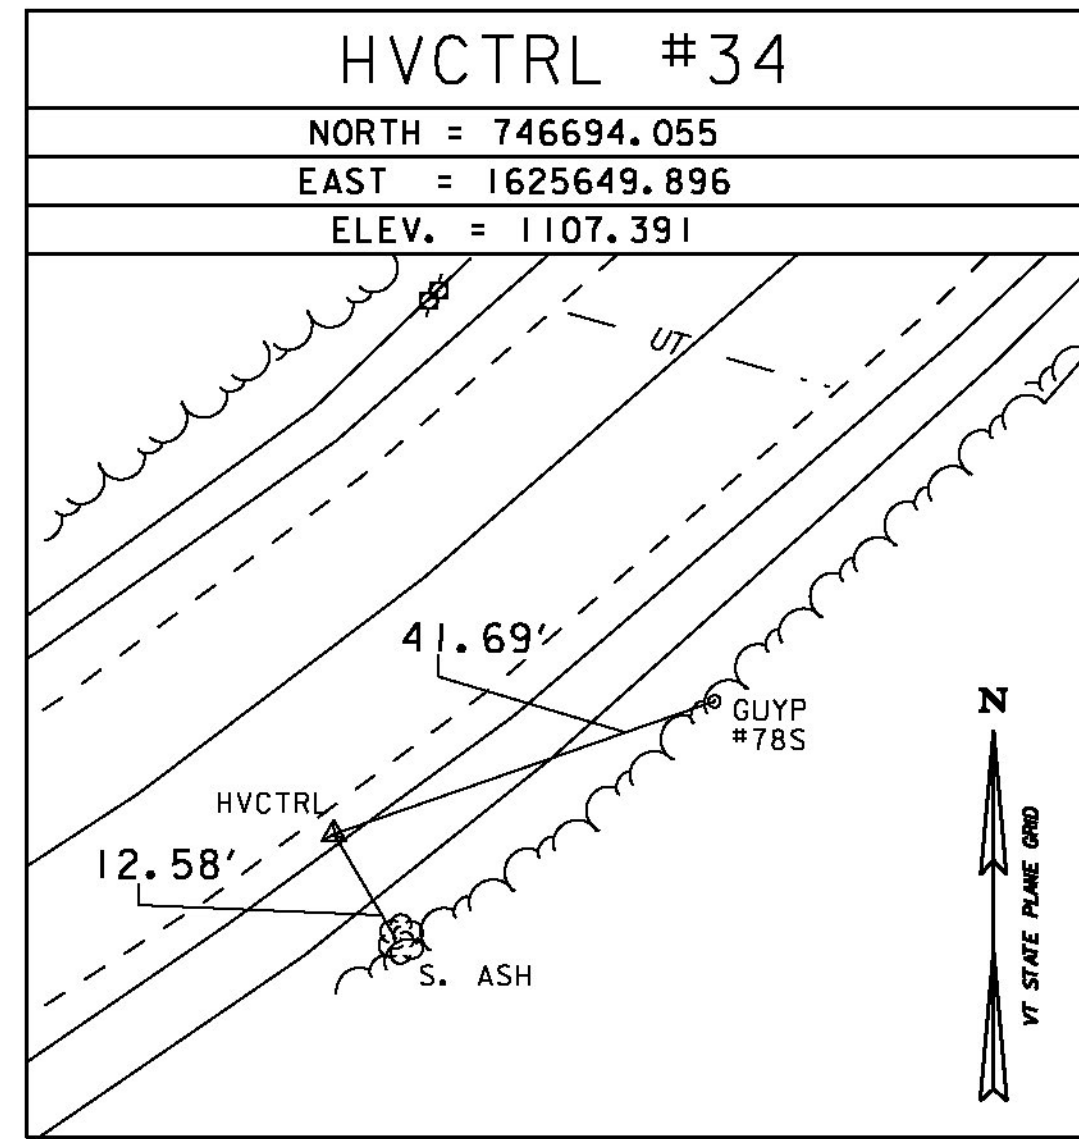

DATUM	
VERTICAL	NAVD 88
HORIZONTAL	NAD 83 (2011)
ADJUSTMENT	COMPASS

TIE SHEET 3	PROJECT NAME: ELMORE-MORRISTOWN
	PROJECT NUMBER: STP 2937 (1)
FILE NAME: z11c310.dgn	PLOT DATE: 3/3/14
PROJECT LEADER: C. LATHROP	DRAWN BY: R. BULLOCK
DESIGNED BY: S. LAMPHERE	CHECKED BY: C. LATHROP
PLOT FILE: z11c310.5.i	SHEET 5 OF 194