

DURABLE 4 INCH WHITE LINE, POLYUREA
 STA. 195+50 - STA. 201+25 (SOLID LT & RT)


TEMPORARY 4 INCH WHITE LINE, PAINT
 STA. 195+50 - STA. 201+25 (SOLID LT & RT)

6 INCH UNDERDRAIN PIPE
 STA. 197+00 - STA. 200+50 LT

DURABLE 4 INCH YELLOW LINE, POLYUREA
 STA. 195+50 - STA. 200+64 (SOLID LT, DASHED RT)
 STA. 200+64 - STA. 201+25 (DASHED CL)

TEMPORARY 4 INCH YELLOW LINE, PAINT
 STA. 195+50 - STA. 200+64 (SOLID LT, DASHED RT)
 STA. 200+64 - STA. 201+25 (DASHED CL)

REMOVING SIGNS
 AS SHOWN - 1

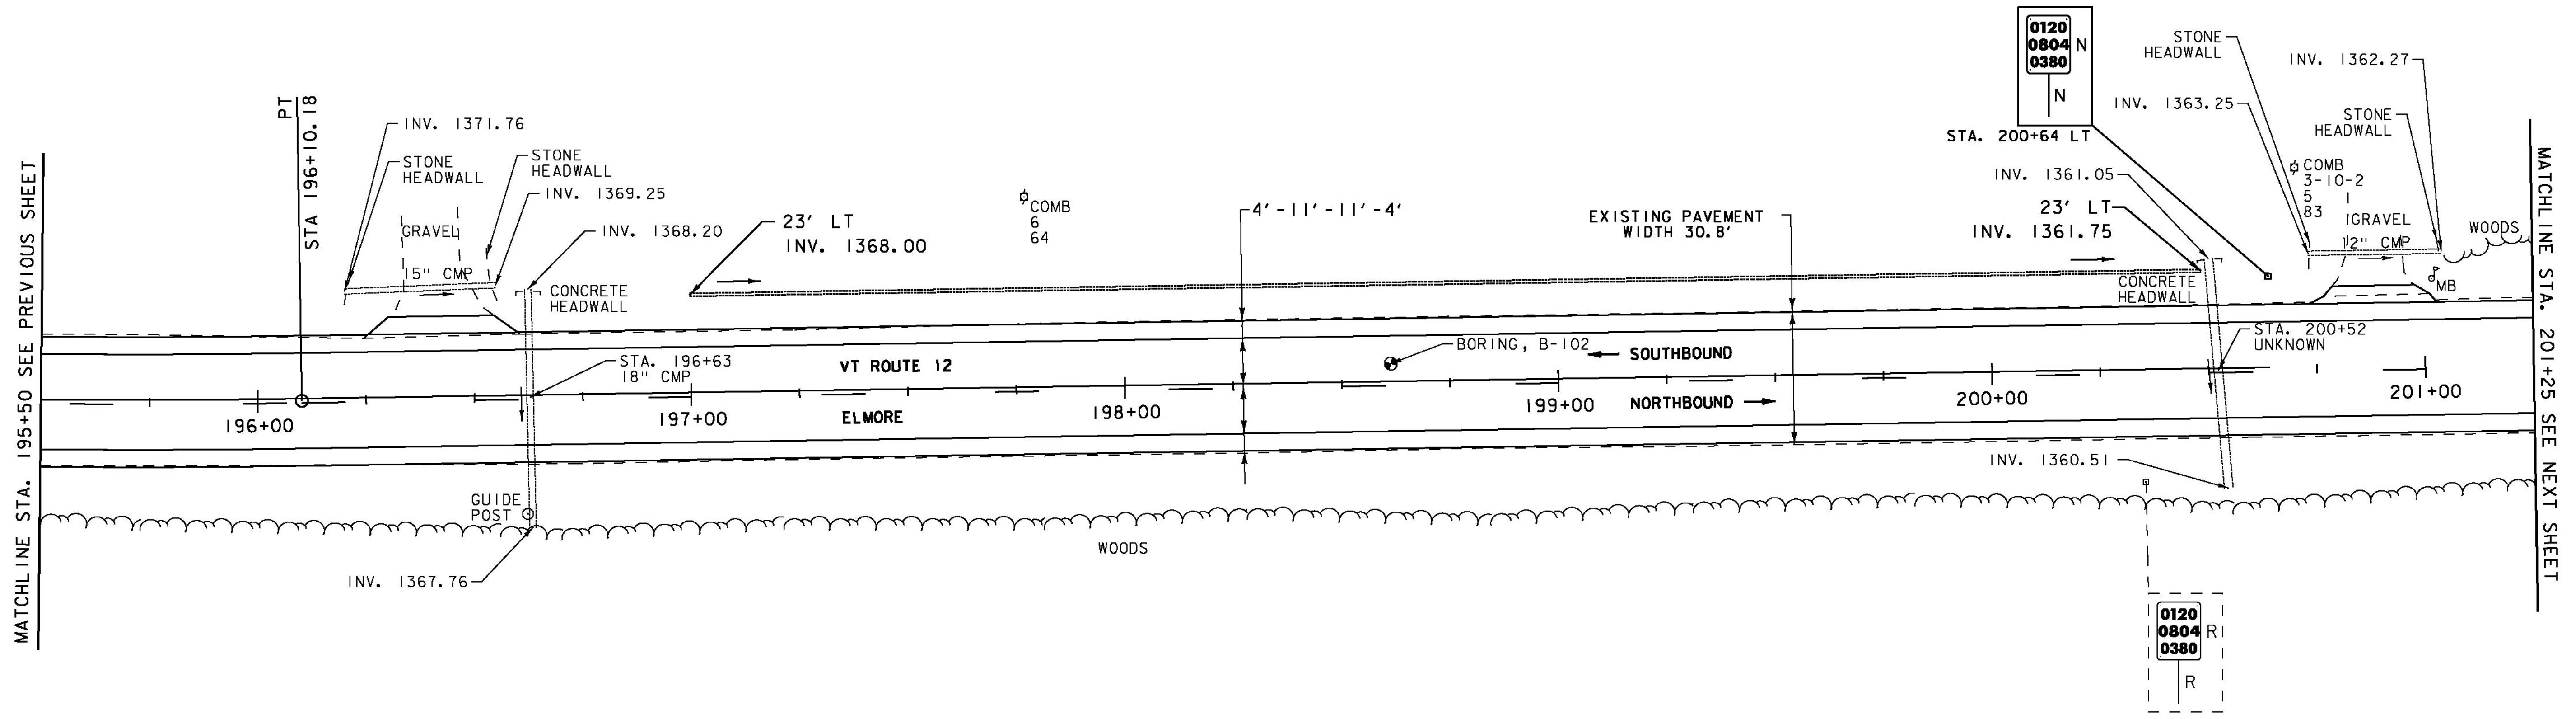

SIGN LEGEND
 R = REMOVE
 R&S = REMOVE AND SALVAGE
 RET = RETAIN
 S = SALVAGED
 N = NEW
 B-B = BACK TO BACK
 - - = EXISTING
 — = NEW



PROJECT LAYOUT SHEET 3	PROJECT NAME: ELMORE-MORRISTOWN	PLOT DATE: 3/3/14
	PROJECT NUMBER: STP 2937 (1)	DRAWN BY: J. GOODALL
	FILE NAME: z11c310.dgn	CHECKED BY: C. LATHROP
	DESIGNED BY: S. LAMPHERE	SHEET 26 OF 194
	PLOT FILE: z11c310.26.i	