



DURABLE 4 INCH WHITE LINE, POLYUREA
 STA. 206+50 - STA. 211+50 (SOLID LT & RT)
 (WITH EDGE LINE BREAK RT AT TH#23)

TEMPORARY 4 INCH WHITE LINE, PAINT
 STA. 206+50 - STA. 211+50 (SOLID LT & RT)
 (WITH EDGE LINE BREAK RT AT TH#23)

REMOVING SIGNS
 AS SHOWN - 3

DURABLE 4 INCH YELLOW LINE, POLYUREA
 STA. 206+50 - STA. 209+00 (DASHED LT, SOLID RT)
 STA. 209+00 - STA. 211+50 (SOLID LT & RT)
 (WITH CENTERLINE BREAK AT TH#23)

TEMPORARY 4 INCH YELLOW LINE, PAINT
 STA. 206+50 - STA. 209+00 (DASHED LT, SOLID RT)
 STA. 209+00 - STA. 211+50 (SOLID LT & RT)
 (WITH CENTERLINE BREAK AT TH#23)

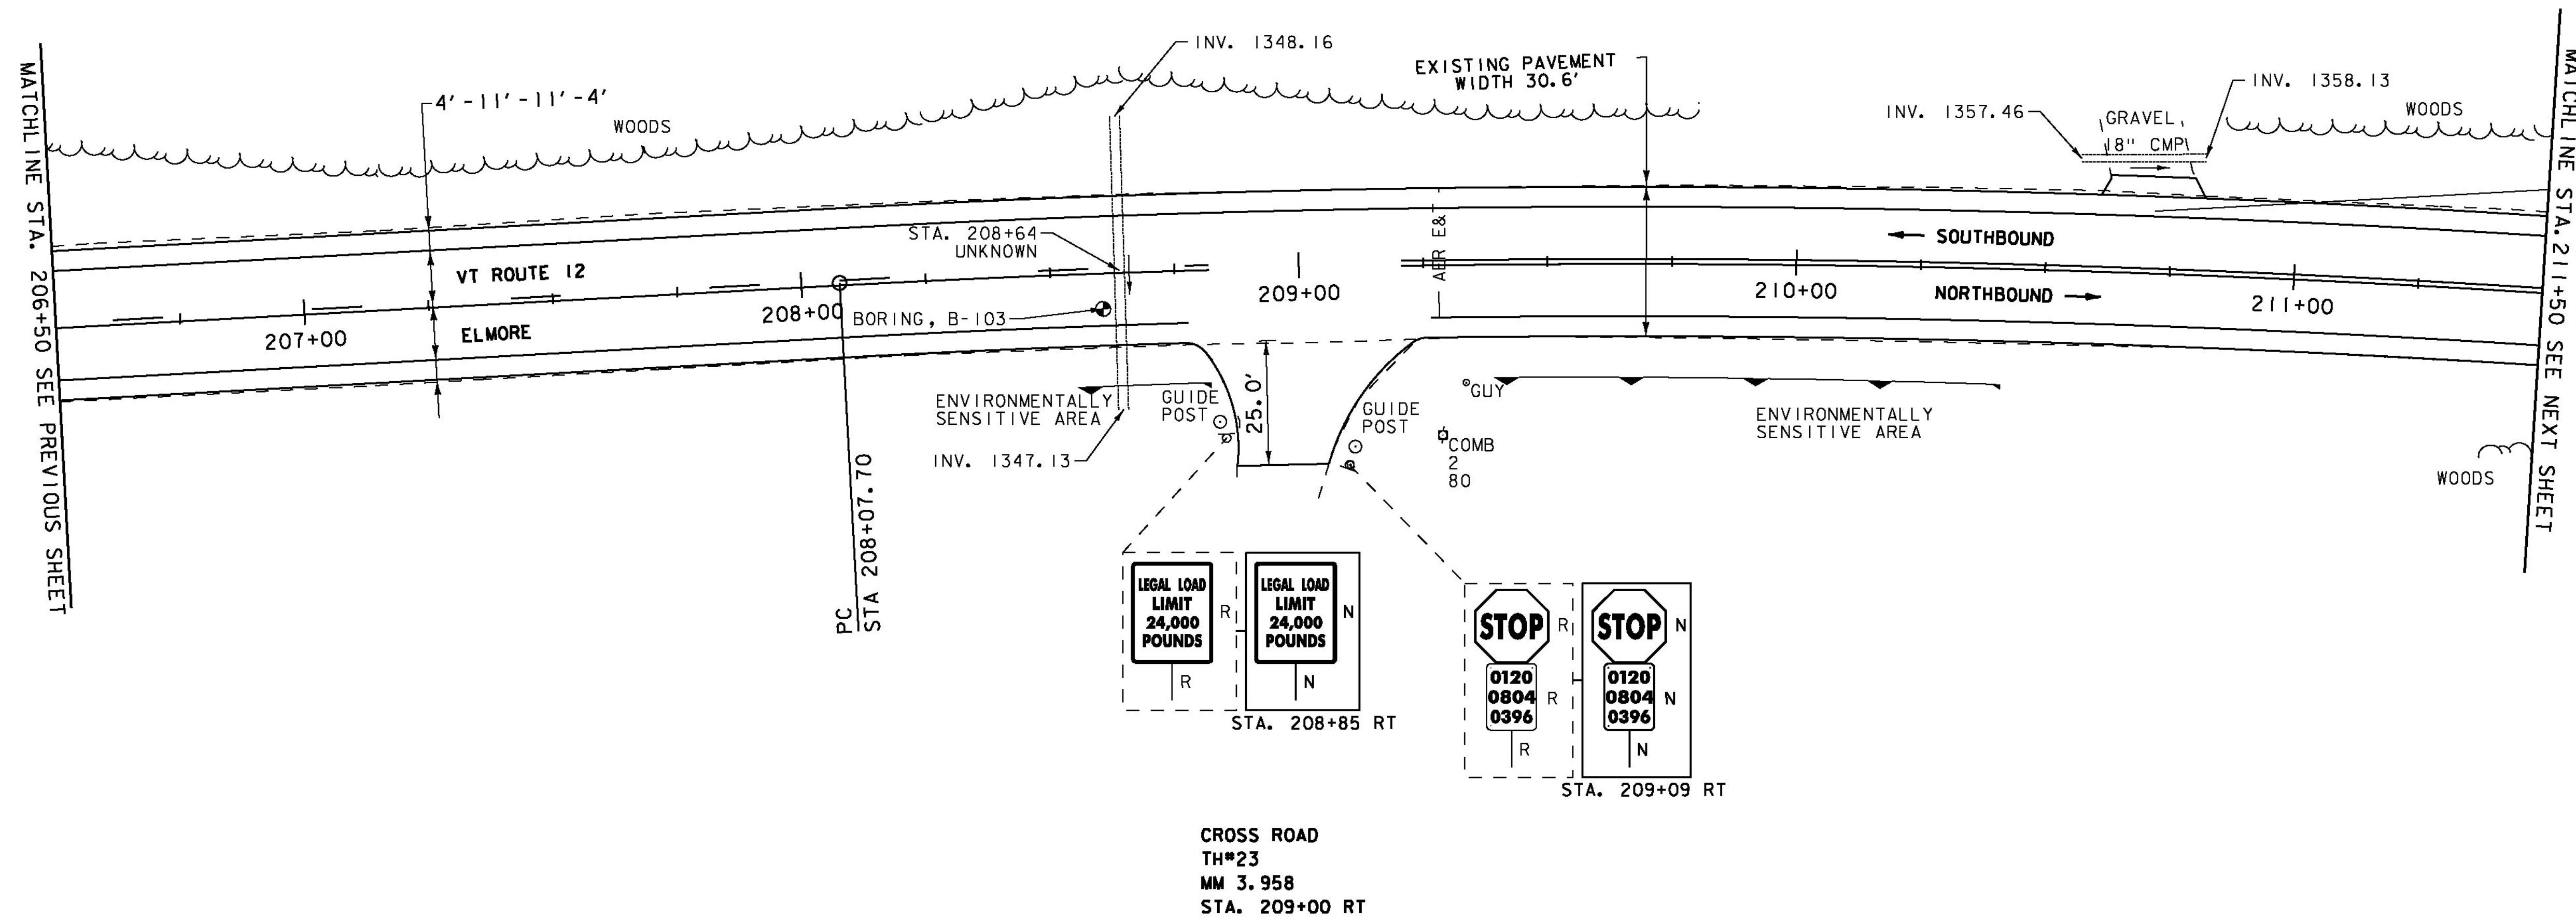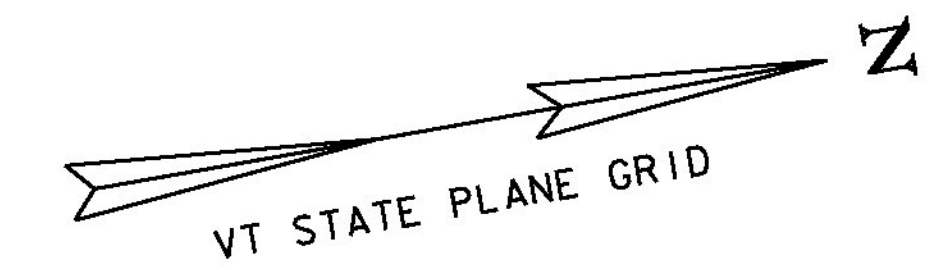

SIGN LEGEND
 R = REMOVE
 R&S = REMOVE AND SALVAGE
 RET = RETAIN
 S = SALVAGED
 N = NEW
 B-B = BACK TO BACK
 - - = EXISTING
 — = NEW

ENVIRONMENTALLY SENSITIVE LOCATIONS:

NO.	LIMITS	POS.	TYPE
1.	STA. 208+55 - STA. 208+82	RT	-
2.	STA. 209+39 - STA. 210+41	RT	-



PROJECT LAYOUT SHEET 5

PROJECT NAME: ELMORE-MORRISTOWN

PROJECT NUMBER: STP 2937 (1)

FILE NAME: z11c310.dgn
 PROJECT LEADER: C. LATHROP
 DESIGNED BY: S. LAMPHERE
 PLOT FILE: z11c310.28.i

PLOT DATE: 3/3/14
 DRAWN BY: J. GOODALL
 CHECKED BY: C. LATHROP
 SHEET 28 OF 194