

REMOVAL AND DISPOSAL OF GUARDRAIL
 STA. 229+87.5 - STA. 232+75 RT

STEEL BEAM GUARDRAIL, GALVANIZED
 STA. 229+75 - STA. 231+50 RT

STEEL BEAM GUARDRAIL, GALVANIZED W/8 FEET POSTS
 STA. 231+50 - STA. 232+75 RT

ANCHOR FOR STEEL BEAM RAIL
 STA. 229+75 RT


DURABLE 4 INCH WHITE LINE, POLYUREA
 STA. 227+50 - STA. 232+75 (SOLID LT & RT)

DURABLE 4 INCH YELLOW LINE, POLYUREA
 STA. 227+50 - STA. 229+68 (SOLID LT, DASHED RT)
 STA. 229+68 - STA. 232+75 (DASHED CL)


6 INCH UNDERDRAIN PIPE
 STA. 227+50 - STA. 230+50 LT

TEMPORARY 4 INCH WHITE LINE, PAINT
 STA. 227+50 - STA. 232+75 (SOLID LT & RT)

TEMPORARY 4 INCH YELLOW LINE, PAINT
 STA. 227+50 - STA. 229+68 (SOLID LT, DASHED RT)
 STA. 229+68 - STA. 232+75 (DASHED CL)

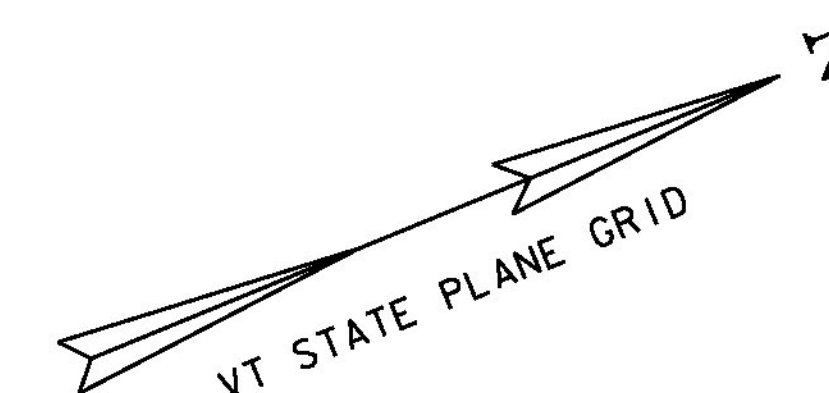

CURVE #5
 DELTA = 1°27'59"
 D = 0°24'33"
 R = 14000.00'
 T = 179.18'
 L = 358.33'
 E = 1.15'
 BANKING NORMAL CROWN
 DESIGN SPEED 50 MPH

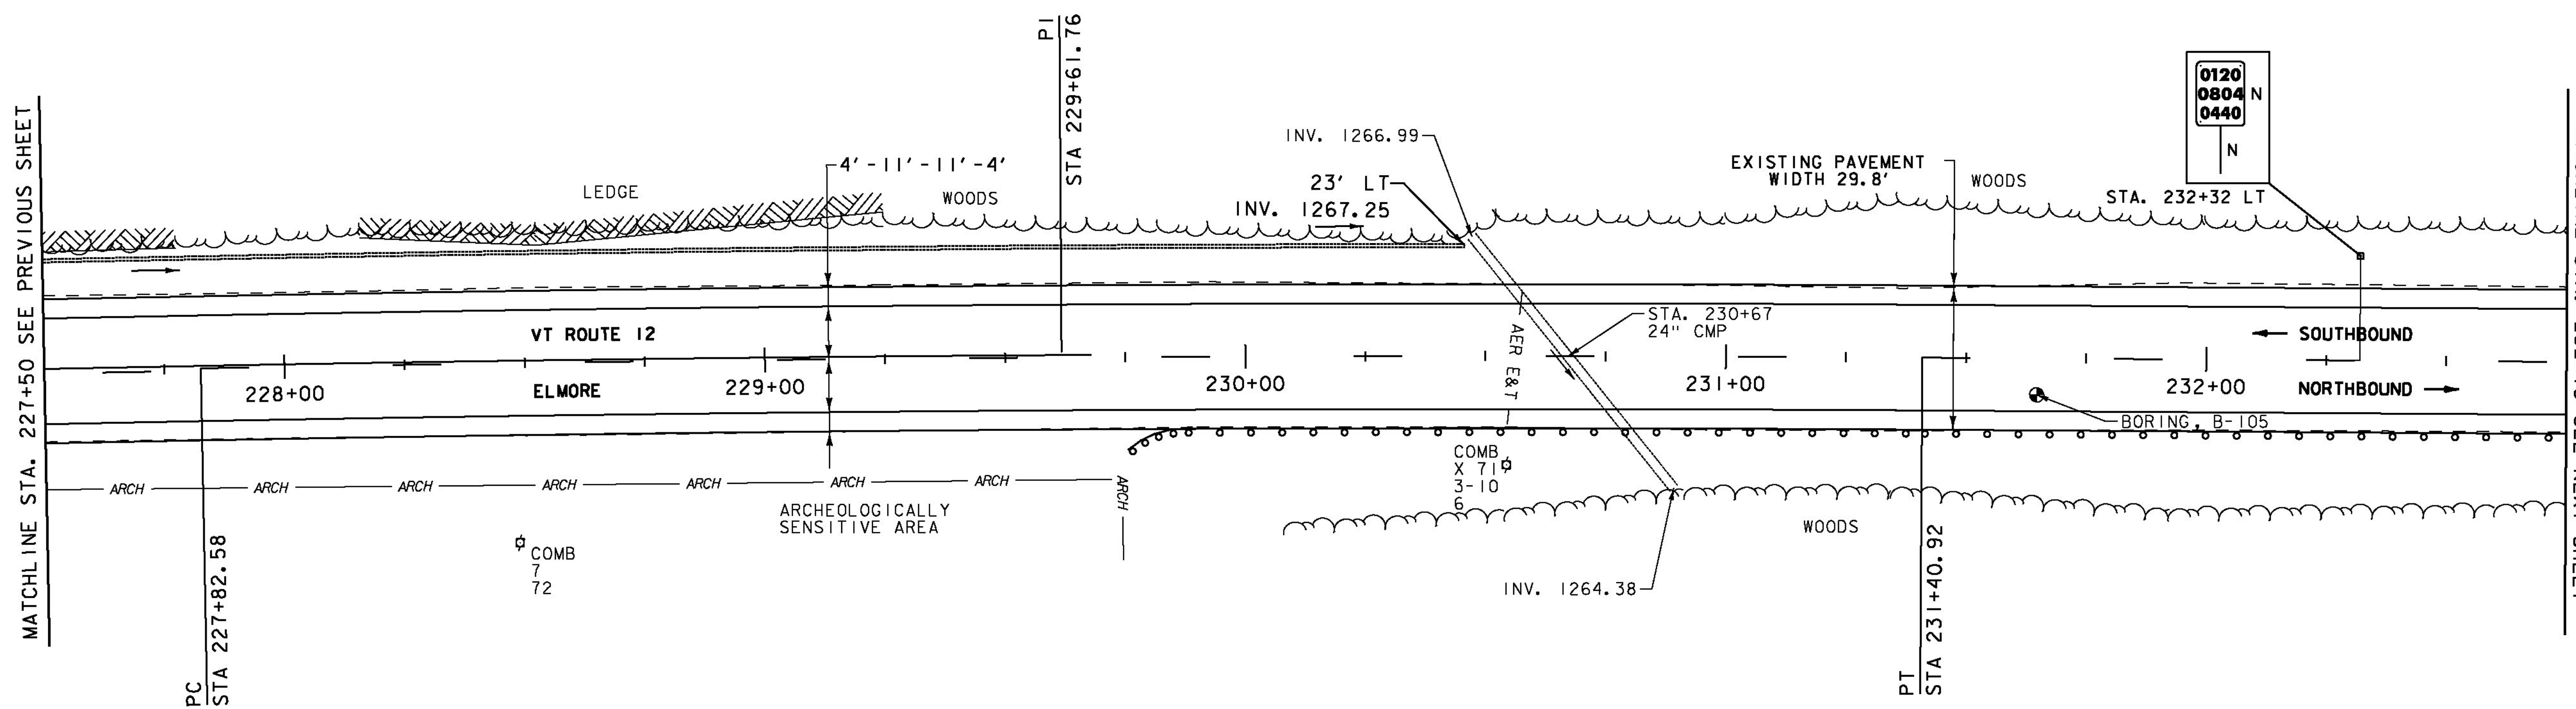

SIGN LEGEND
 R = REMOVE
 R&S = REMOVE AND SALVAGE
 RET = RETAIN
 S = SALVAGED
 N = NEW
 B-B = BACK TO BACK
 - - = EXISTING
 — = NEW



PROJECT LAYOUT SHEET 9

PROJECT NAME: ELMORE-MORRISTOWN	PLOT DATE: 3/3/14
PROJECT NUMBER: STP 2937 (1)	DRAWN BY: J. GOODALL
FILE NAME: z11c310.dgn	CHECKED BY: C. LATHROP
PROJECT LEADER: C. LATHROP	SHEET 32 OF 194
DESIGNED BY: S. LAMPHERE	
PLOT FILE: z11c310_32.i	