



DURABLE 4 INCH WHITE LINE, POLYUREA
 STA. 287+25 - STA. 292+50 (SOLID LT & RT)

TEMPORARY 4 INCH WHITE LINE, PAINT
 STA. 287+25 - STA. 292+50 (SOLID LT & RT)

DURABLE 4 INCH YELLOW LINE, POLYUREA
 STA. 287+25 - STA. 289+59 (SOLID LT, DASHED RT)
 STA. 289+59 - STA. 291+98 (DASHED CL)
 STA. 291+98 - STA. 292+50 (DASHED LT, SOLID RT)

TEMPORARY 4 INCH YELLOW LINE, PAINT
 STA. 287+25 - STA. 289+59 (SOLID LT, DASHED RT)
 STA. 289+59 - STA. 291+98 (DASHED CL)
 STA. 291+98 - STA. 292+50 (DASHED LT, SOLID RT)

6 INCH UNDERDRAIN PIPE
 STA. 287+25 - STA. 289+60 RT
 STA. 292+00 - STA. 292+50 RT

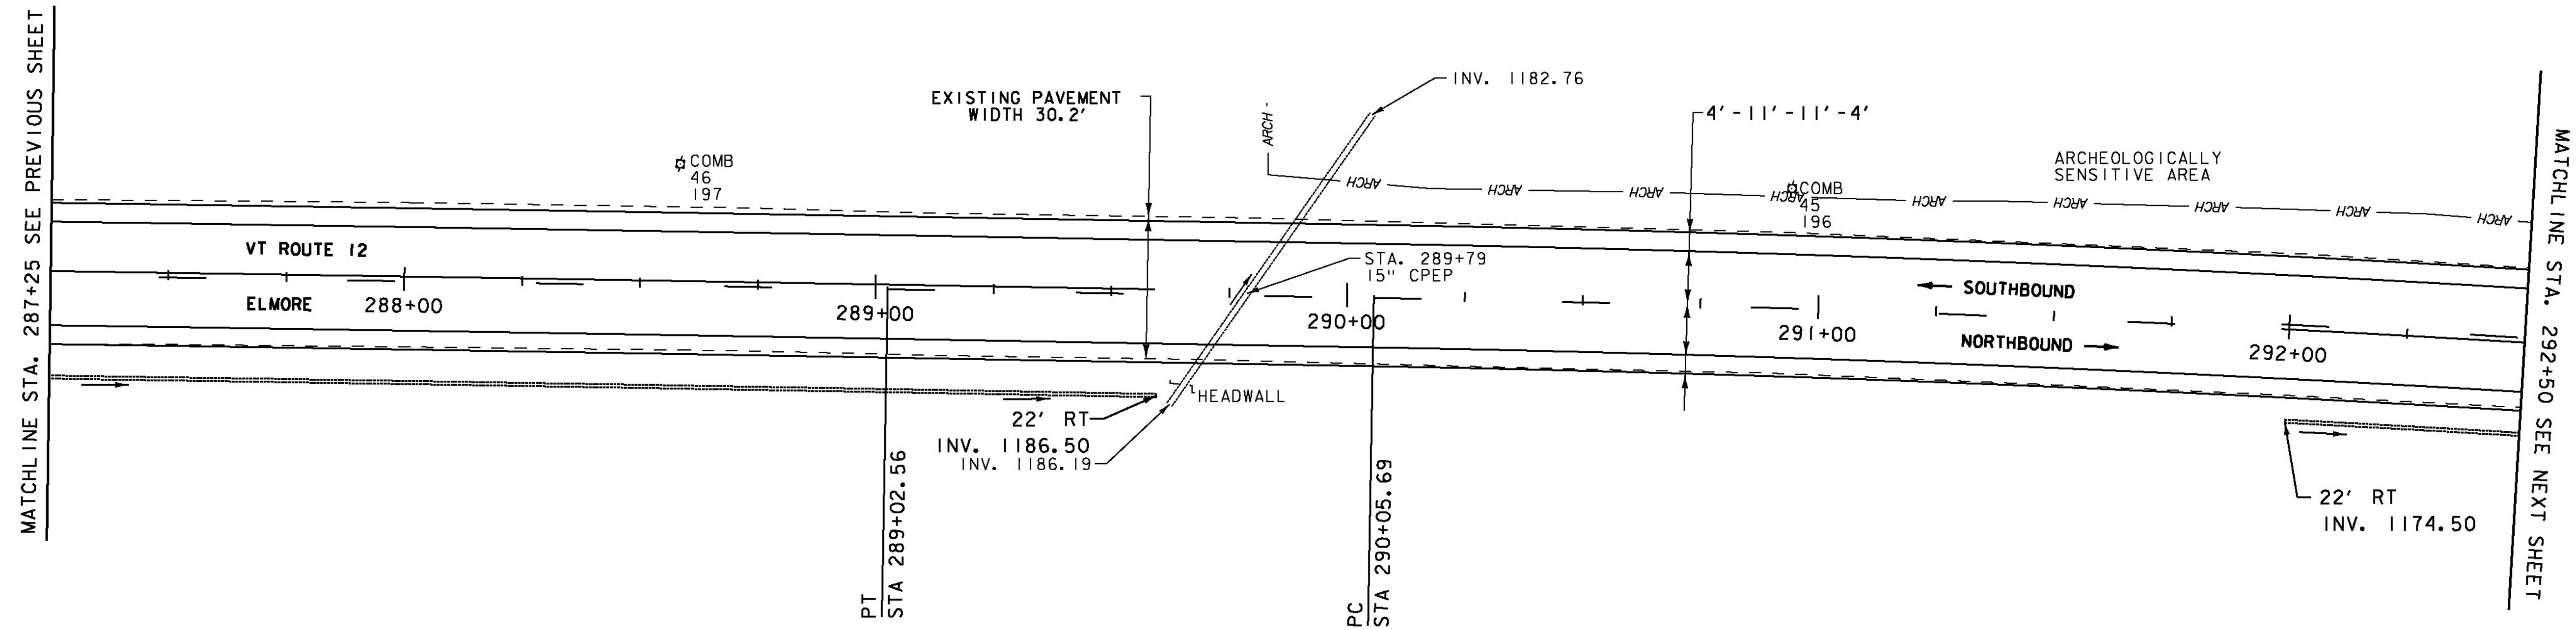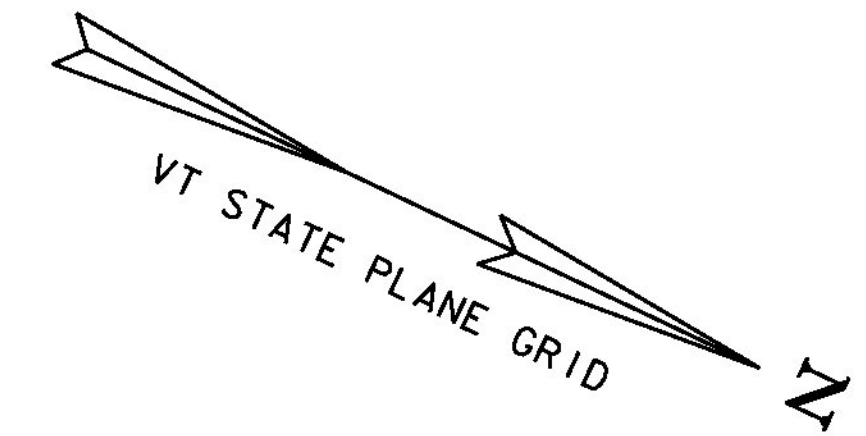

SIGN LEGEND
 R = REMOVE
 R&S = REMOVE AND SALVAGE
 RET = RETAIN
 S = SALVAGED
 N = NEW
 B-B = BACK TO BACK
 - - = EXISTING
 — = NEW



PROJECT LAYOUT SHEET 20

PROJECT NAME: ELMORE-MORRISTOWN	PROJECT NUMBER: STP 2937 (1)
FILE NAME: z11c310.dgn	PLOT DATE: 3/3/14
PROJECT LEADER: C. LATHROP	DRAWN BY: J. GOODALL
DESIGNED BY: S. LAMPHERE	CHECKED BY: C. LATHROP
PLOT FILE: z11c310_43.i	SHEET 43 OF 194