
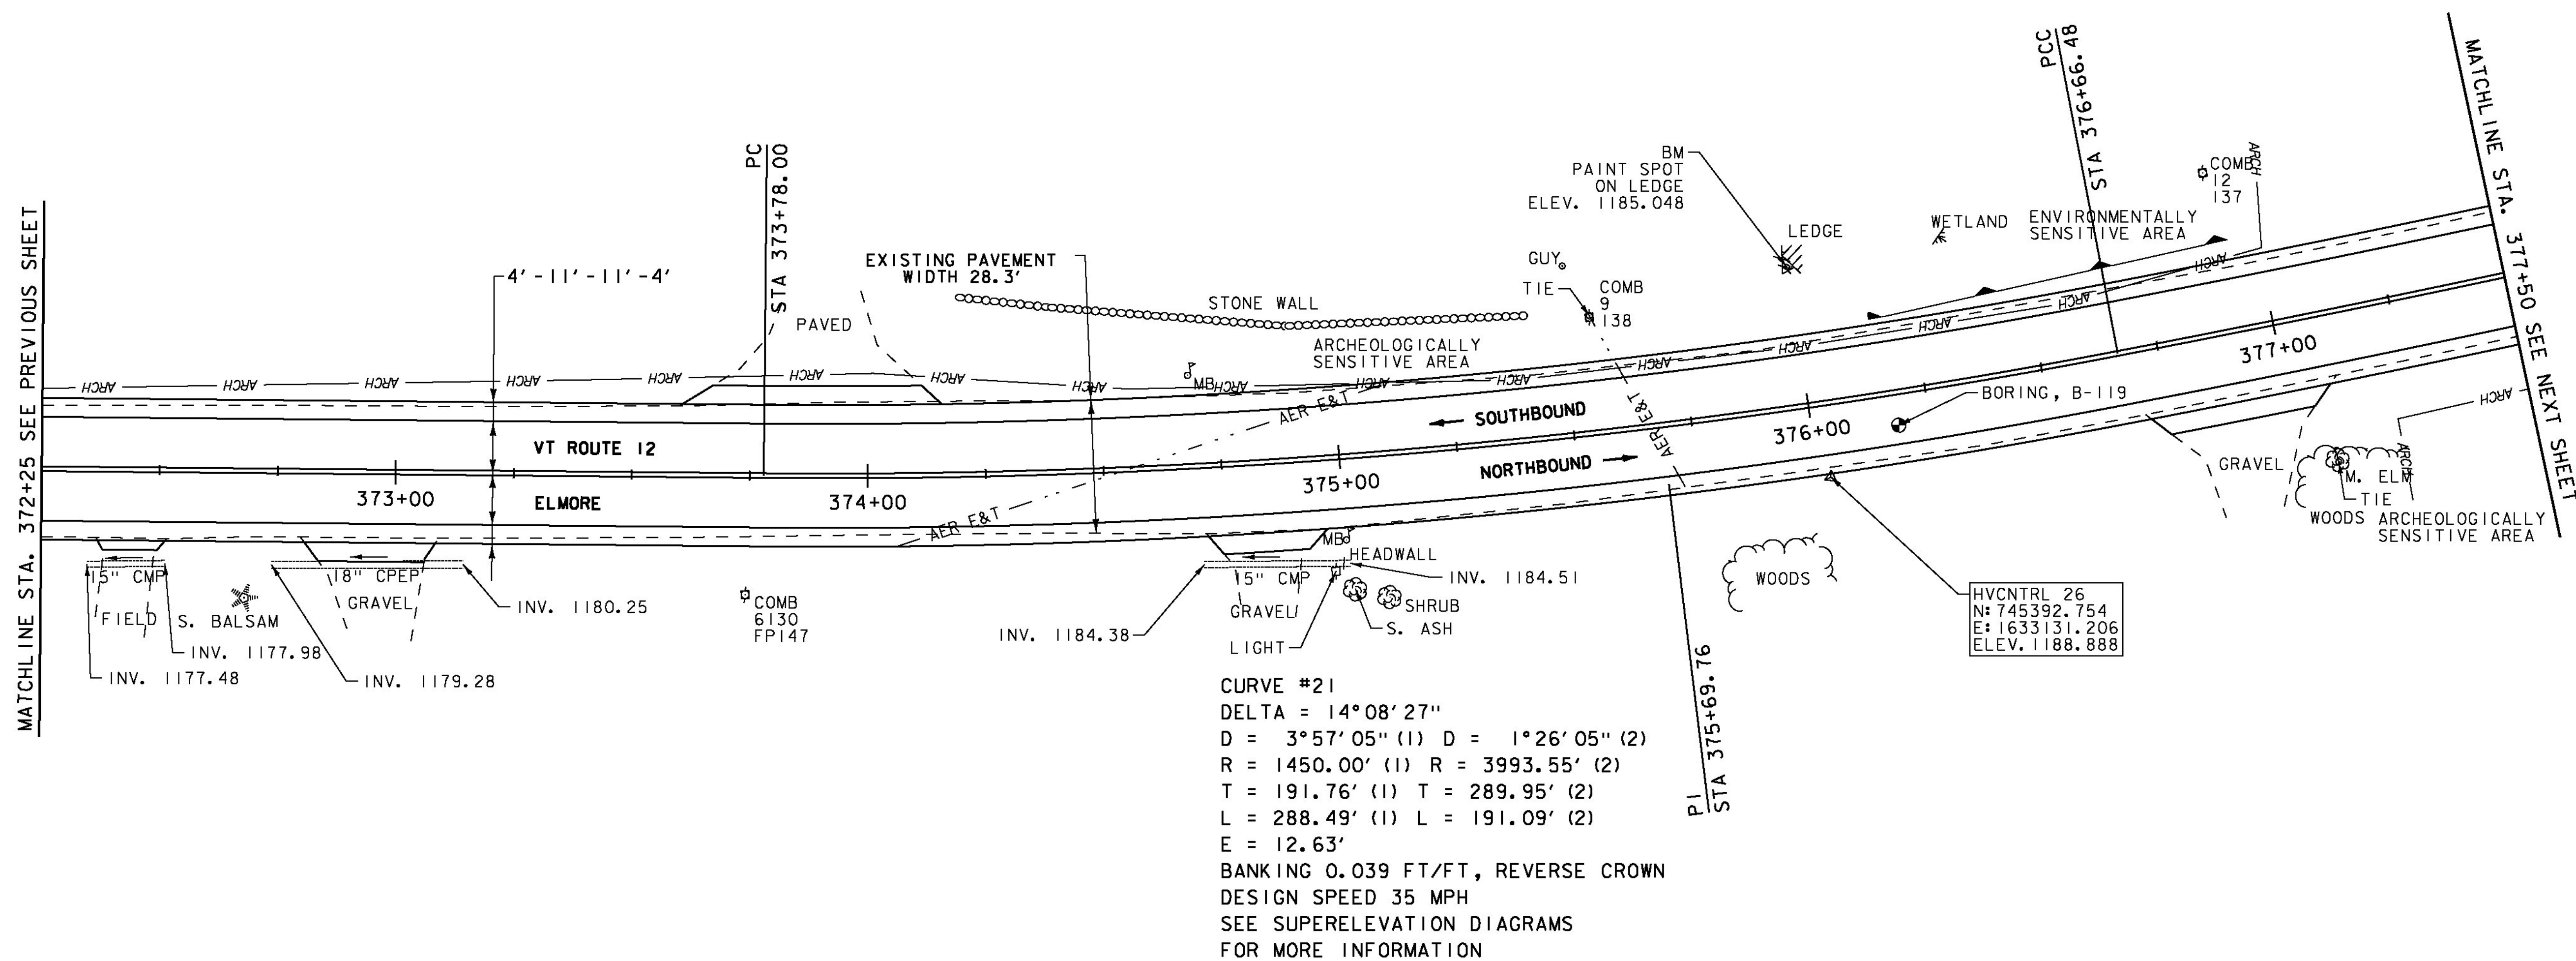


DURABLE 4 INCH WHITE LINE, POLYUREA  
 STA. 372+25 - STA. 377+50 (SOLID LT & RT)

TEMPORARY 4 INCH WHITE LINE, PAINT  
 STA. 372+25 - STA. 377+50 (SOLID LT & RT)

DURABLE 4 INCH YELLOW LINE, POLYUREA  
 STA. 372+25 - STA. 377+50 (SOLID LT & RT)

TEMPORARY 4 INCH YELLOW LINE, PAINT  
 STA. 372+25 - STA. 377+50 (SOLID LT & RT)

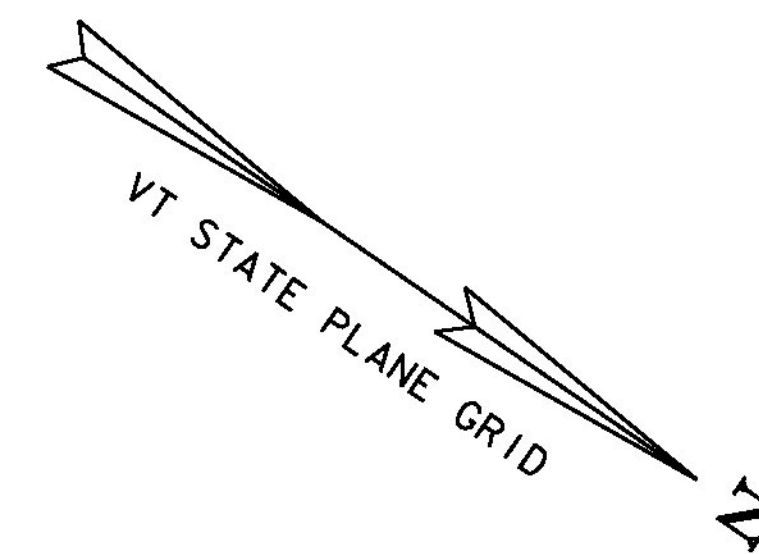

MATCHLINE STA. 372+25 SEE PREVIOUS SHEET

MATCHLINE STA. 377+50 SEE NEXT SHEET

**SIGN LEGEND**

- R = REMOVE
- R&S = REMOVE AND SALVAGE
- RET = RETAIN
- S = SALVAGED
- N = NEW
- B-B = BACK TO BACK
- - = EXISTING
- = NEW



**PROJECT LAYOUT SHEET 36**

PROJECT NAME: ELMORE-MORRISTOWN

PROJECT NUMBER: STP 2937 (1)

FILE NAME: z11c310.dgn  
 PROJECT LEADER: C. LATHROP  
 DESIGNED BY: S. LAMPHERE  
 PLOT FILE: z11c310\_59.i

PLOT DATE: 3/3/14  
 DRAWN BY: J. GOODALL  
 CHECKED BY: C. LATHROP  
 SHEET 59 OF 194