




188+50

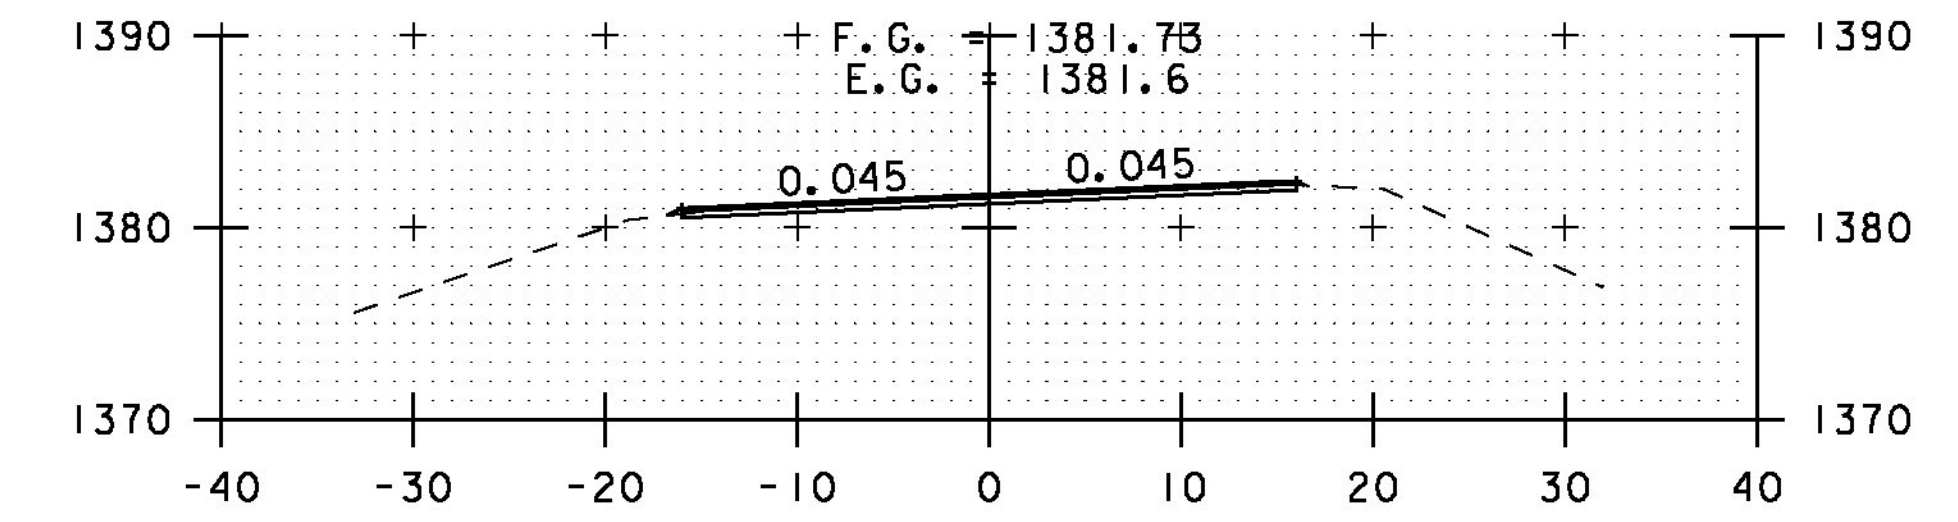


190+50

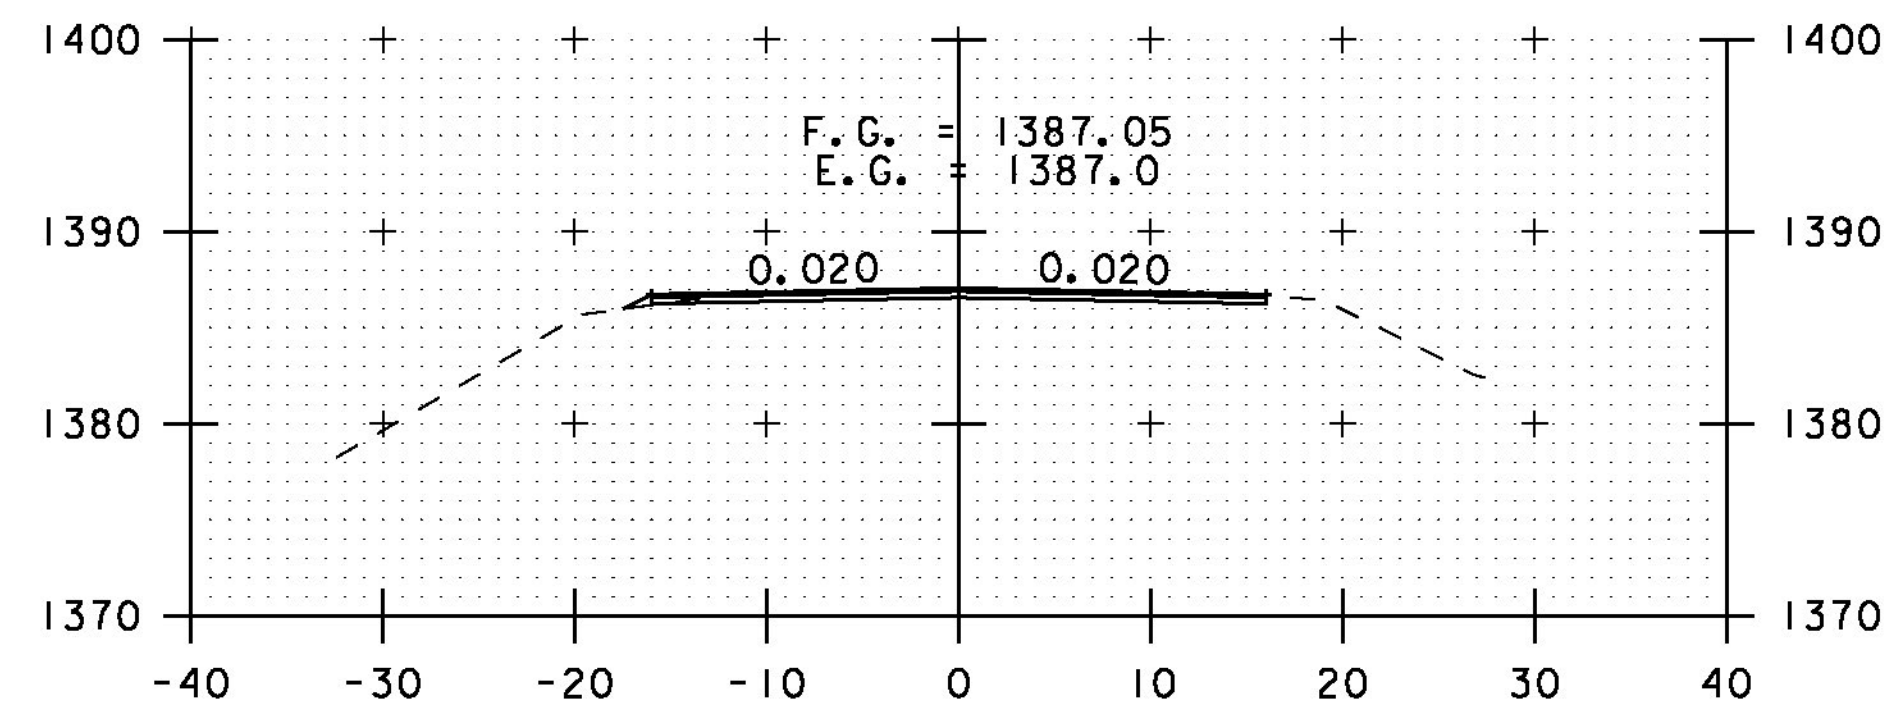


186+50

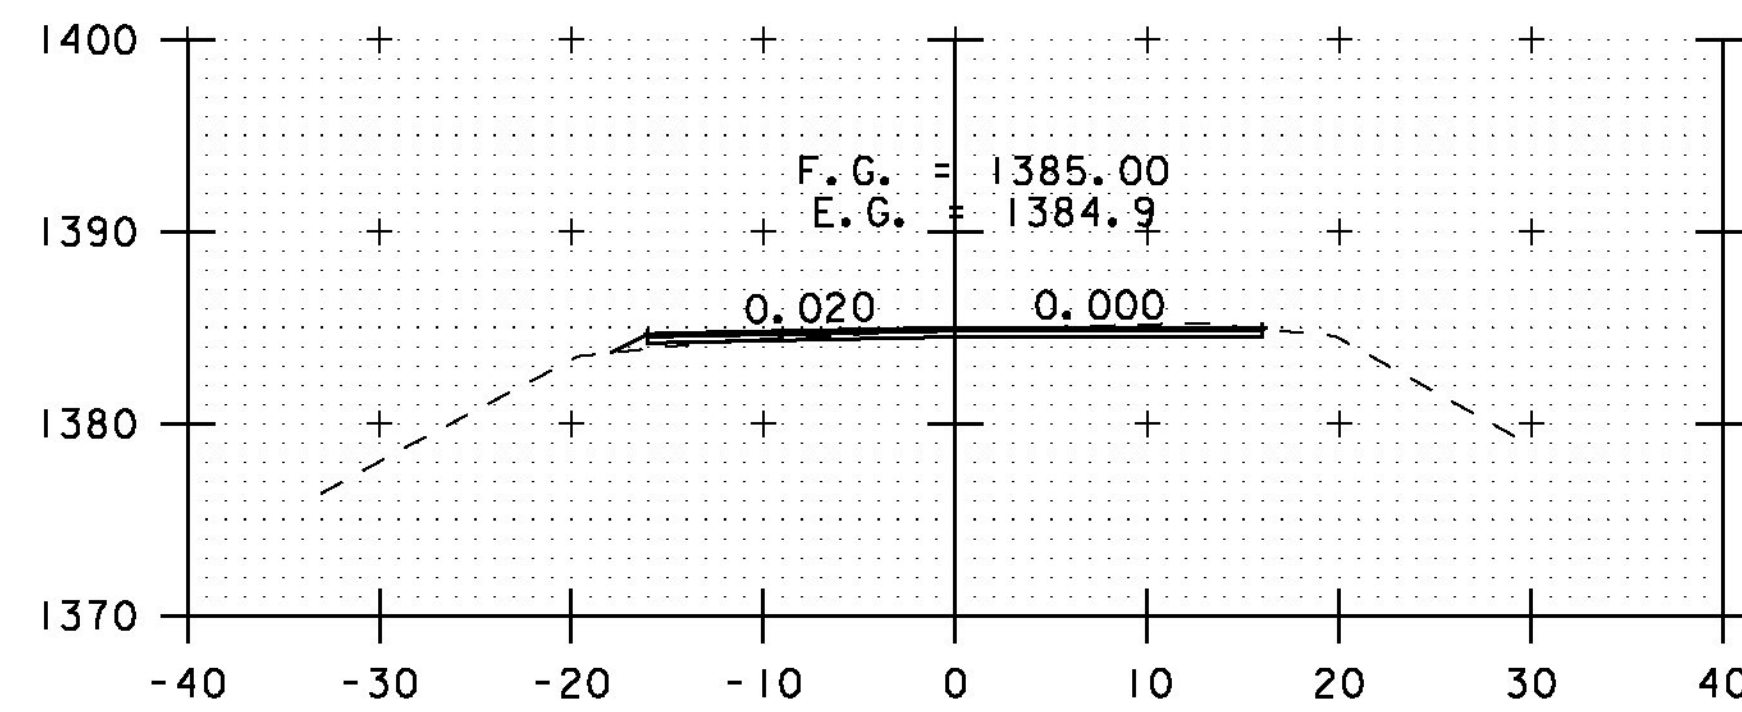


188+00

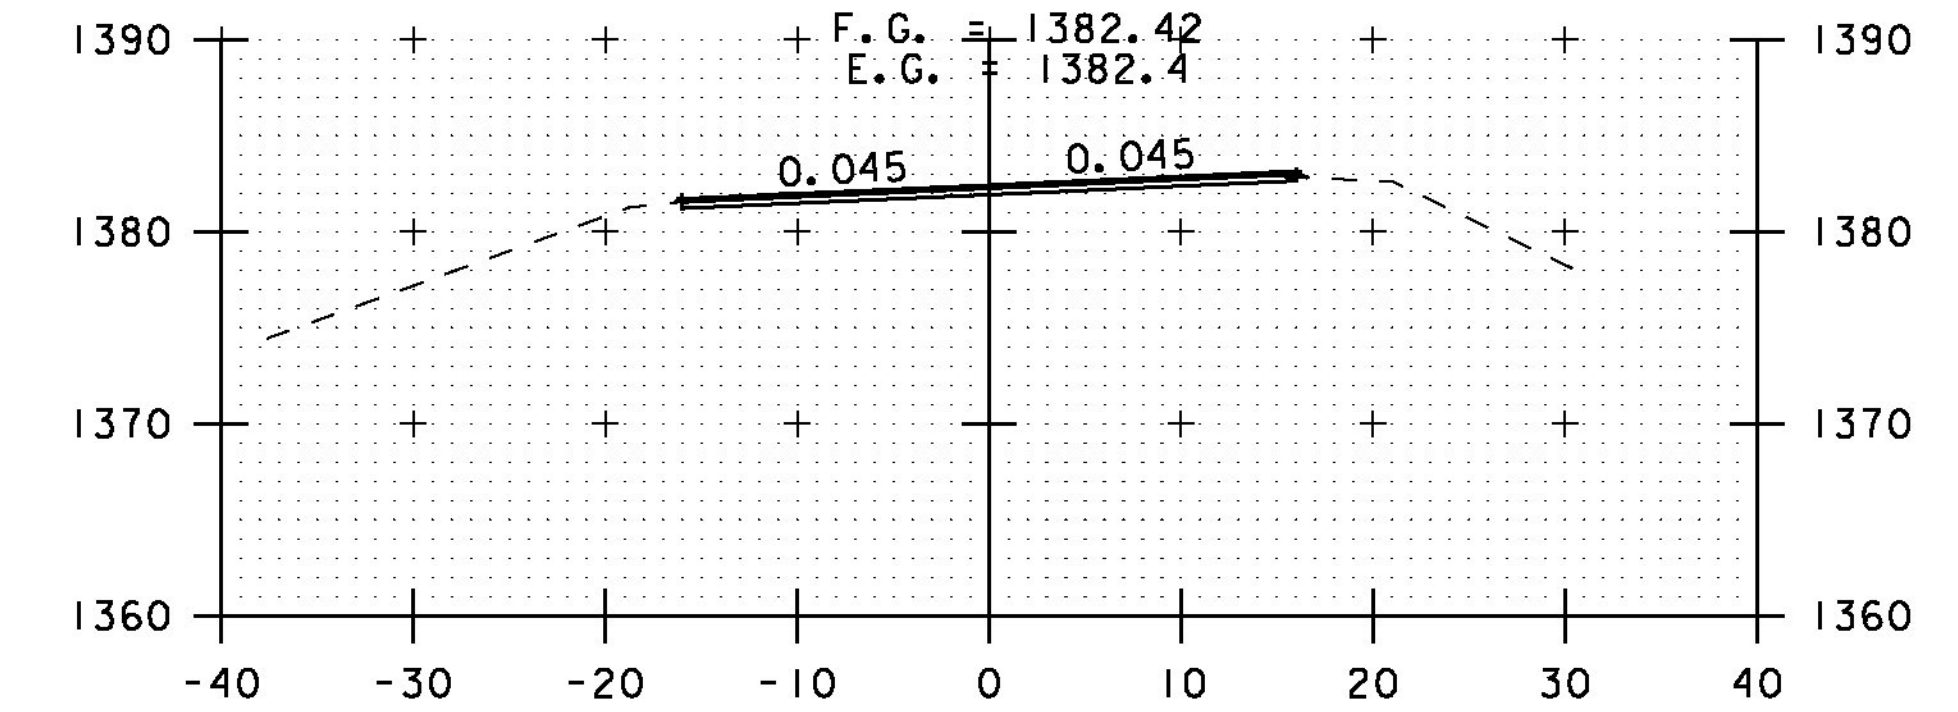


190+00

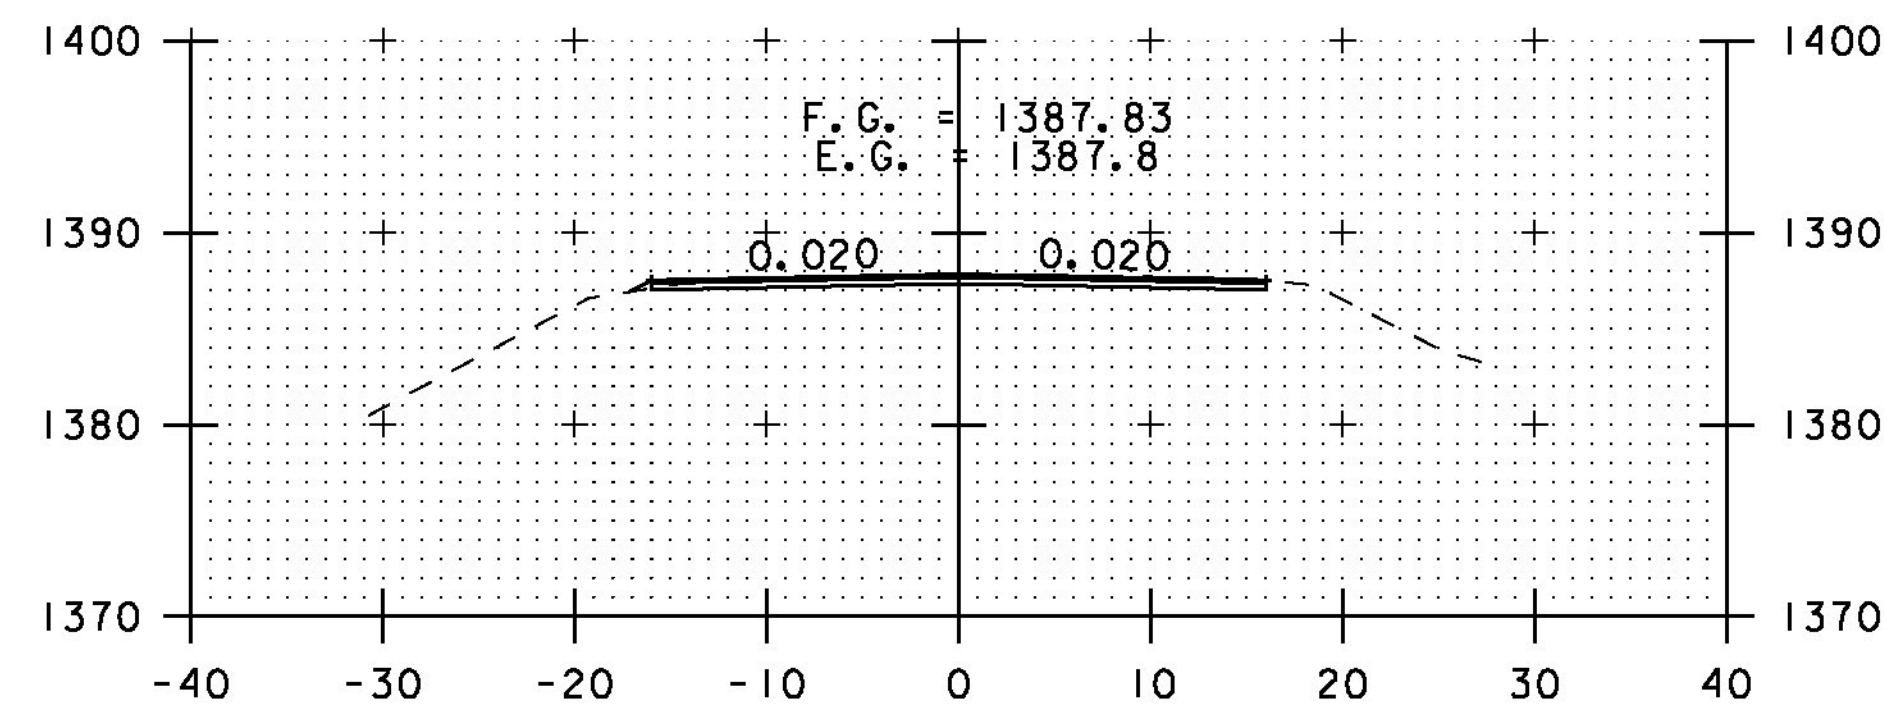


186+00

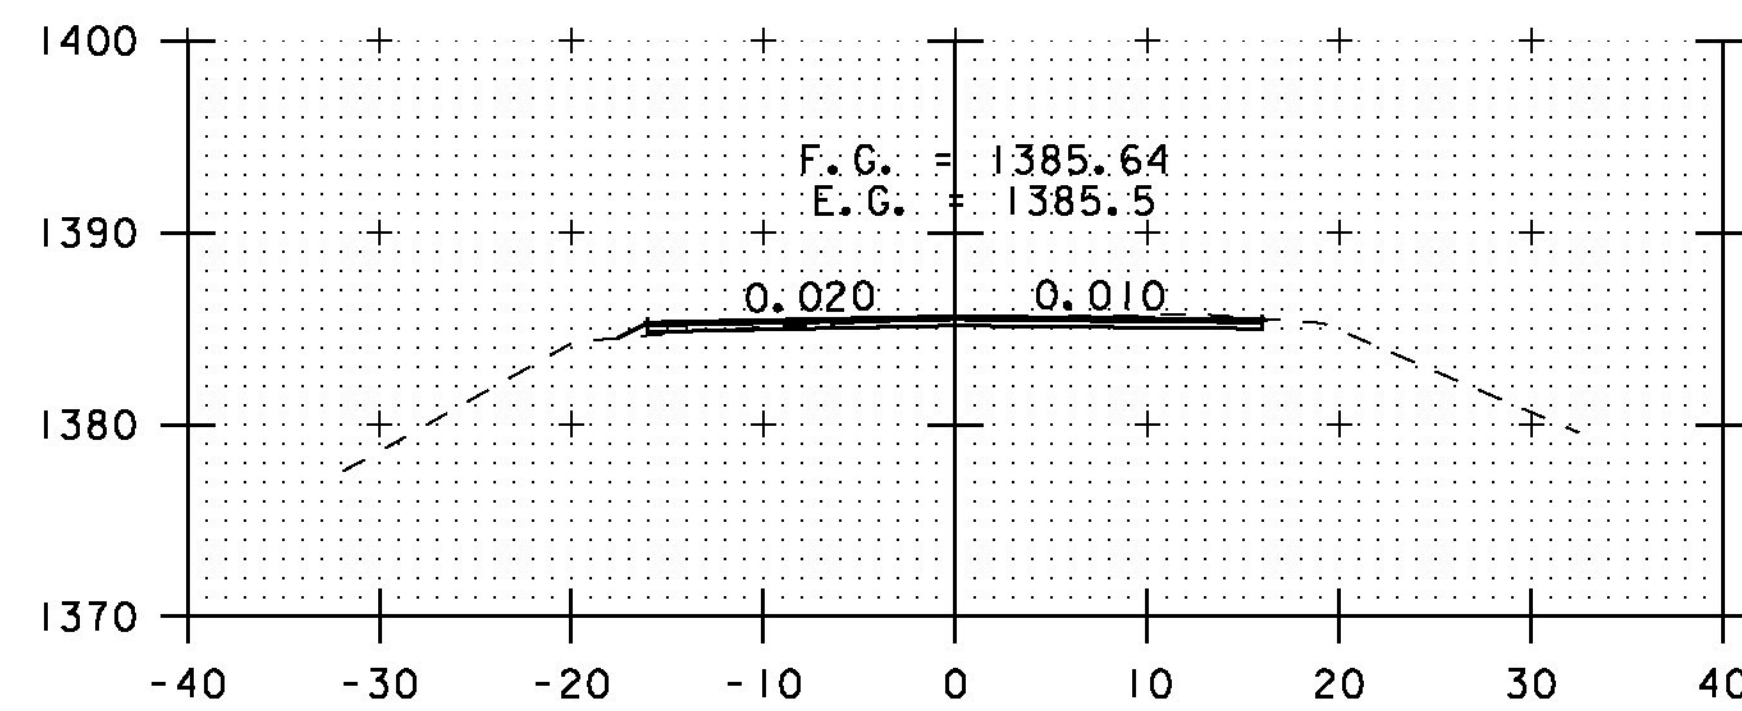


187+50

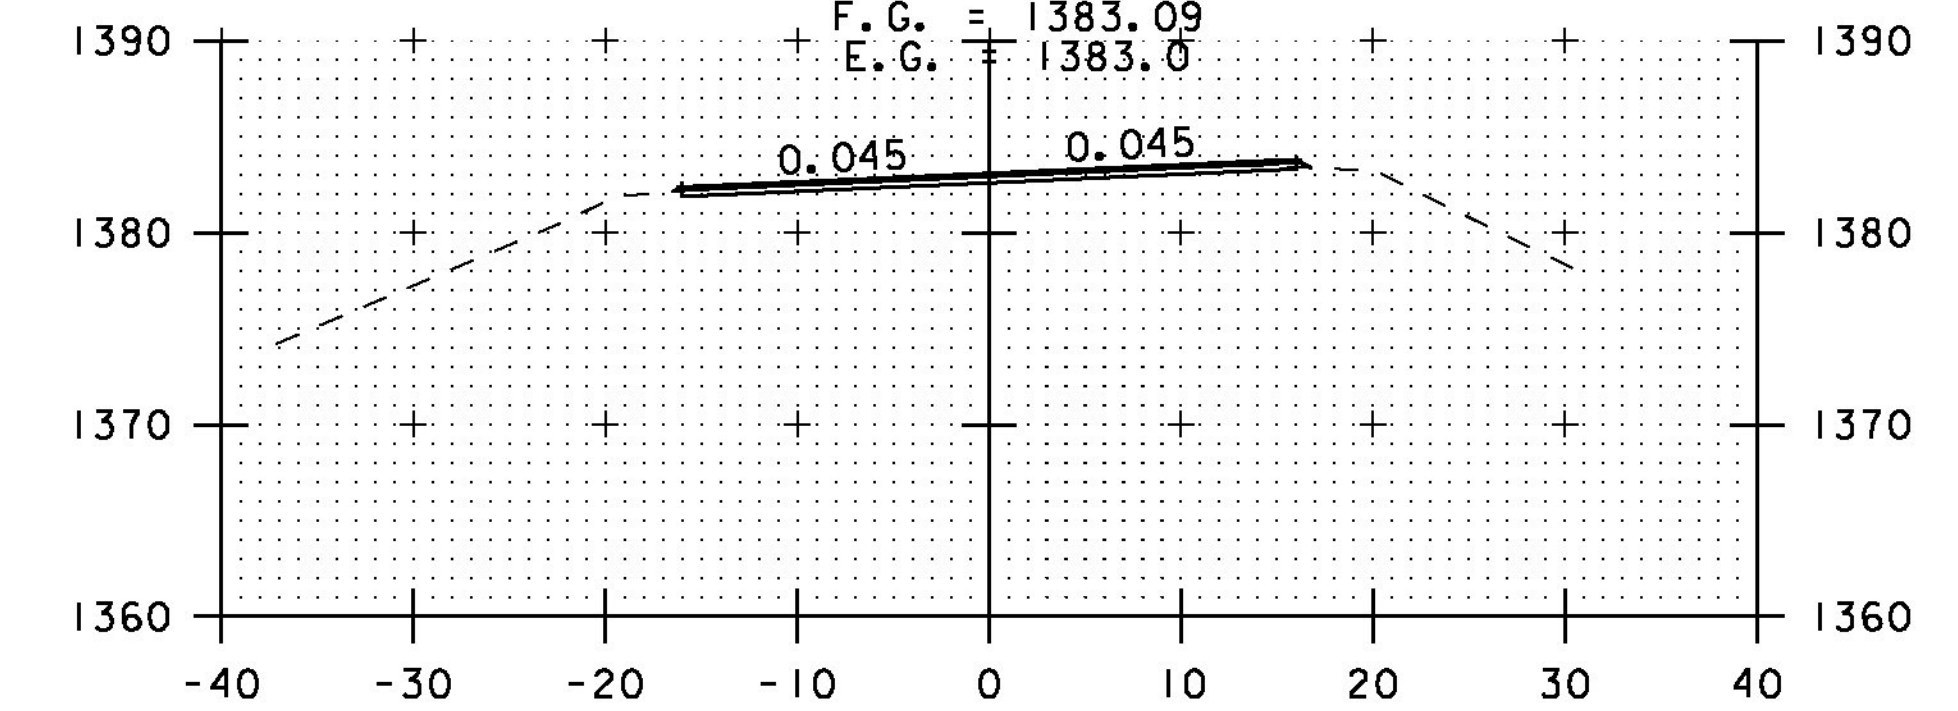


189+50

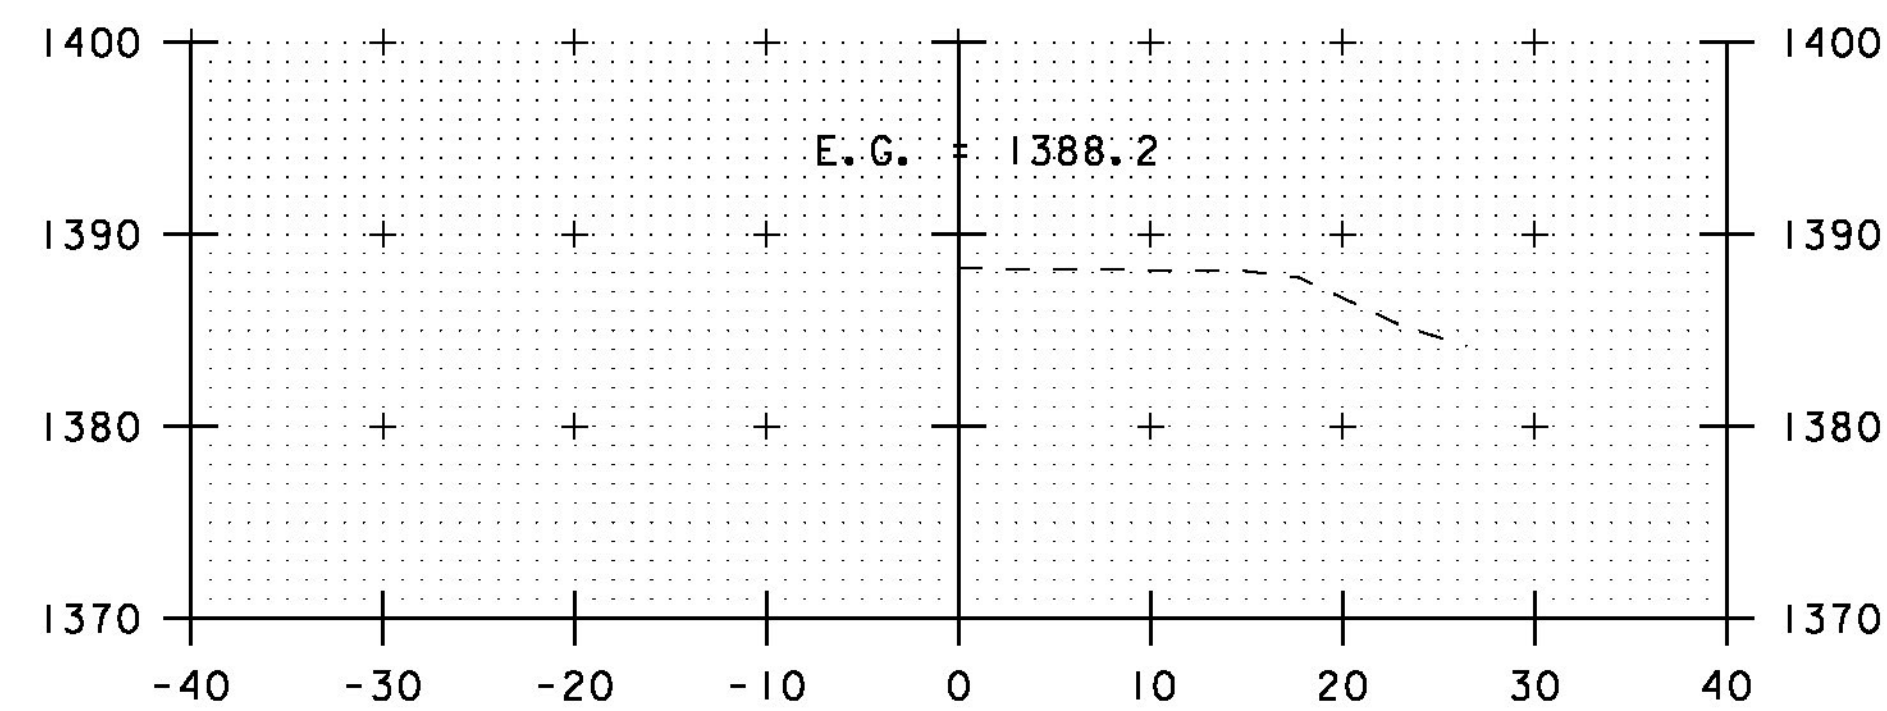

185+75

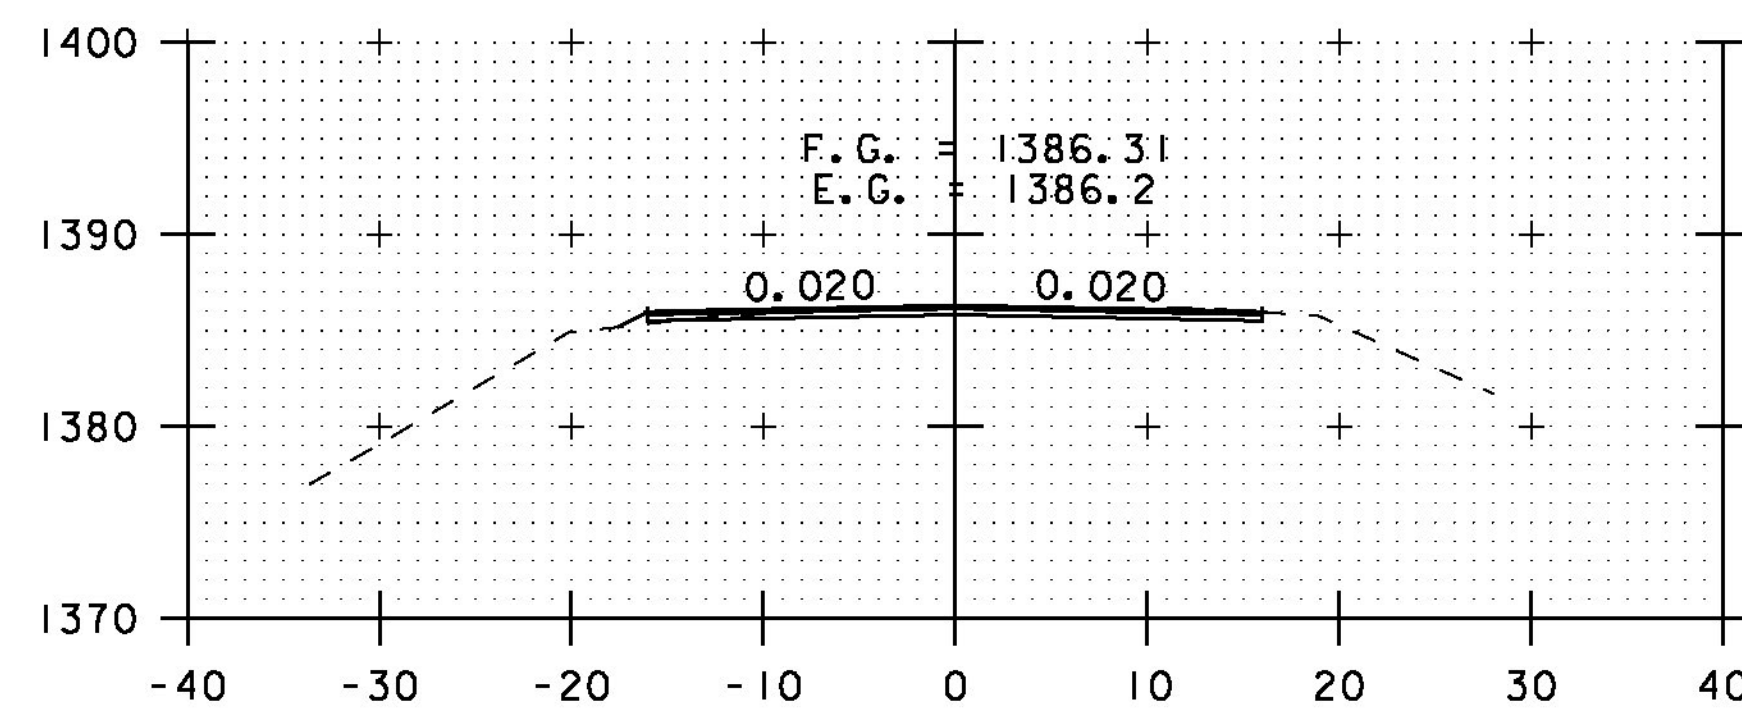

187+00

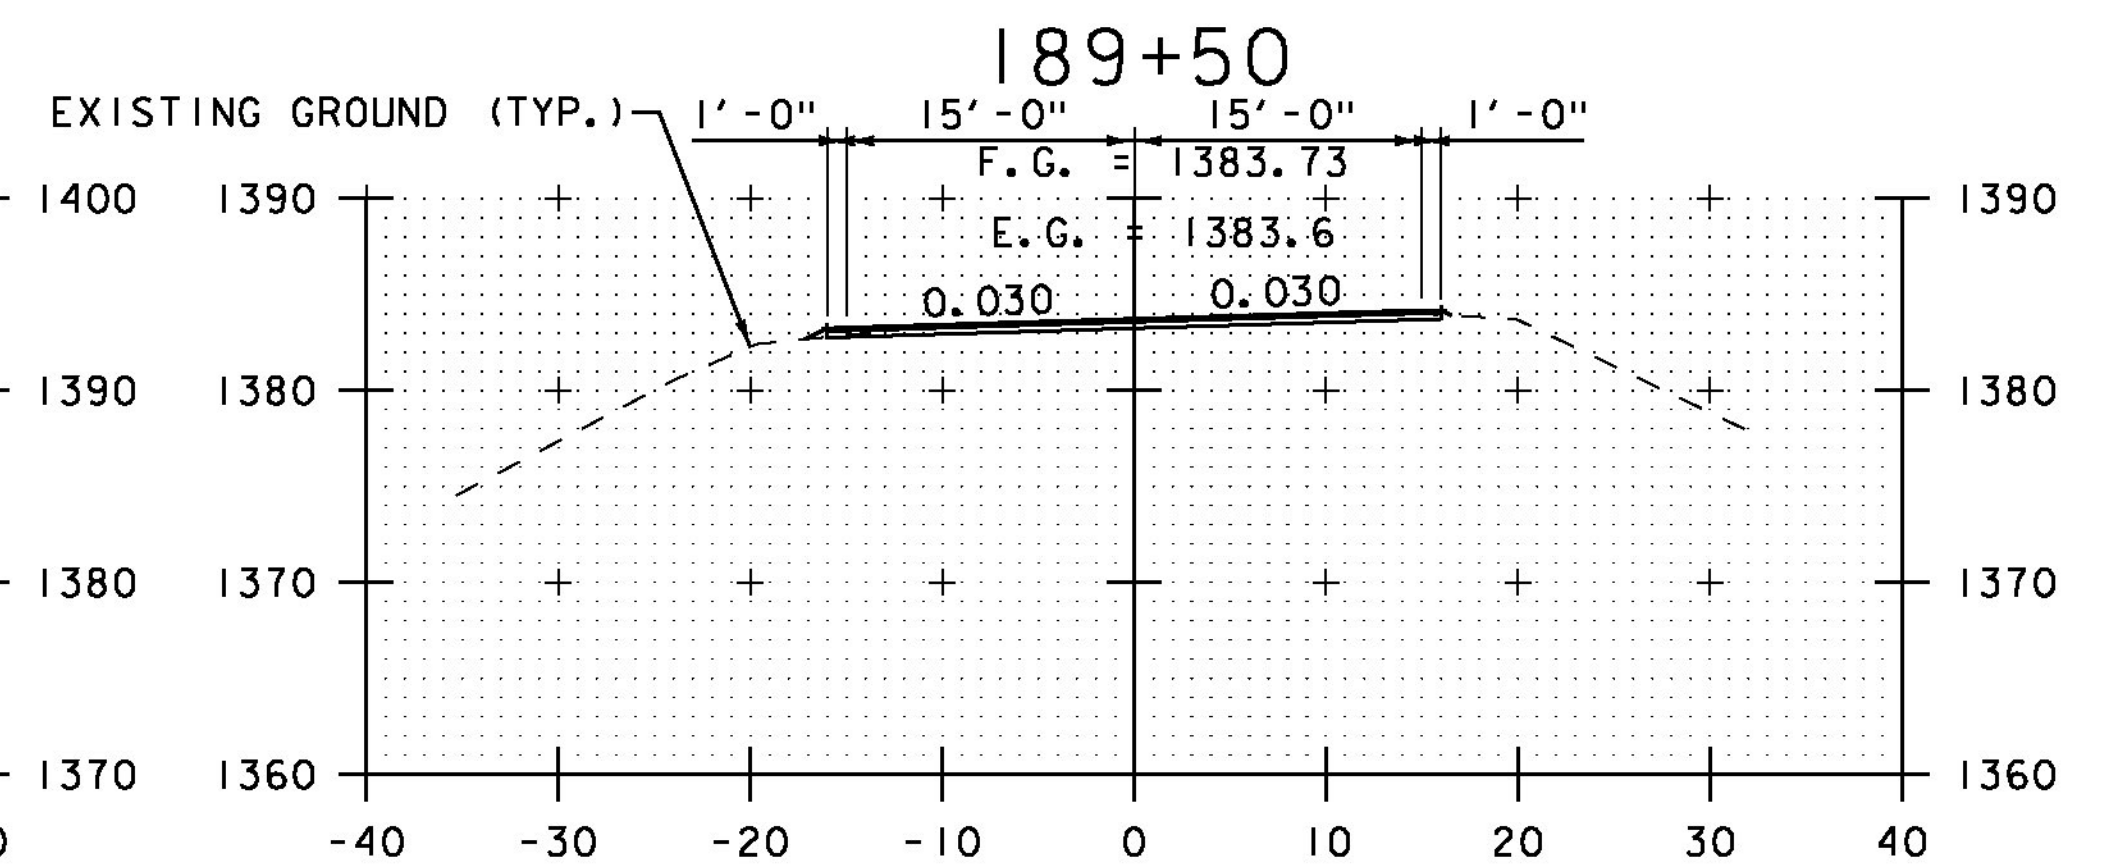

189+00

STA. 185+75 TO STA. 190+50



CROSS SECTION SHEET 1

PROJECT NAME: ELMORE-MORRISTOWN

PROJECT NUMBER: STP 2937 (1)

FILE NAME: z11c310.dgn

PROJECT LEADER: C. LATHROP

DESIGNED BY: S. LAMPHERE

PLOT FILE: z11c310_129.i

PLOT DATE: 3/3/14

DRAWN BY: B. MARTIN

CHECKED BY: C. LATHROP

SHEET 129 OF 194