




198+00

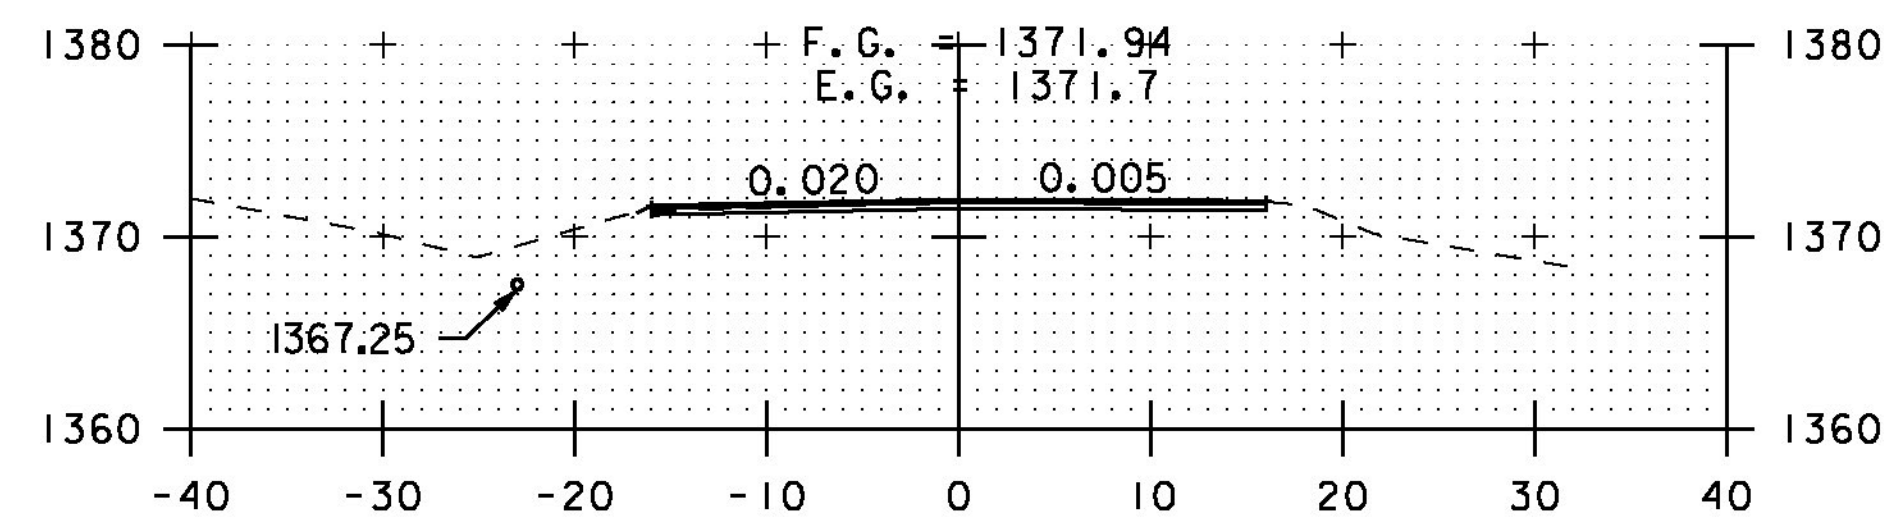


197+50

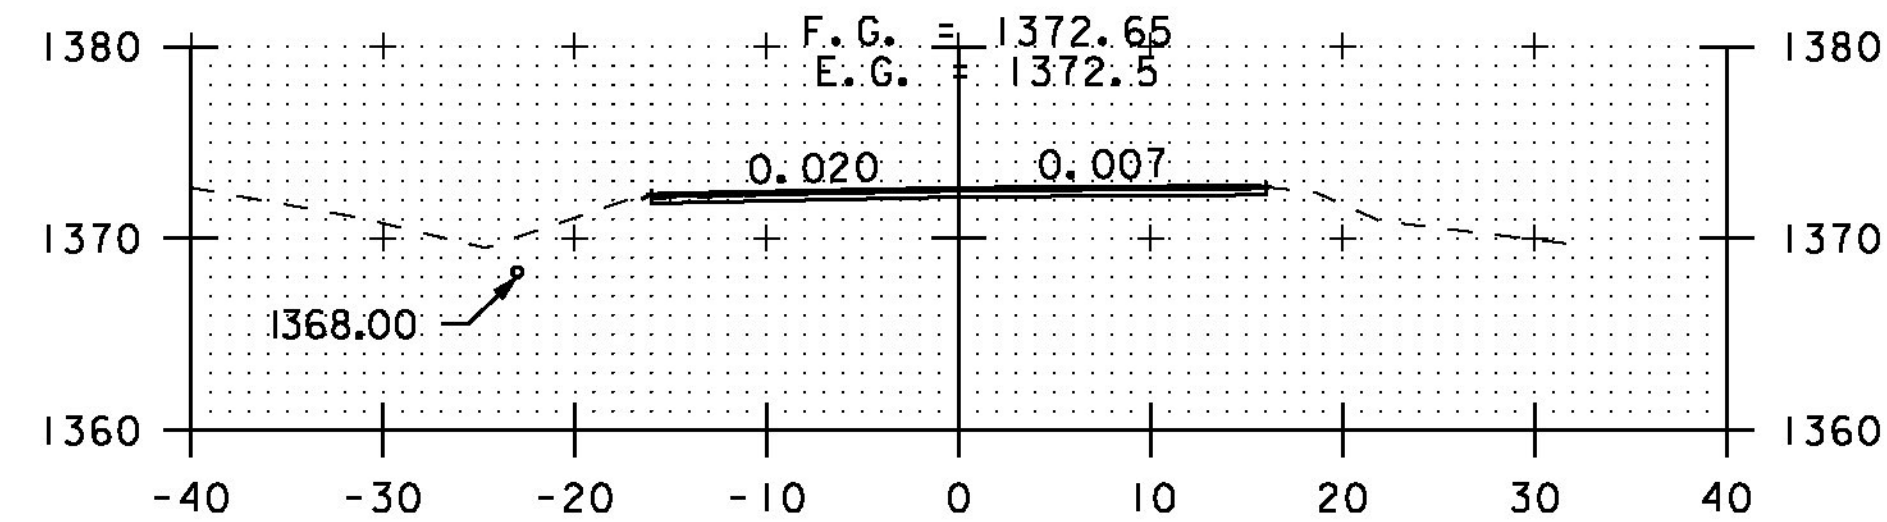


197+00

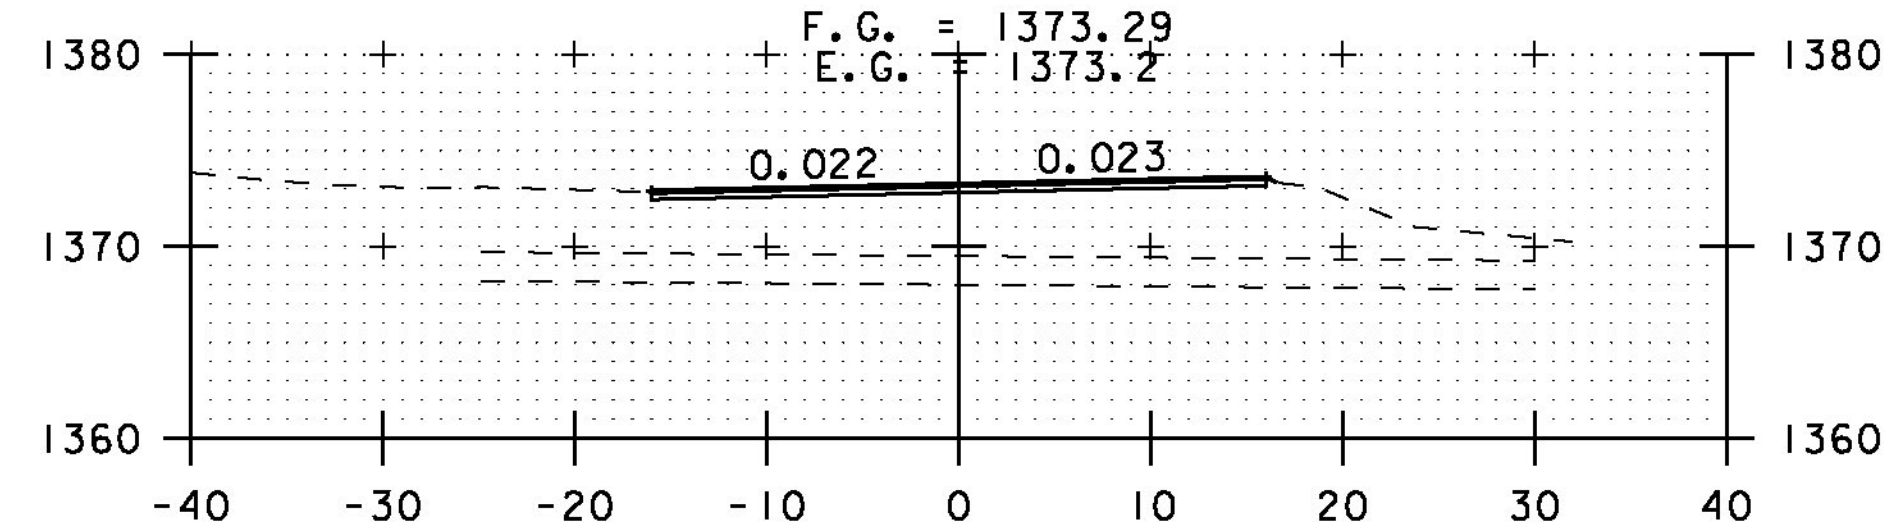


196+50

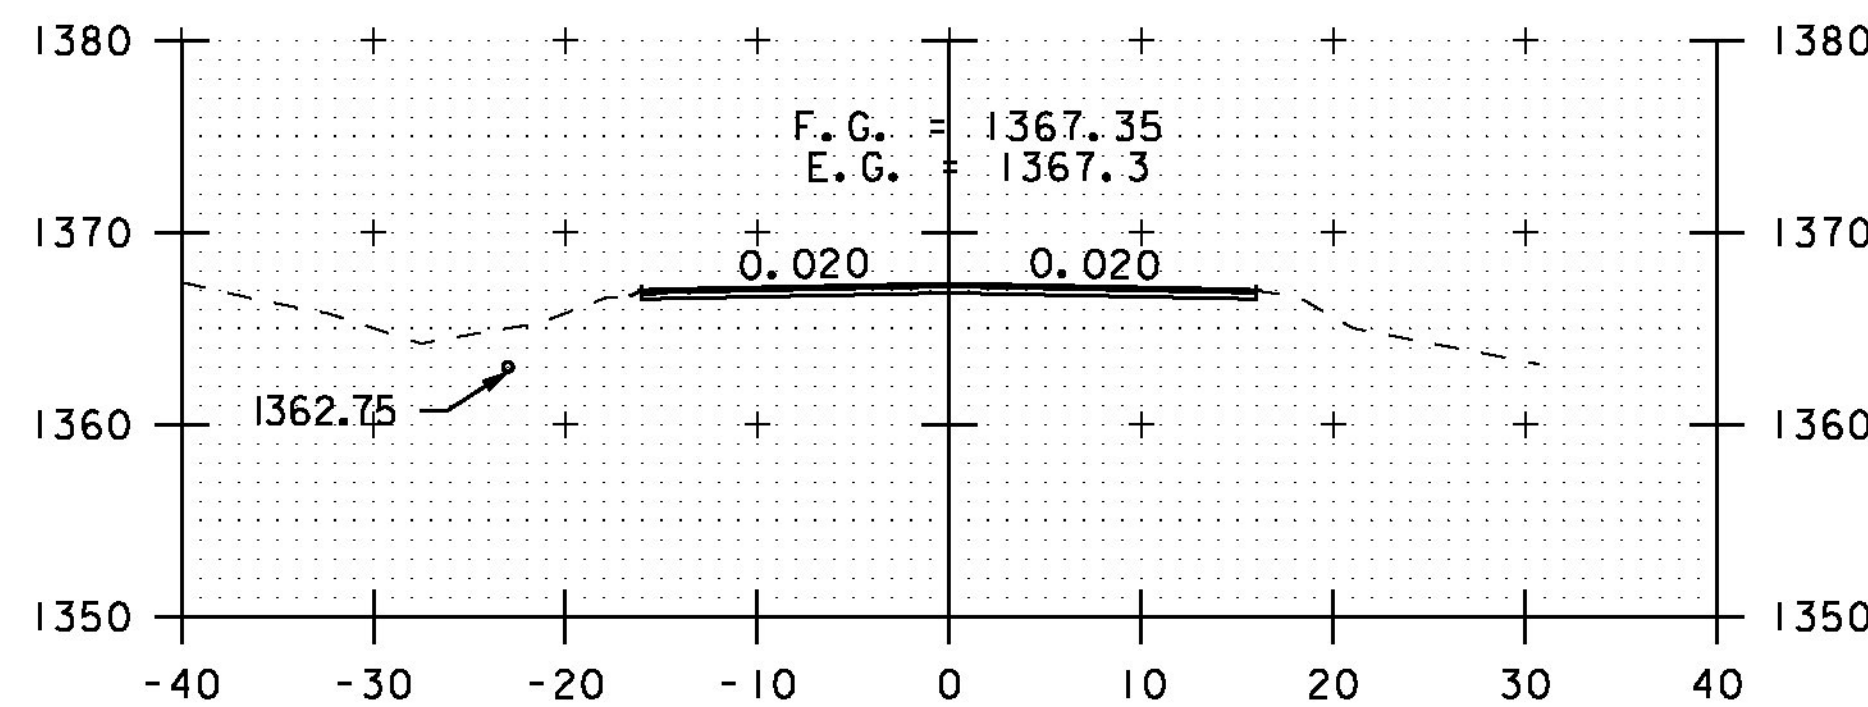


200+00

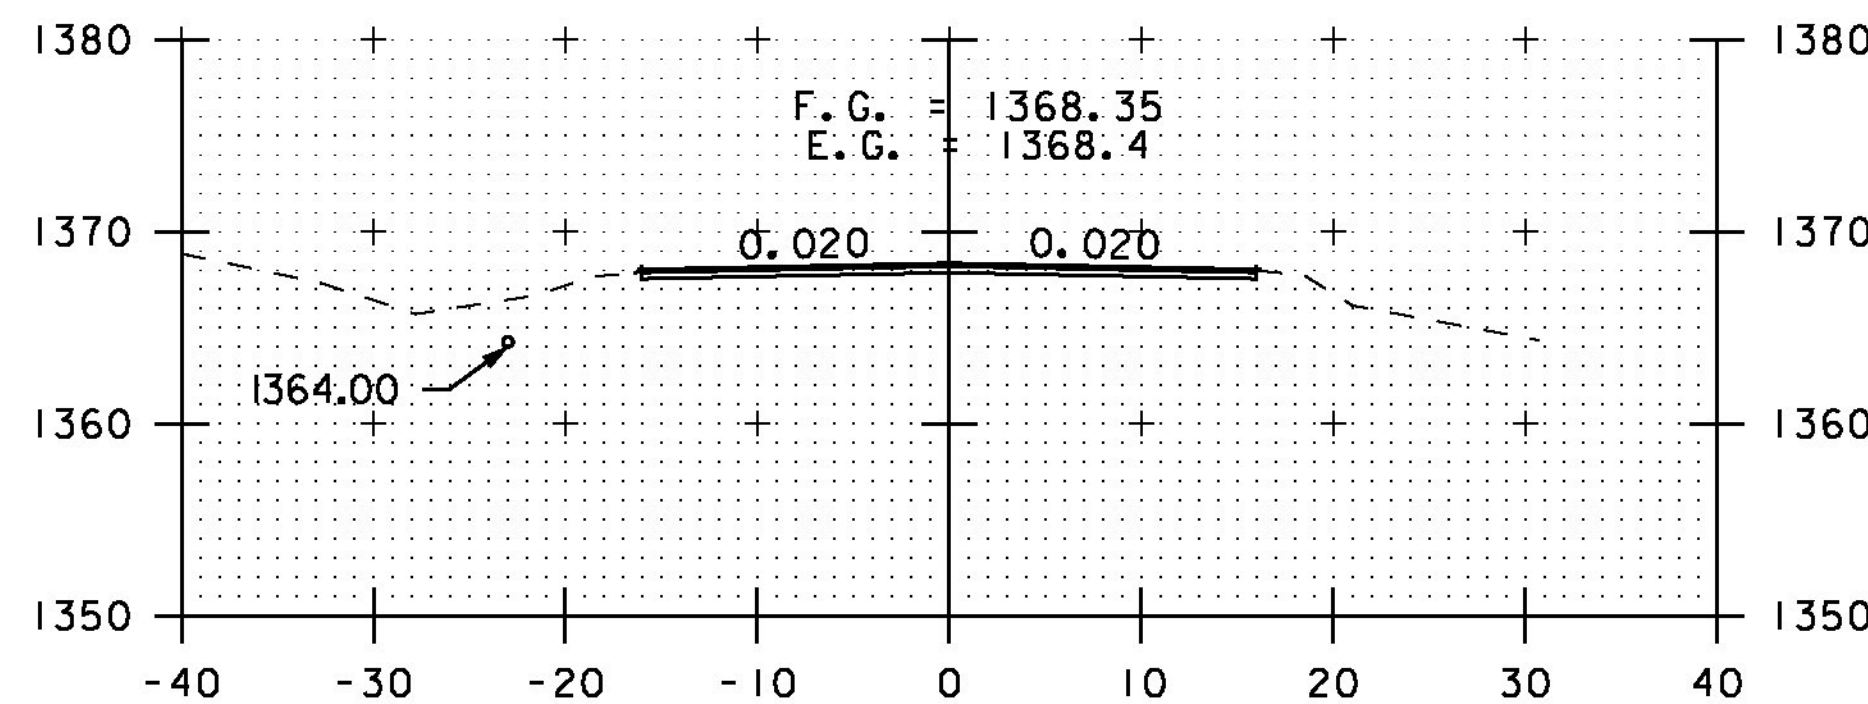


199+50

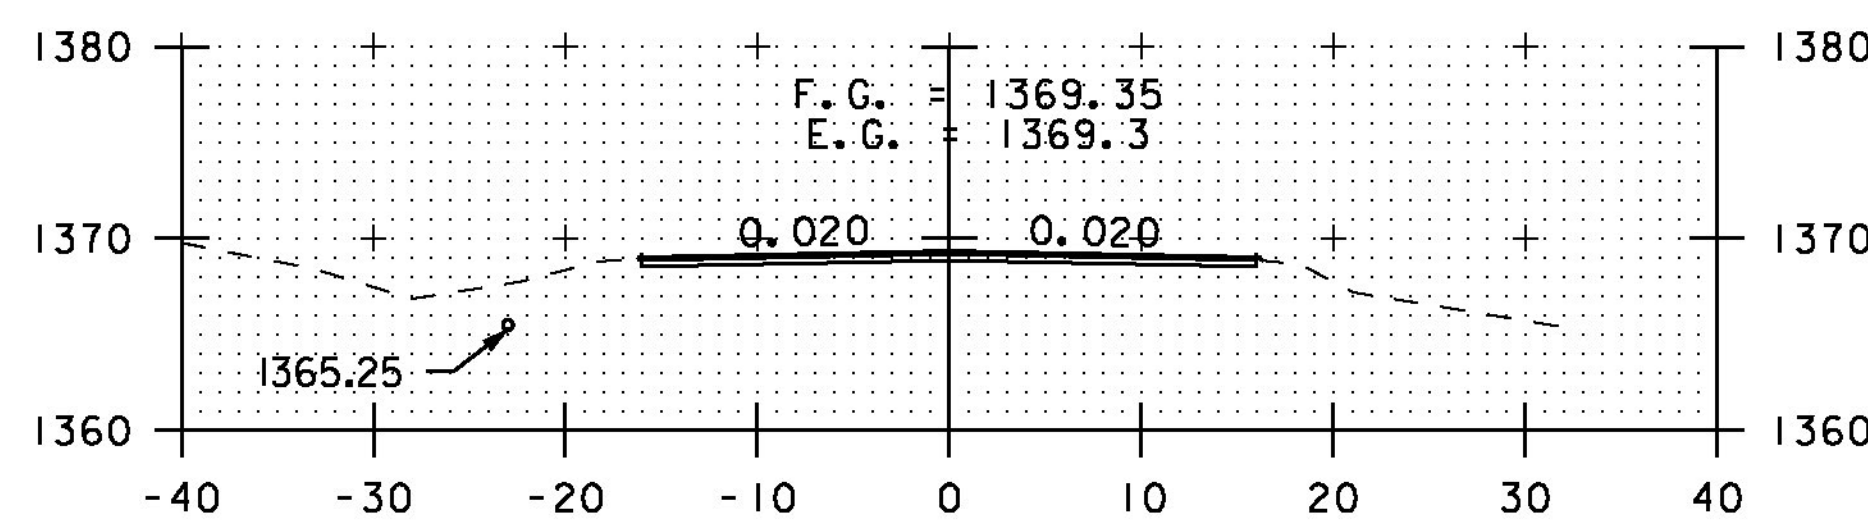

199+00

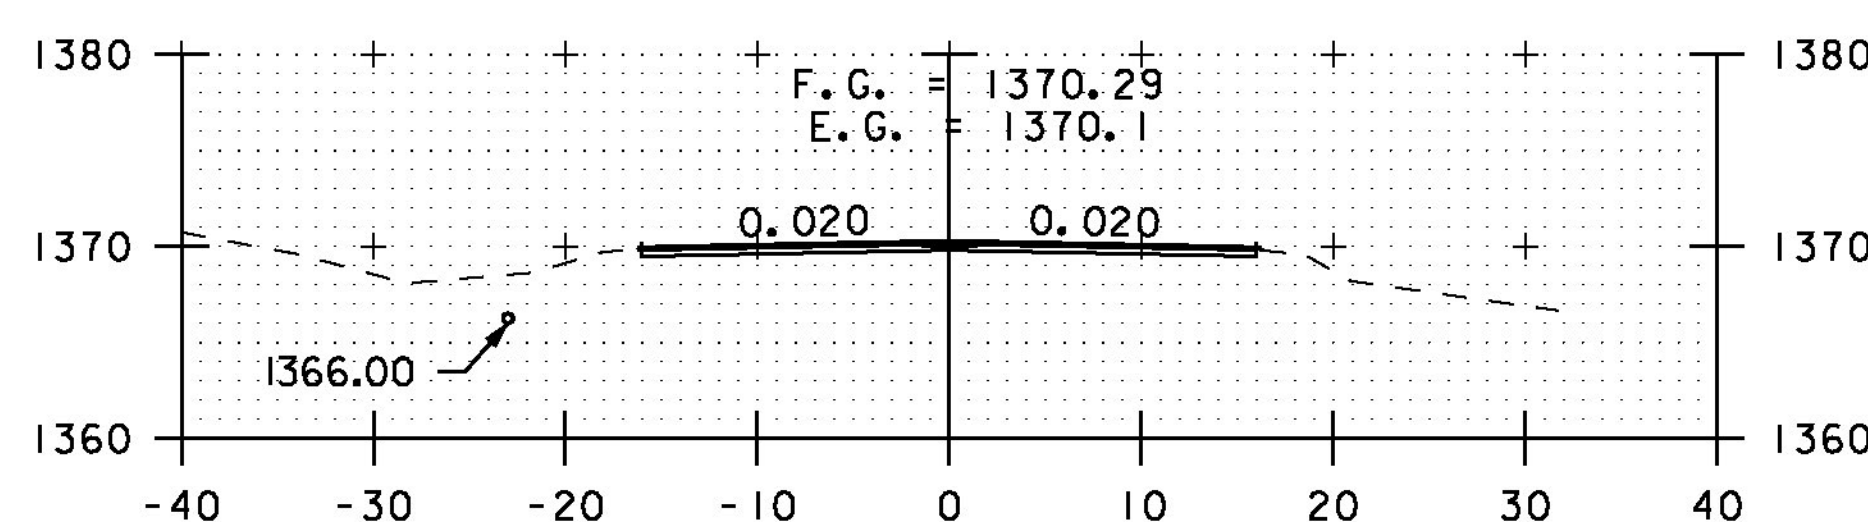


198+50

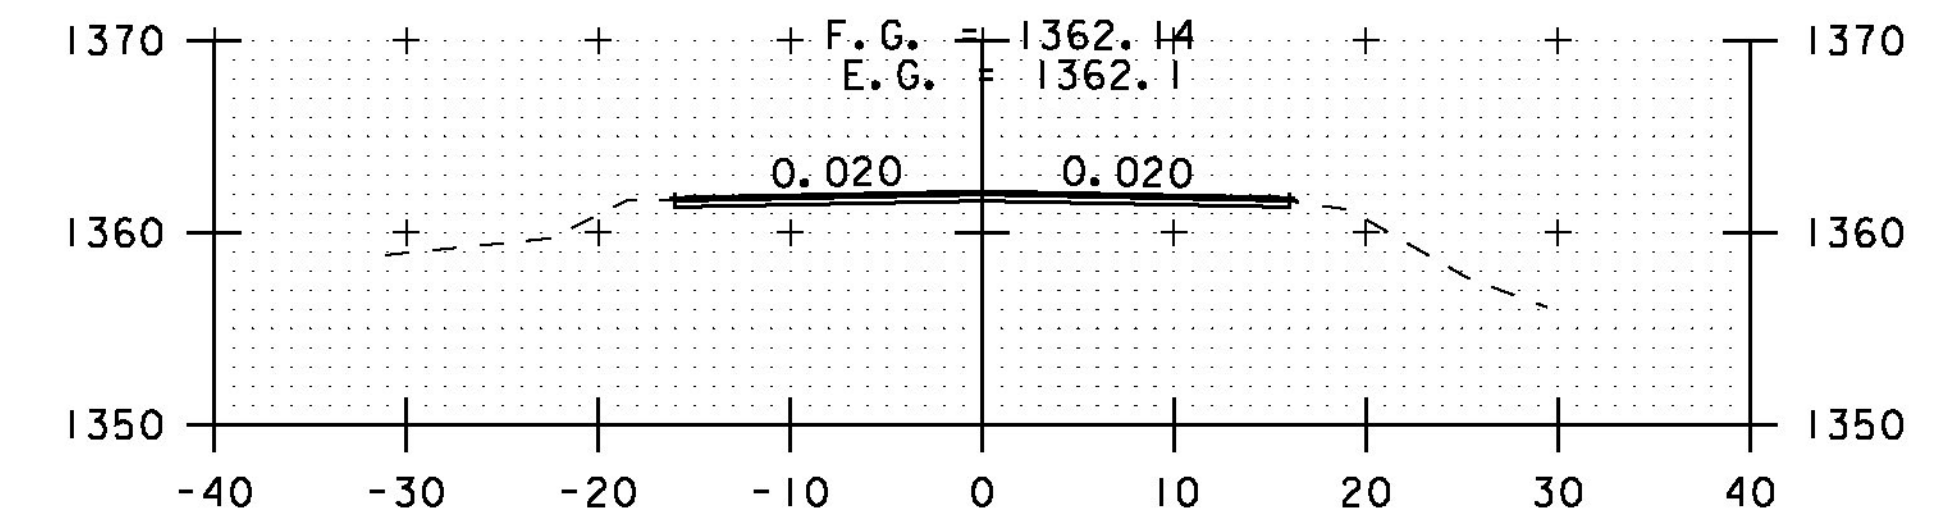


202+00



201+50

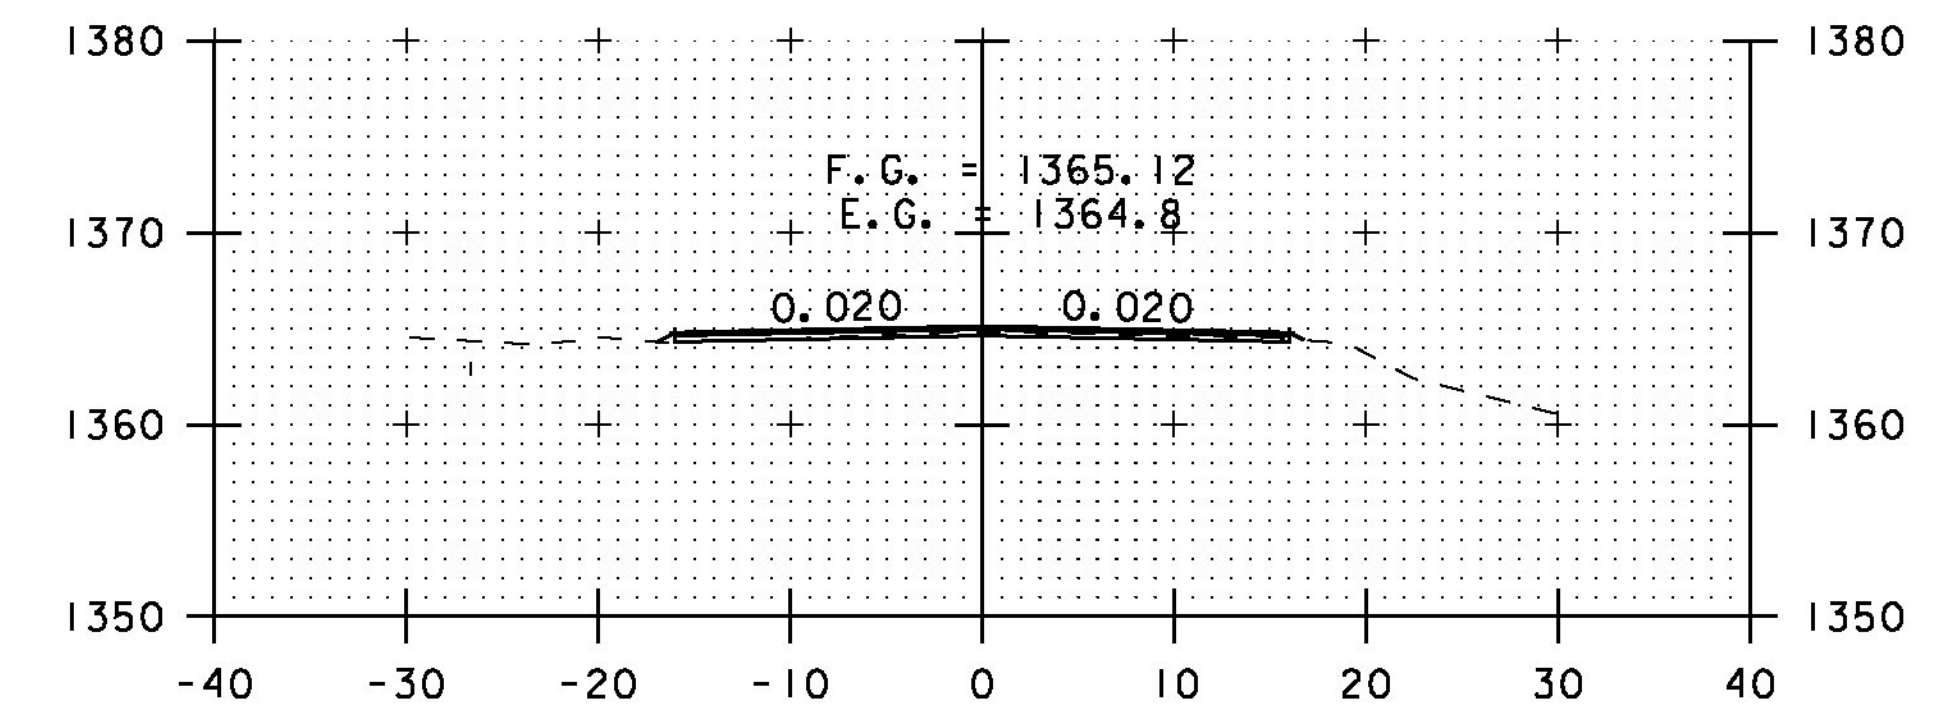

201+00

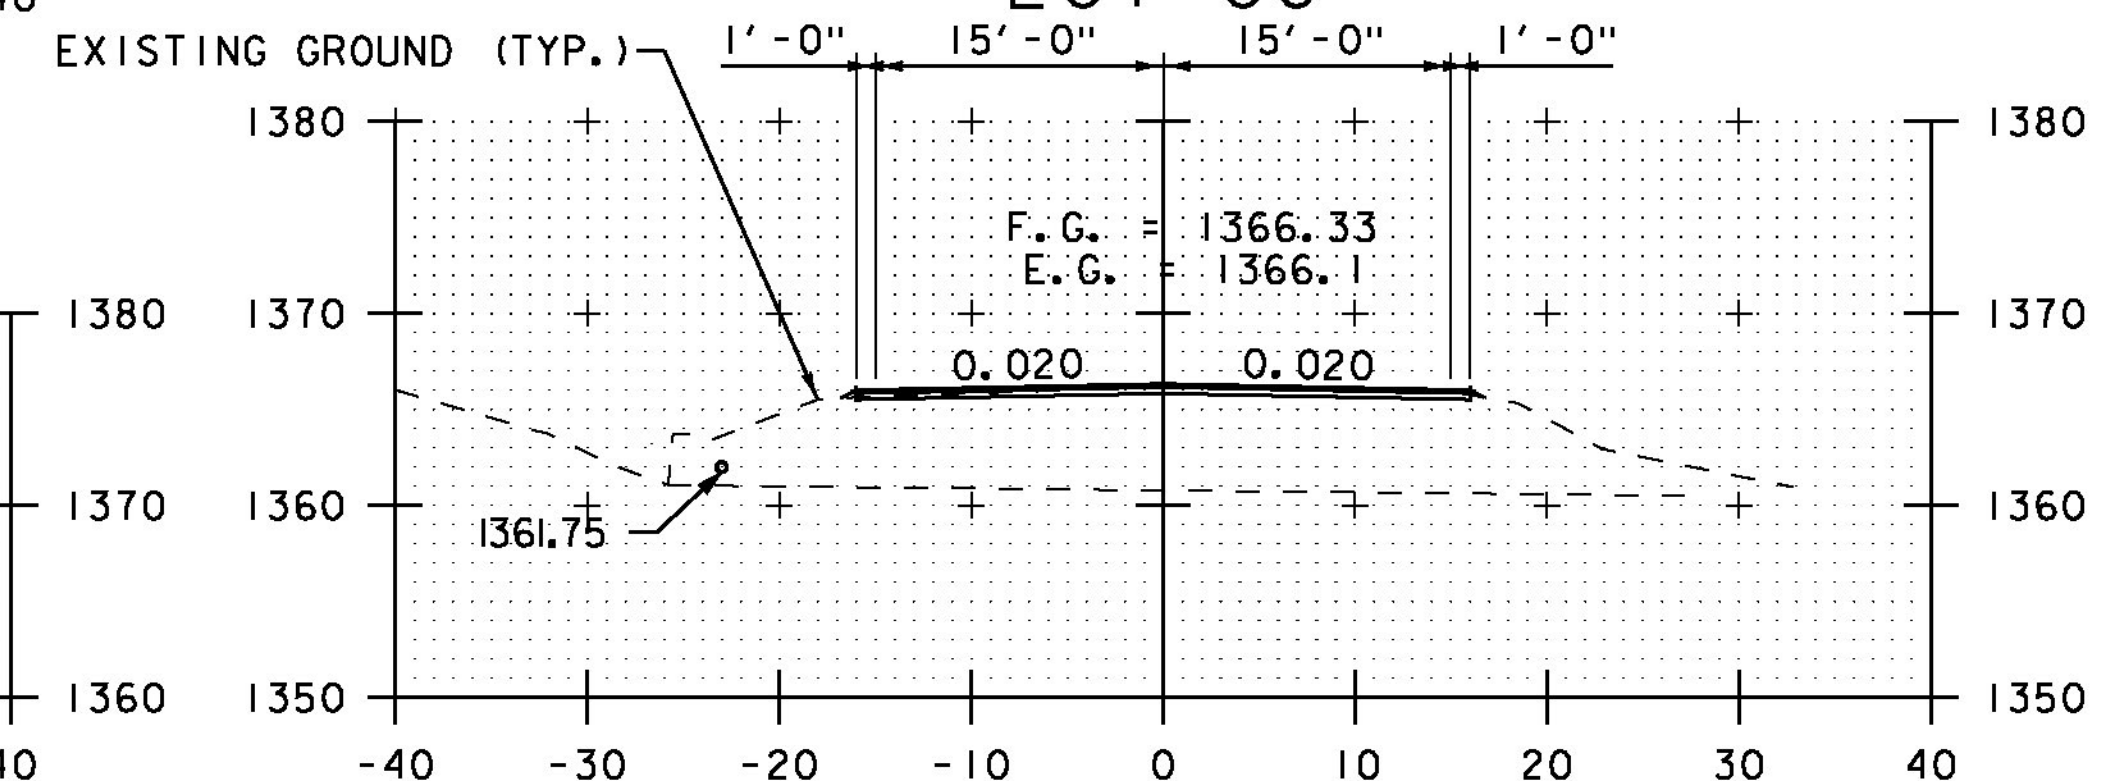

200+50

STA. 196+50 TO STA. 202+00



CROSS SECTION SHEET 3

PROJECT NAME: ELMORE-MORRISTOWN

PROJECT NUMBER: STP 2937 (1)

FILE NAME: z11c310.dgn

PROJECT LEADER: C. LATHROP

DESIGNED BY: S. LAMPHERE

PLOT FILE: z11c310_131.i

PLOT DATE: 3/3/14

DRAWN BY: B. MARTIN

CHECKED BY: C. LATHROP

SHEET 131 OF 194