




203+50

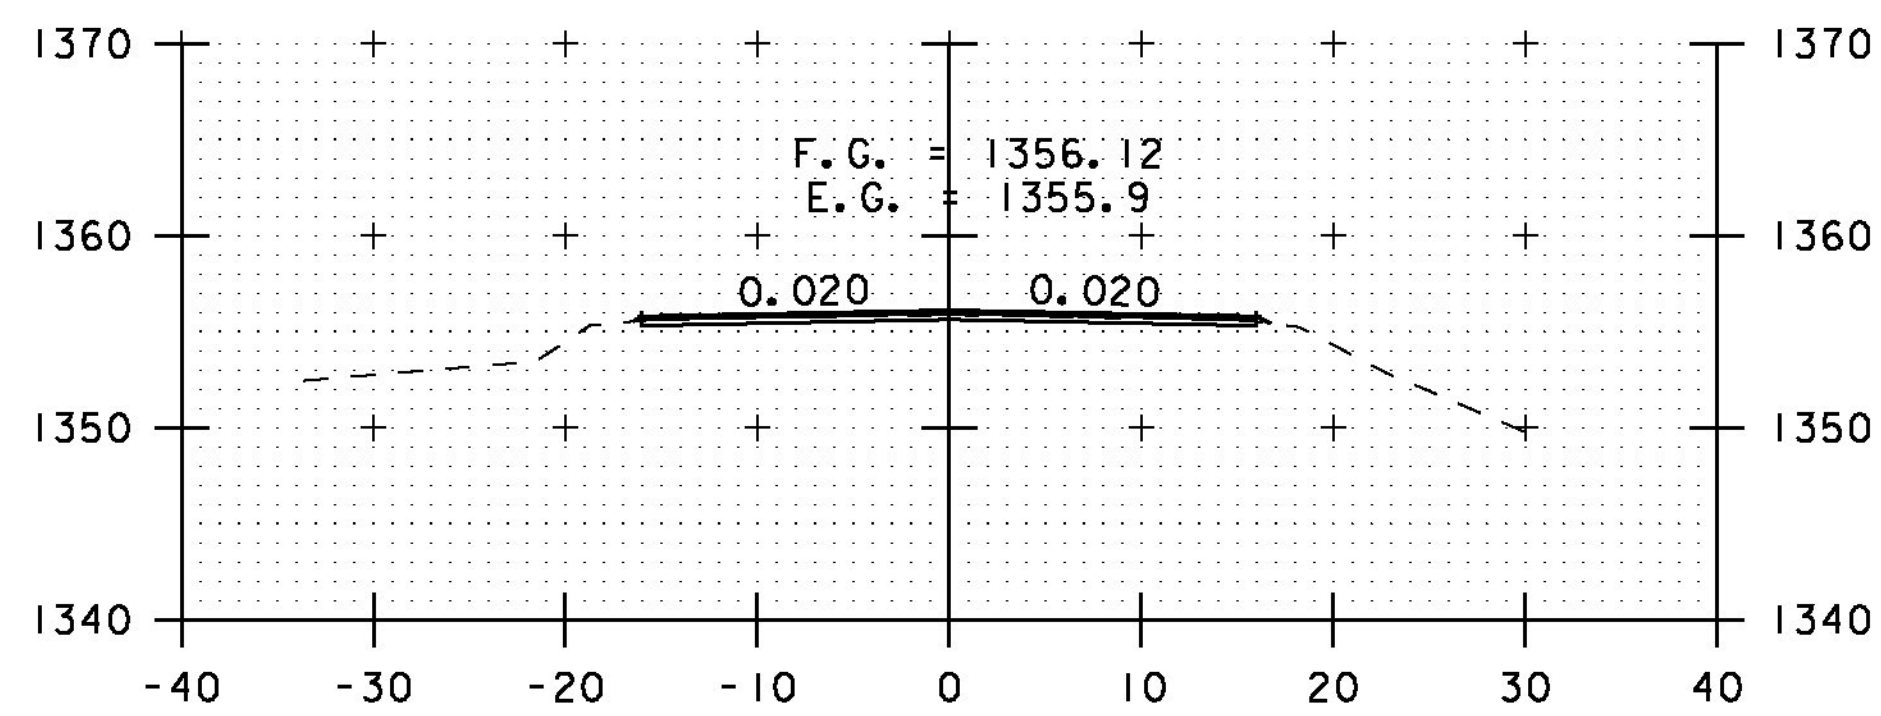


205+00

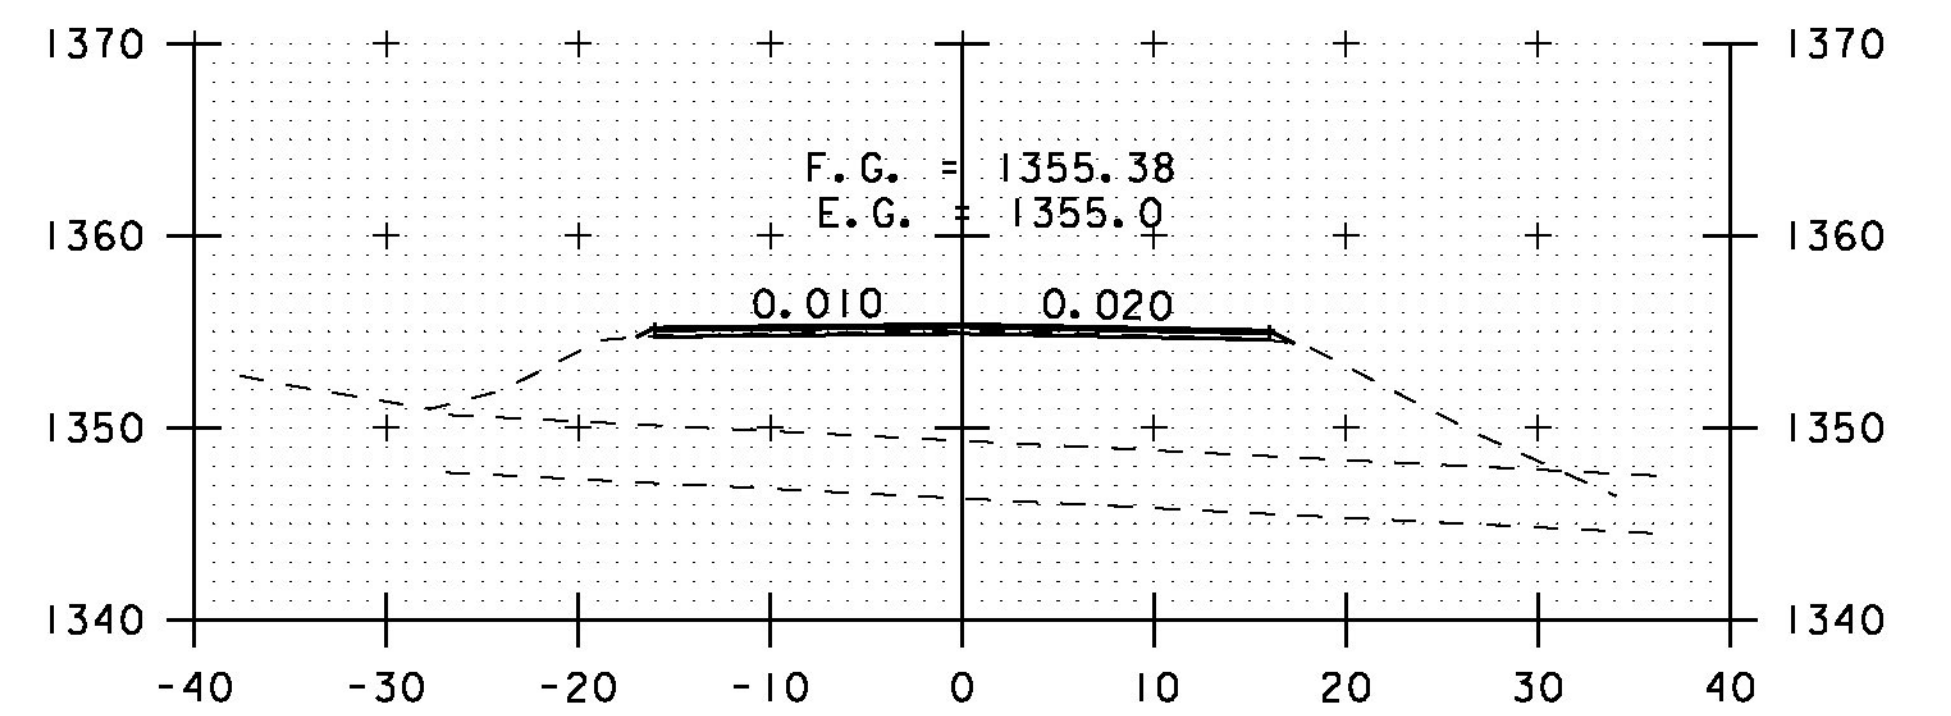


206+50

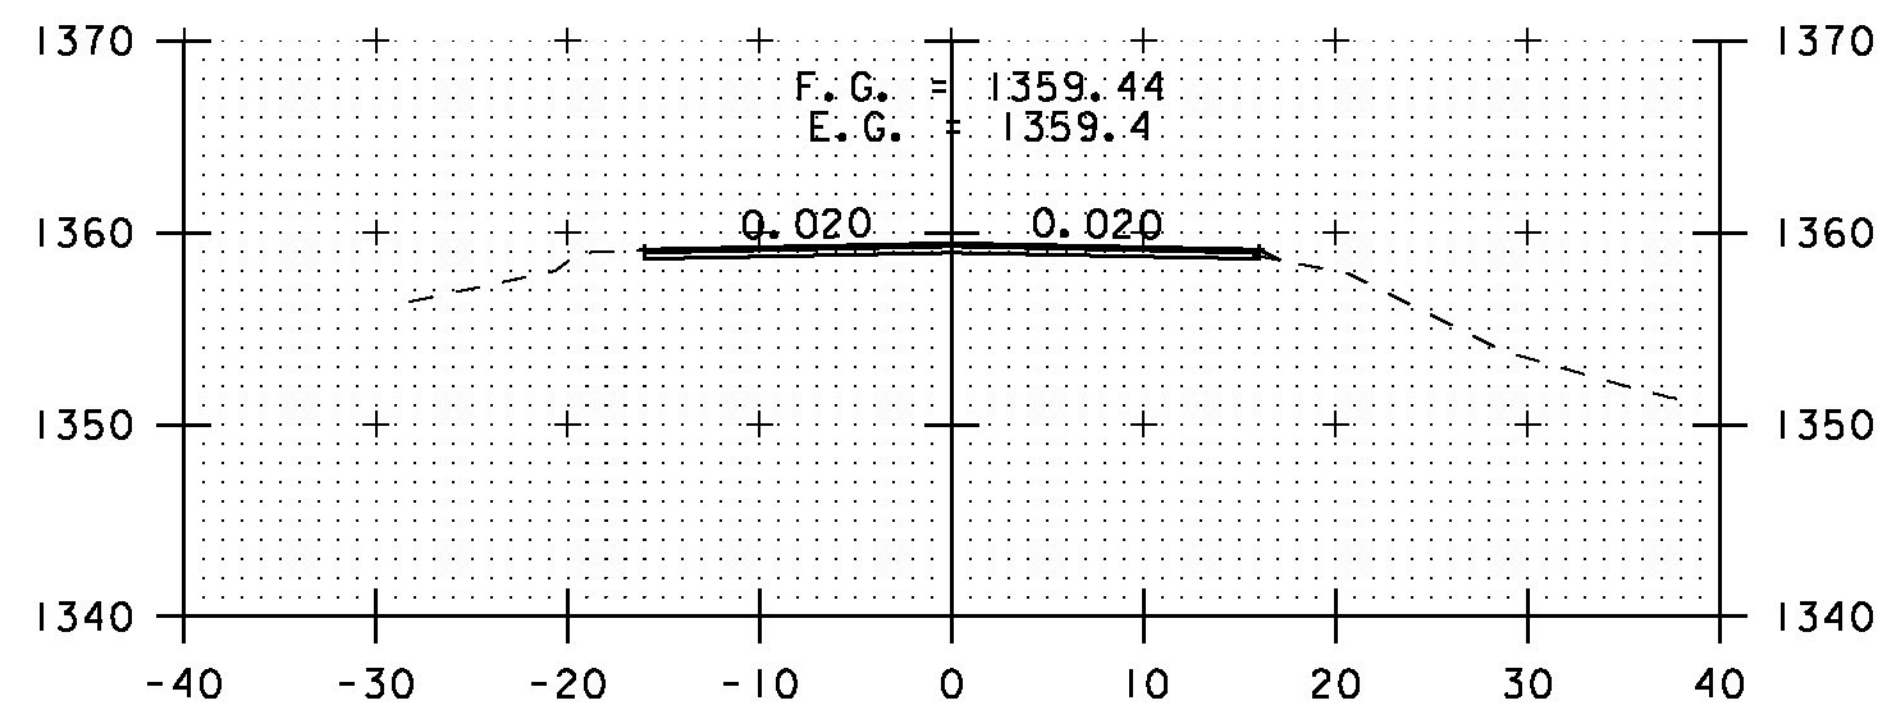


203+00

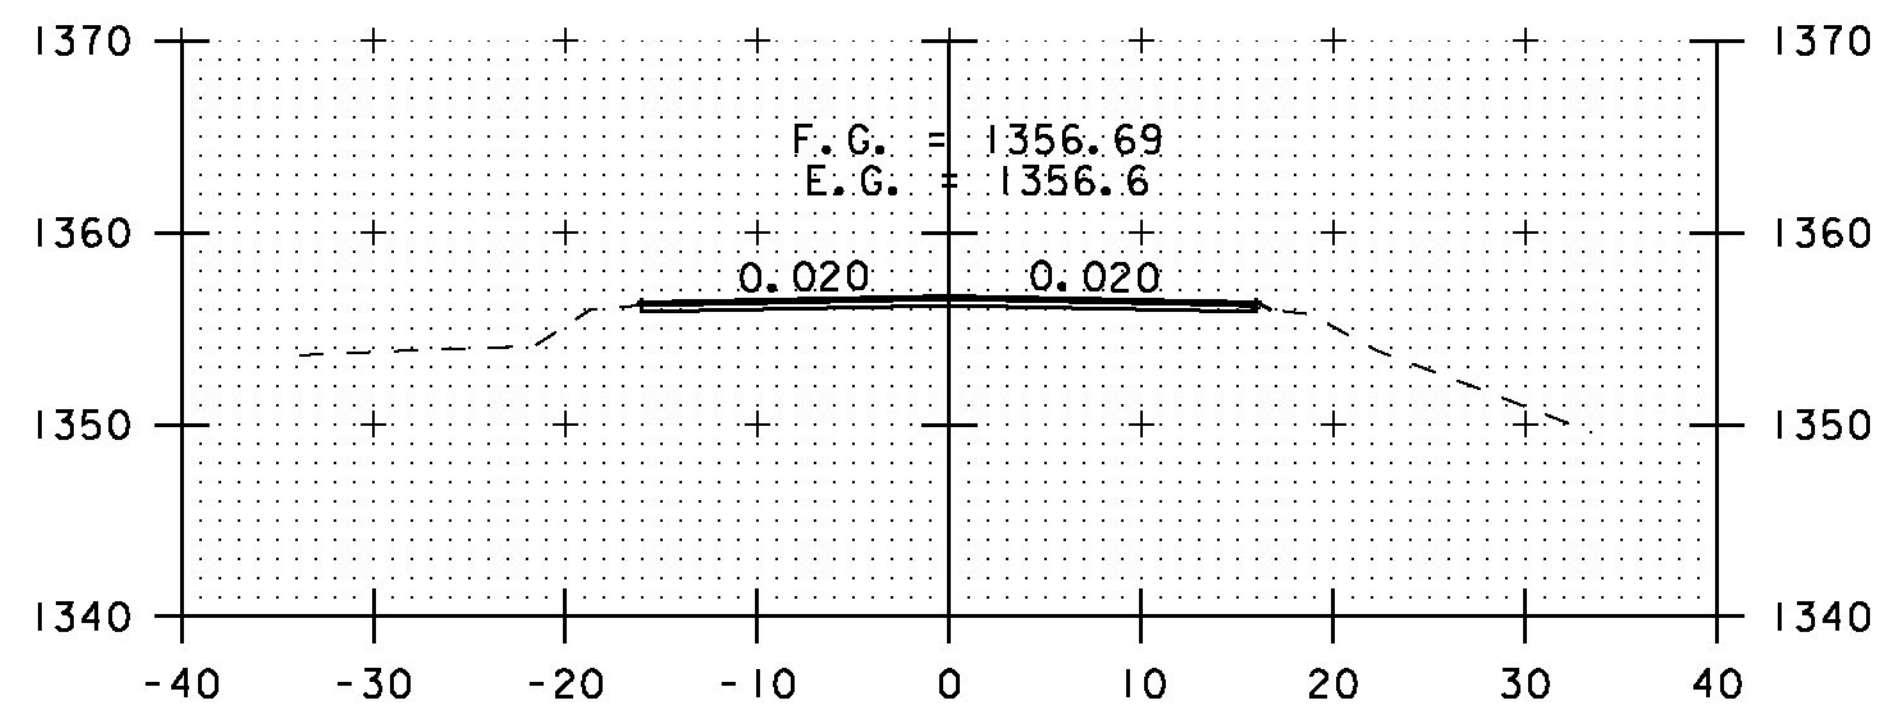


204+50

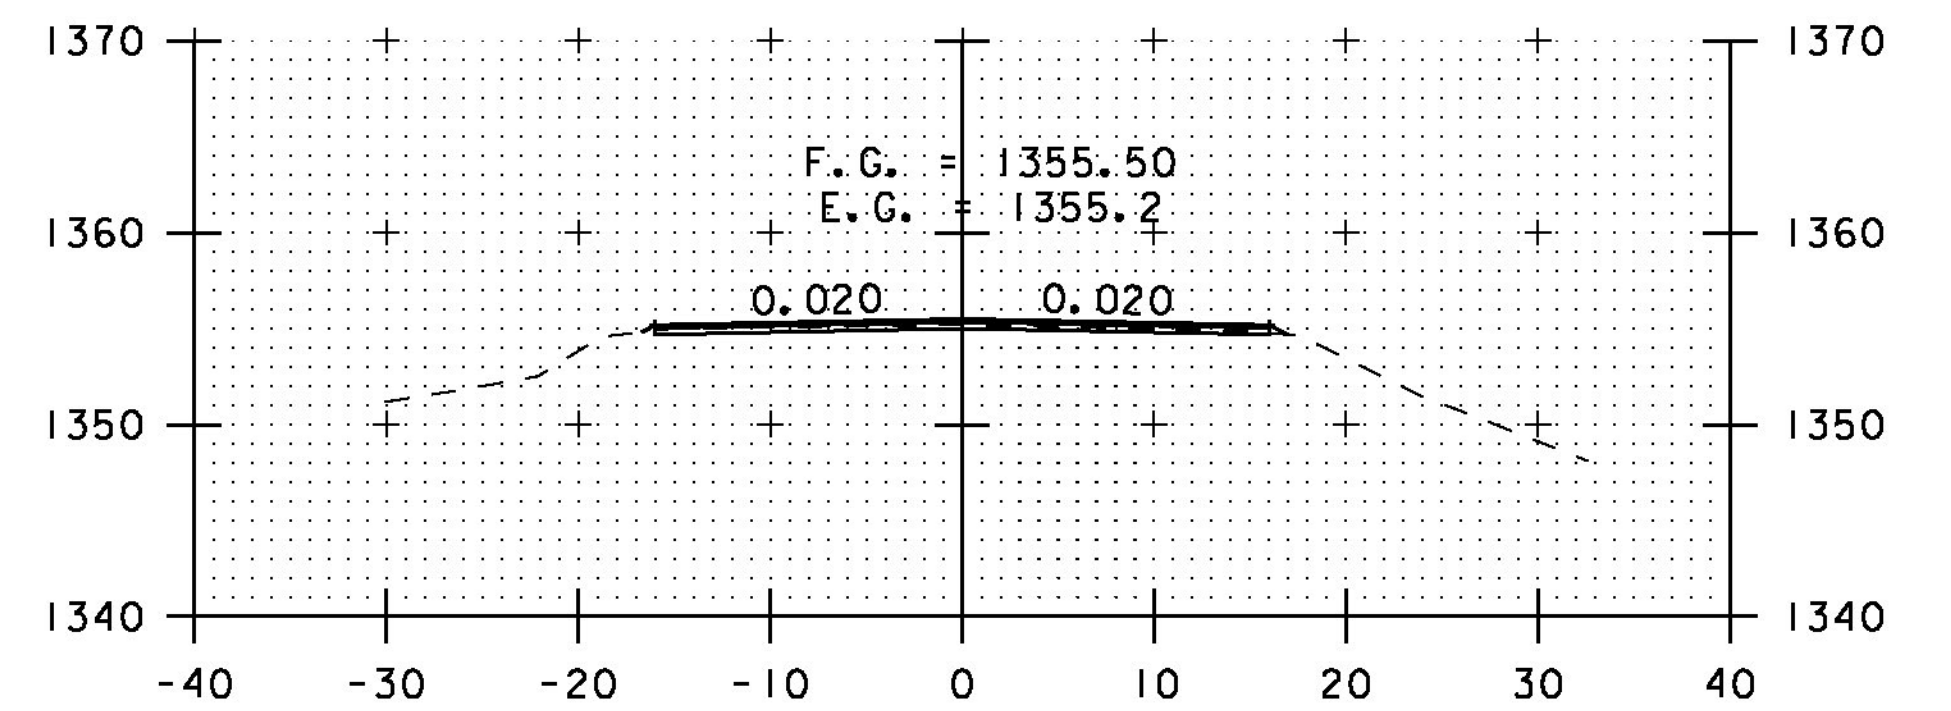


206+00

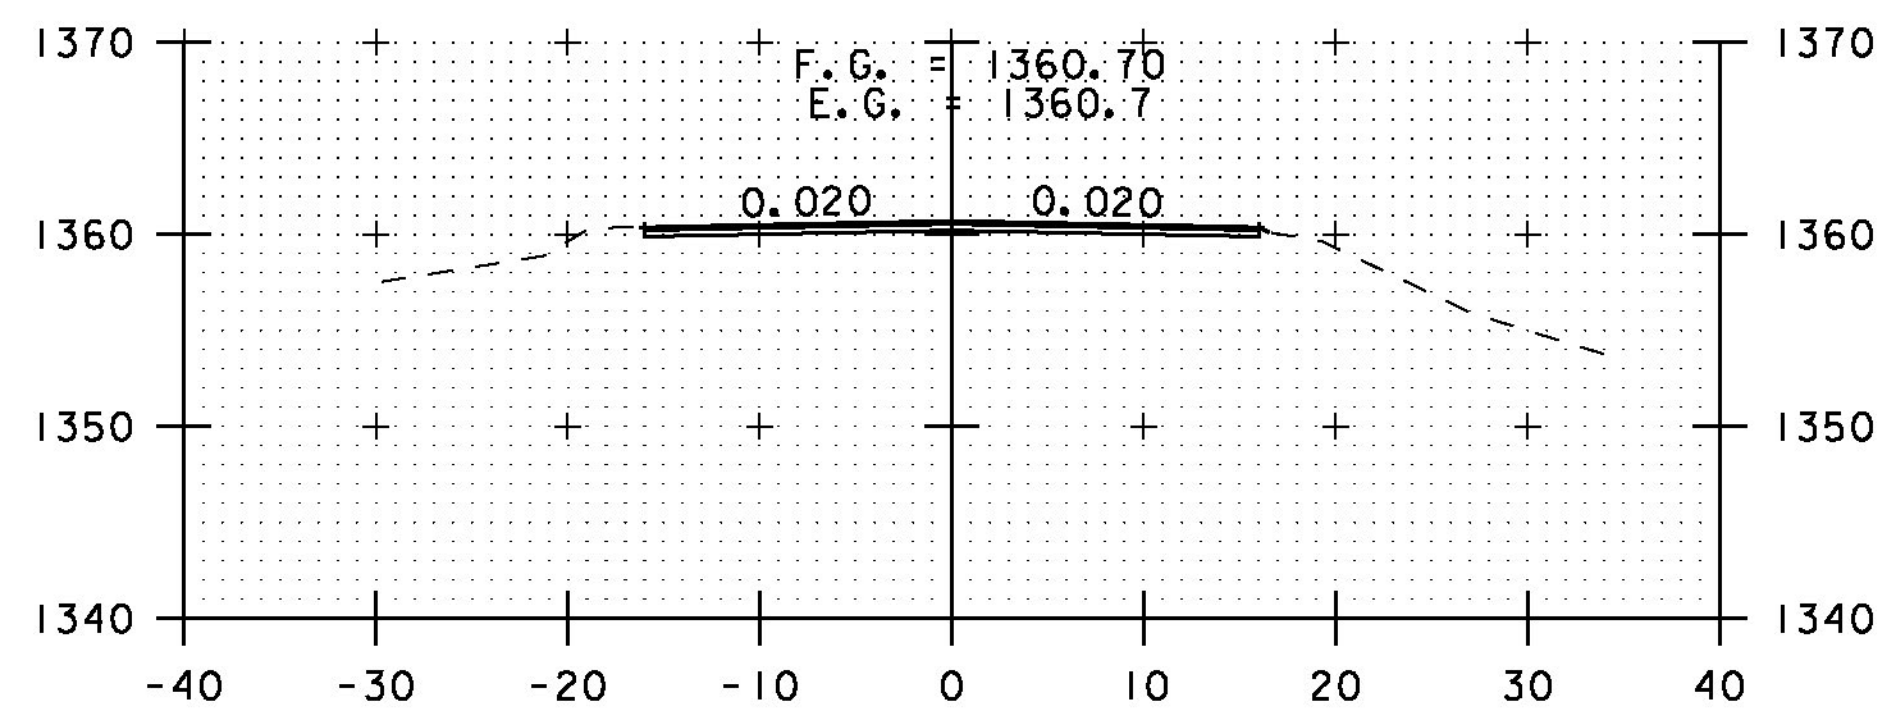

202+50

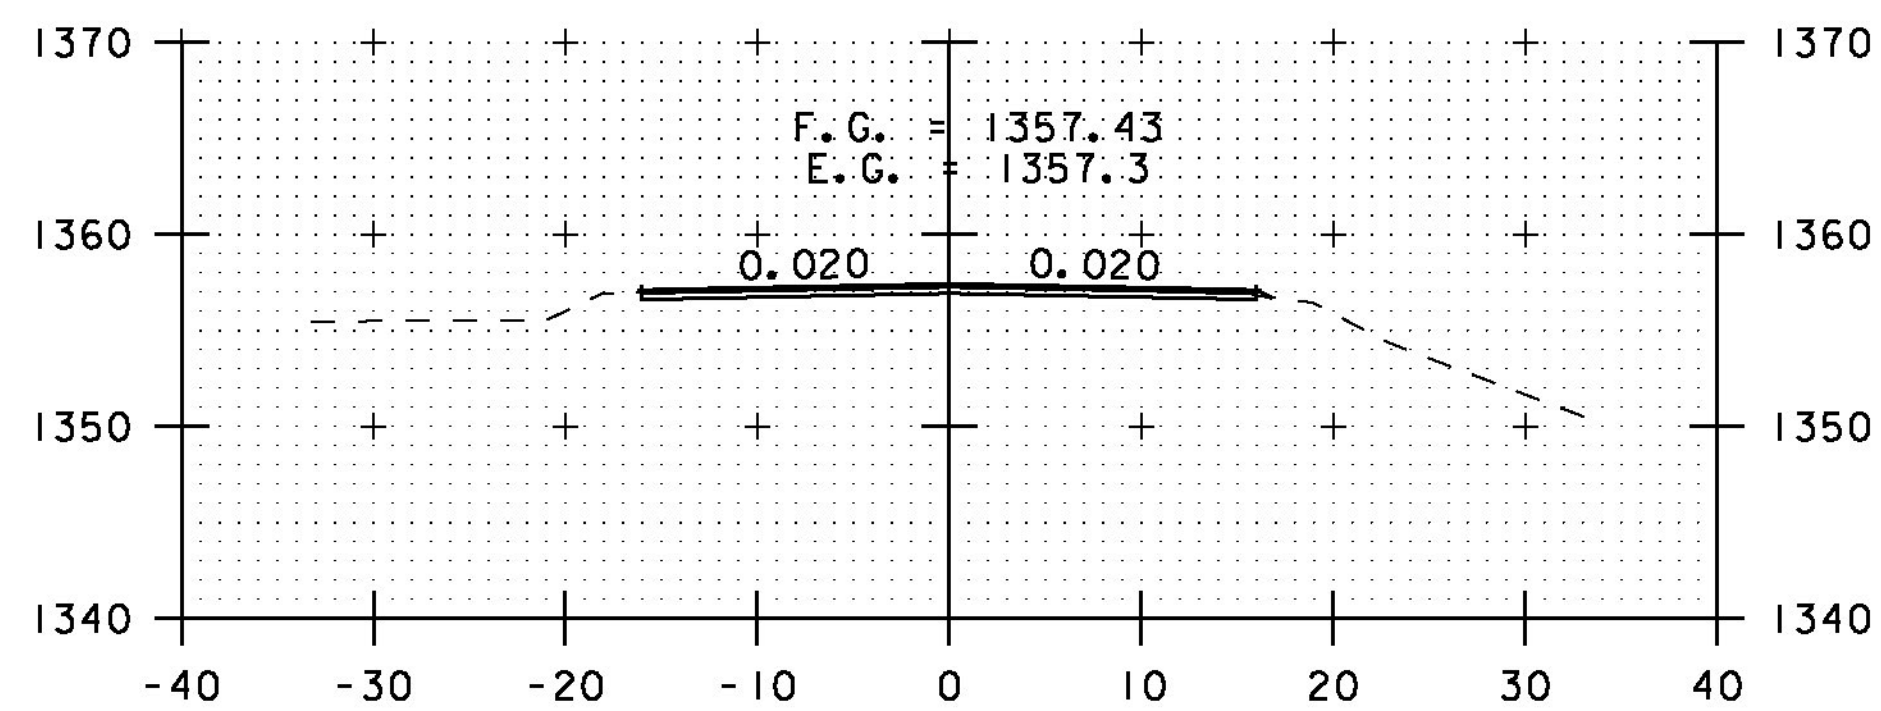

204+00

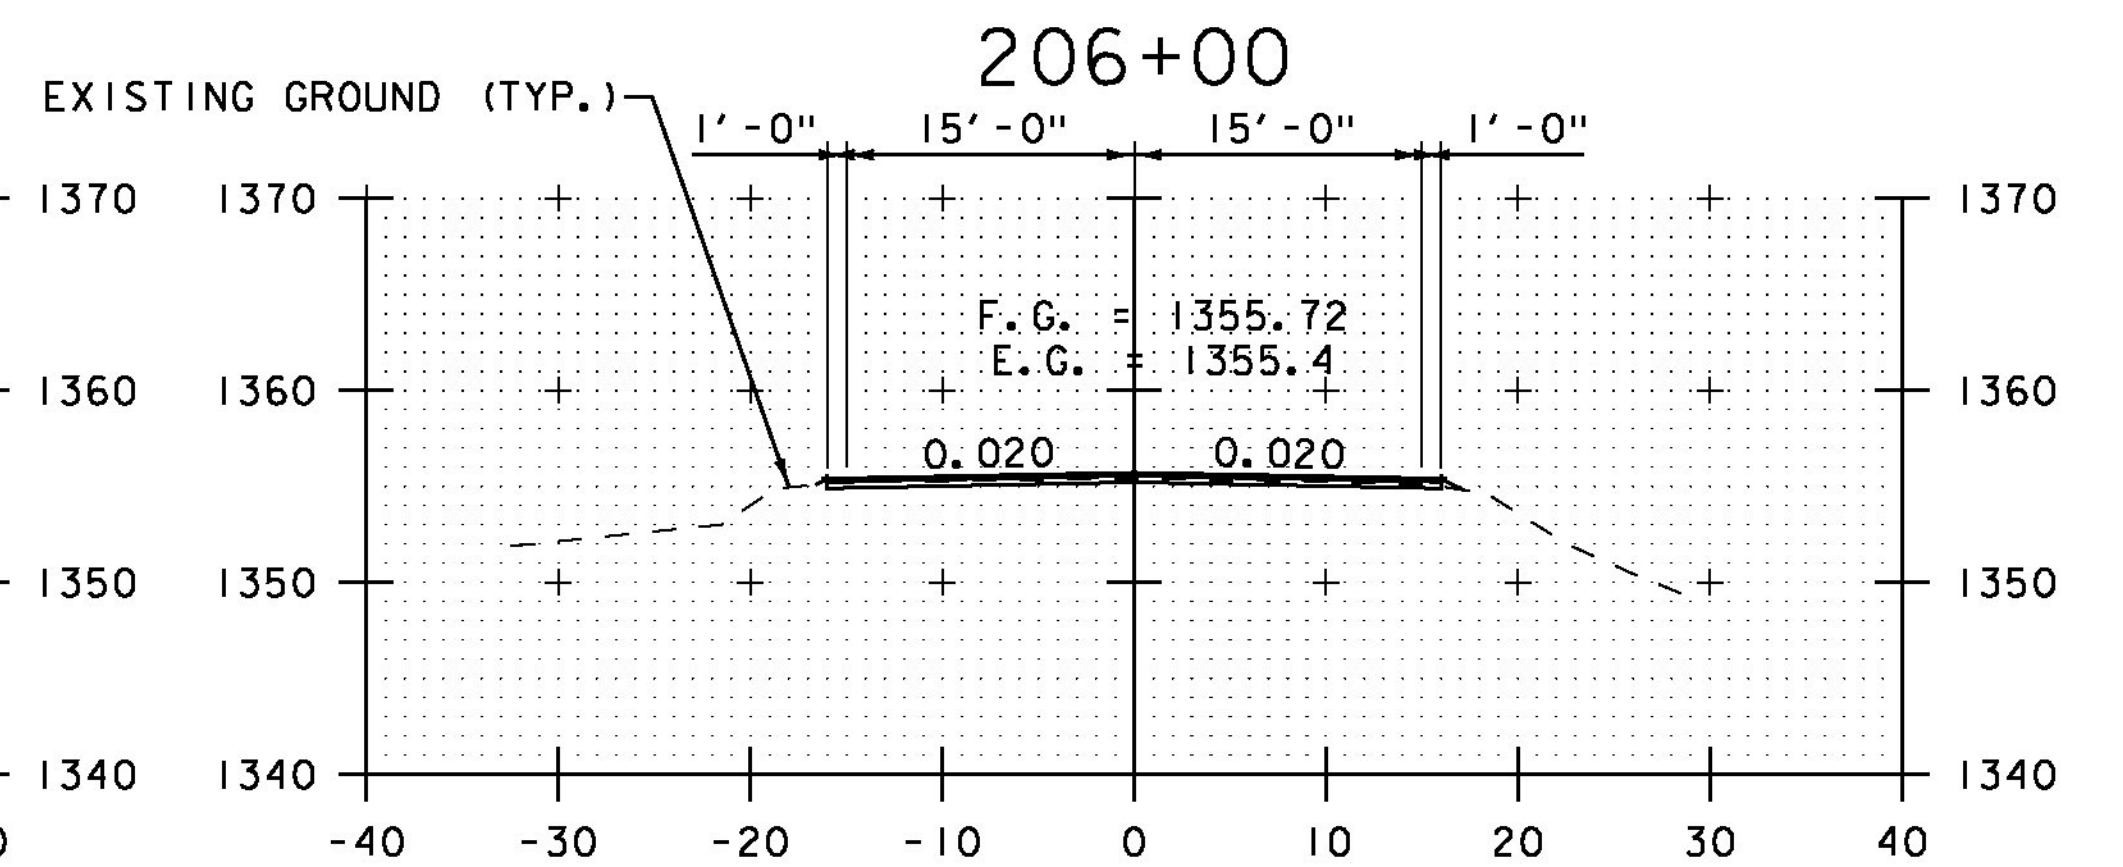

205+50

STA. 202+50 TO STA. 206+50

SCALE 1" = 10'-0"

CROSS SECTION SHEET 4

PROJECT NAME: ELMORE-MORRISTOWN	PLOT DATE: 3/3/14
PROJECT NUMBER: STP 2937 (1)	DRAWN BY: B. MARTIN
FILE NAME: z11c310.dgn	CHECKED BY: C. LATHROP
PROJECT LEADER: C. LATHROP	SHEET 132 OF 194
DESIGNED BY: S. LAMPHERE	
PLOT FILE: z11c310_132.i	