




208+00

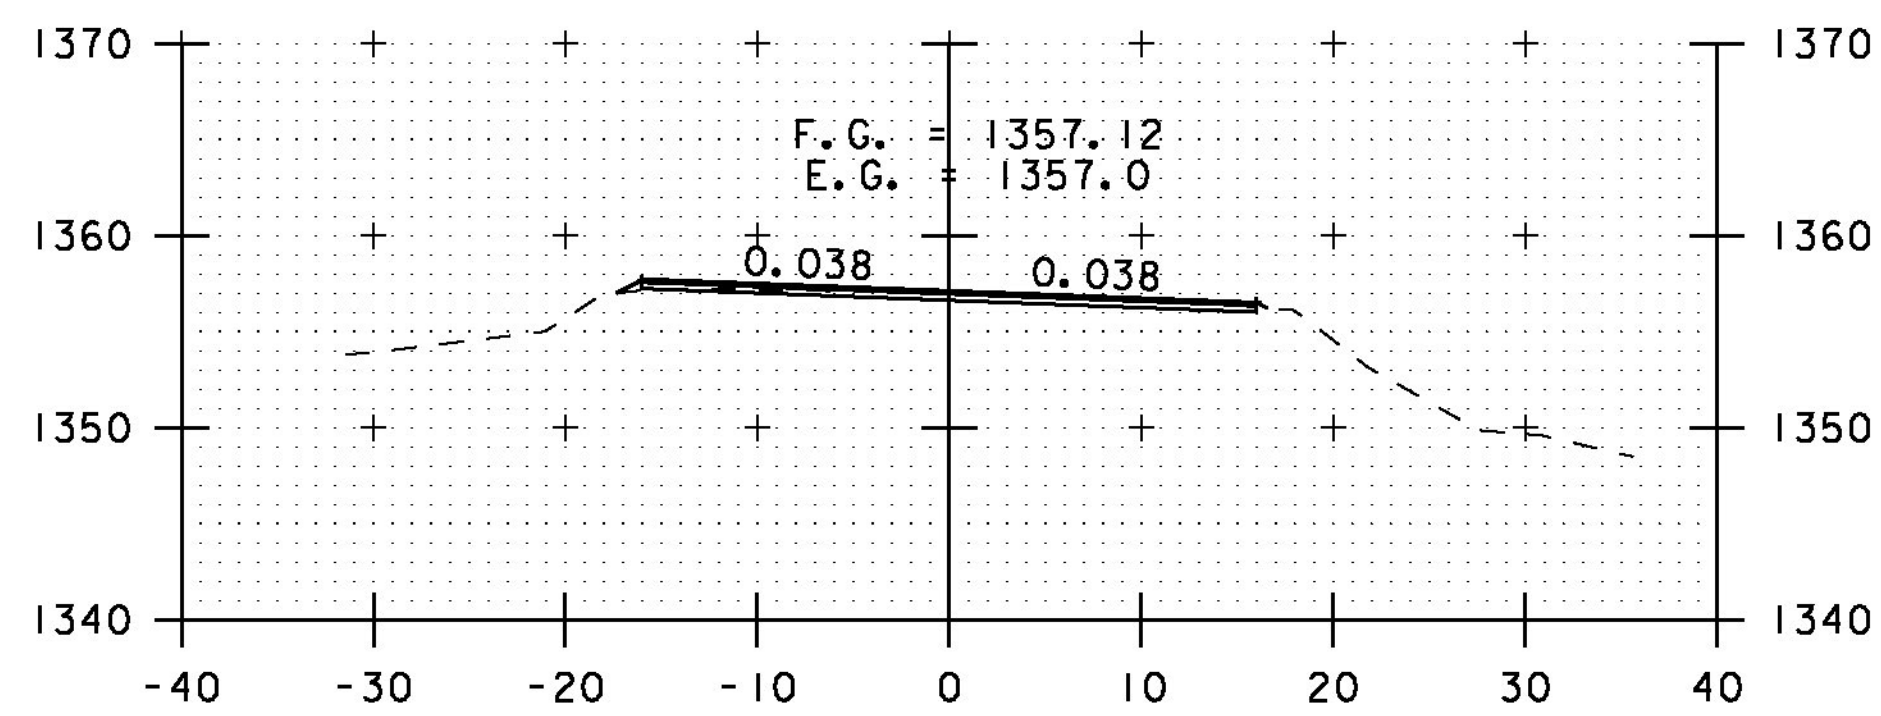


209+50

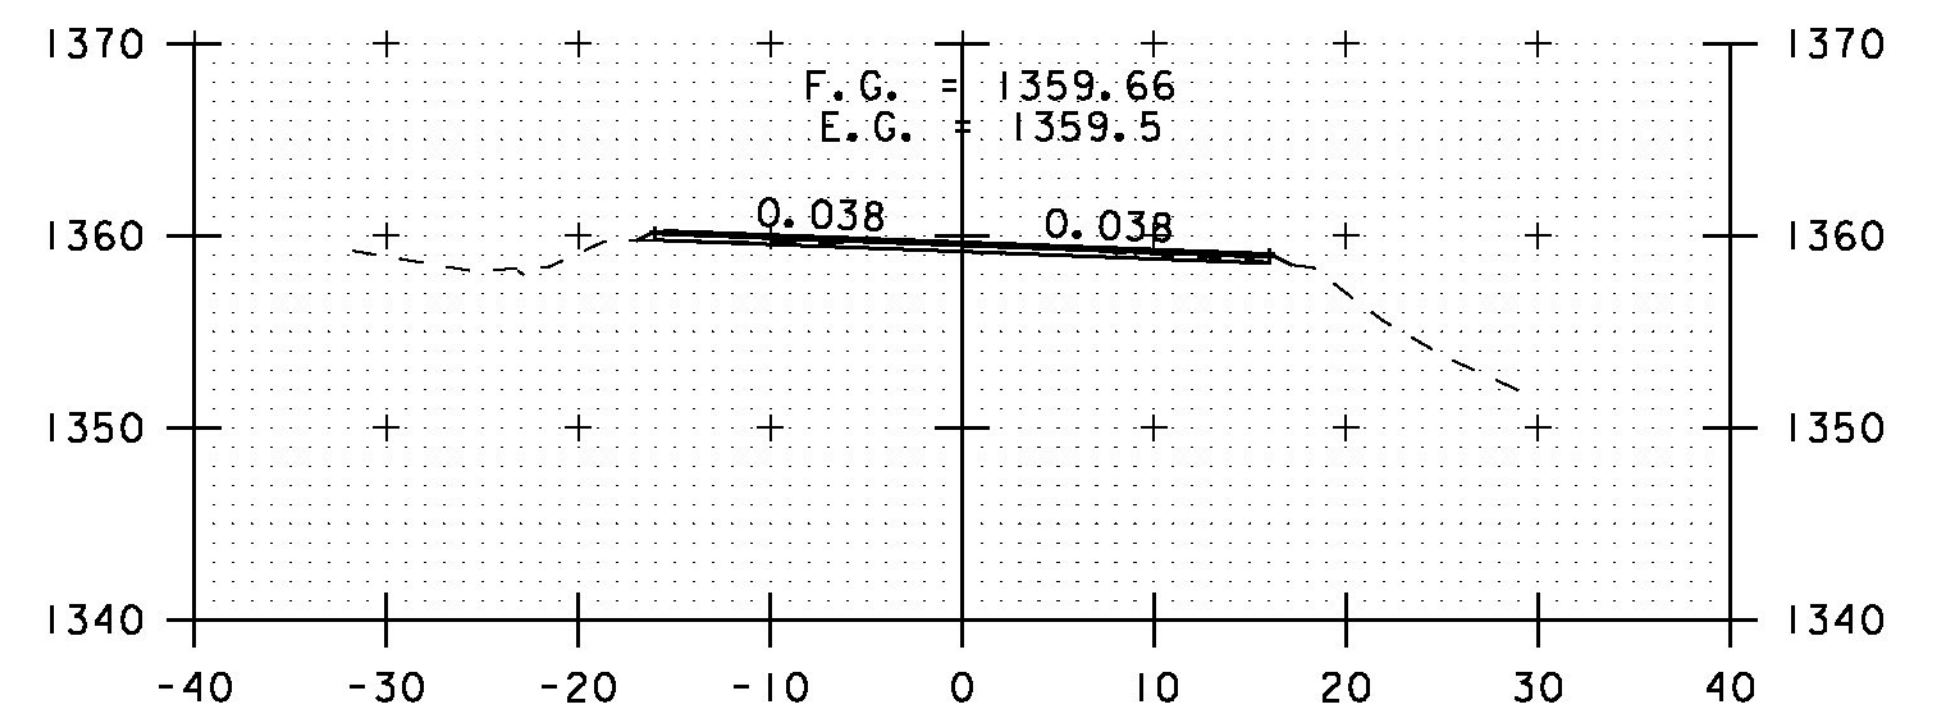


211+00

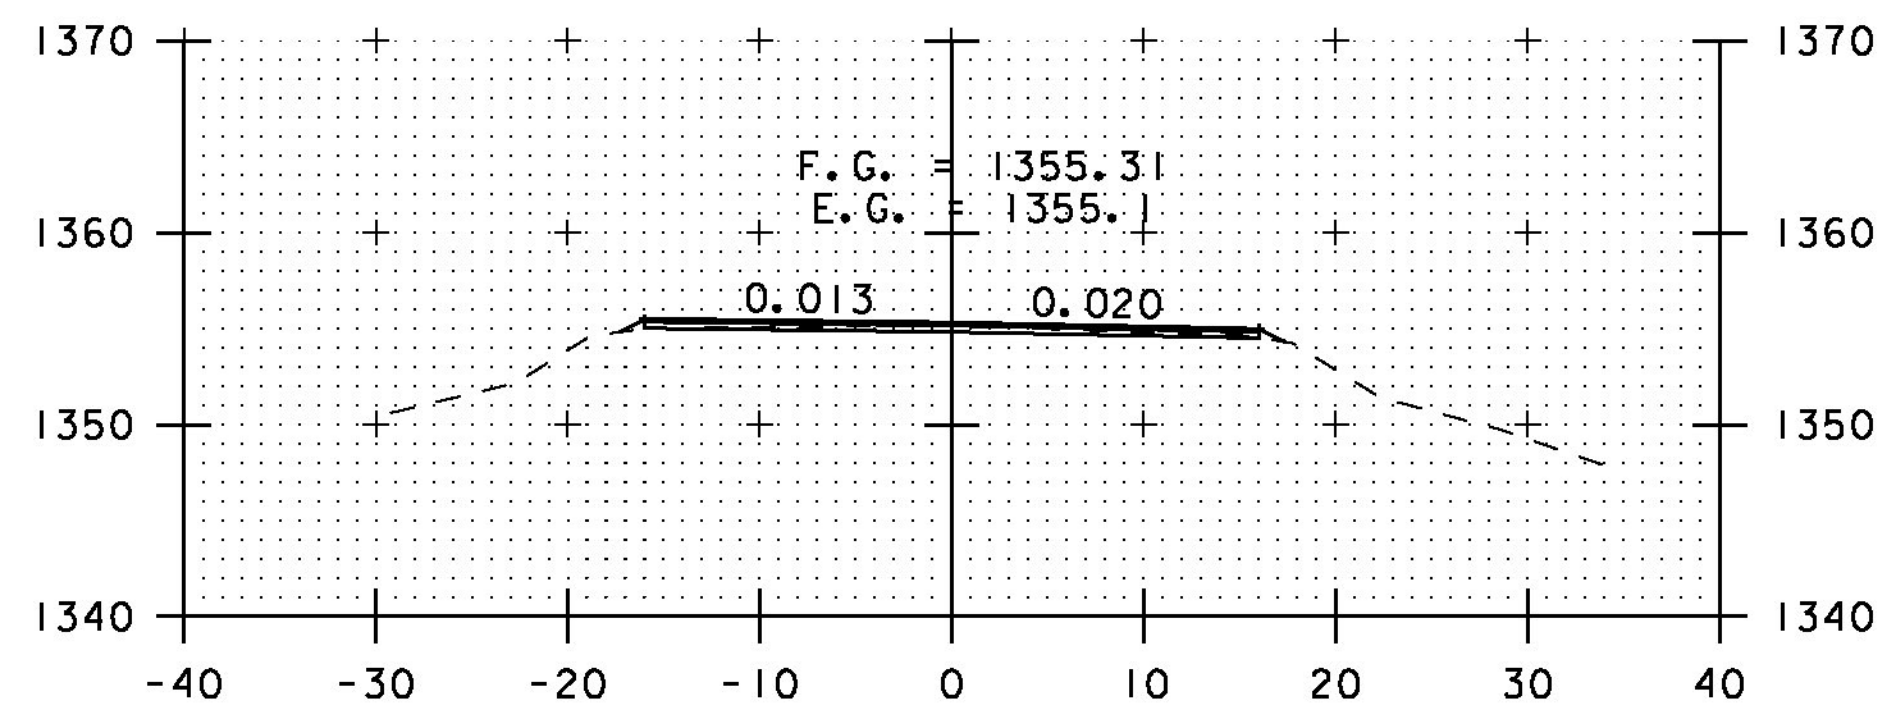


207+50

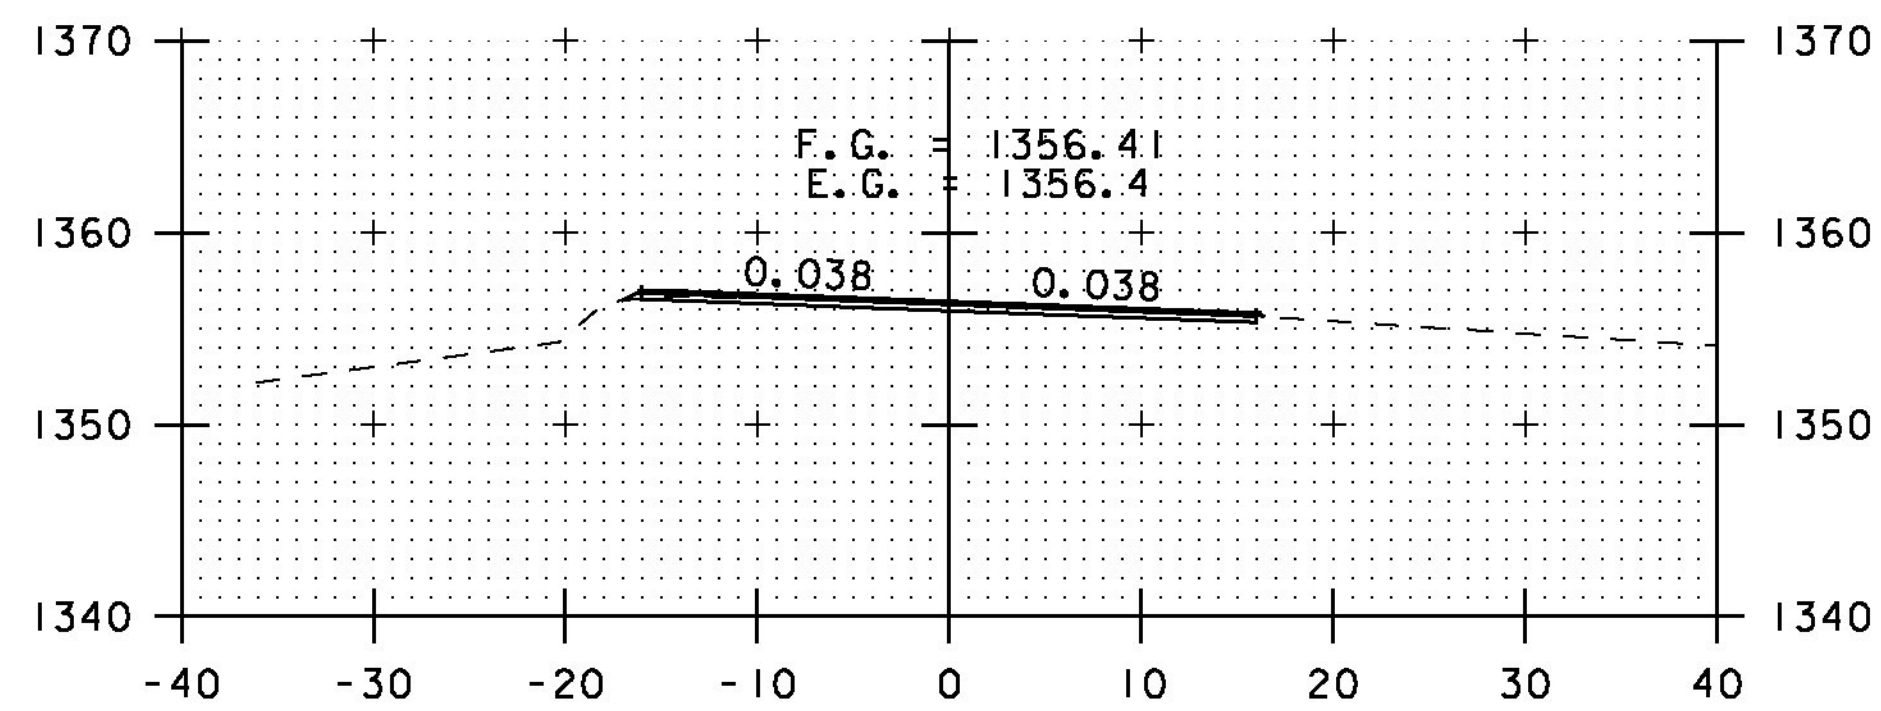


209+00

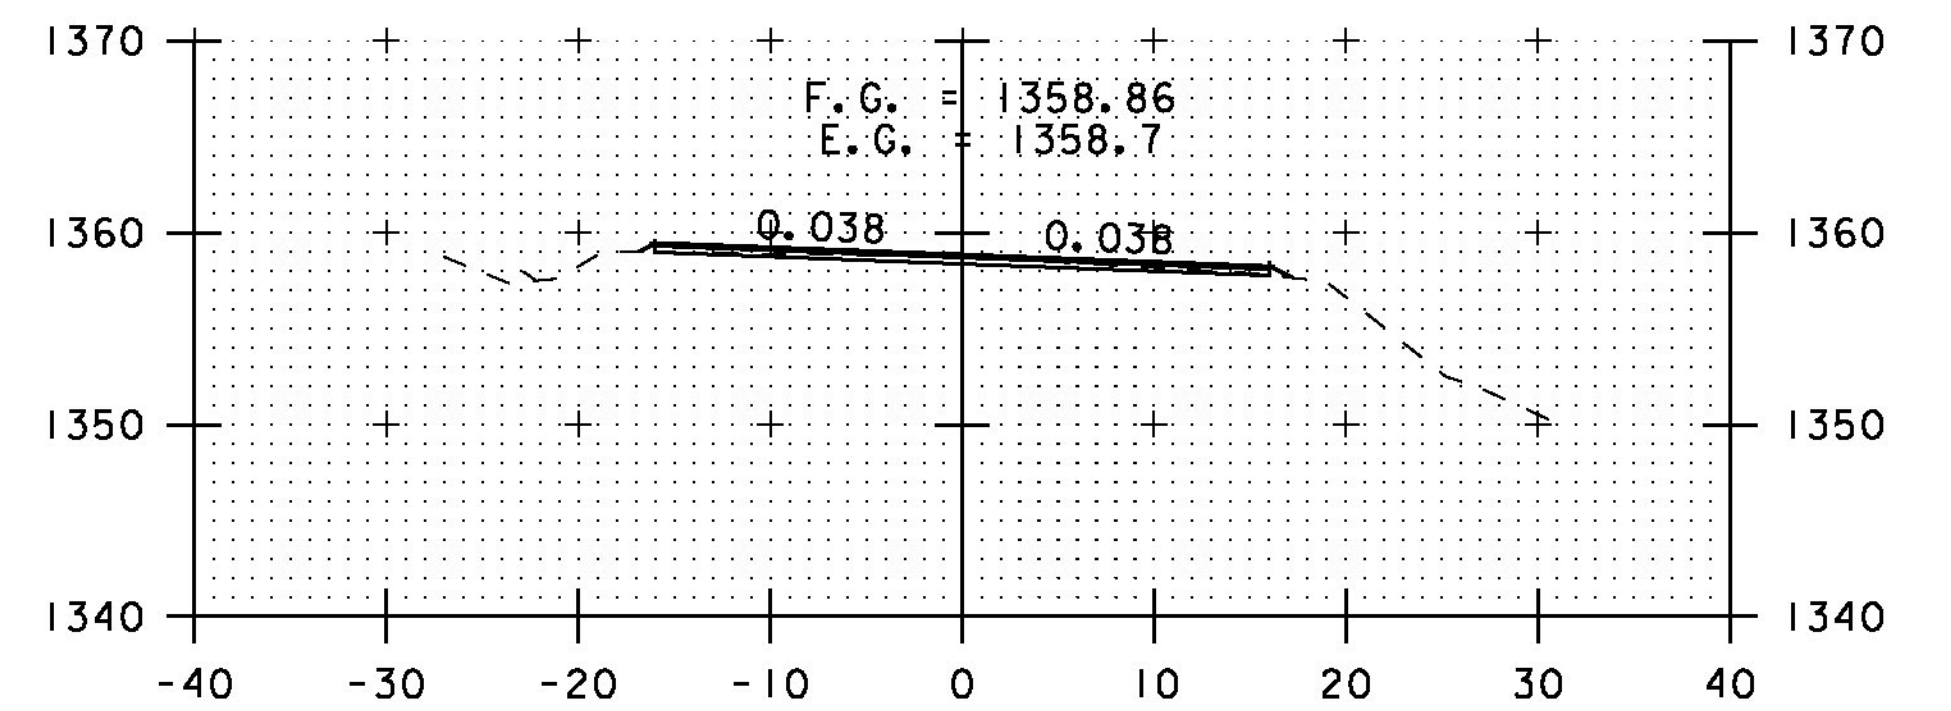


210+50

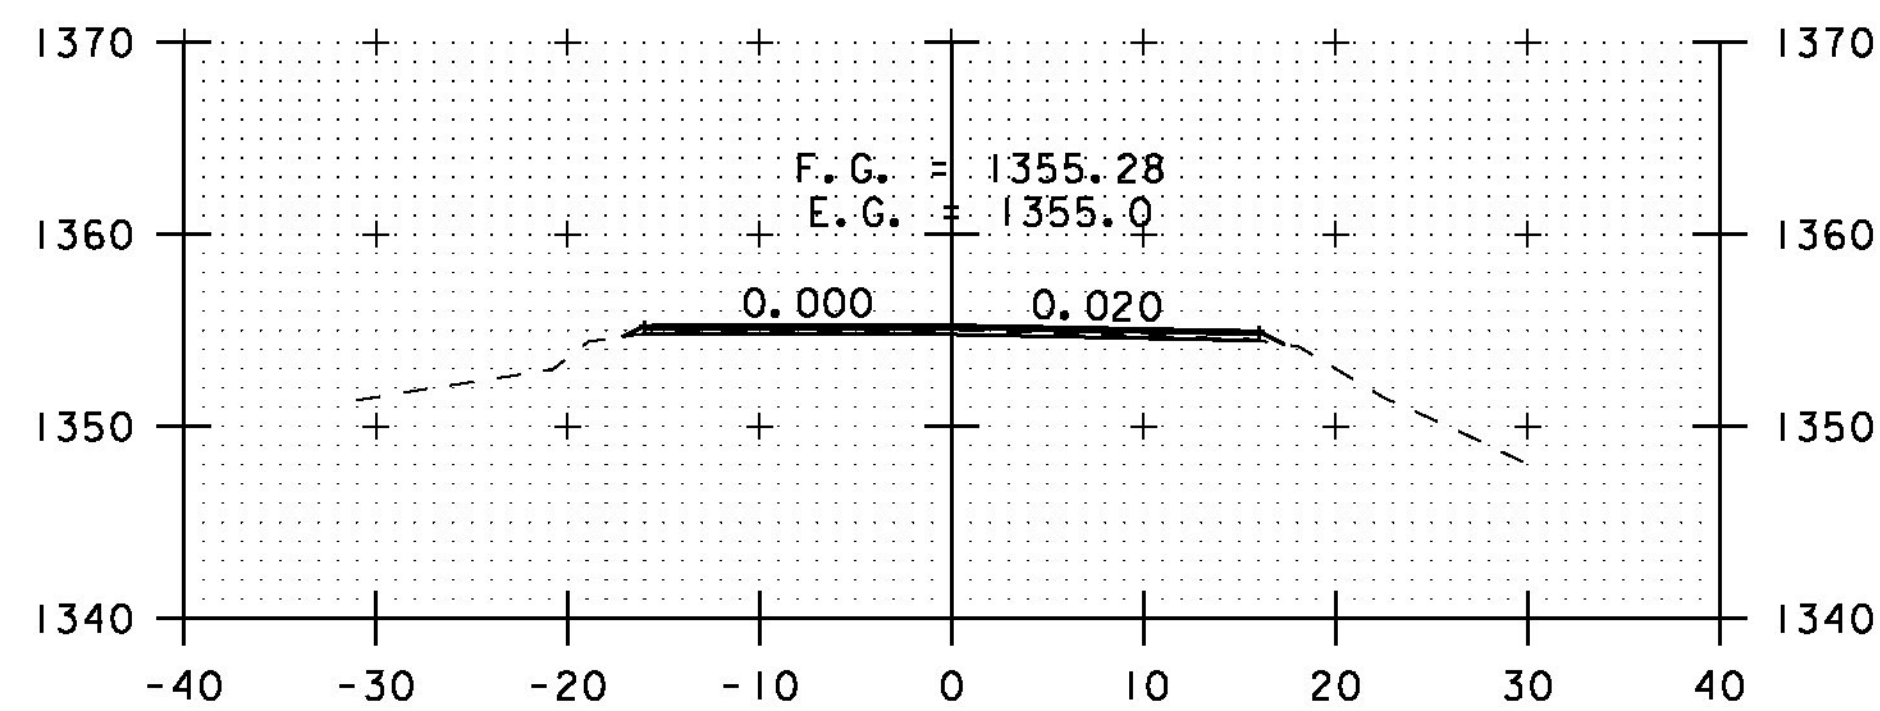

207+00

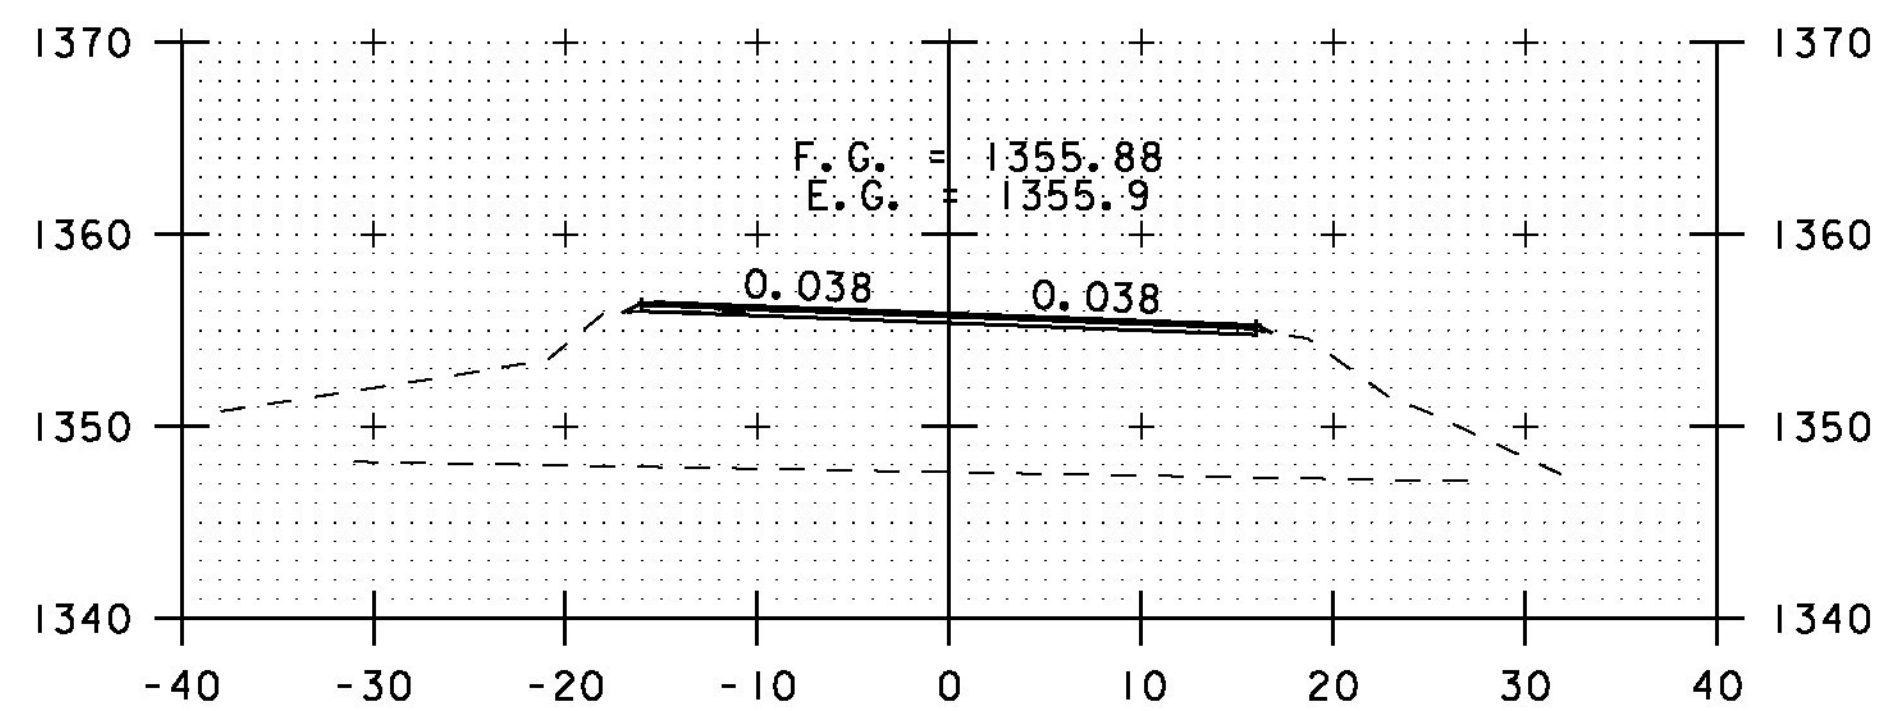

208+50

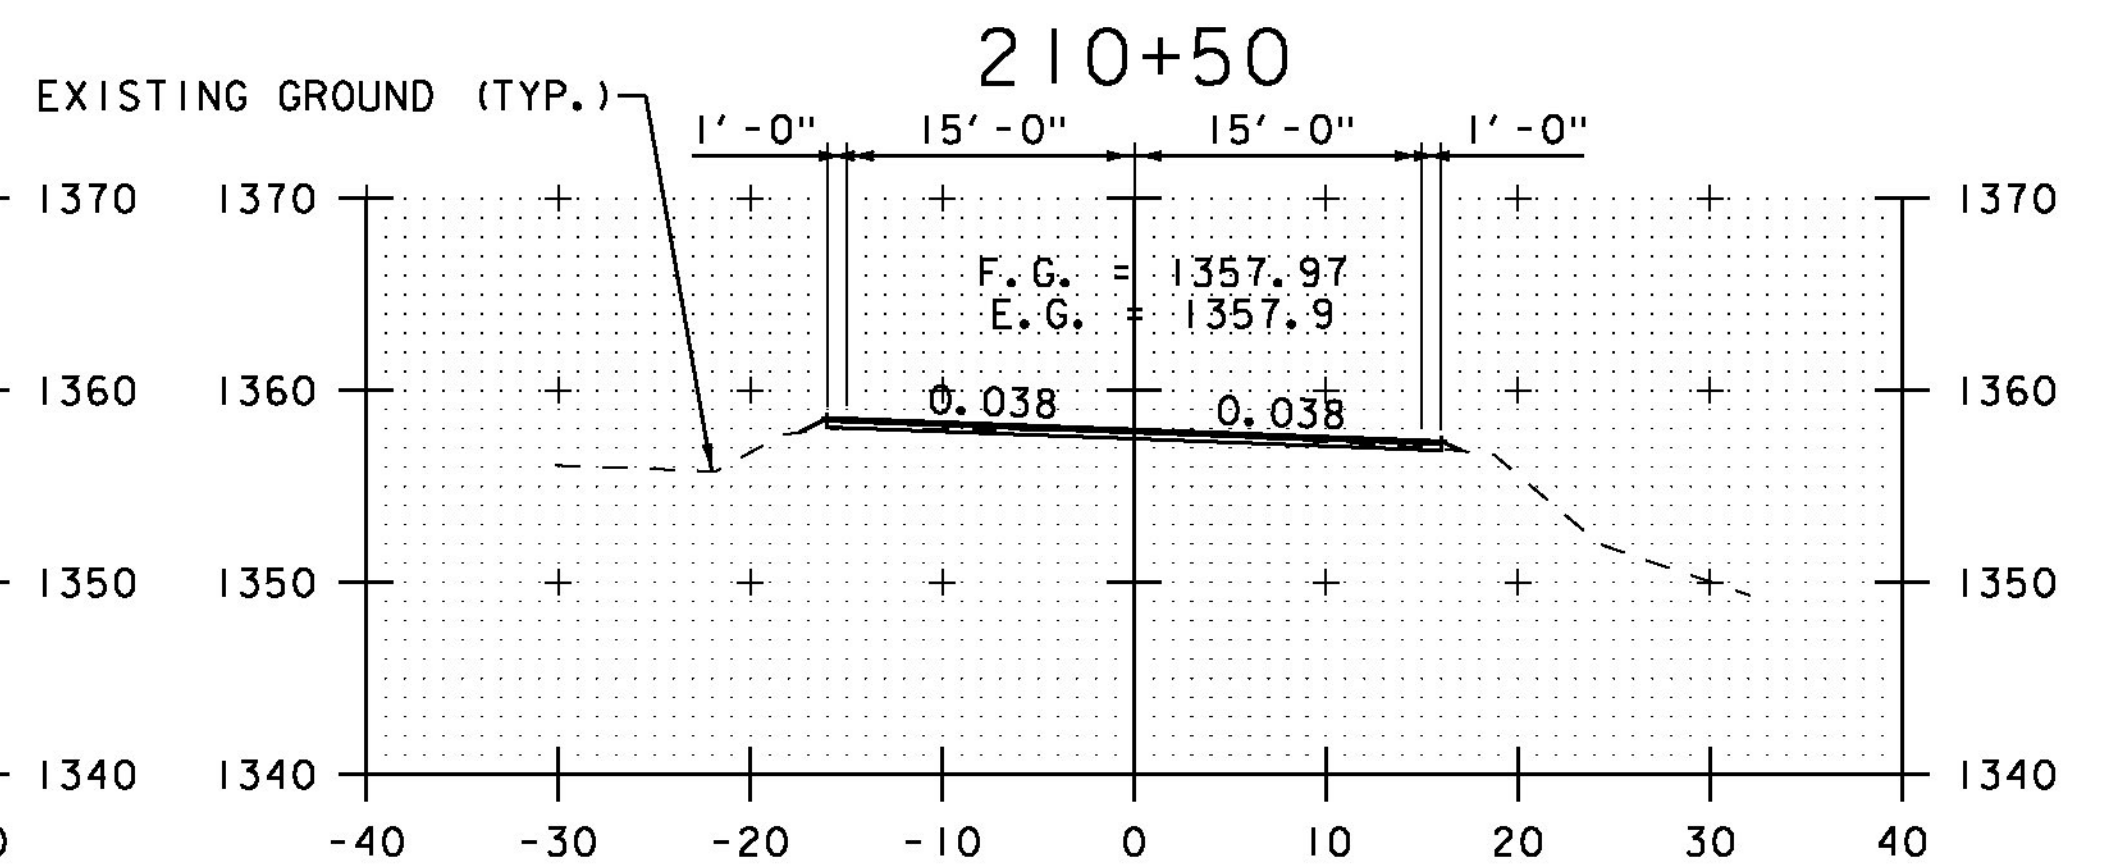

210+00

STA. 207+00 TO STA. 211+00



CROSS SECTION SHEET 5

PROJECT NAME: ELMORE-MORRISTOWN	PROJECT NUMBER: STP 2937 (I)
FILE NAME: z11c310.dgn	PLOT DATE: 3/3/14
PROJECT LEADER: C. LATHROP	DRAWN BY: B. MARTIN
DESIGNED BY: S. LAMPHERE	CHECKED BY: C. LATHROP
PLOT FILE: z11c310_133.i	SHEET 133 OF 194