




213+00

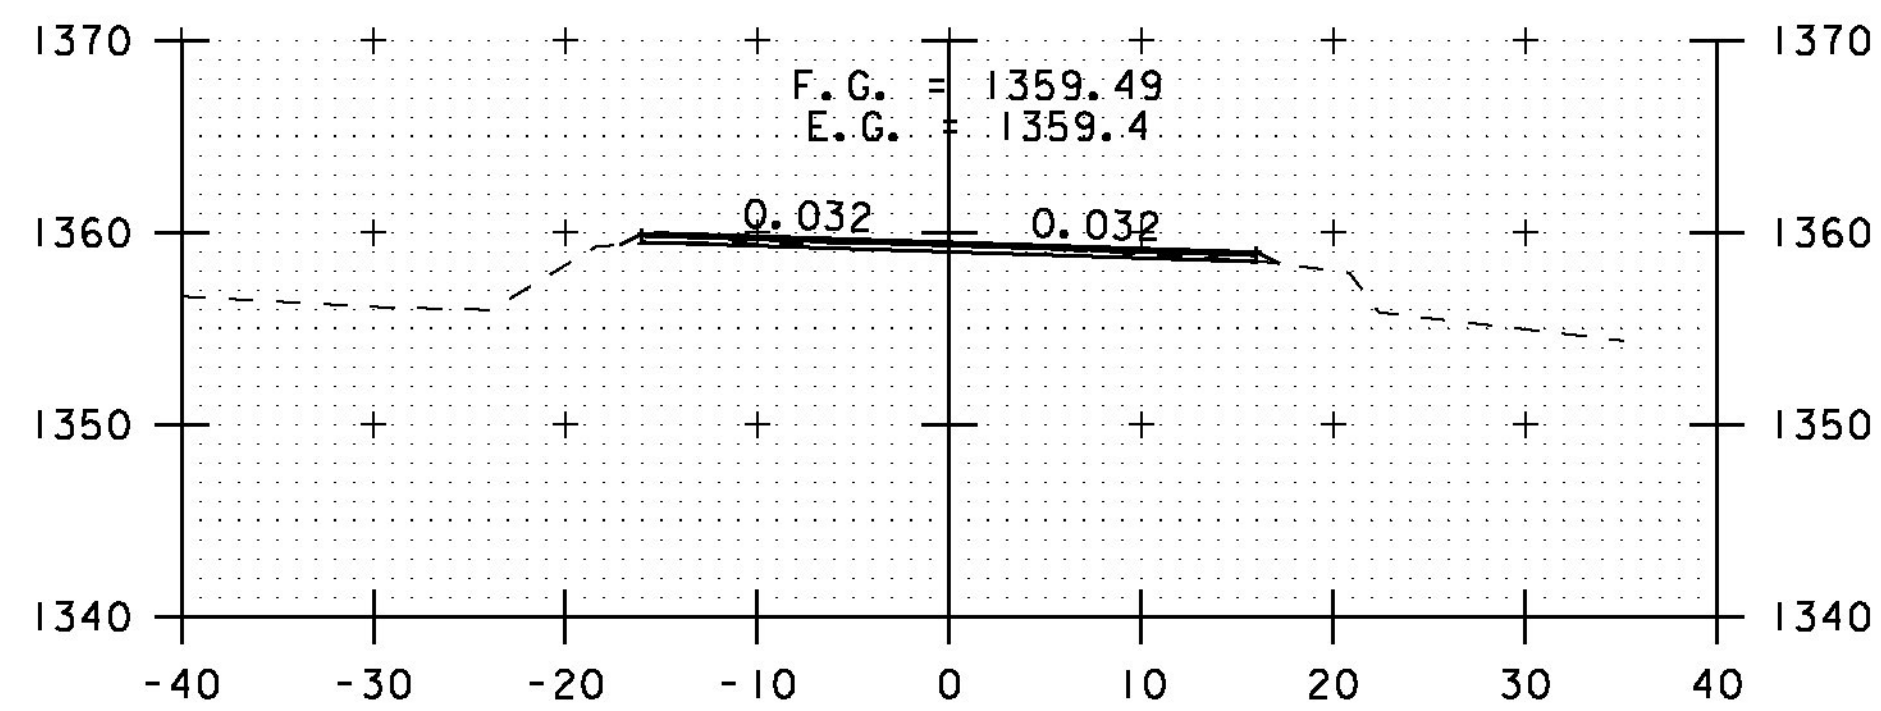


215+00

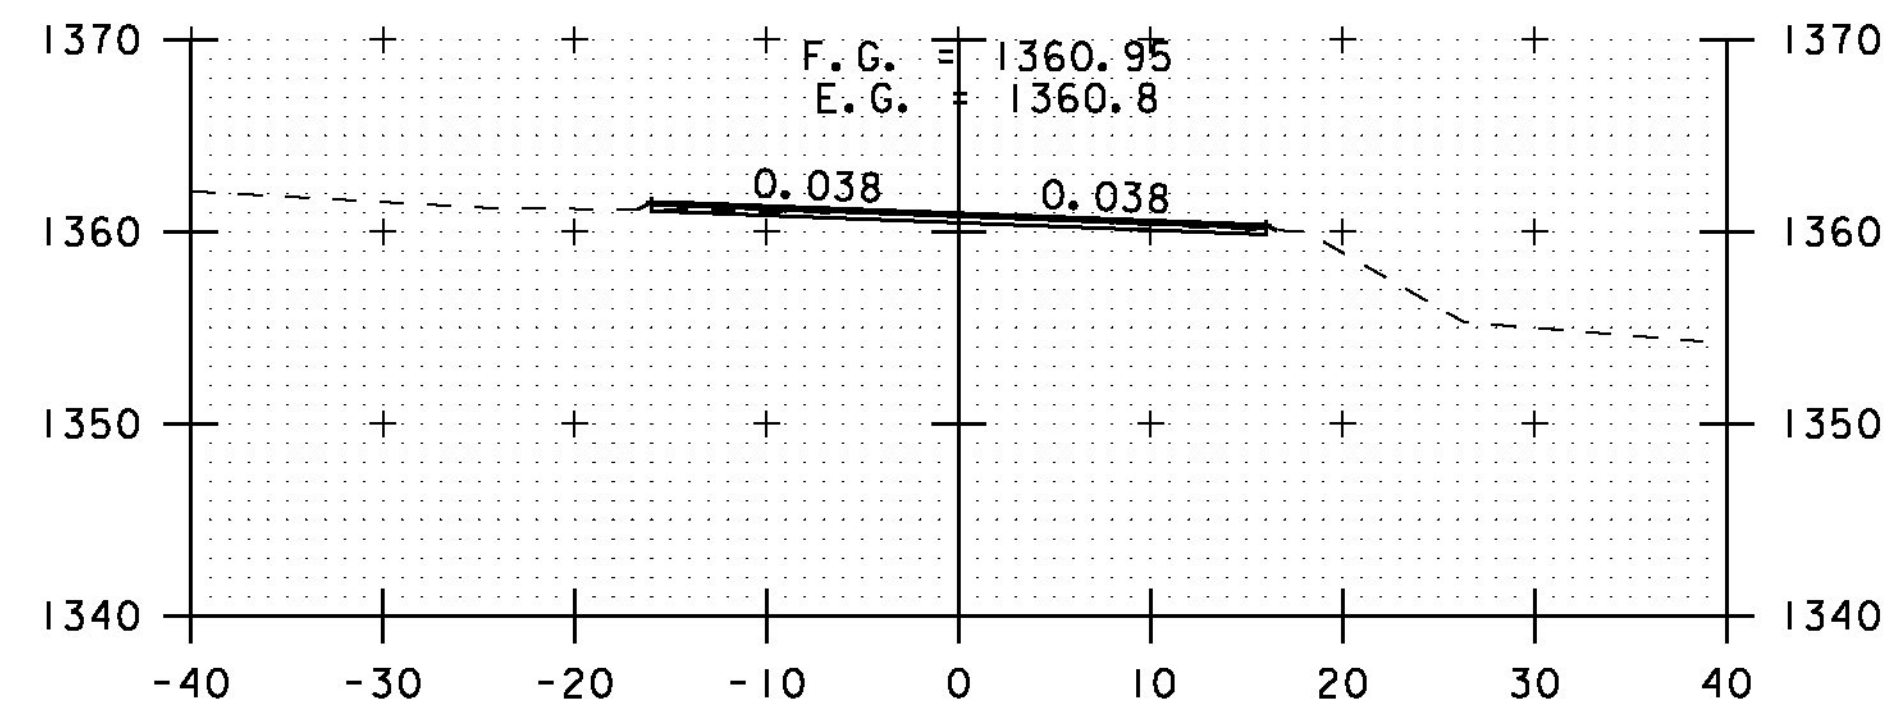


212+50

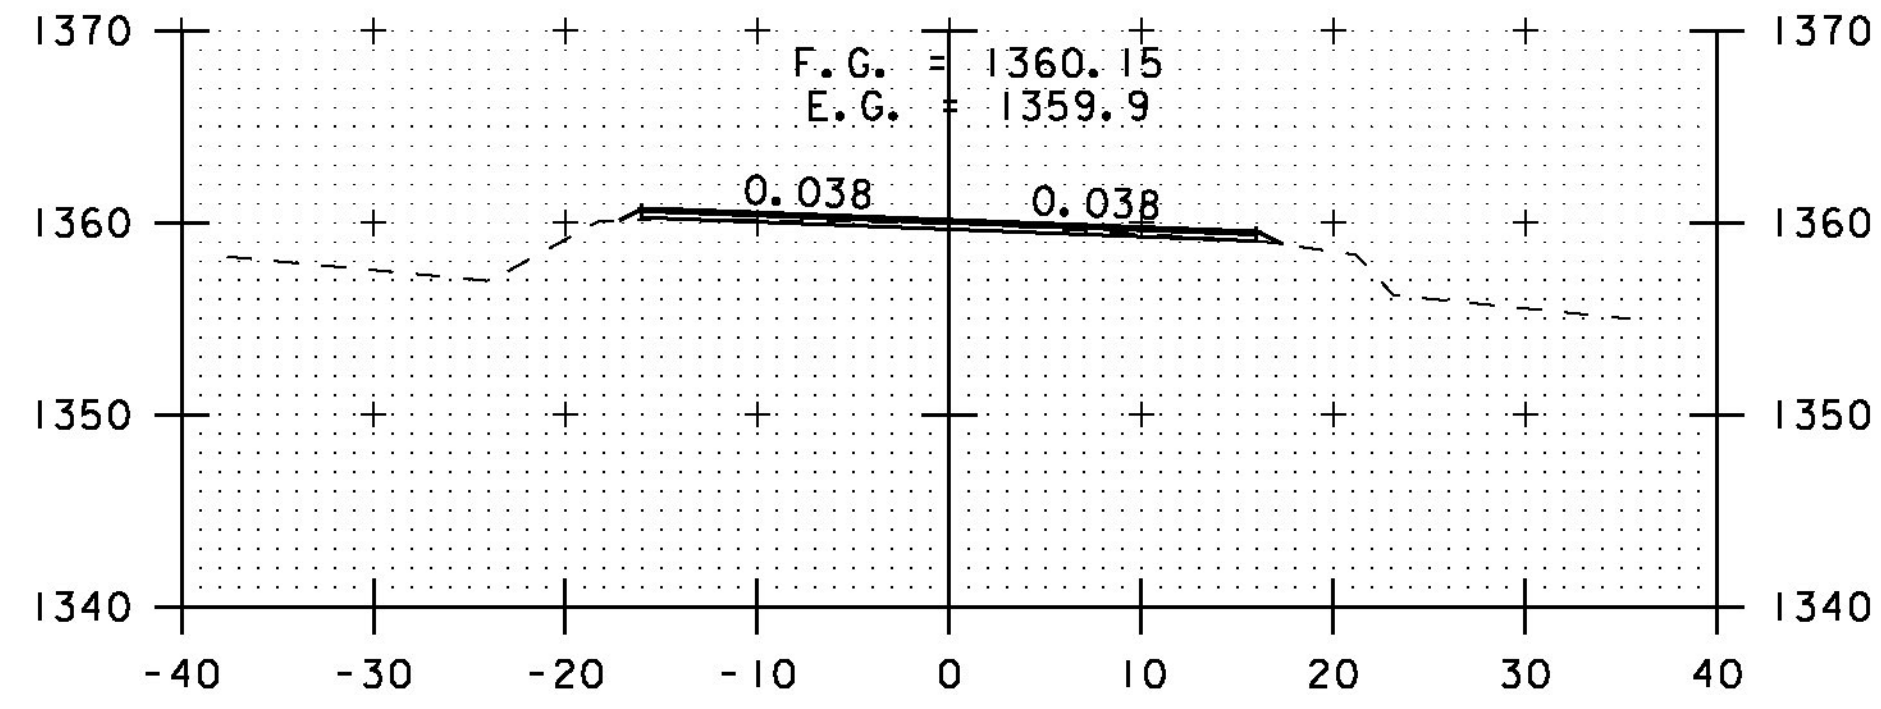


214+50

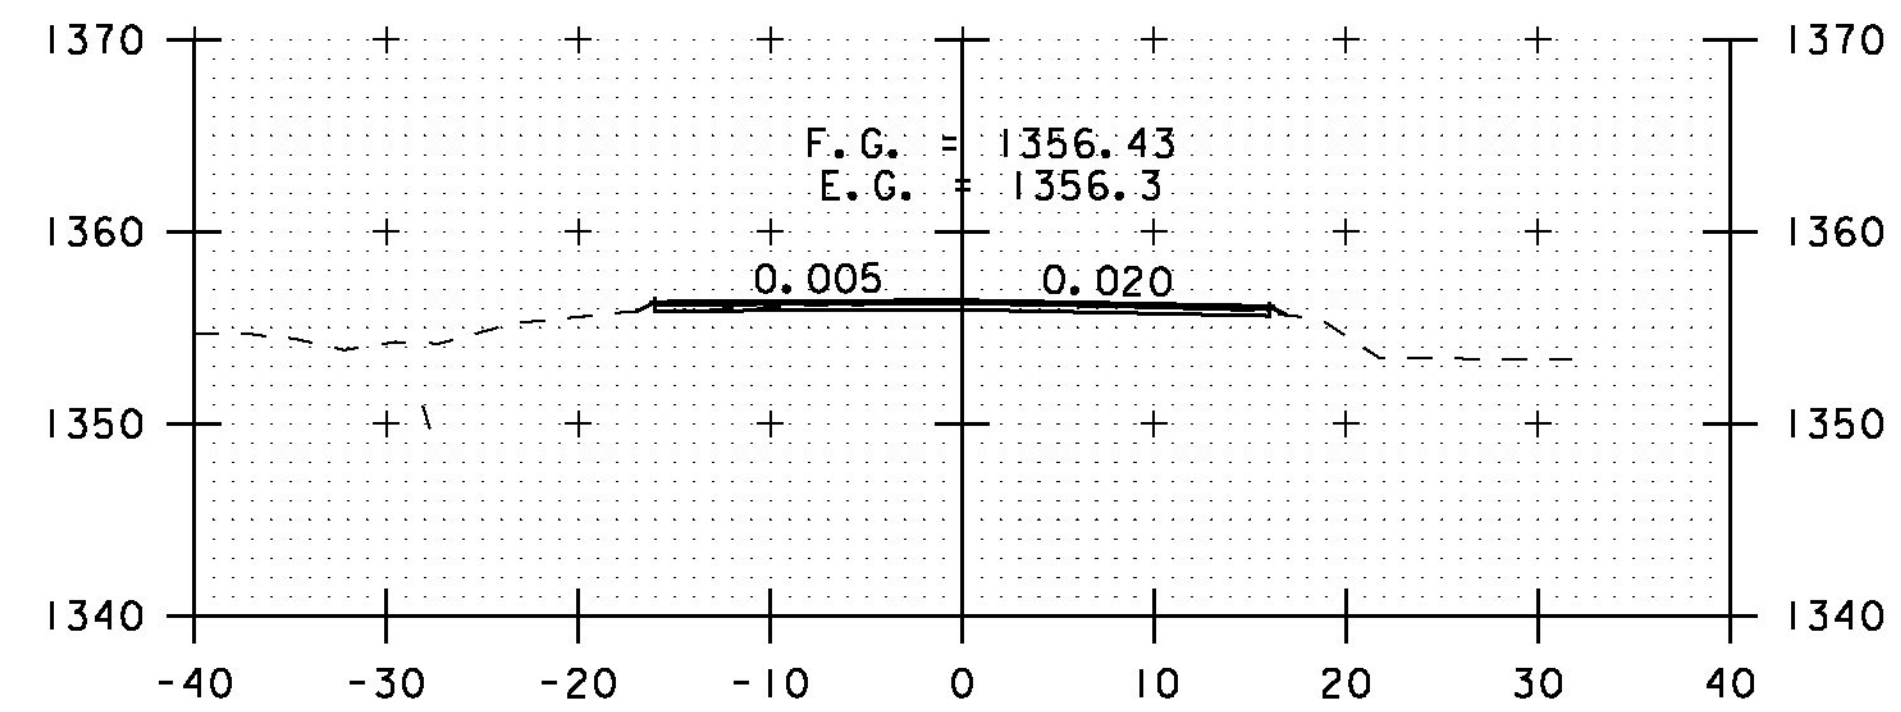


216+50

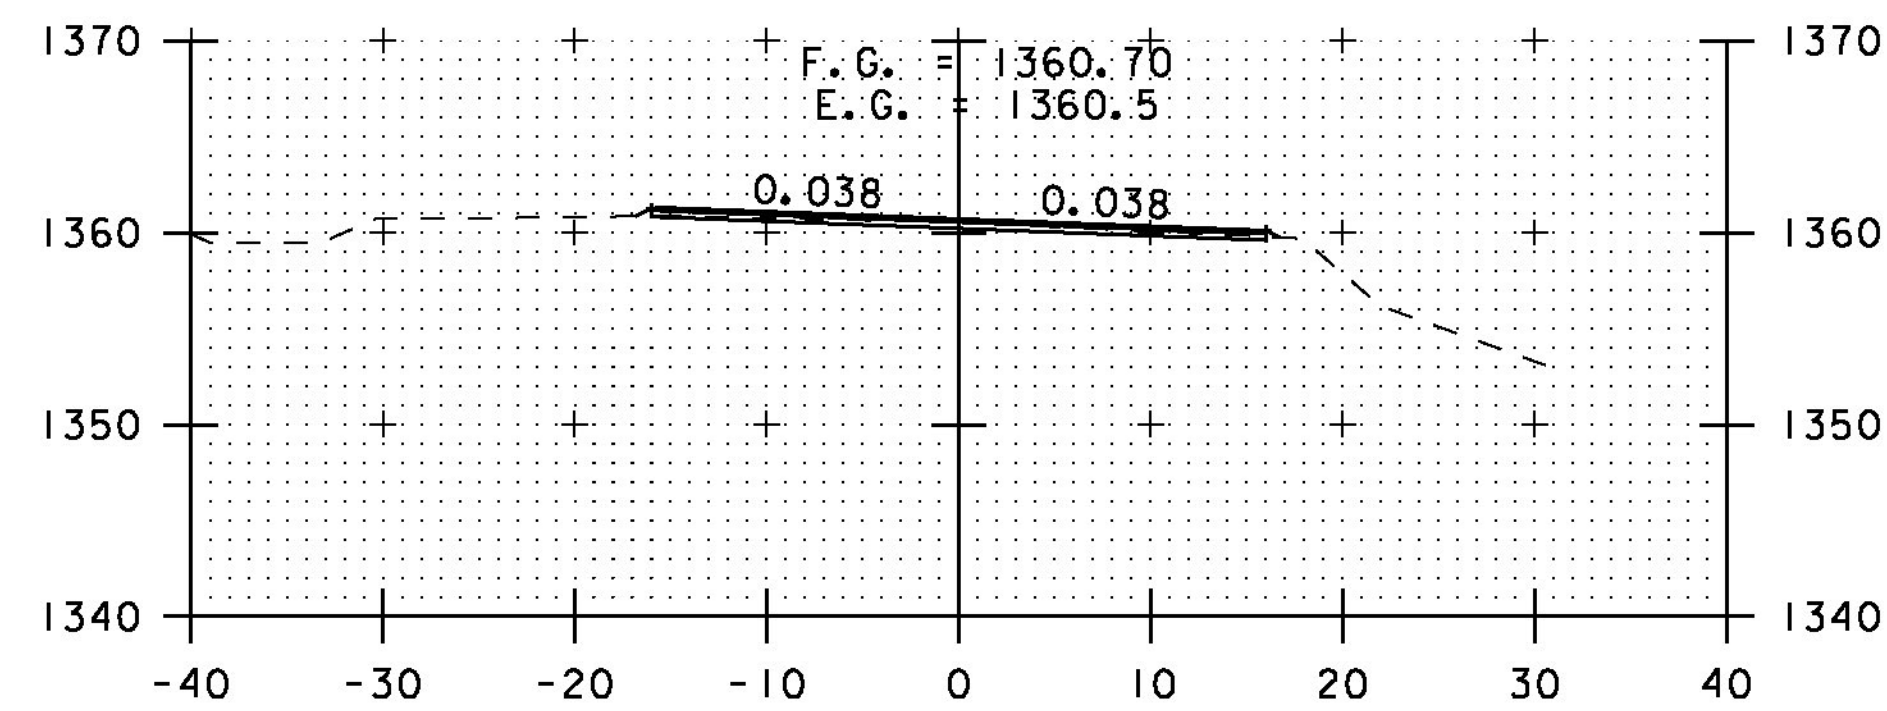


212+00

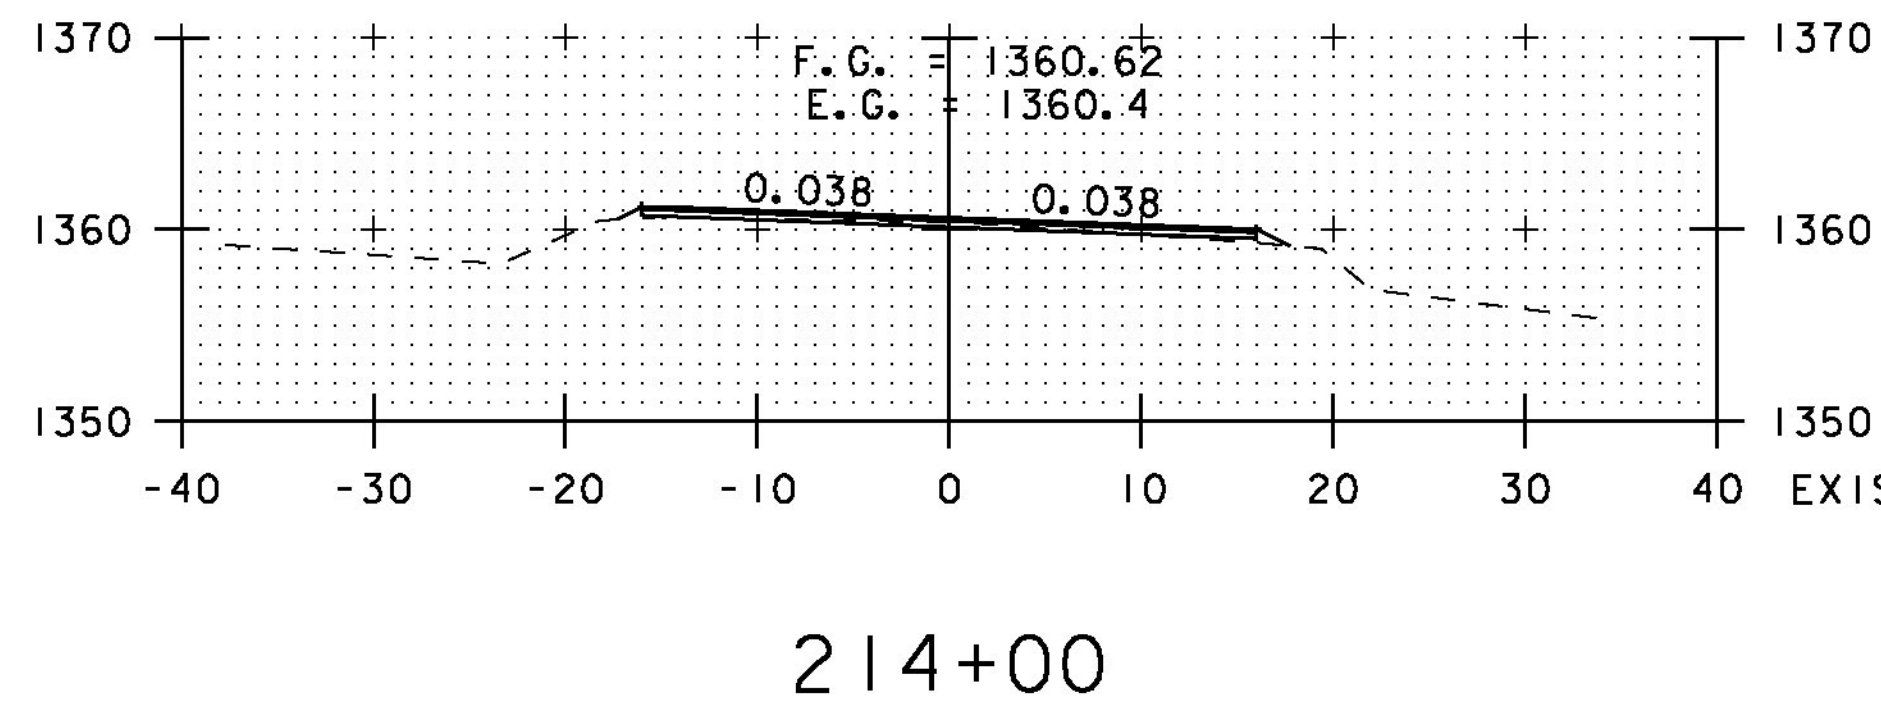


214+00

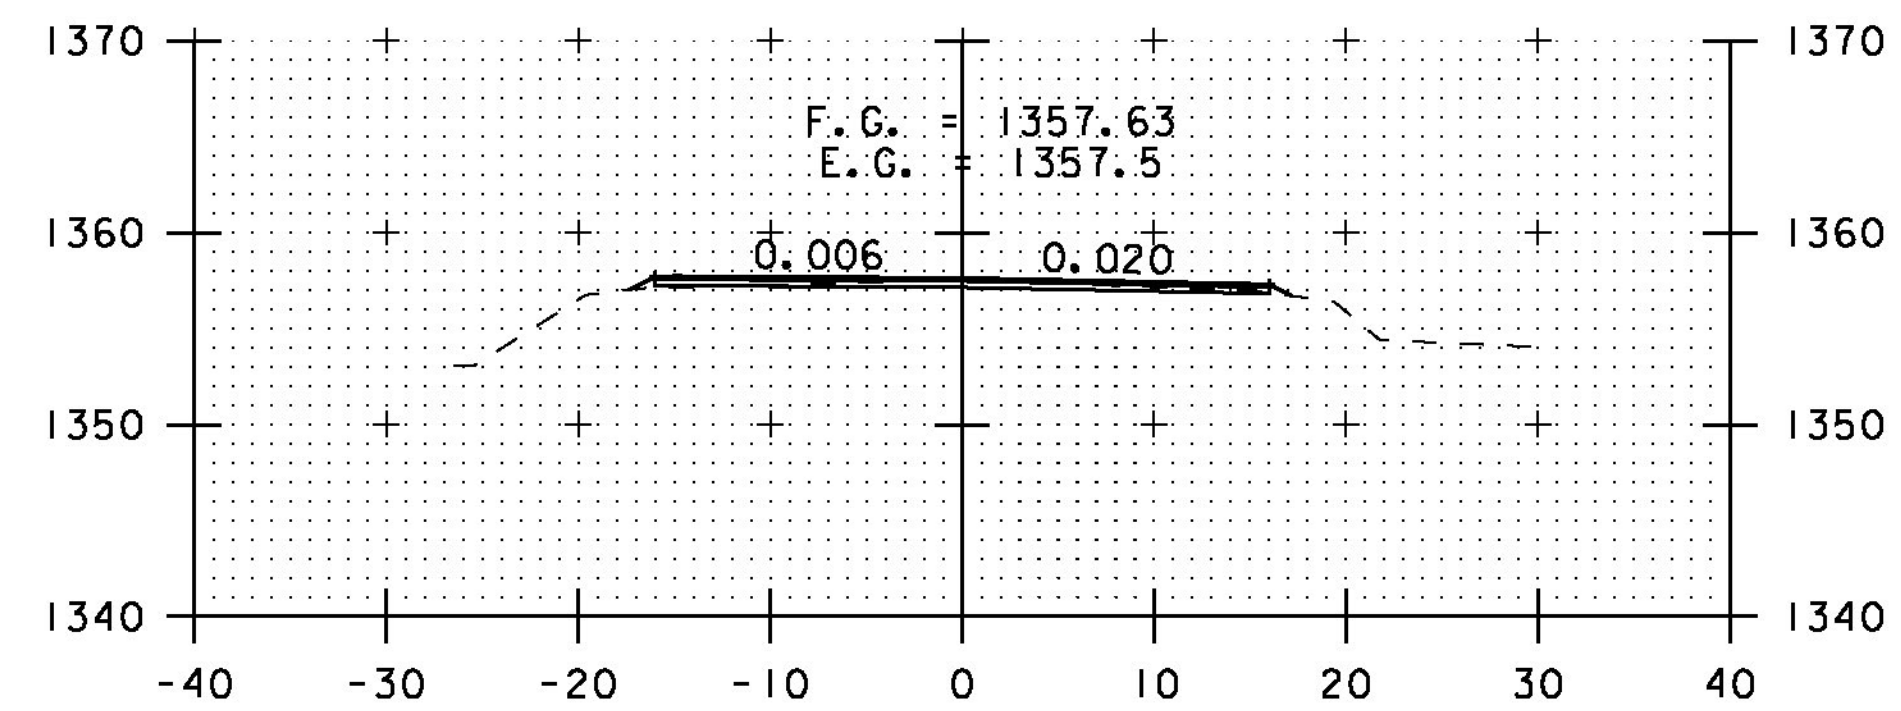


216+00

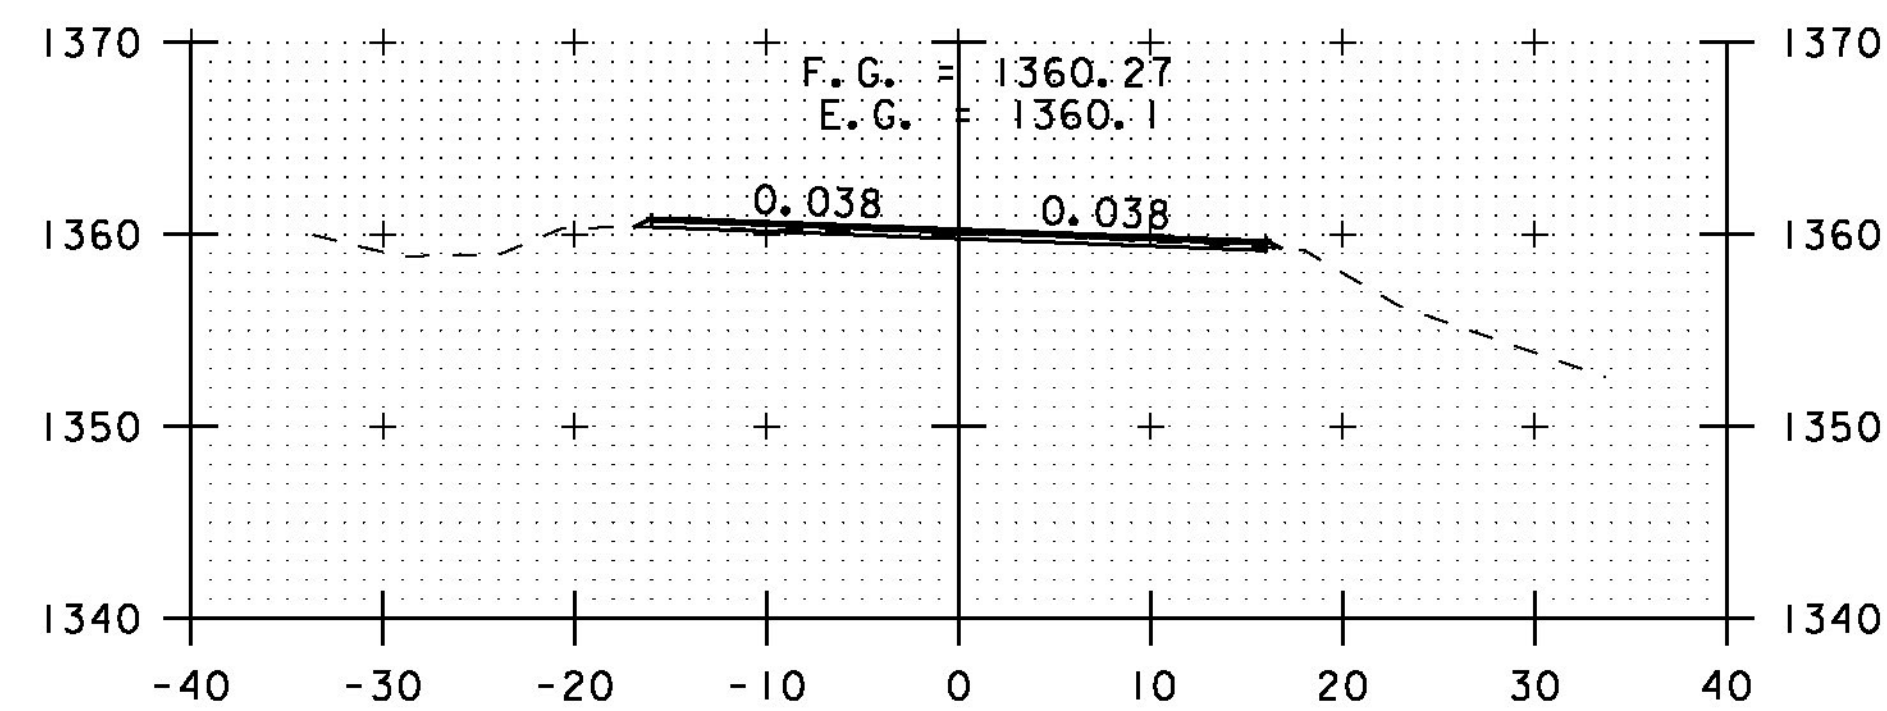

211+50

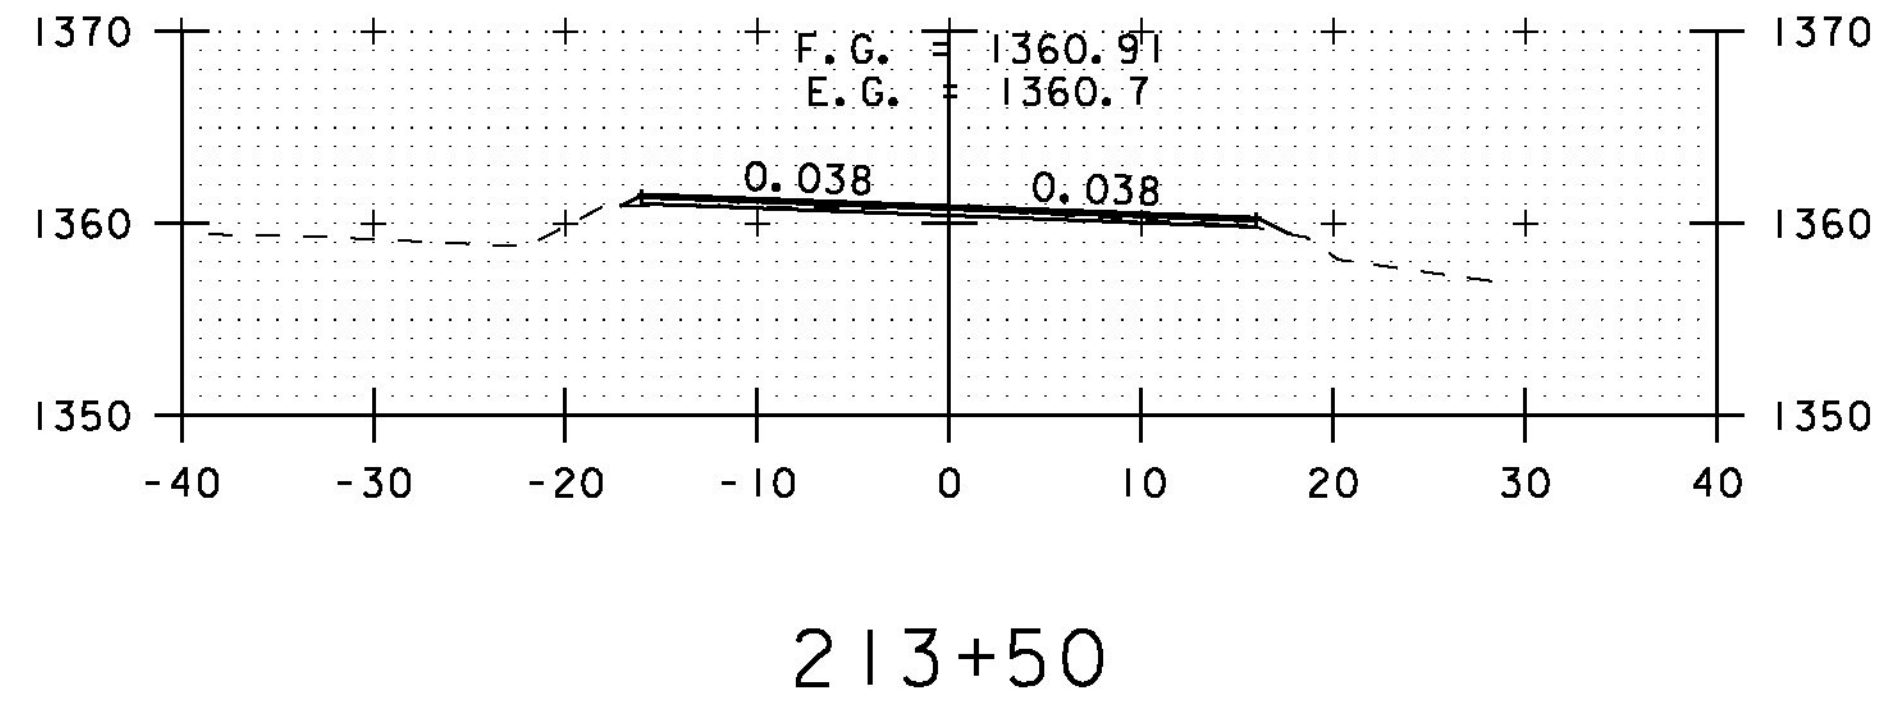

213+50

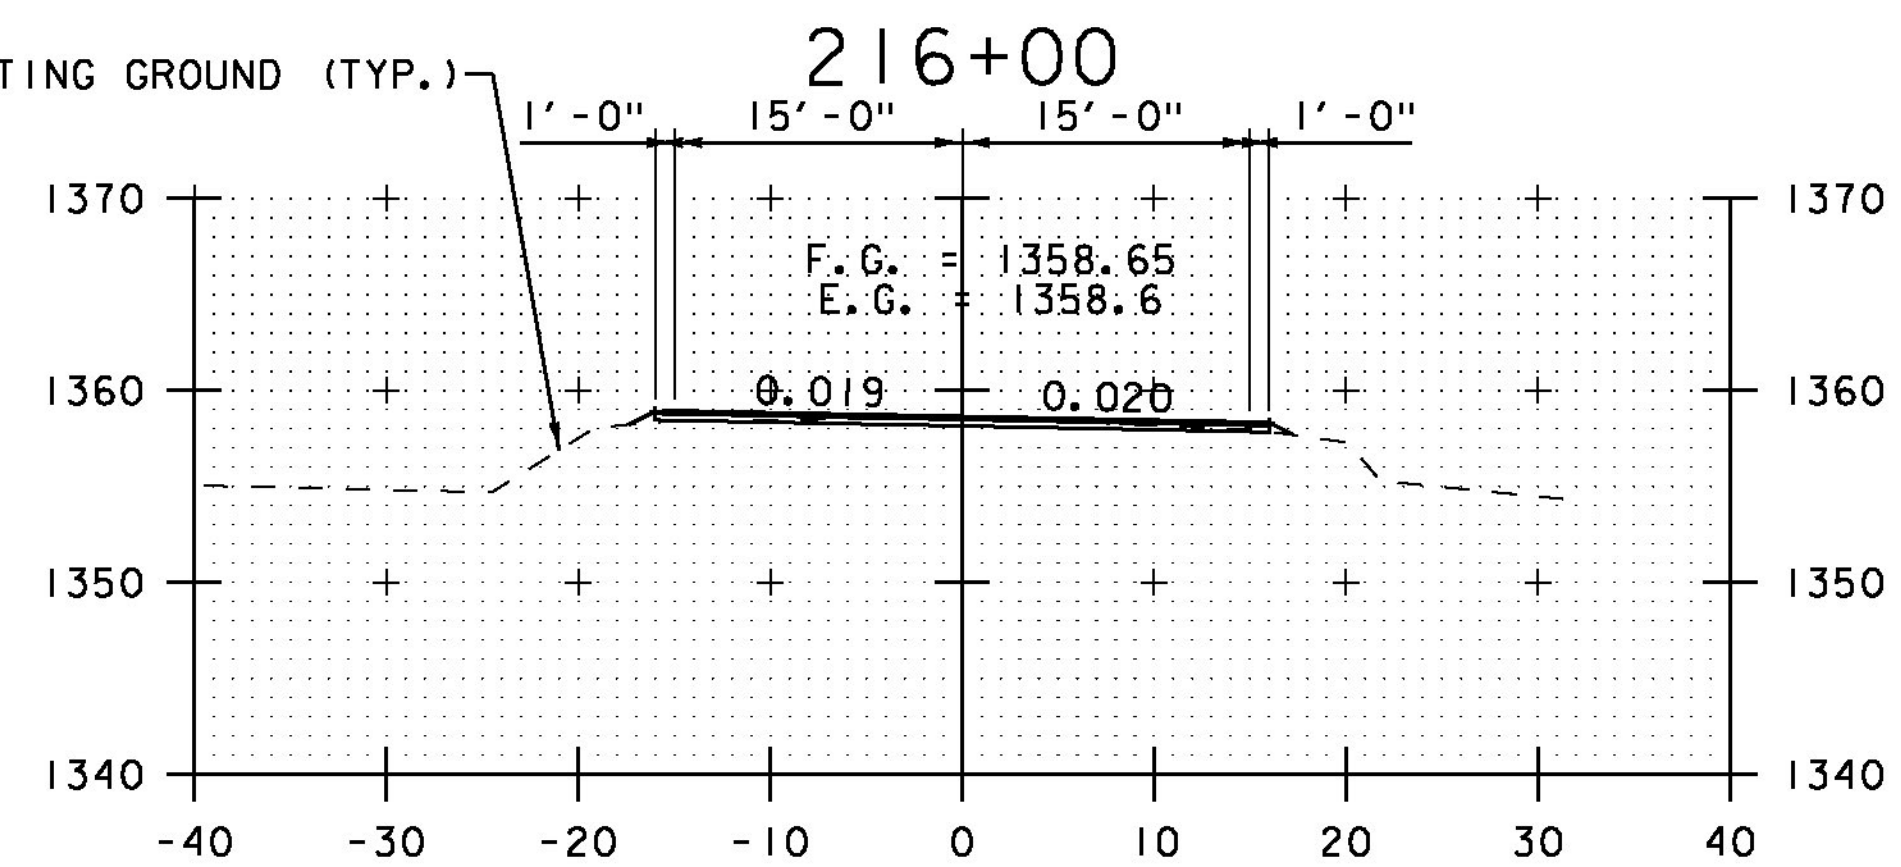

215+50

STA. 211+50 TO STA. 216+50



CROSS SECTION SHEET 6

PROJECT NAME: ELMORE-MORRISTOWN

PROJECT NUMBER: STP 2937 (I)

FILE NAME: z11c310.dgn

PROJECT LEADER: C. LATHROP

DESIGNED BY: S. LAMPHERE

PLOT FILE: z11c310_134.i

PLOT DATE: 3/3/14

DRAWN BY: B. MARTIN

CHECKED BY: C. LATHROP

SHEET 134 OF 194