




218+50

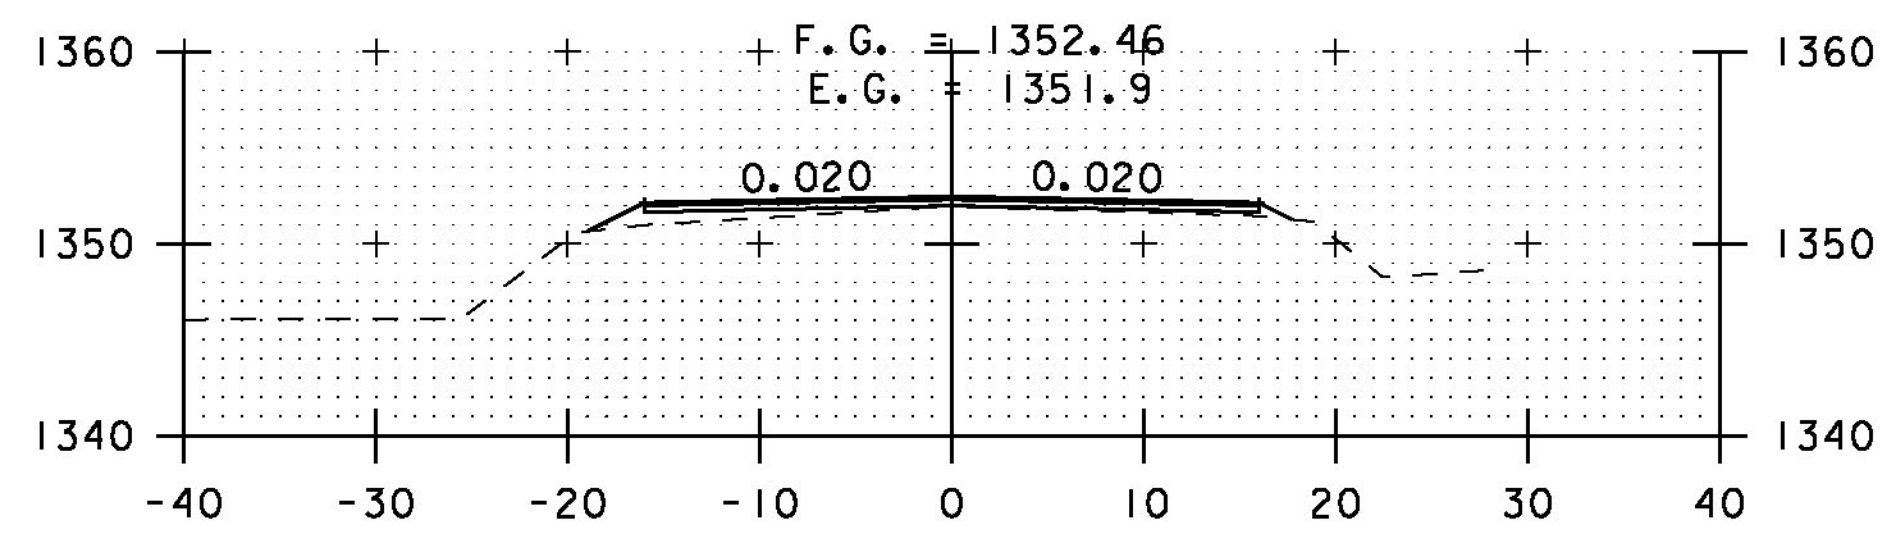


218+00

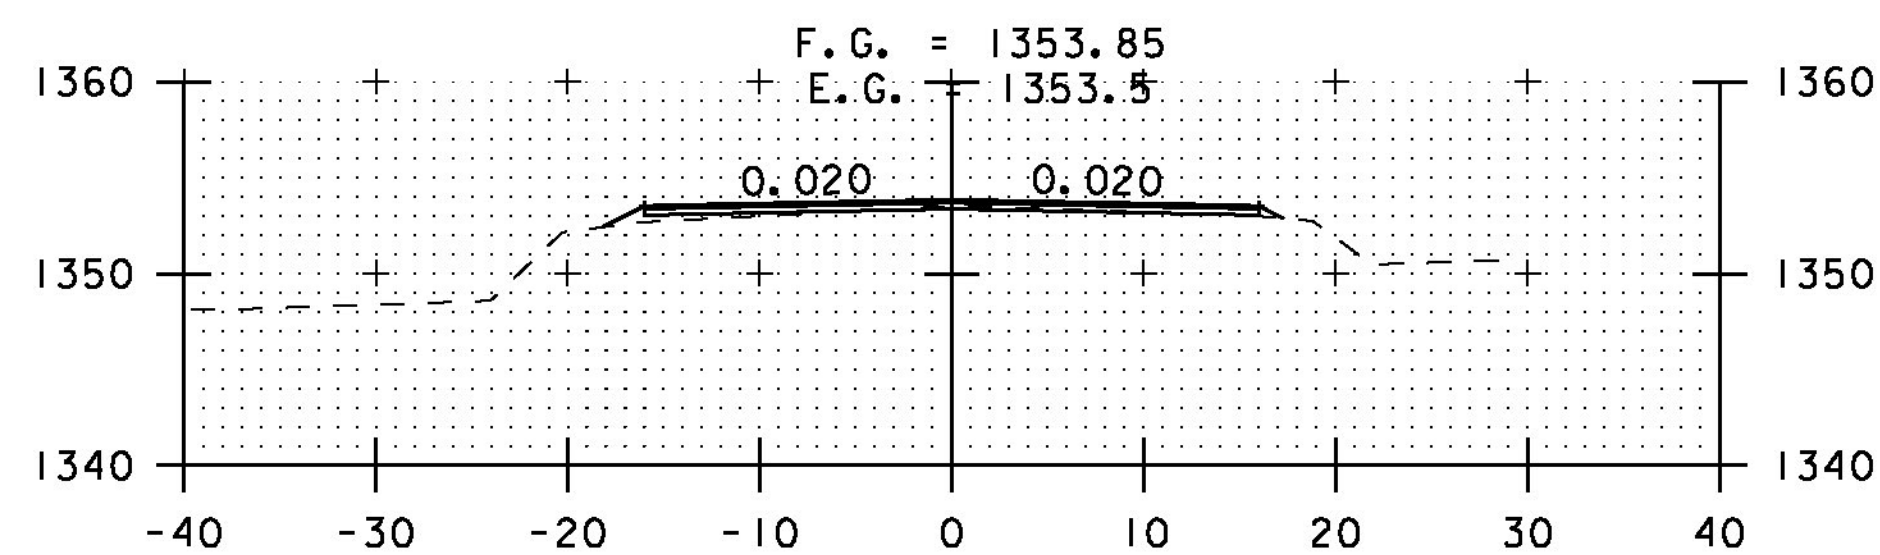


217+50

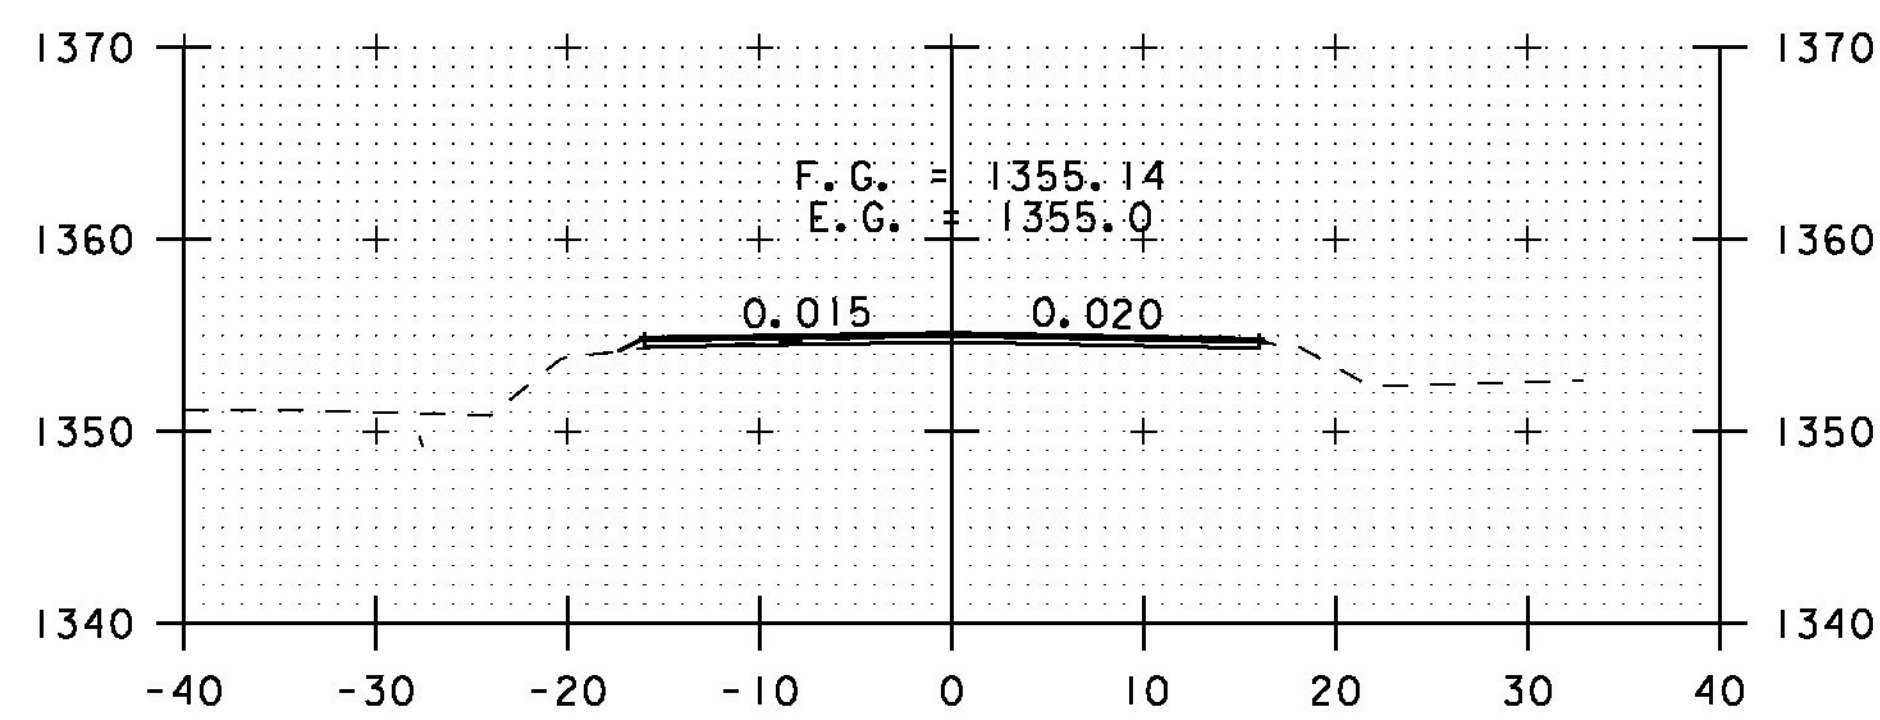


217+00

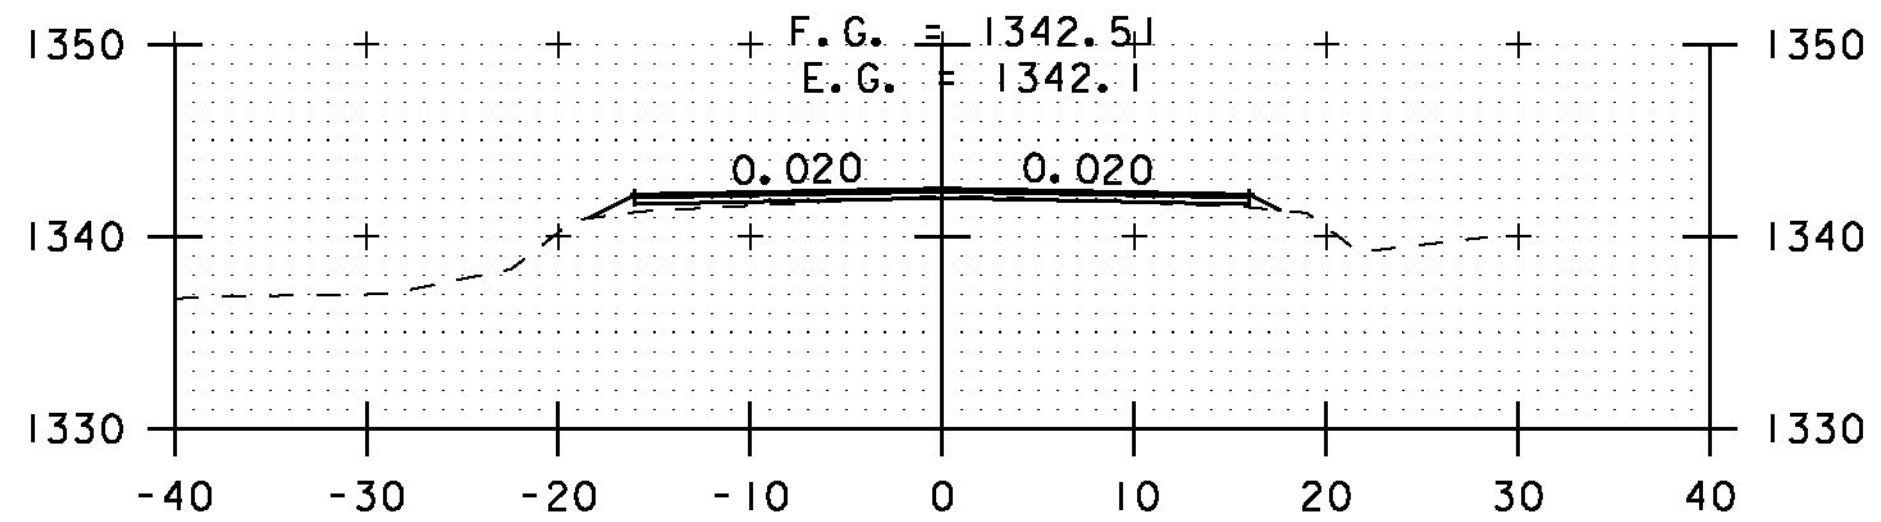


220+50

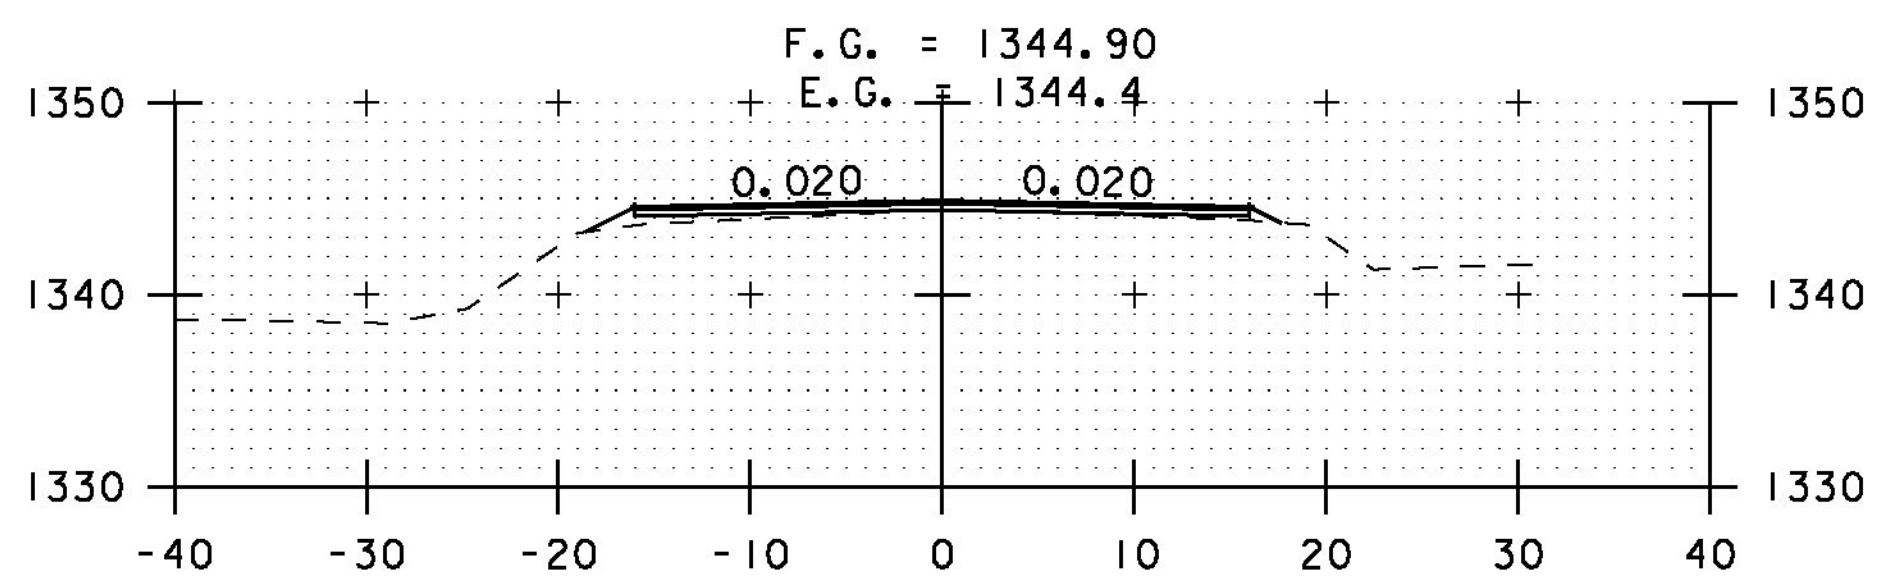


220+00

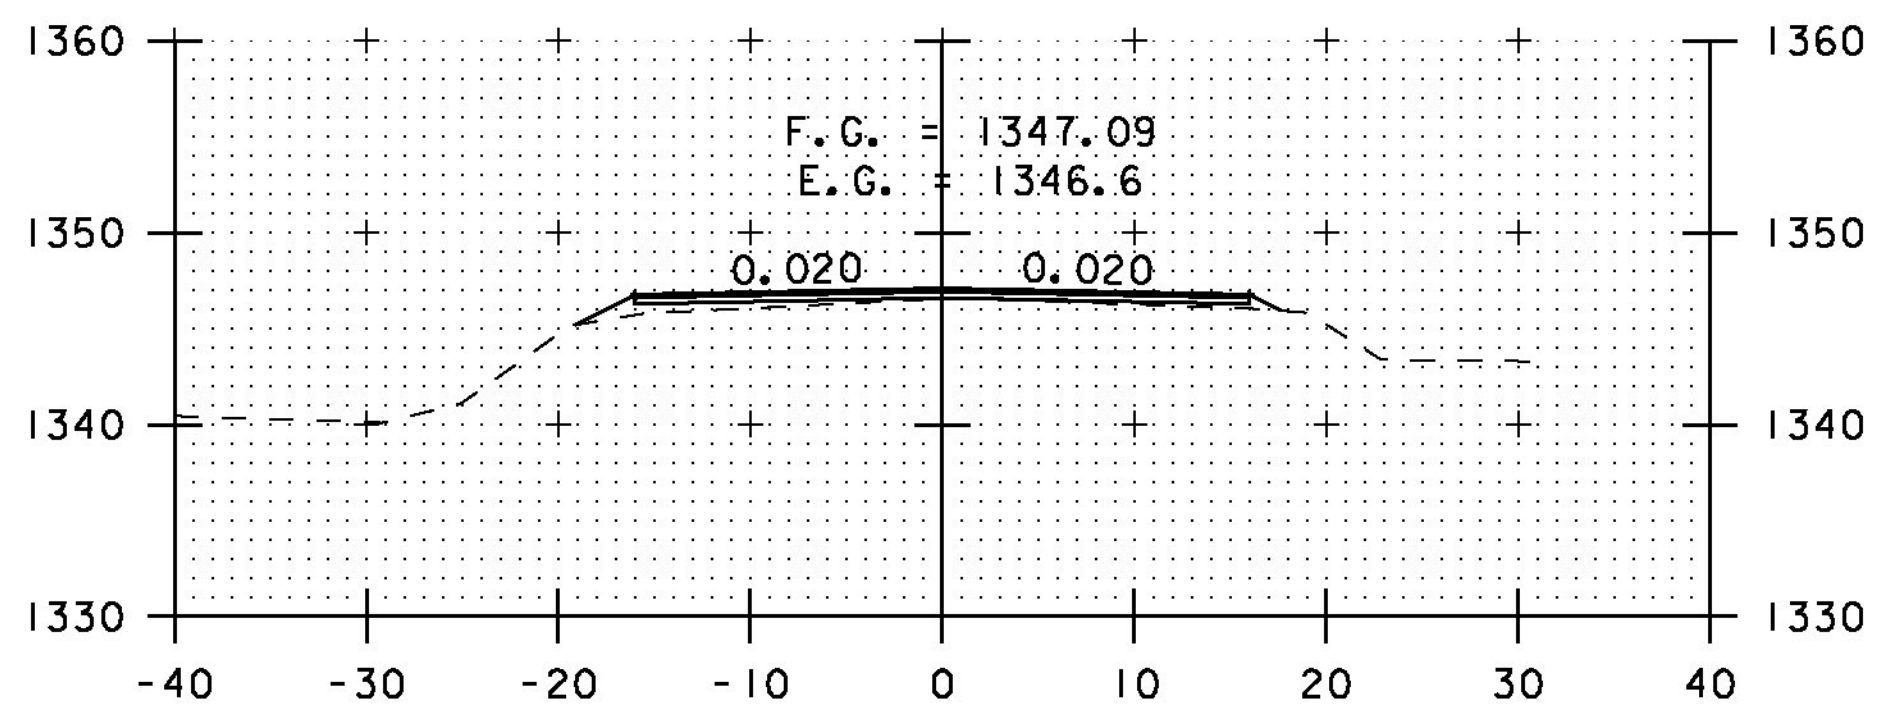


219+50

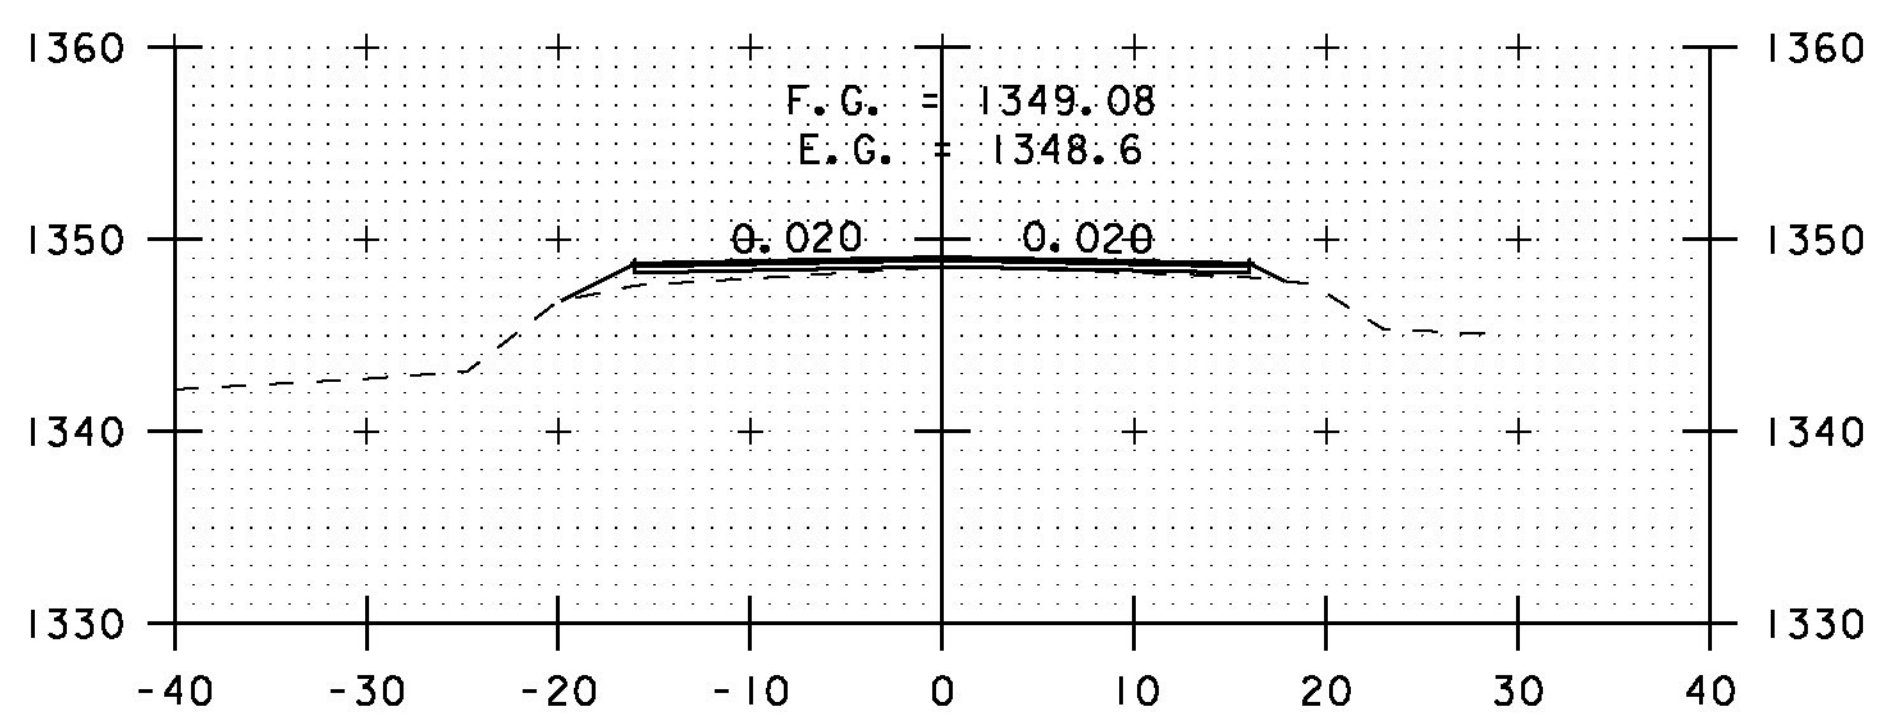


219+00

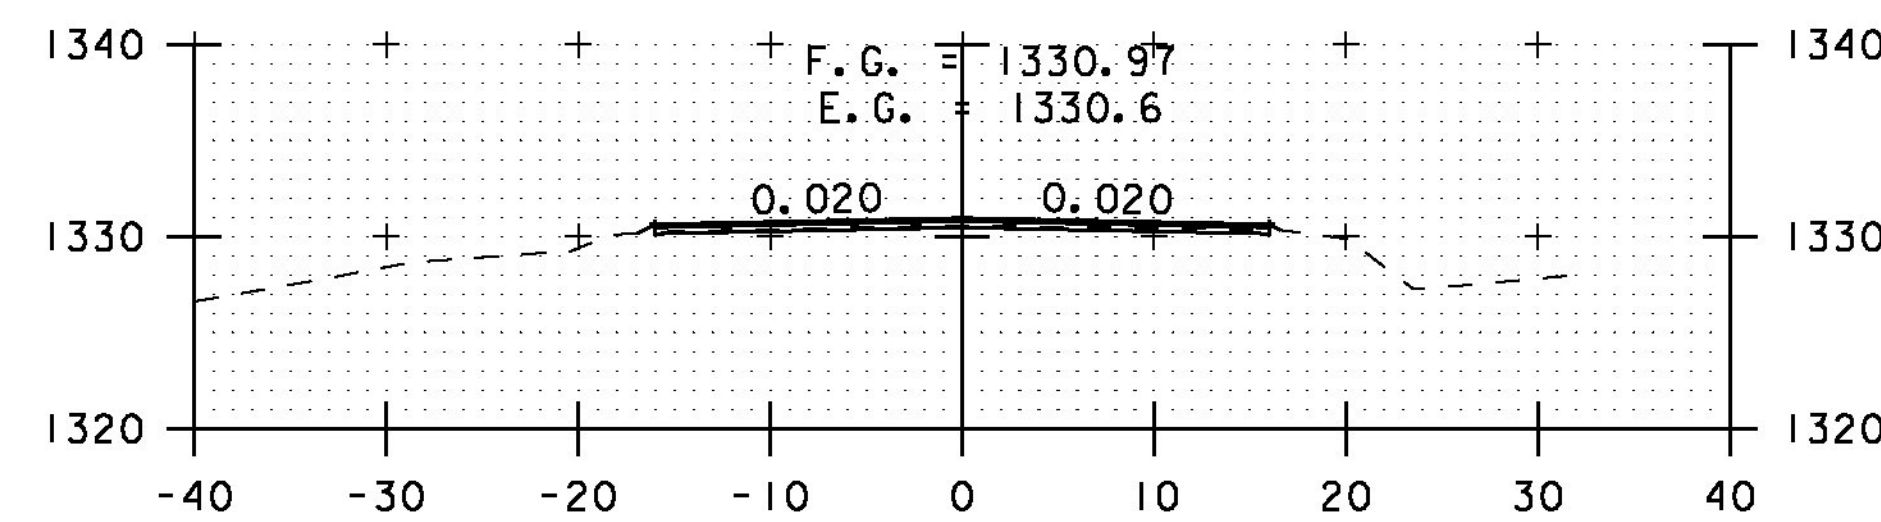


222+50

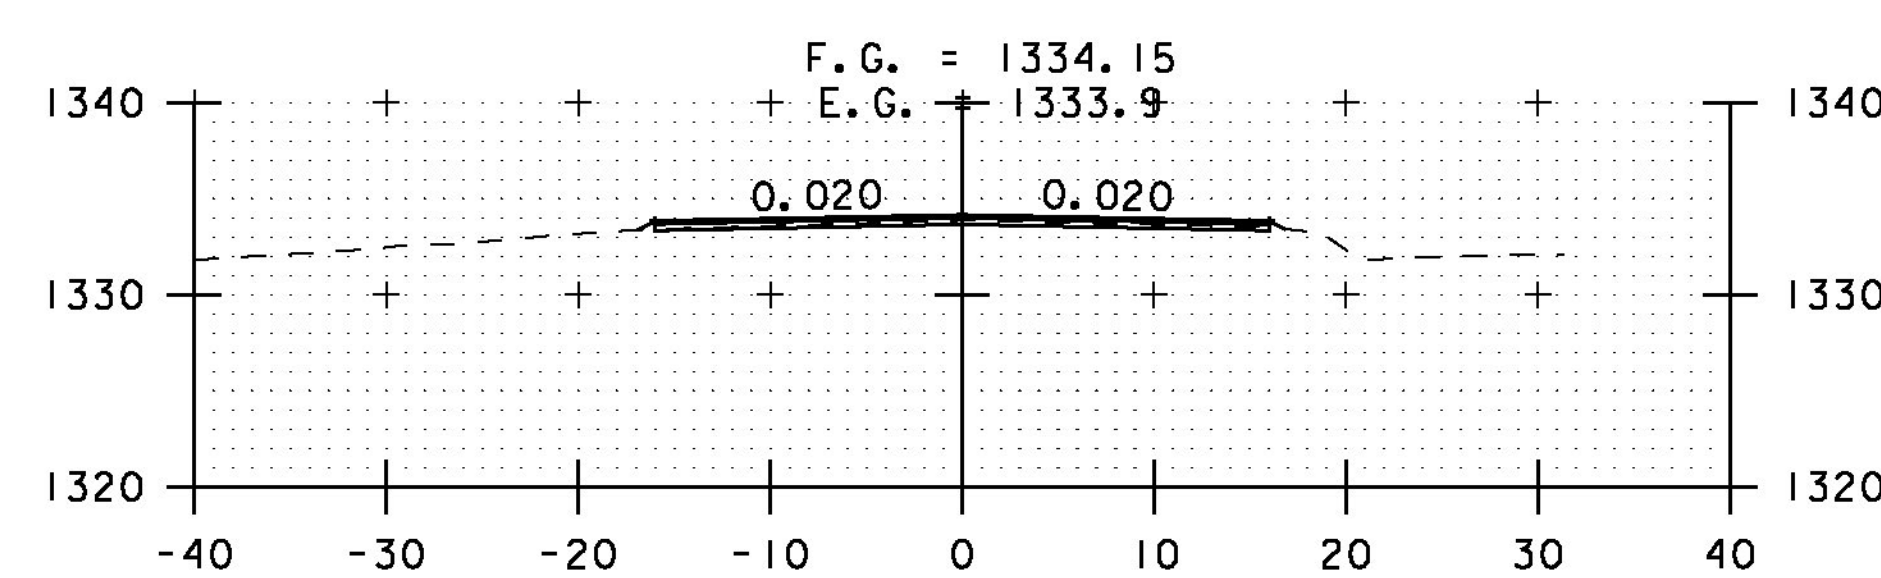

222+00

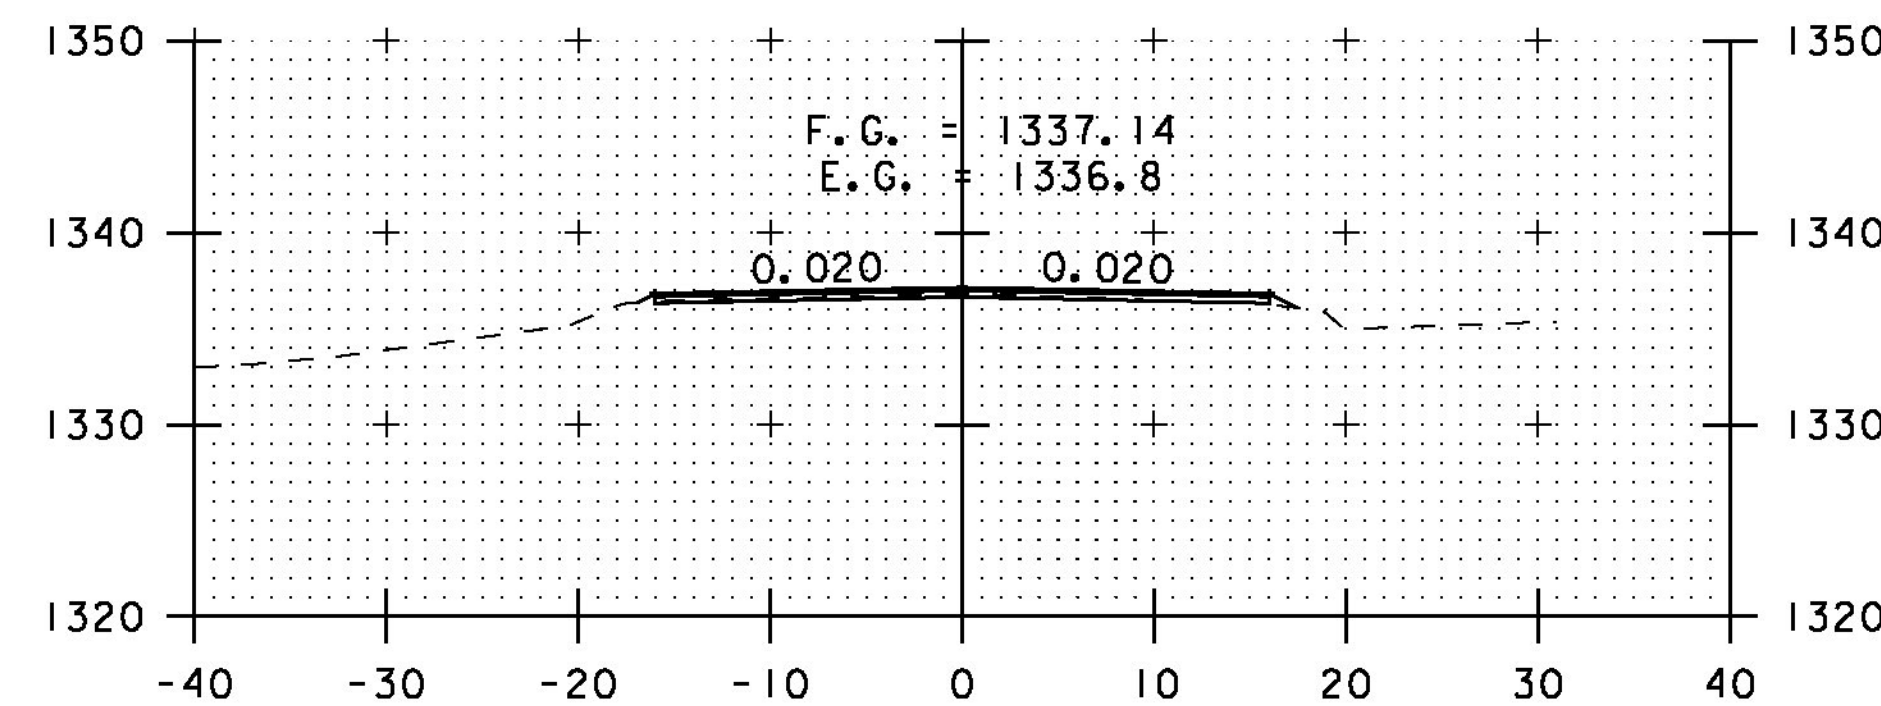

221+50

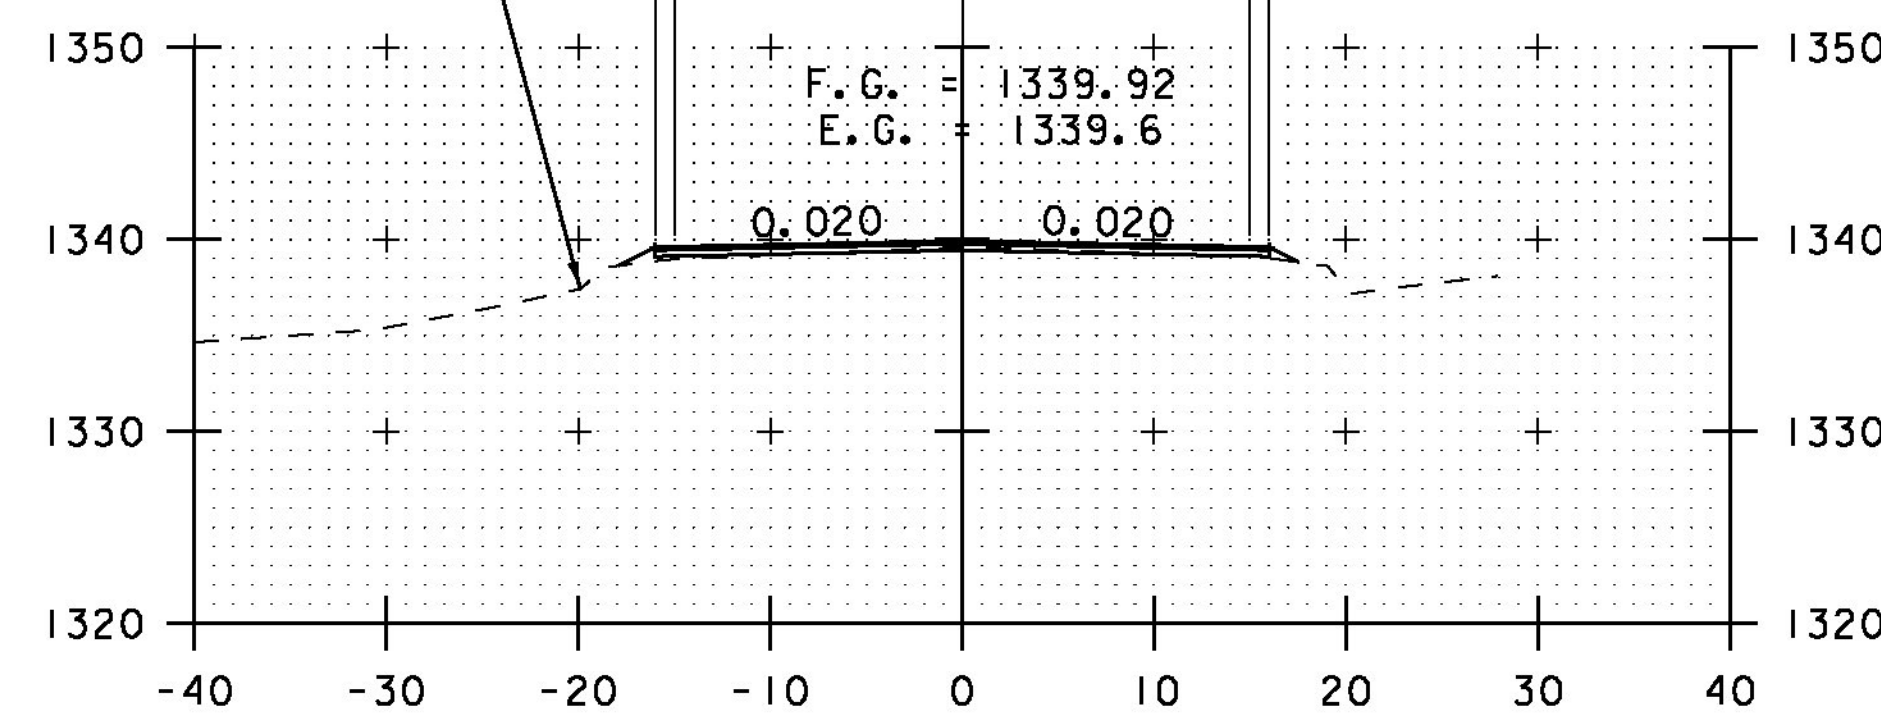

221+00

STA. 217+00 TO STA. 222+50



**CROSS SECTION SHEET 7**

PROJECT NAME: ELMORE-MORRISTOWN

PROJECT NUMBER: STP 2937 (1)

FILE NAME: z11c310.dgn

PROJECT LEADER: C. LATHROP

DESIGNED BY: S. LAMPHERE

PLOT FILE: z11c310\_135.i

PLOT DATE: 3/3/14

DRAWN BY: B. MARTIN

CHECKED BY: C. LATHROP

SHEET 135 OF 194