




224+50

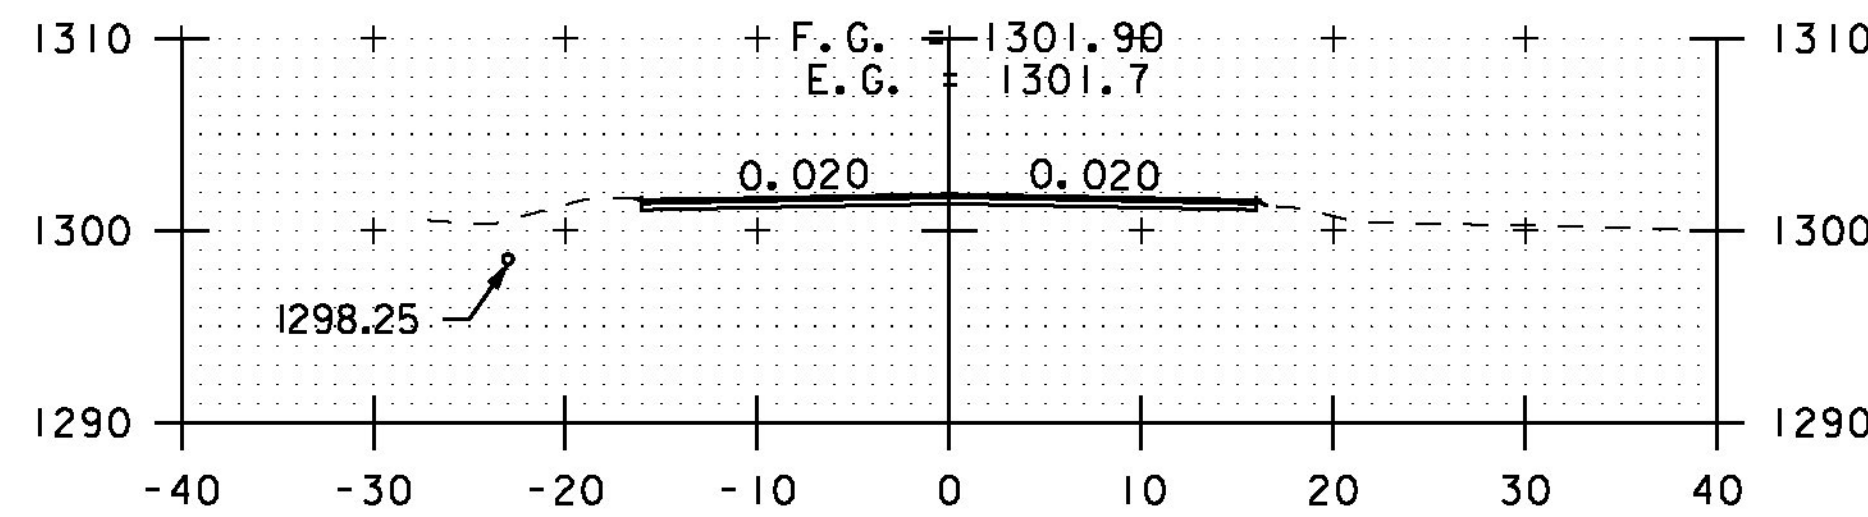


226+50

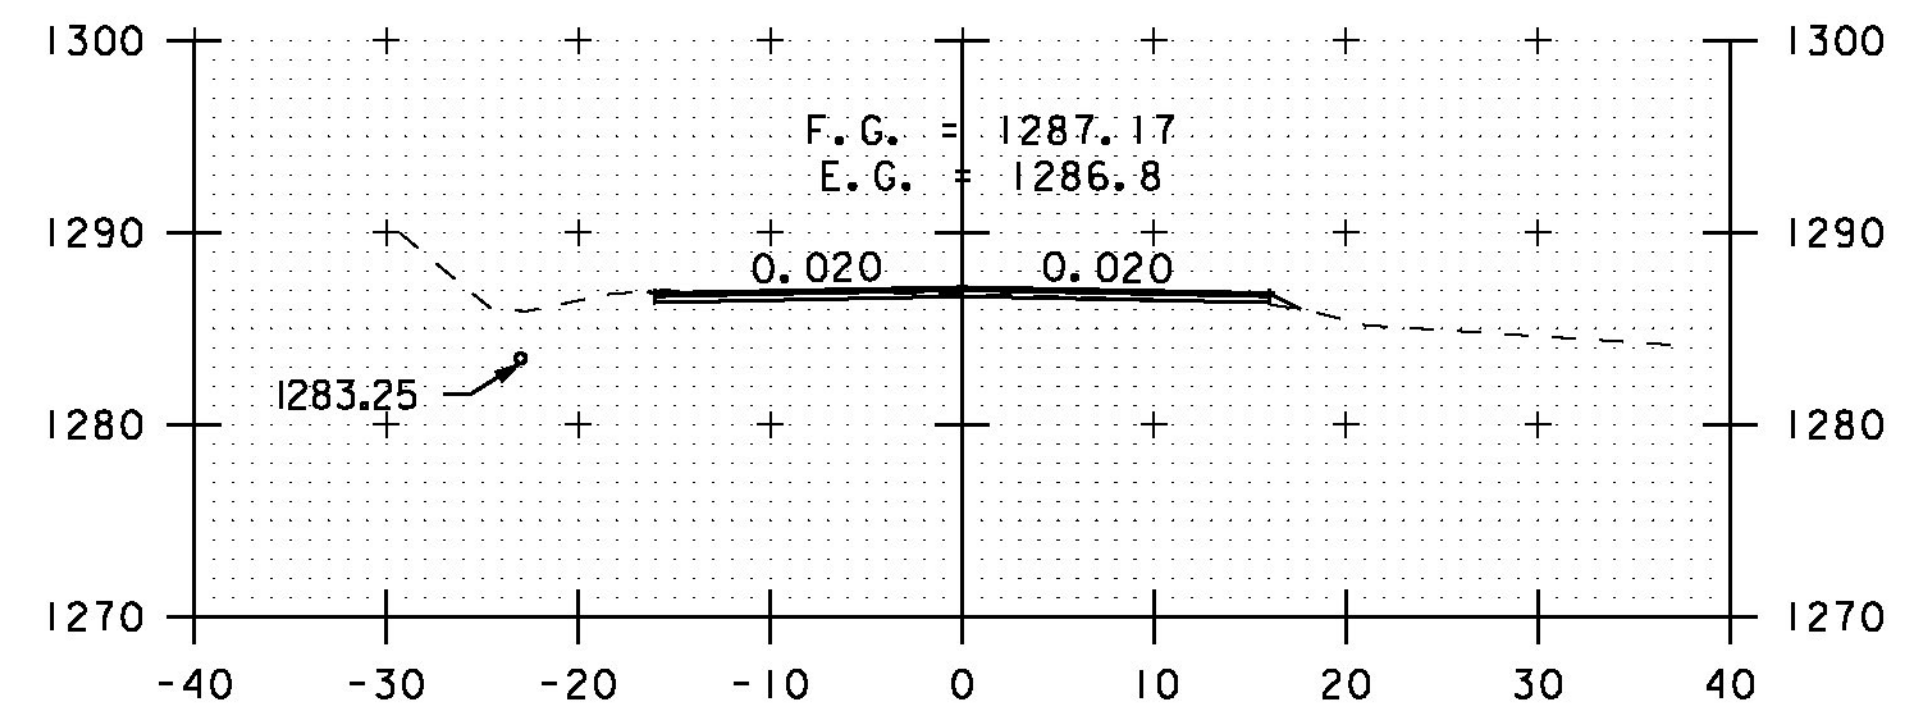


228+50

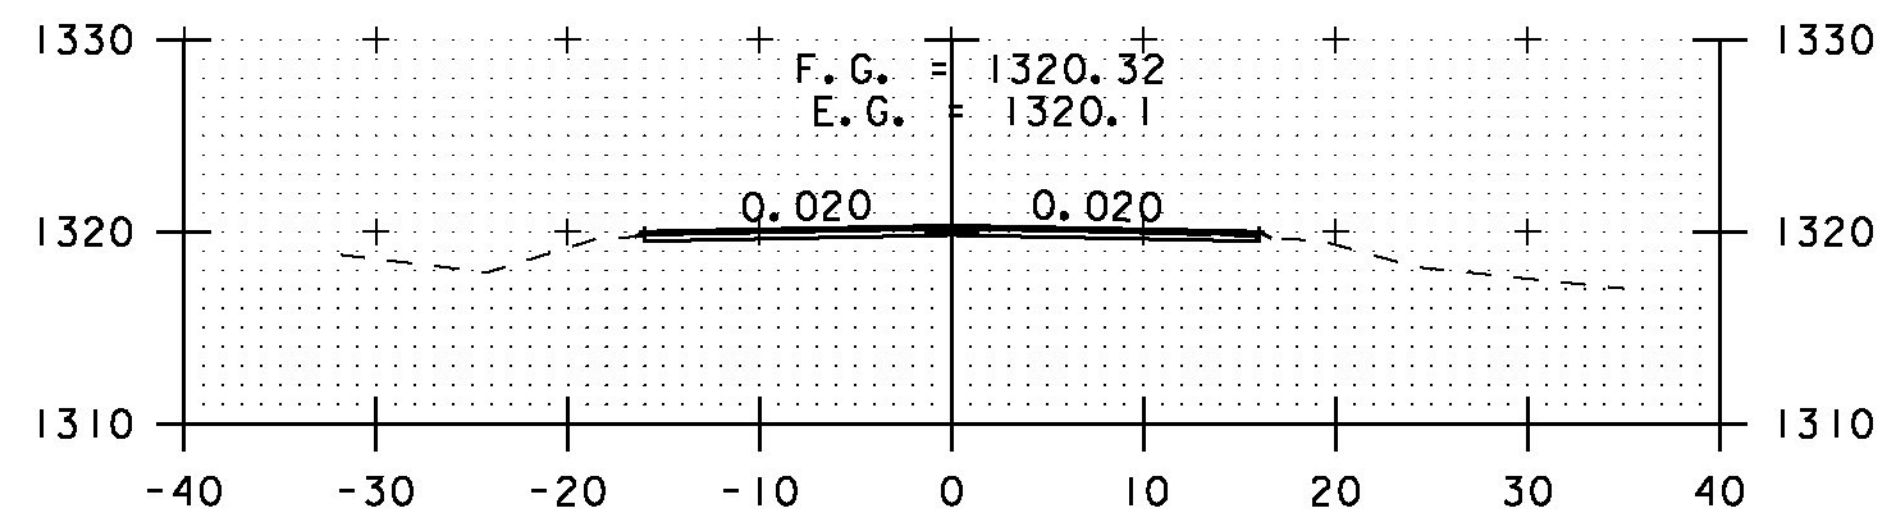


224+00

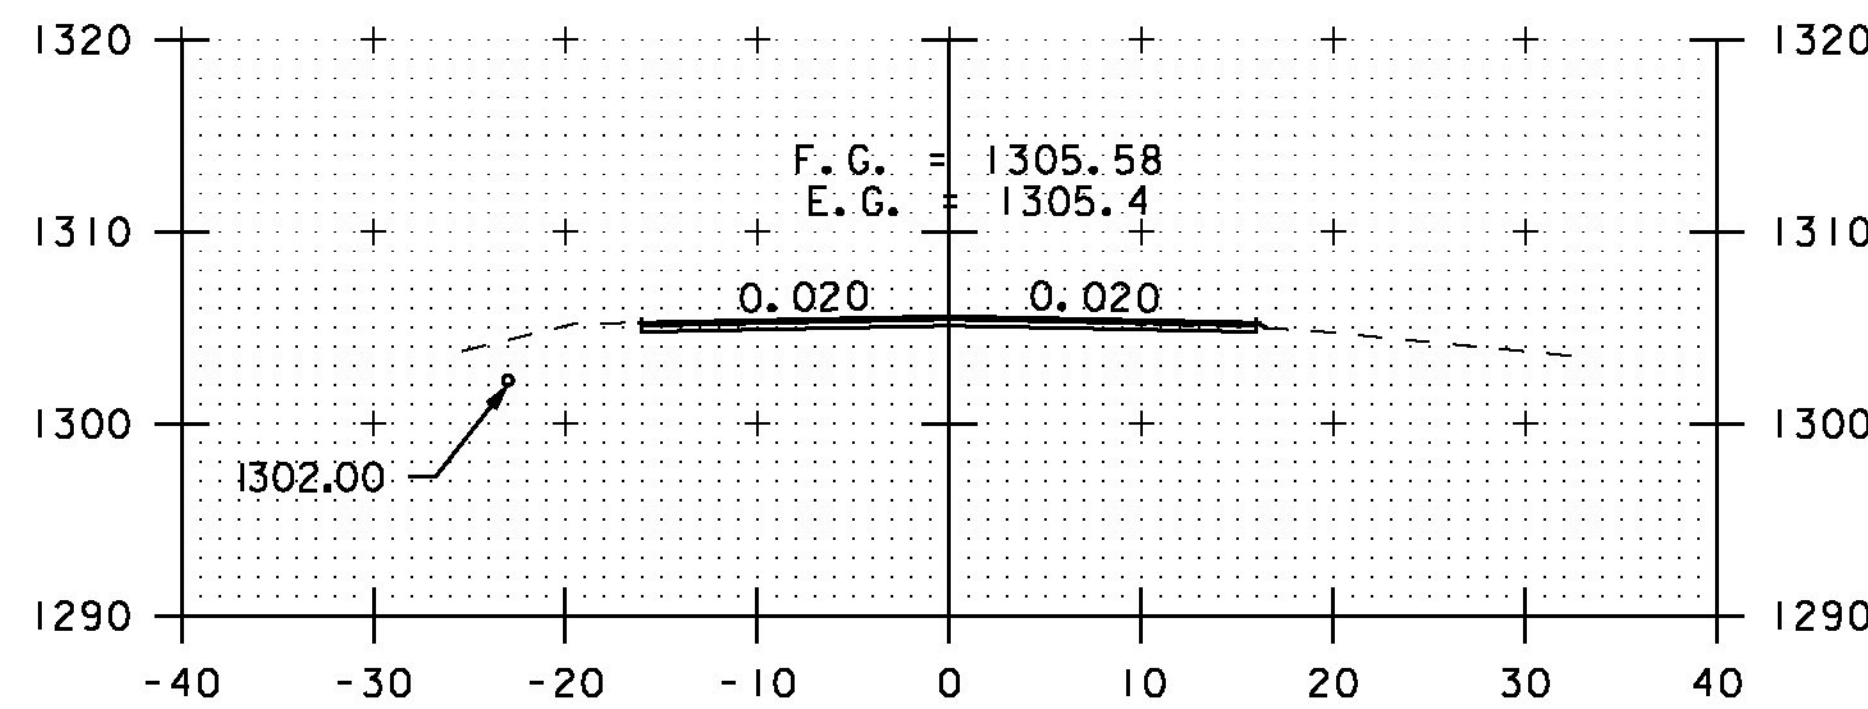


226+00

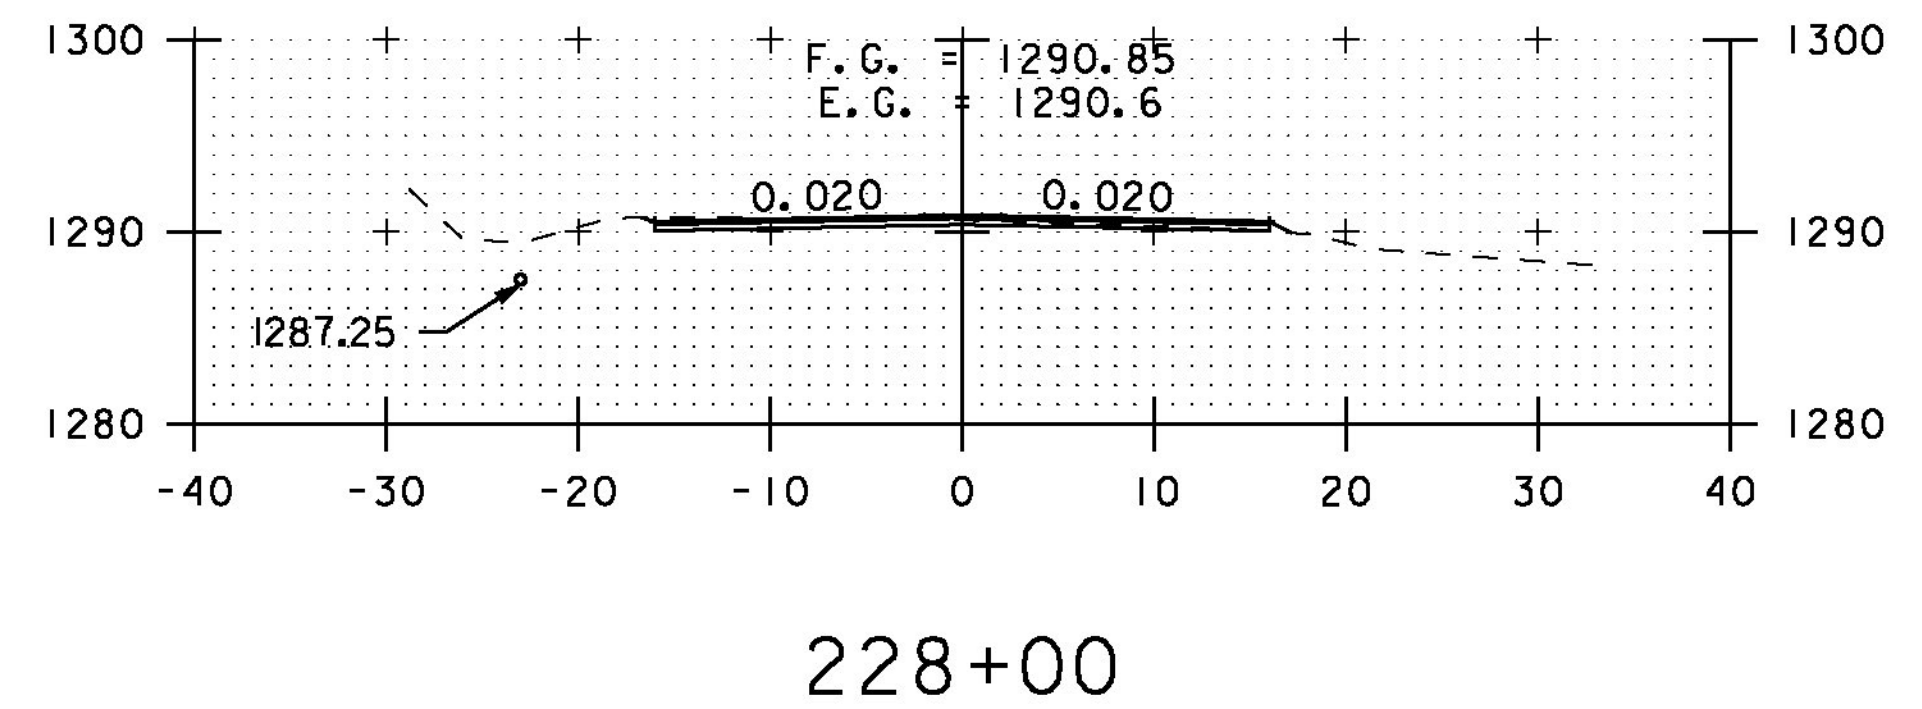


228+00

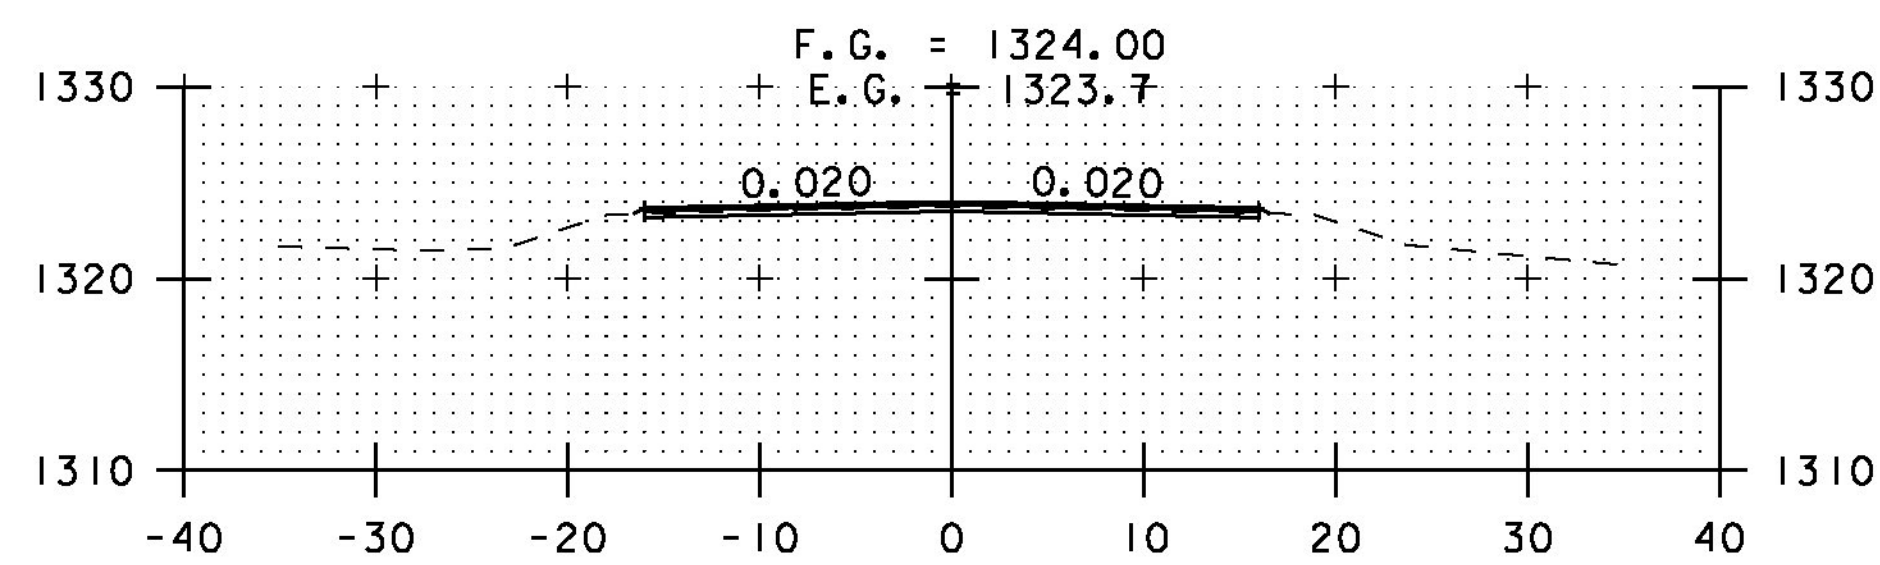


223+50

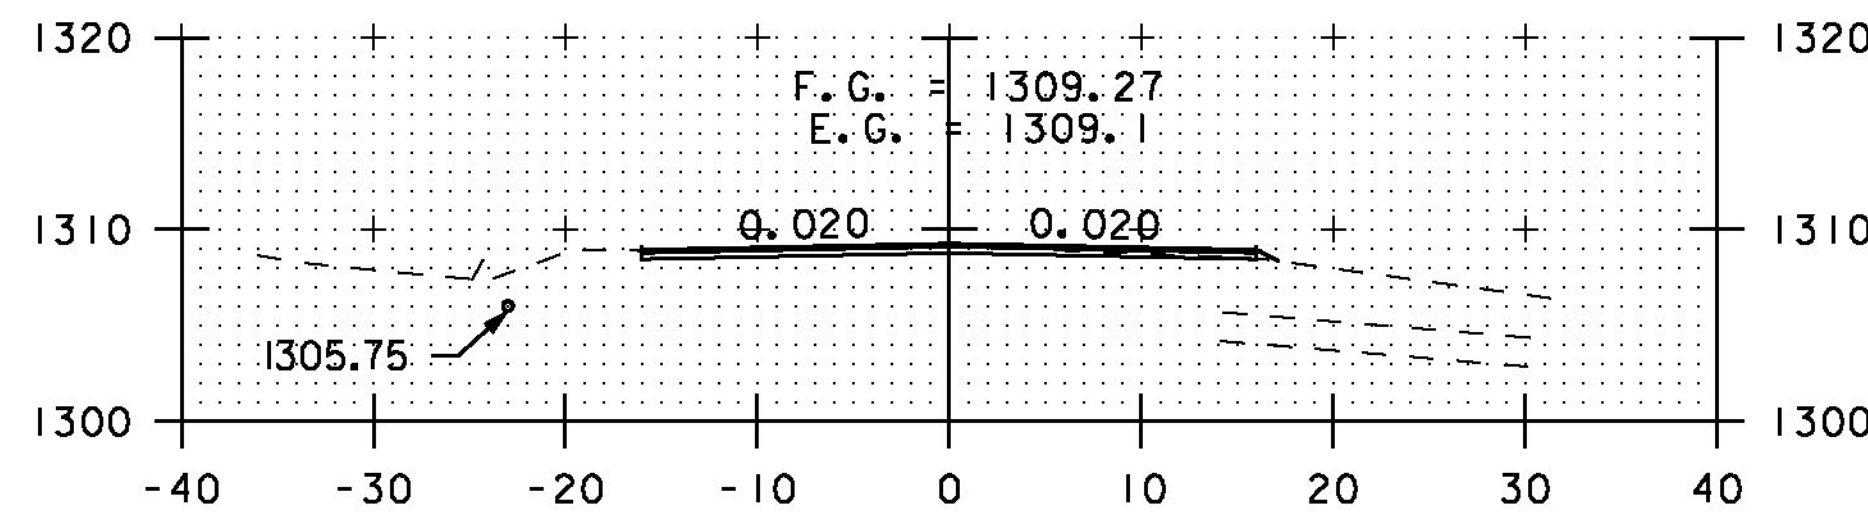


225+50

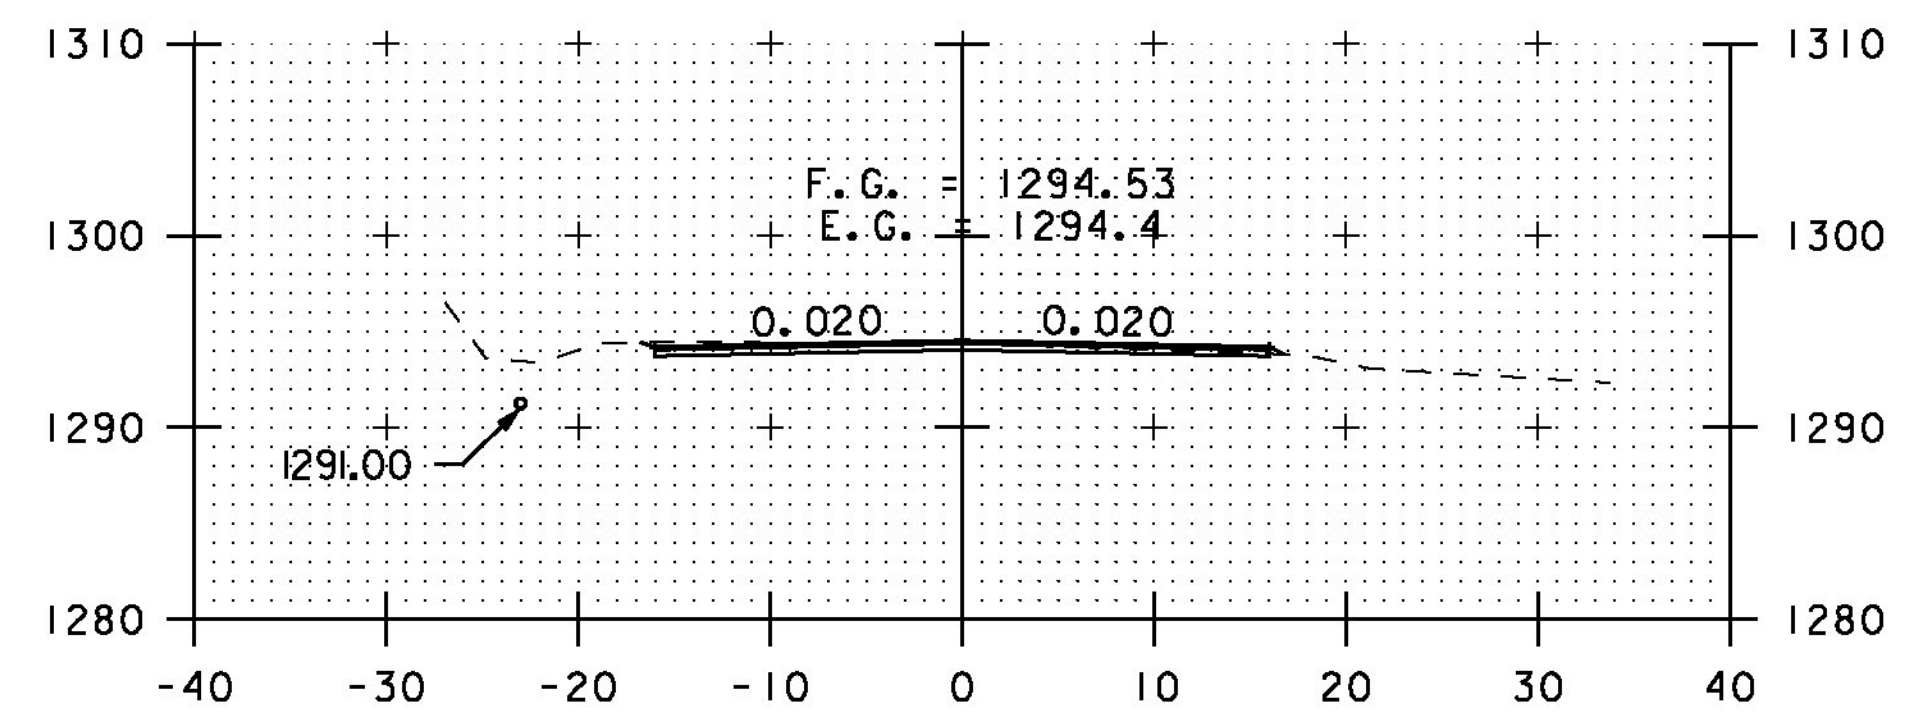


227+50

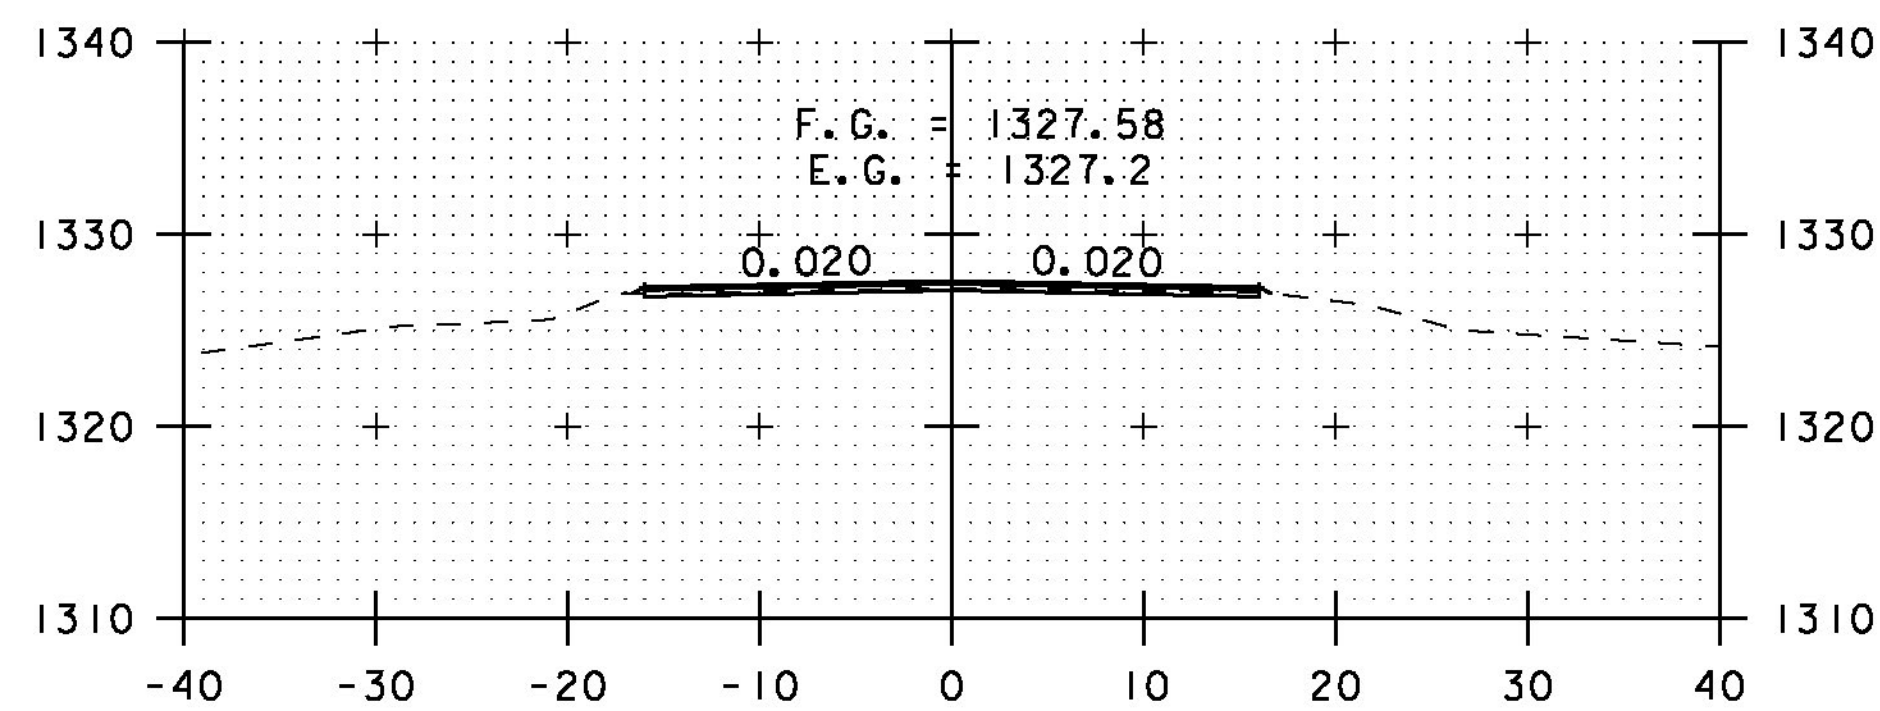

223+00

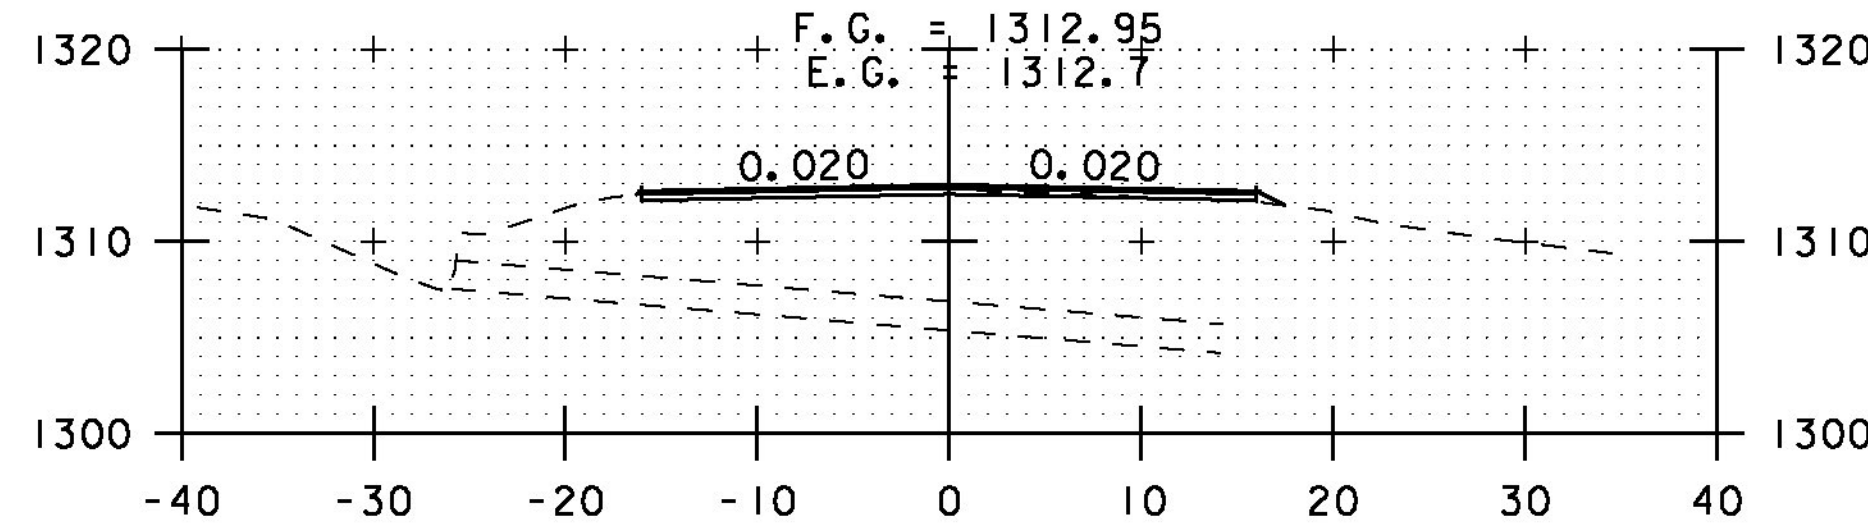

225+00

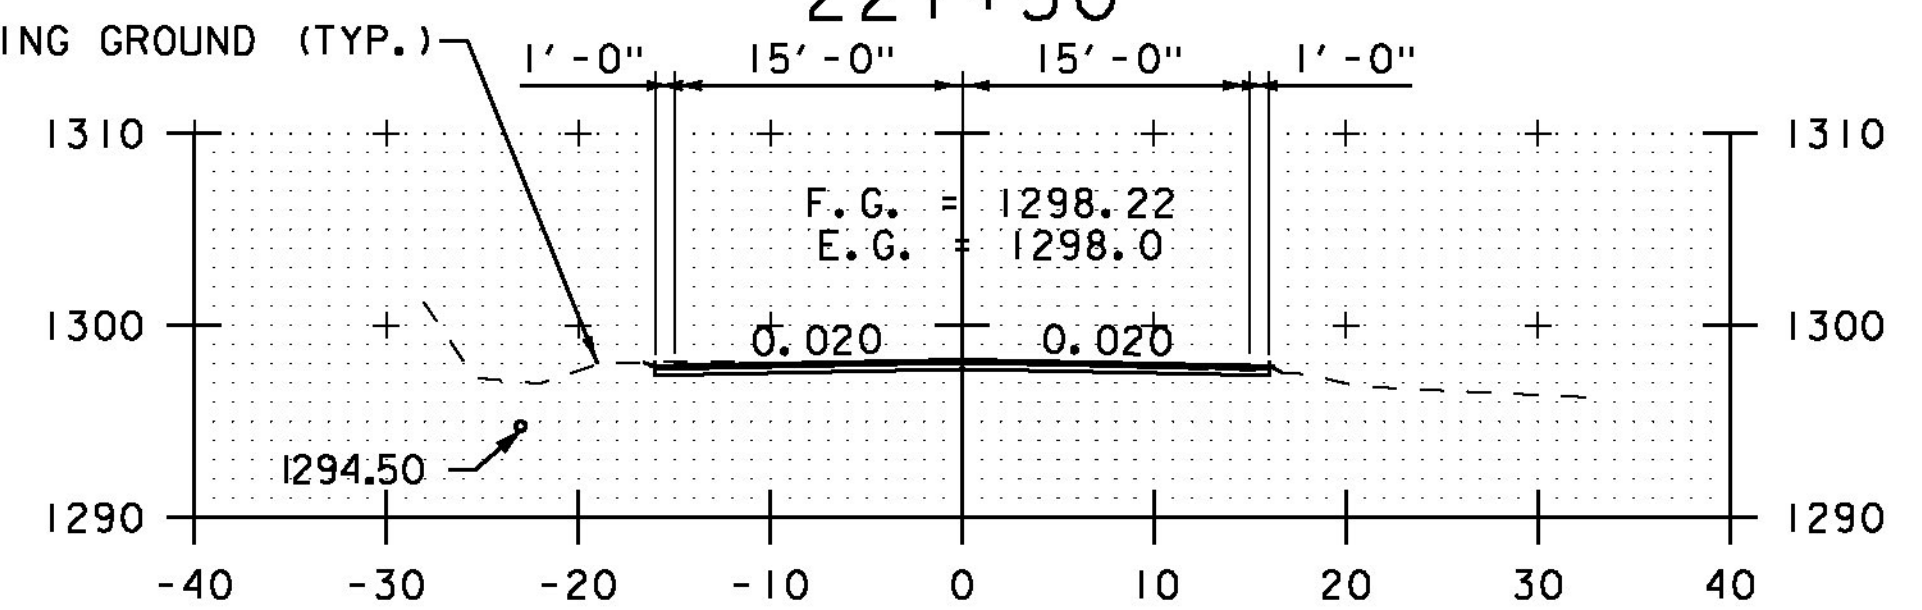

227+00

STA. 223+00 TO STA. 228+50



CROSS SECTION SHEET 8

PROJECT NAME: ELMORE-MORRISTOWN

PROJECT NUMBER: STP 2937 (1)

FILE NAME: z11c310.dgn

PROJECT LEADER: C. LATHROP

DESIGNED BY: S. LAMPHERE

PLOT FILE: z11c310_136.i

PLOT DATE: 3/3/14

DRAWN BY: B. MARTIN

CHECKED BY: C. LATHROP

SHEET 136 OF 194