




230+50

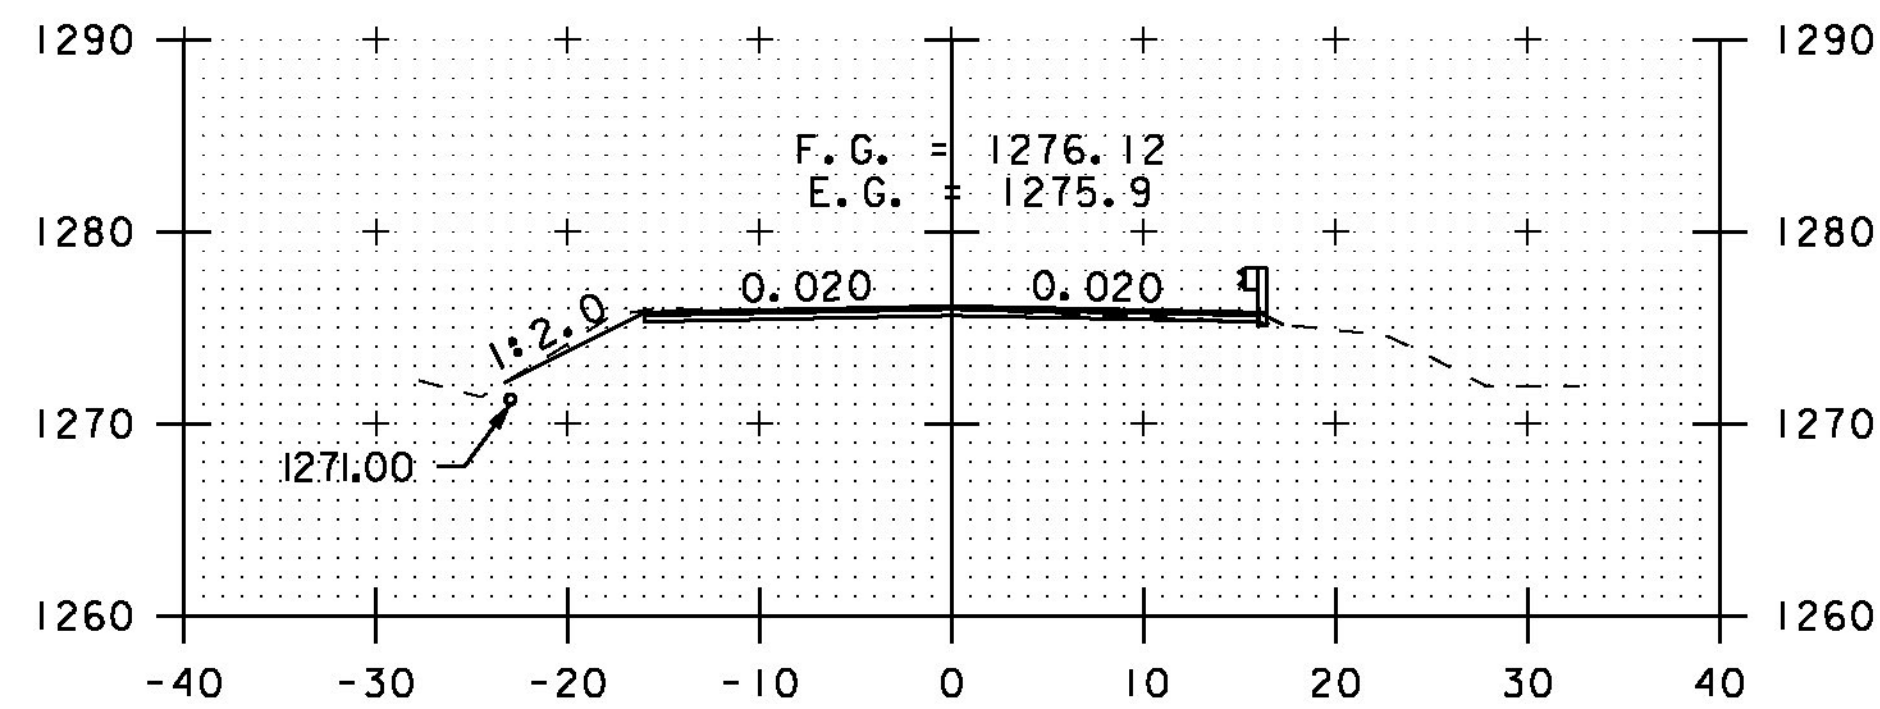


230+00

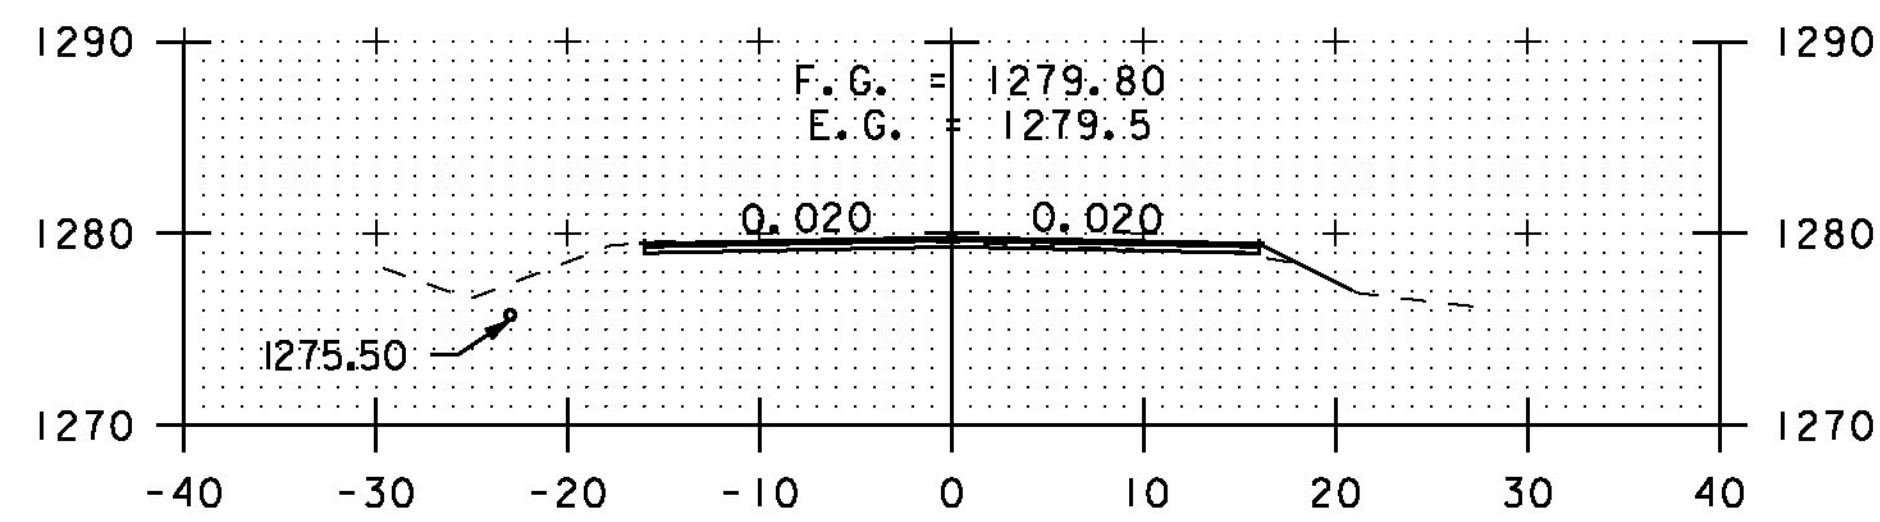


229+50

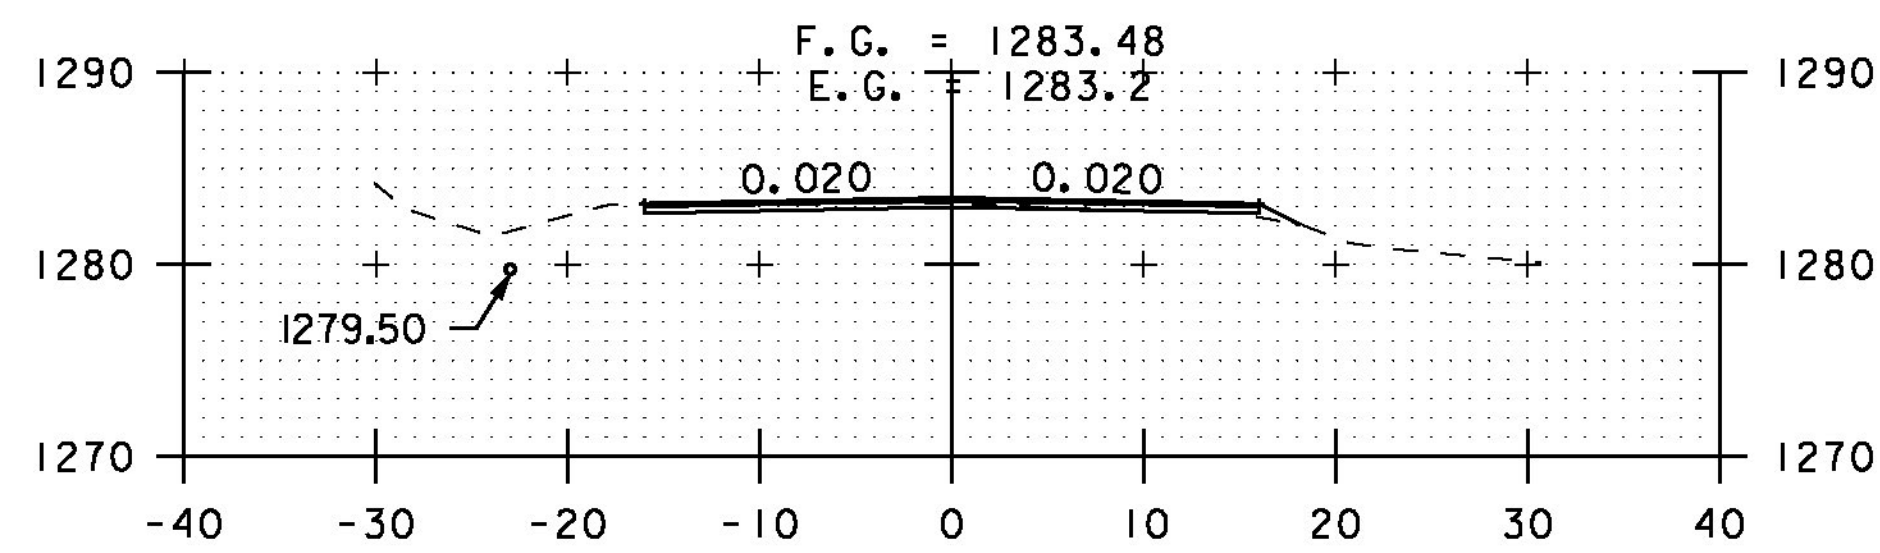


229+00

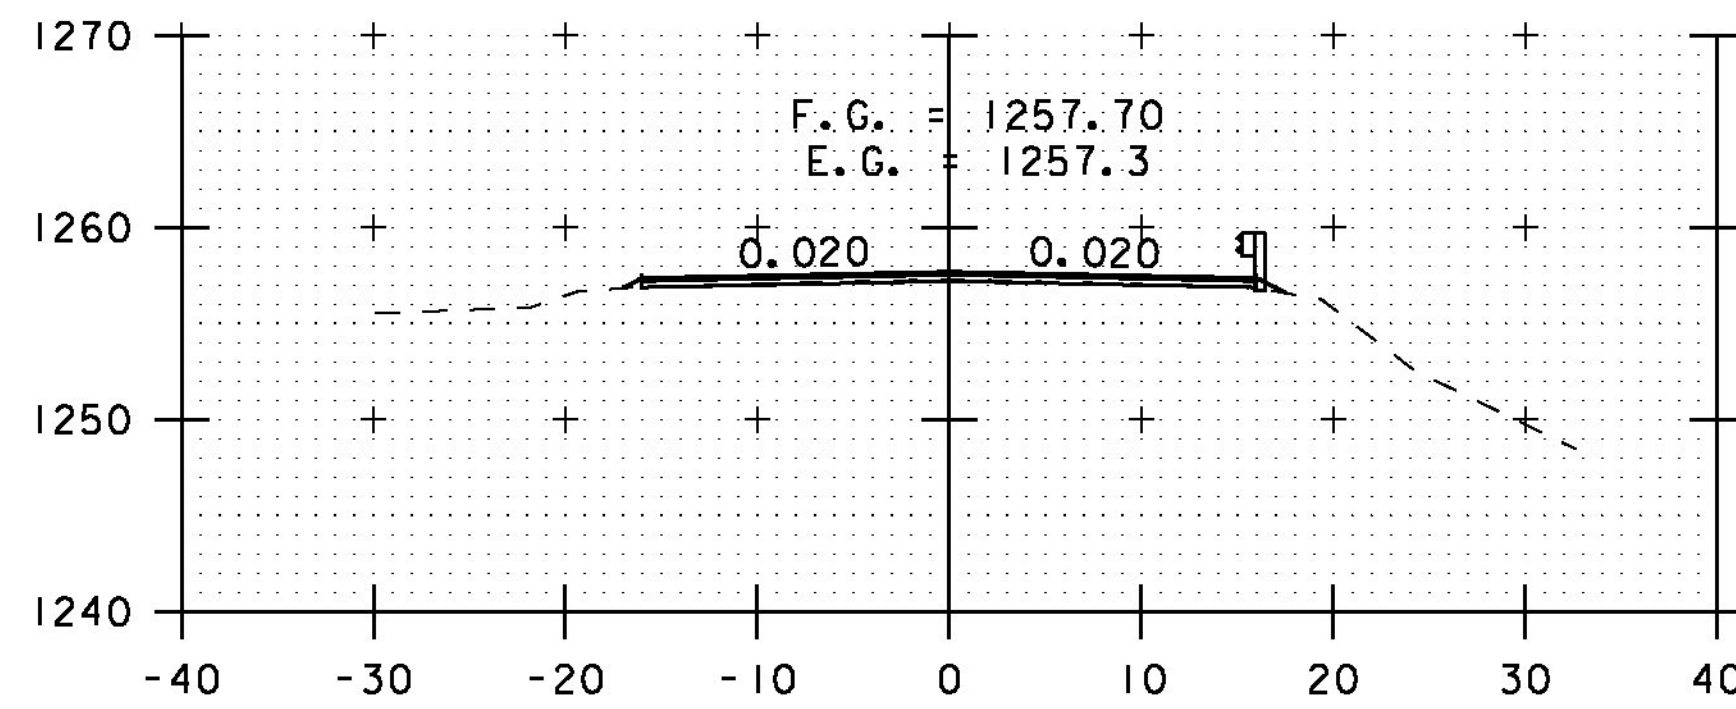


232+50

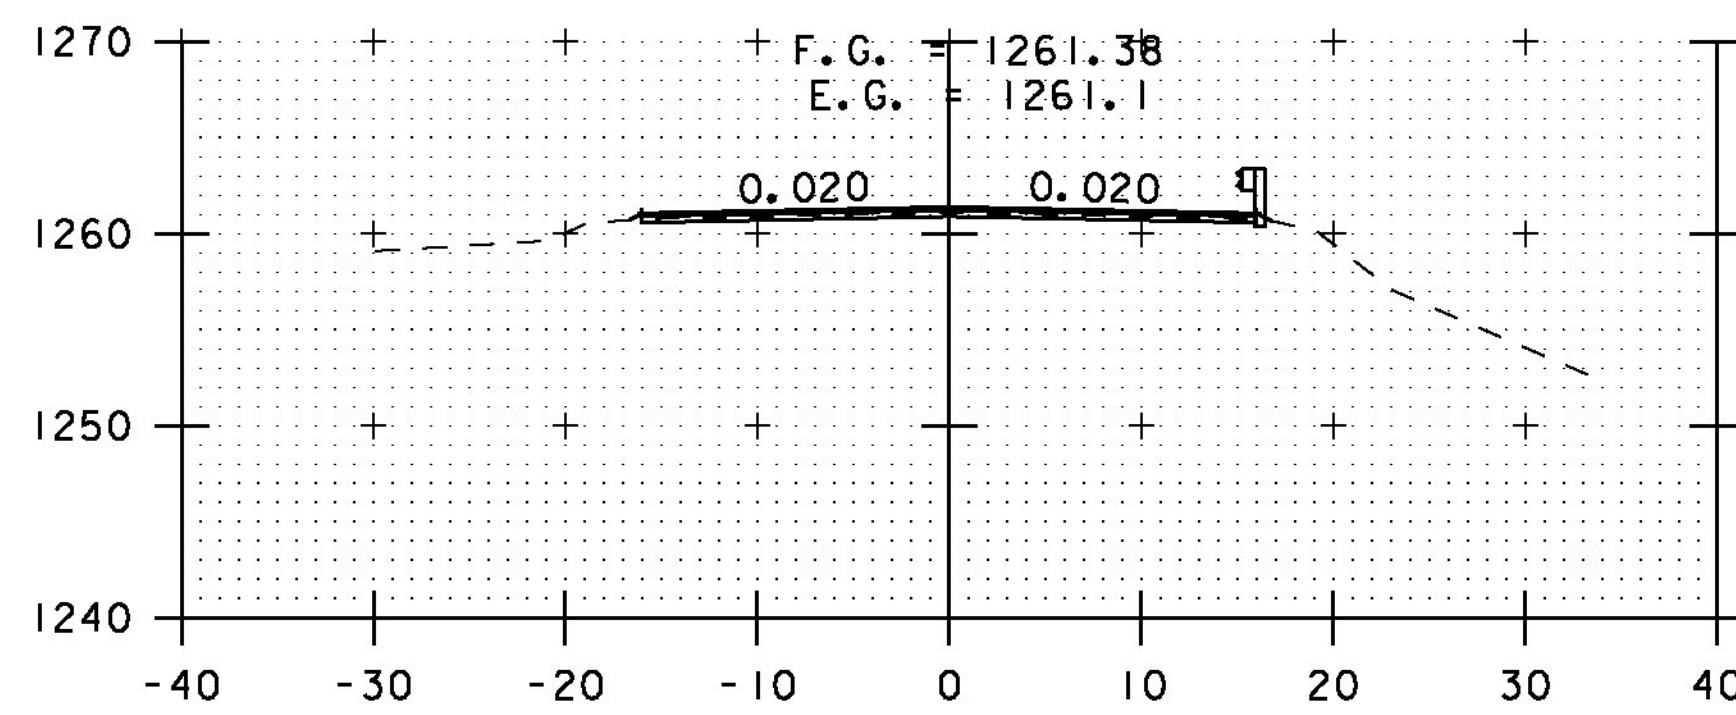


232+00

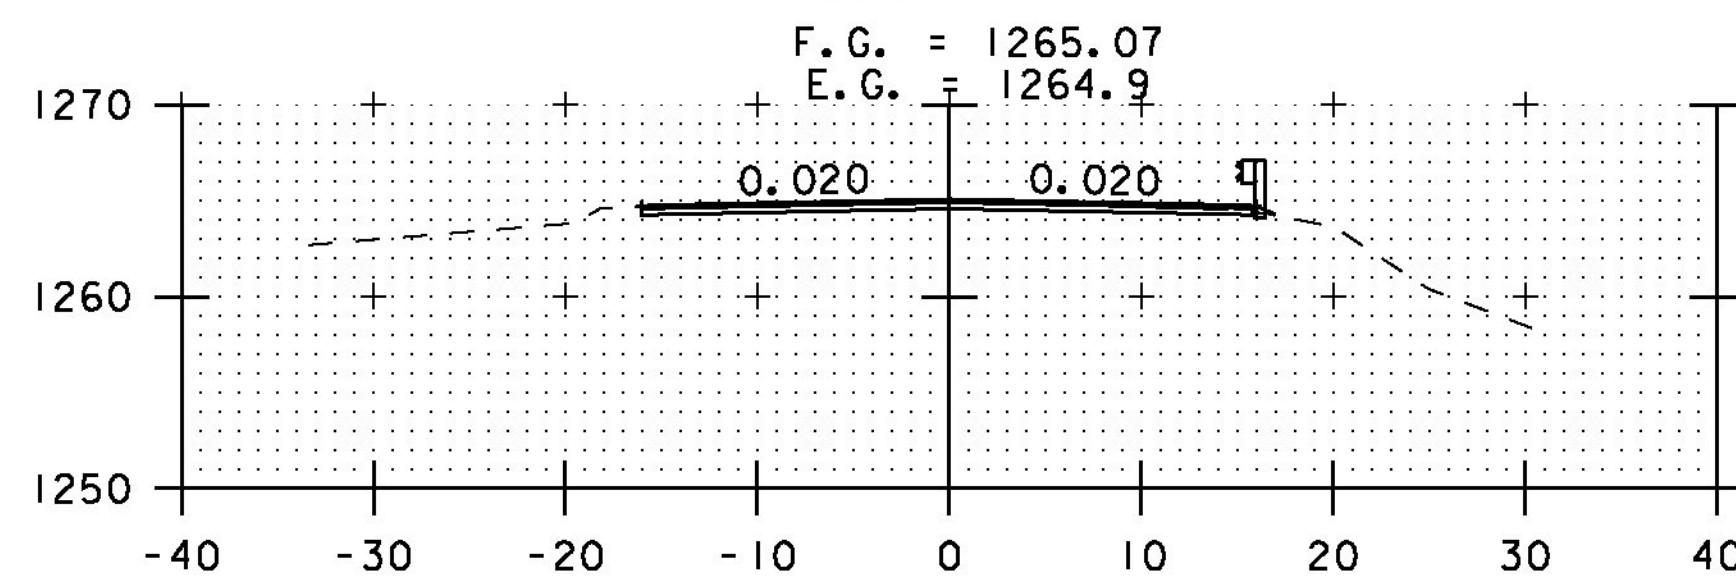


231+50

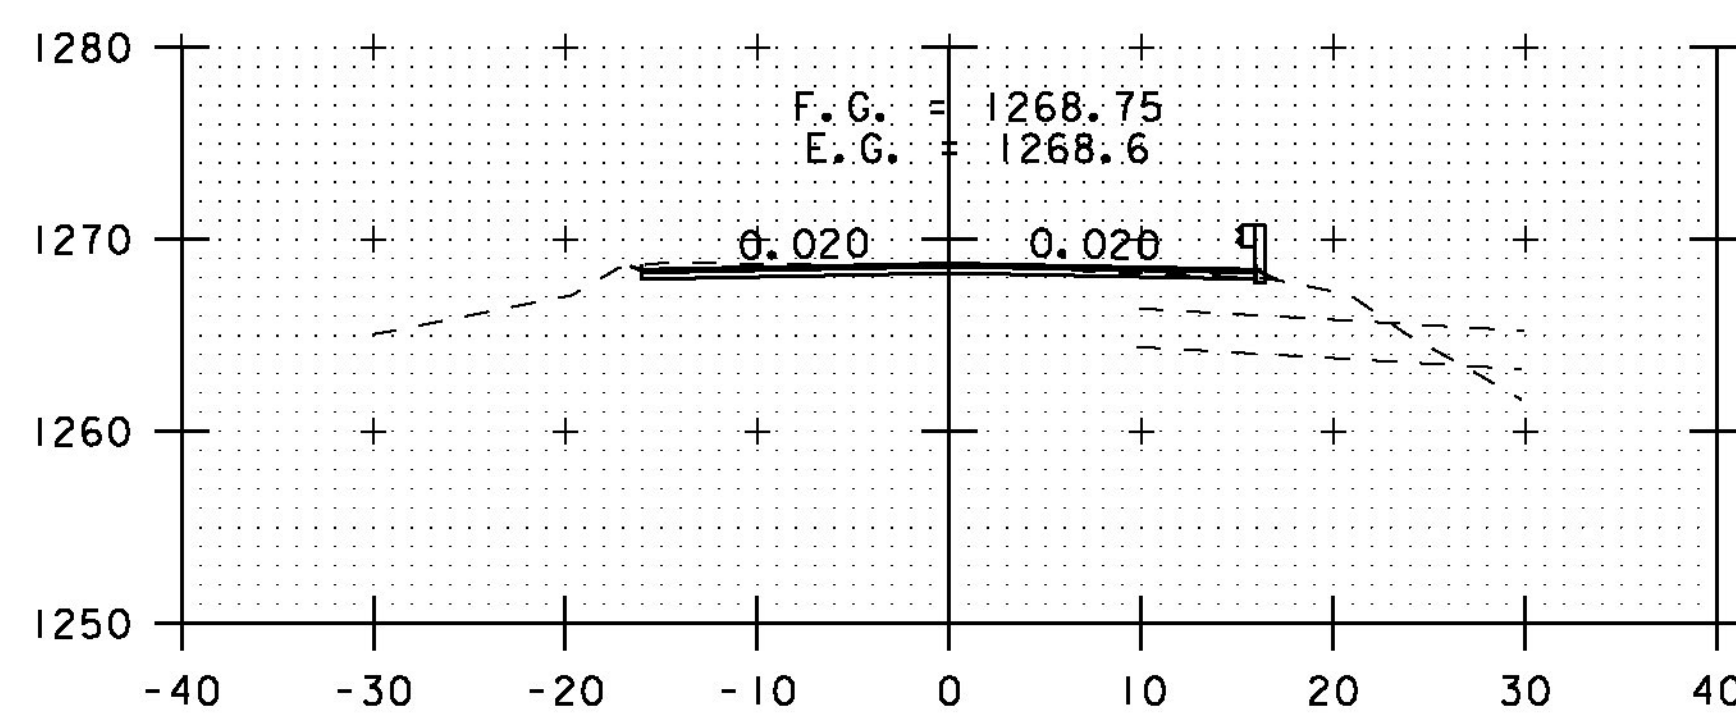


231+00

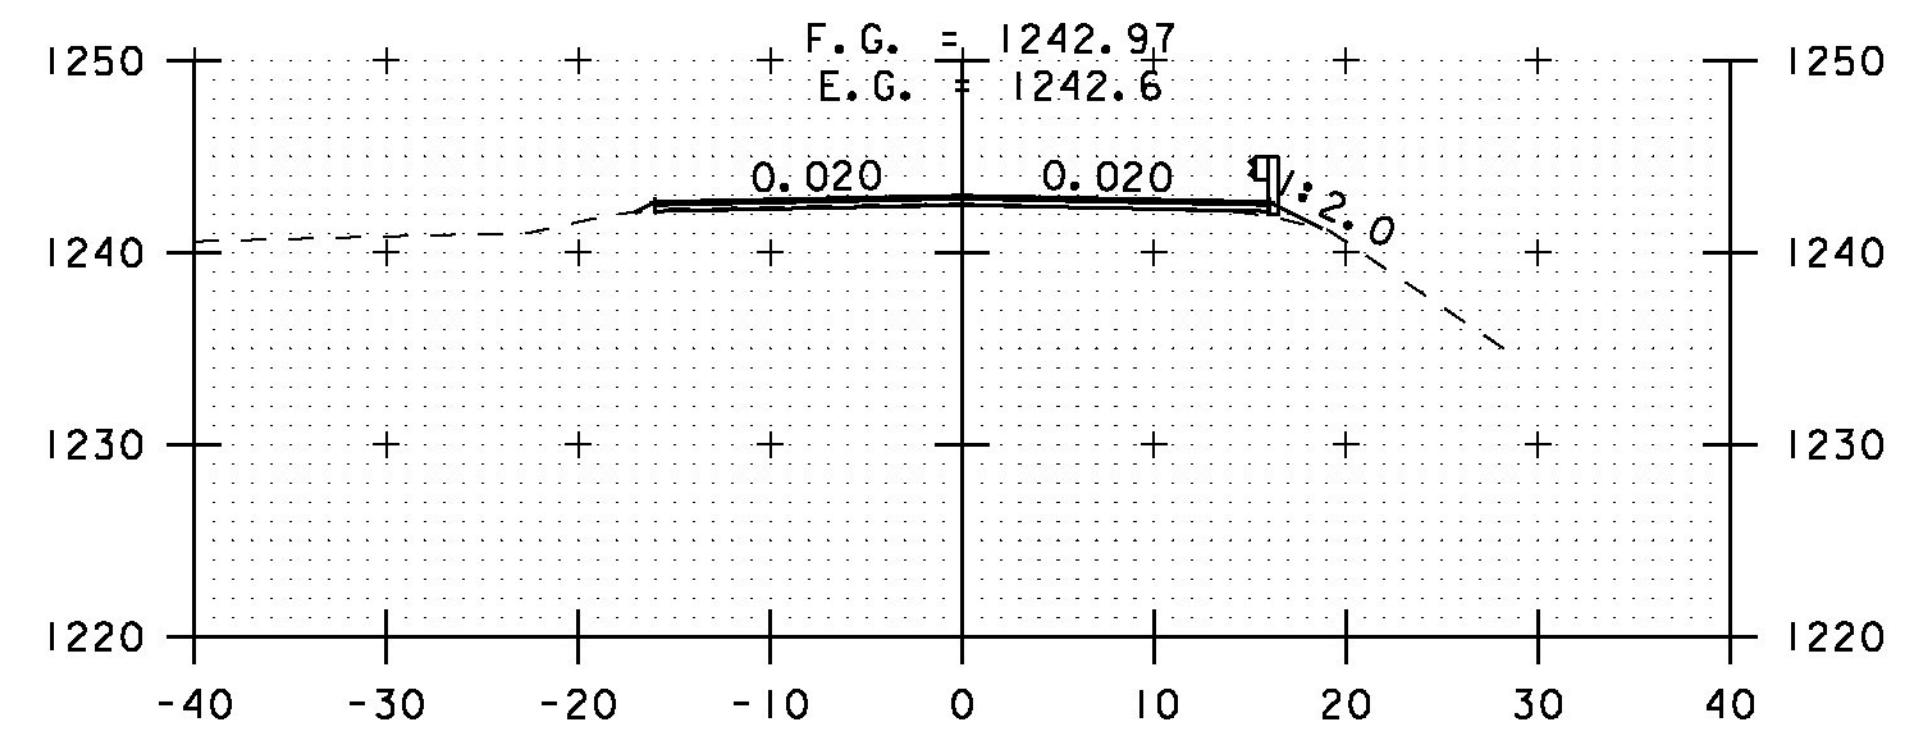


234+50

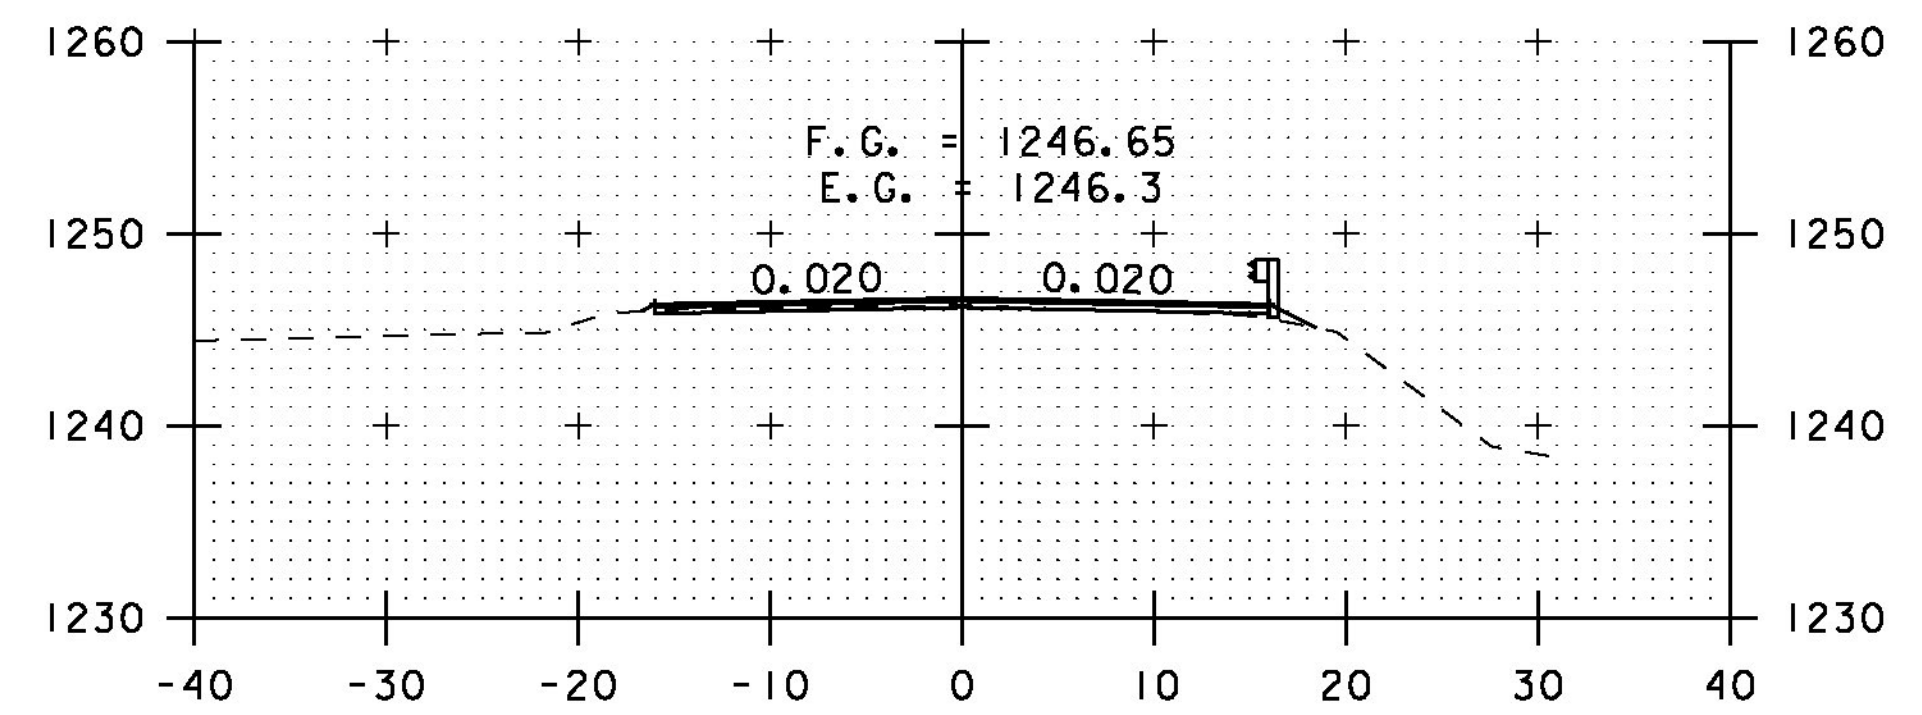

234+00

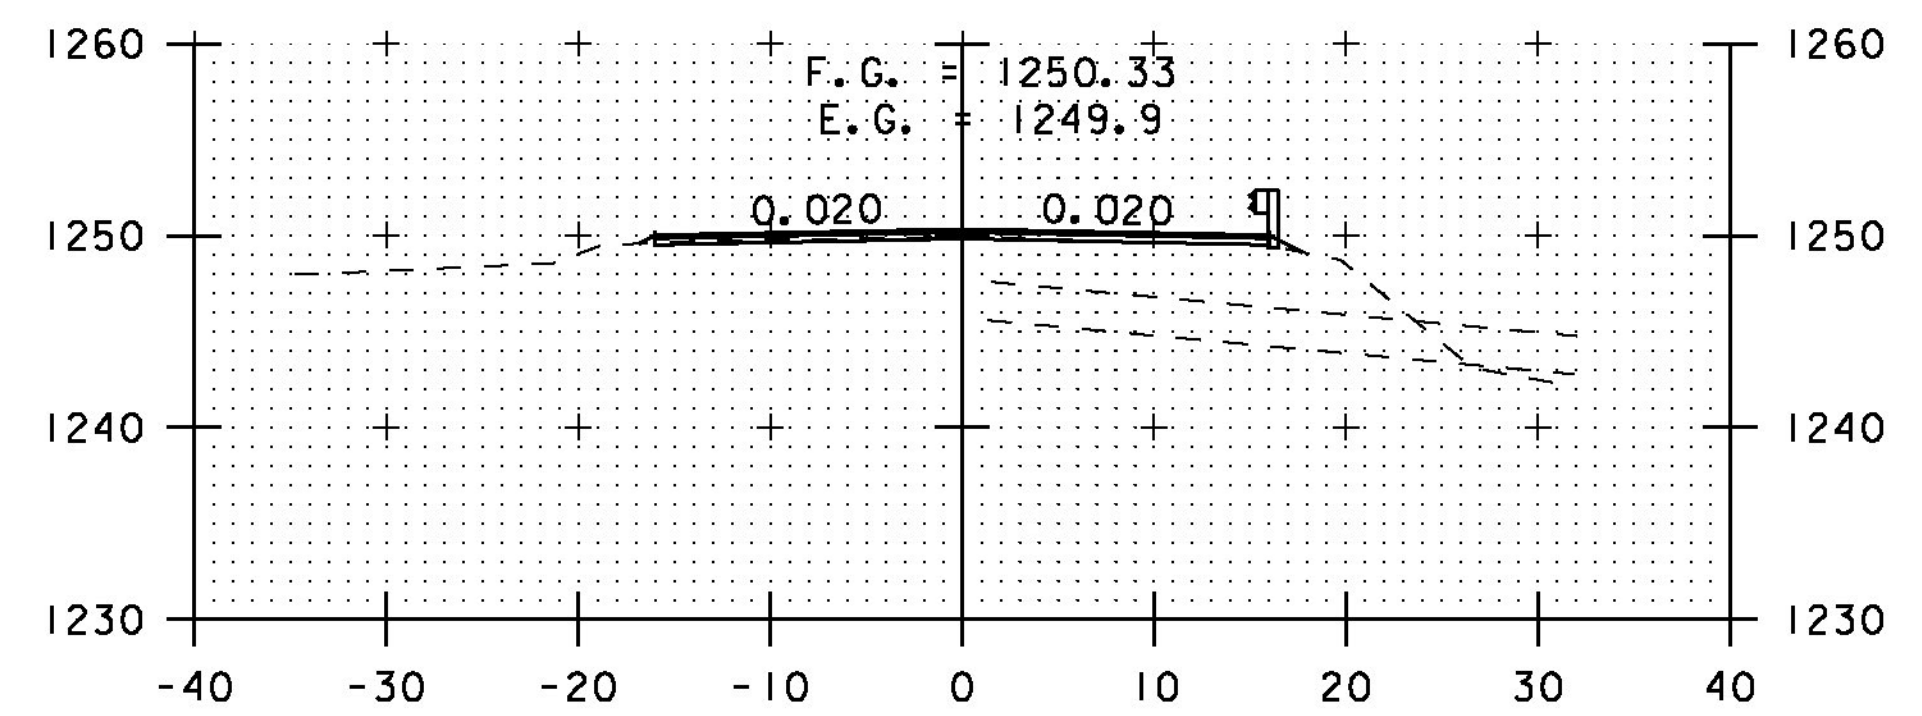

233+50

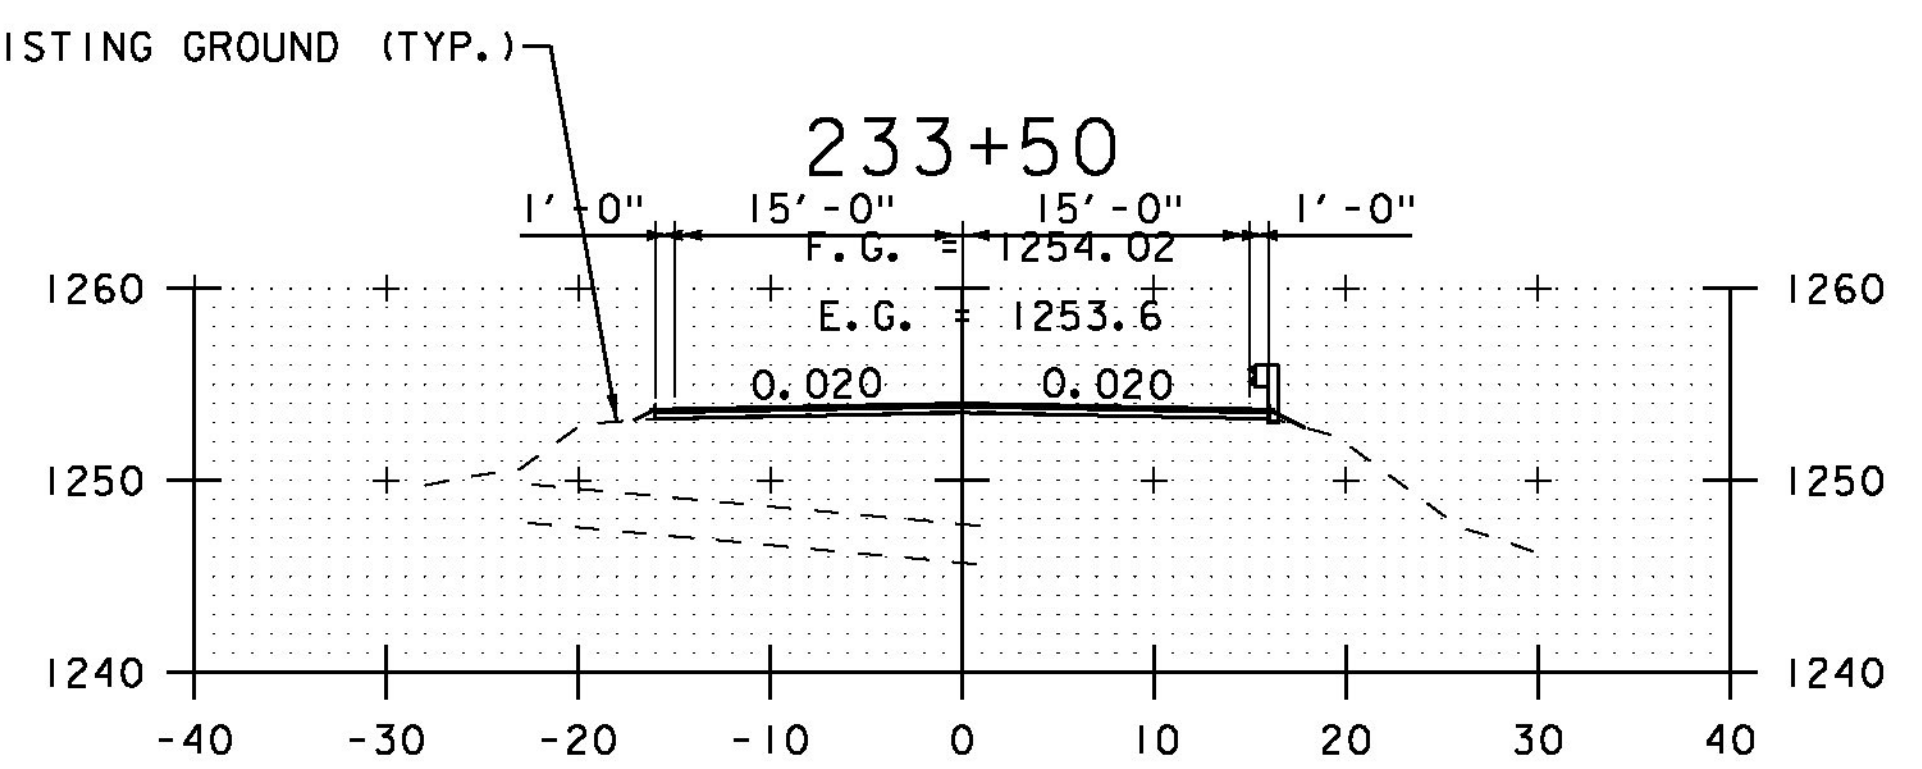

233+00

STA. 229+00 TO STA. 234+50



CROSS SECTION SHEET 9

PROJECT NAME: ELMORE-MORRISTOWN	PROJECT NUMBER: STP 2937 (I)
FILE NAME: z11c310.dgn	PLOT DATE: 3/3/14
PROJECT LEADER: C. LATHROP	DRAWN BY: B. MARTIN
DESIGNED BY: S. LAMPHERE	CHECKED BY: C. LATHROP
PLOT FILE: z11c310_137.i	SHEET 137 OF 194