




236+00

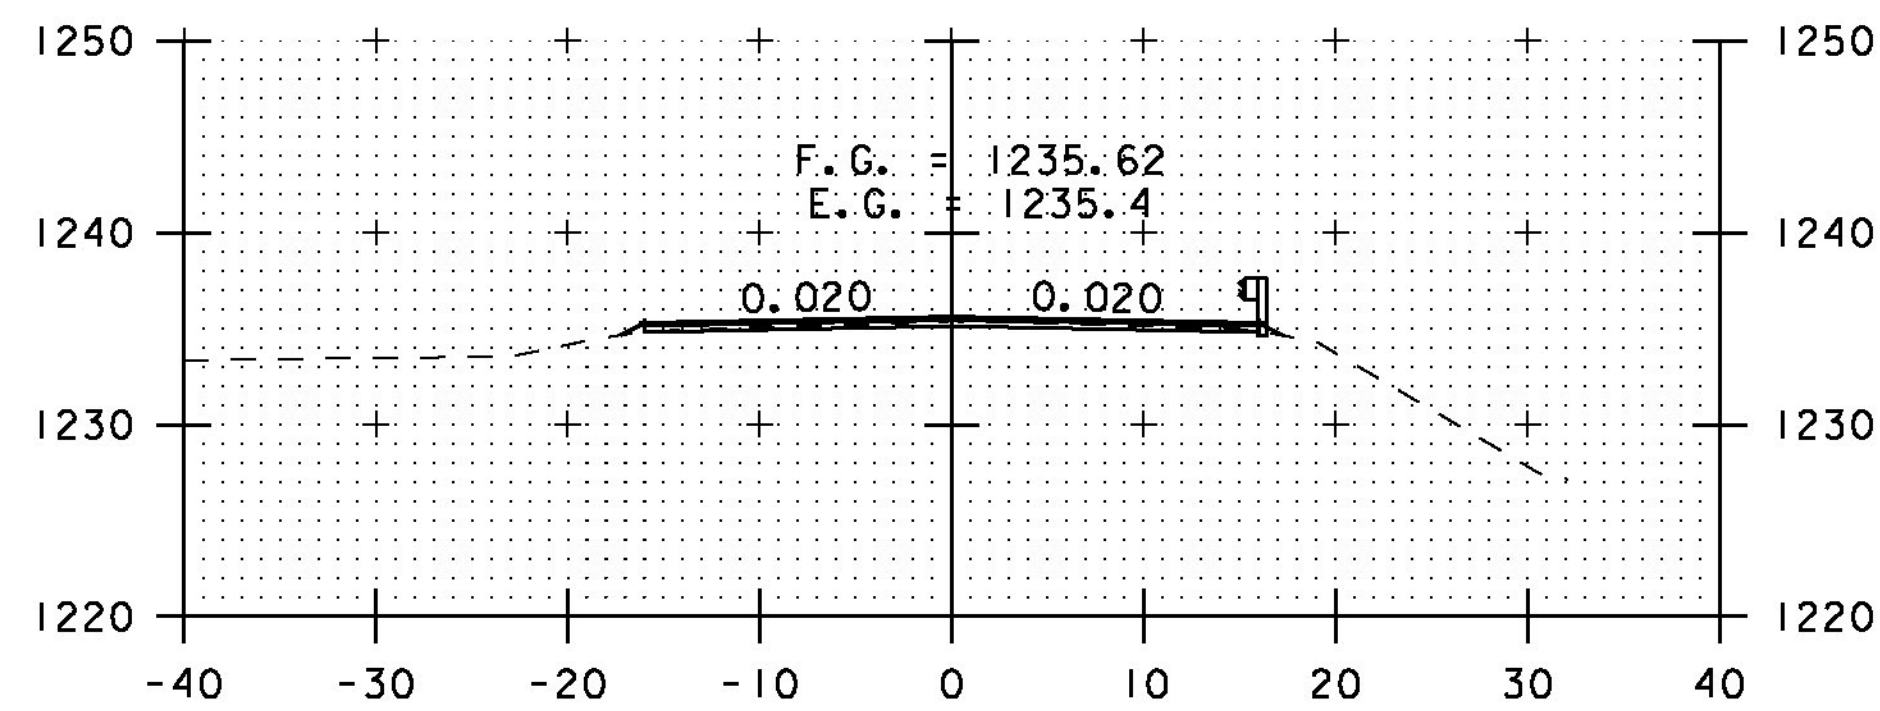


235+50

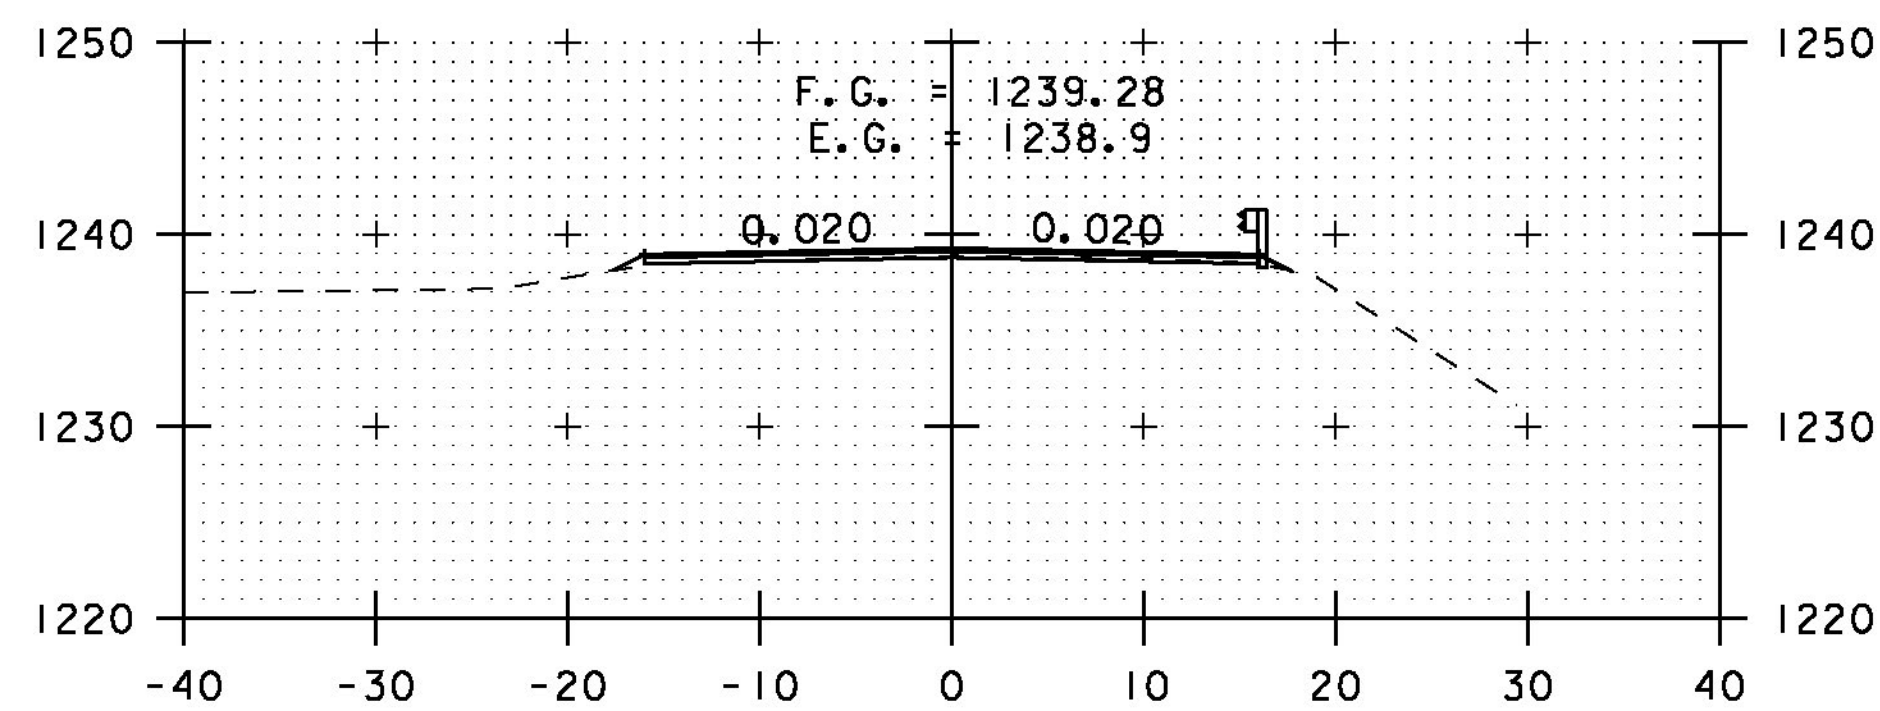


235+00

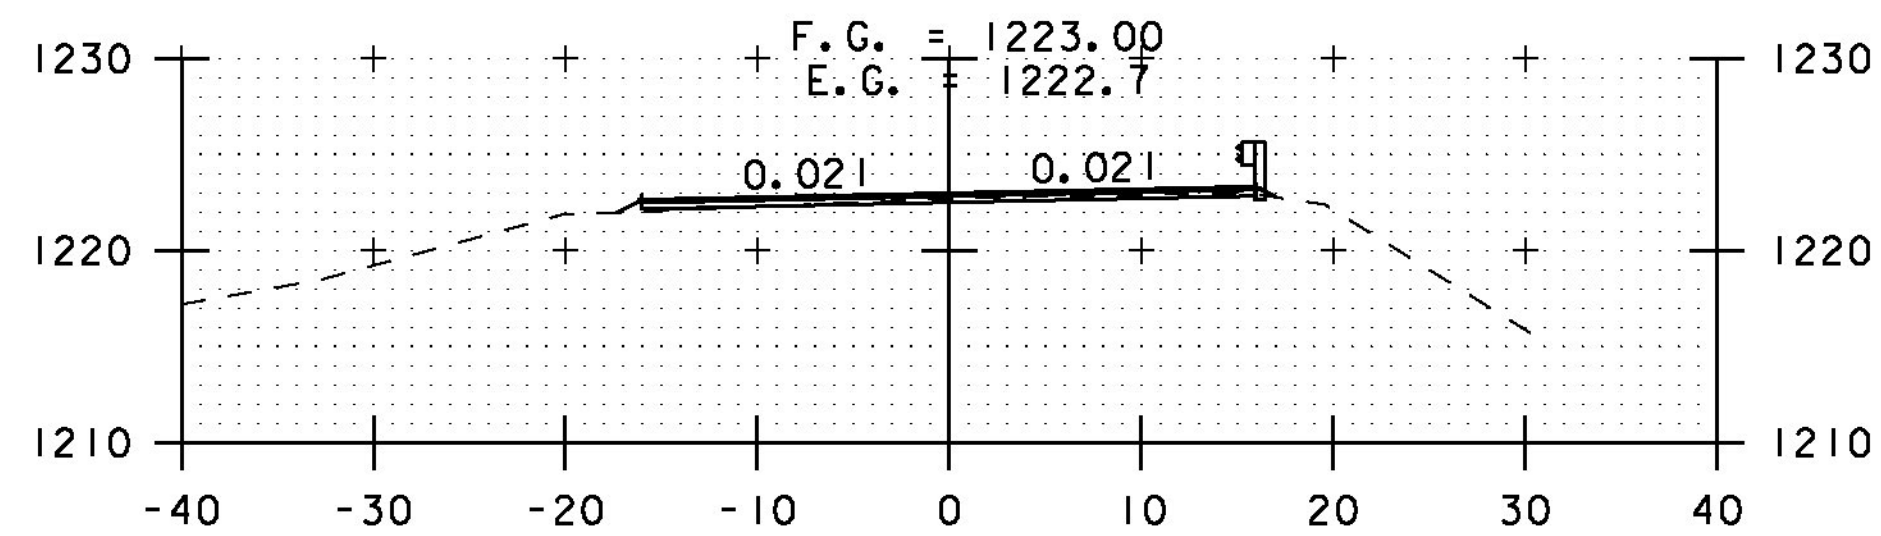


238+00

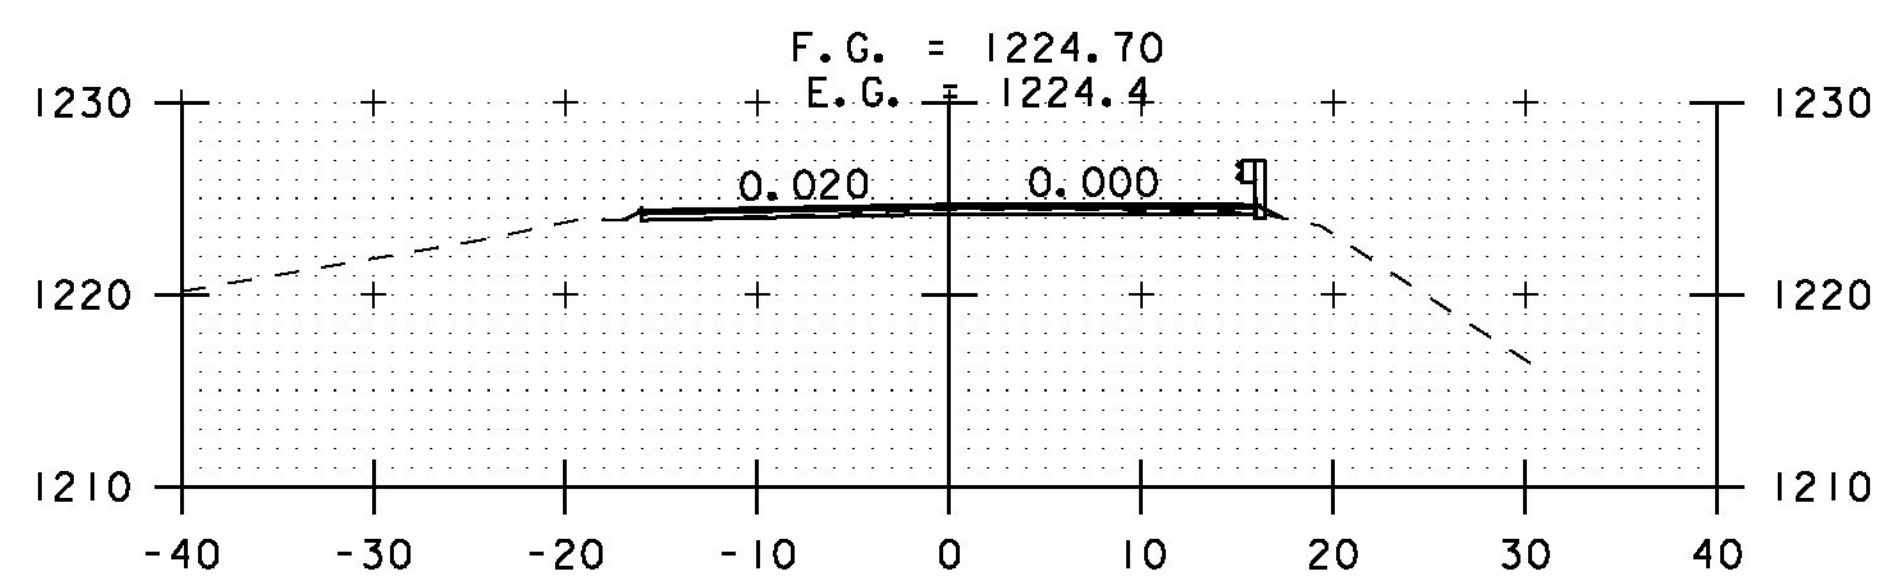


237+50

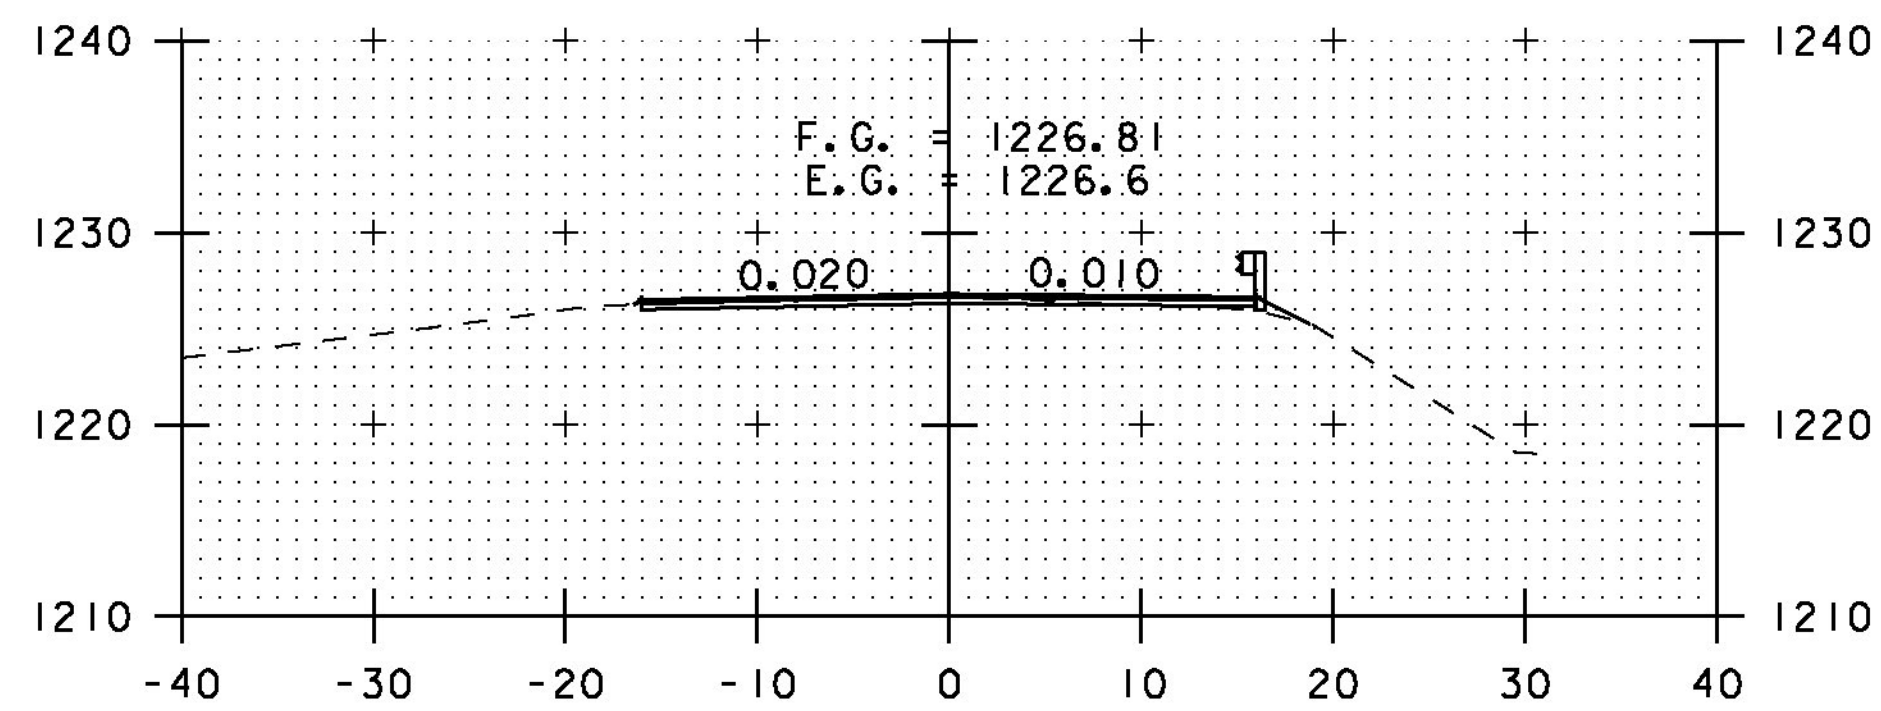


237+00

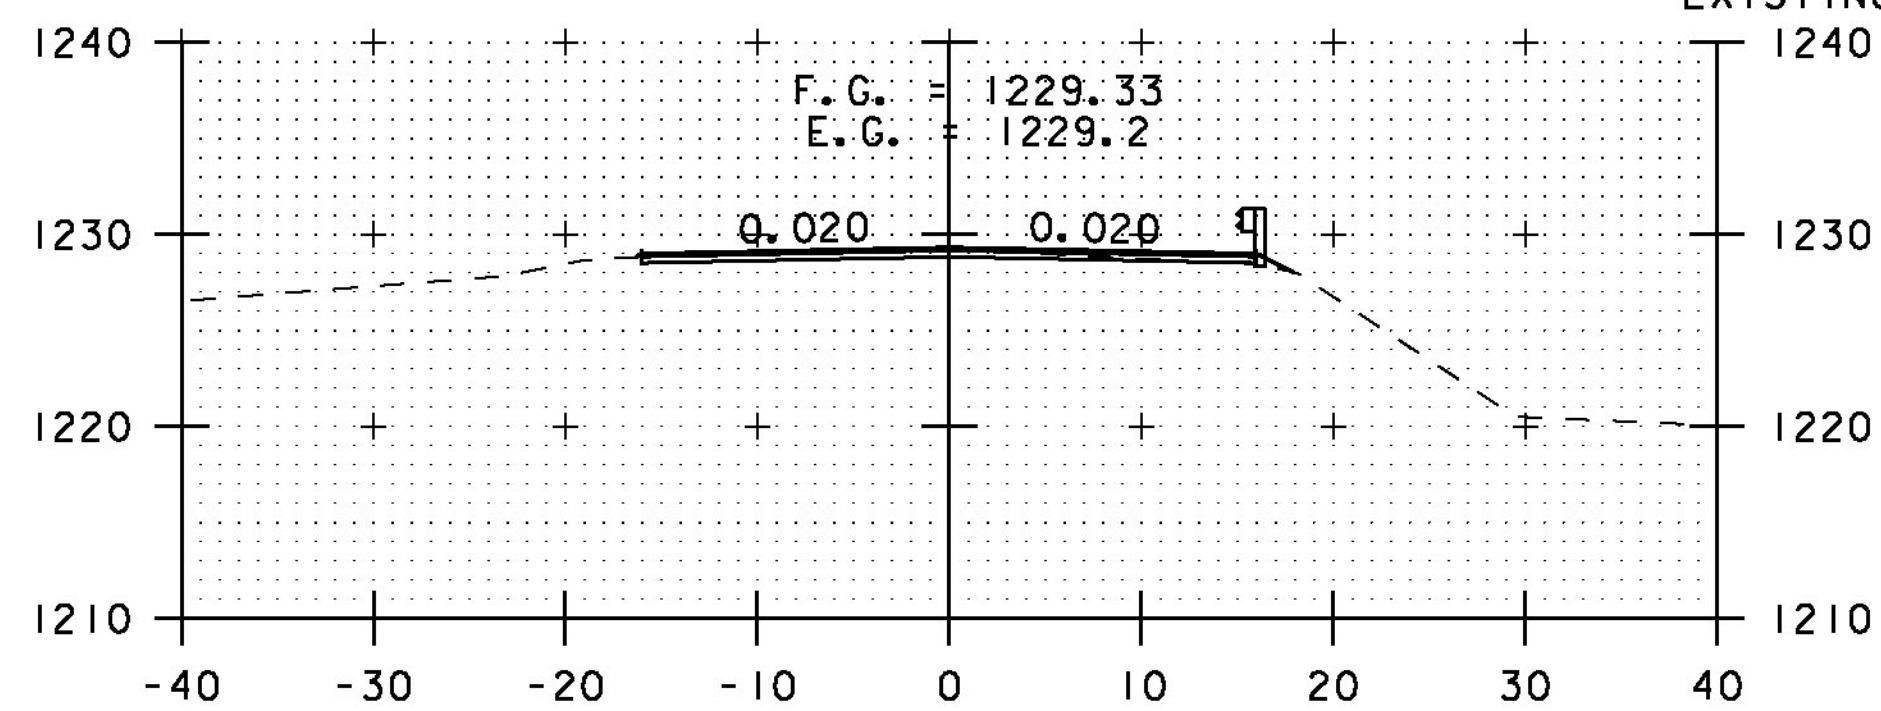


236+50

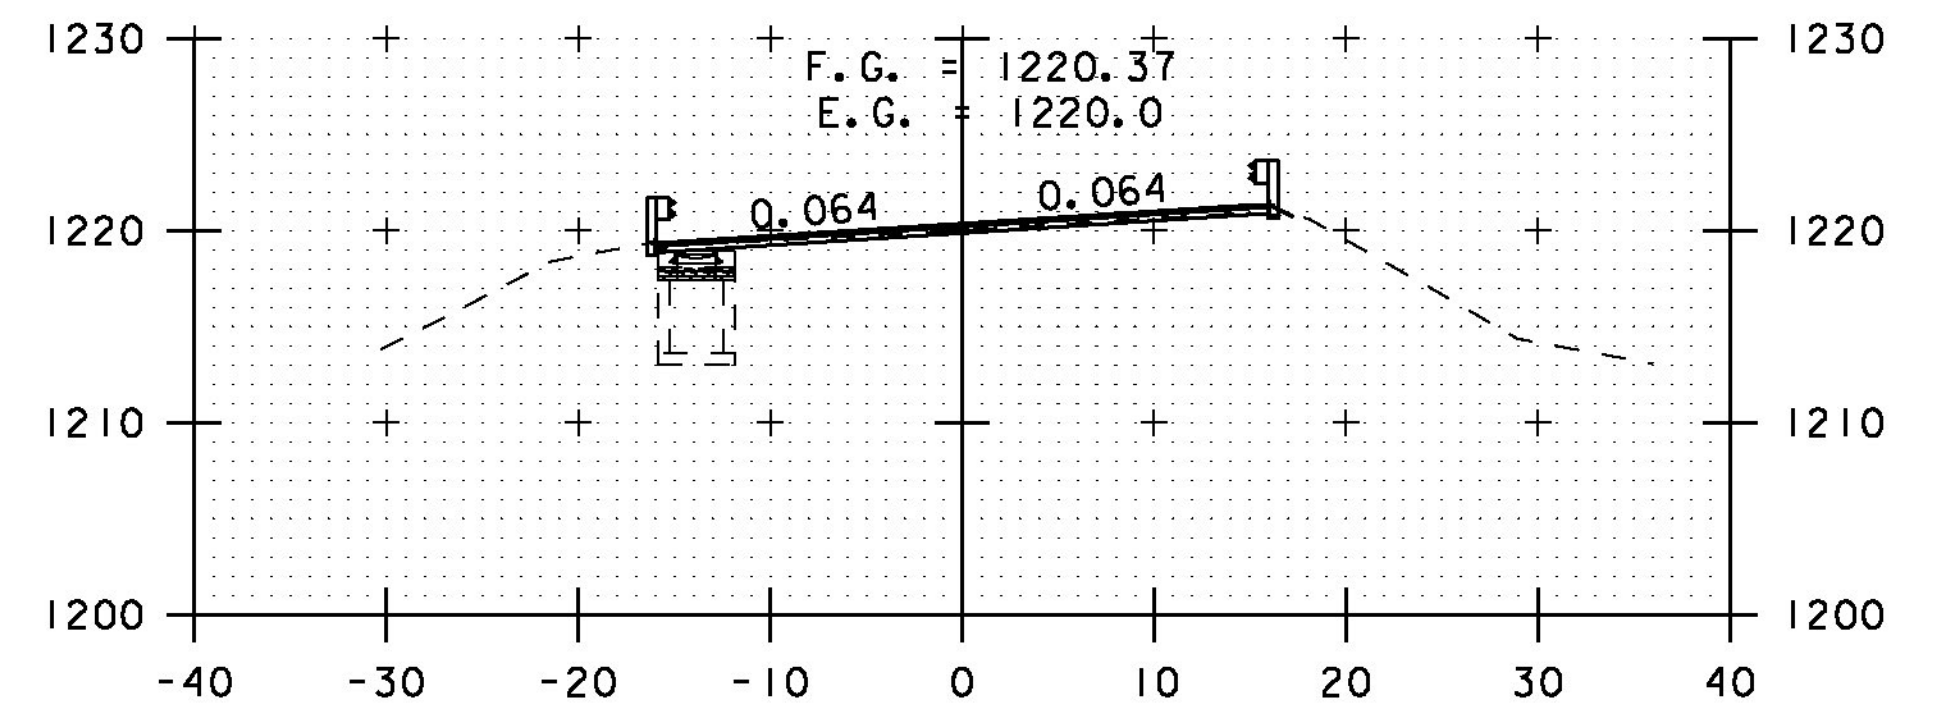


240+00

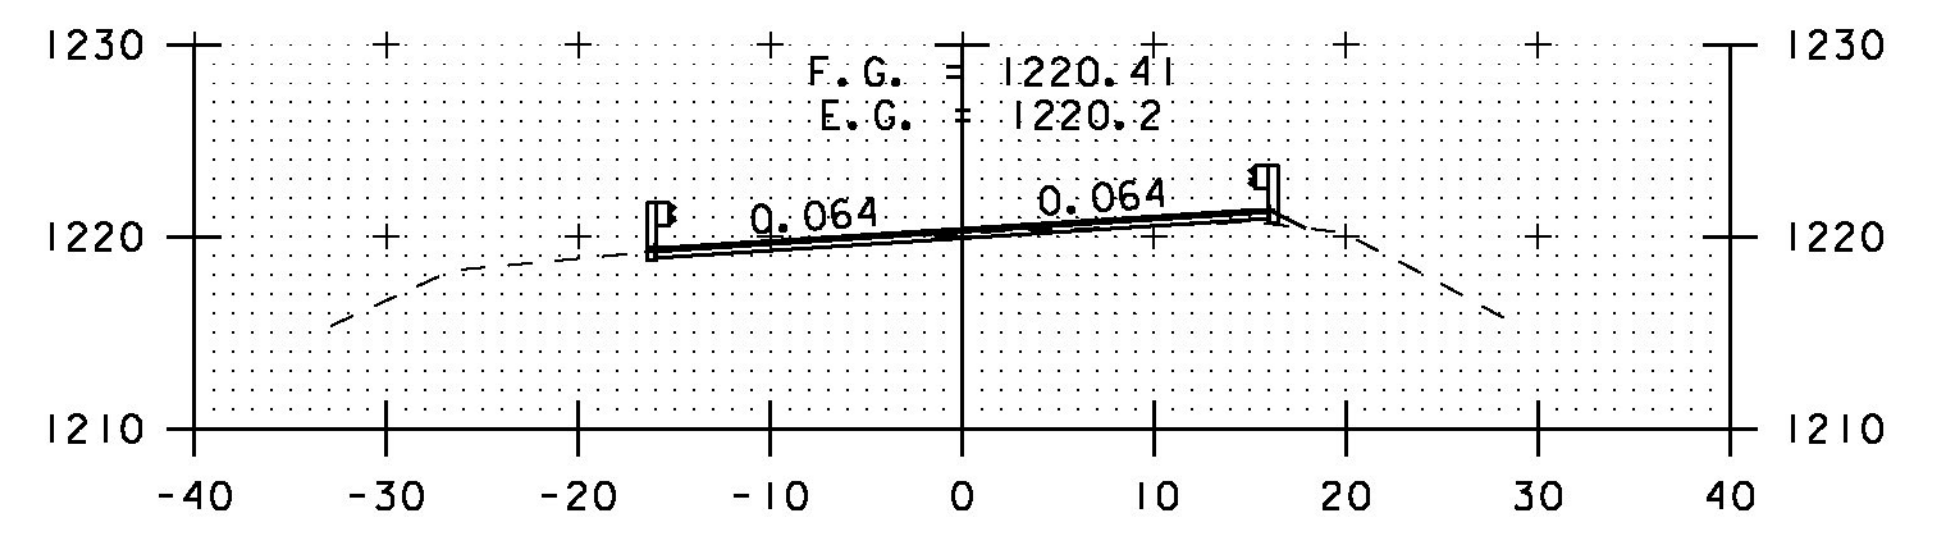

239+50

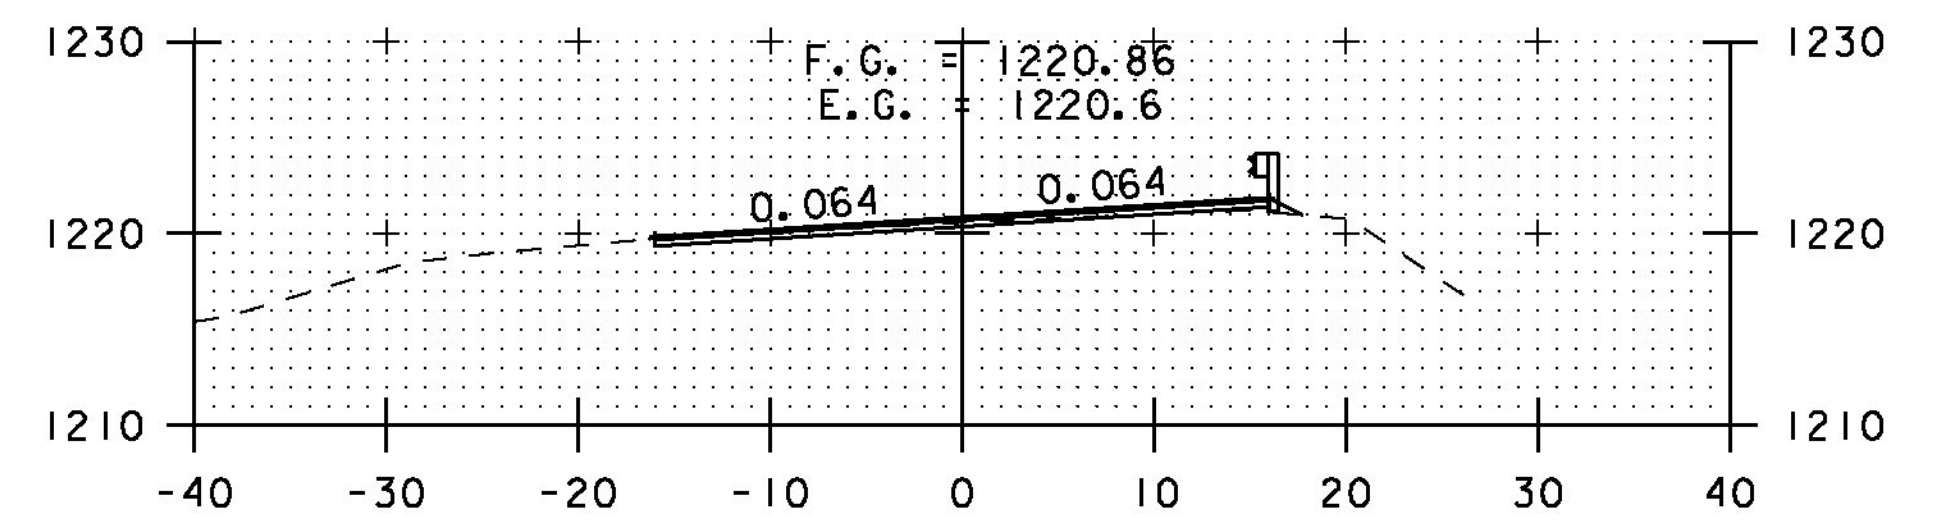

239+00

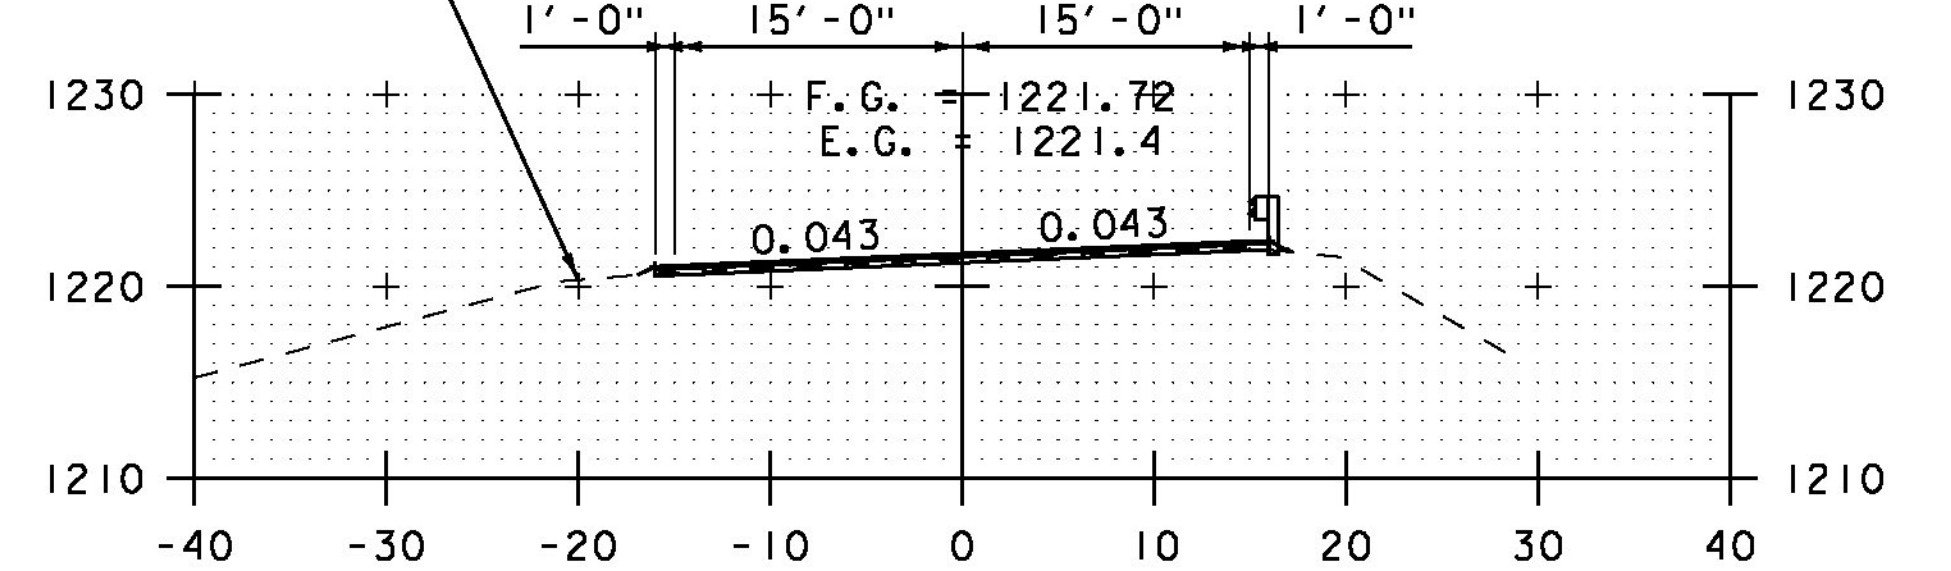

238+50

STA. 235+00 TO STA. 240+00



CROSS SECTION SHEET 10

PROJECT NAME: ELMORE-MORRISTOWN

PROJECT NUMBER: STP 2937 (1)

FILE NAME: z11c310.dgn

PROJECT LEADER: C. LATHROP

DESIGNED BY: S. LAMPHERE

PLOT FILE: z11c310_138.i

PLOT DATE: 3/3/14

DRAWN BY: B. MARTIN

CHECKED BY: C. LATHROP

SHEET 138 OF 194