




242+00

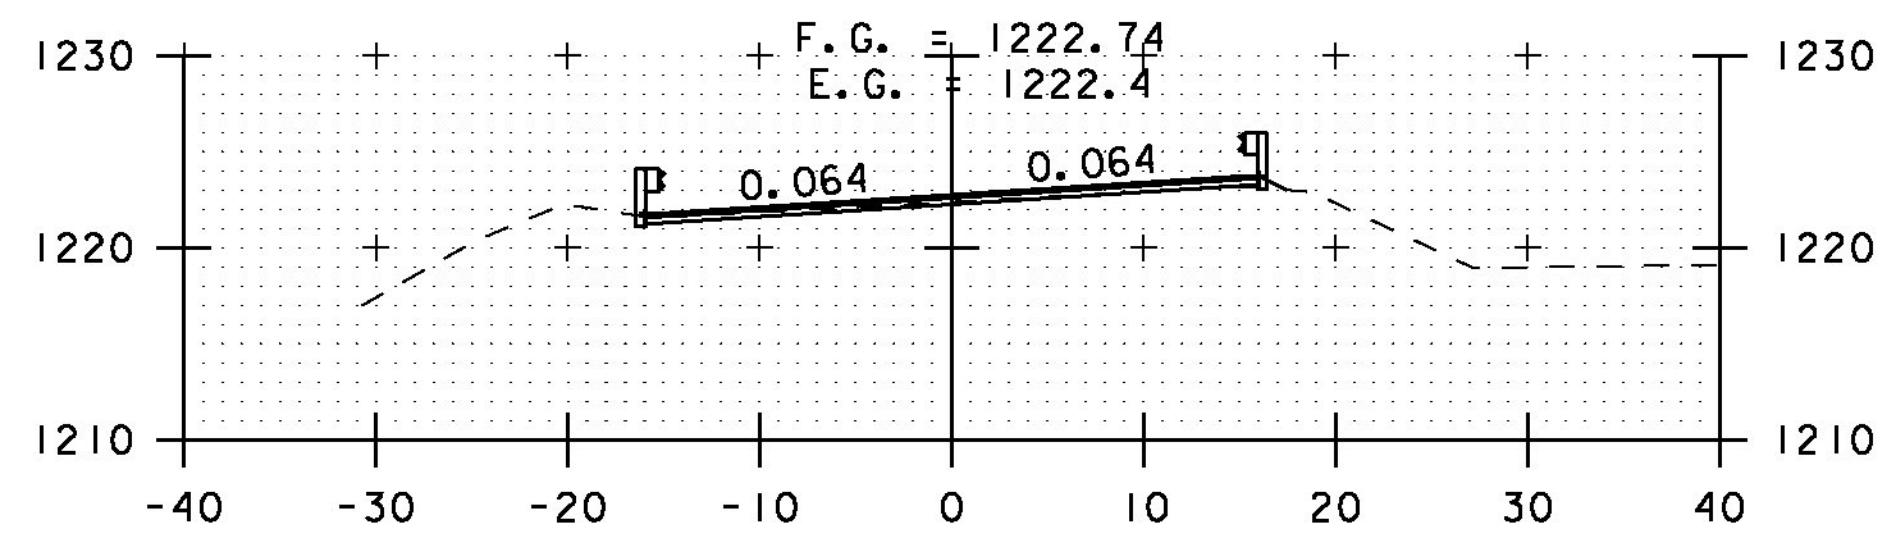


241+50

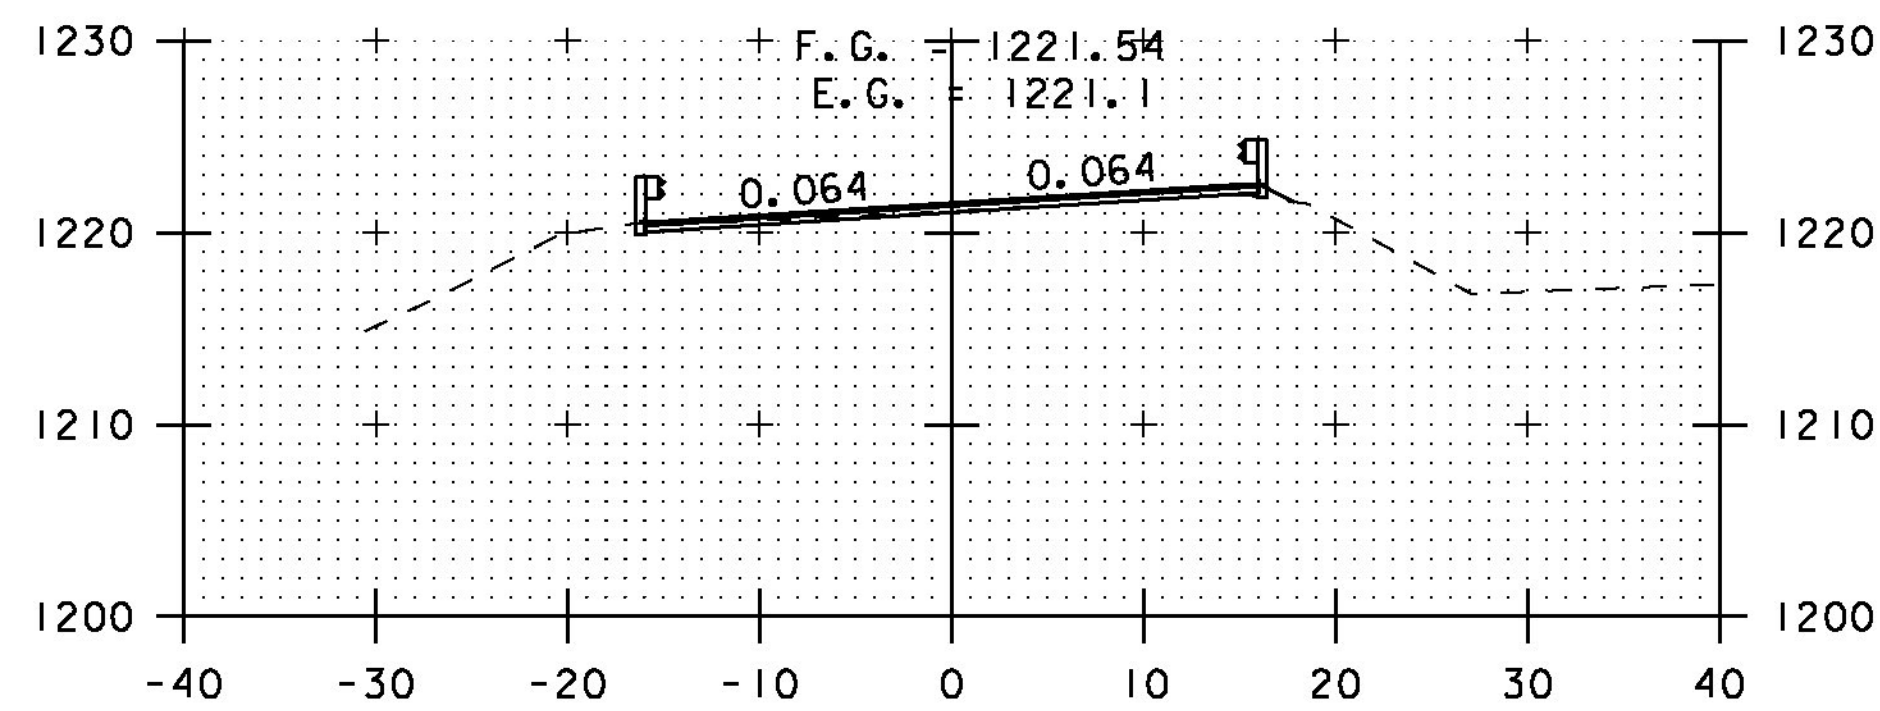


241+00

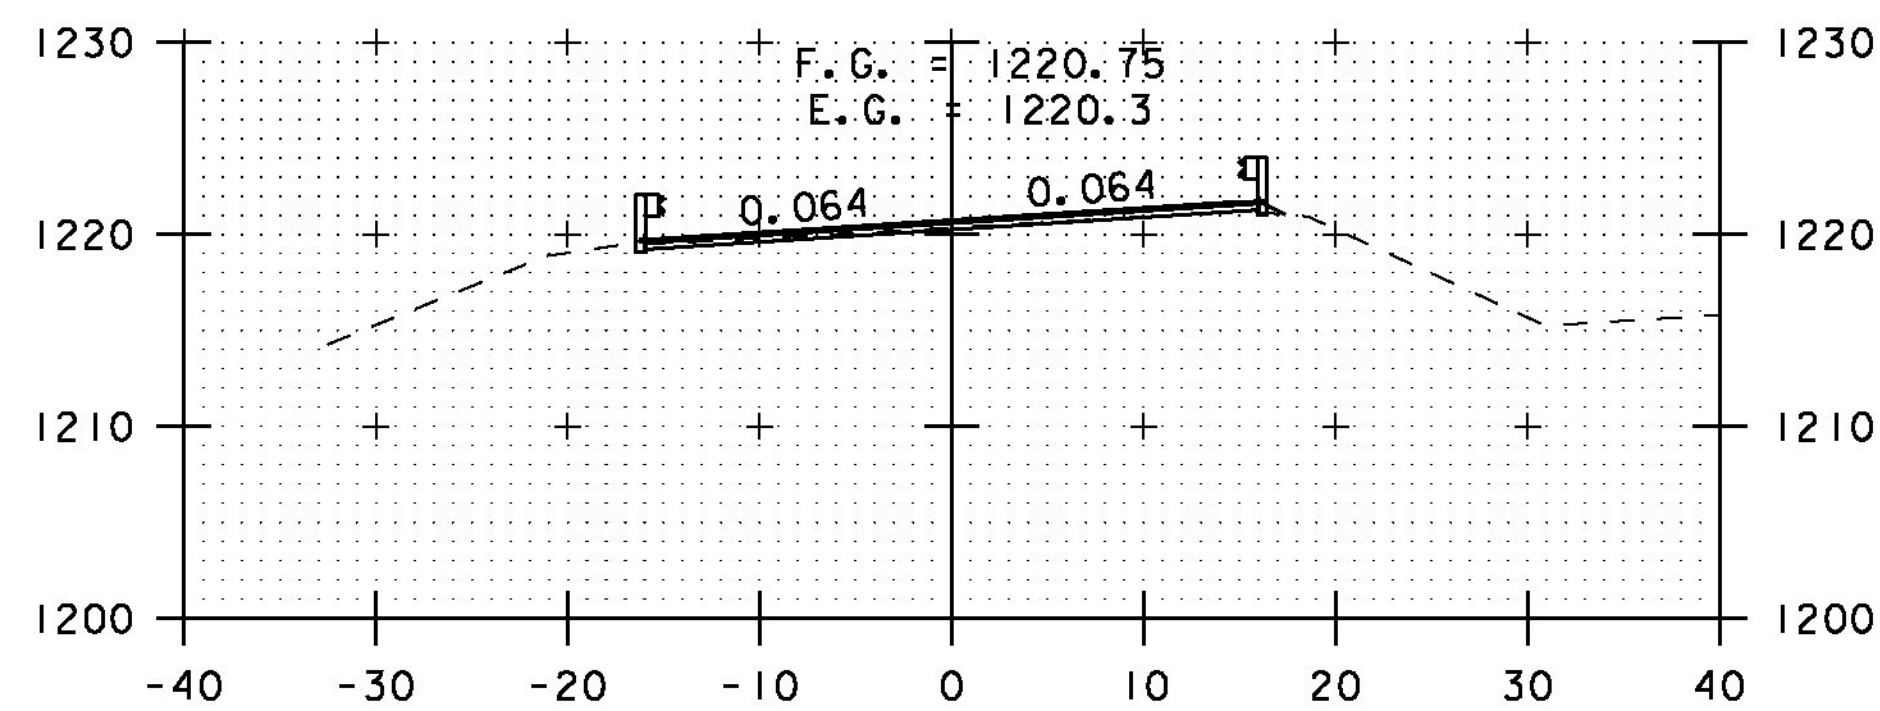


240+50

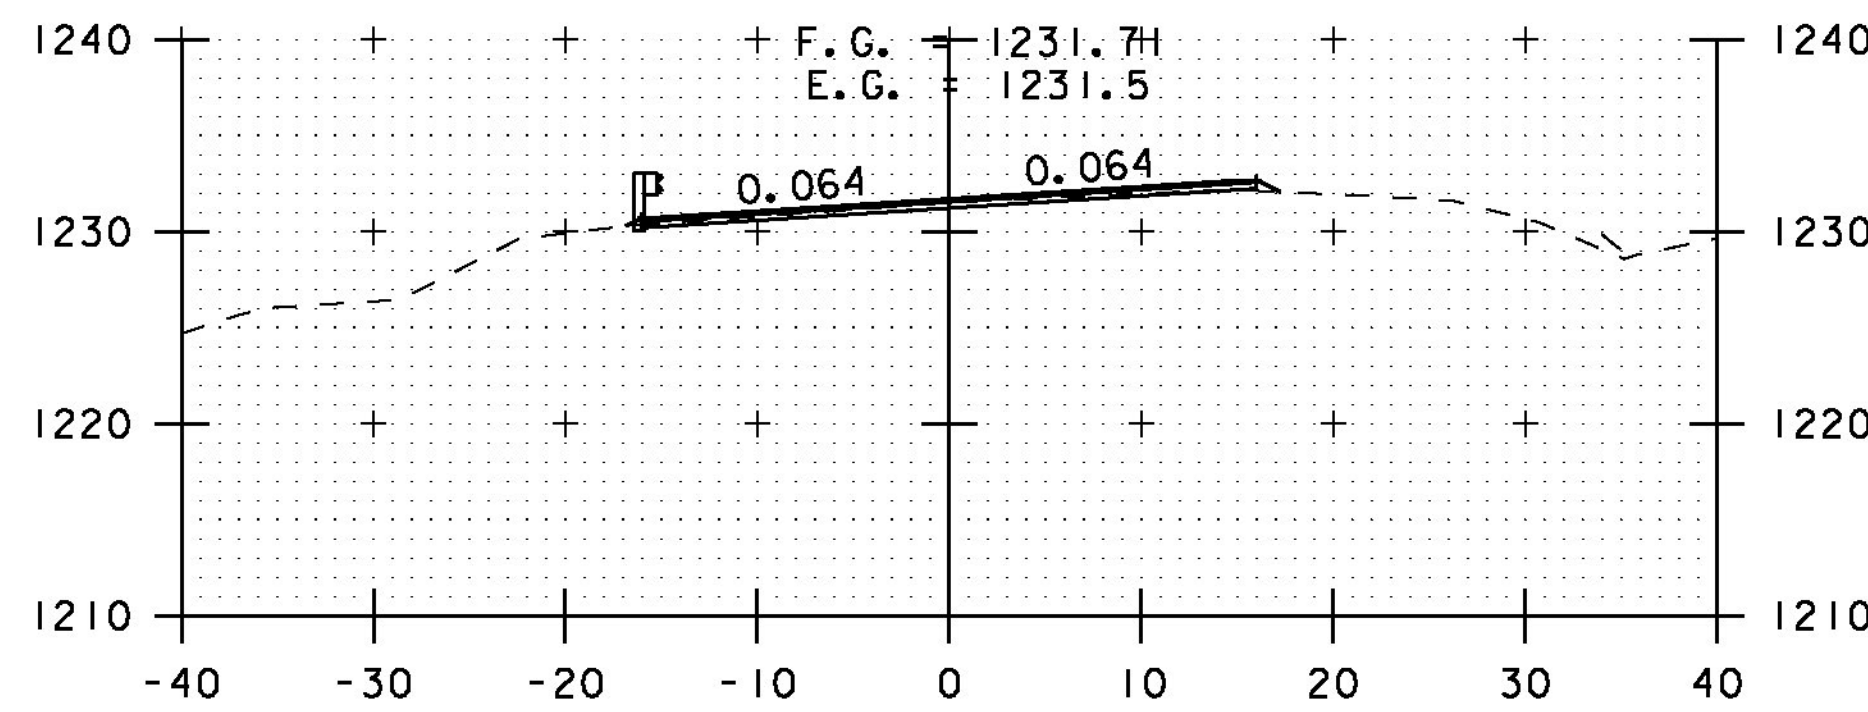


243+50

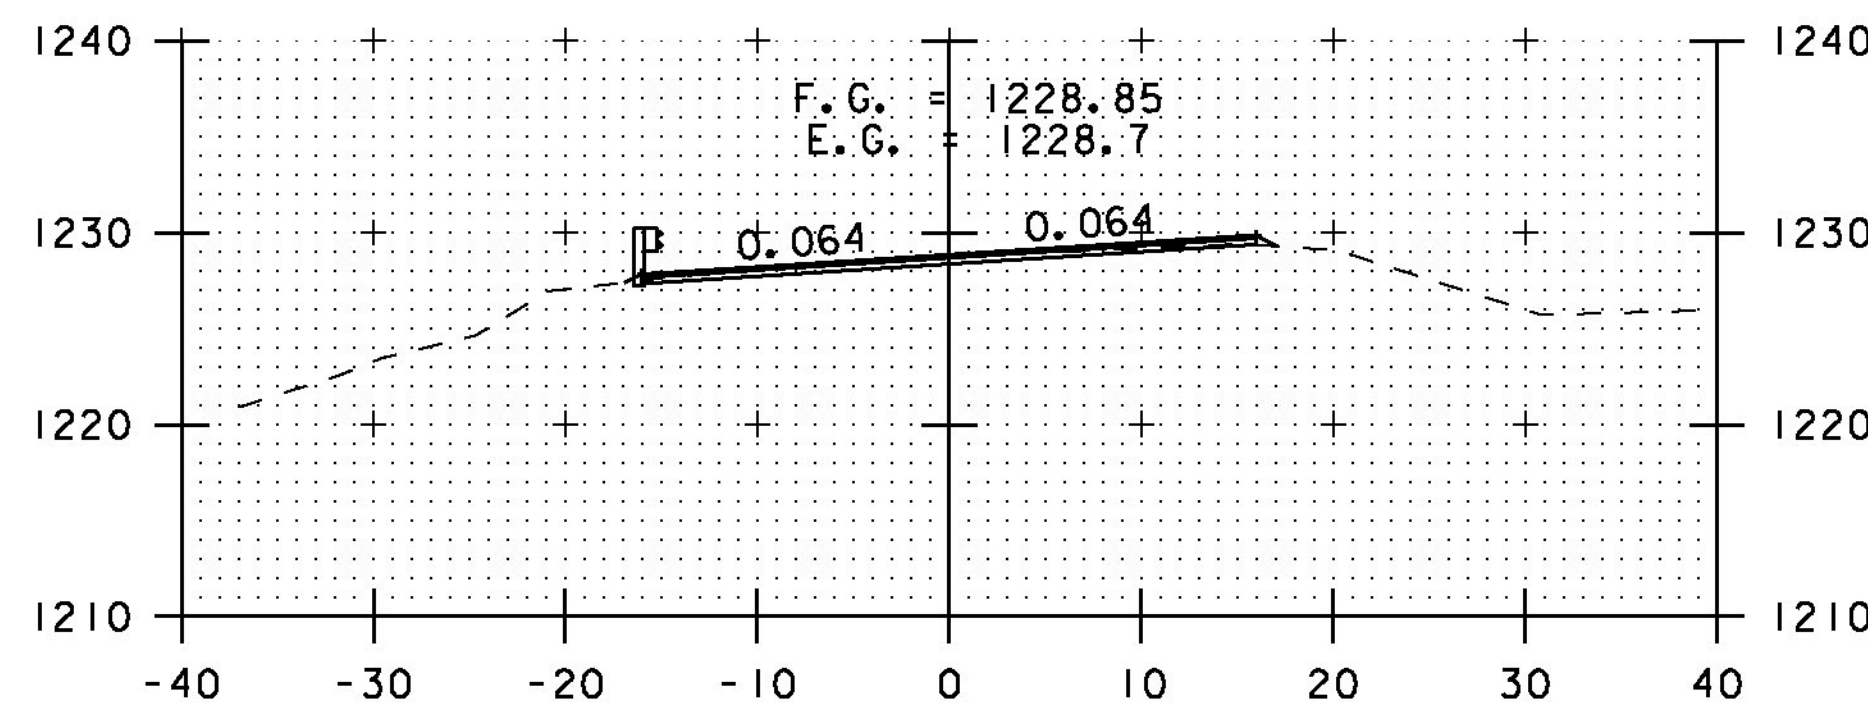


243+00

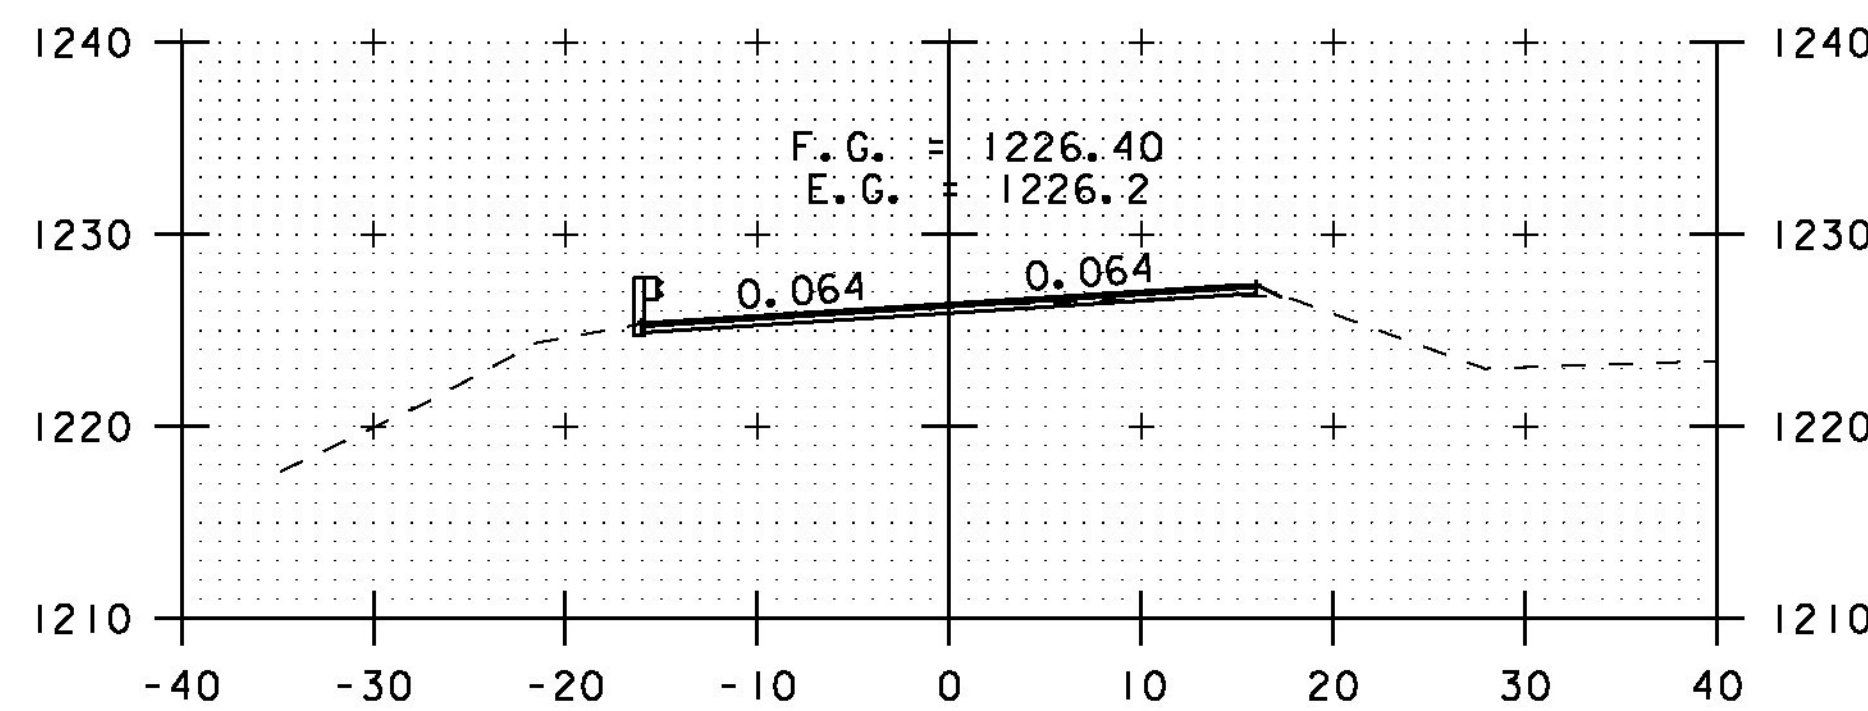


242+50

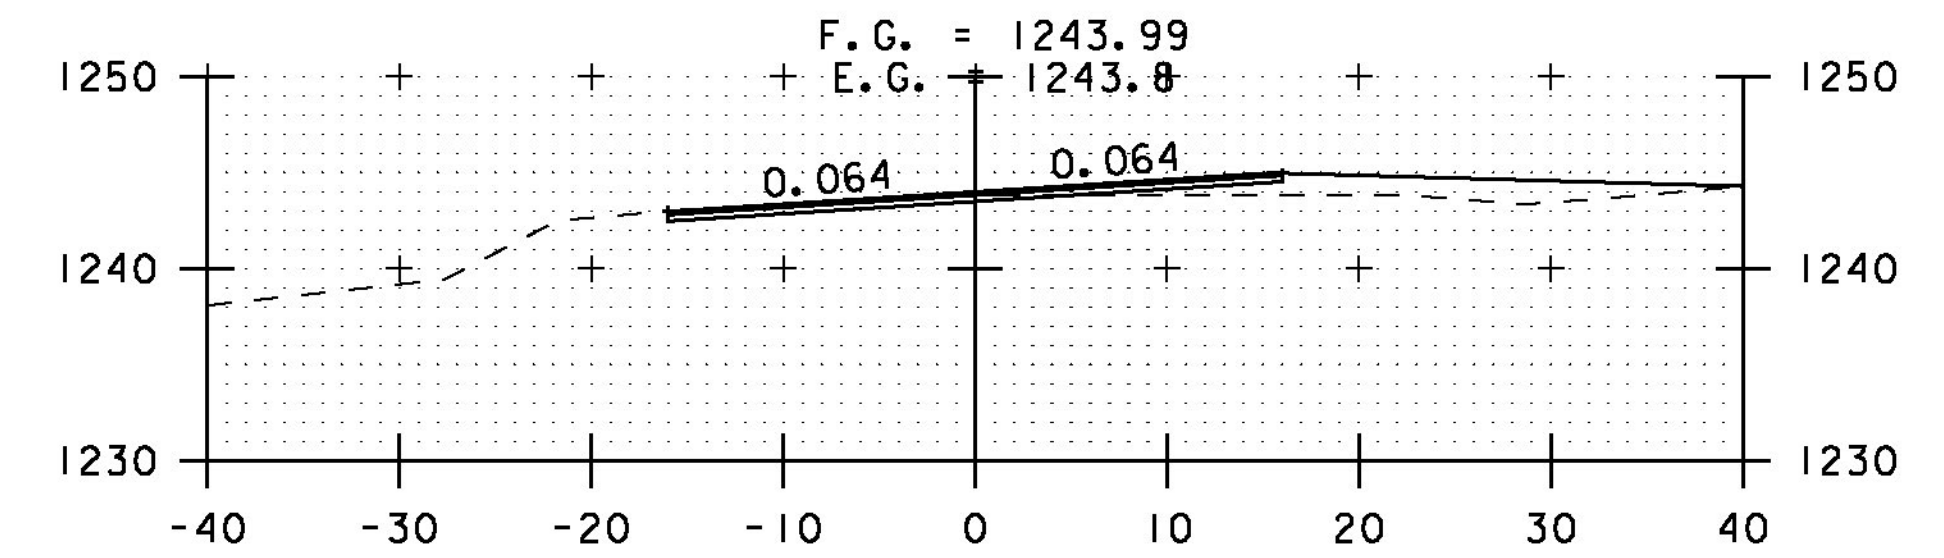


TH#1 RT  
245+50

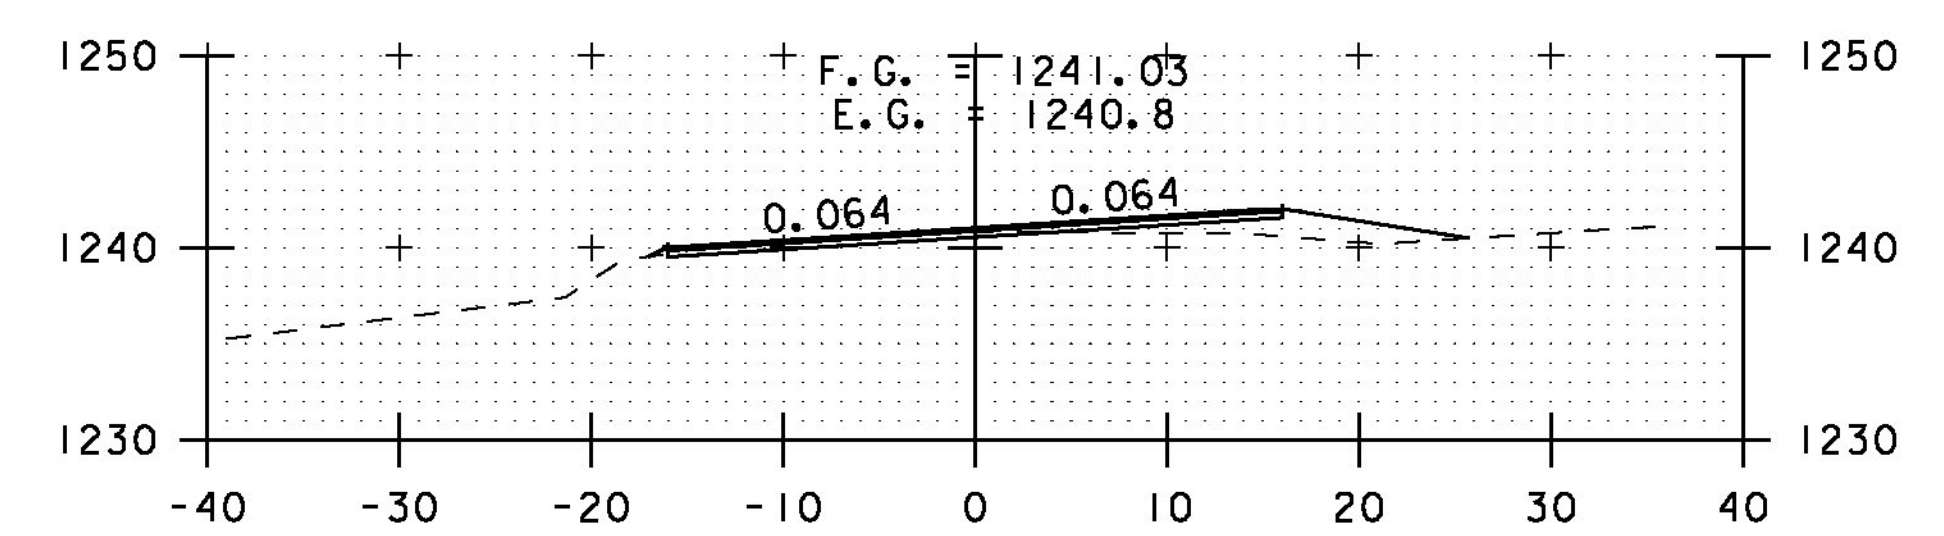

DRIVE RT  
245+00

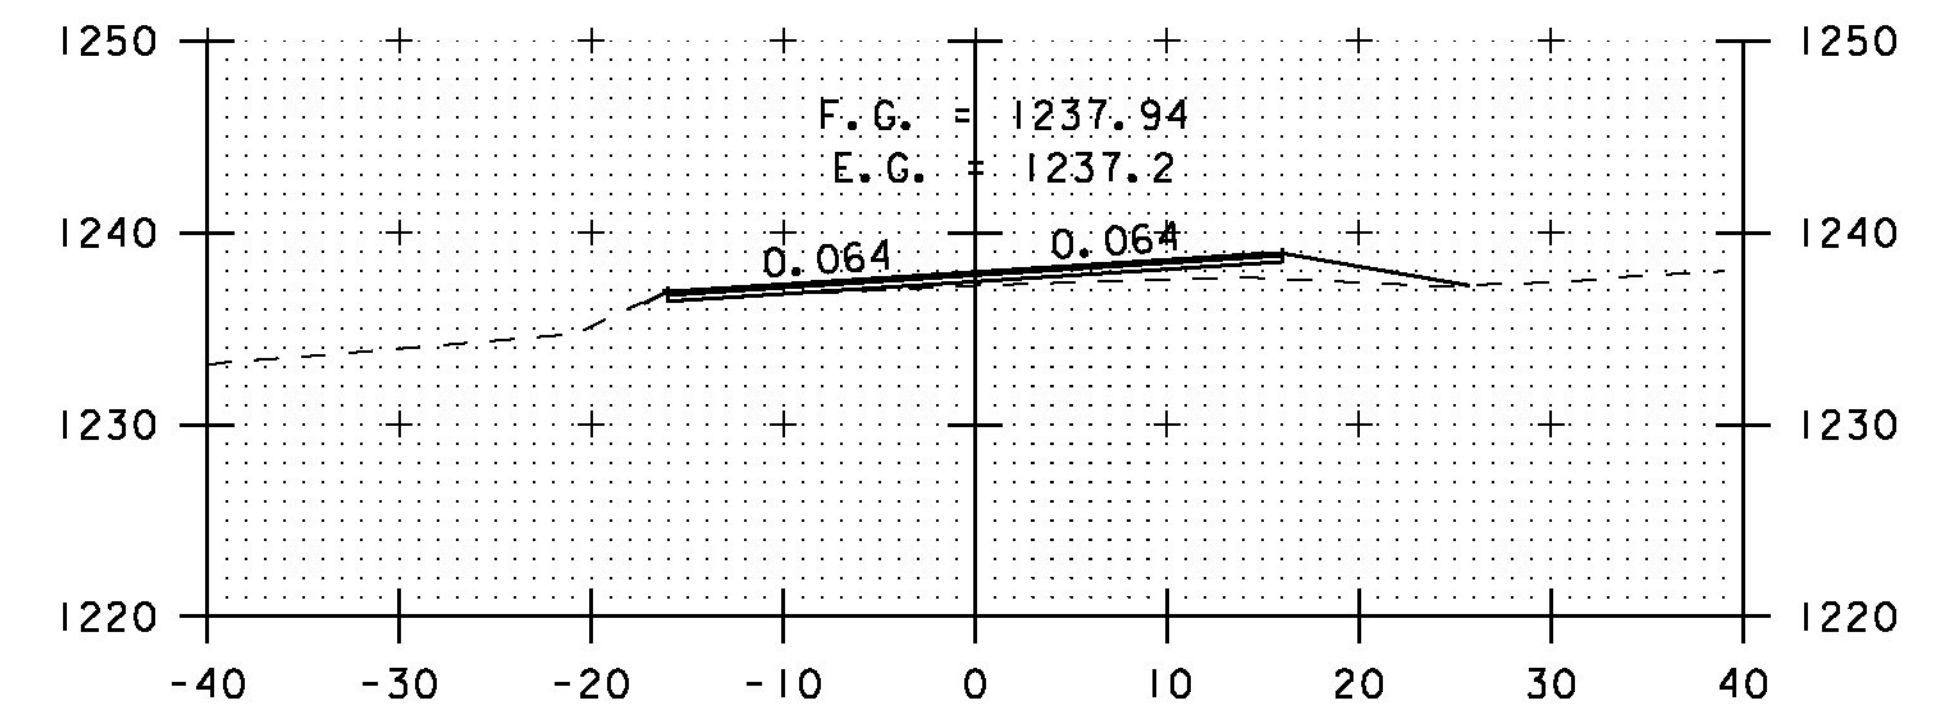

DRIVE RT  
244+50

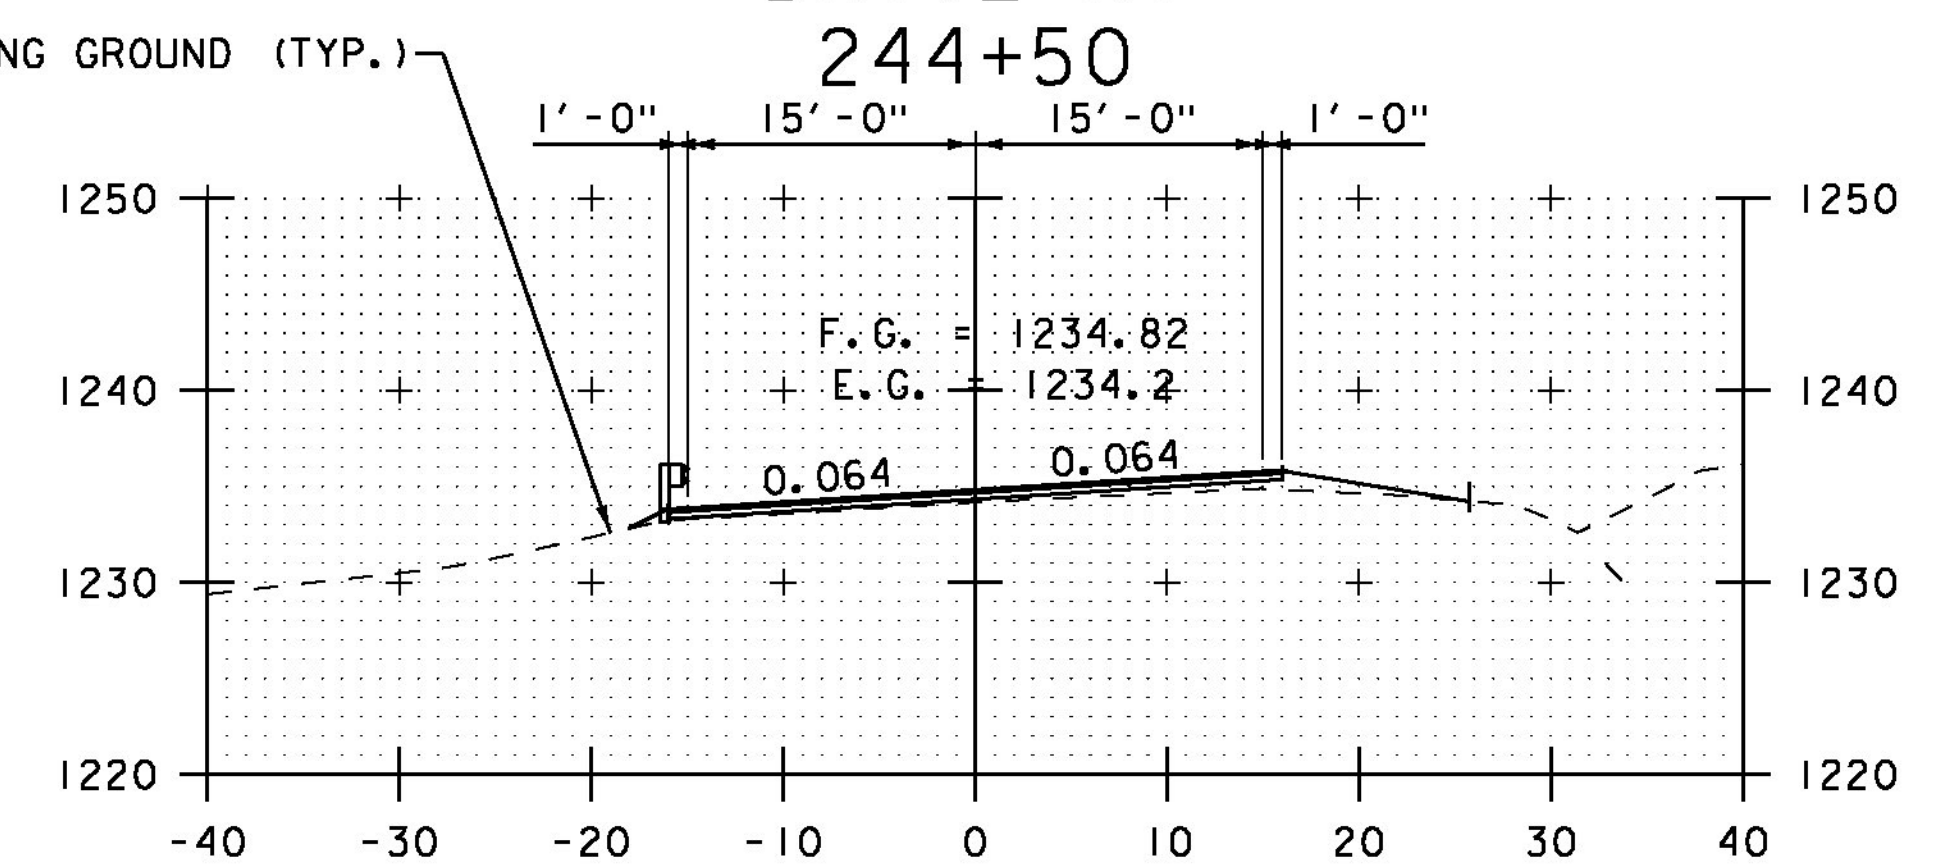

244+00 DRIVE RT



STA. 240+50 TO STA. 245+50

**CROSS SECTION SHEET 11**

PROJECT NAME: ELMORE-MORRISTOWN

PROJECT NUMBER: STP 2937 (I)

FILE NAME: z11c310.dgn

PROJECT LEADER: C. LATHROP

DESIGNED BY: S. LAMPHERE

PLOT FILE: z11c310\_139.i

PLOT DATE: 3/3/14

DRAWN BY: B. MARTIN

CHECKED BY: C. LATHROP

SHEET 139 OF 194