




247+50

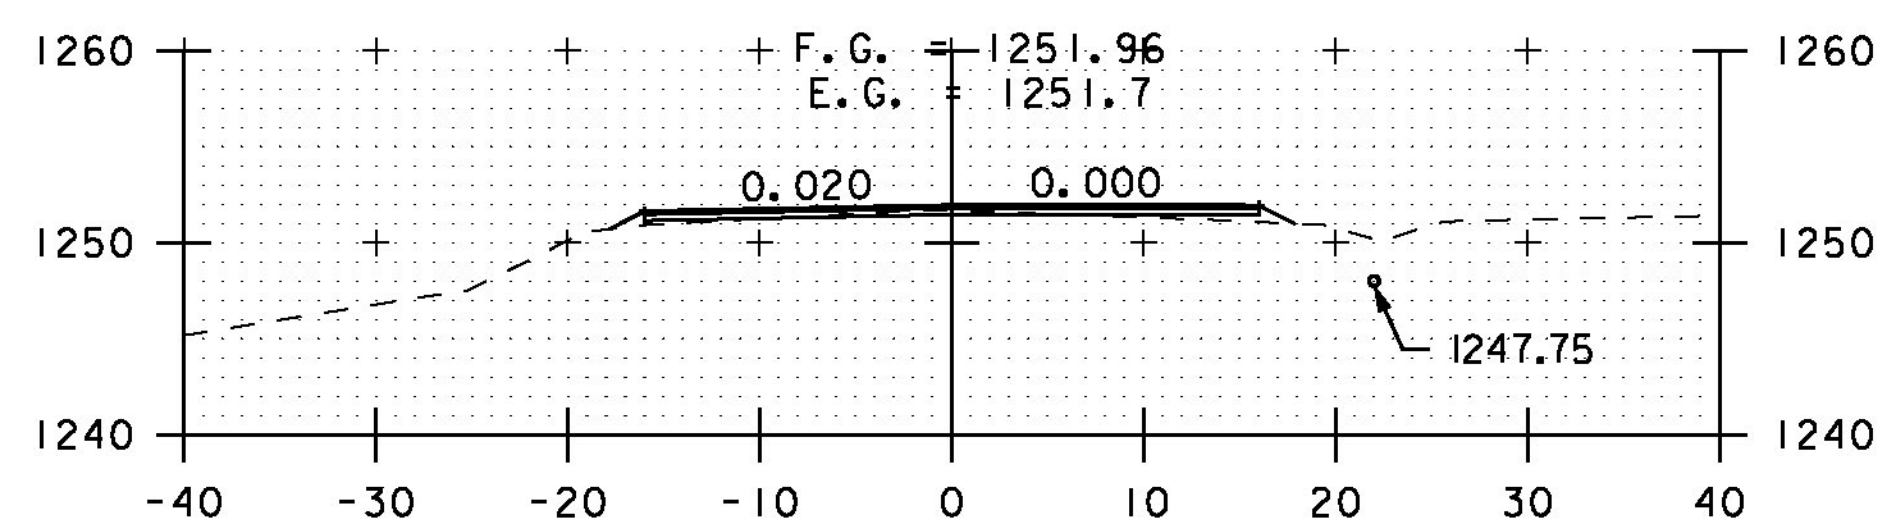


247+00

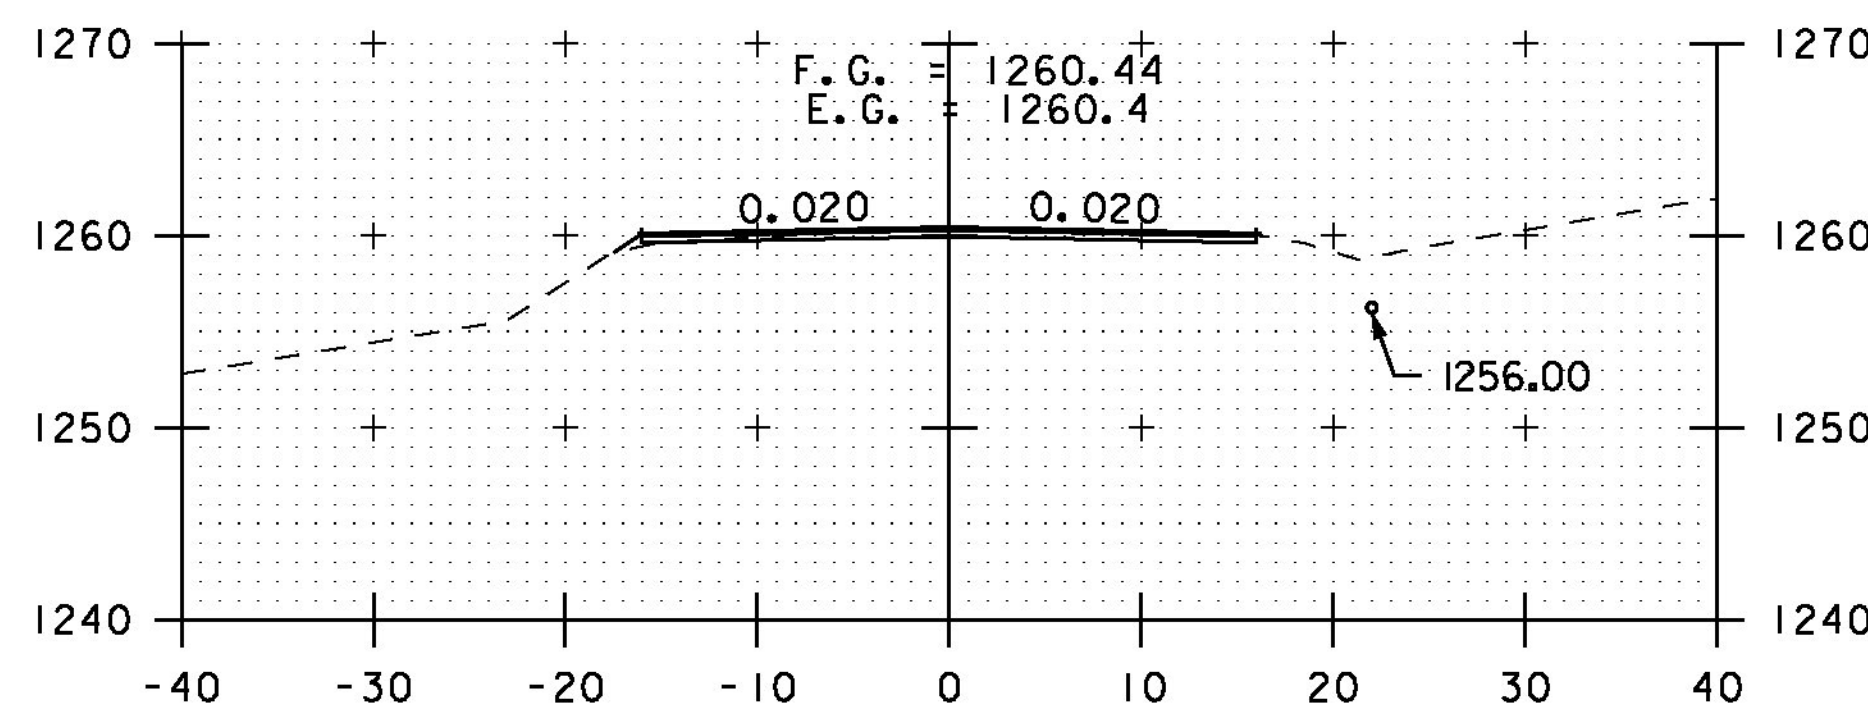


249+00

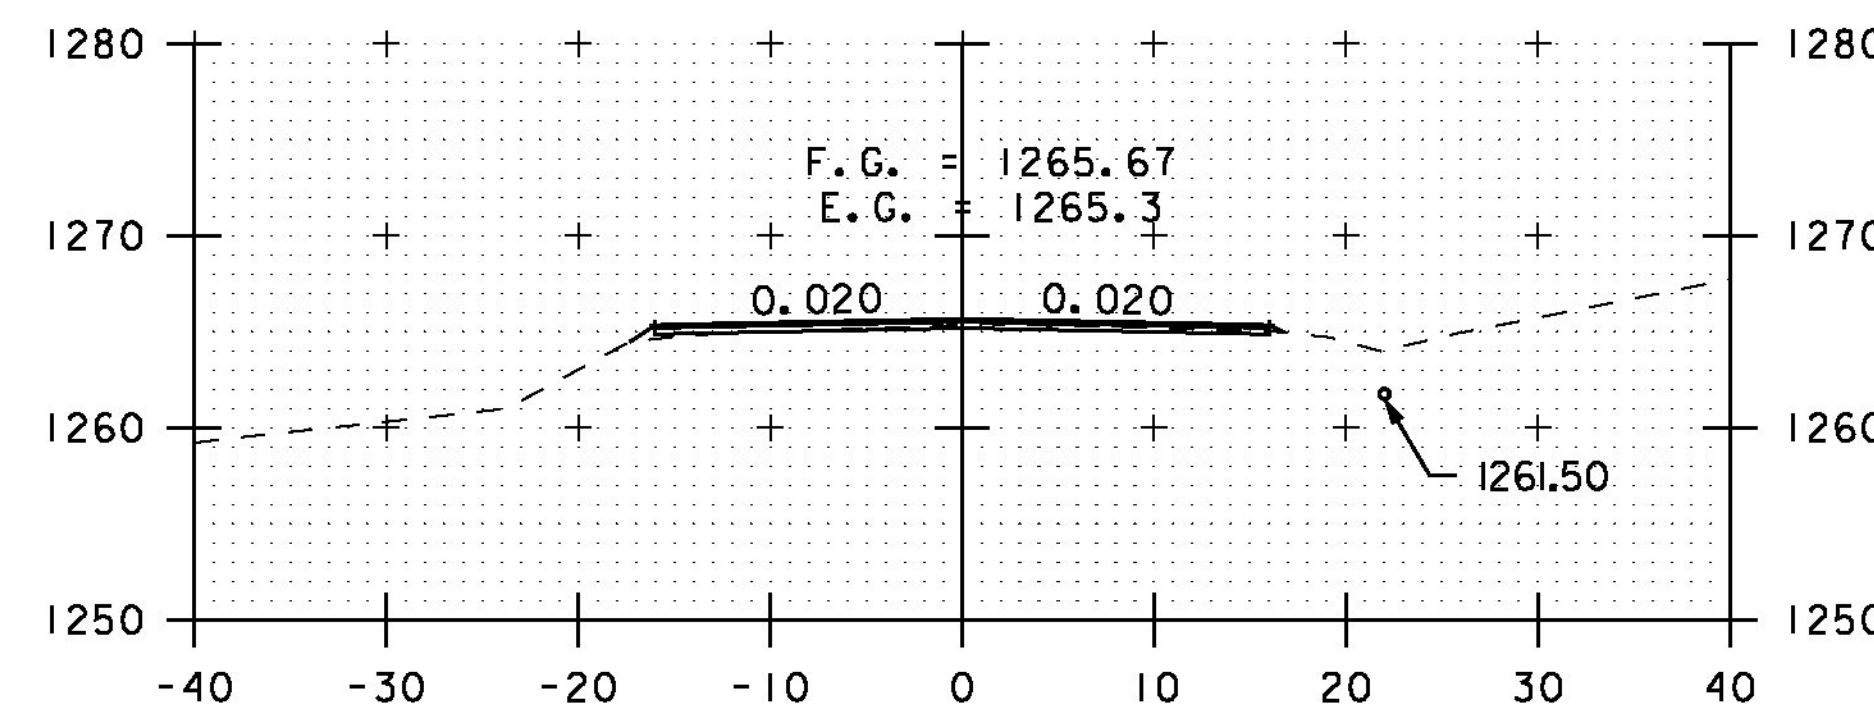


250+50

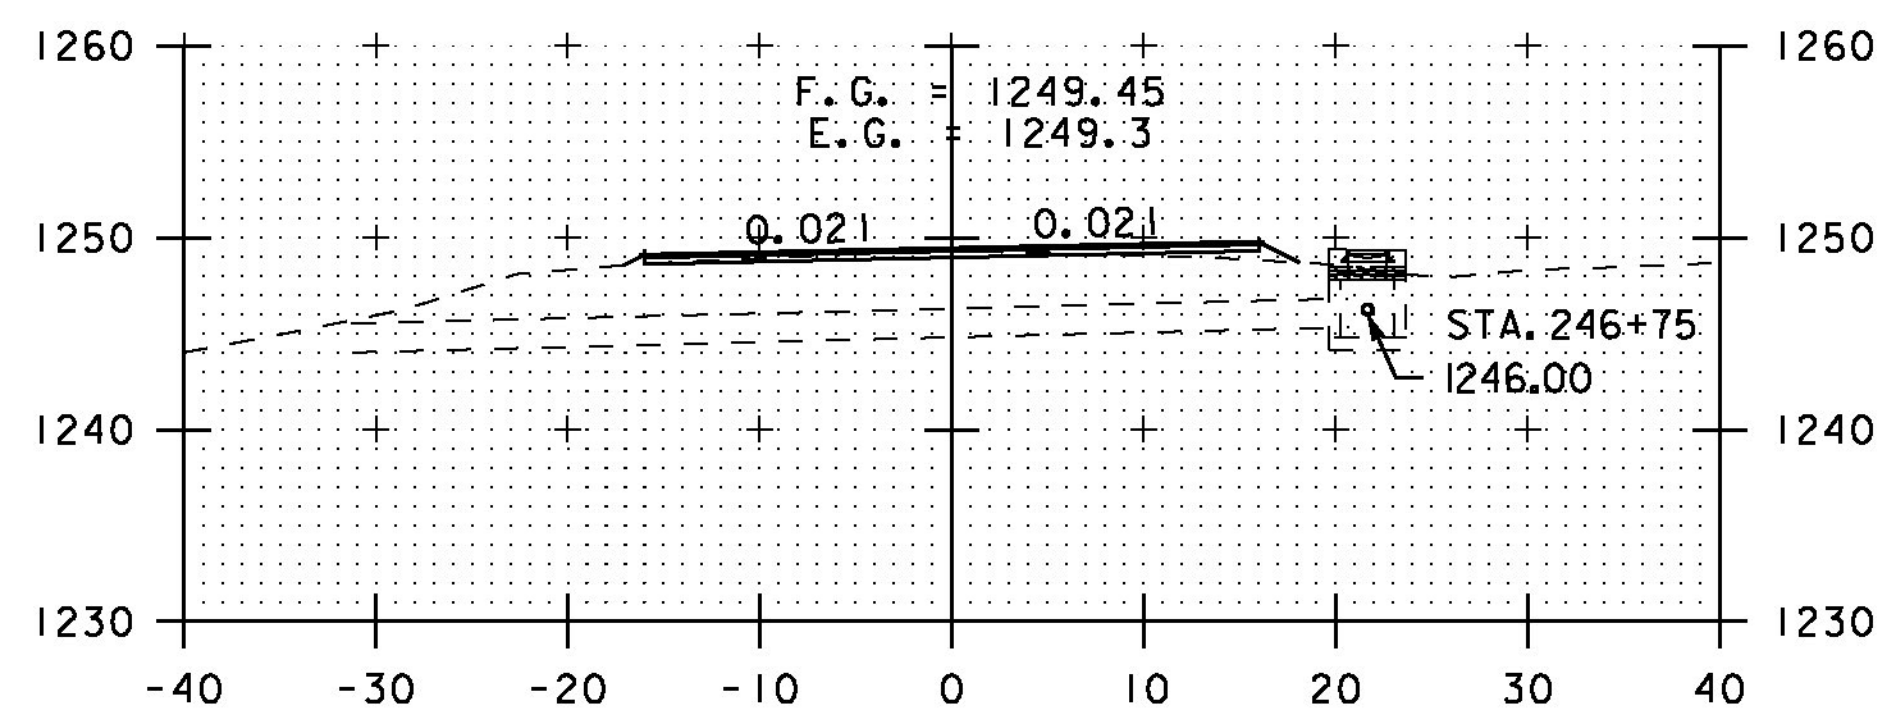


246+50

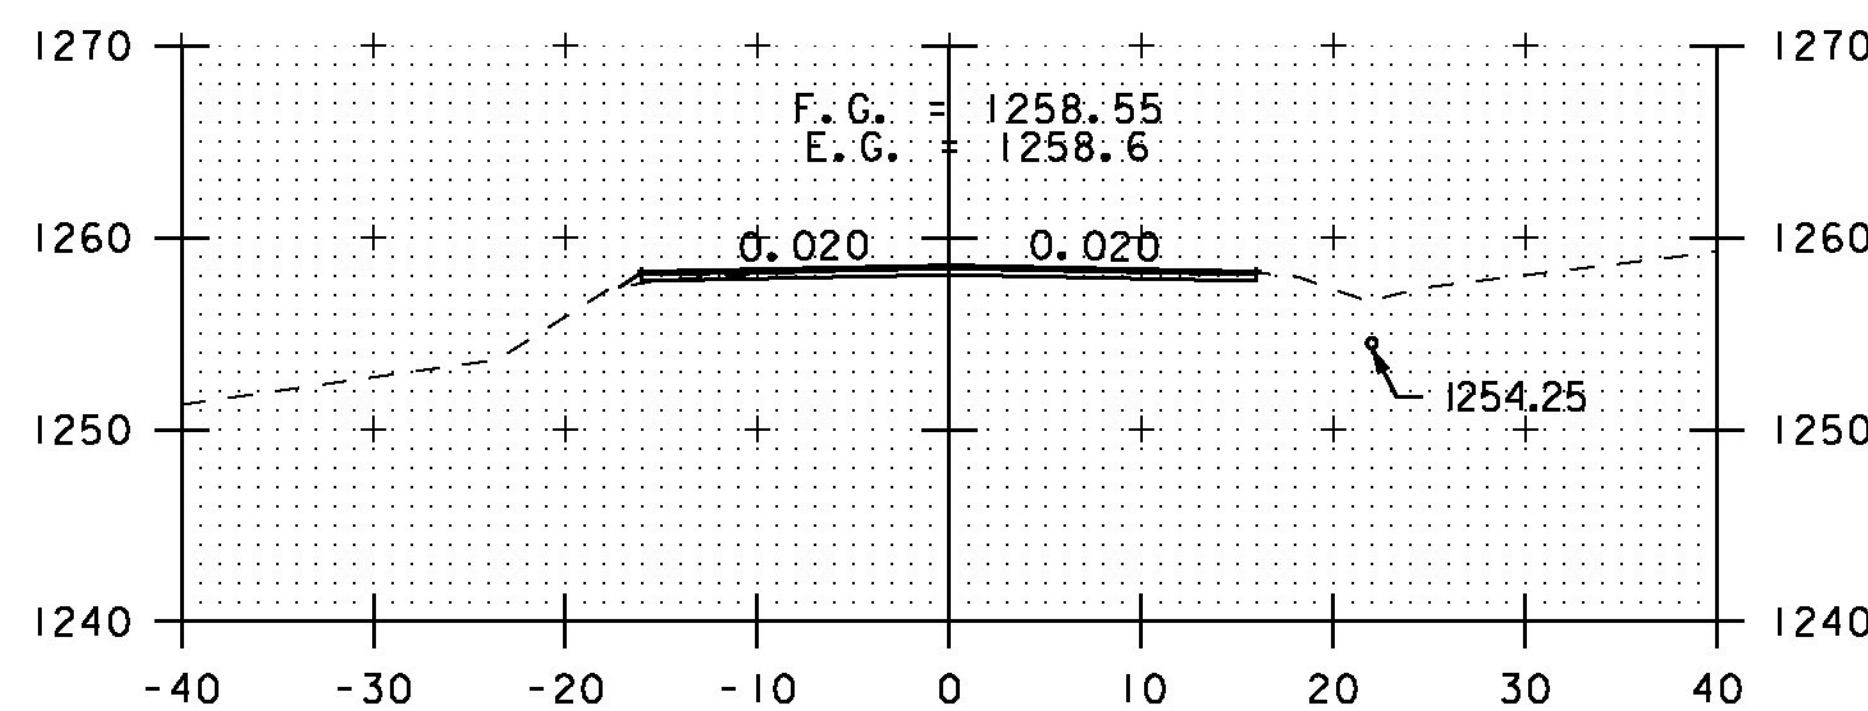


248+50

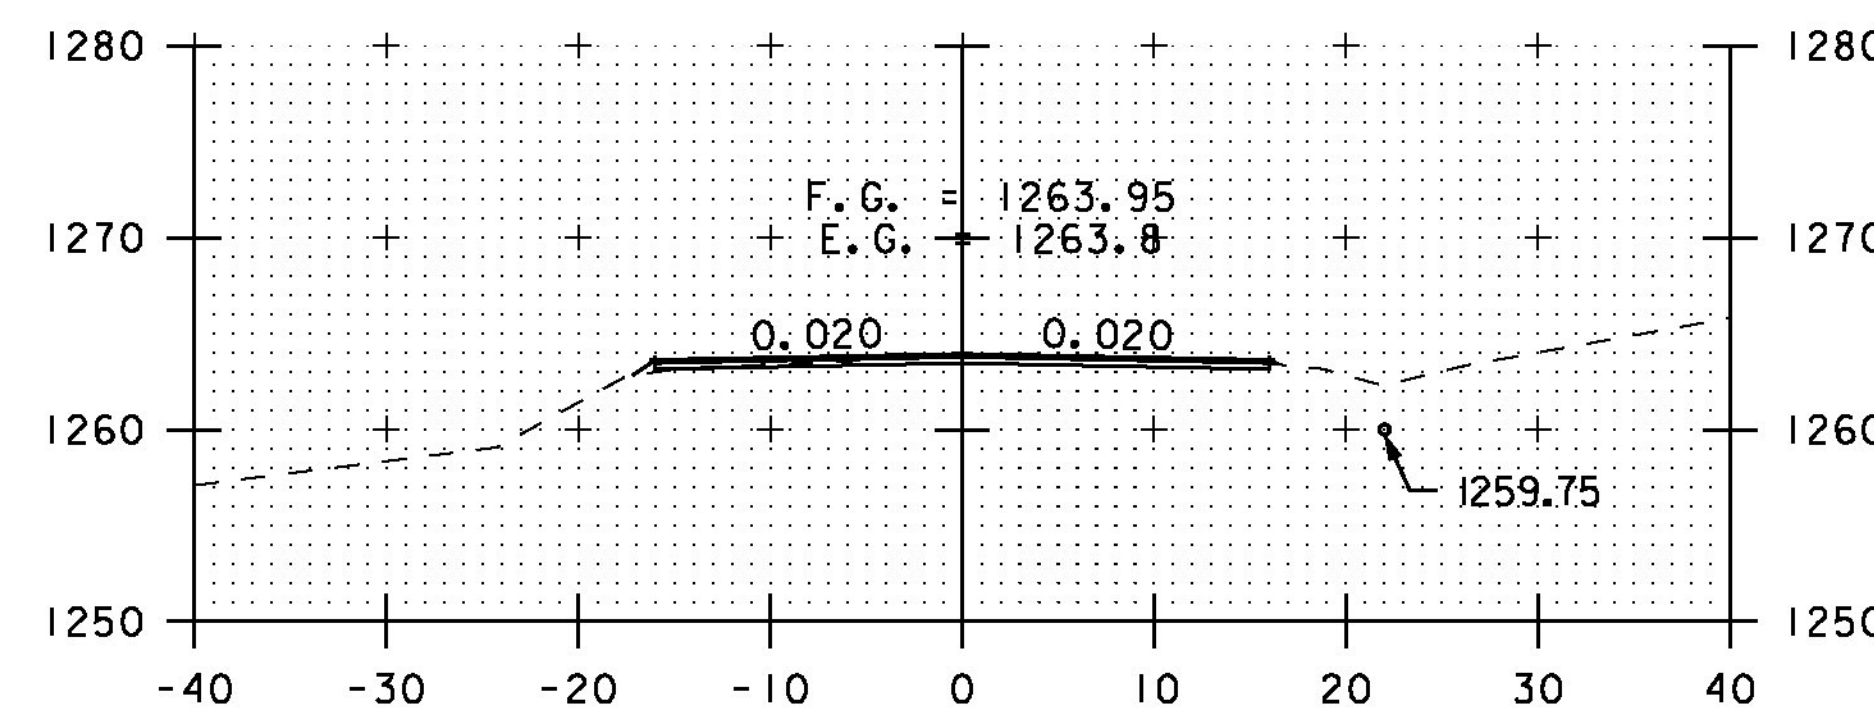


250+00

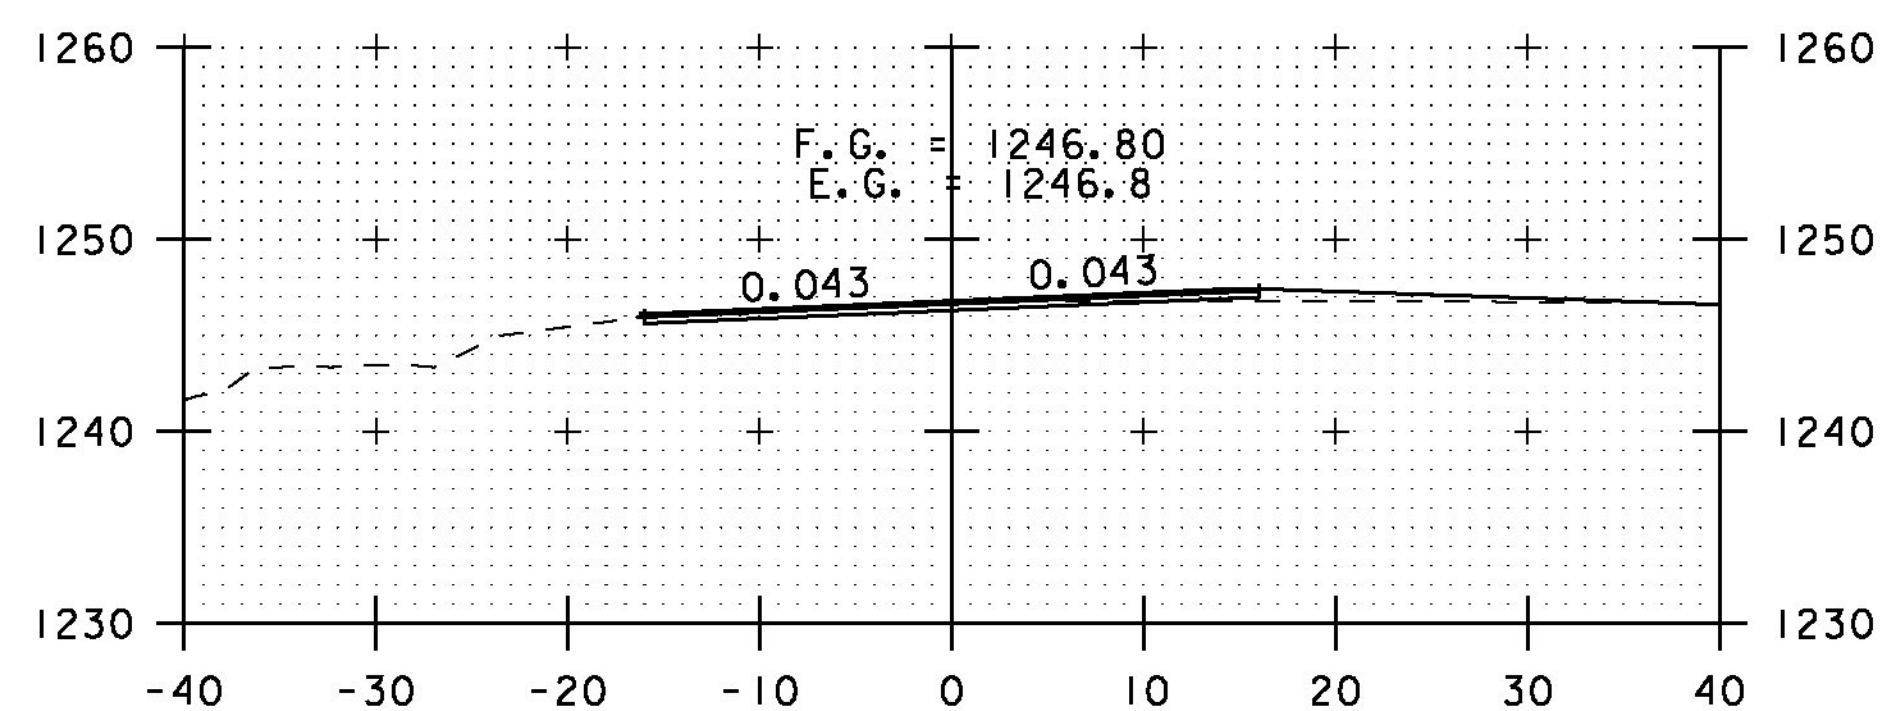

TH#1 RT
246+00

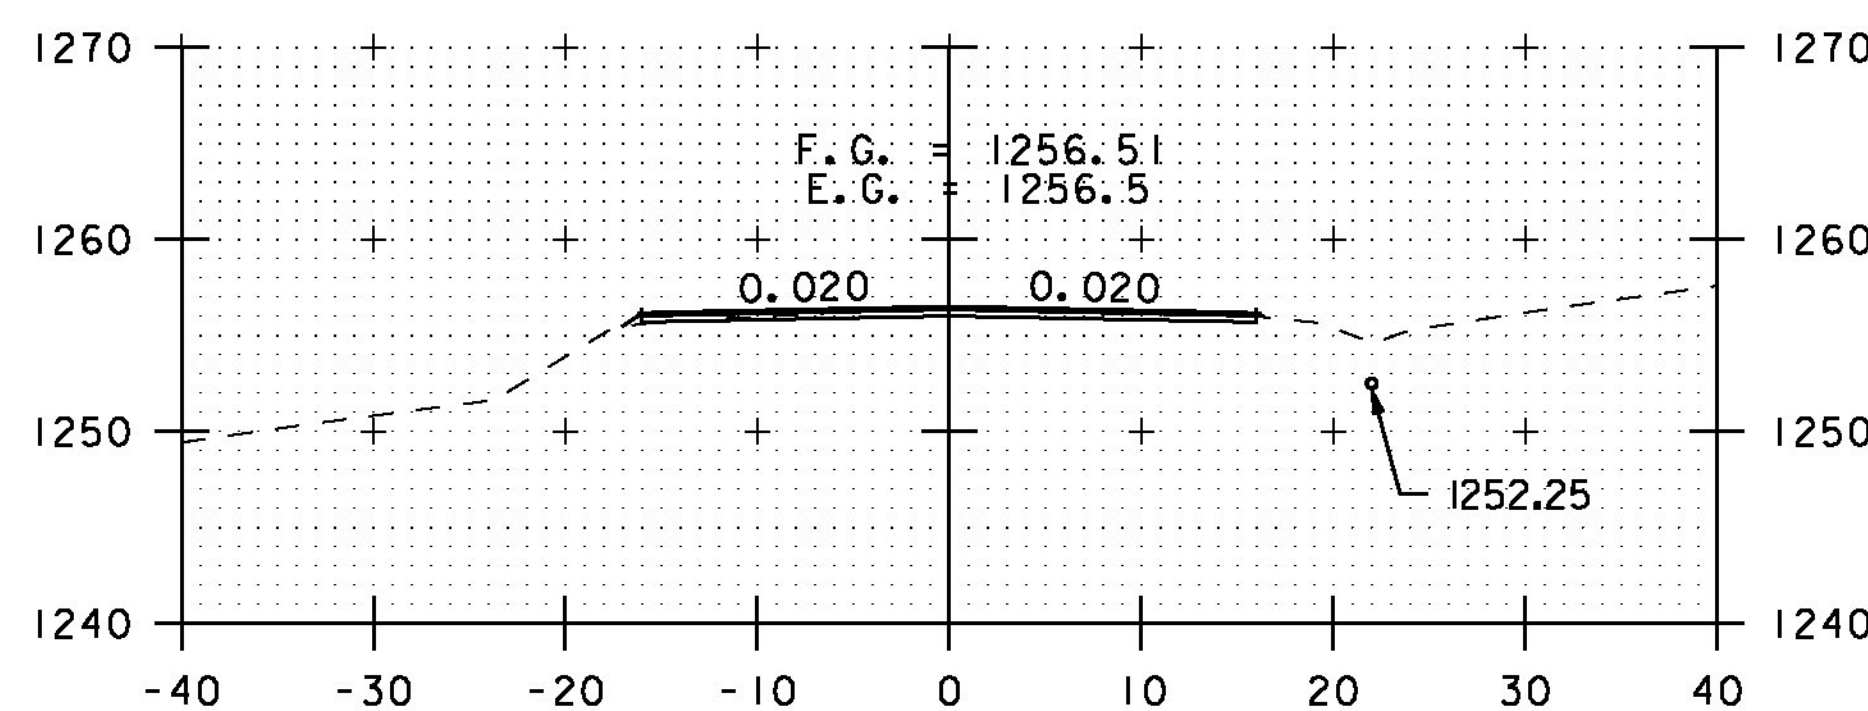

248+00

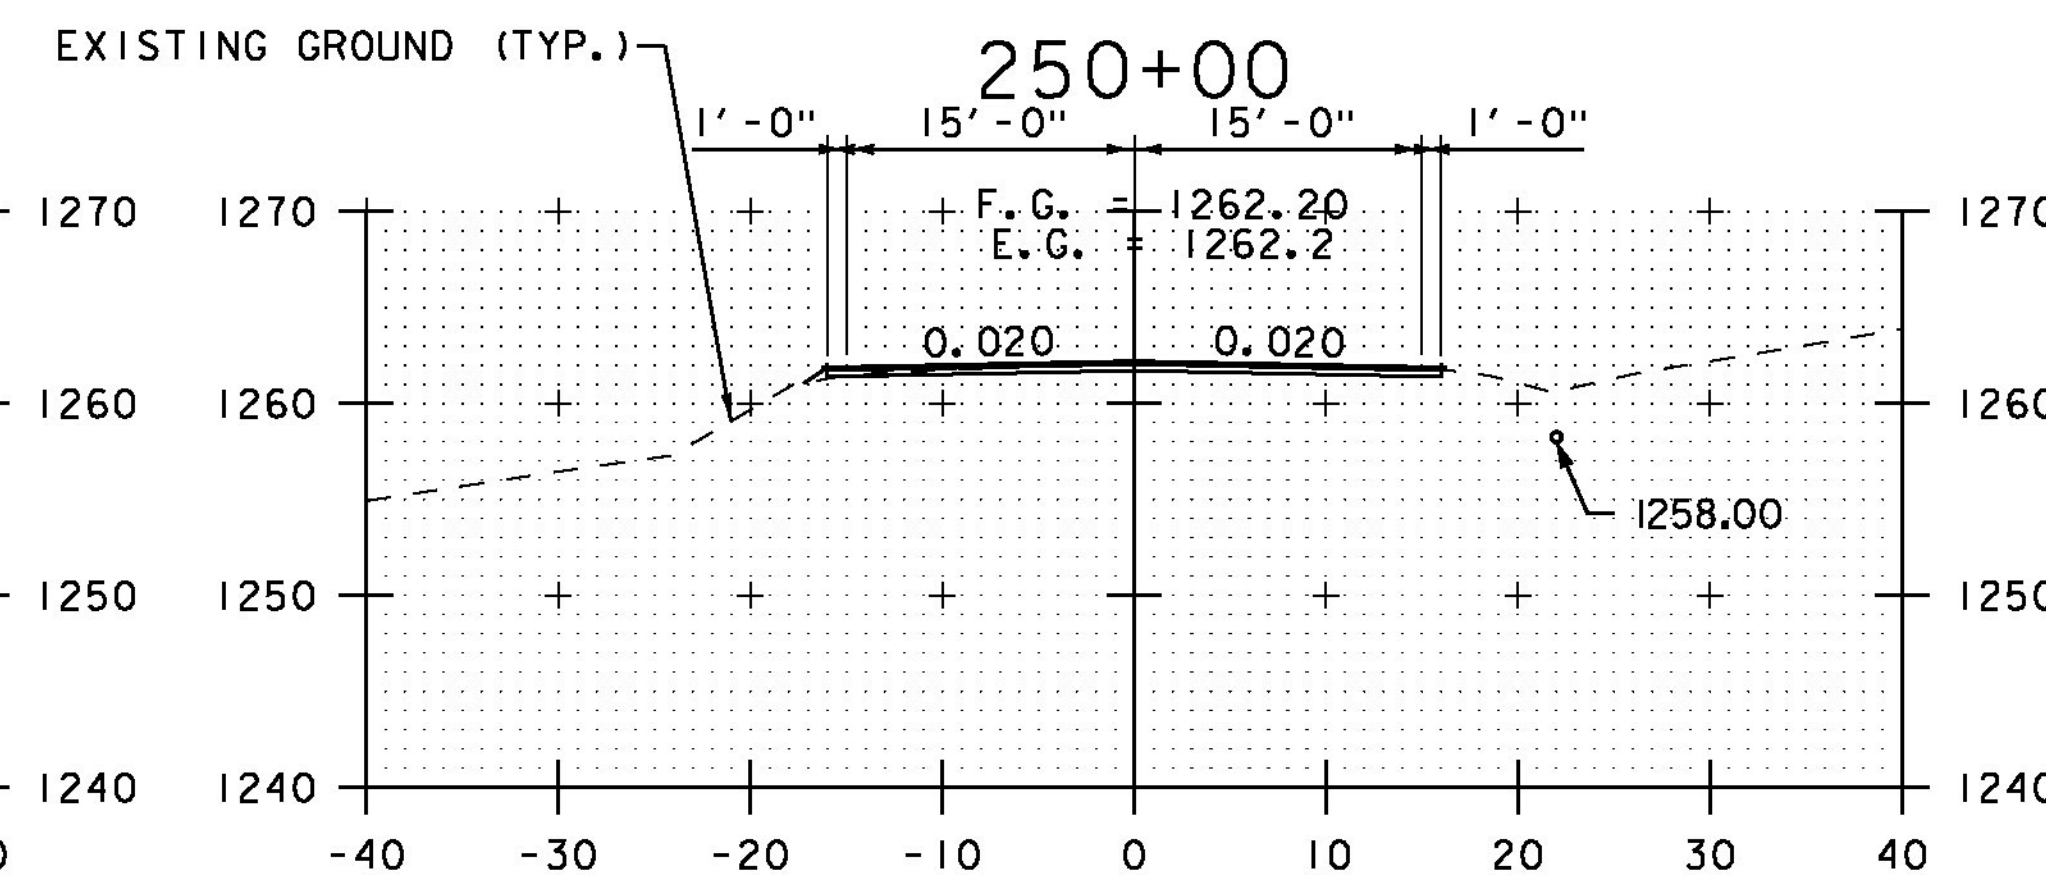

249+50

STA. 246+00 TO STA. 250+50



CROSS SECTION SHEET 12

PROJECT NAME: ELMORE-MORRISTOWN

PROJECT NUMBER: STP 2937 (1)

FILE NAME: z11c310.dgn

PROJECT LEADER: C. LATHROP

DESIGNED BY: S. LAMPHERE

PLOT FILE: z11c310_140.i

PLOT DATE: 3/3/14

DRAWN BY: B. MARTIN

CHECKED BY: C. LATHROP

SHEET 140 OF 194