




258+50

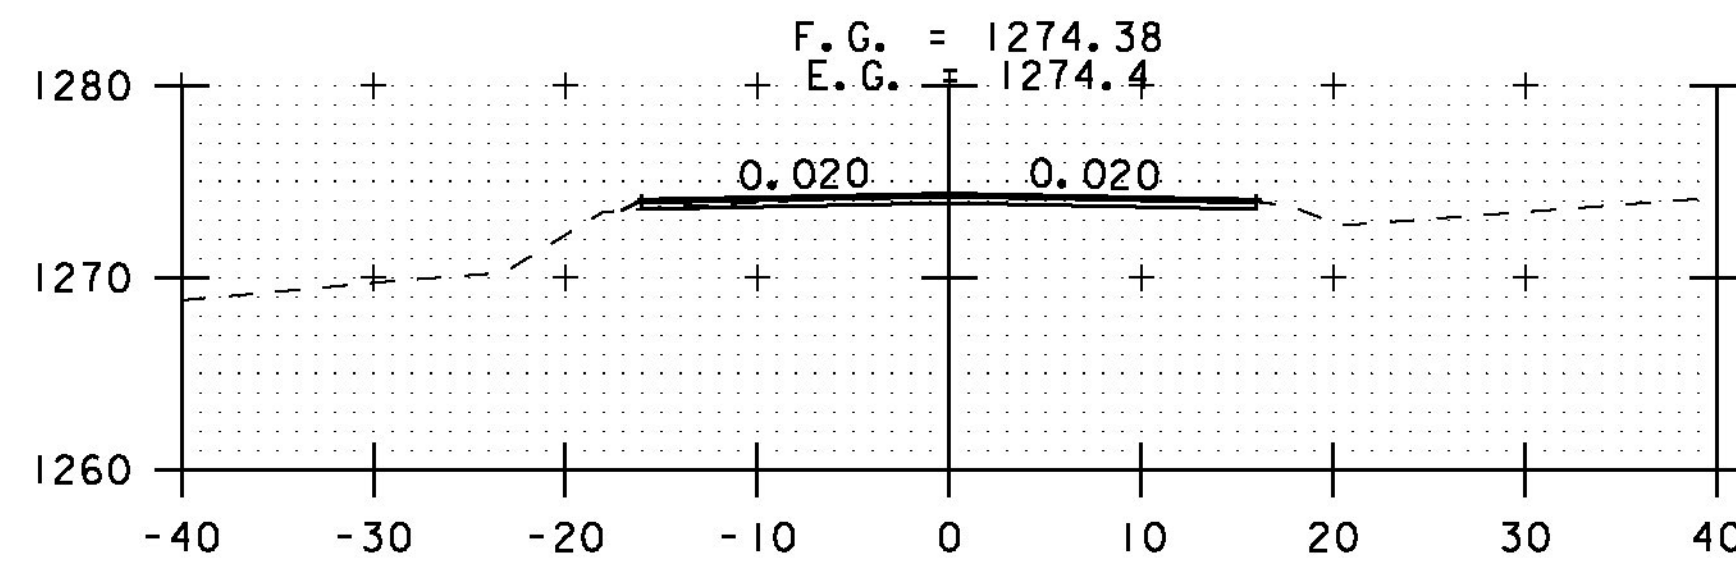


260+50

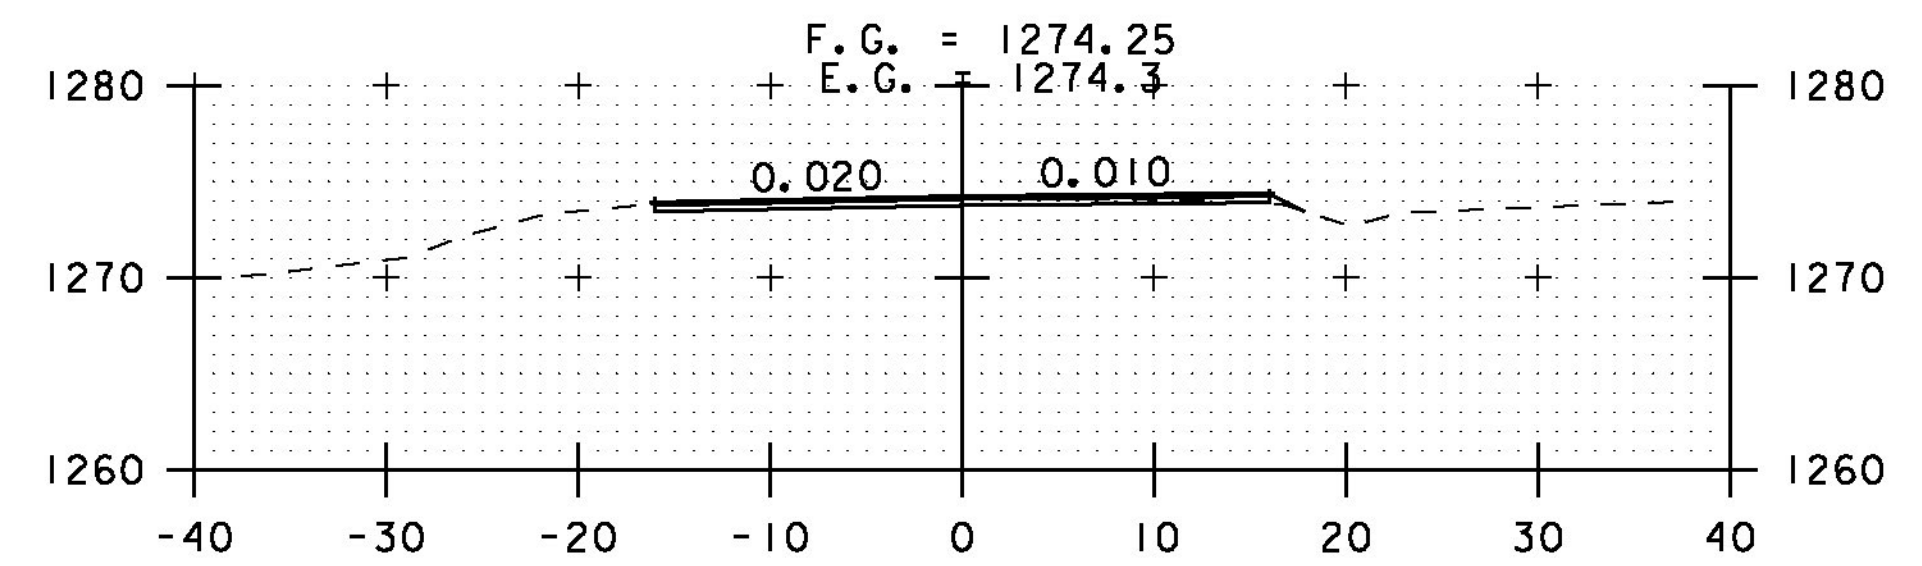


262+50

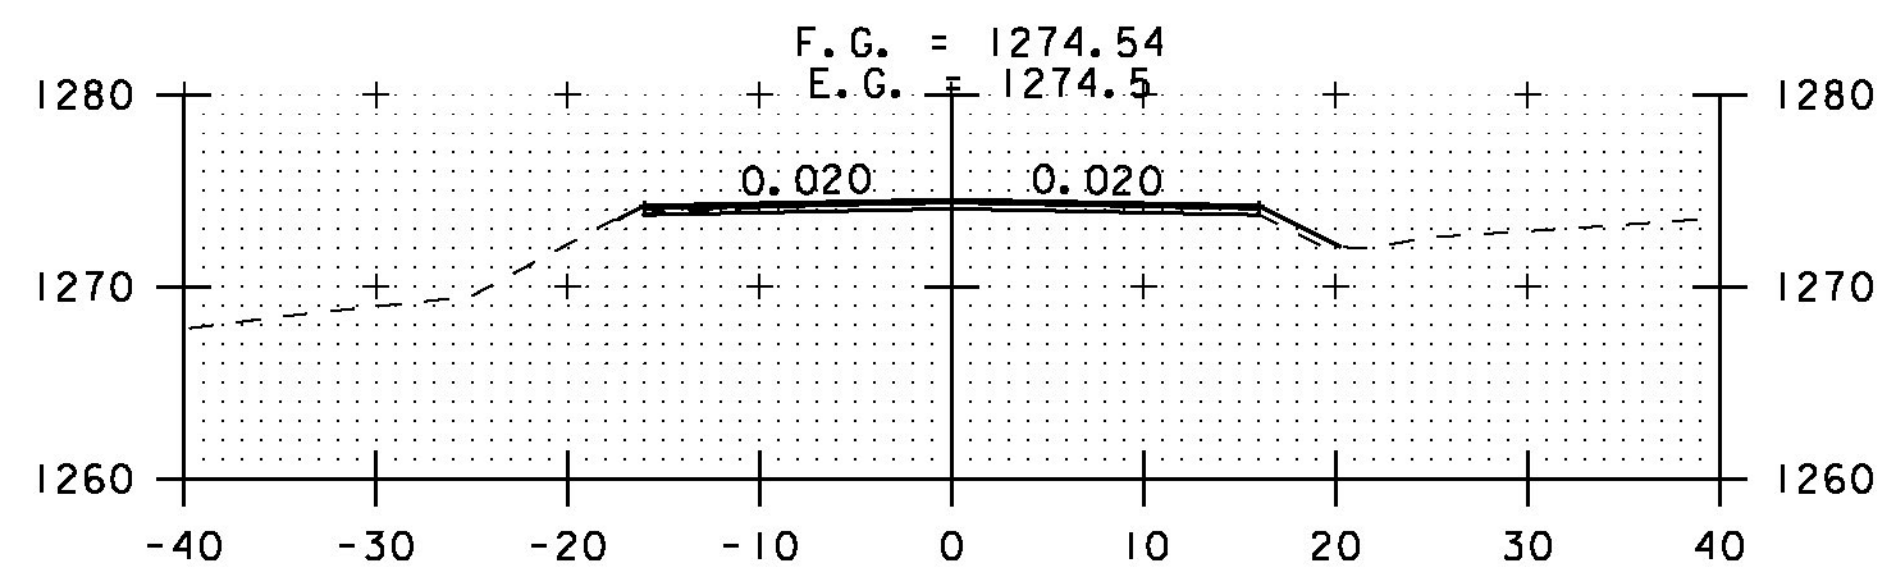


258+00

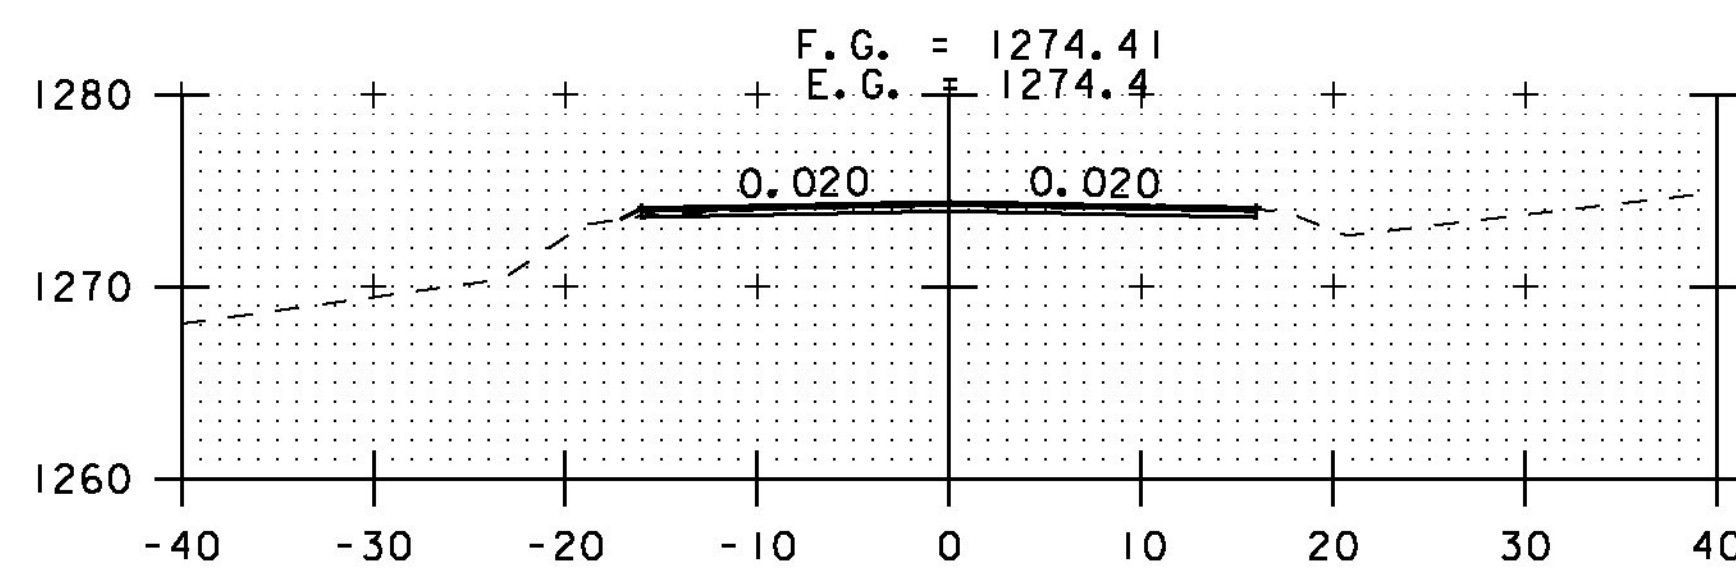


260+00

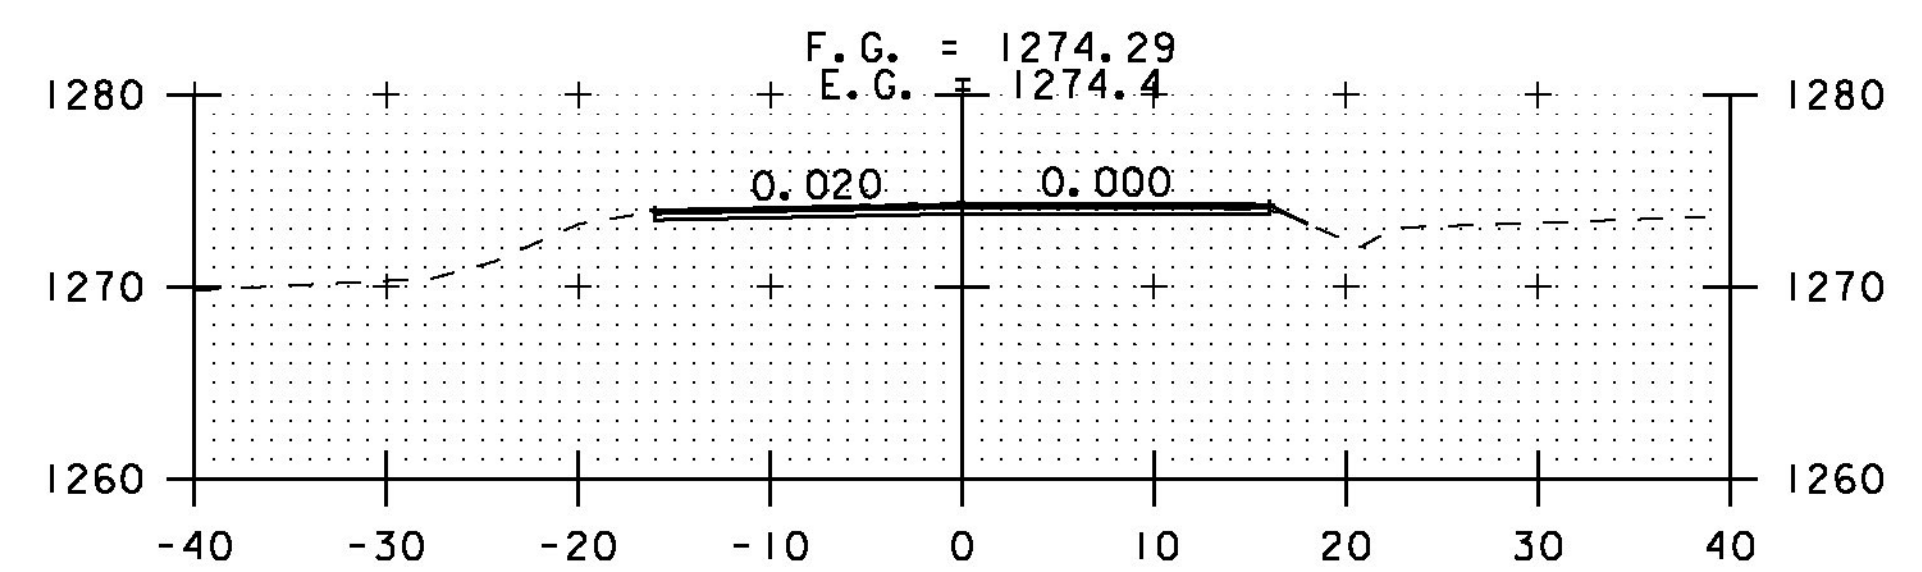


262+00

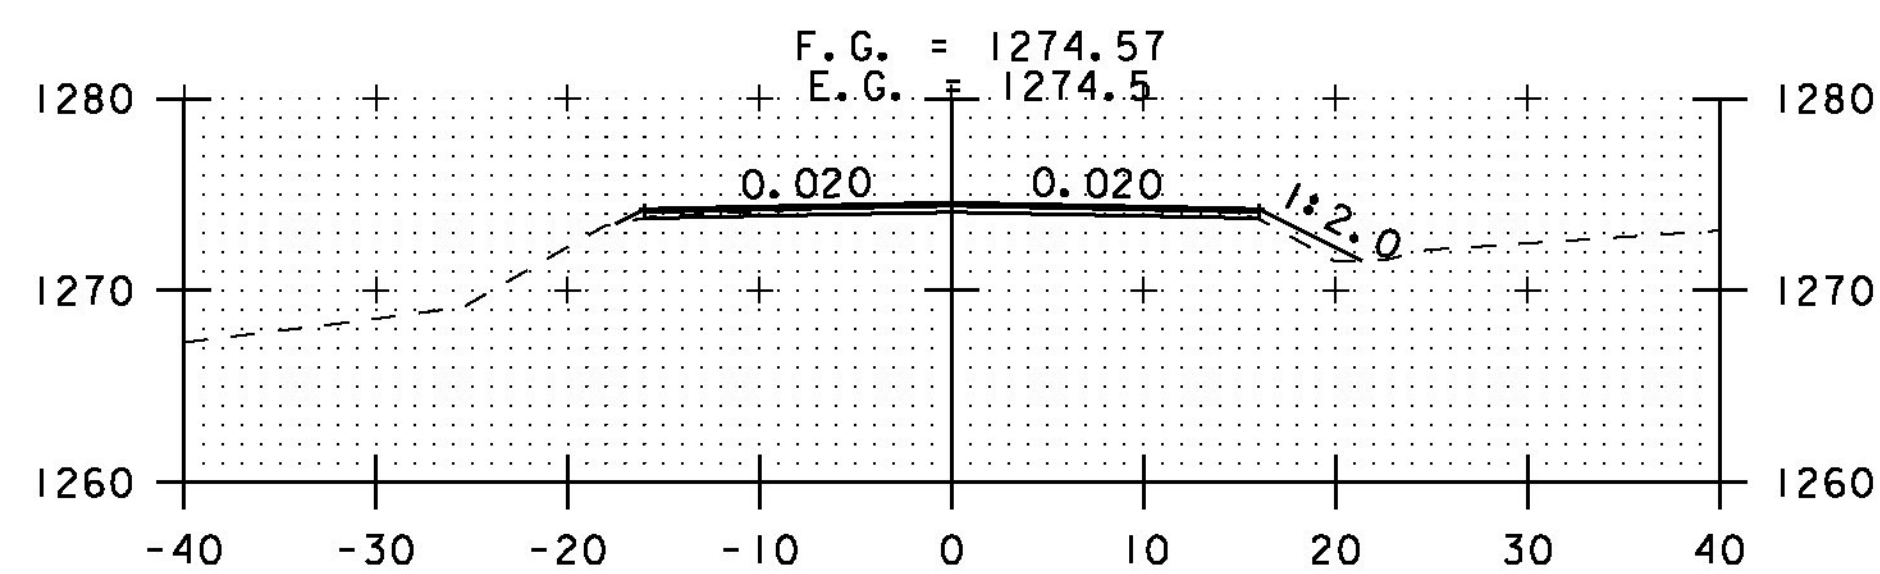


257+50

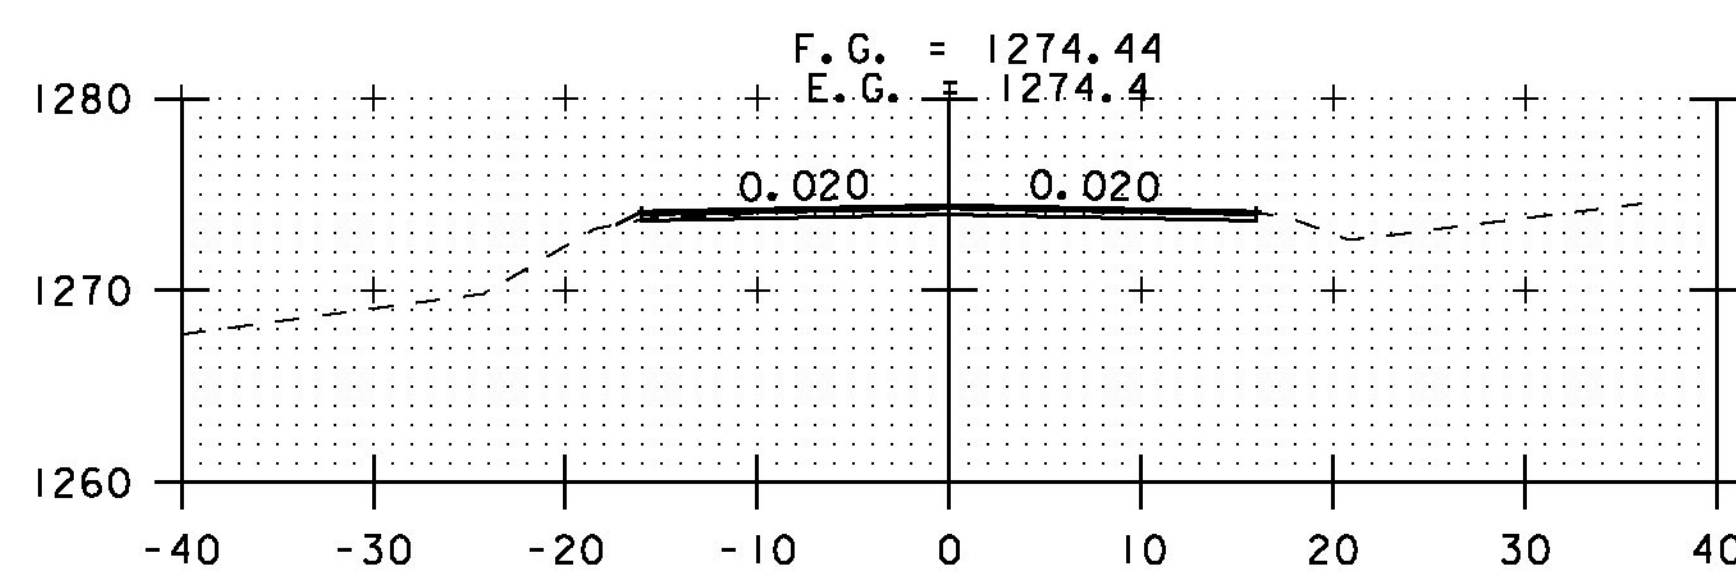


259+50

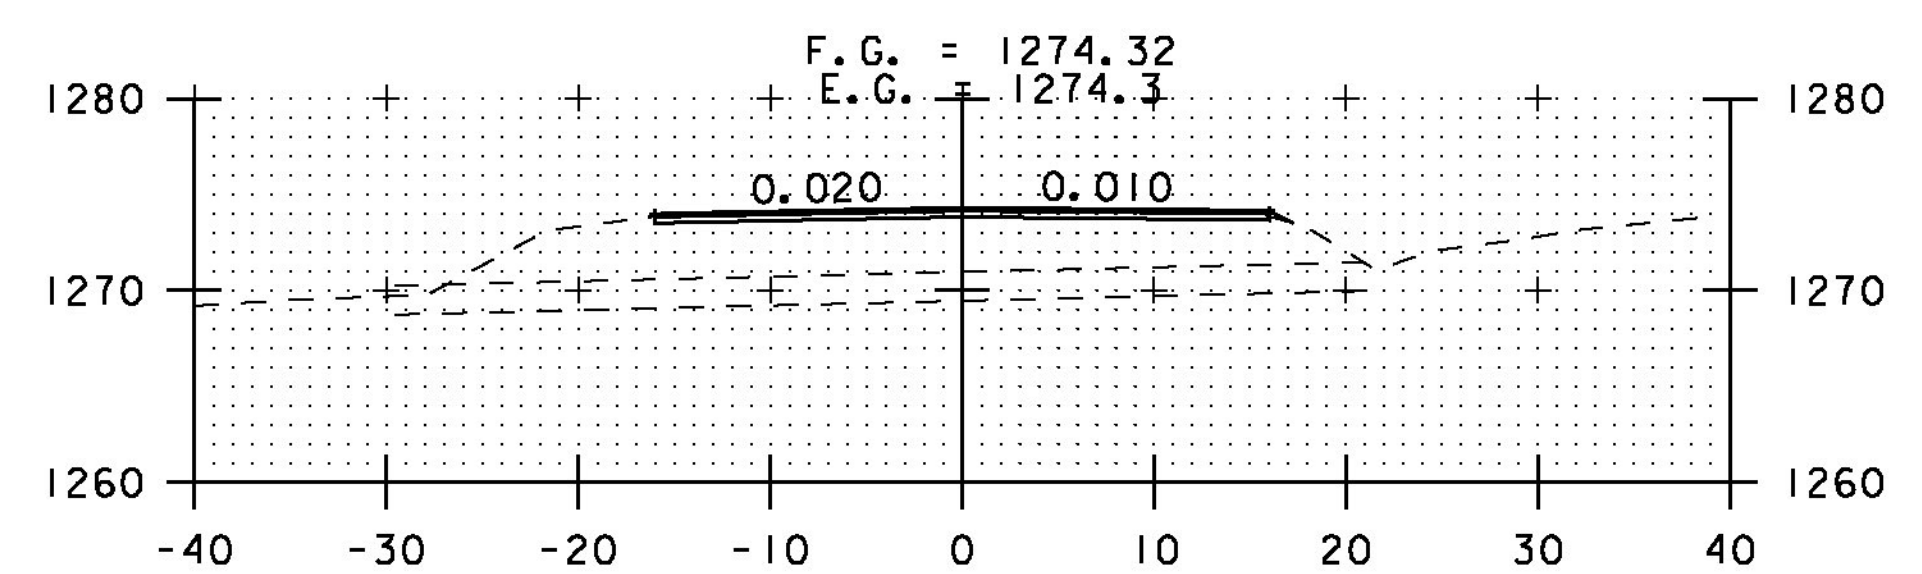


261+50

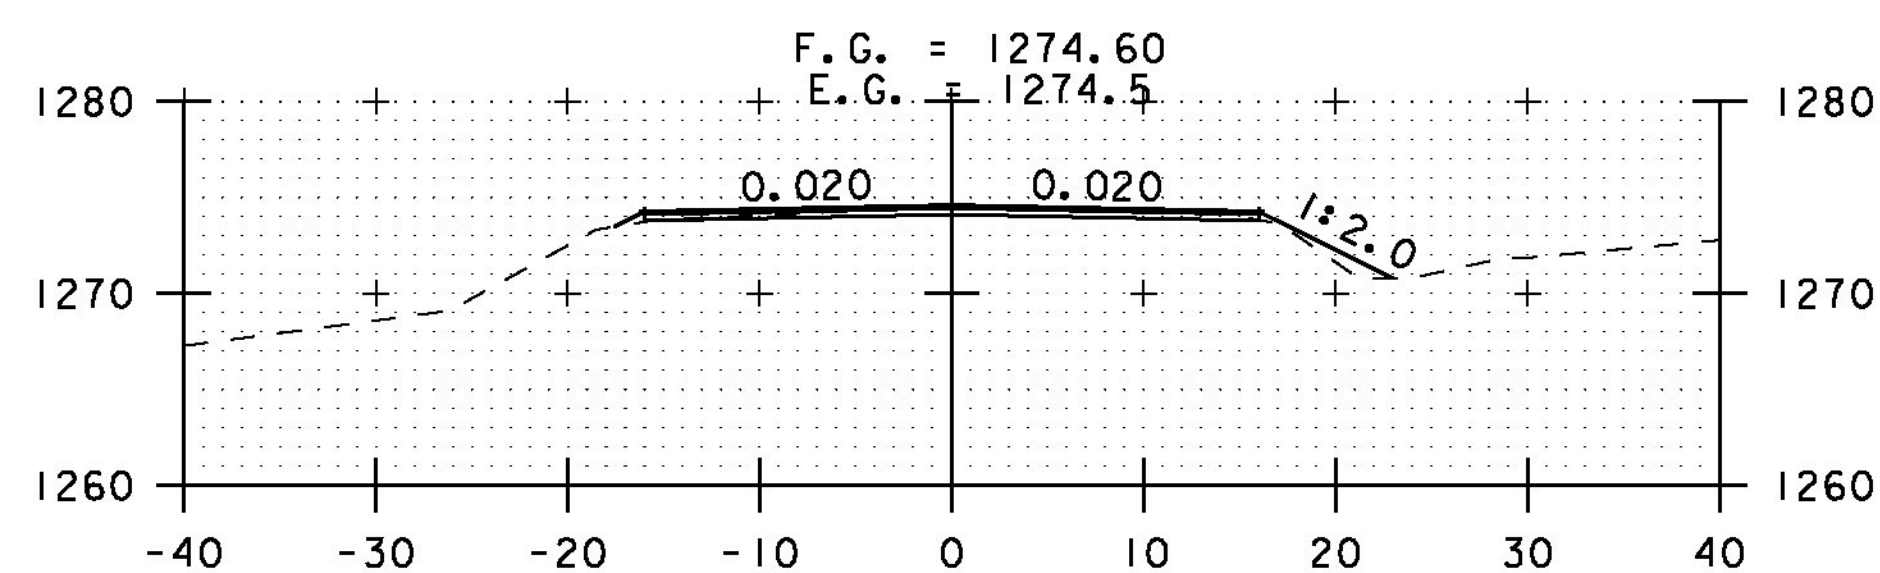

257+00

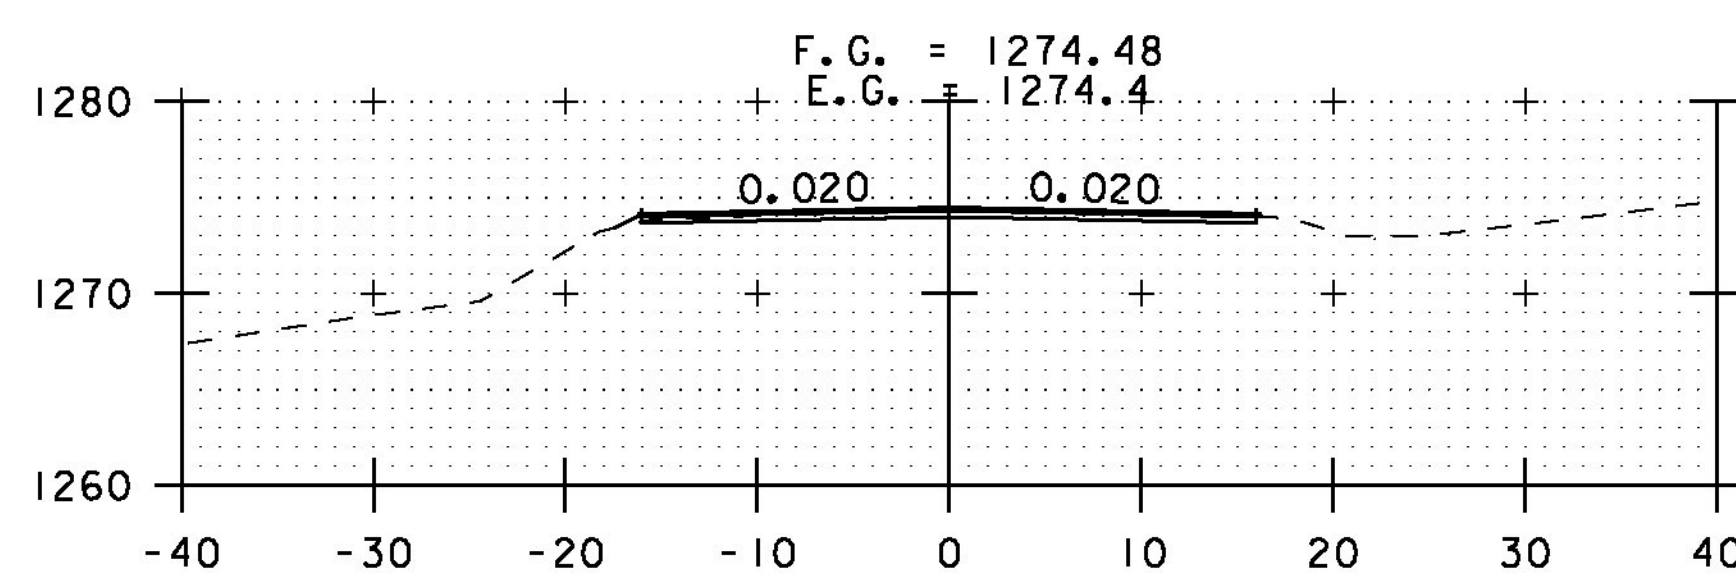

259+00

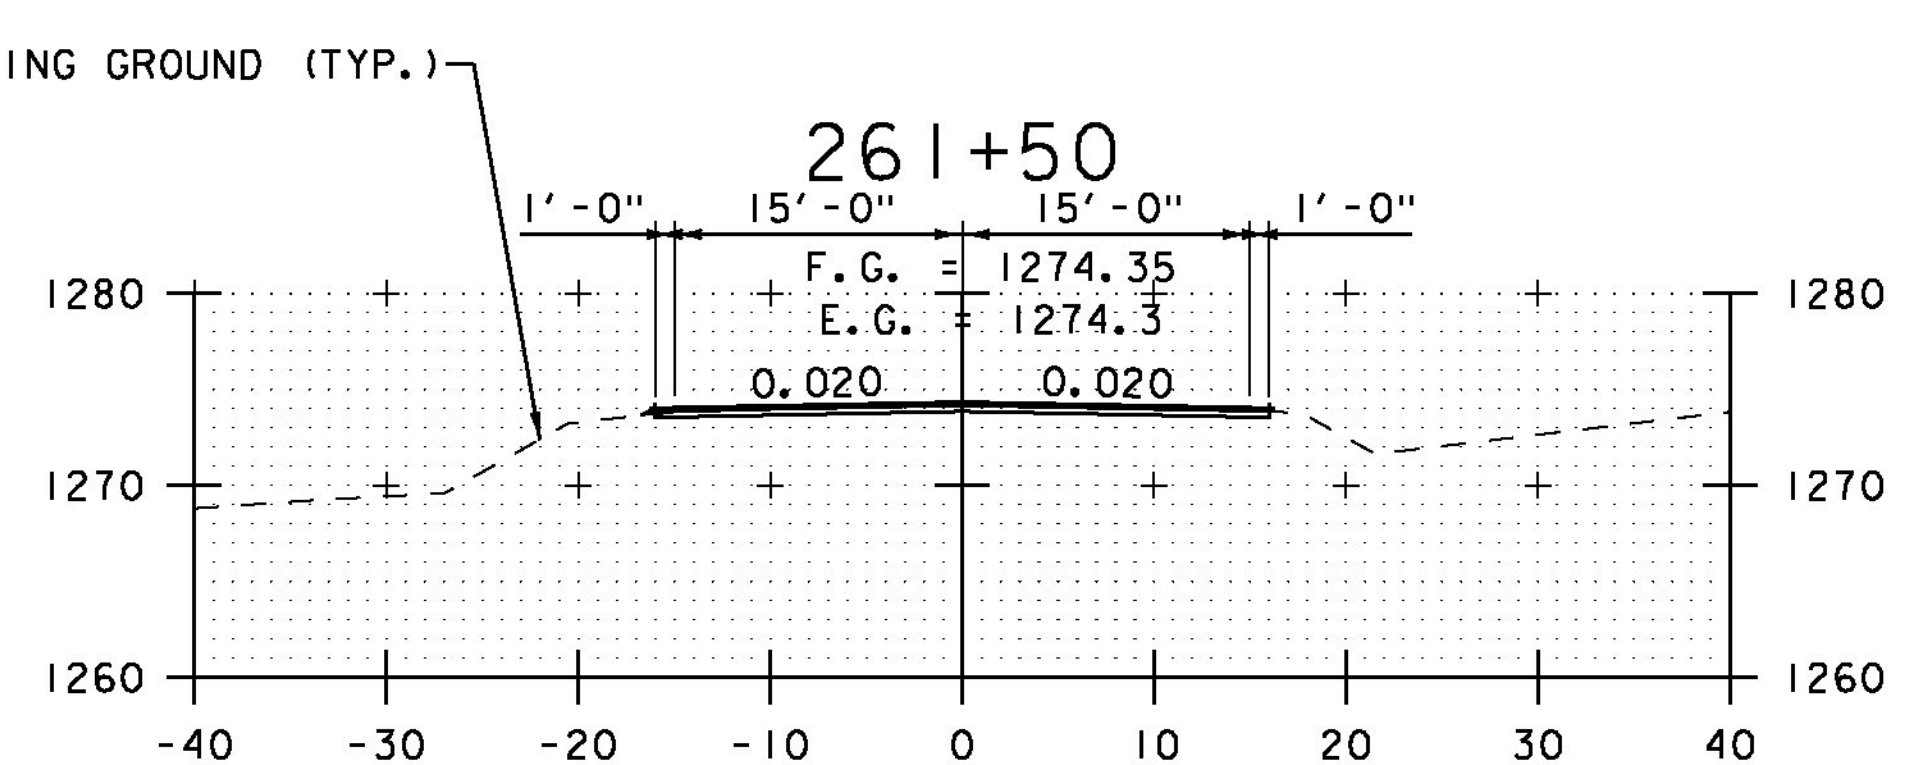

261+00

STA. 257+00 TO STA. 262+50



CROSS SECTION SHEET 14

PROJECT NAME: ELMORE-MORRISTOWN

PROJECT NUMBER: STP 2937 (1)

FILE NAME: z11c310.dgn

PROJECT LEADER: C. LATHROP

DESIGNED BY: S. LAMPHERE

PLOT FILE: z11c310_142.i

PLOT DATE: 3/3/14

DRAWN BY: B. MARTIN

CHECKED BY: C. LATHROP

SHEET 142 OF 194