




264+50

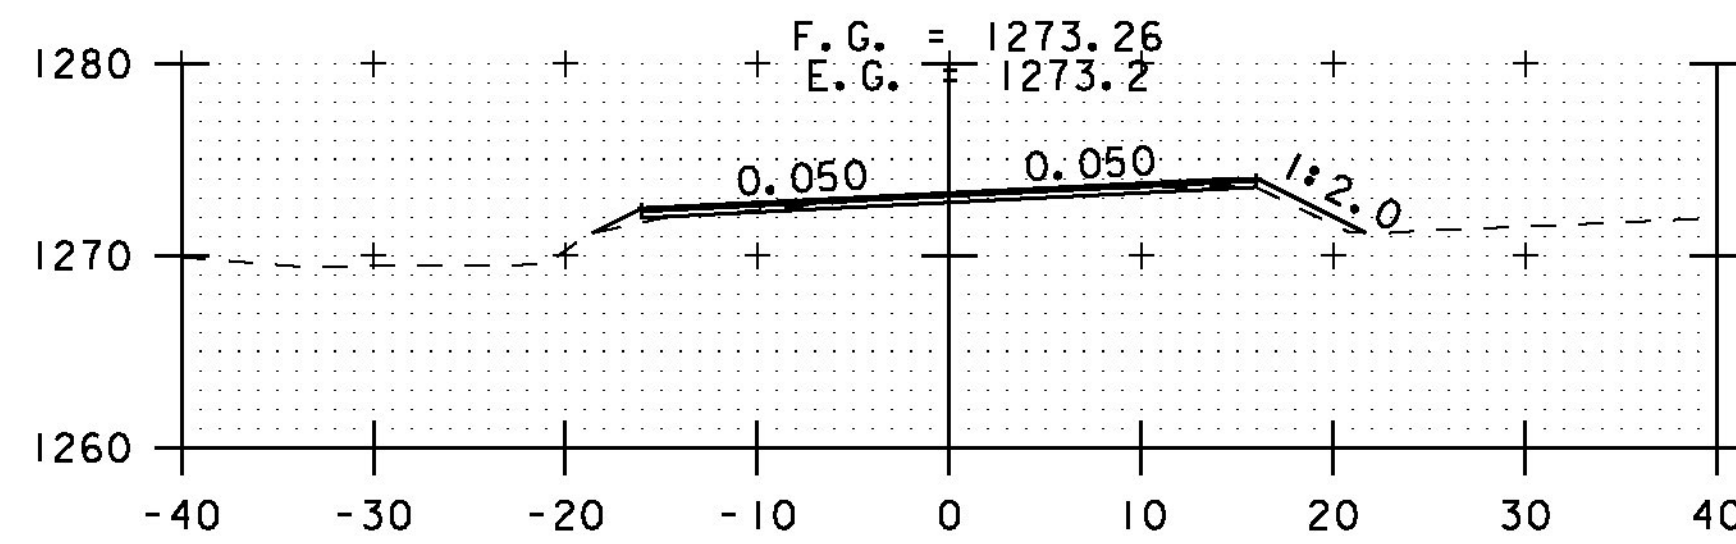


266+50

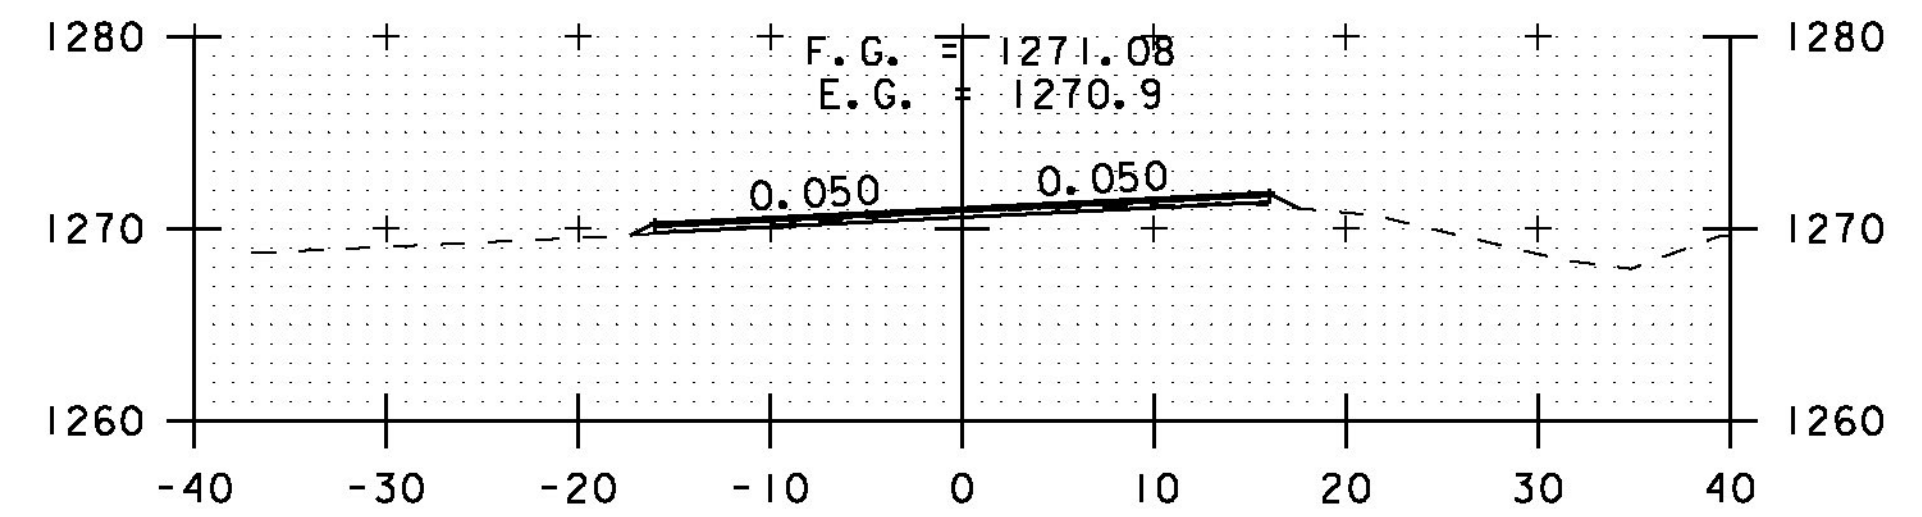


268+50

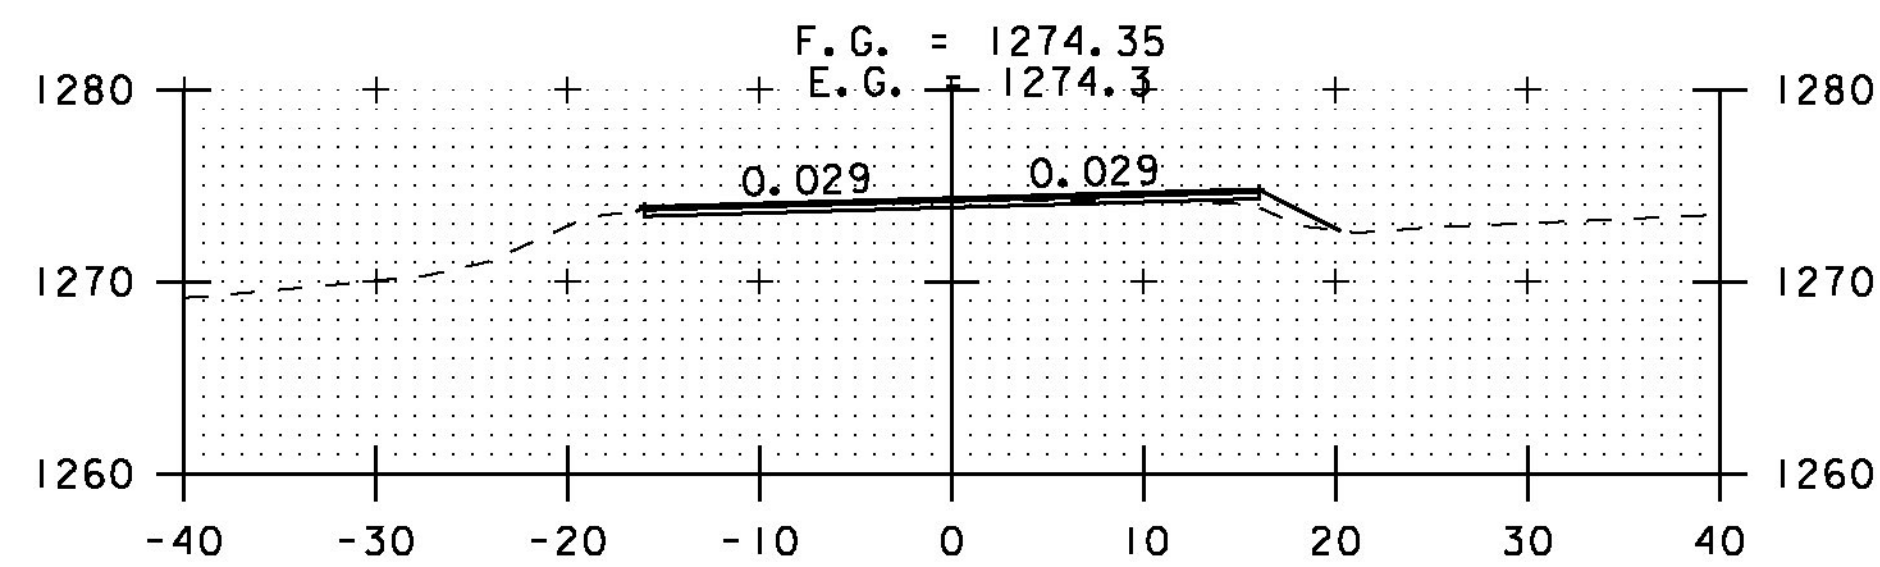


264+00

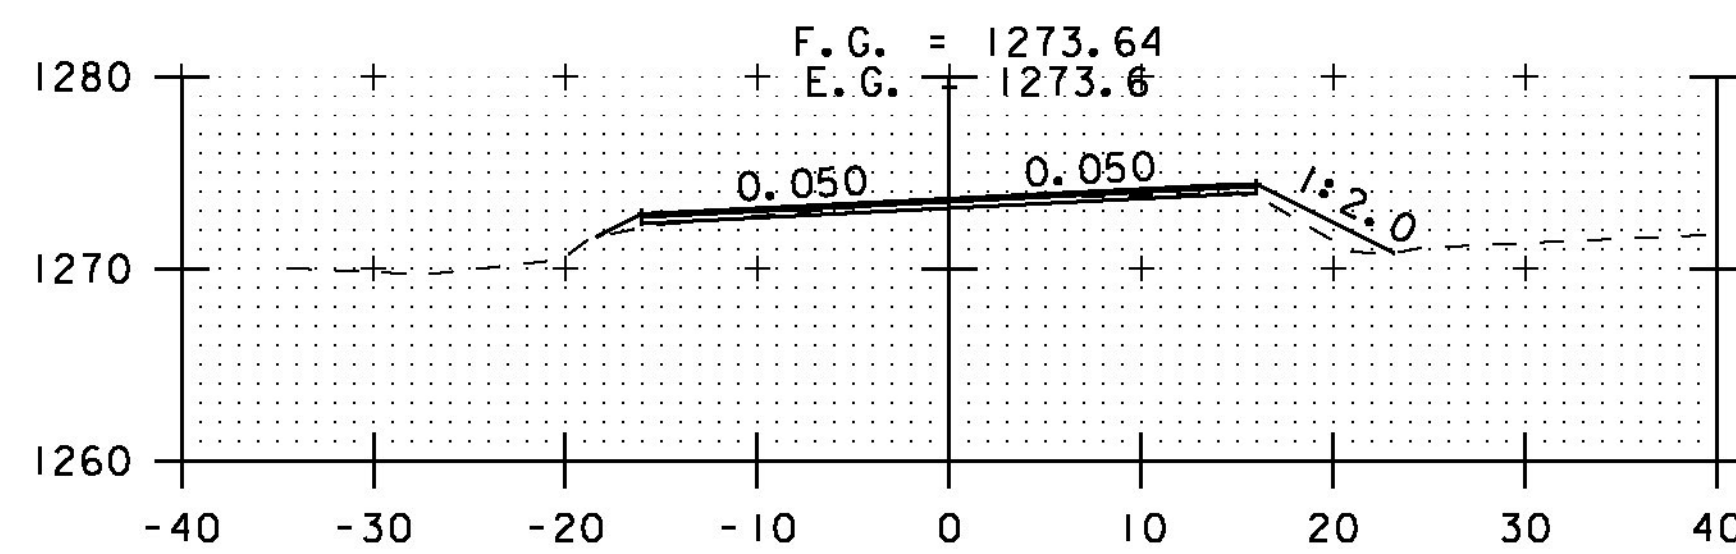


266+00

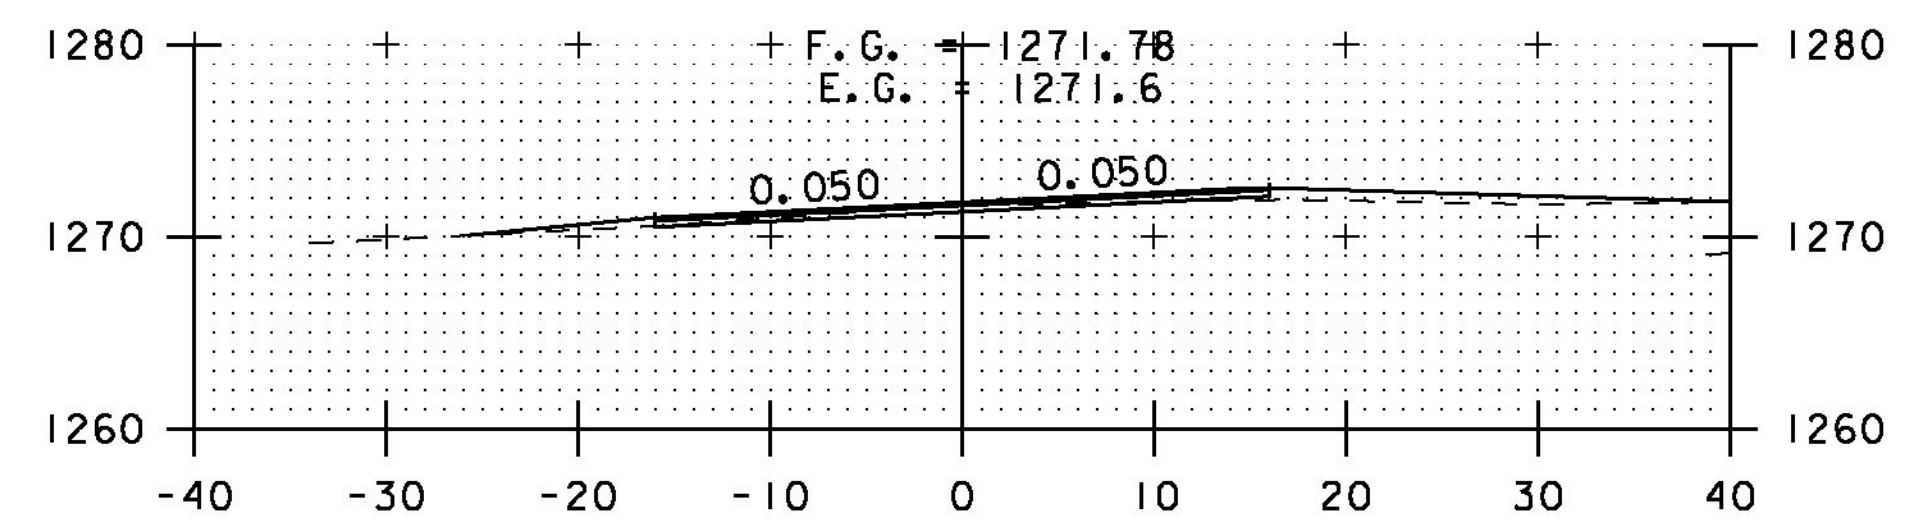


DRIVE LT, TH#11 RT
268+00

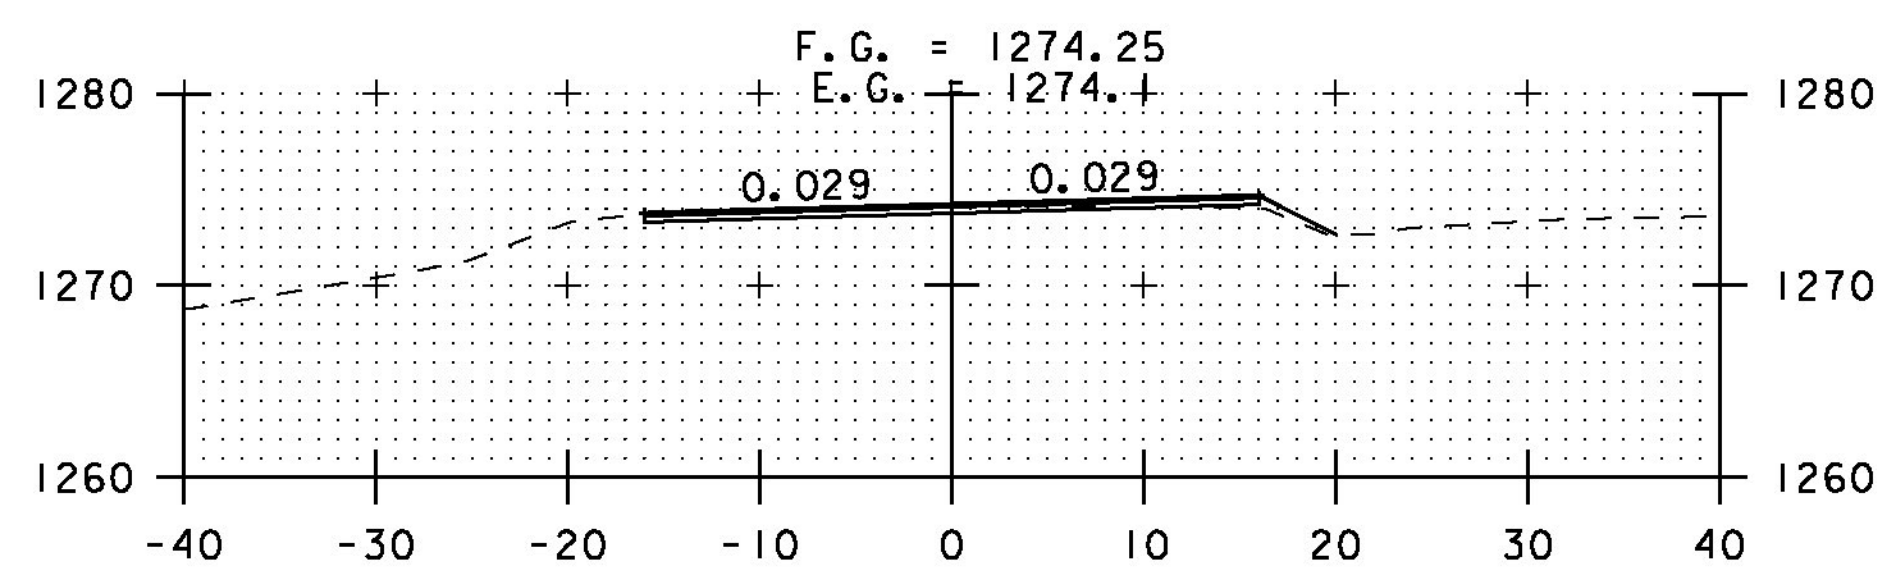


263+50

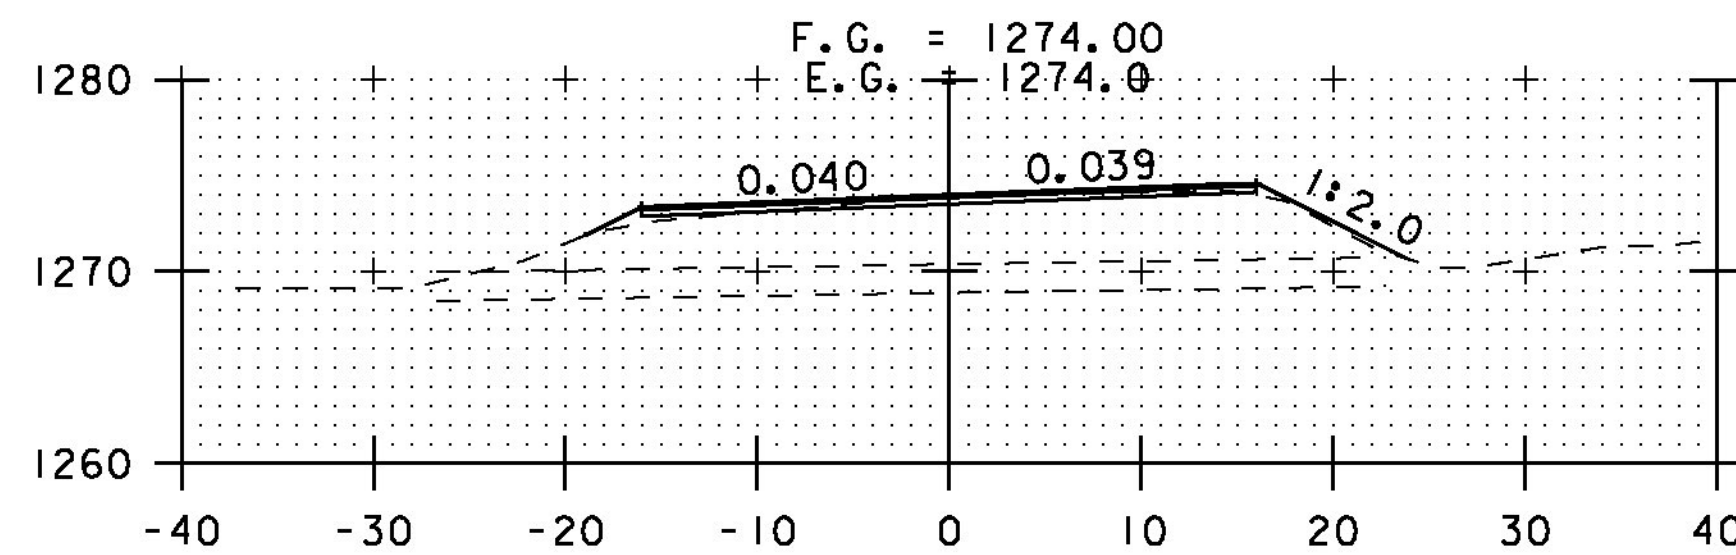


265+50

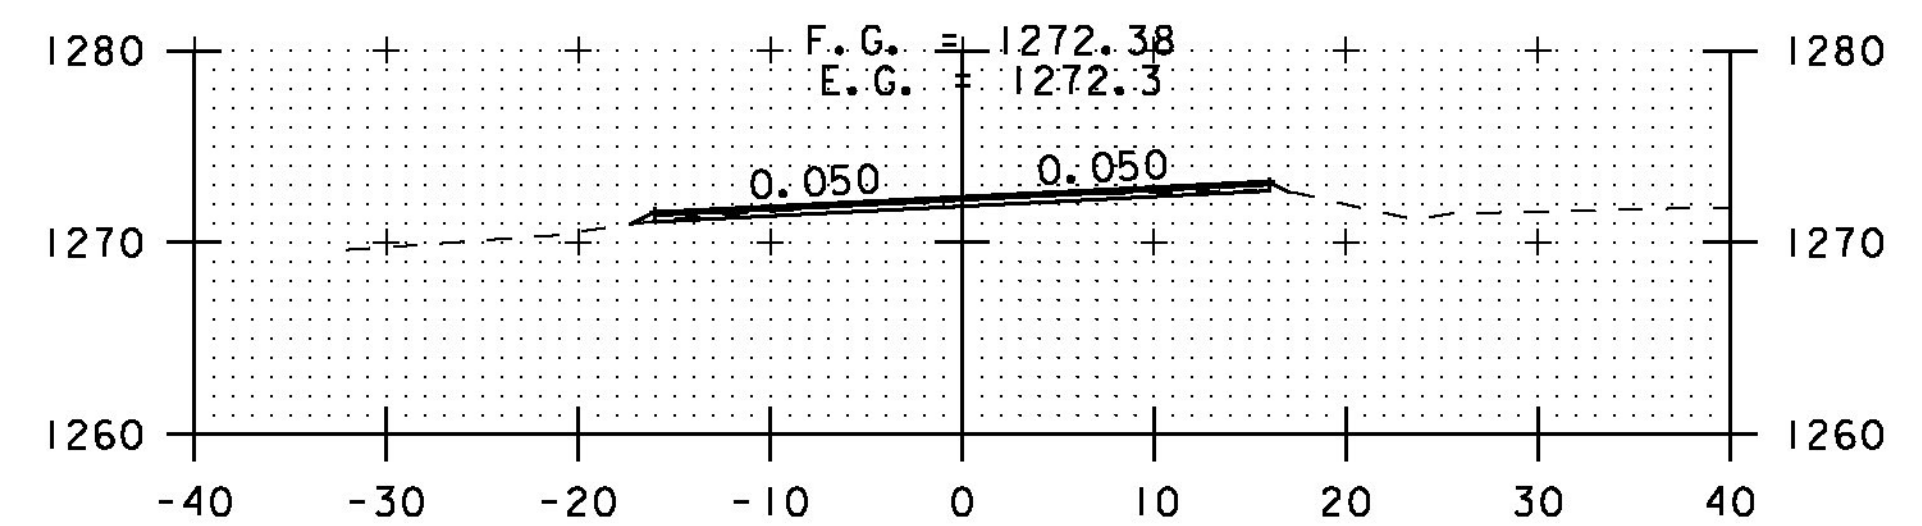


267+50

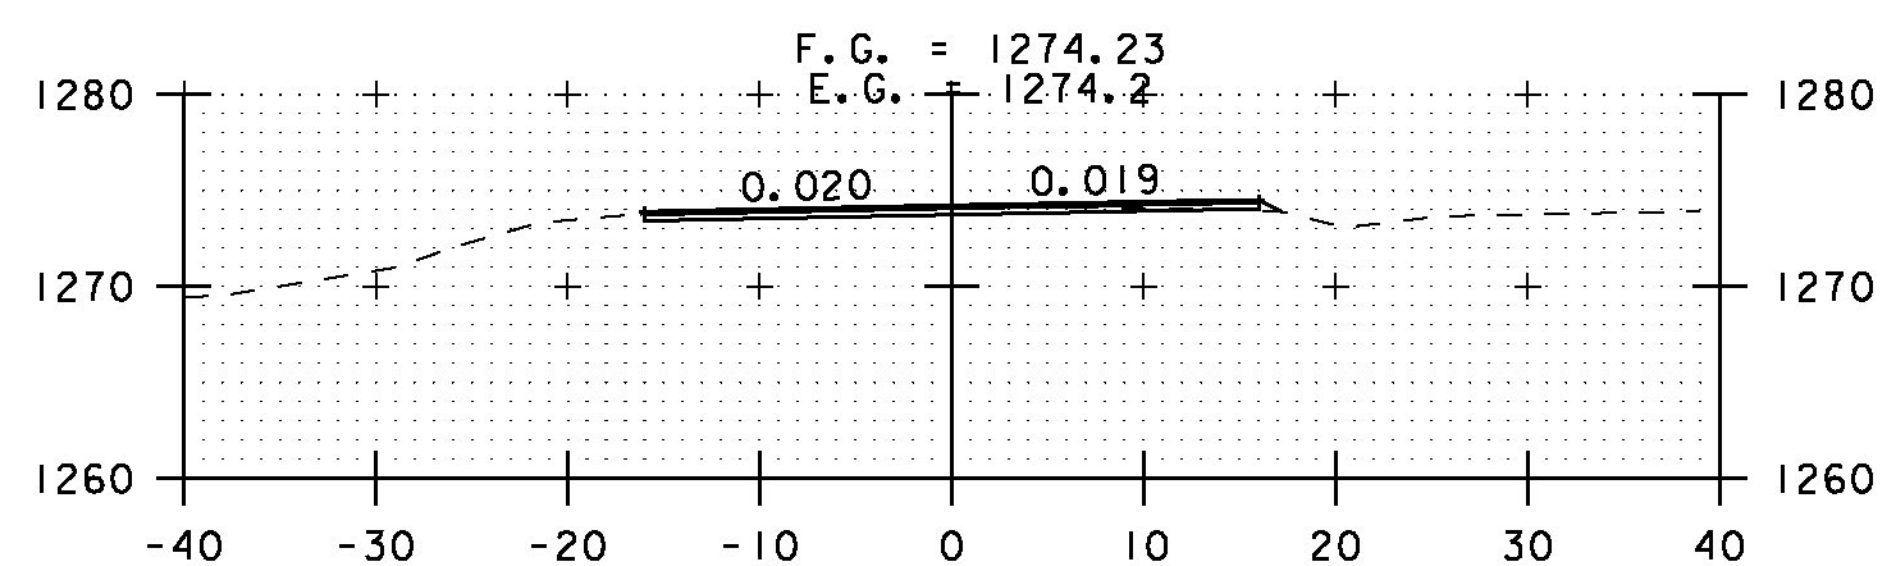

263+00

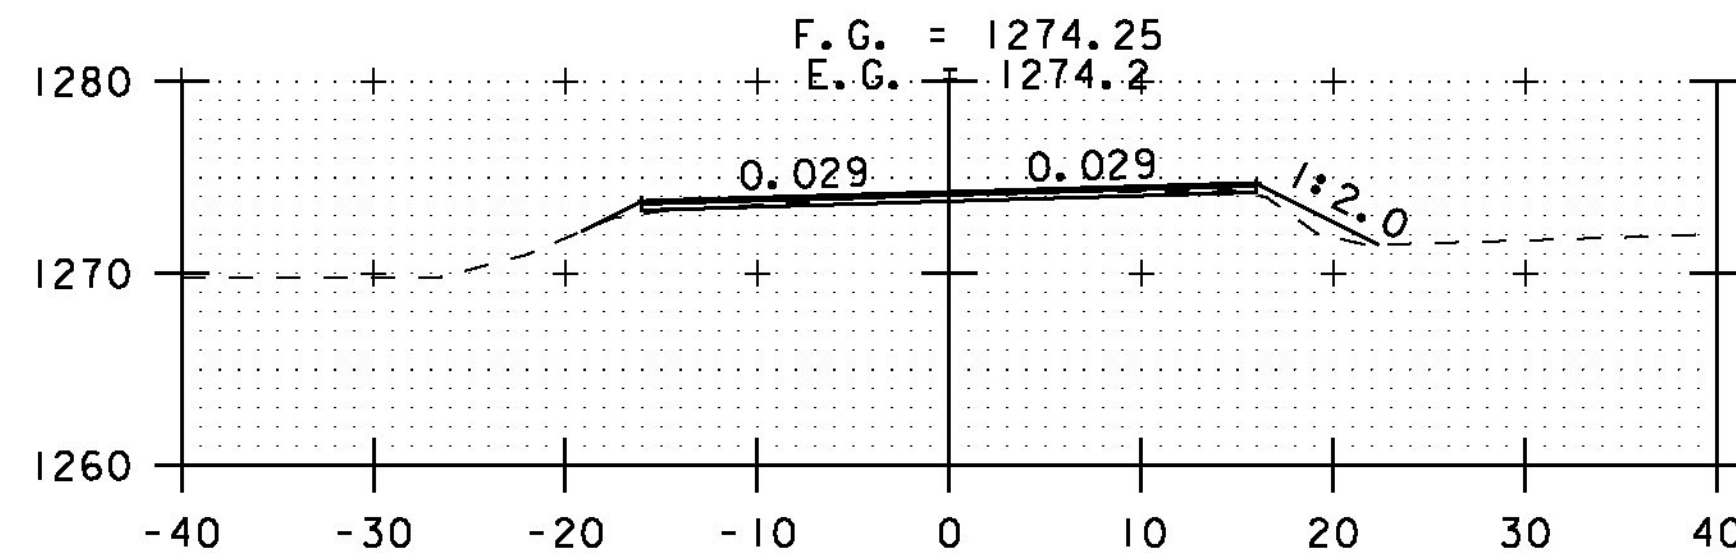

265+00

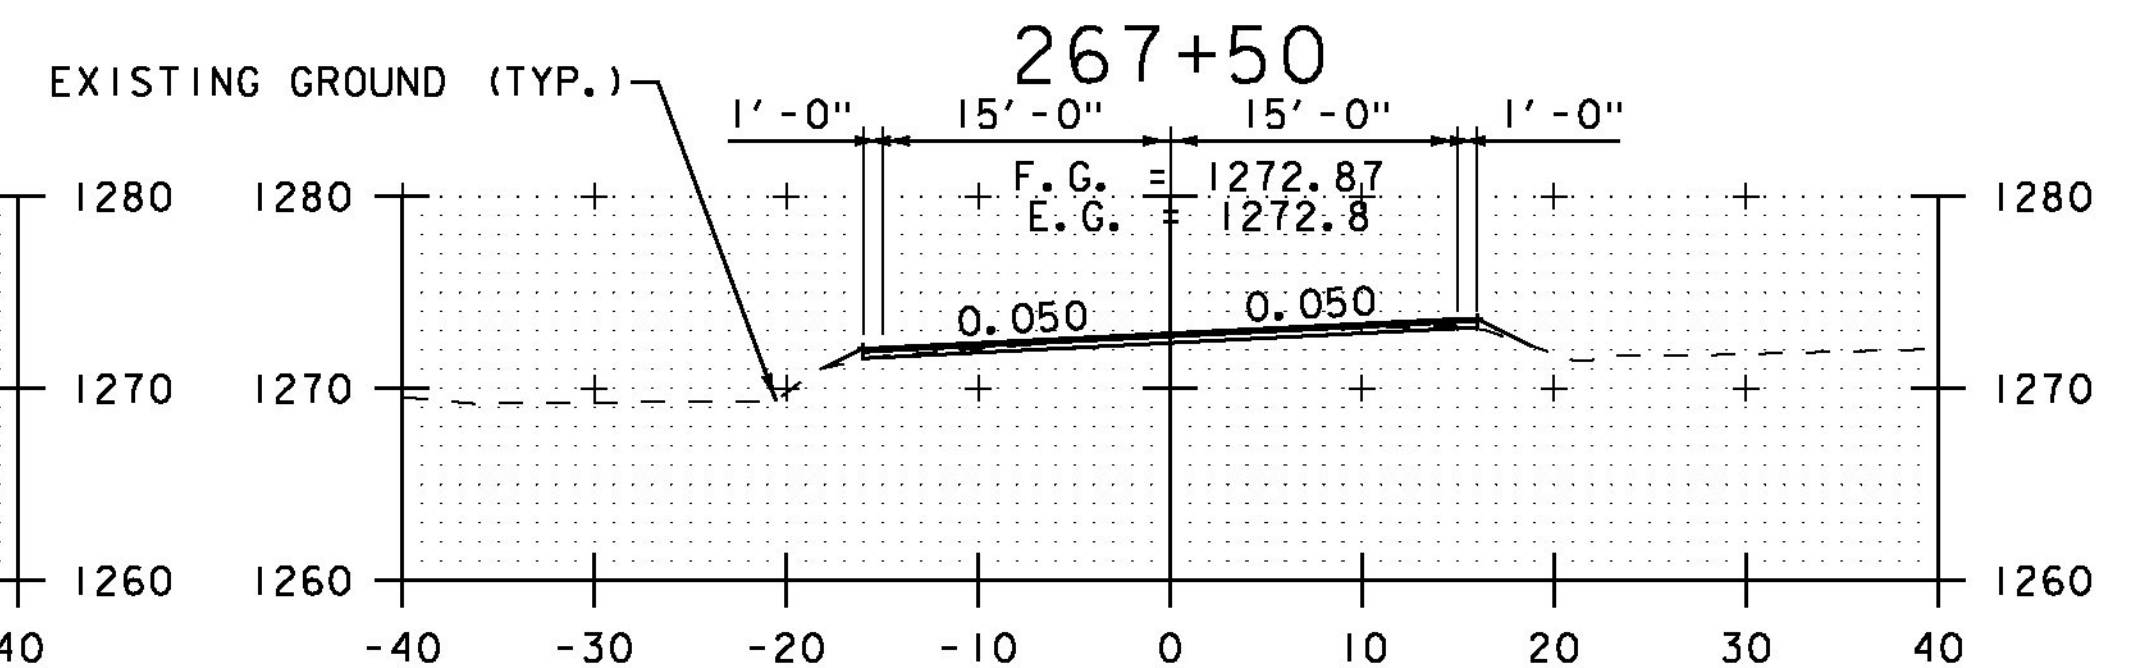

267+00

STA. 263+00 TO STA. 268+50



CROSS SECTION SHEET 15

PROJECT NAME: ELMORE-MORRISTOWN

PROJECT NUMBER: STP 2937 (1)

FILE NAME: z11c310.dgn

PROJECT LEADER: C. LATHROP

DESIGNED BY: S. LAMPHERE

PLOT FILE: z11c310_143.i

PLOT DATE: 3/3/14

DRAWN BY: B. MARTIN

CHECKED BY: C. LATHROP

SHEET 143 OF 194