




276+50

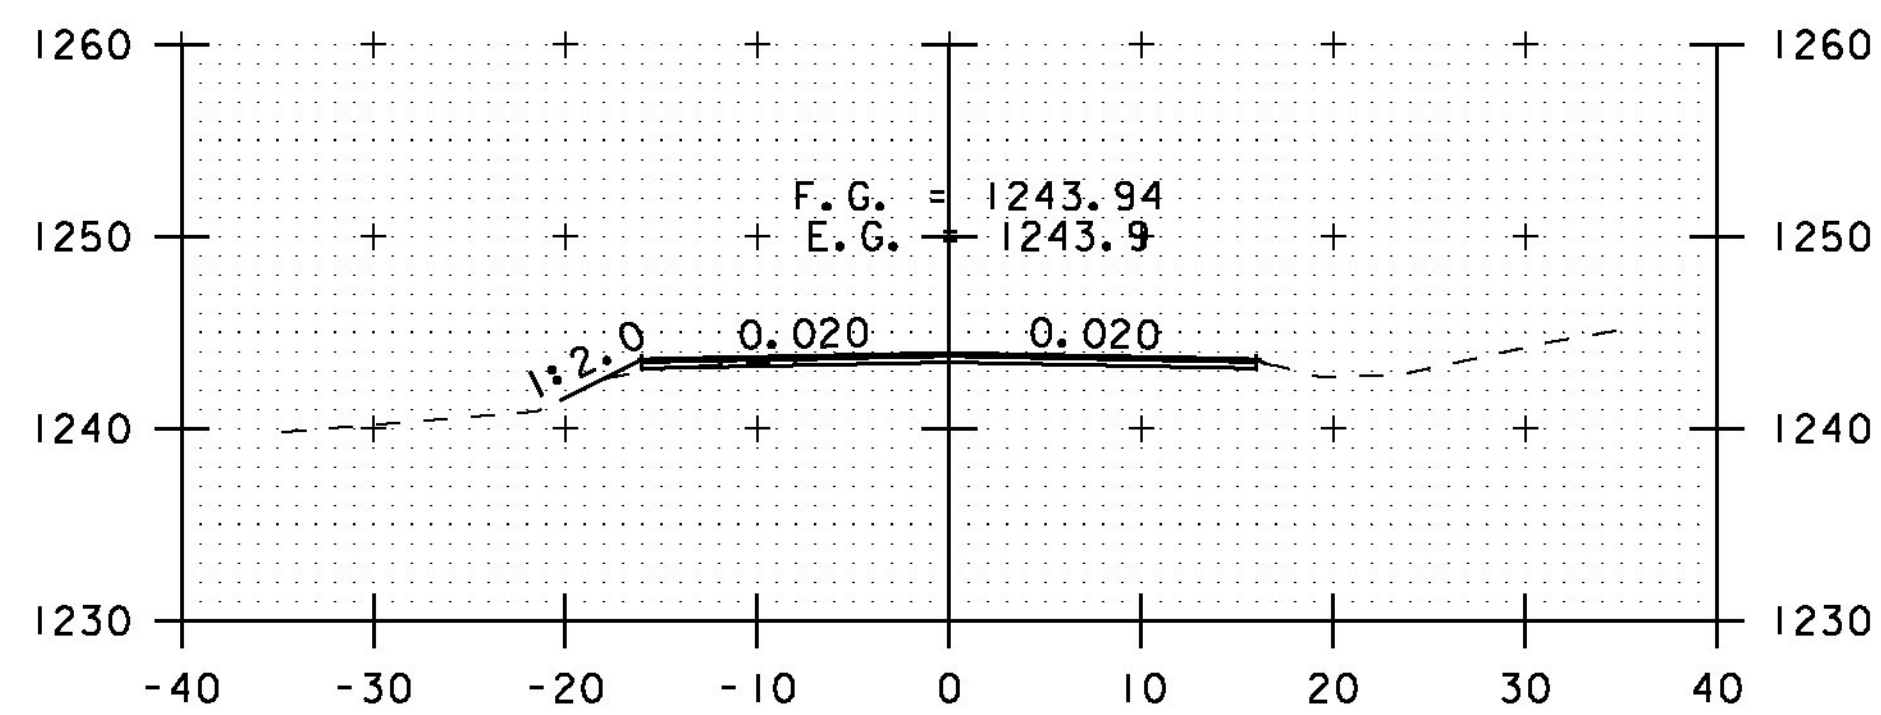


278+50

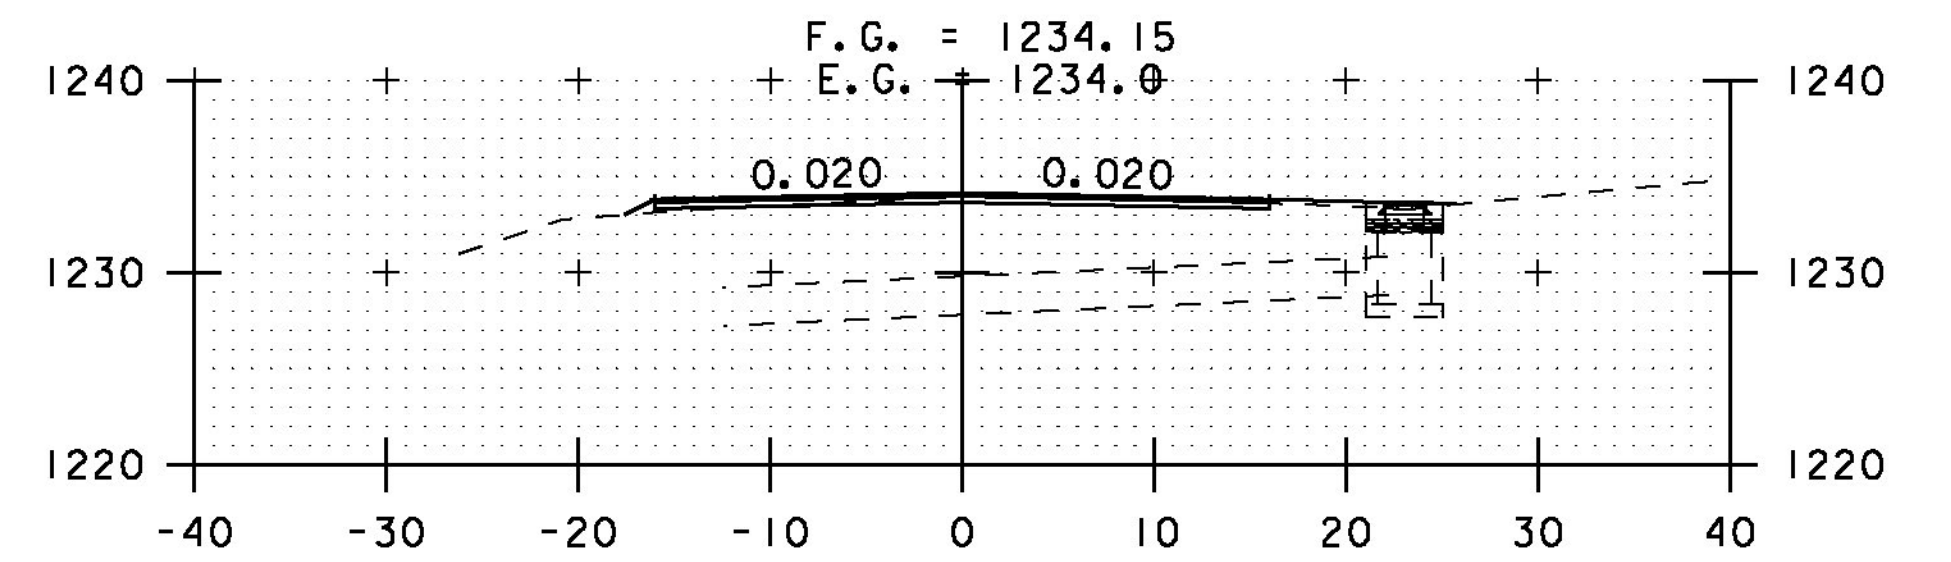


DRIVE RT
280+50

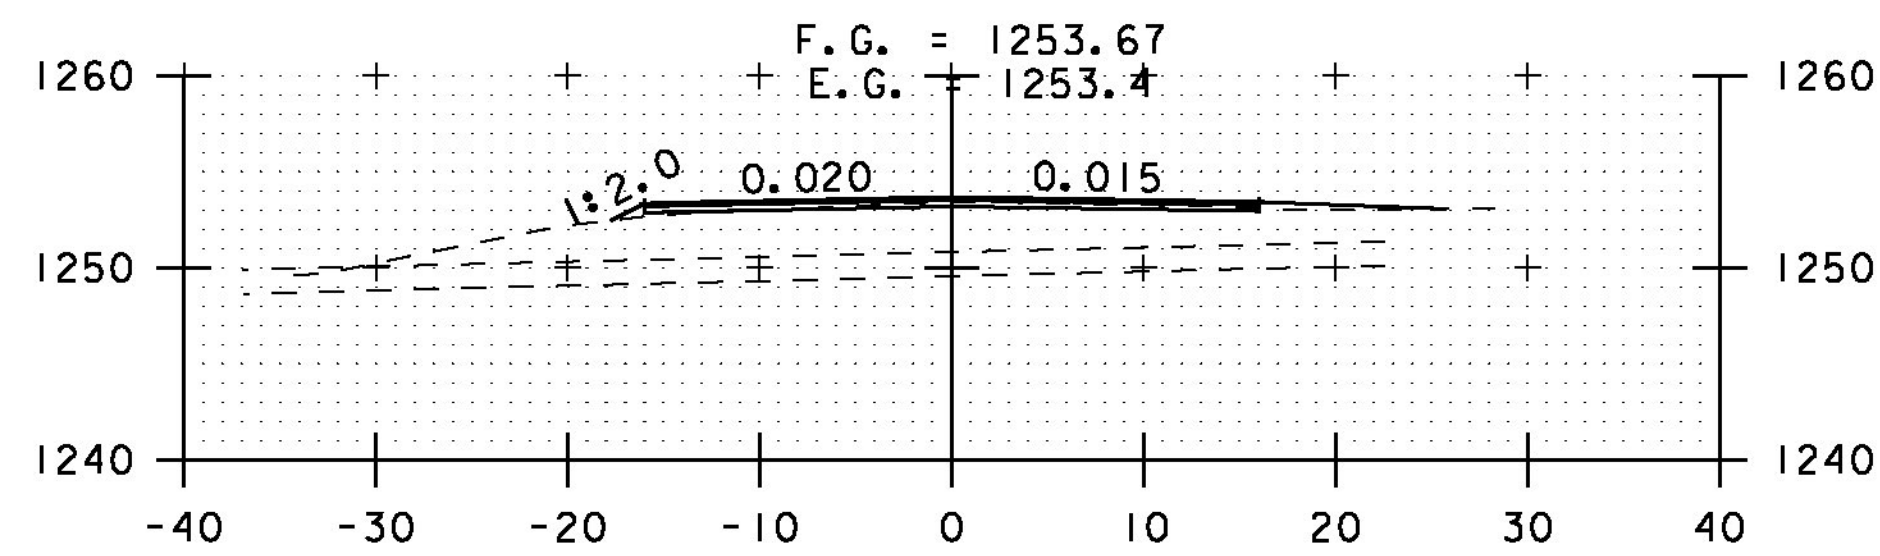


DRIVE RT
276+00

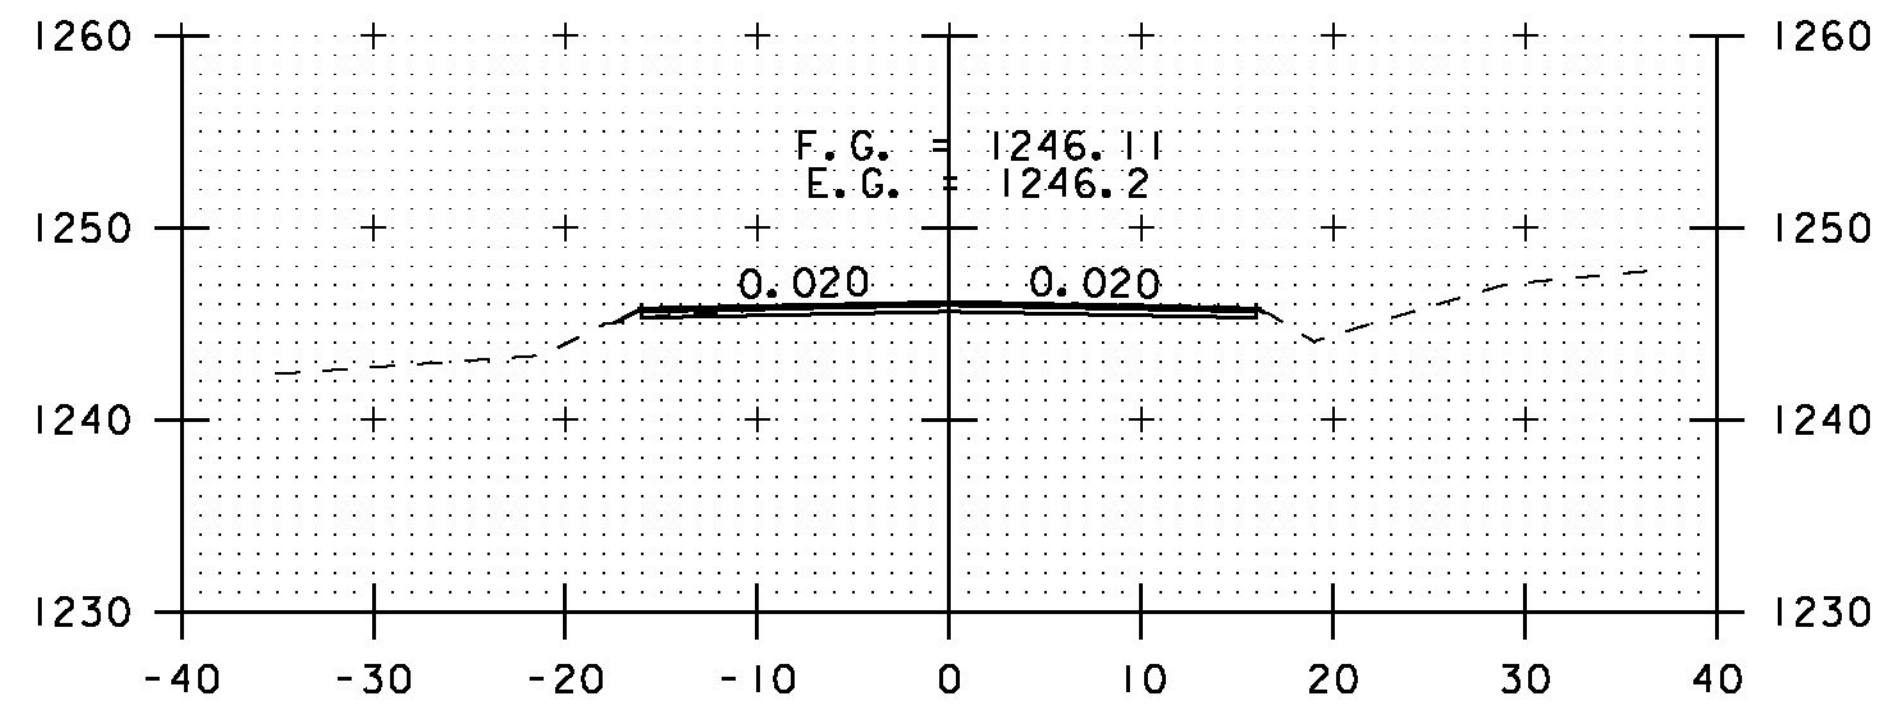


278+00

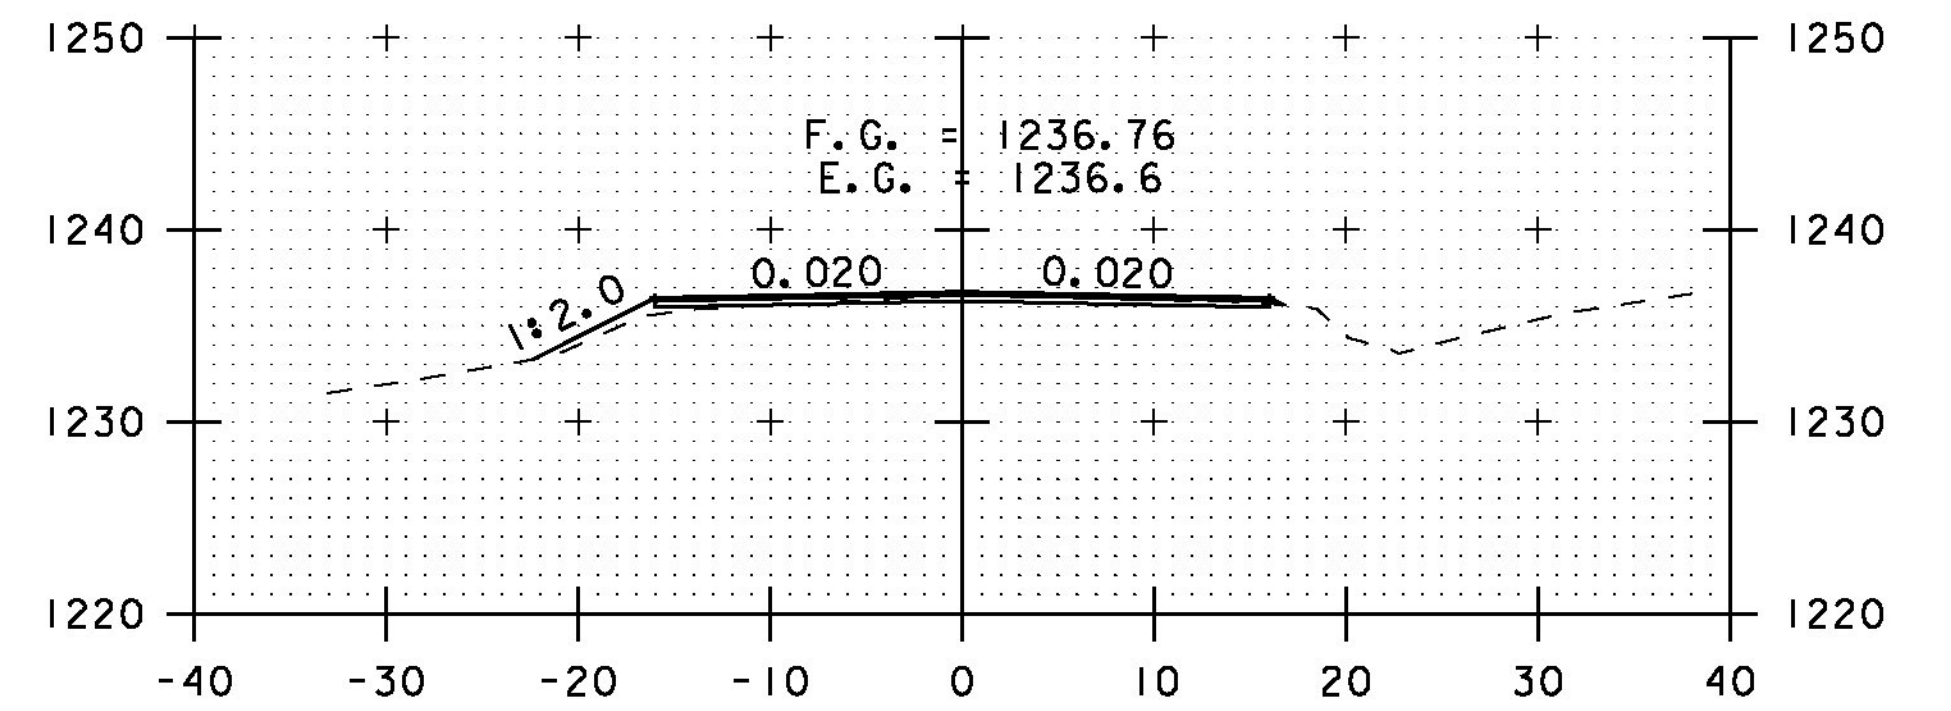


280+00

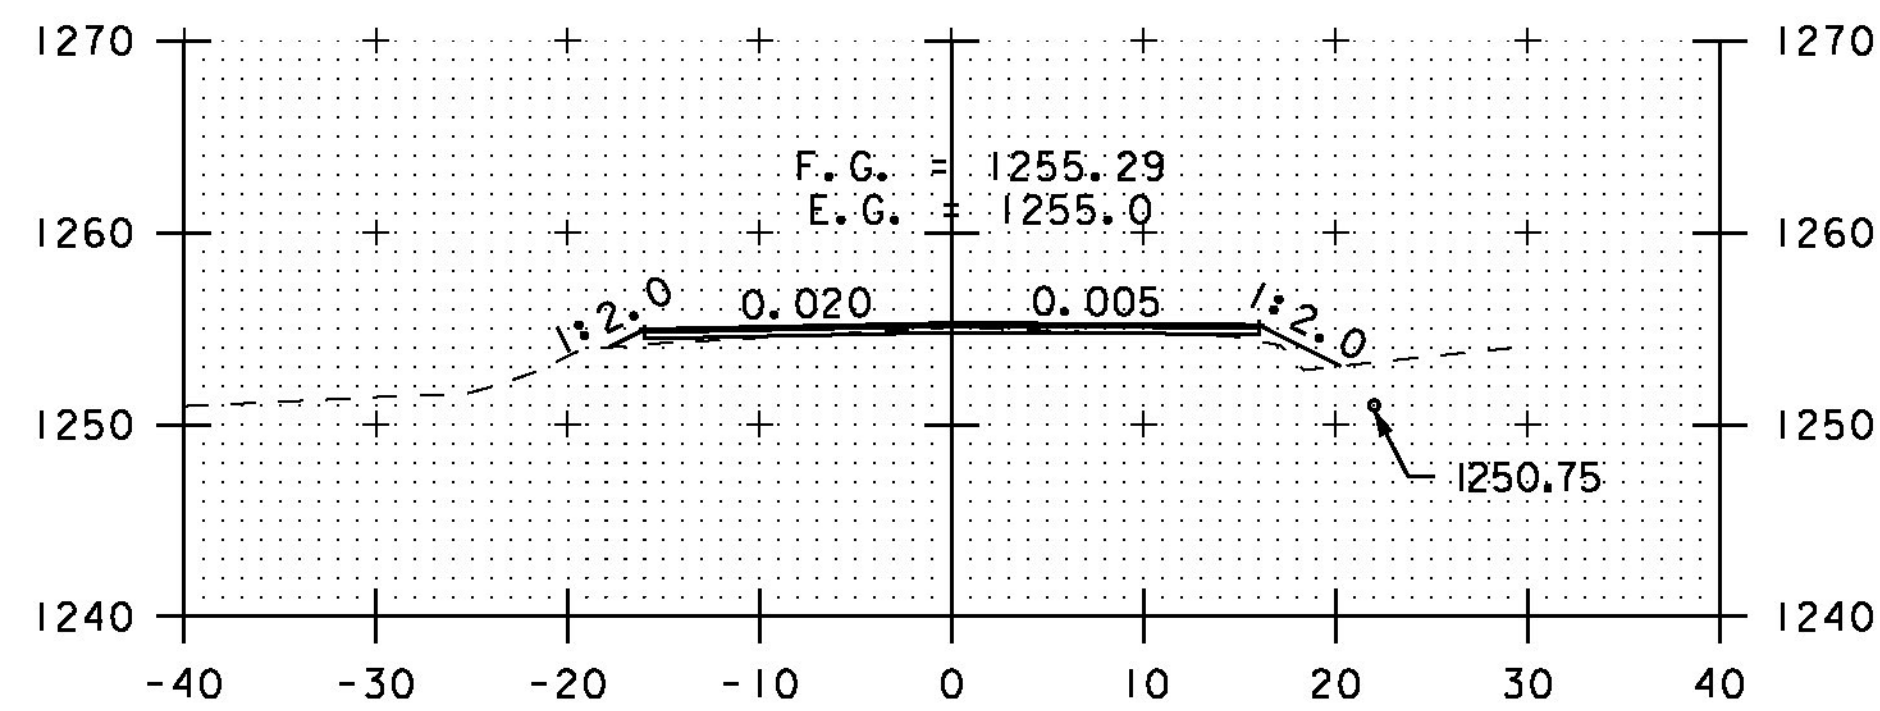


275+50

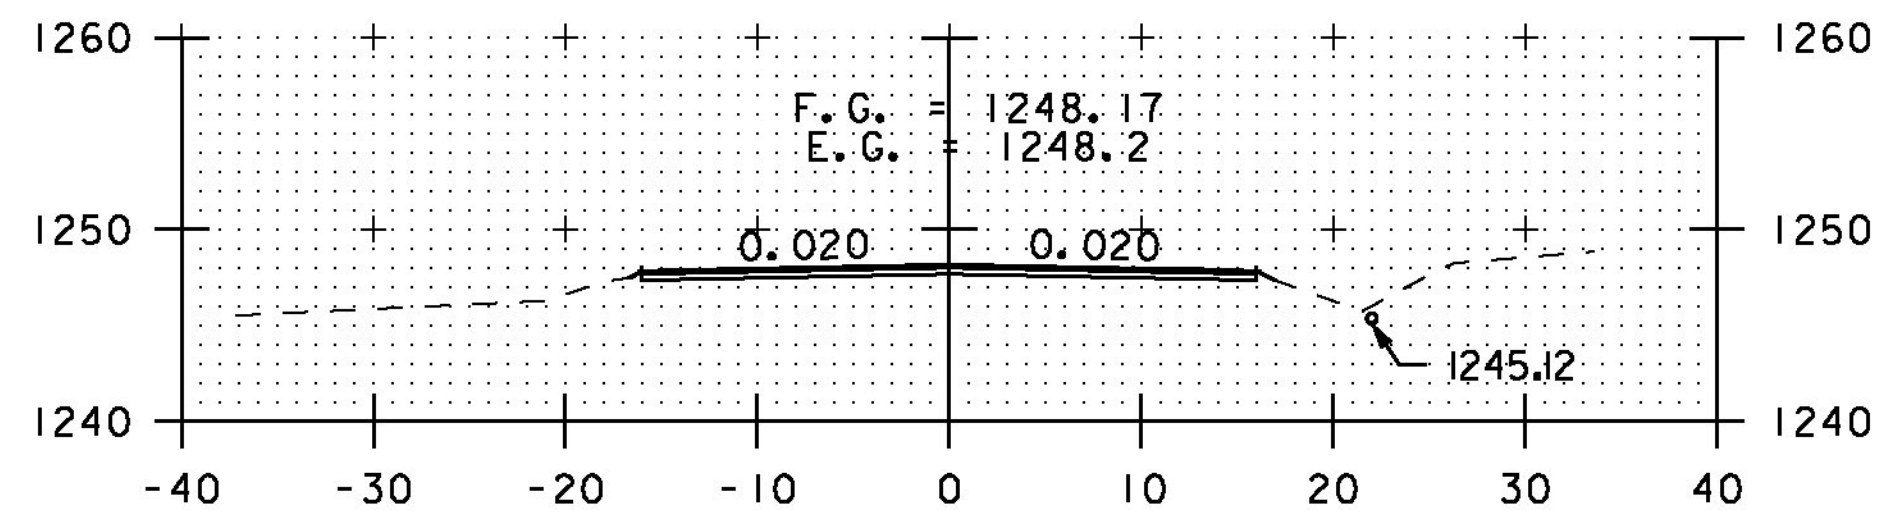


277+50

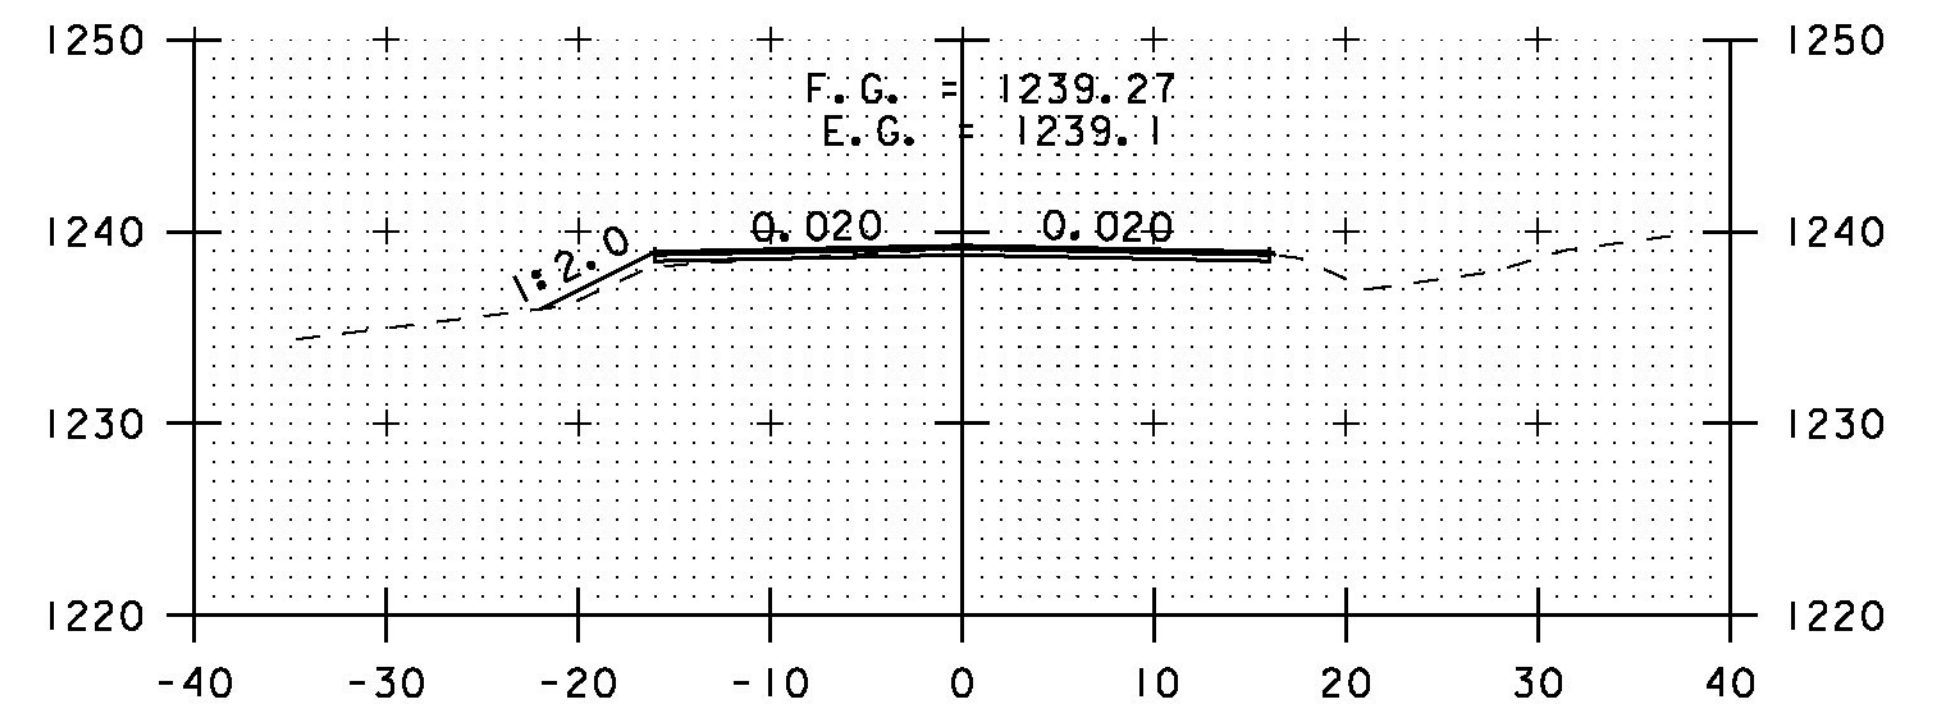


279+50

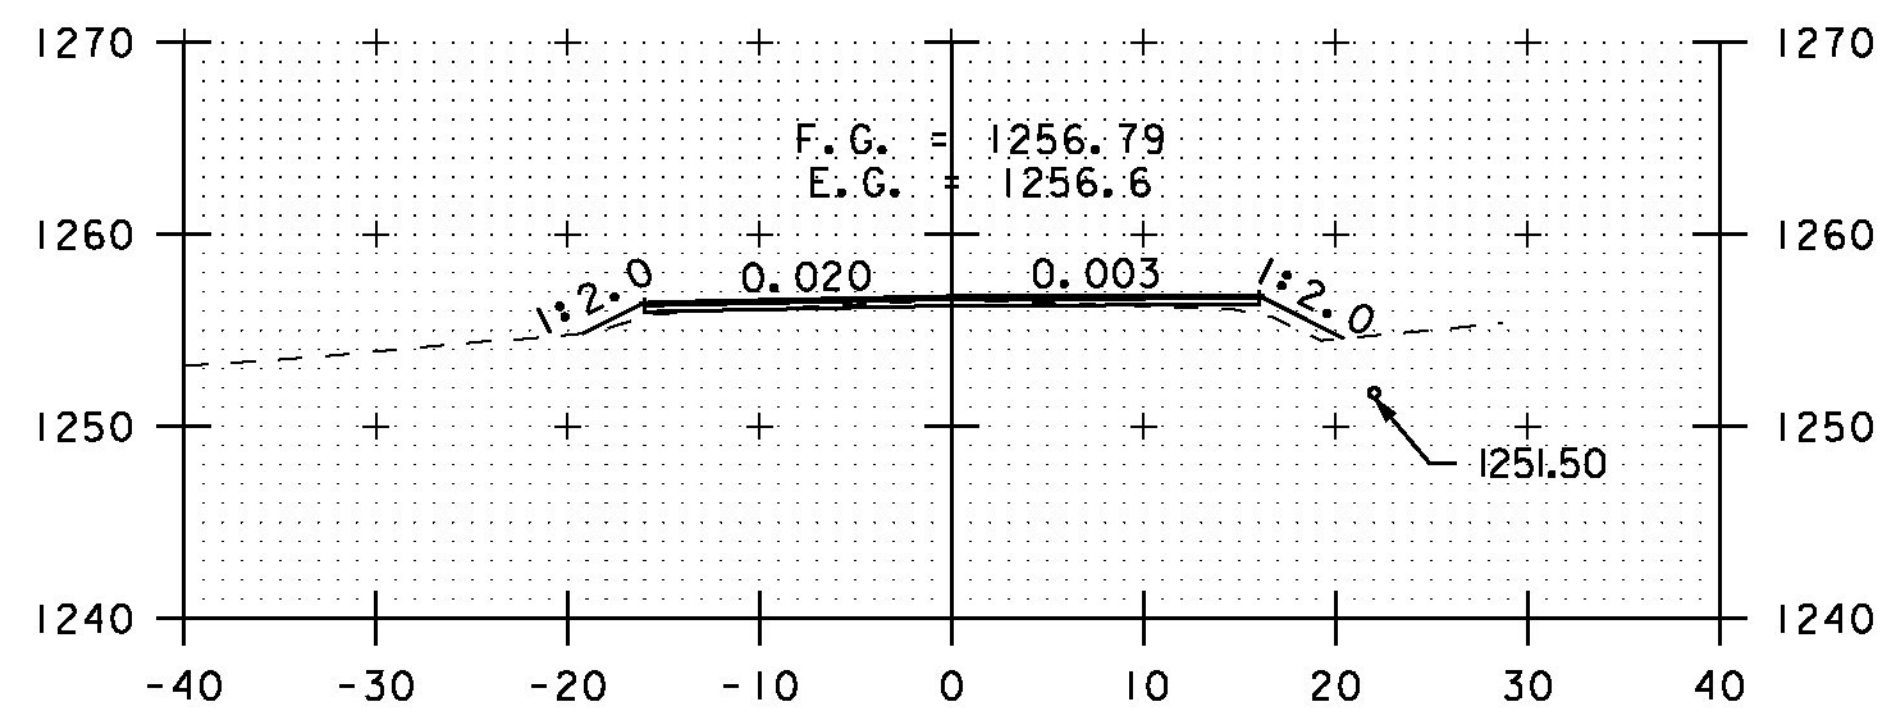

275+00

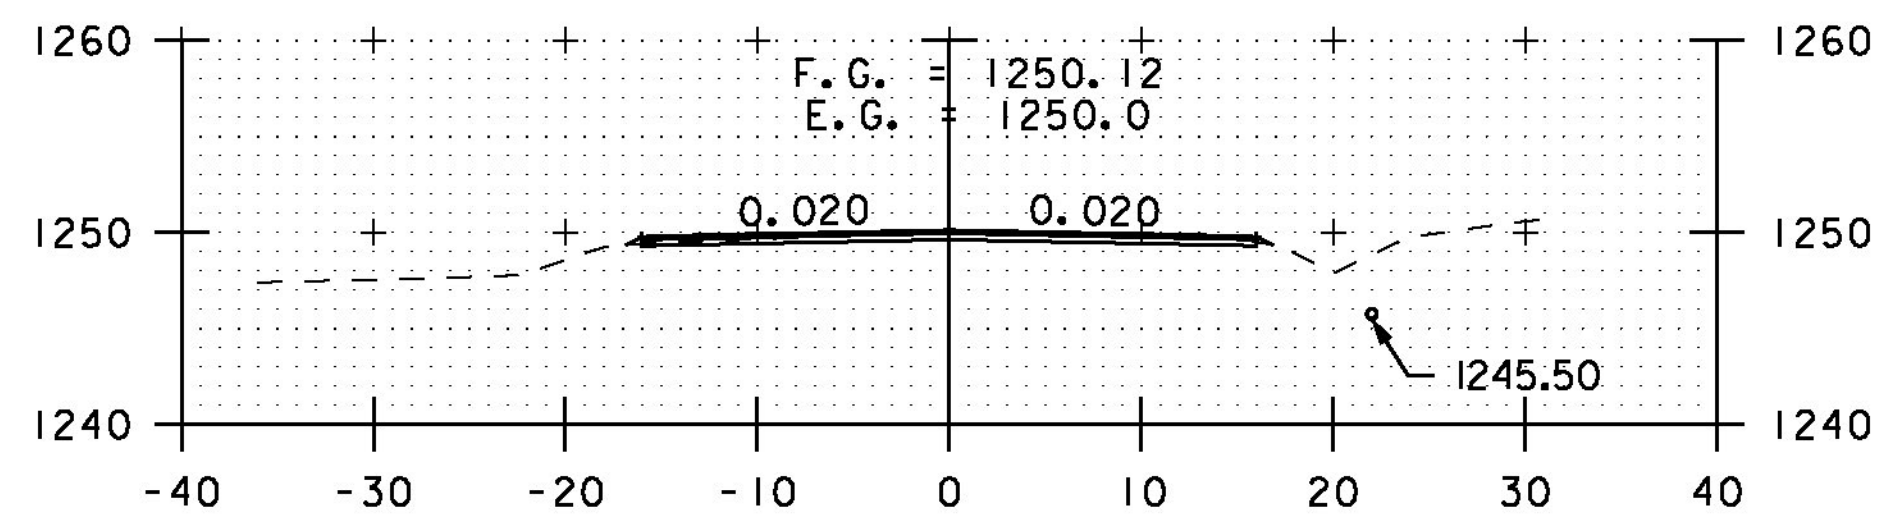

277+00

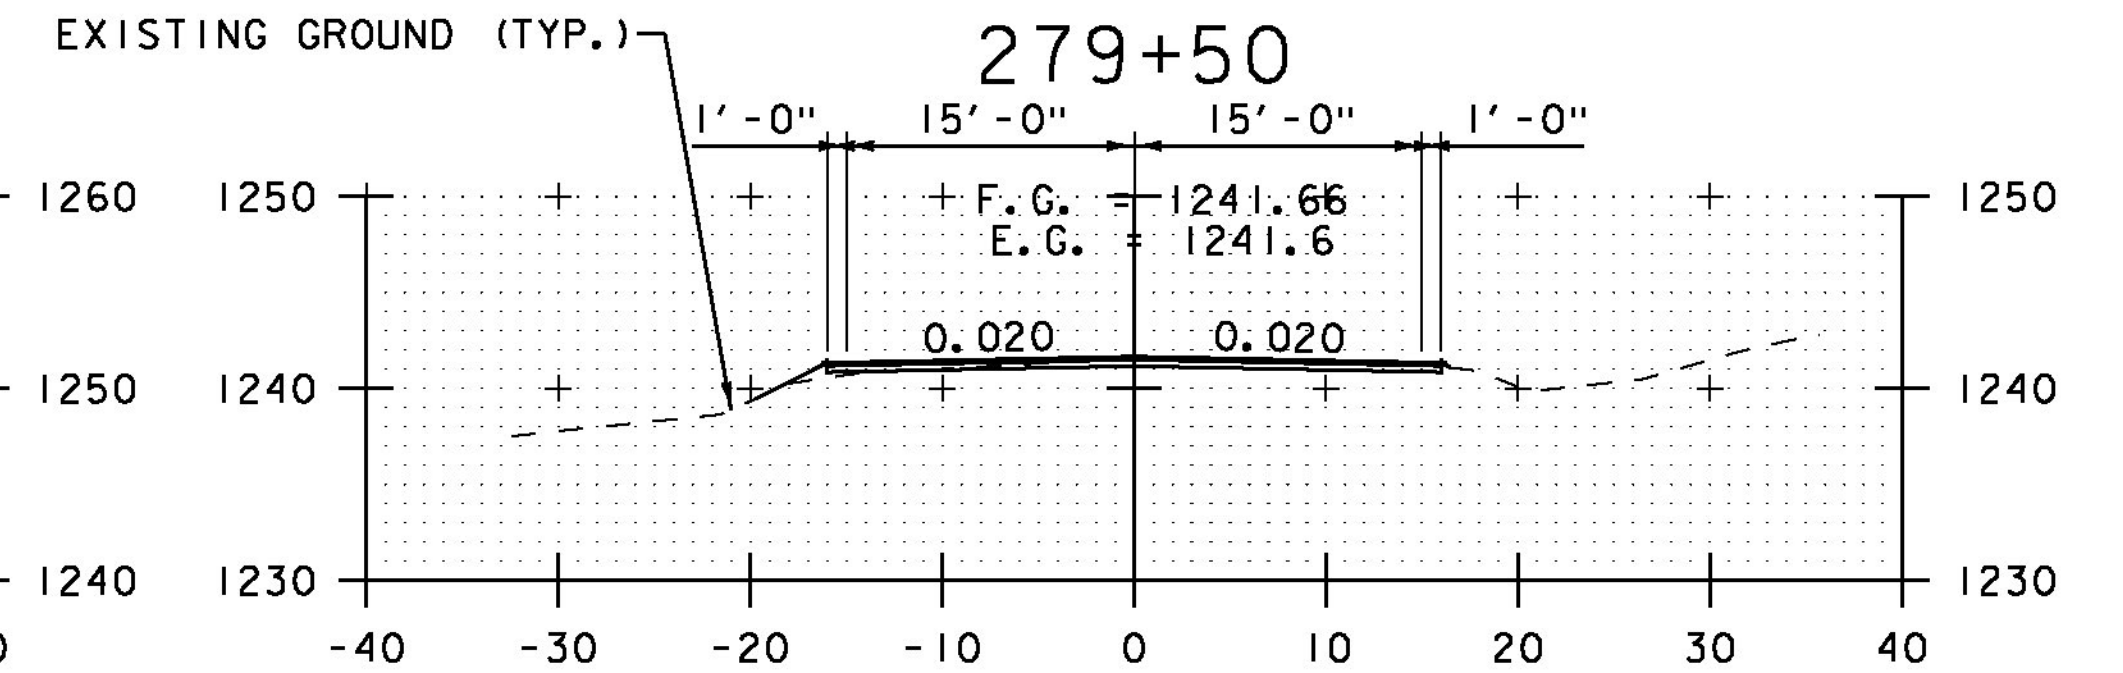

279+00

STA. 275+00 TO STA. 280+50



**CROSS
SECTION
SHEET 17**

PROJECT NAME: ELMORE-MORRISTOWN

PROJECT NUMBER: STP 2937 (1)

FILE NAME: z11c310.dgn

PROJECT LEADER: C. LATHROP

DESIGNED BY: S. LAMPHERE

PLOT FILE: z11c310_145.i

PLOT DATE: 3/3/14

DRAWN BY: B. MARTIN

CHECKED BY: C. LATHROP

SHEET 145 OF 194