




282+50

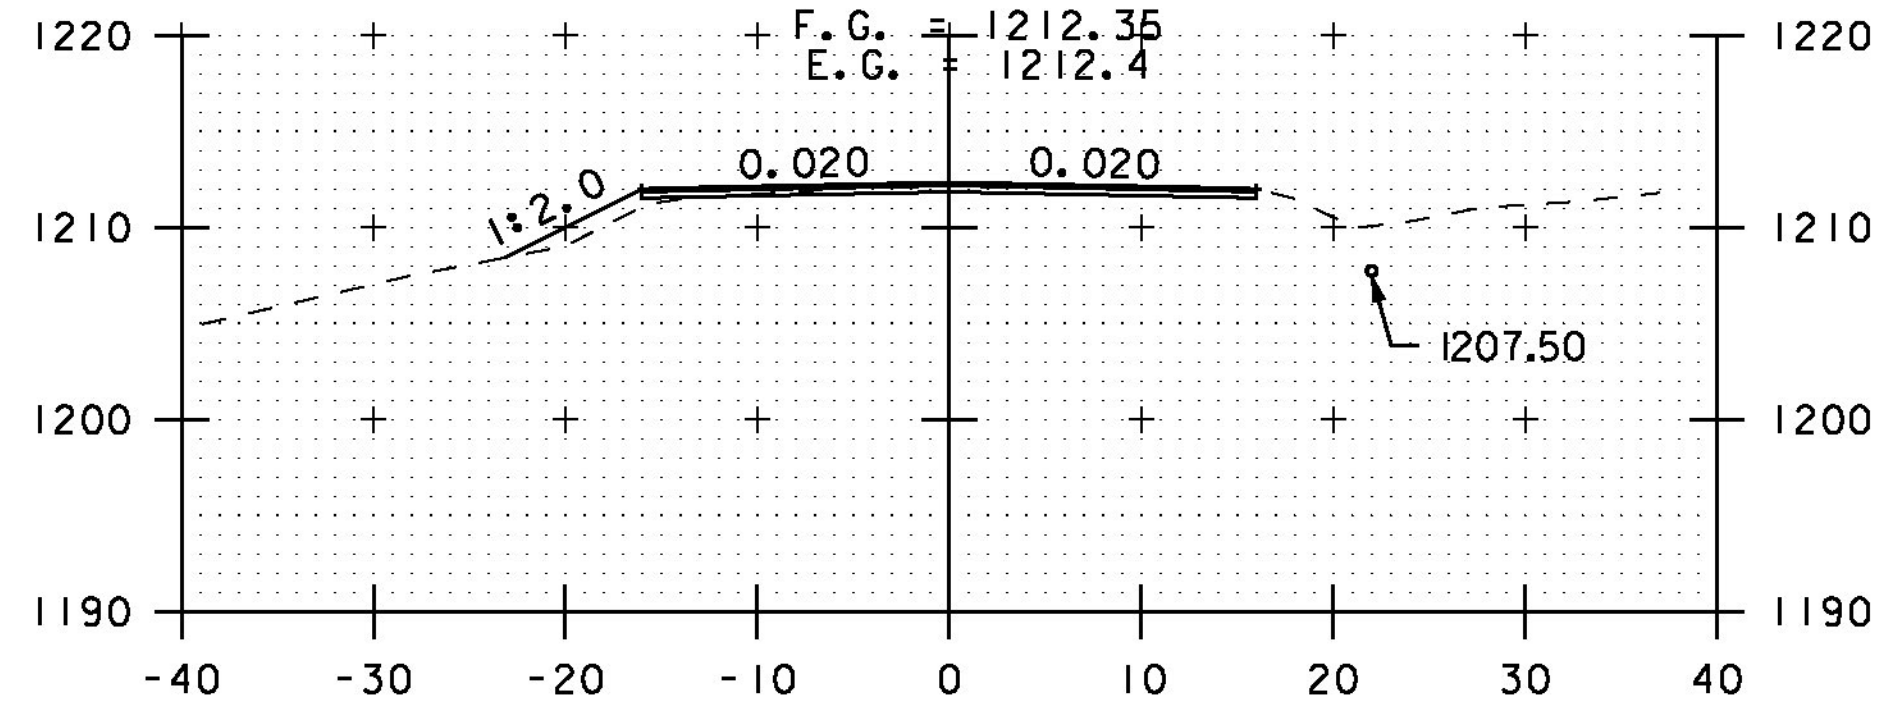


284+50

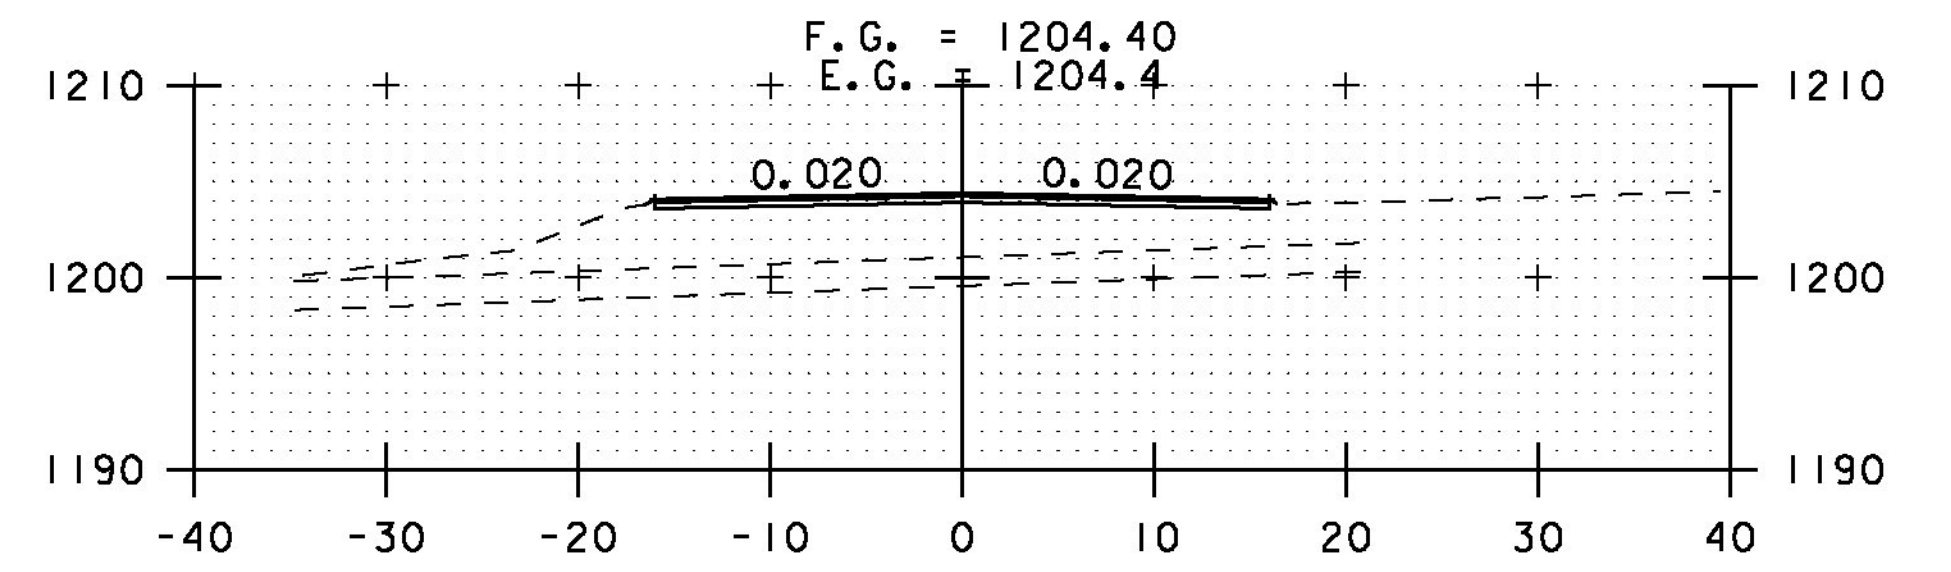


286+50

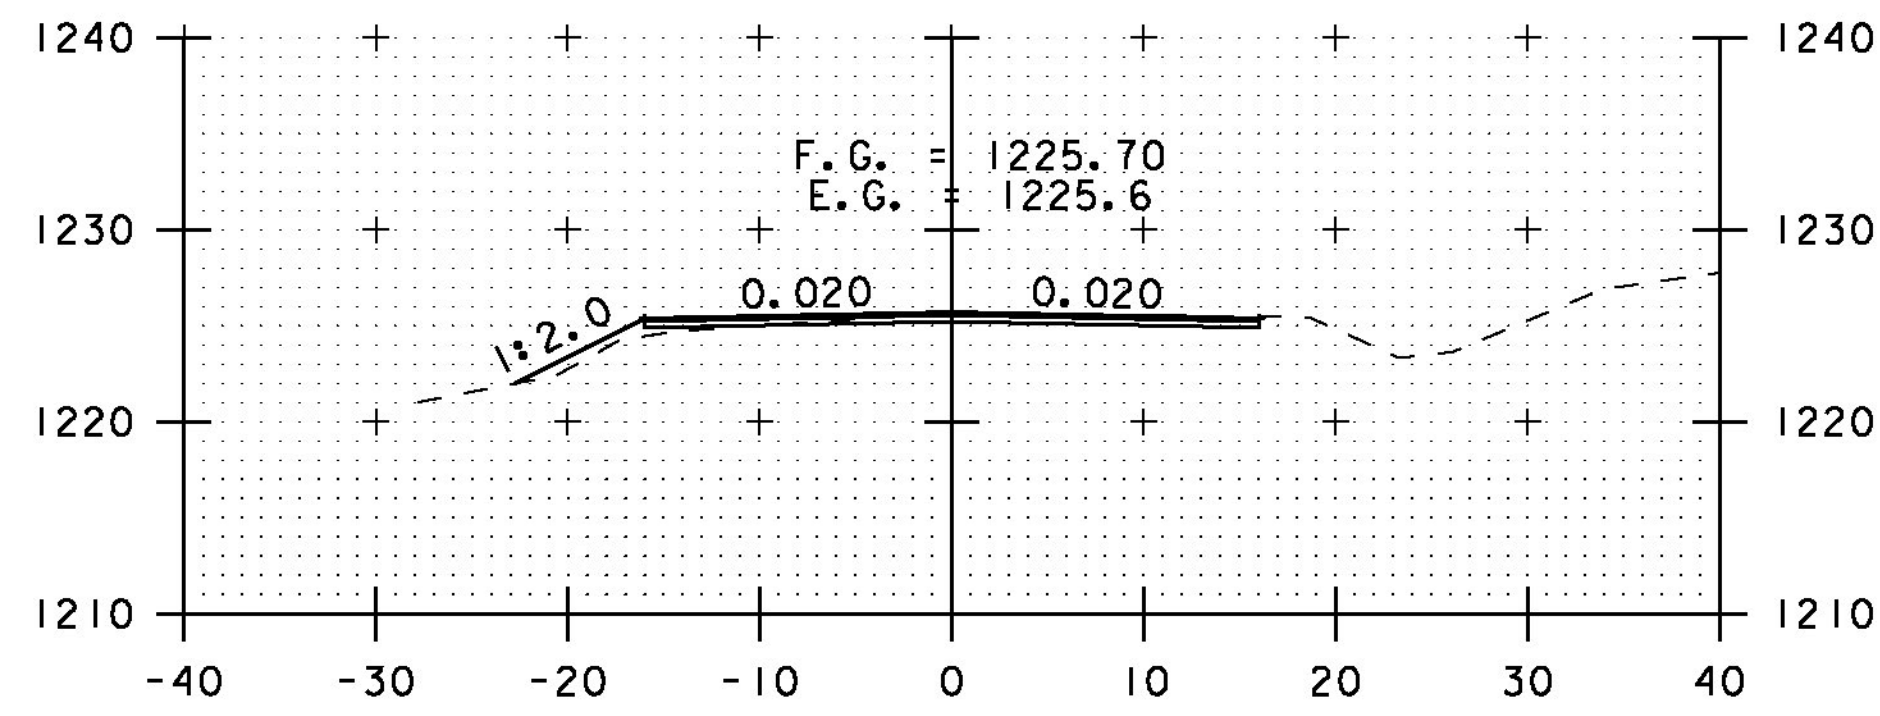


282+00

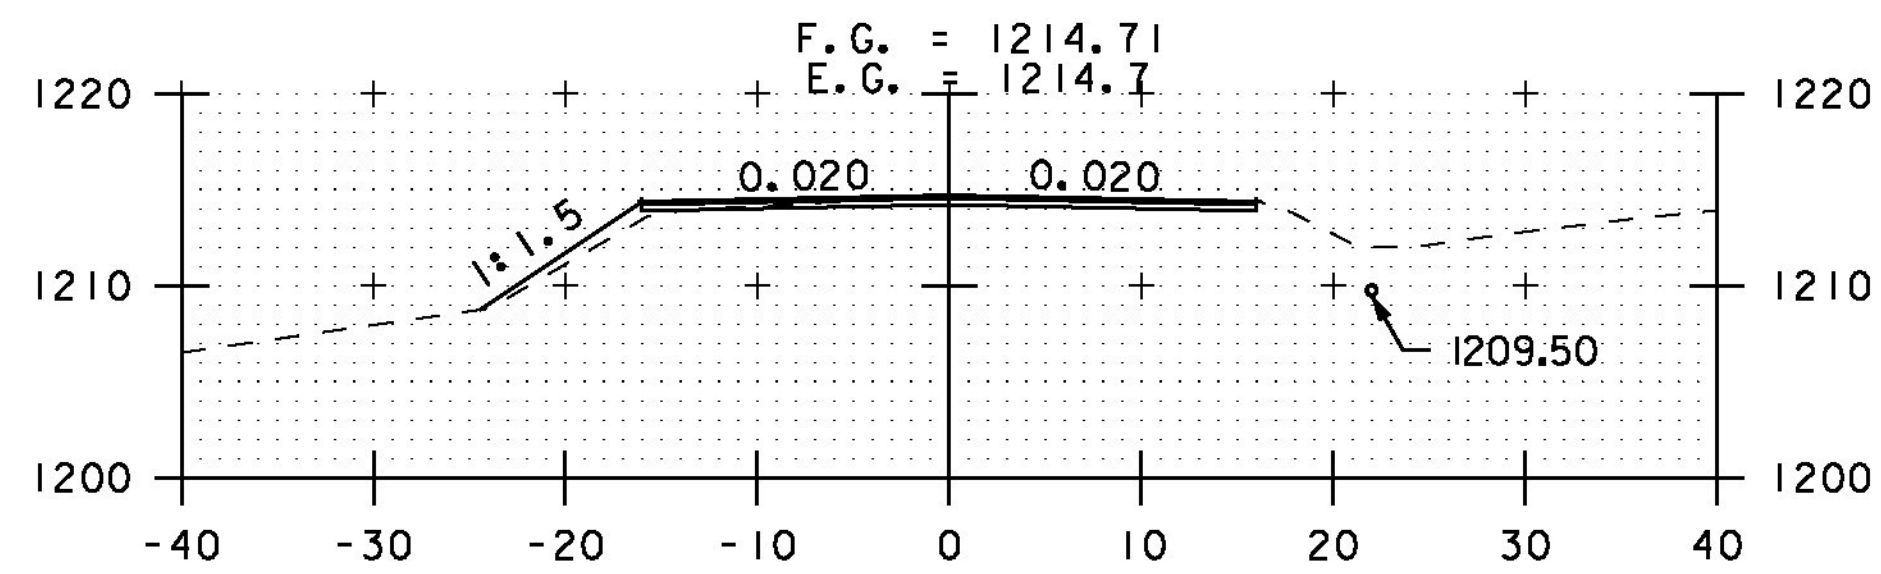


284+00

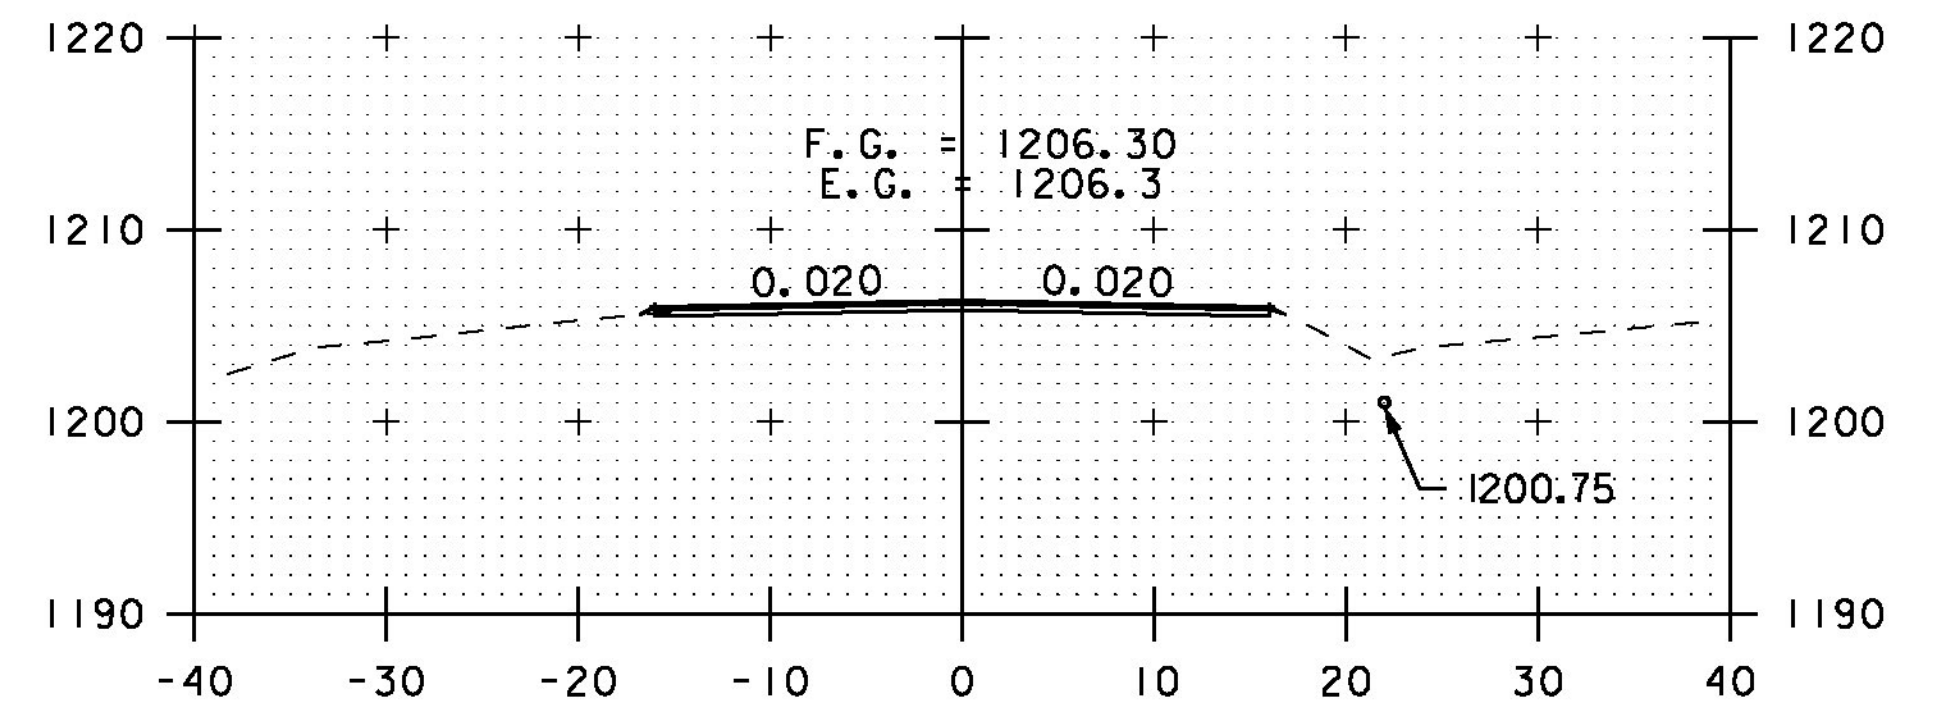


286+00

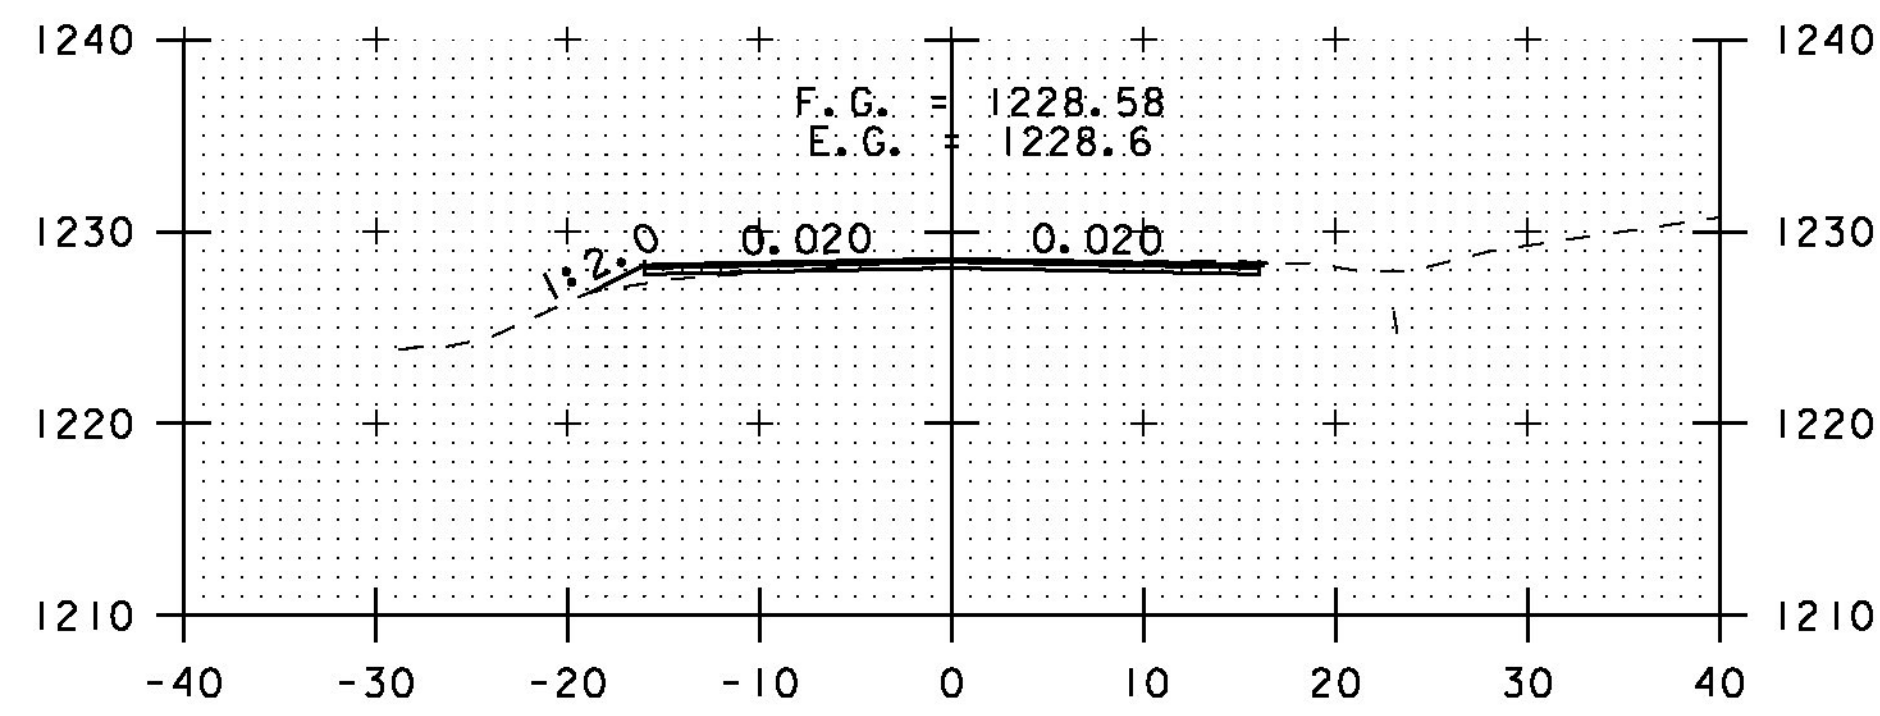


281+00

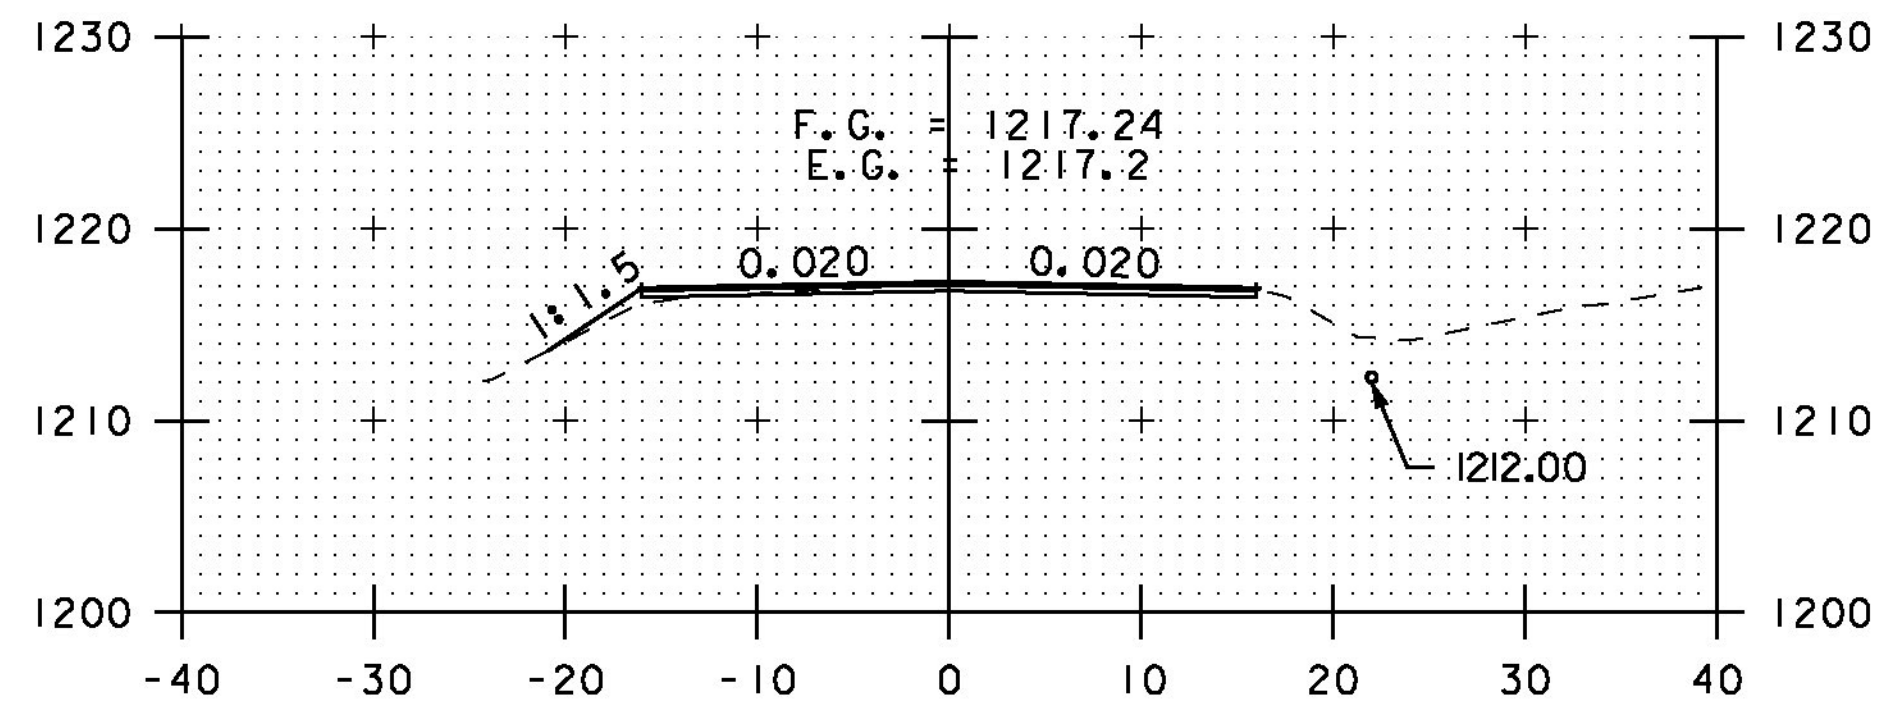


283+50

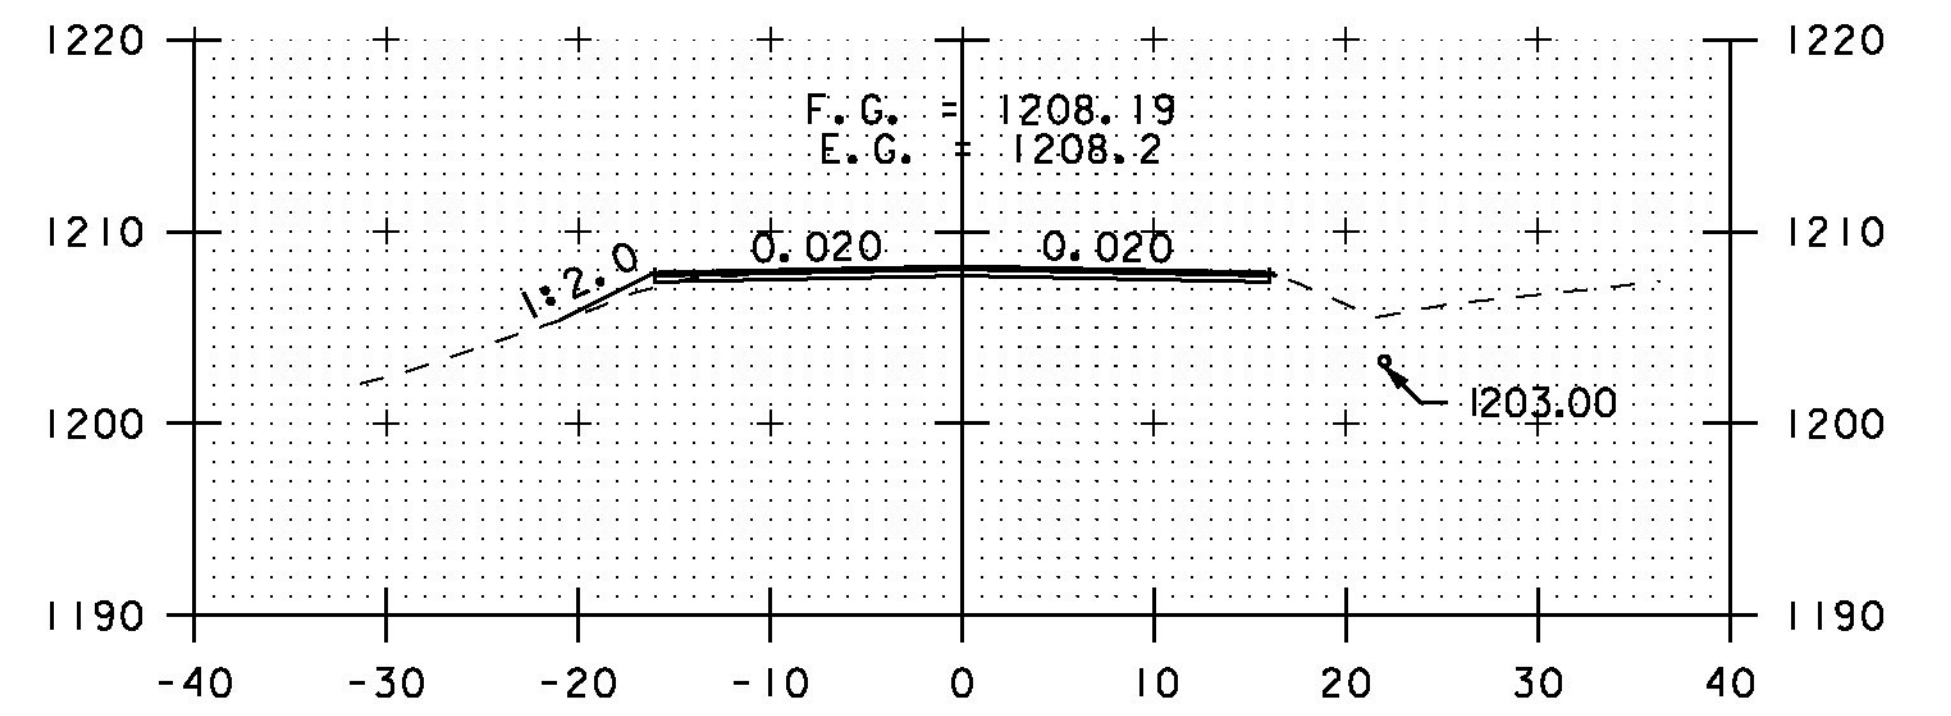


286+00

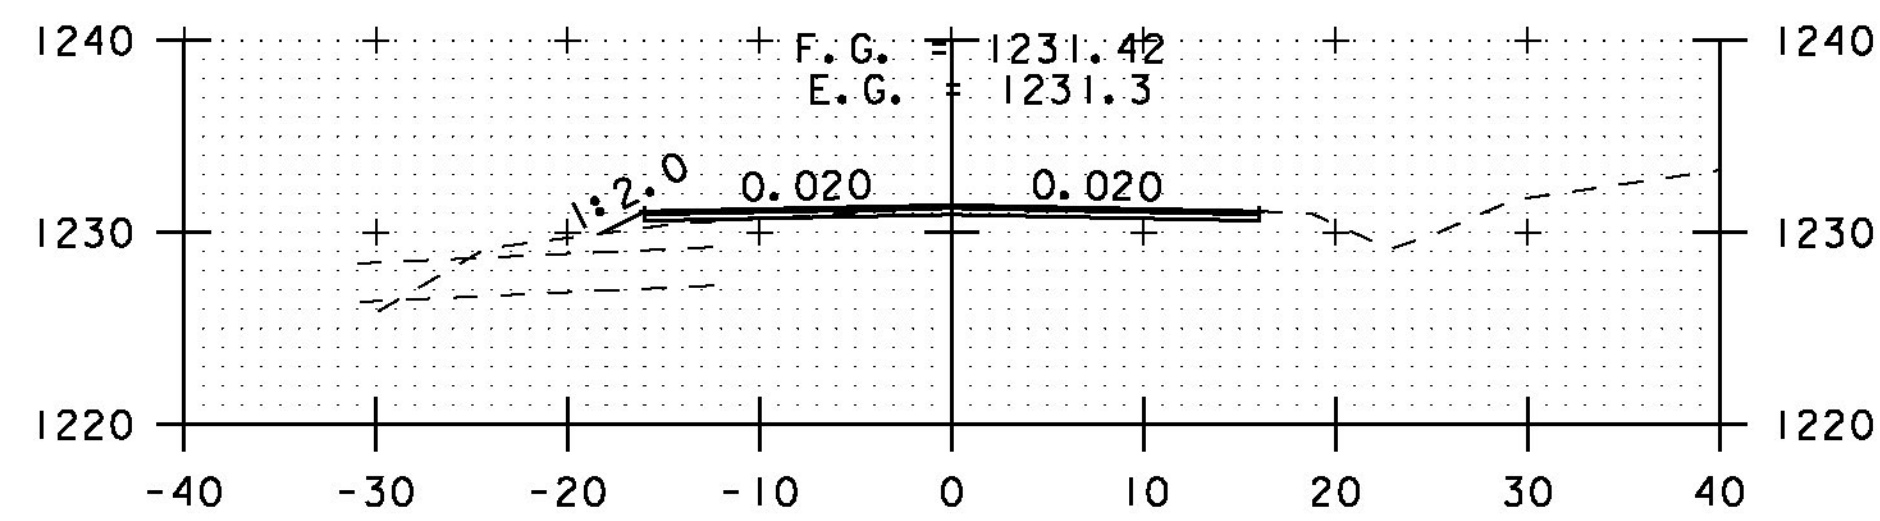

281+00

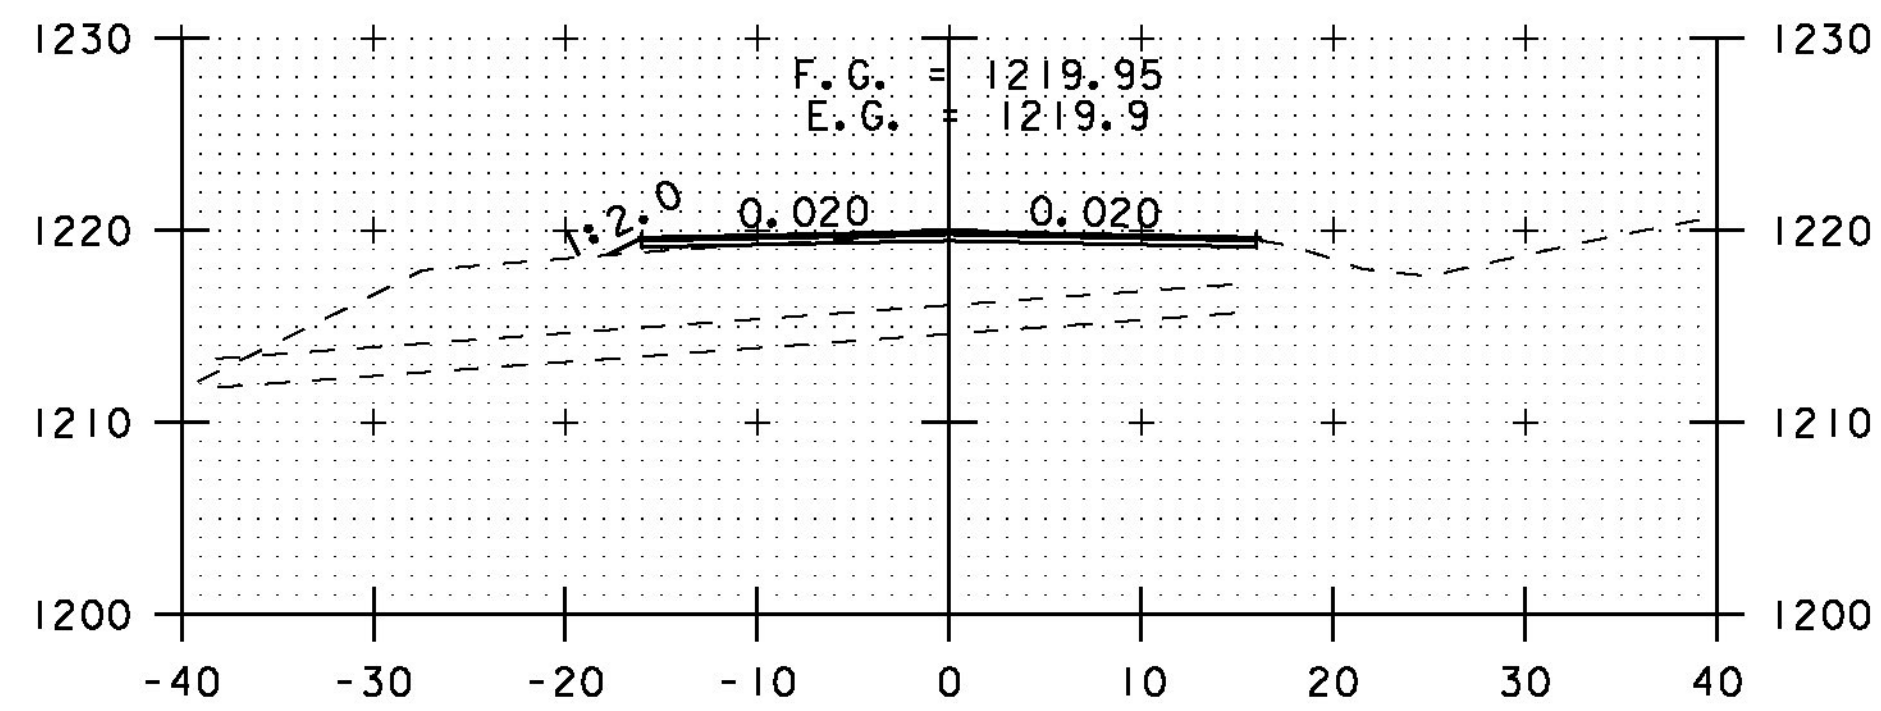

283+00

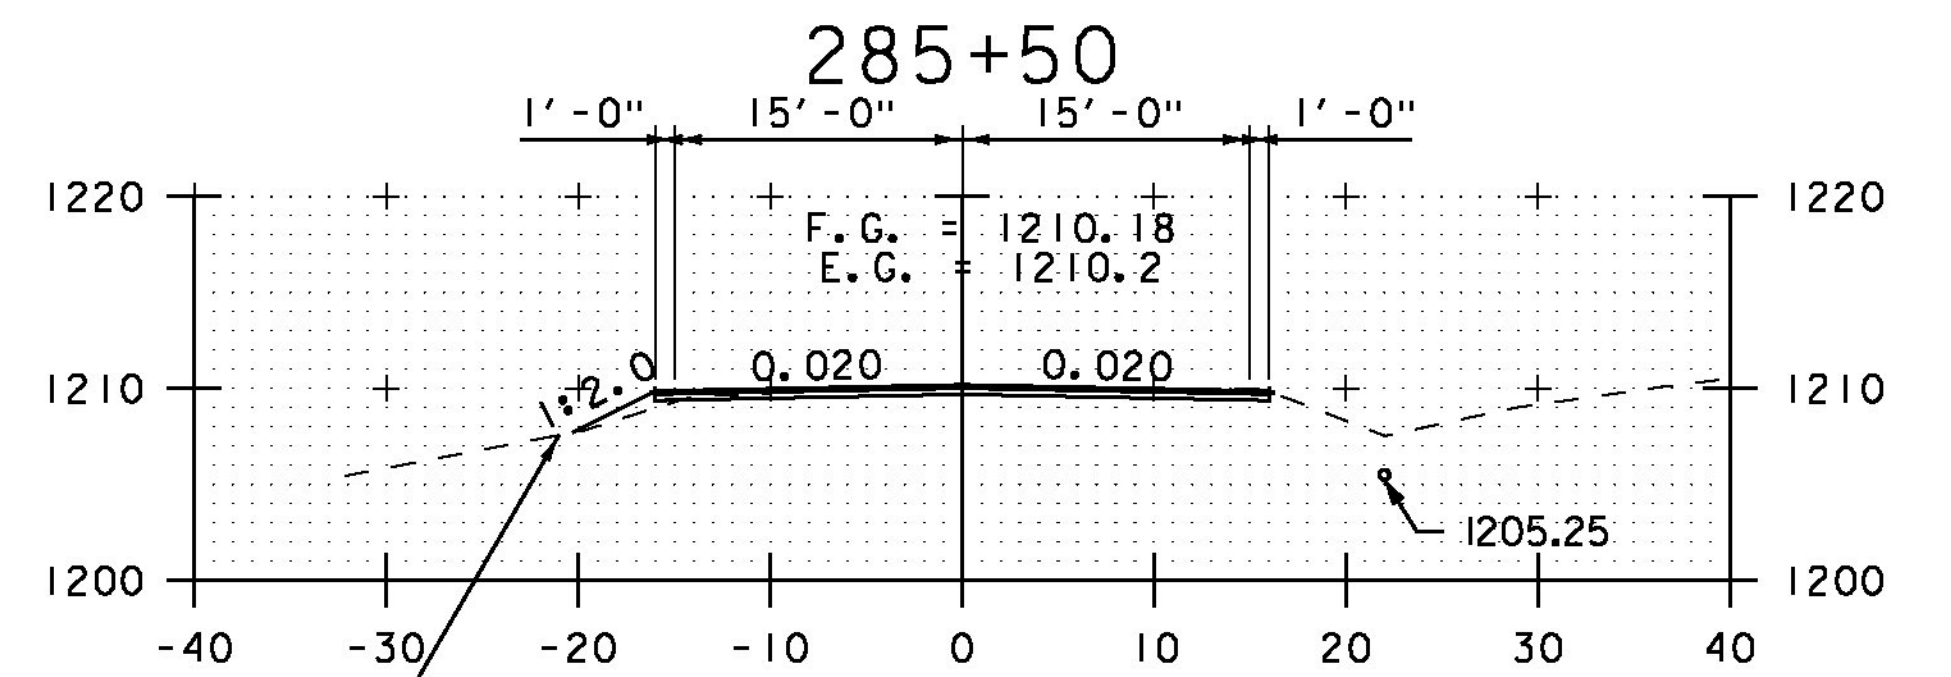

285+50

EXISTING GROUND (TYP.)

285+00

STA. 281+00 TO STA. 286+50



CROSS SECTION SHEET 18

PROJECT NAME: ELMORE-MORRISTOWN

PROJECT NUMBER: STP 2937 (1)

FILE NAME: z11c310.dgn

PROJECT LEADER: C. LATHROP

DESIGNED BY: S. LAMPHERE

PLOT FILE: z11c310_146.i

PLOT DATE: 3/3/14

DRAWN BY: B. MARTIN

CHECKED BY: C. LATHROP

SHEET 146 OF 194