




294+50

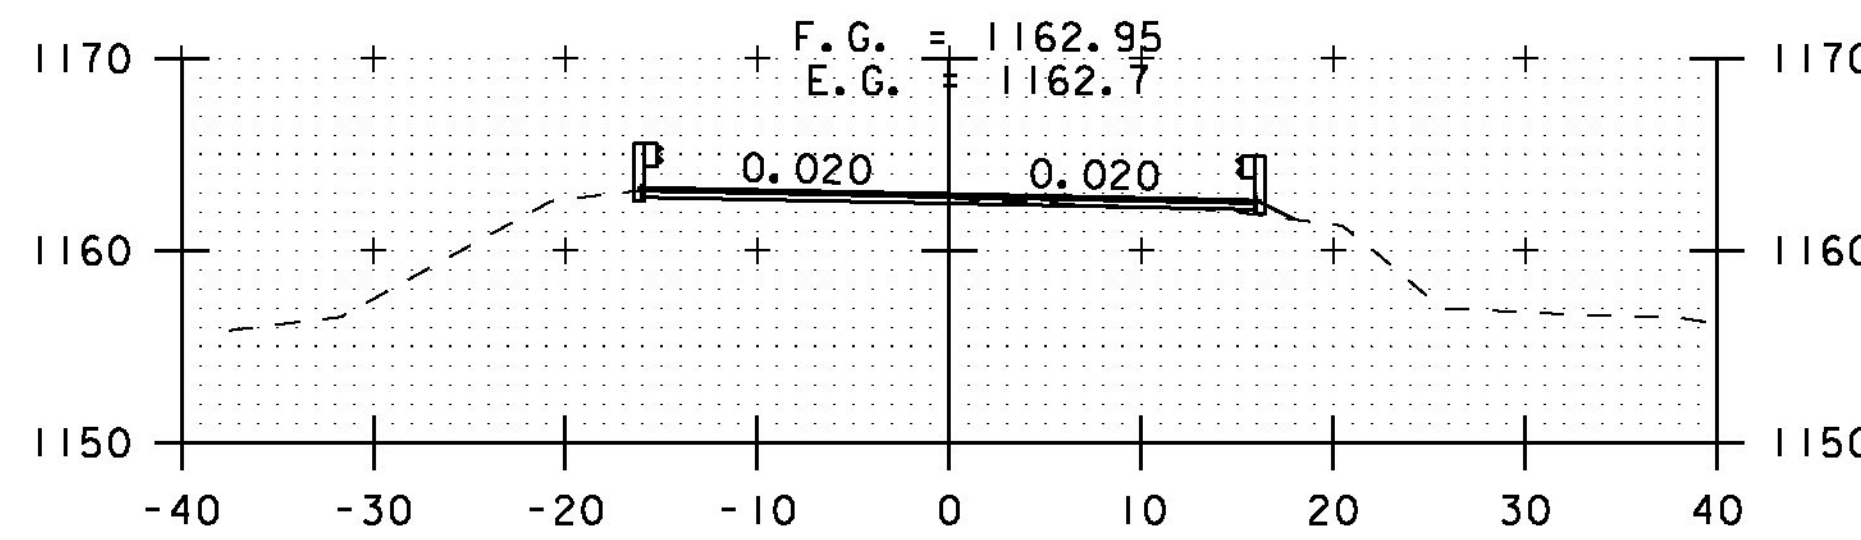


296+50

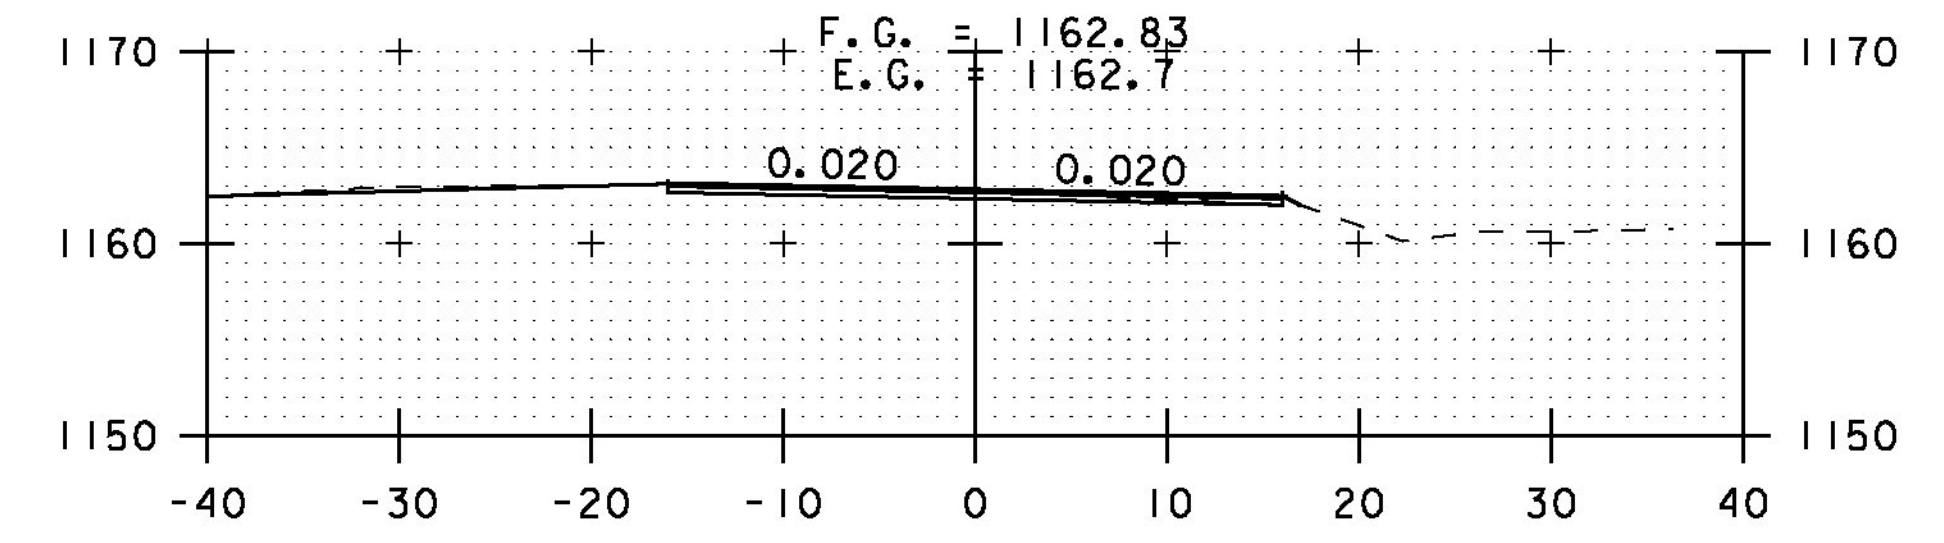


TH#8 LT
298+50

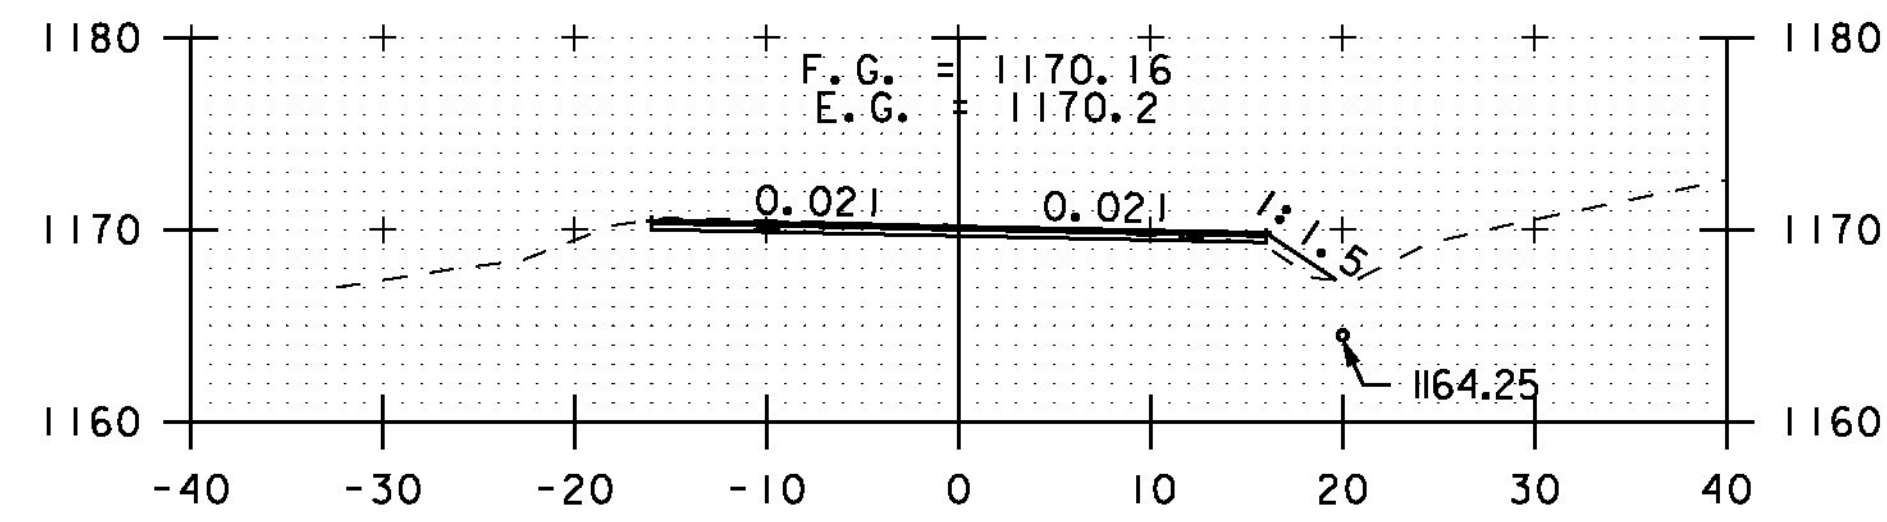


294+00

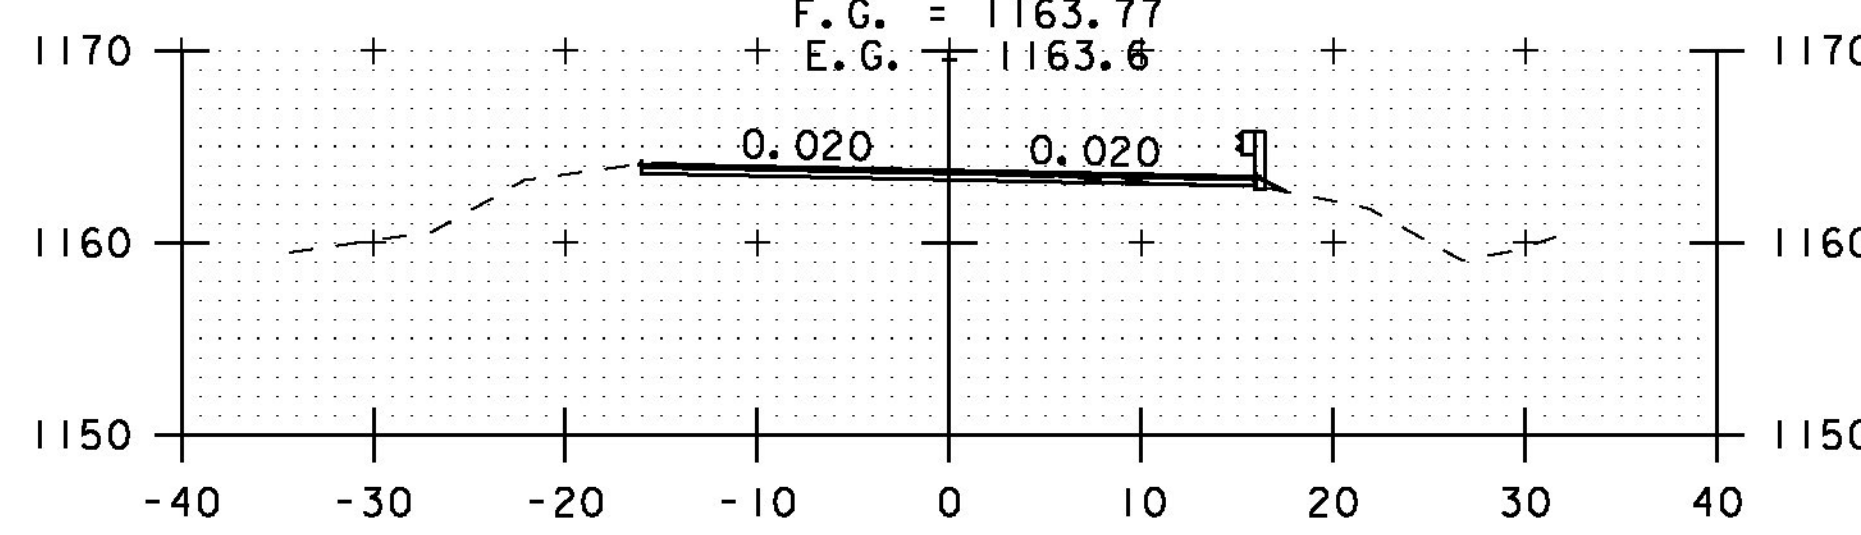


296+00

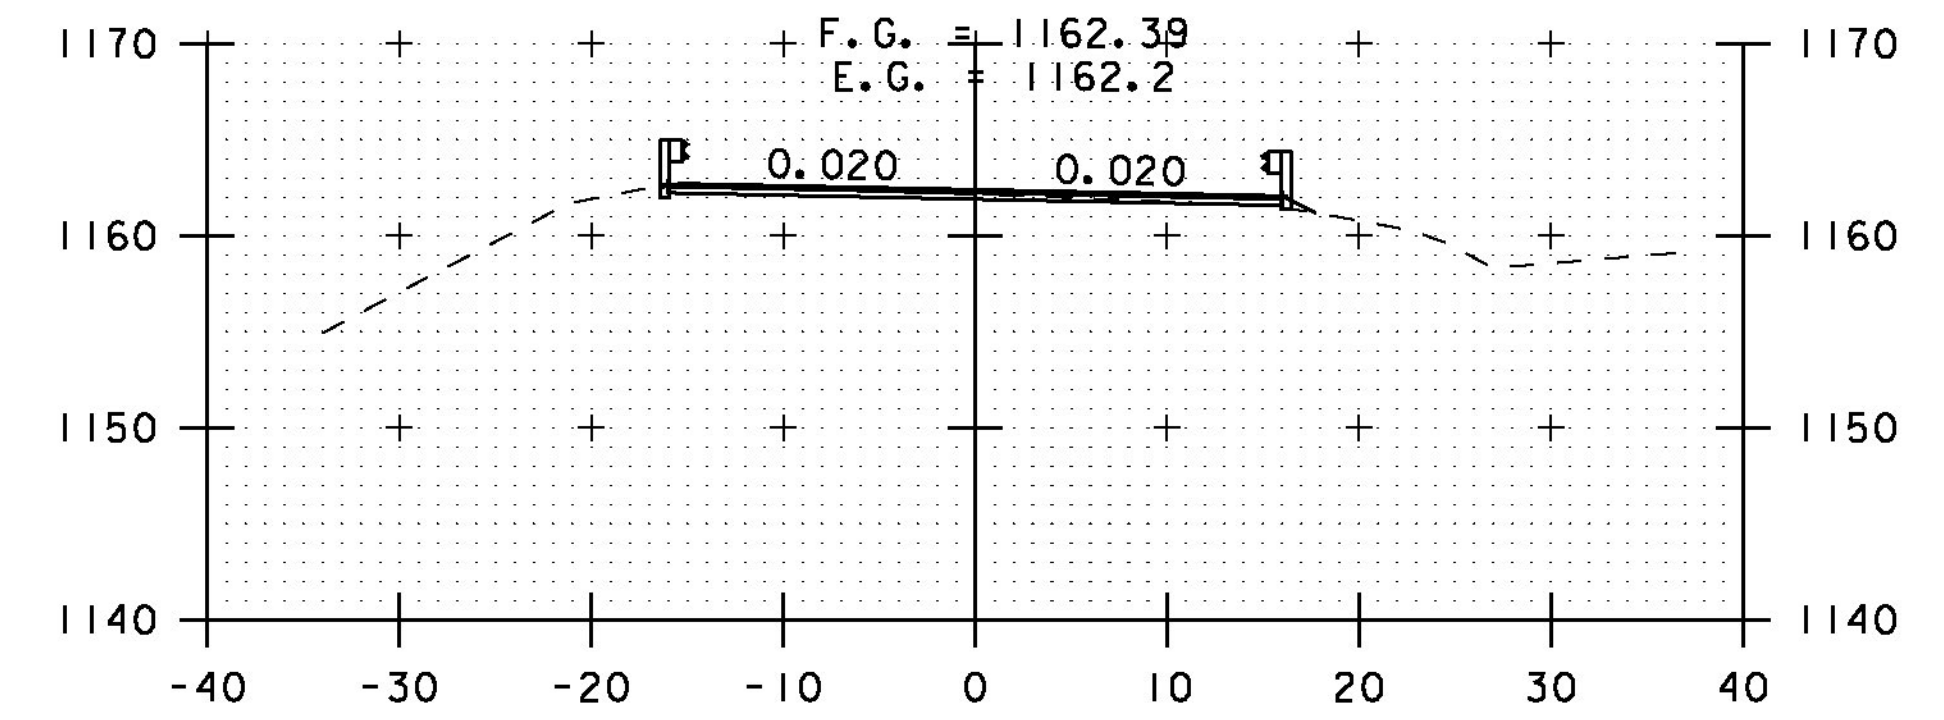


298+00

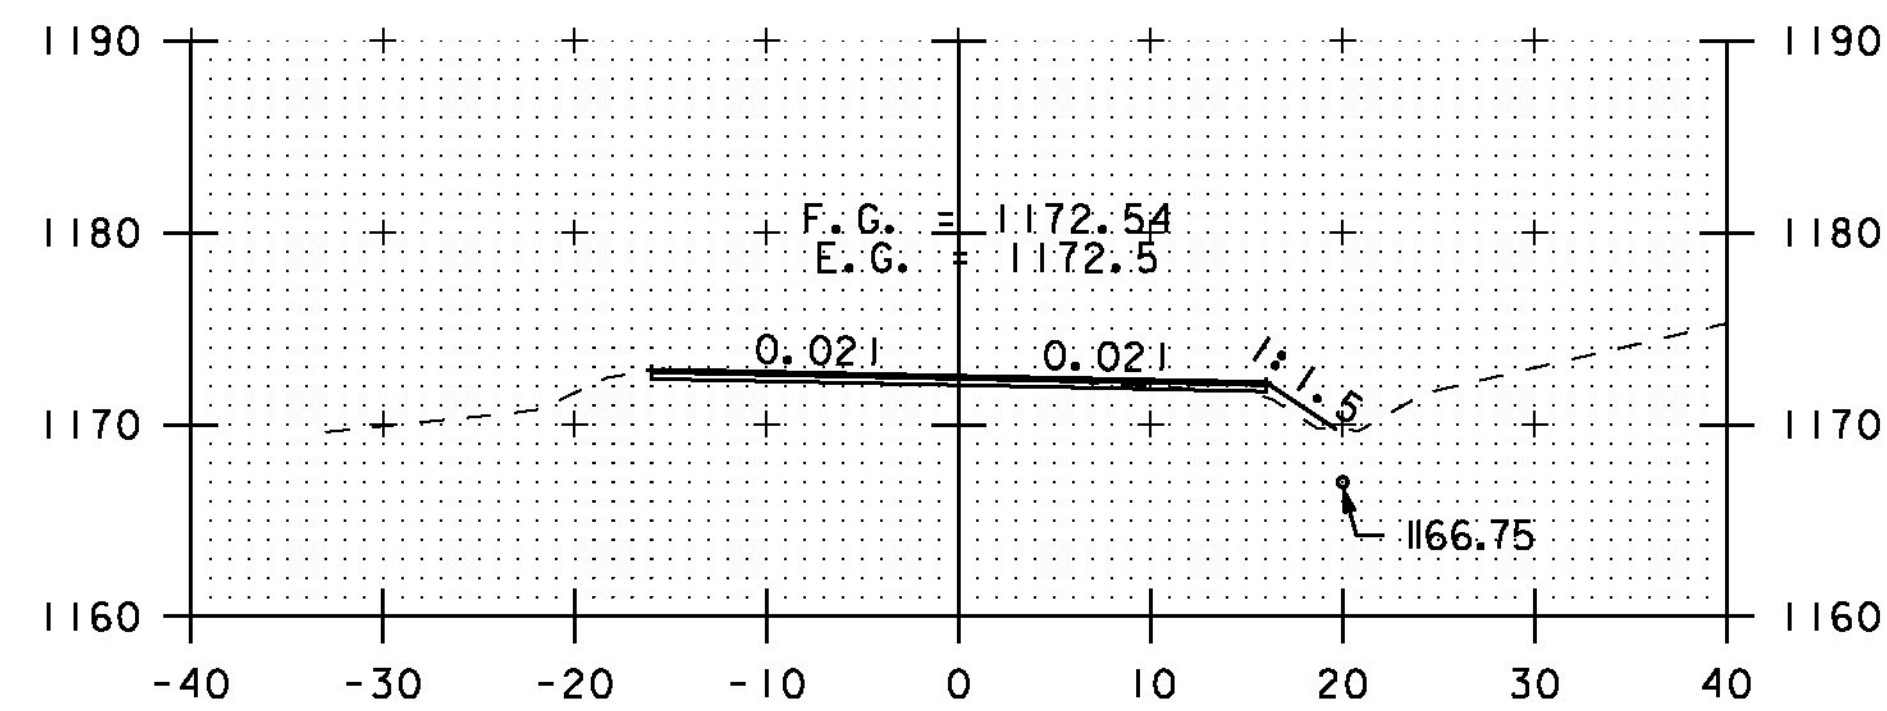


293+50

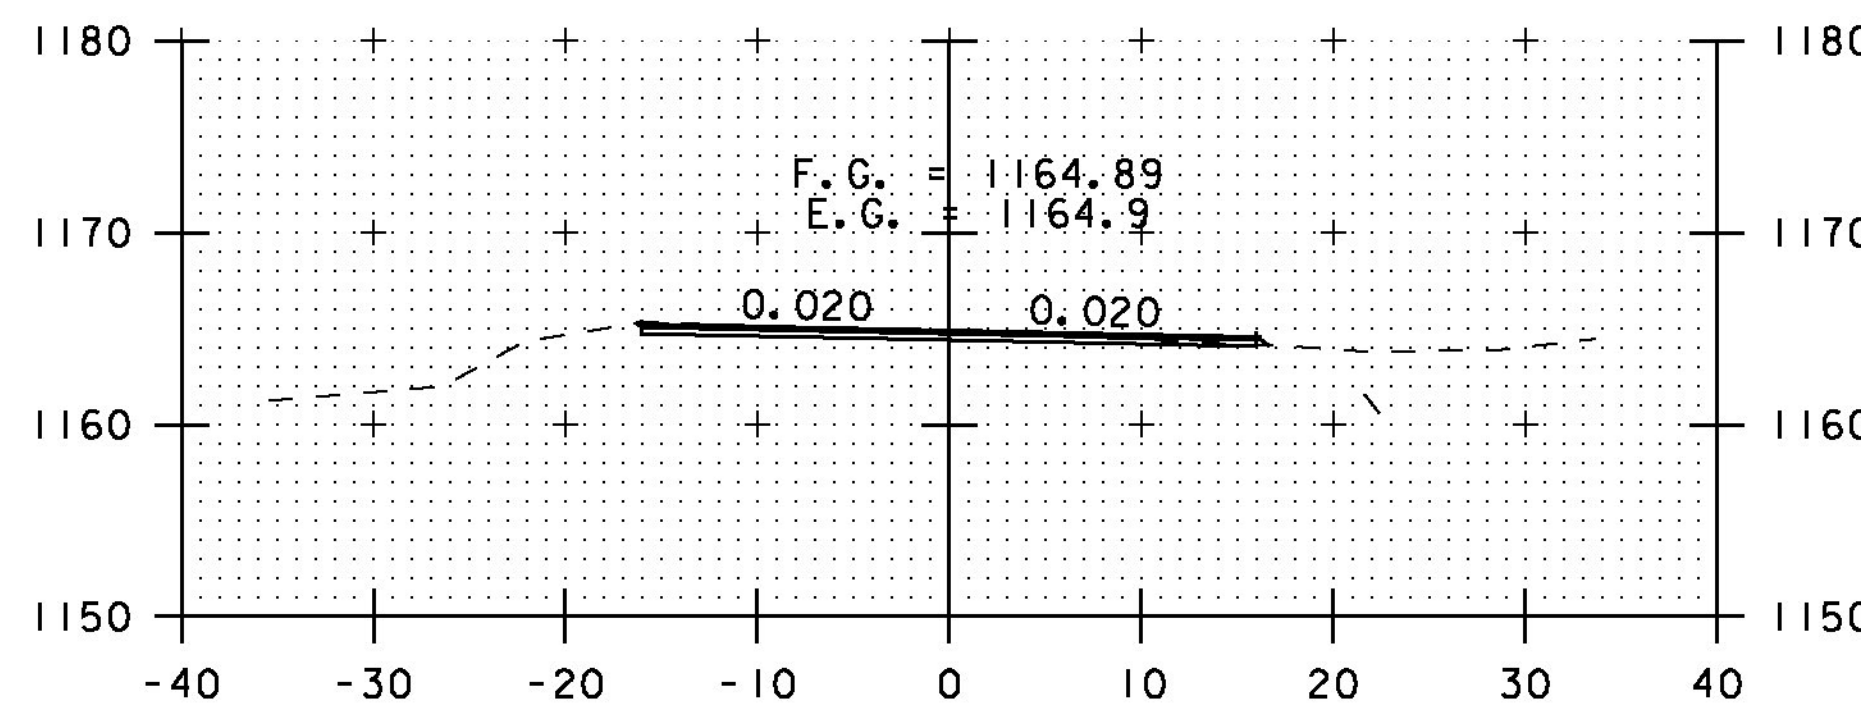


DRIVE RT
295+50

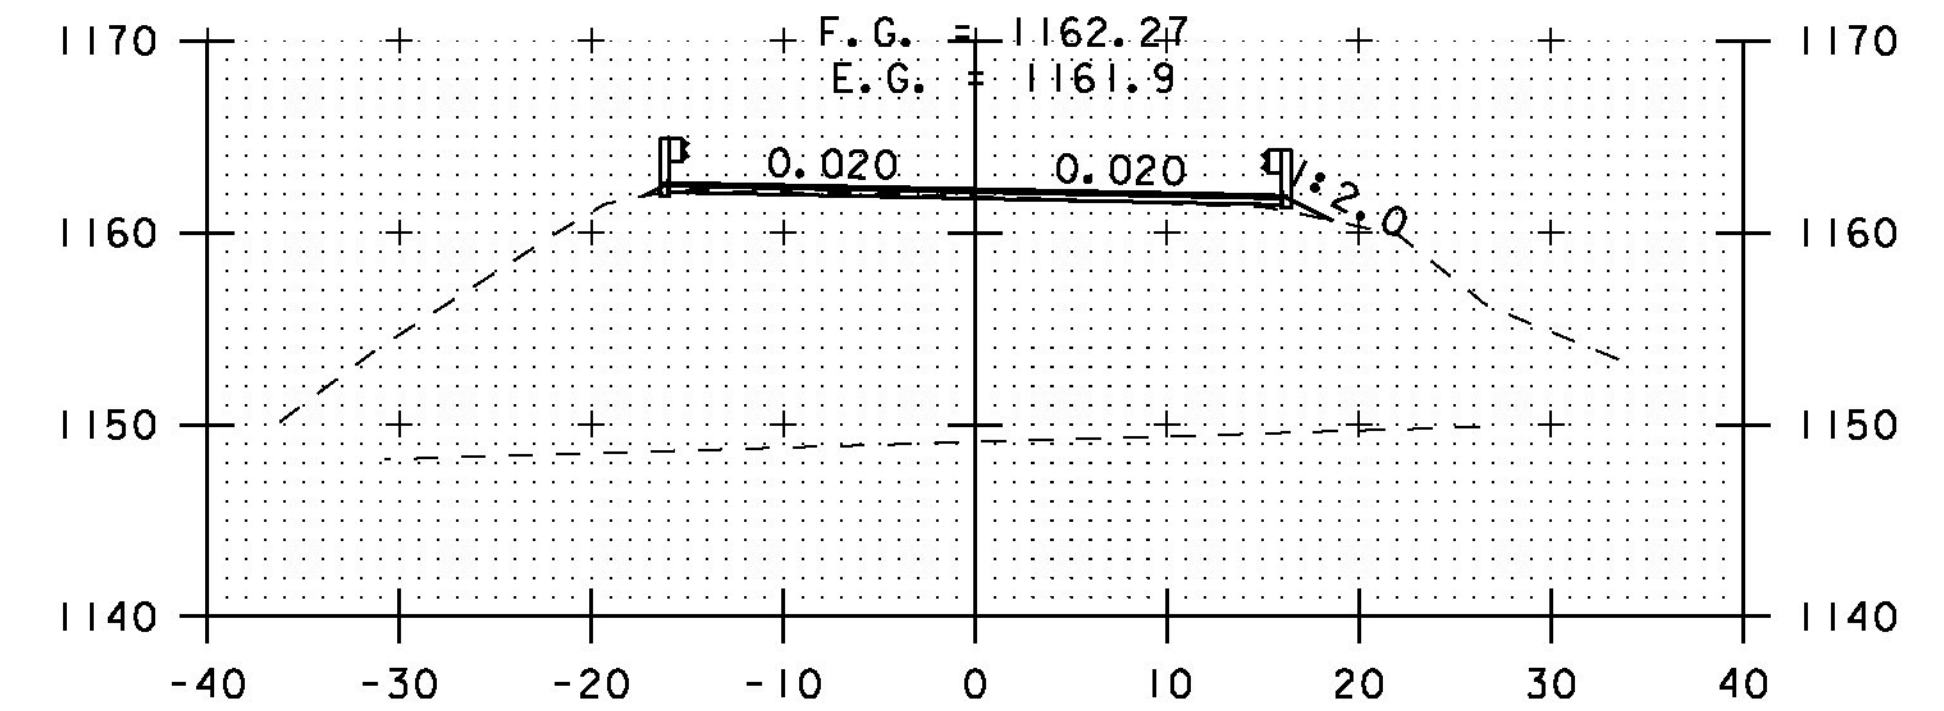


297+50

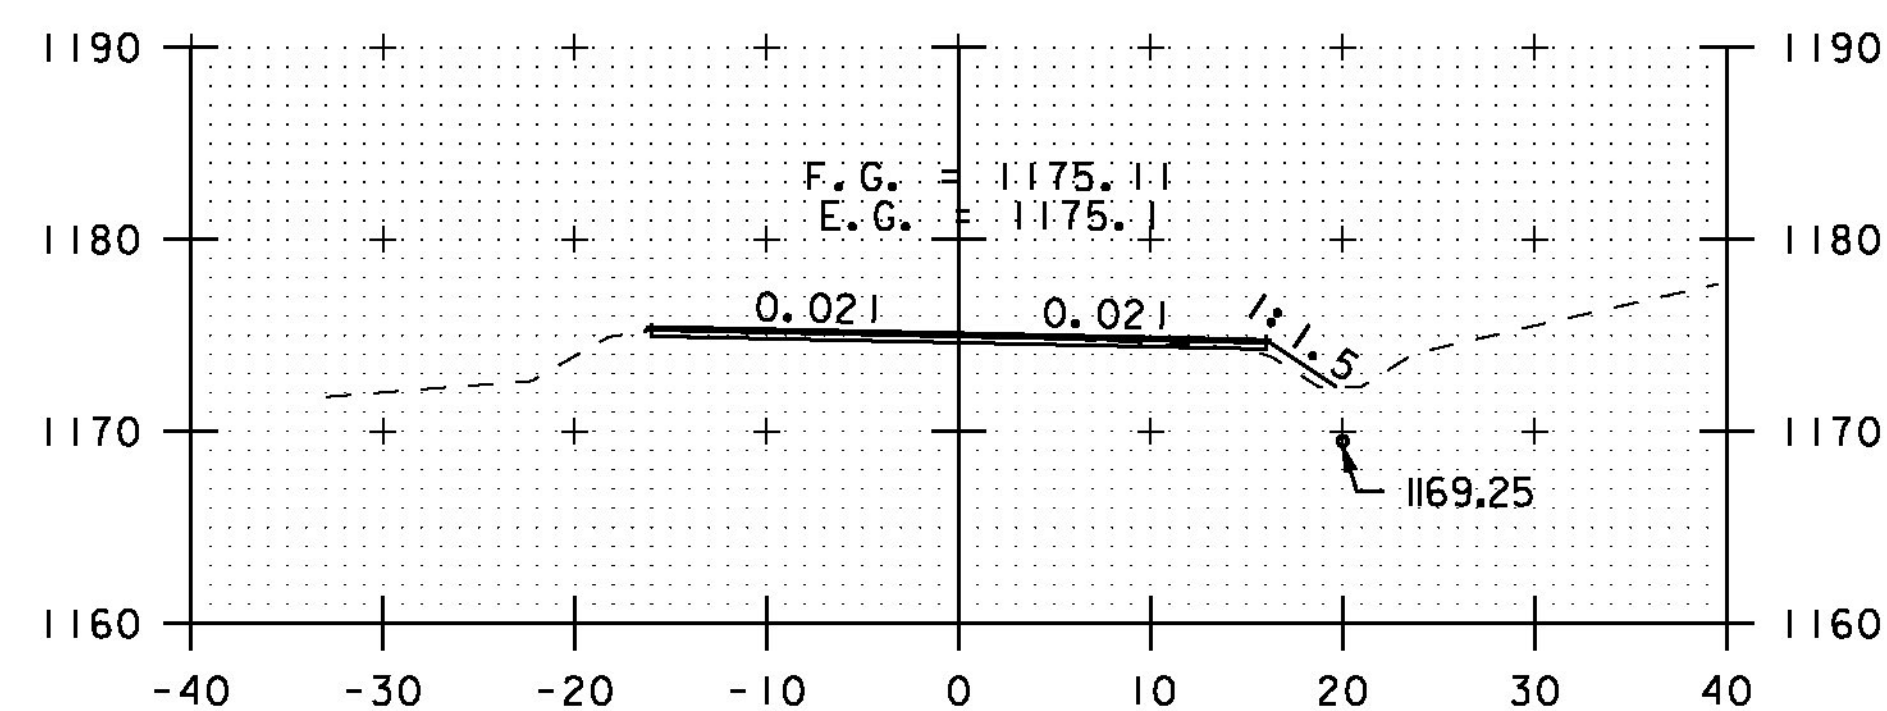

293+00

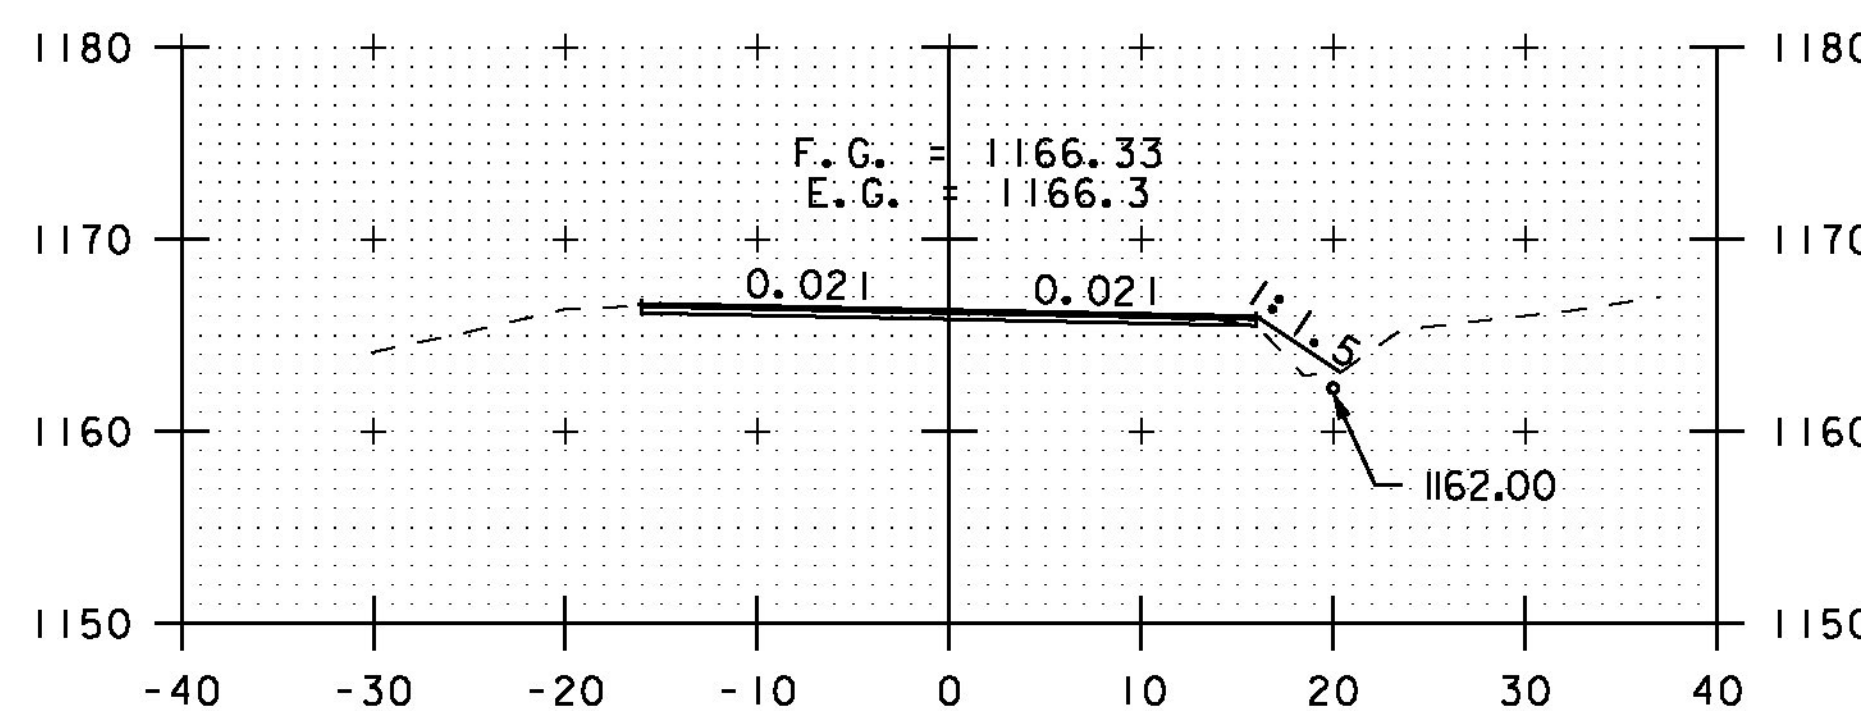

DRIVE LT
295+00

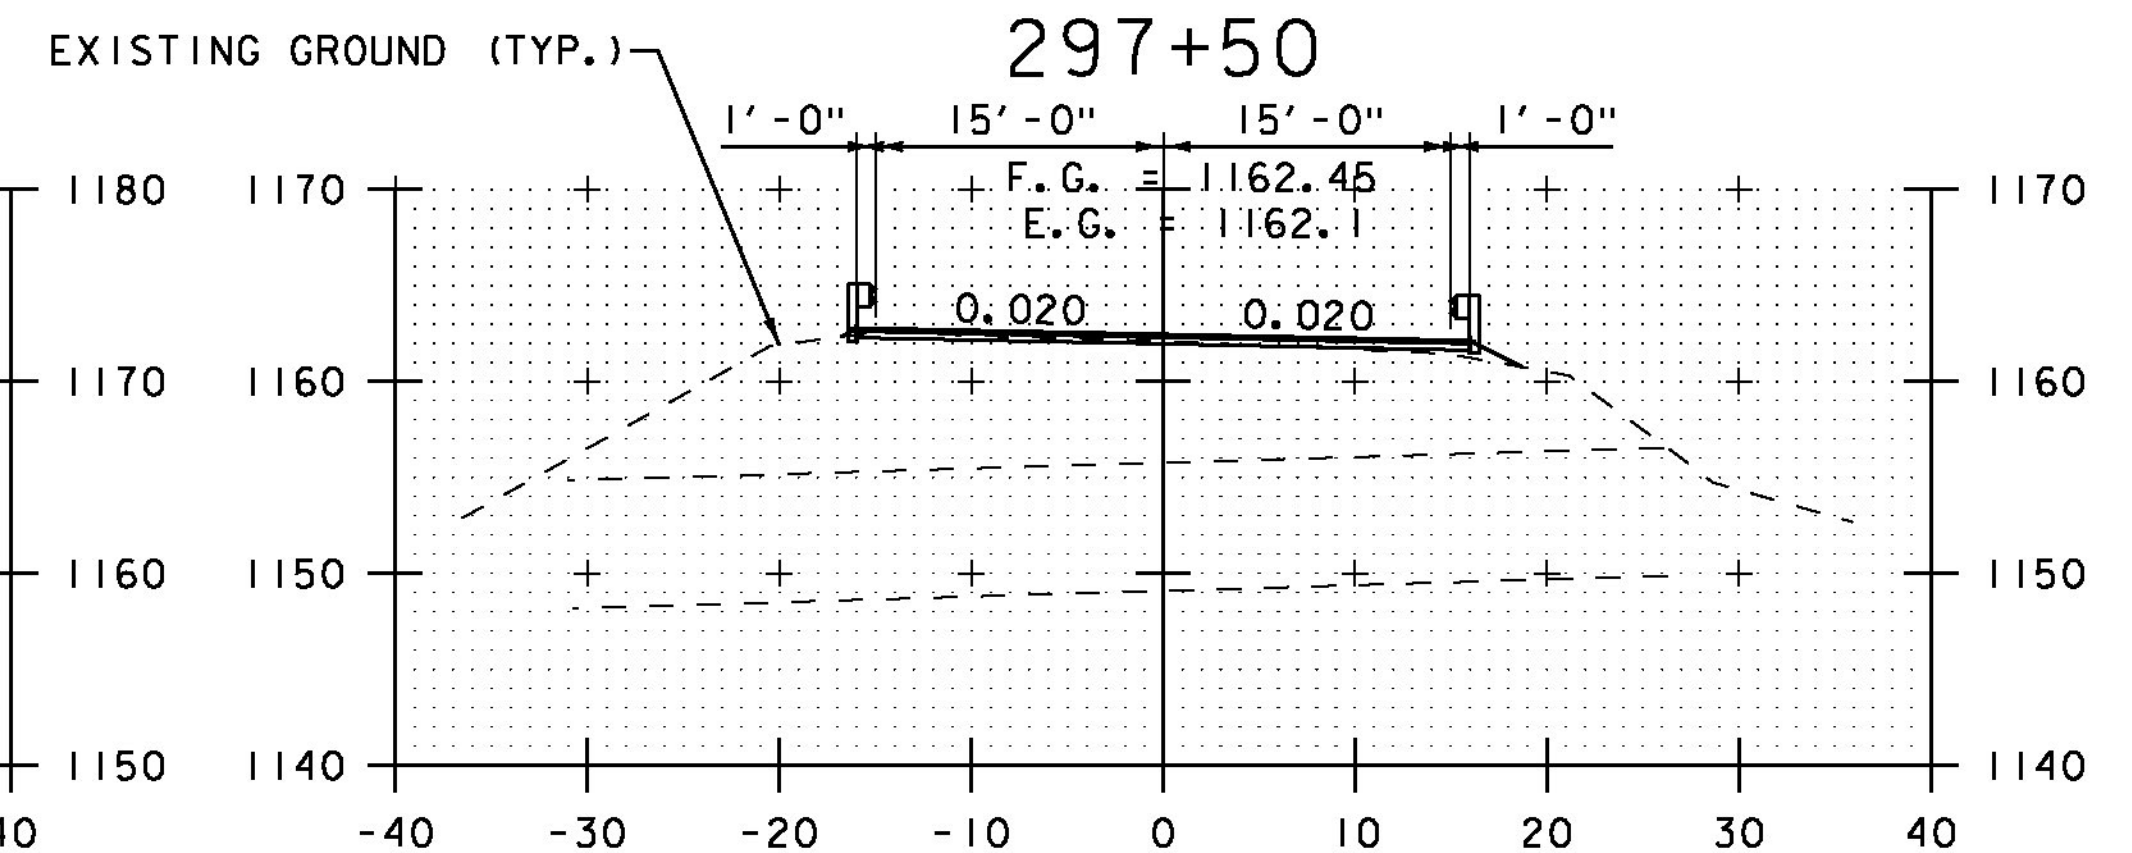

297+00



STA. 293+00 TO STA. 298+50

CROSS SECTION SHEET 20

PROJECT NAME: ELMORE-MORRISTOWN	PROJECT NUMBER: STP 2937 (1)
FILE NAME: z11c310.dgn	PLOT DATE: 3/3/14
PROJECT LEADER: C. LATHROP	DRAWN BY: B. MARTIN
DESIGNED BY: S. LAMPHERE	CHECKED BY: C. LATHROP
PLOT FILE: z11c310_148.i	SHEET 148 OF 194