




300+50

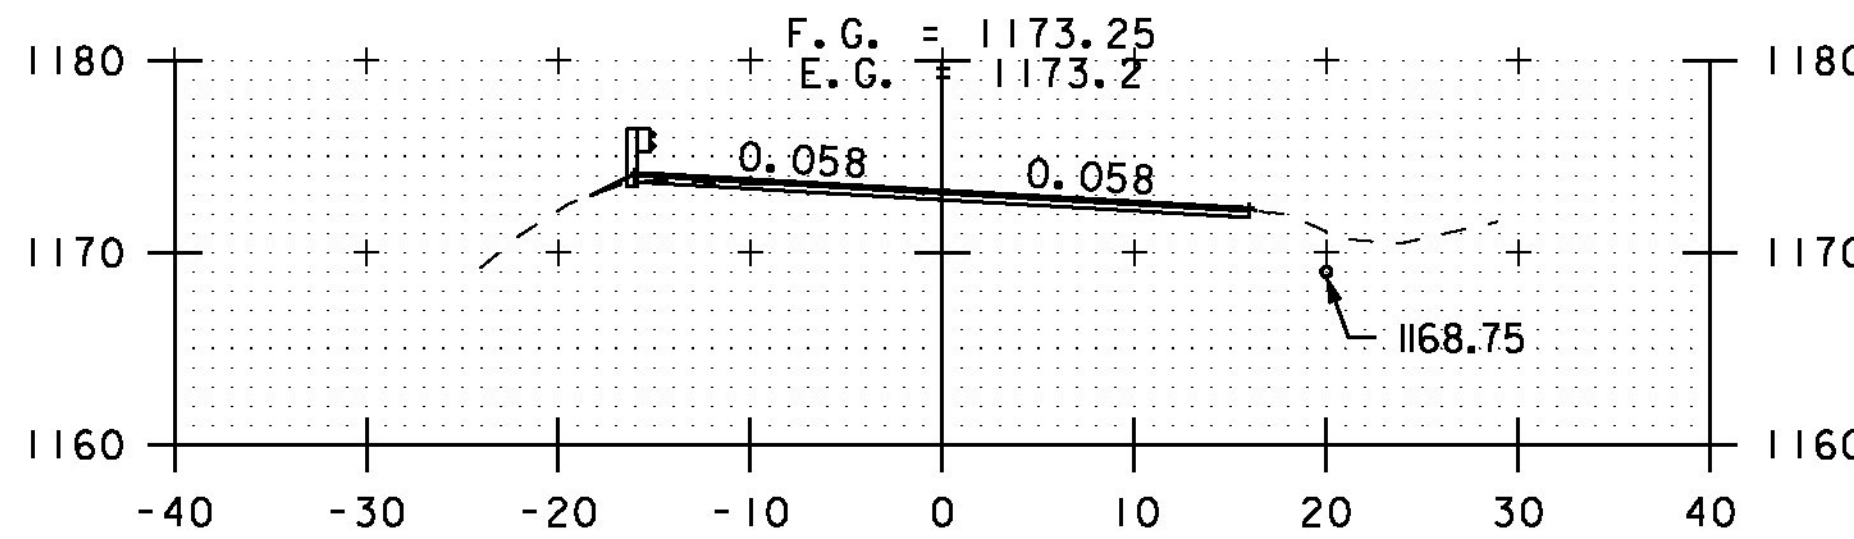


302+50

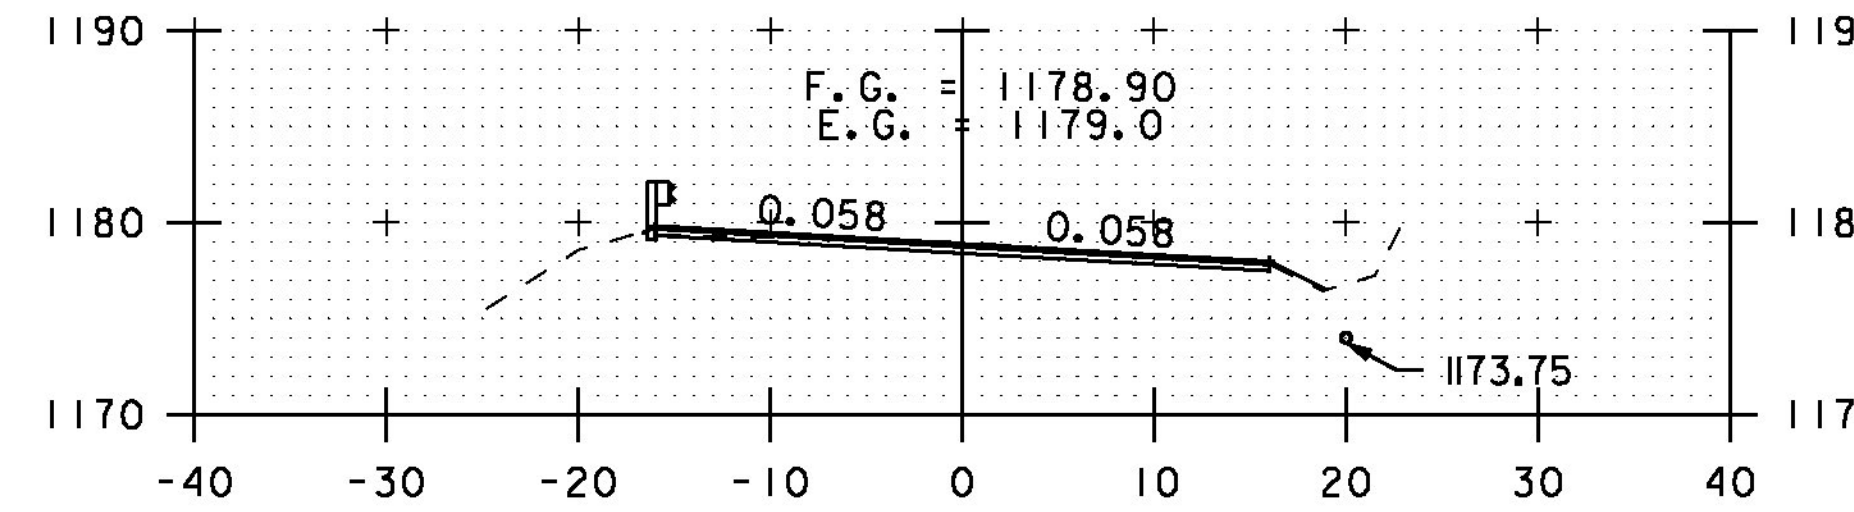


304+50

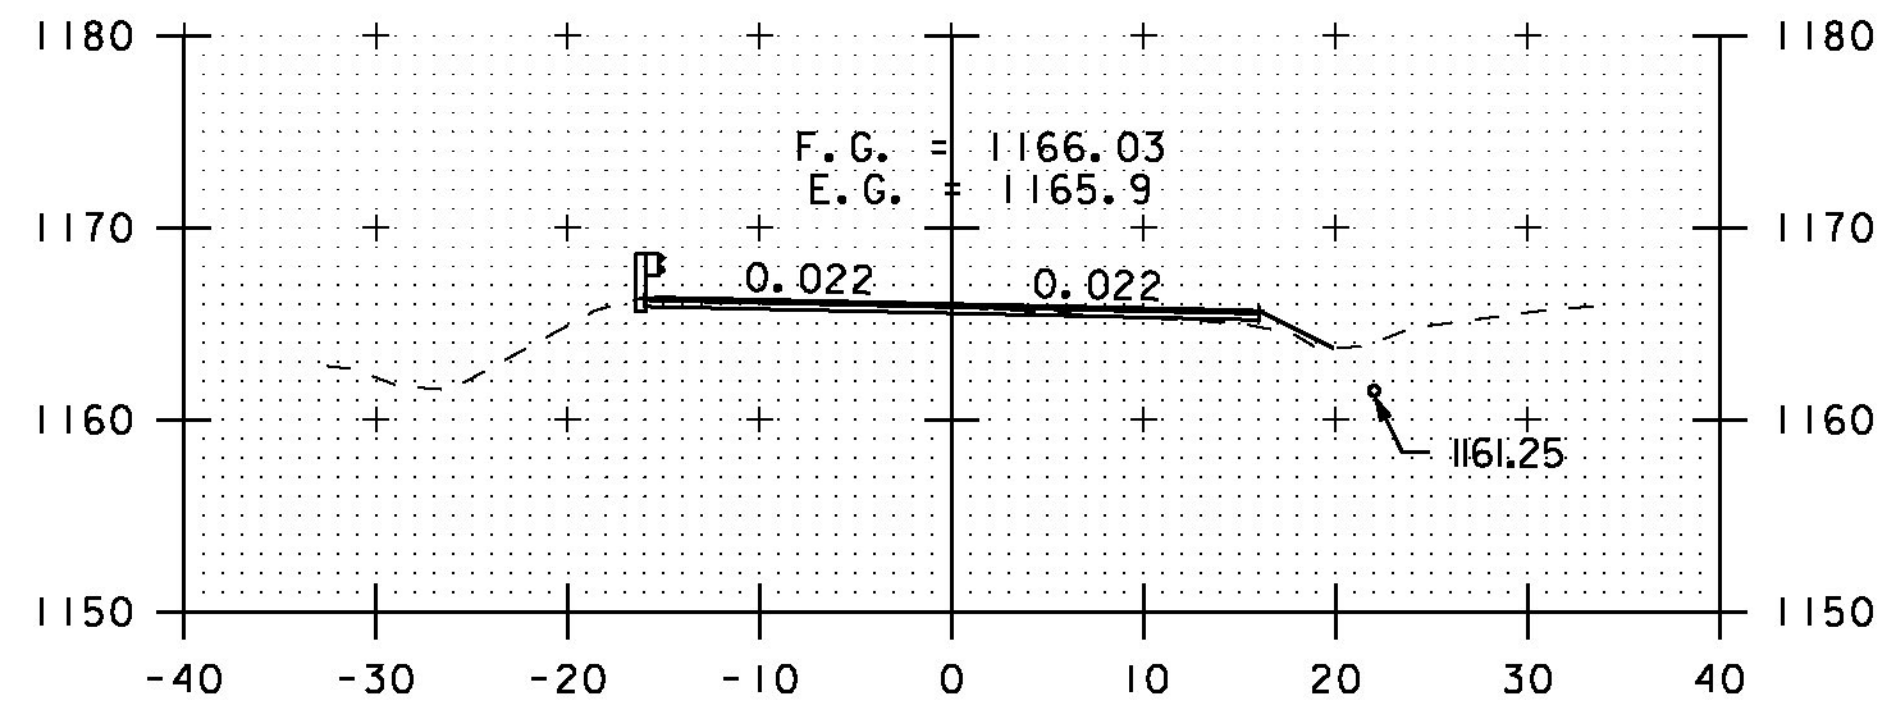


300+00

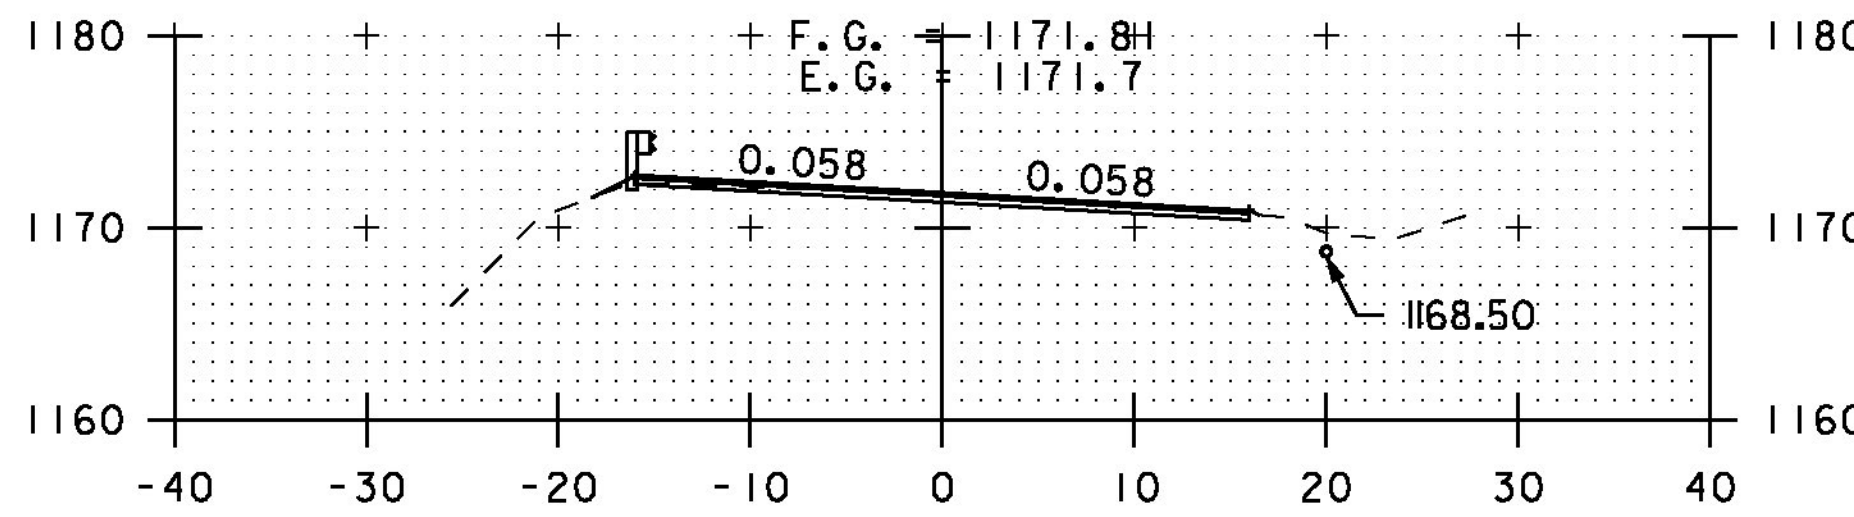


302+00

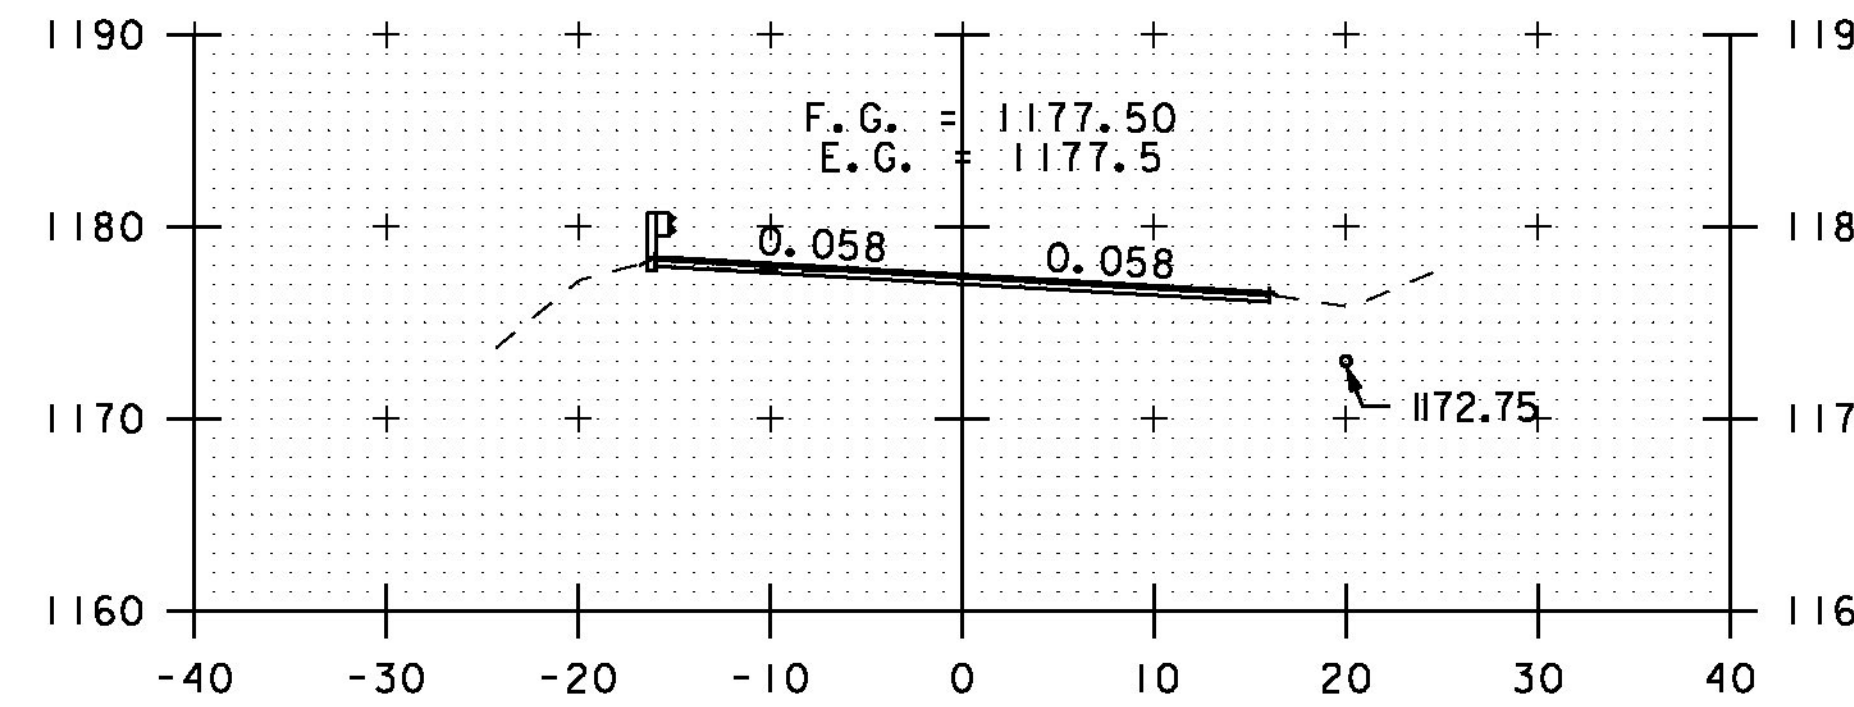


304+00

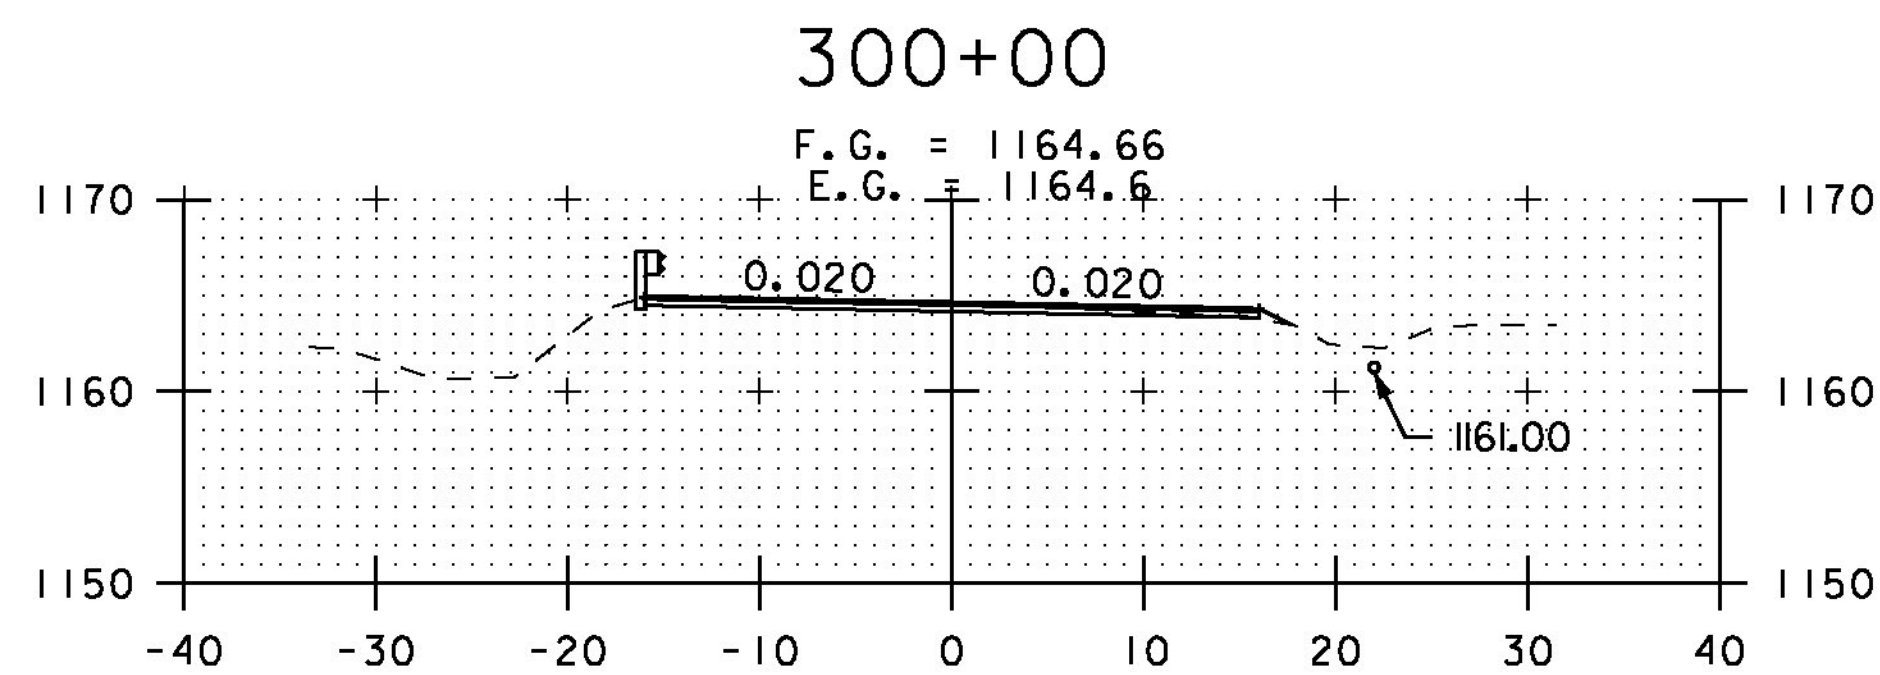


299+50

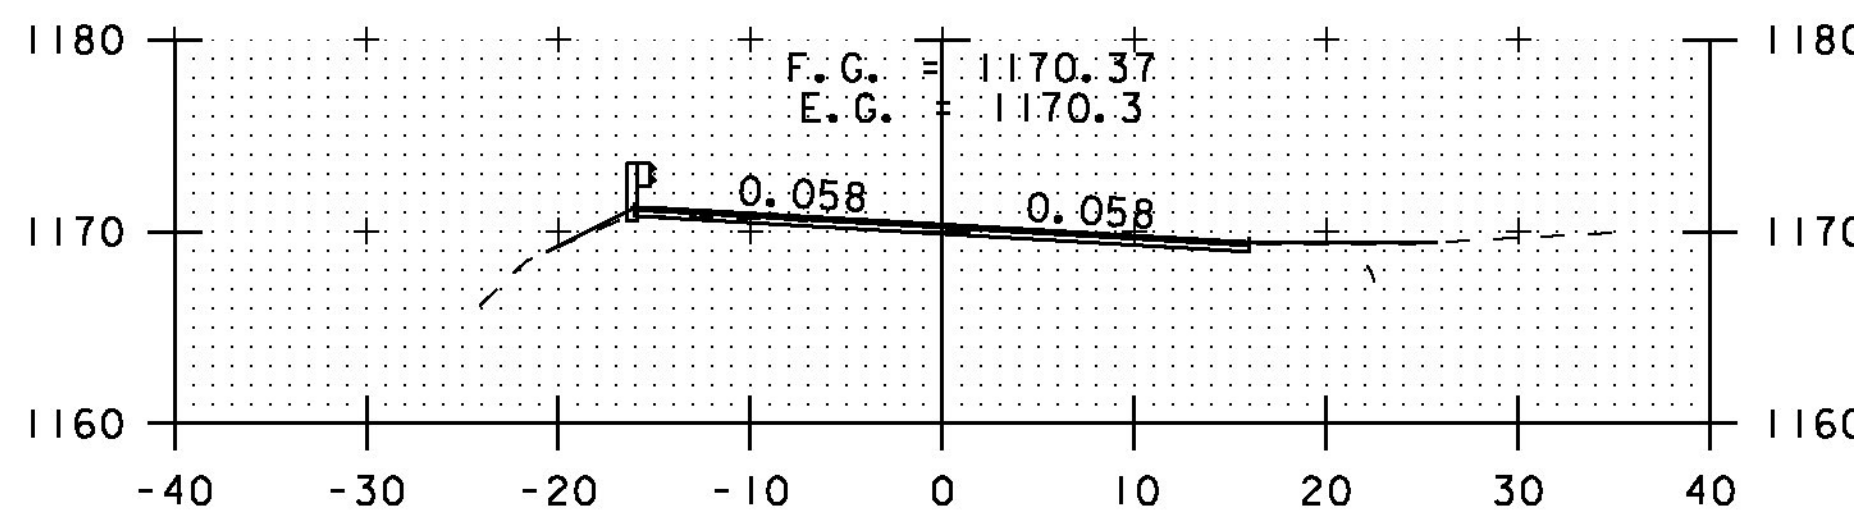


DRIVE RT  
301+50

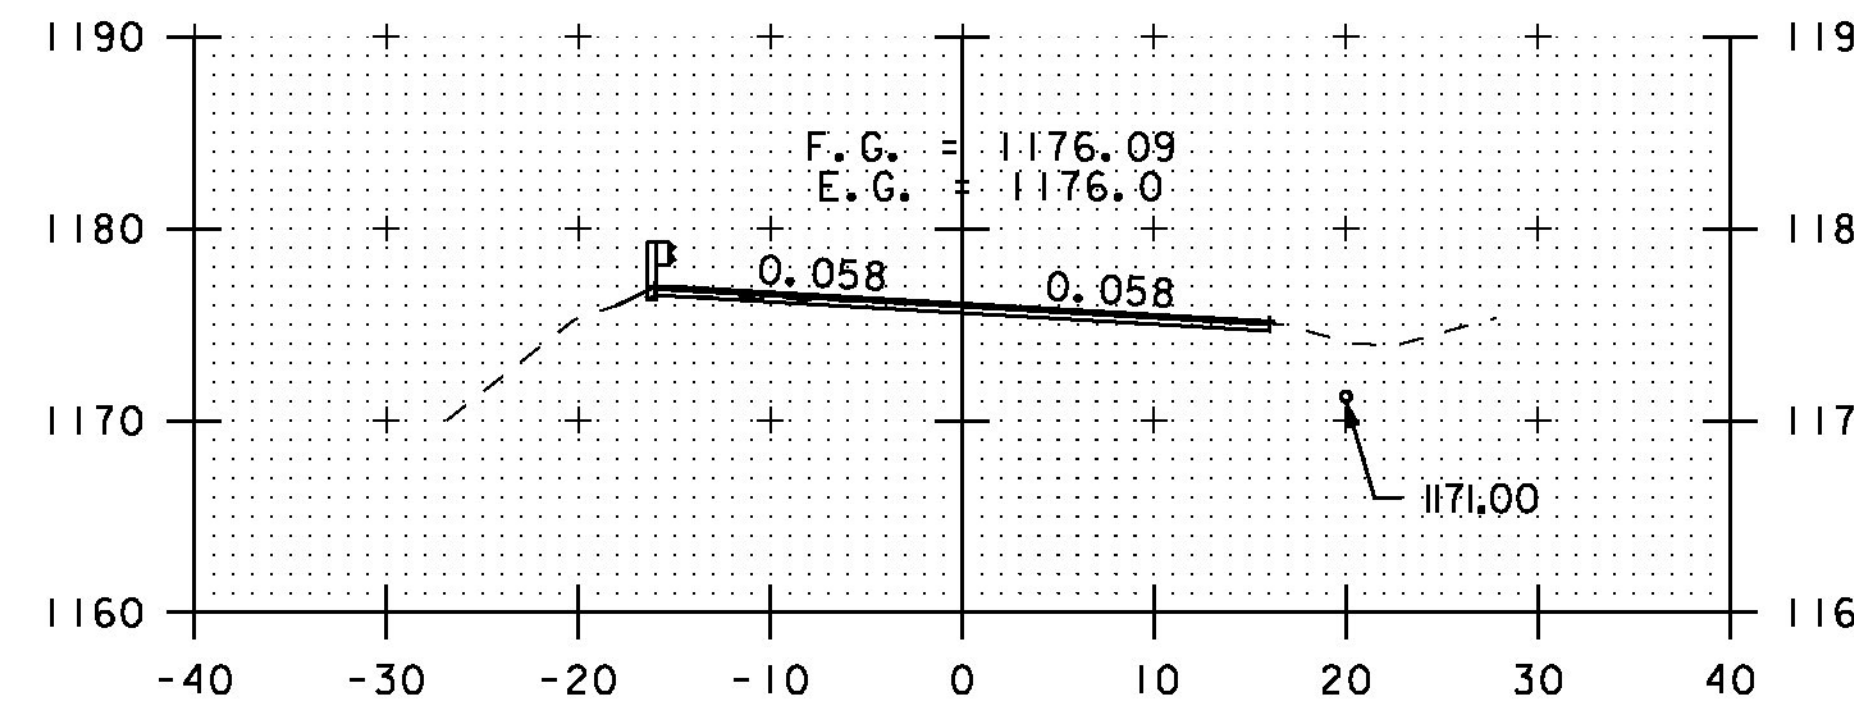


303+50

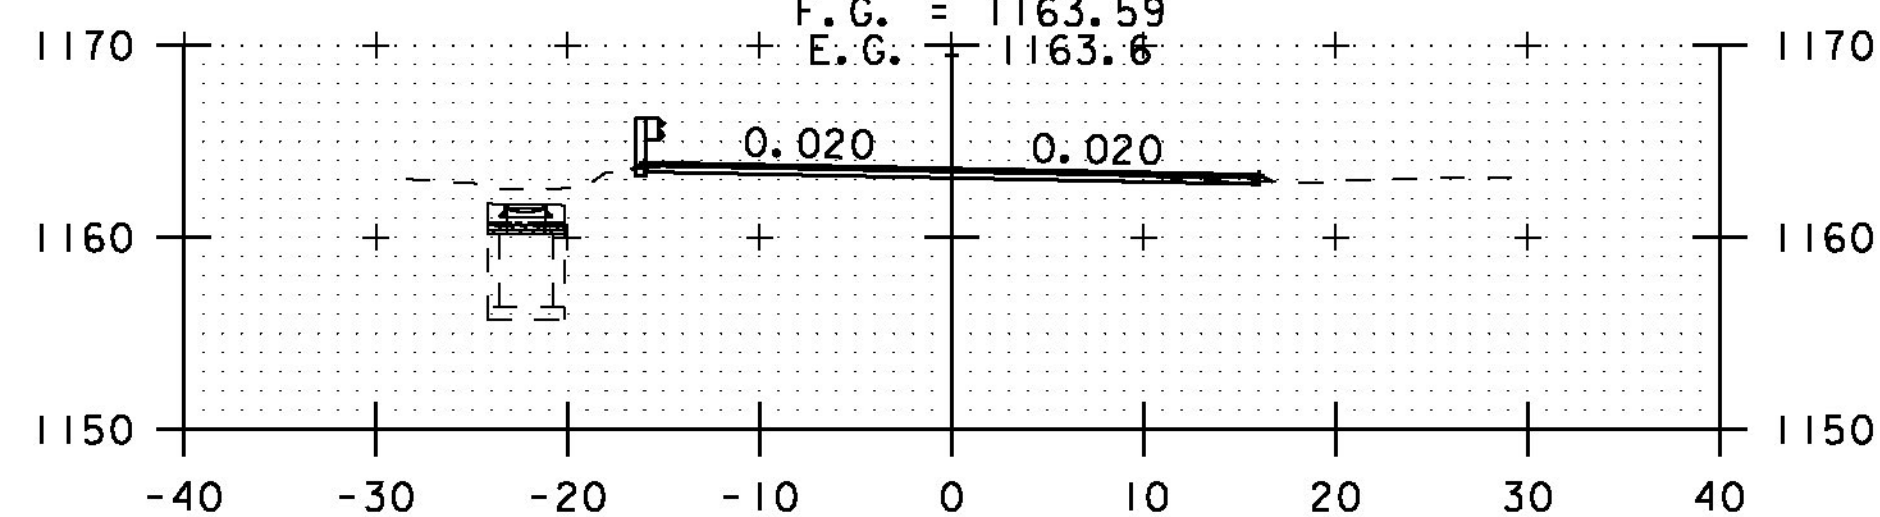

299+00

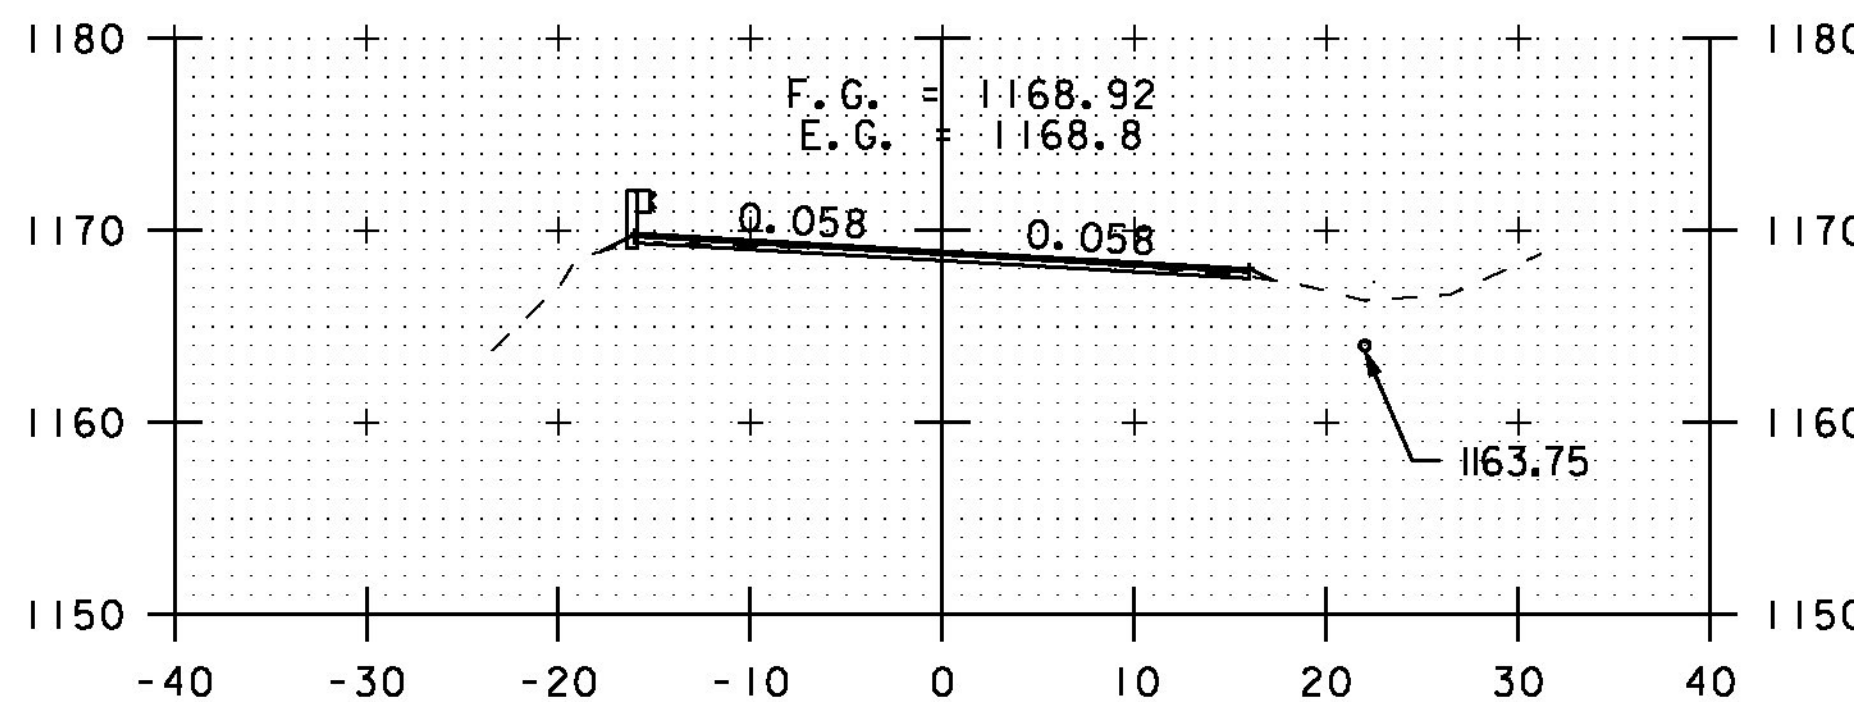

301+00

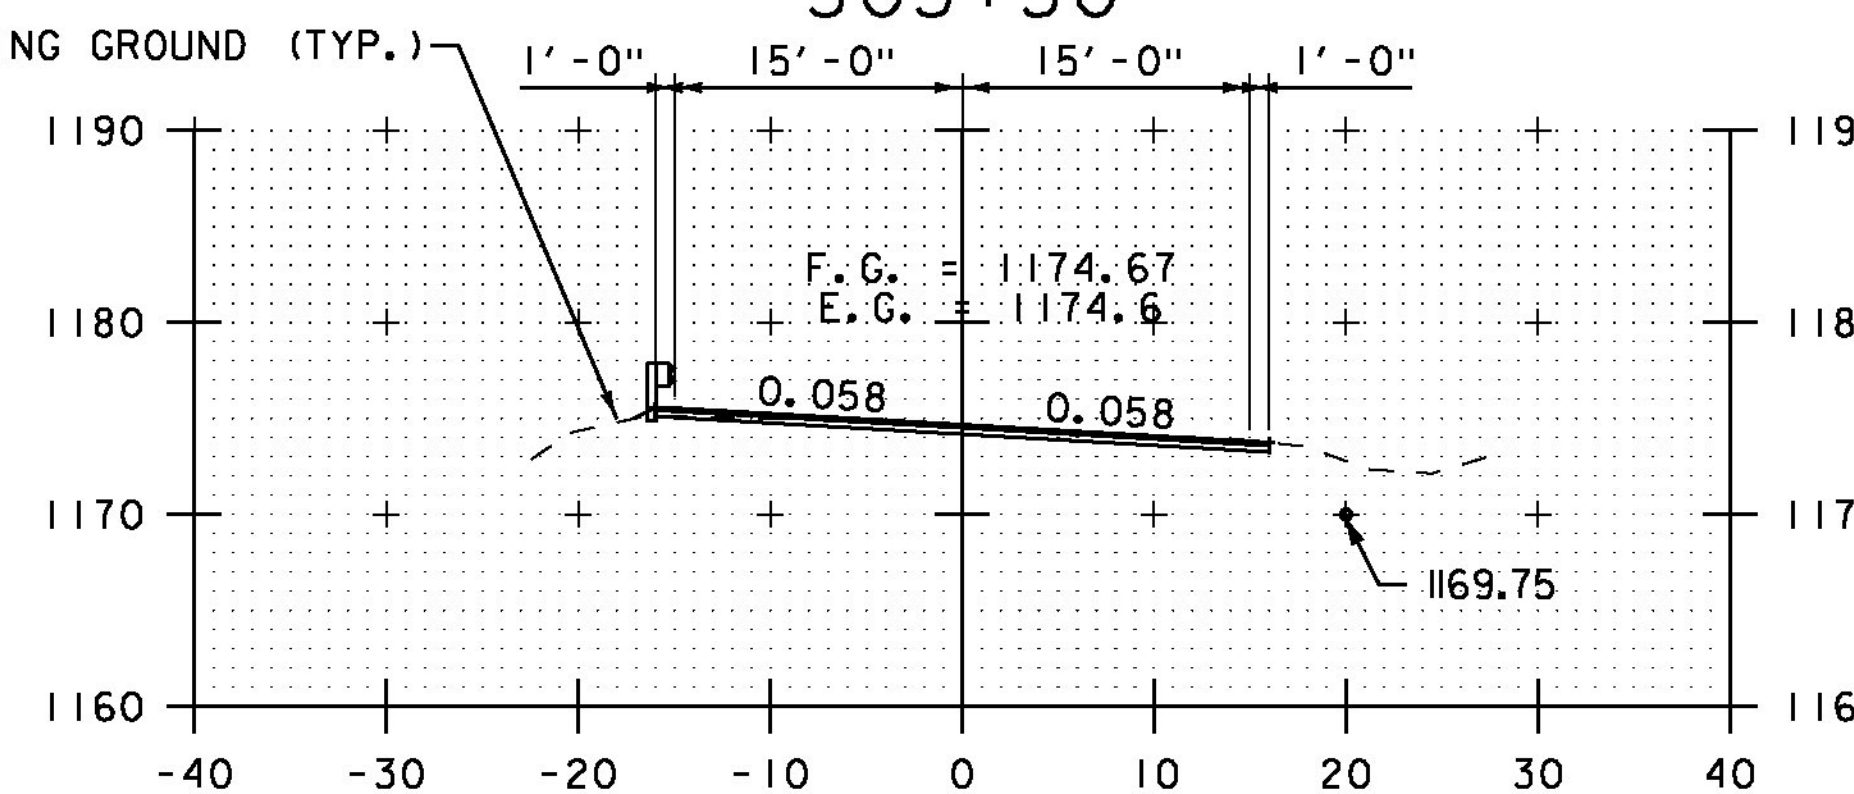

303+00

STA. 299+00 TO STA. 304+50



**CROSS SECTION SHEET 21**

PROJECT NAME: ELMORE-MORRISTOWN

PROJECT NUMBER: STP 2937 (I)

FILE NAME: z11c310.dgn

PROJECT LEADER: C. LATHROP

DESIGNED BY: S. LAMPHERE

PLOT FILE: z11c310\_149.i

PLOT DATE: 3/3/14

DRAWN BY: B. MARTIN

CHECKED BY: C. LATHROP

SHEET 149 OF 194