




309+50

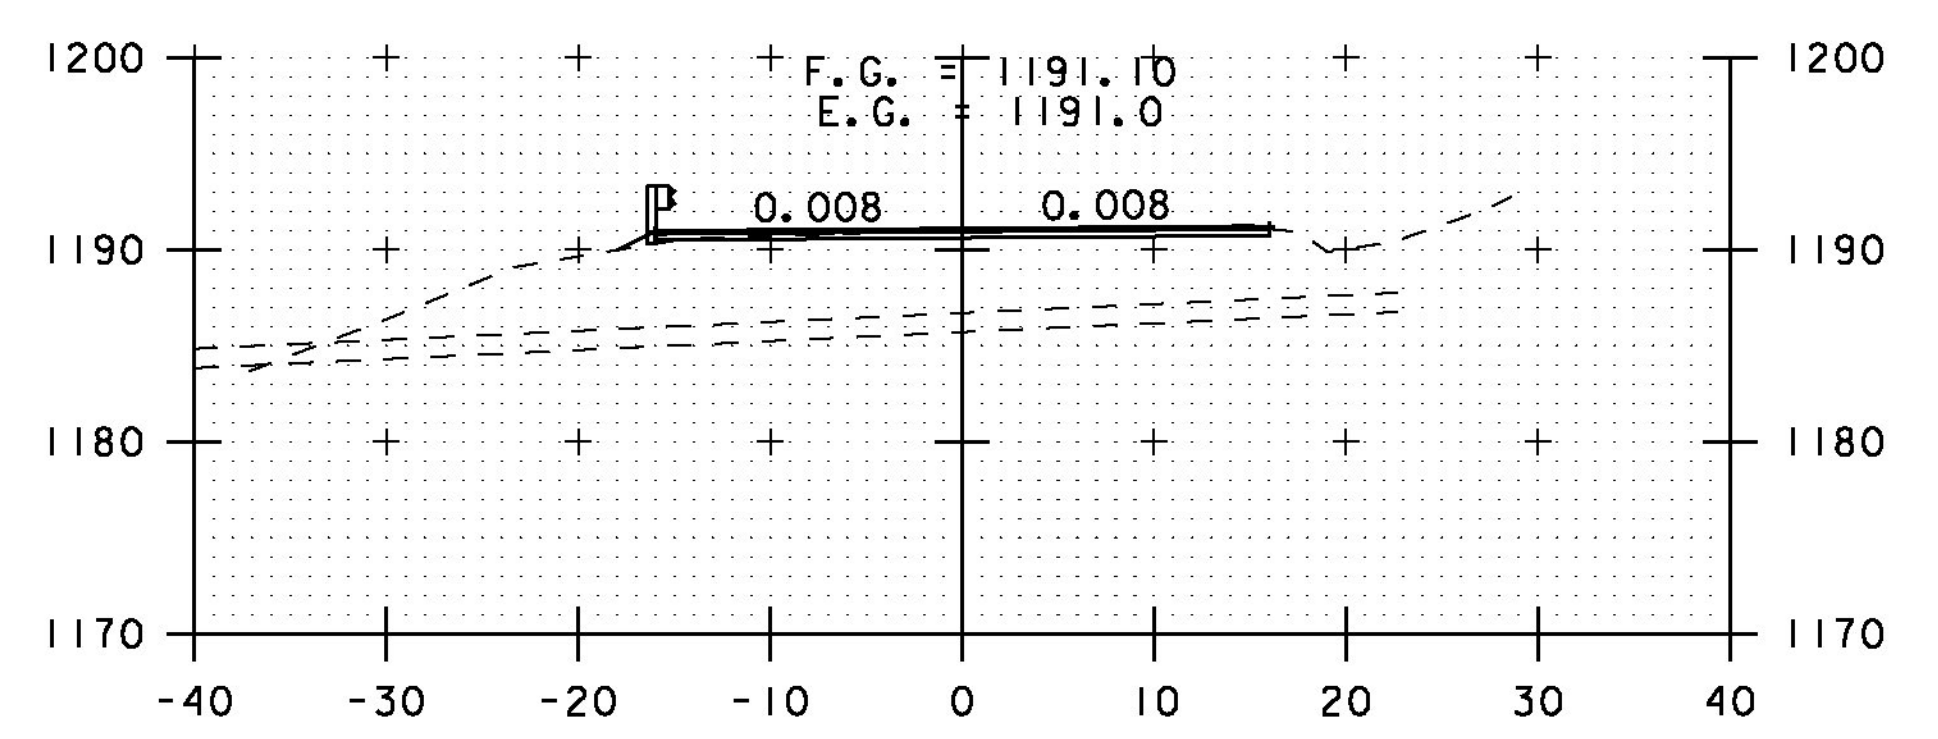


309+00

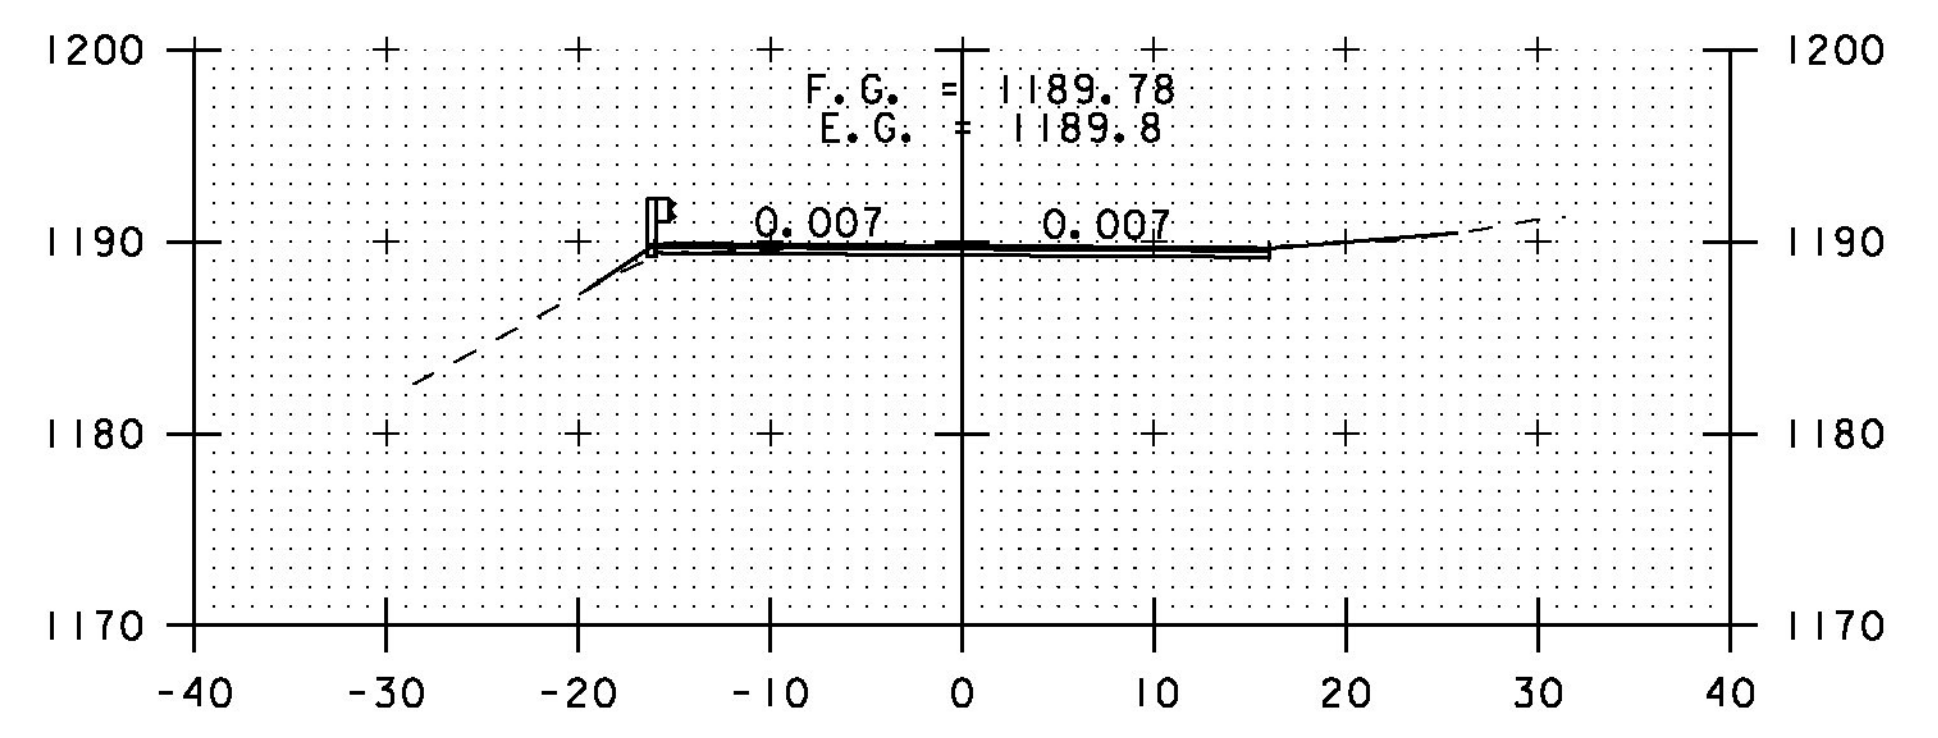


DRIVE RT
308+50

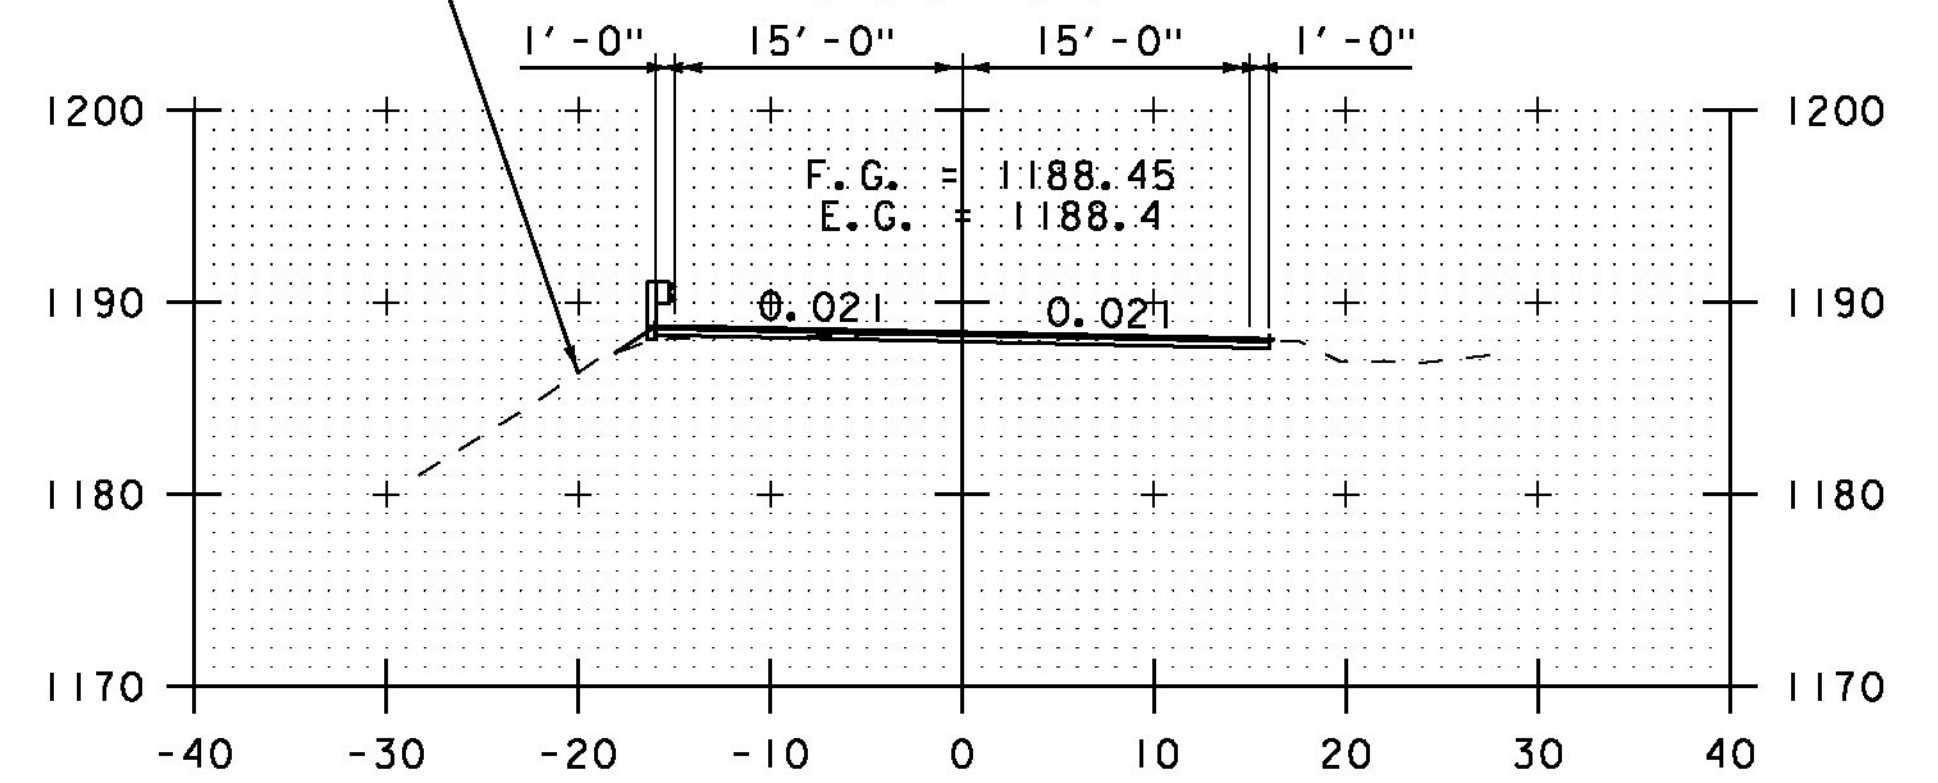


308+00

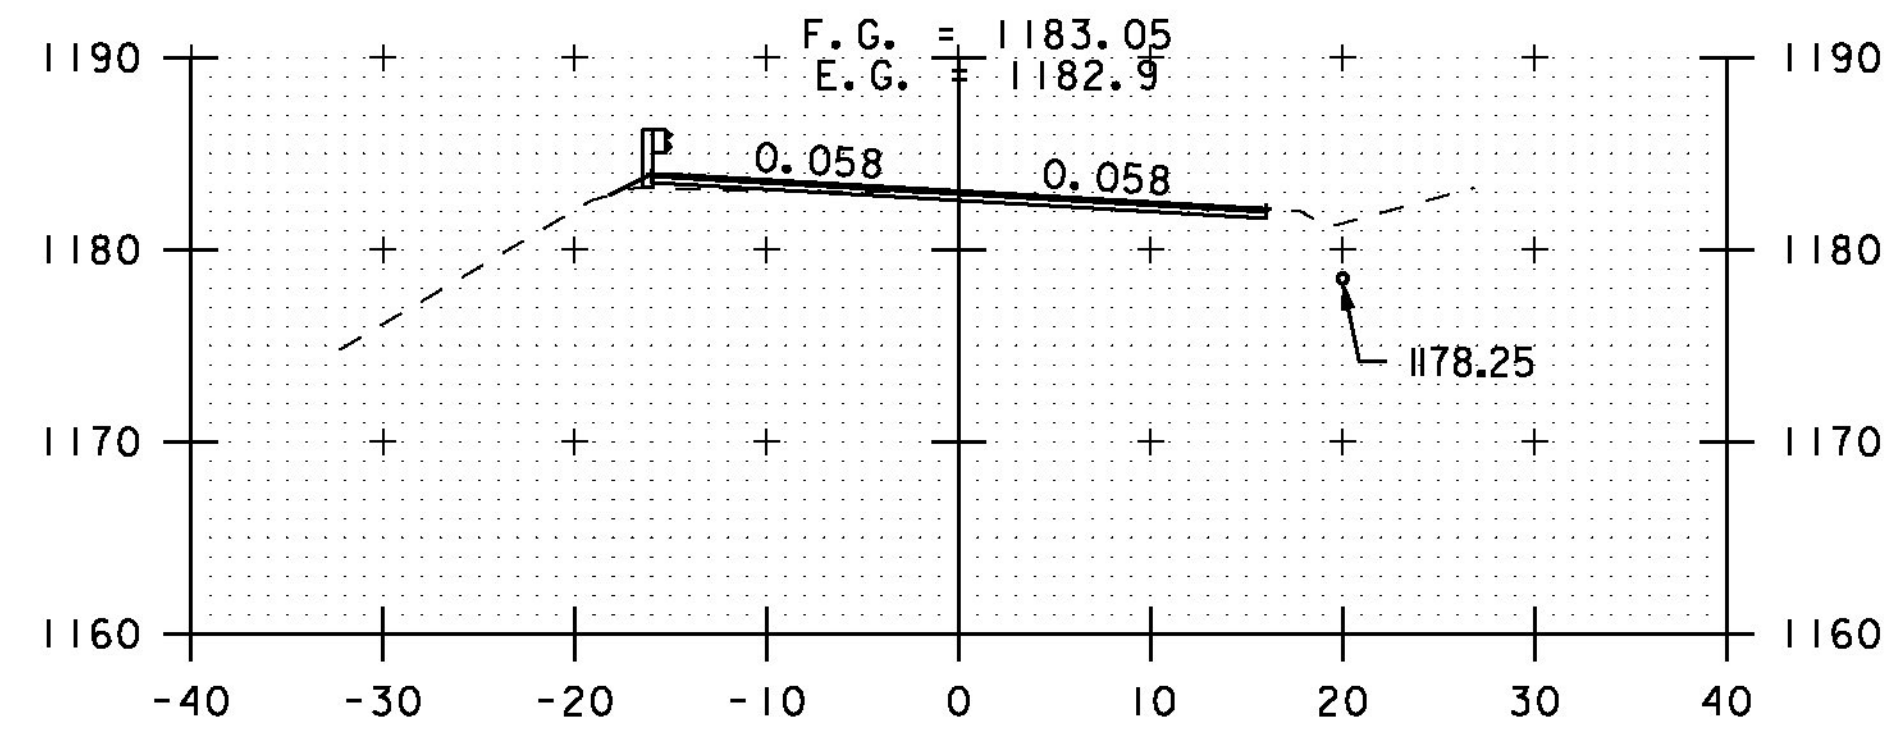


306+00

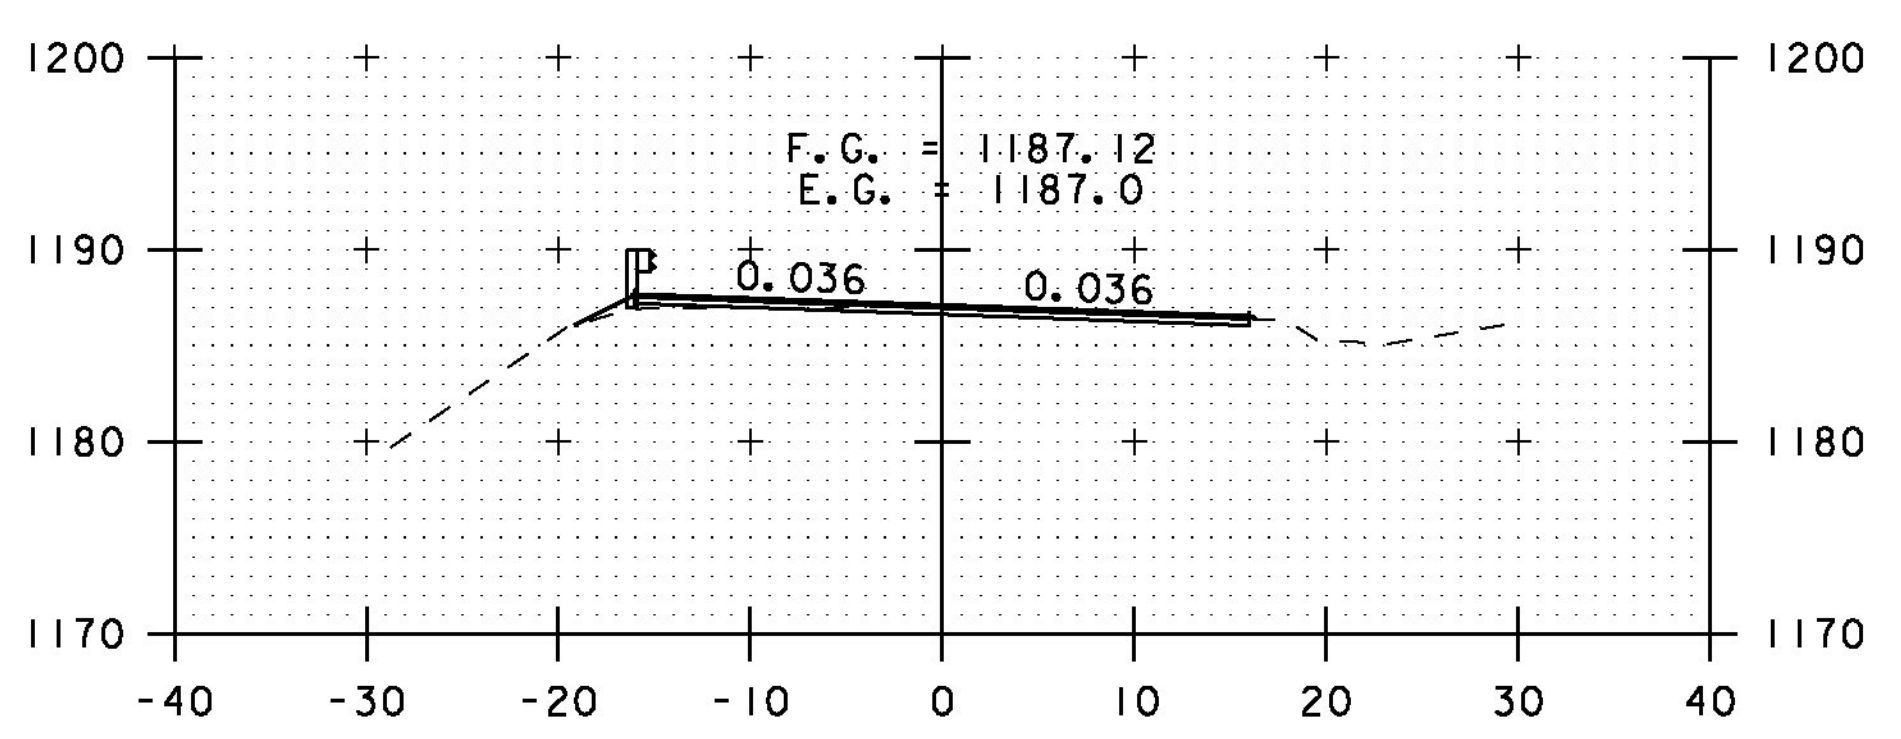


307+50

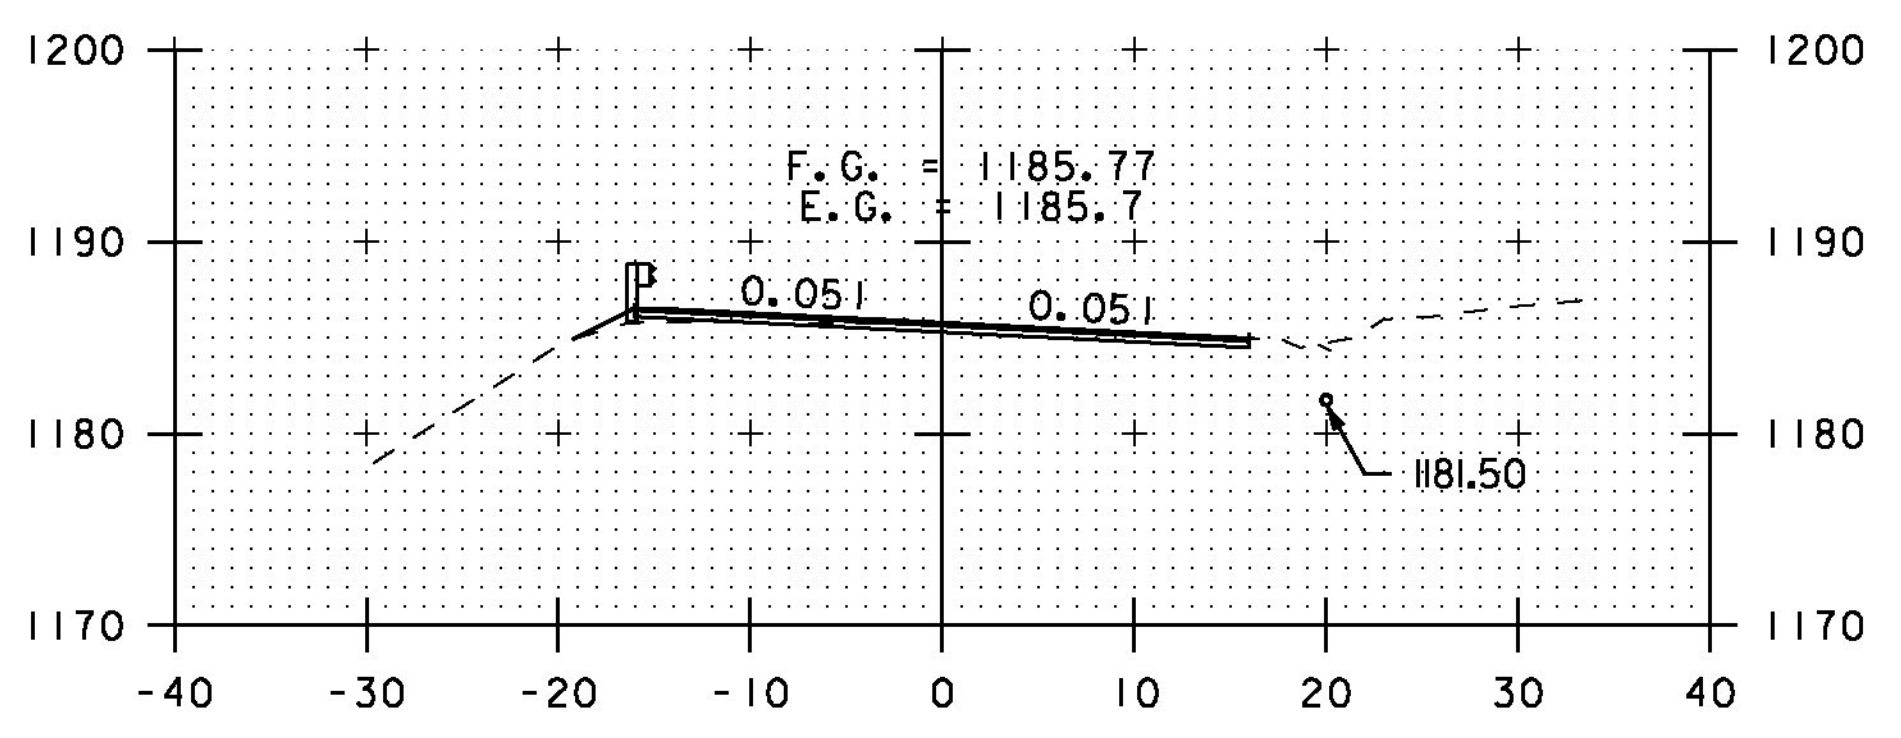


307+00

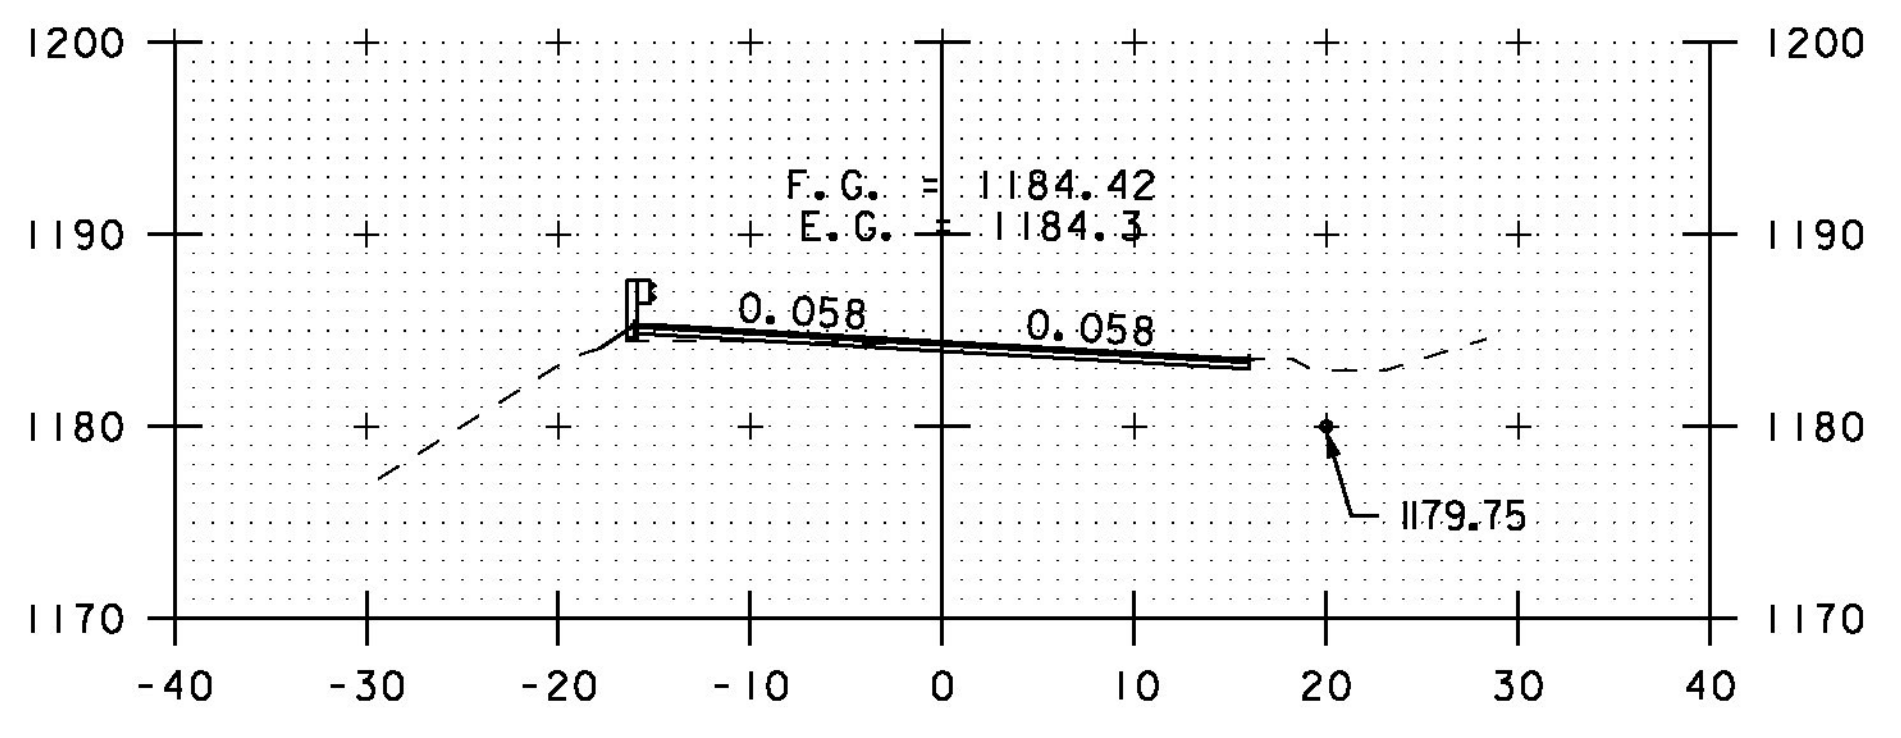

306+50

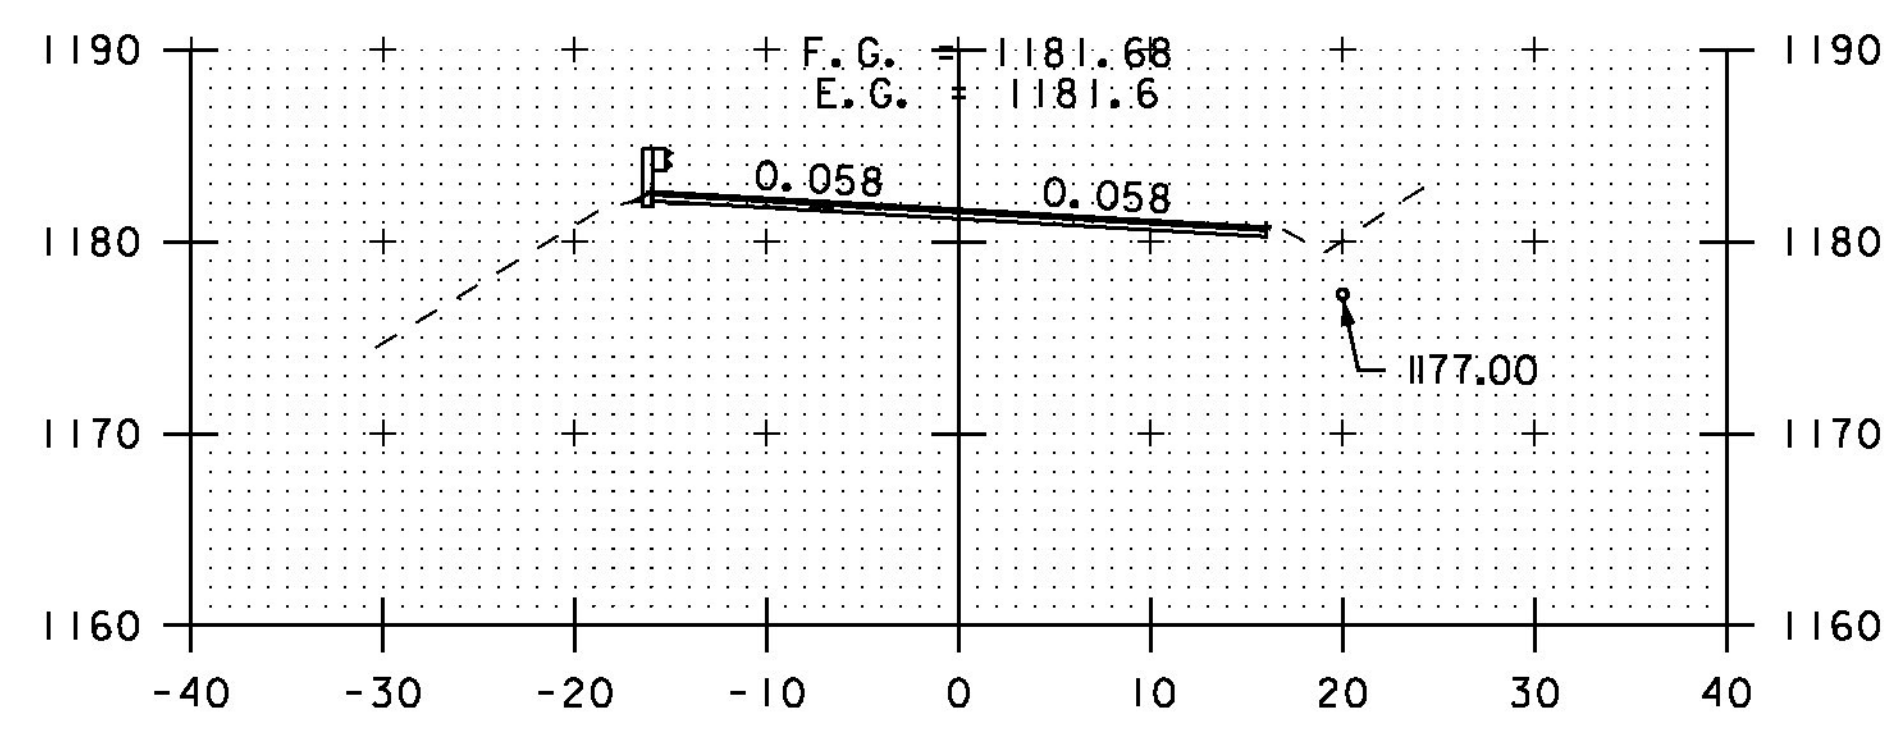

305+50

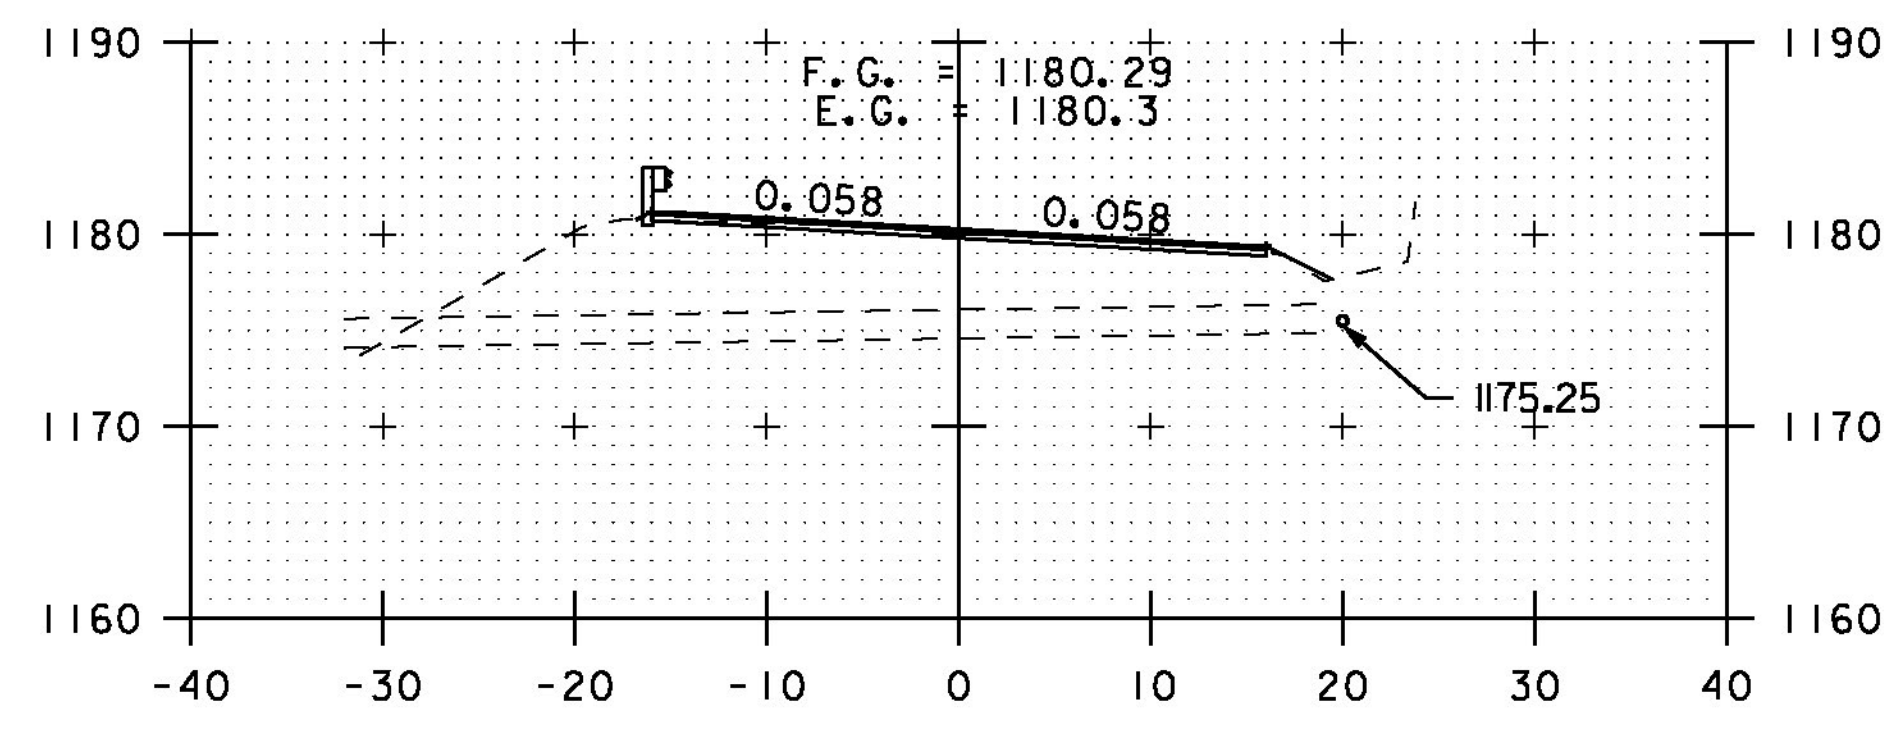

305+00

SCALE 1" = 10'-0"

STA. 305+00 TO STA. 309+50

CROSS SECTION SHEET 22

PROJECT NAME: ELMORE-MORRISTOWN	PLOT DATE: 3/3/14
PROJECT NUMBER: STP 2937 (1)	DRAWN BY: B. MARTIN
FILE NAME: z11c310.dgn	CHECKED BY: C. LATHROP
PROJECT LEADER: C. LATHROP	SHEET 150 OF 194
DESIGNED BY: S. LAMPHERE	
PLOT FILE: z11c310_150.i	