




311+50

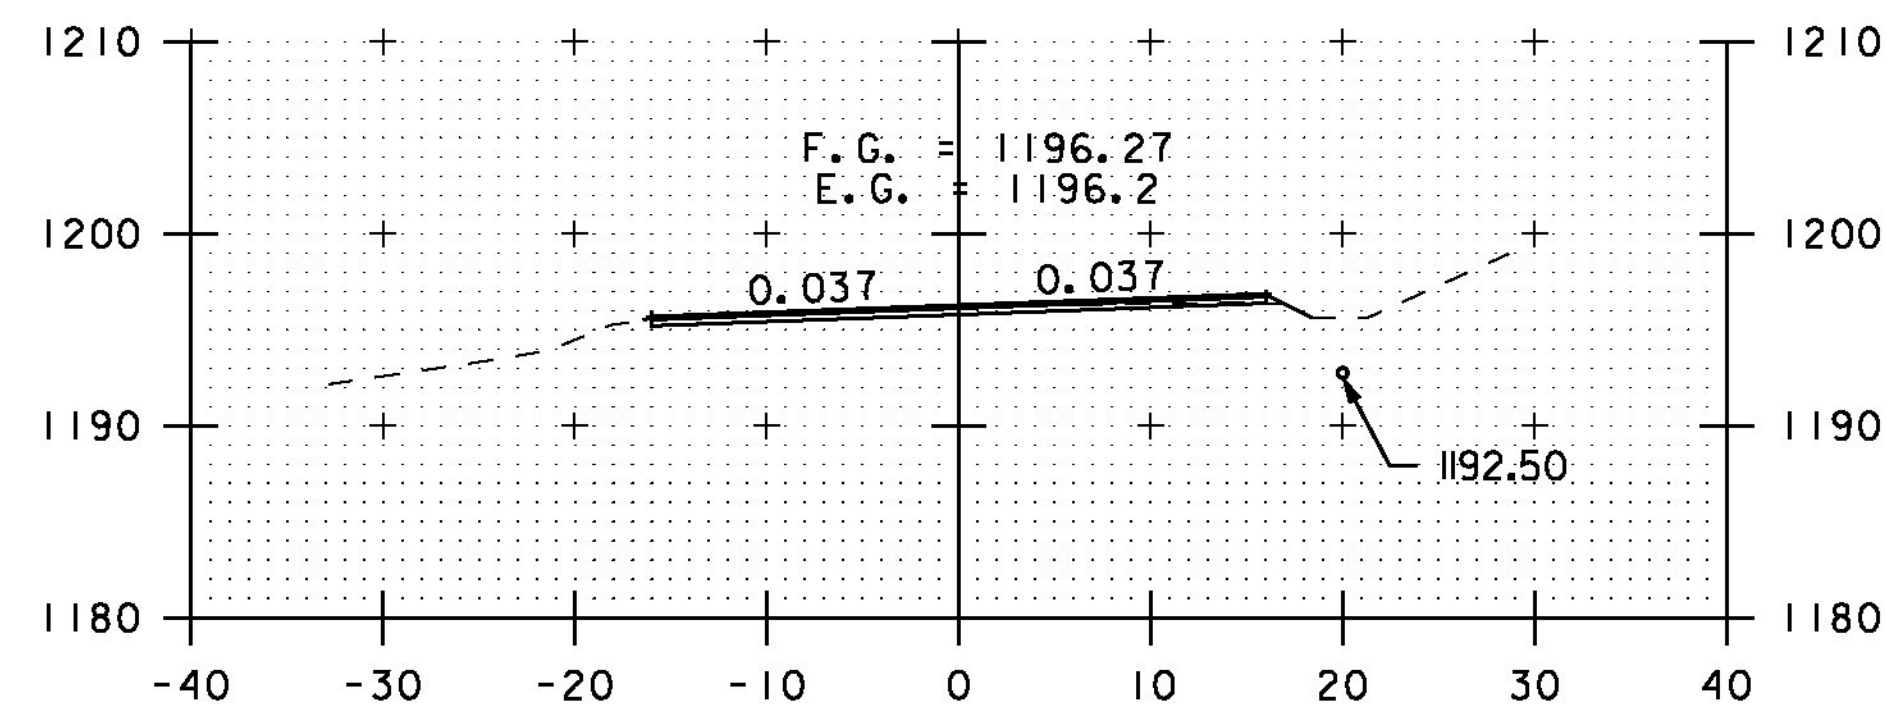


311+00

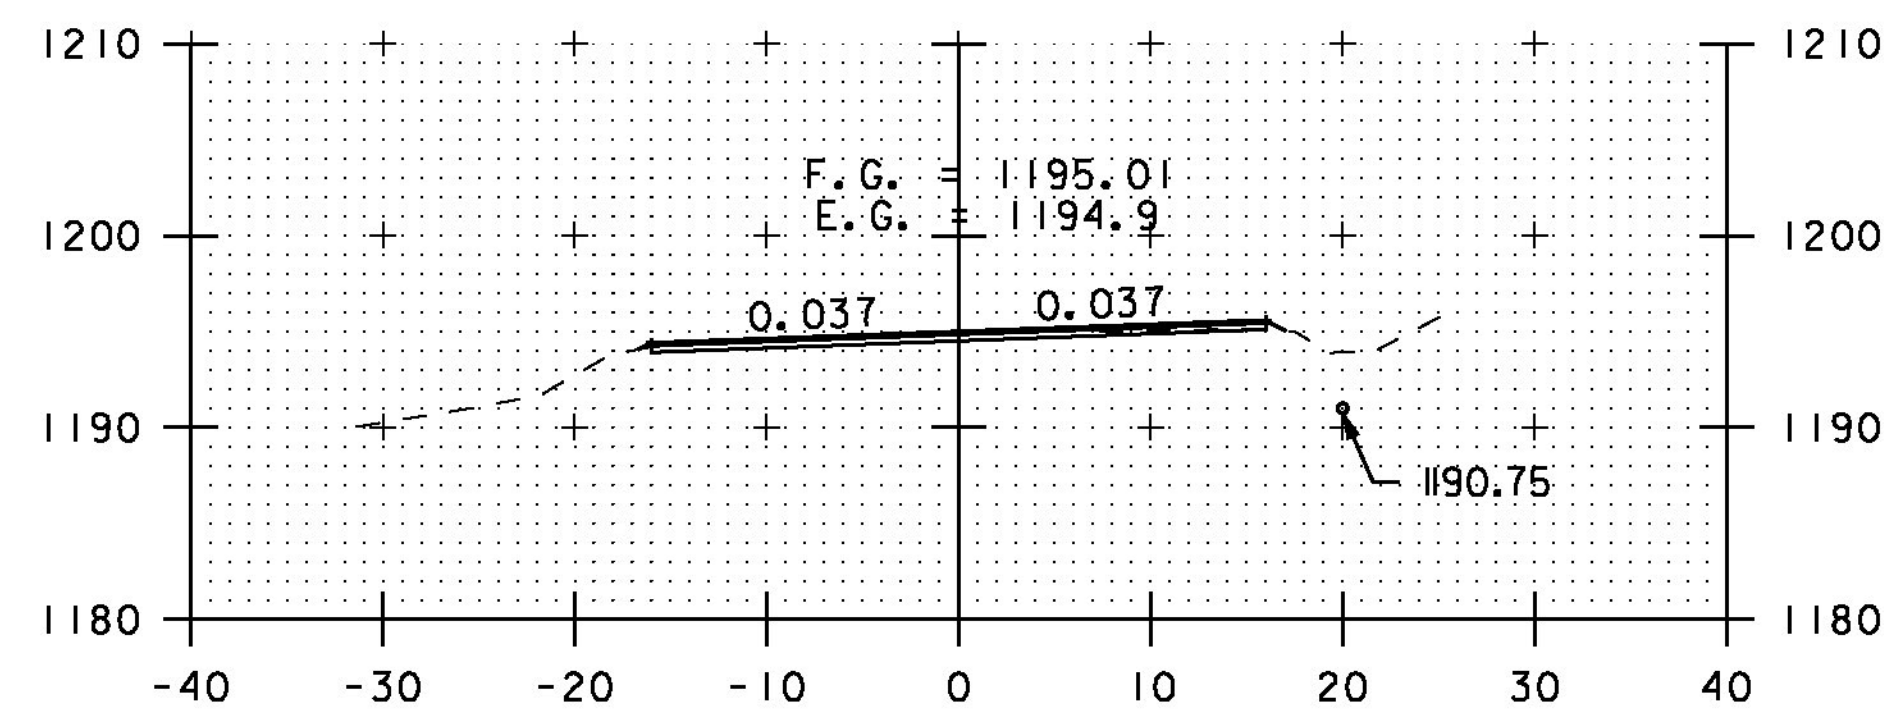


310+50

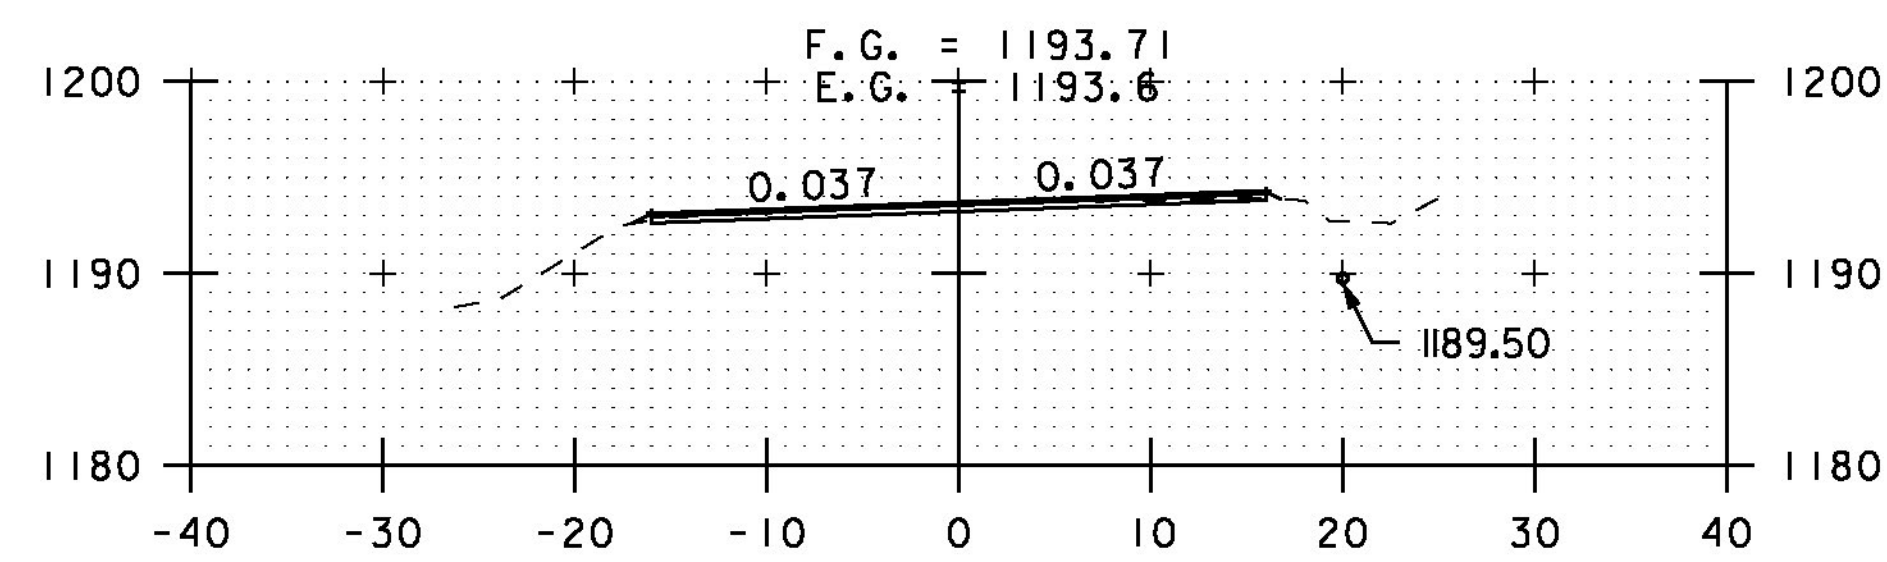


310+00

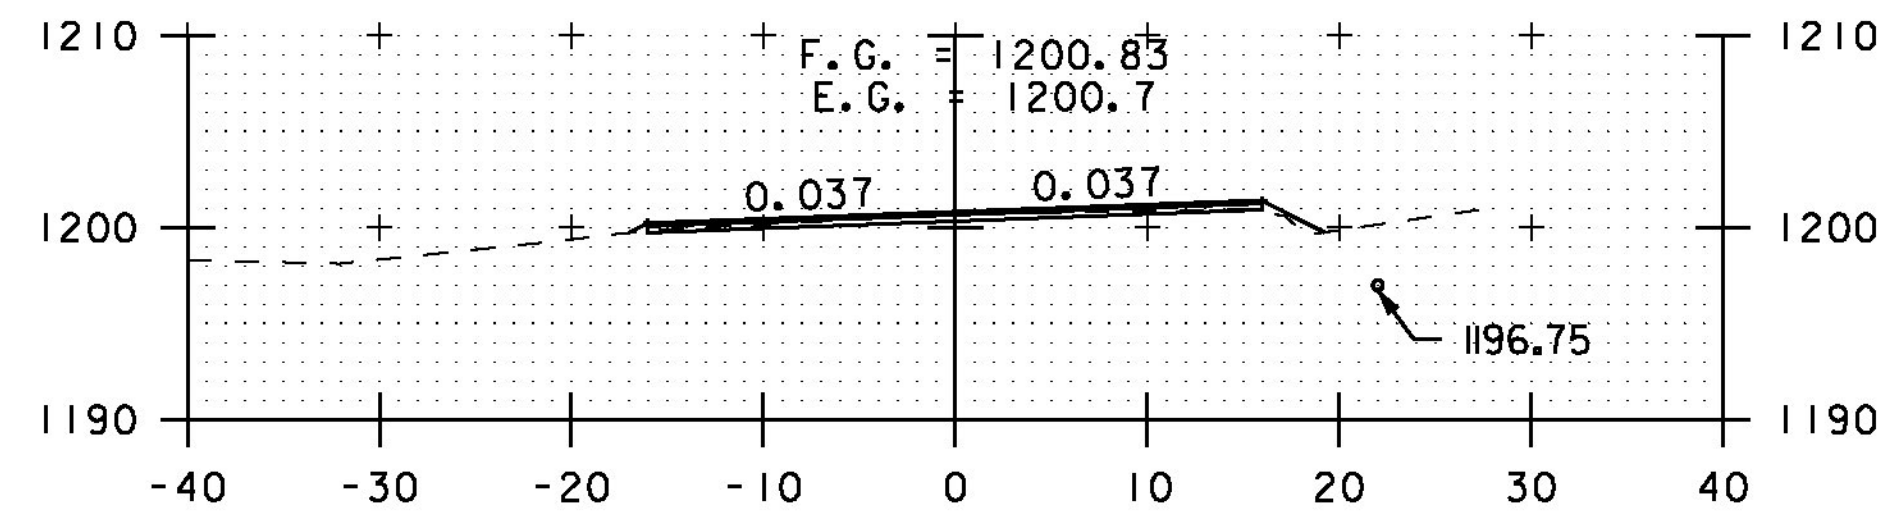


313+50

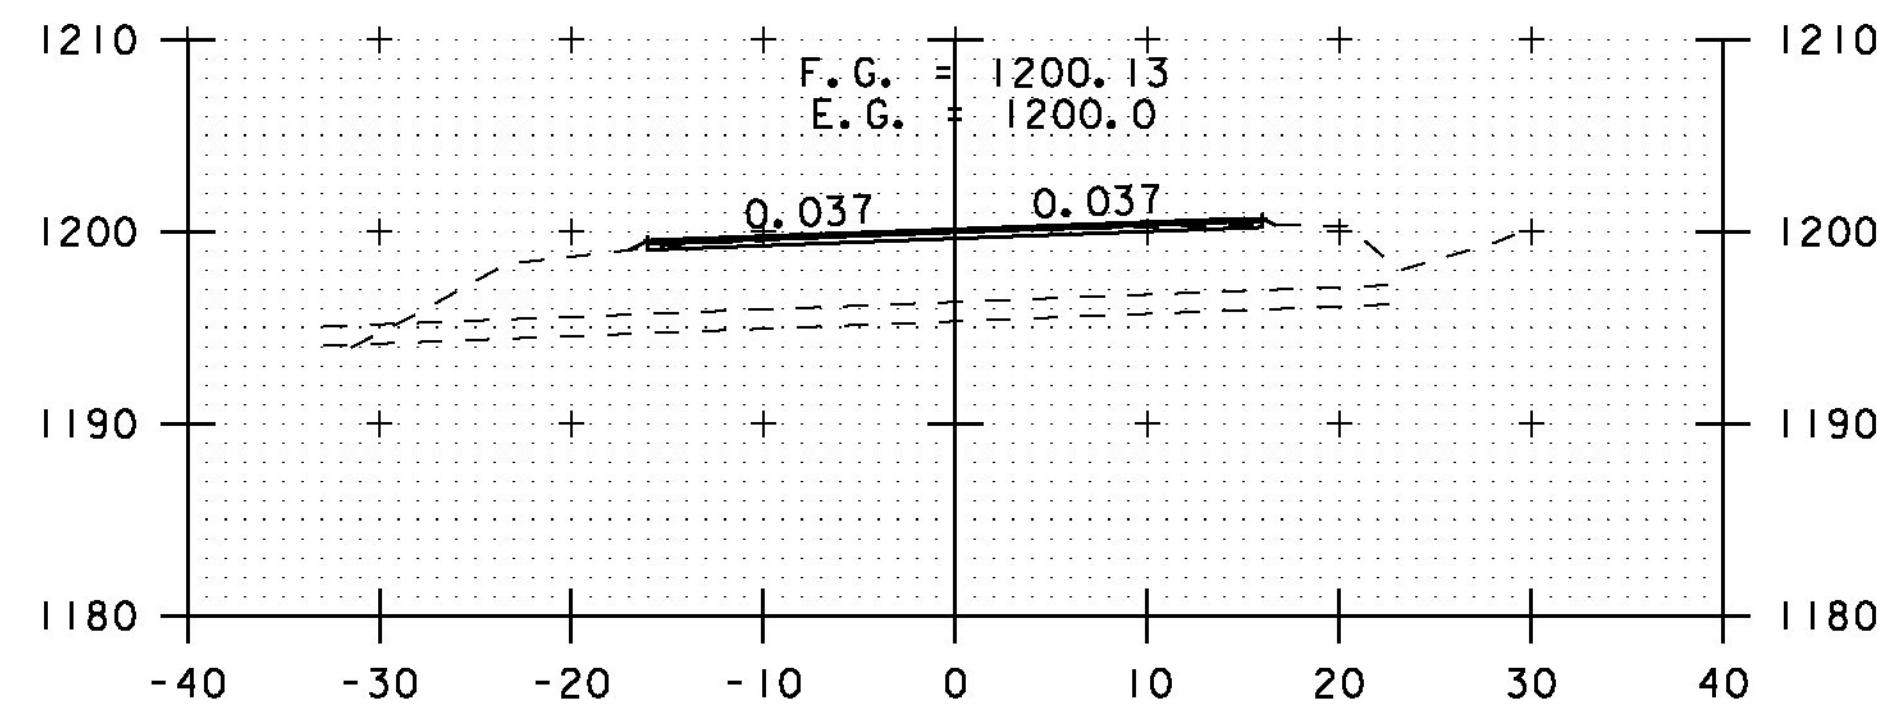


313+00

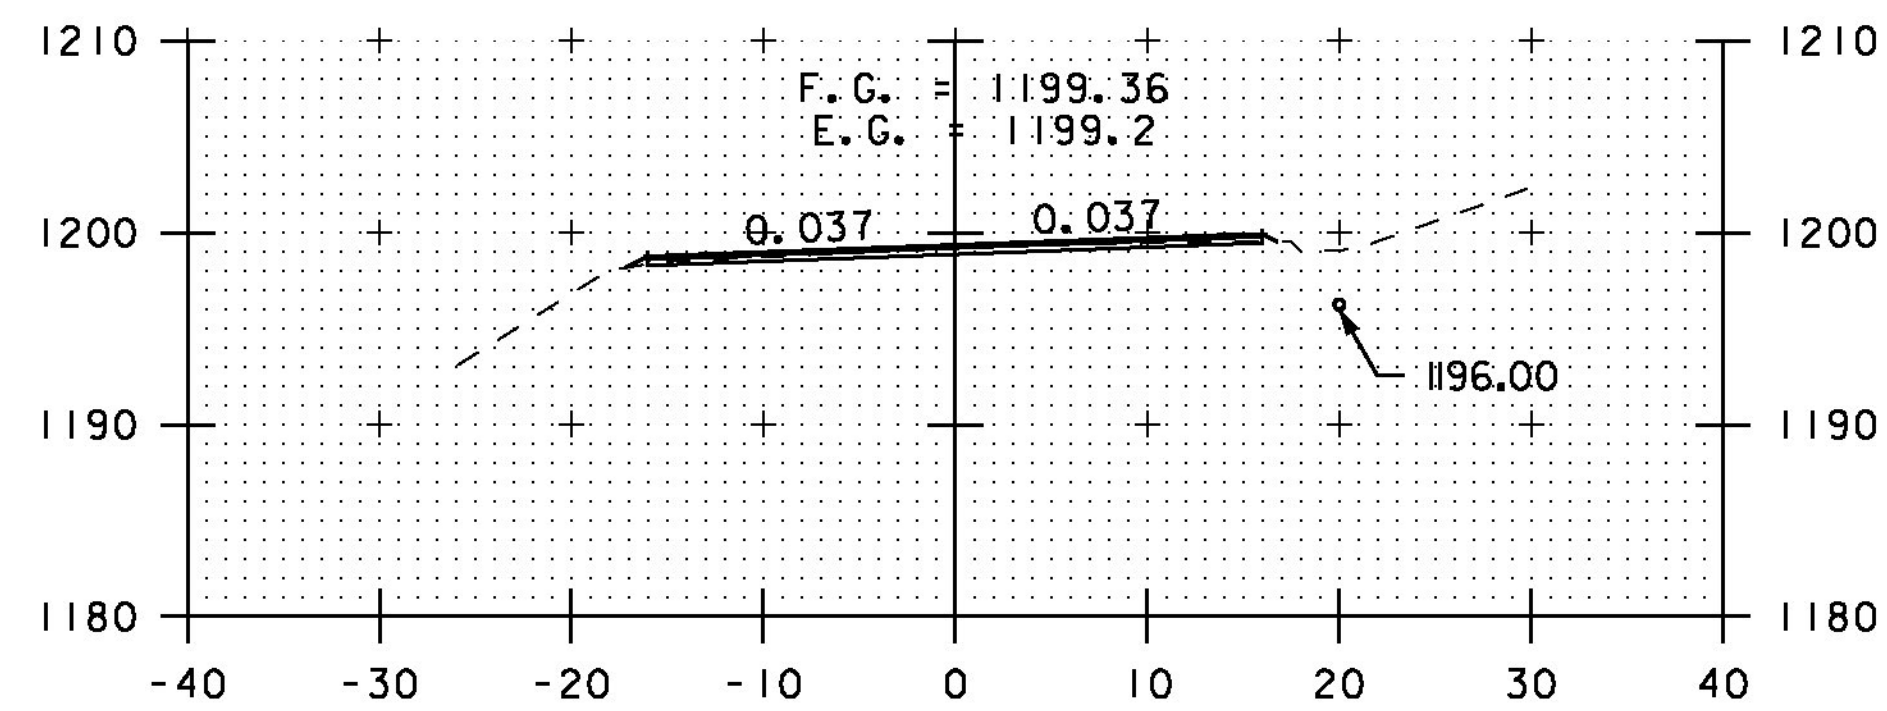


312+50

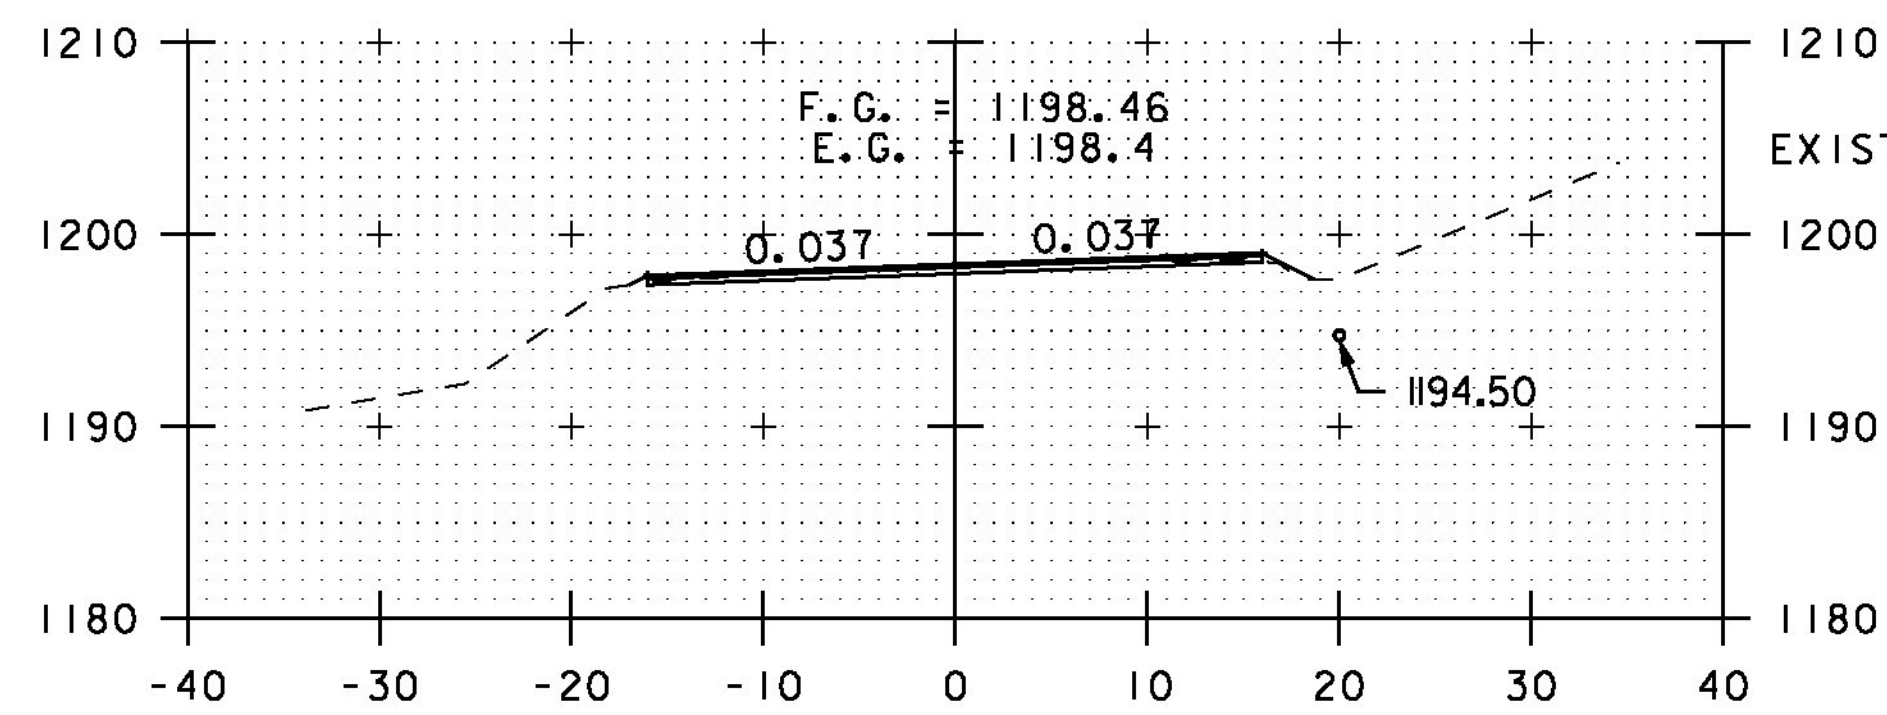


312+00

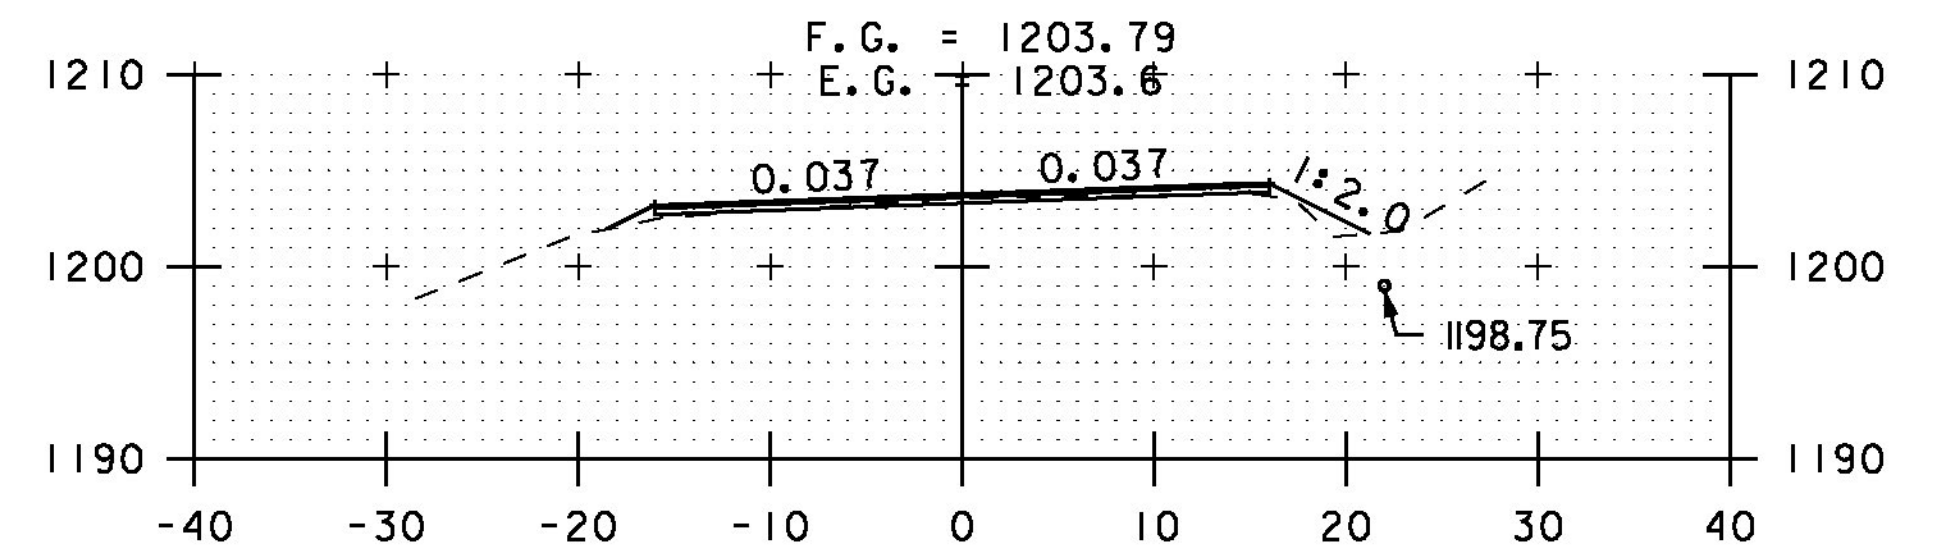


315+50

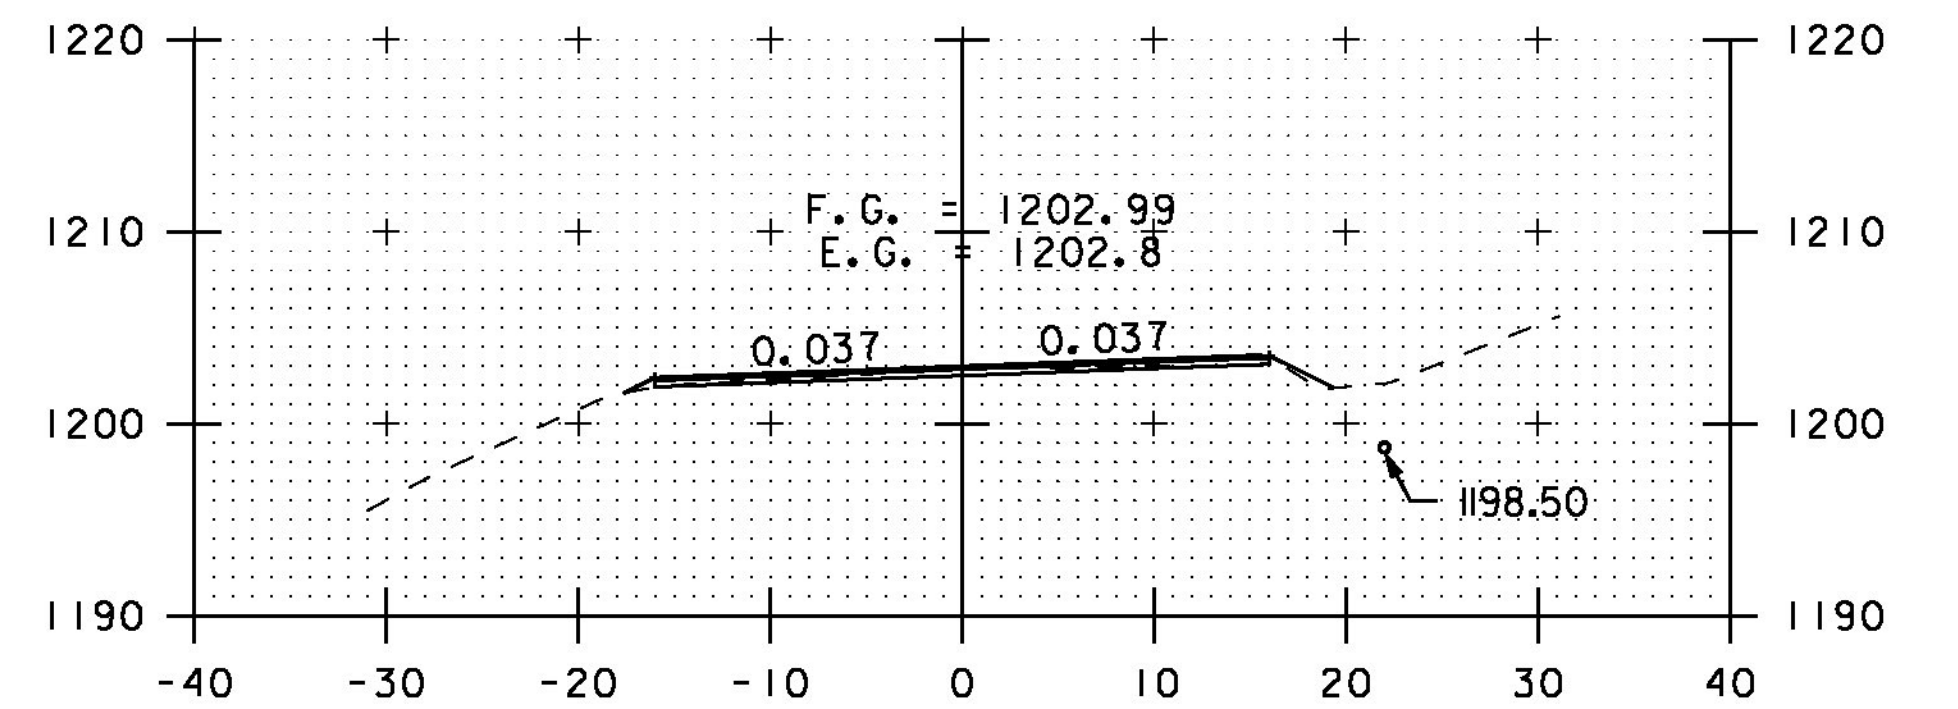

315+00

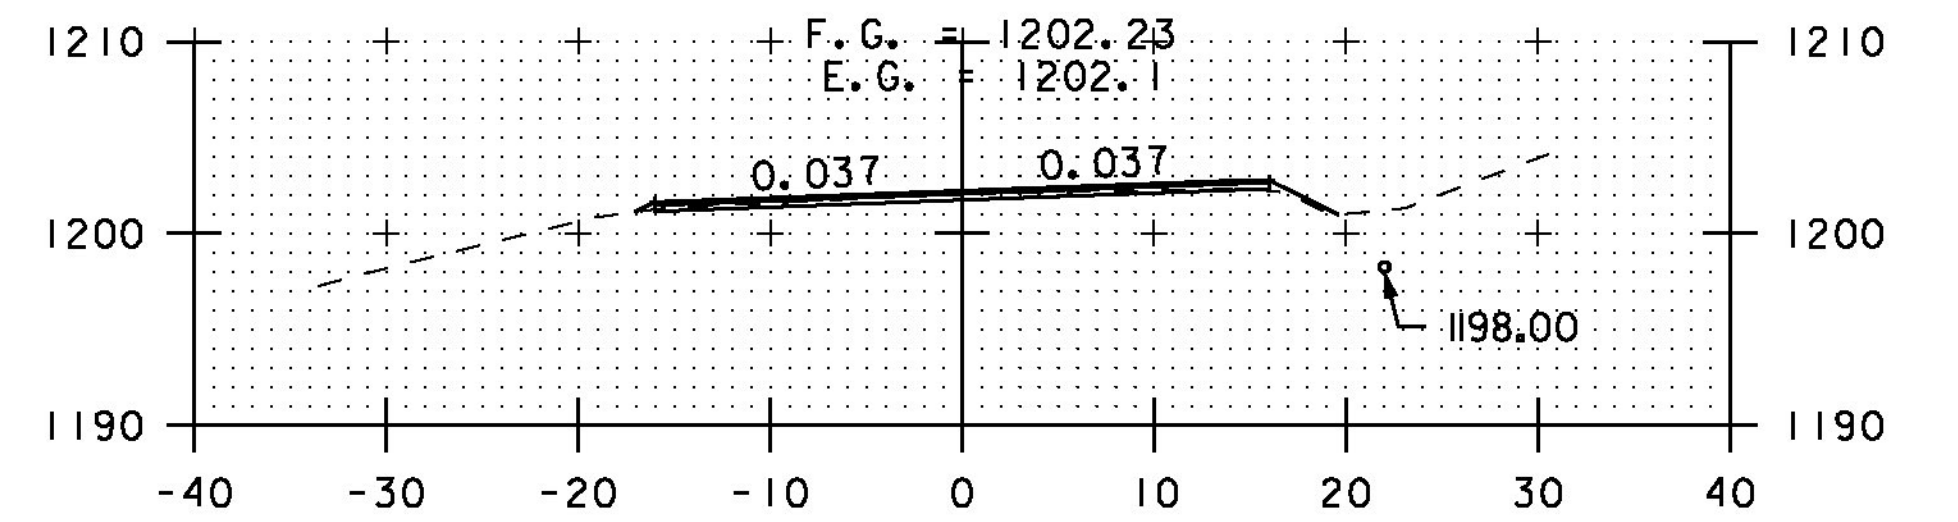

314+50

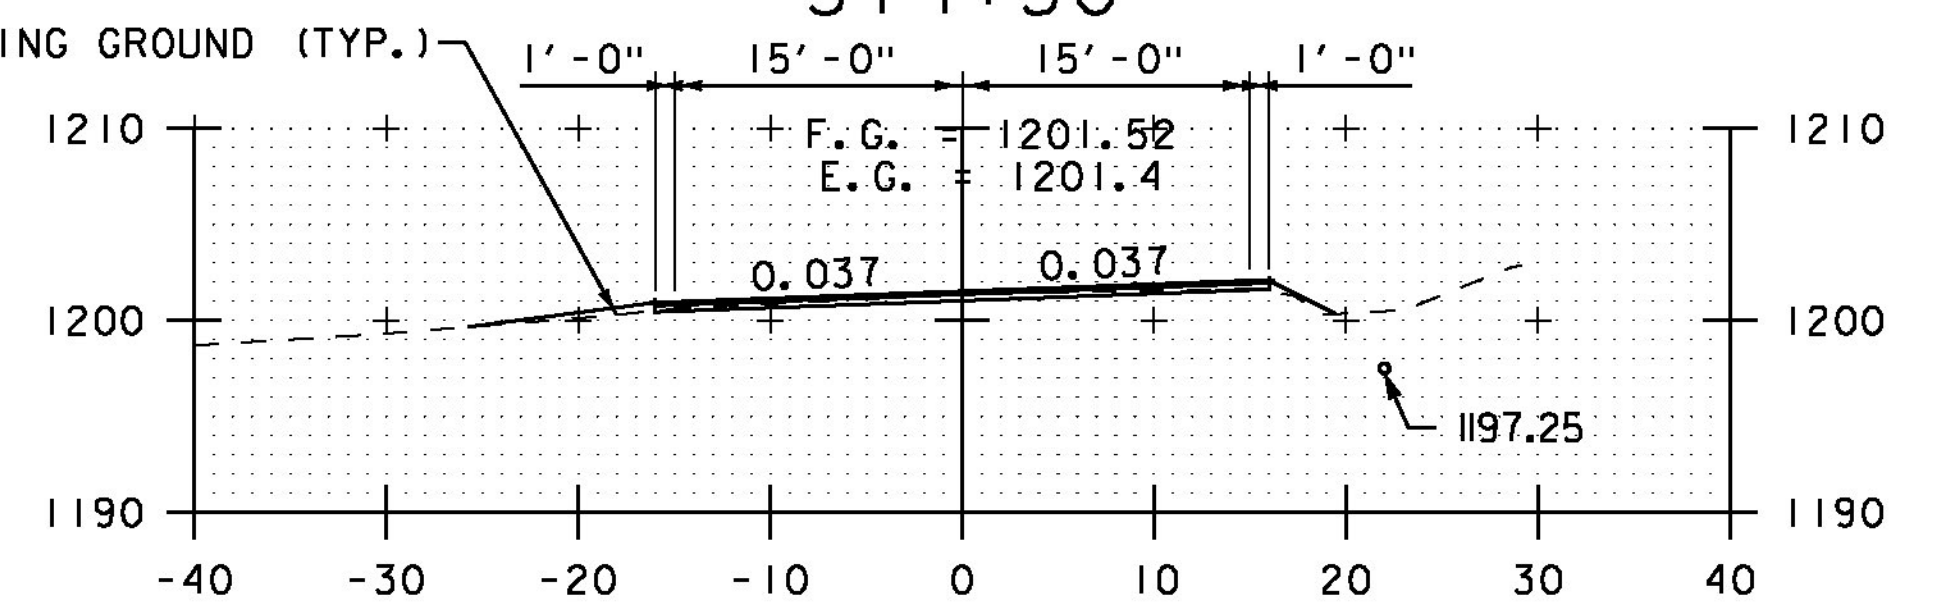

314+00 DRIVE LT

STA. 310+00 TO STA. 315+50

SCALE 1" = 10'-0"

CROSS SECTION SHEET 23

PROJECT NAME: ELMORE-MORRISTOWN

PROJECT NUMBER: STP 2937 (I)

FILE NAME: z11c310.dgn

PROJECT LEADER: C. LATHROP

DESIGNED BY: S. LAMPHERE

PLOT FILE: z11c310_151.i

PLOT DATE: 3/3/14

DRAWN BY: B. MARTIN

CHECKED BY: C. LATHROP

SHEET 151 OF 194