




317+50

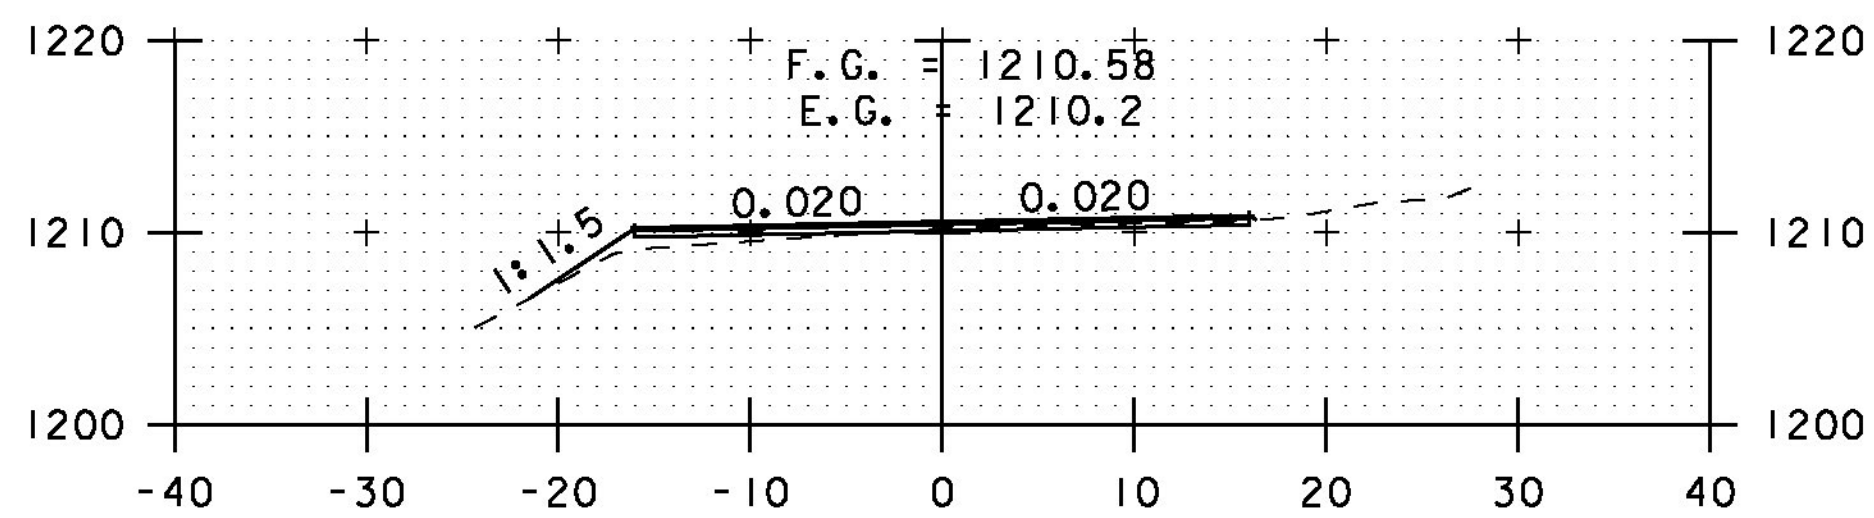


319+50

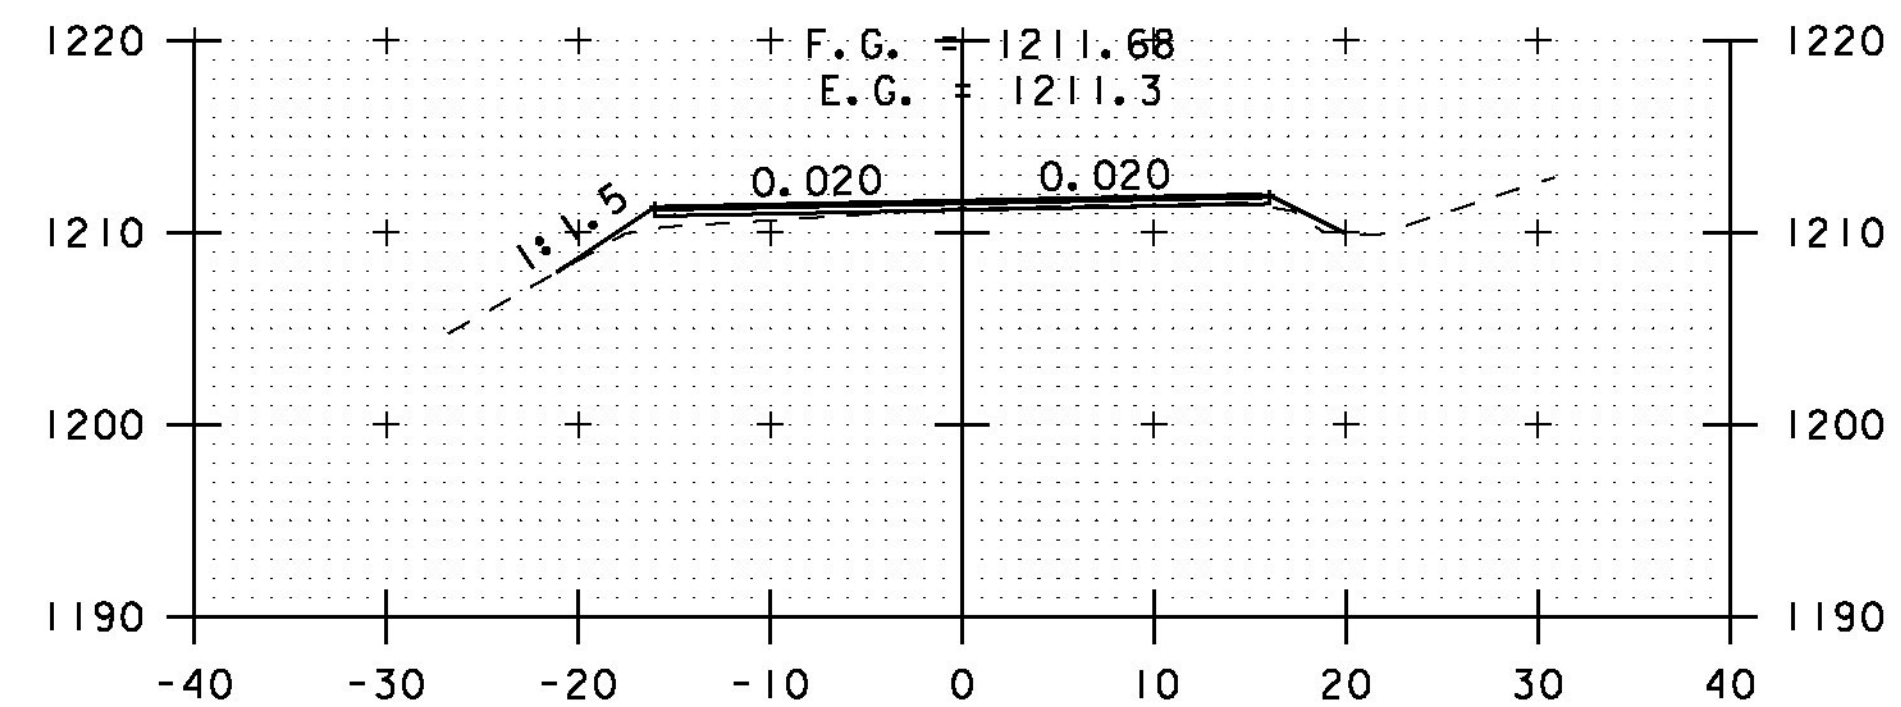


321+50

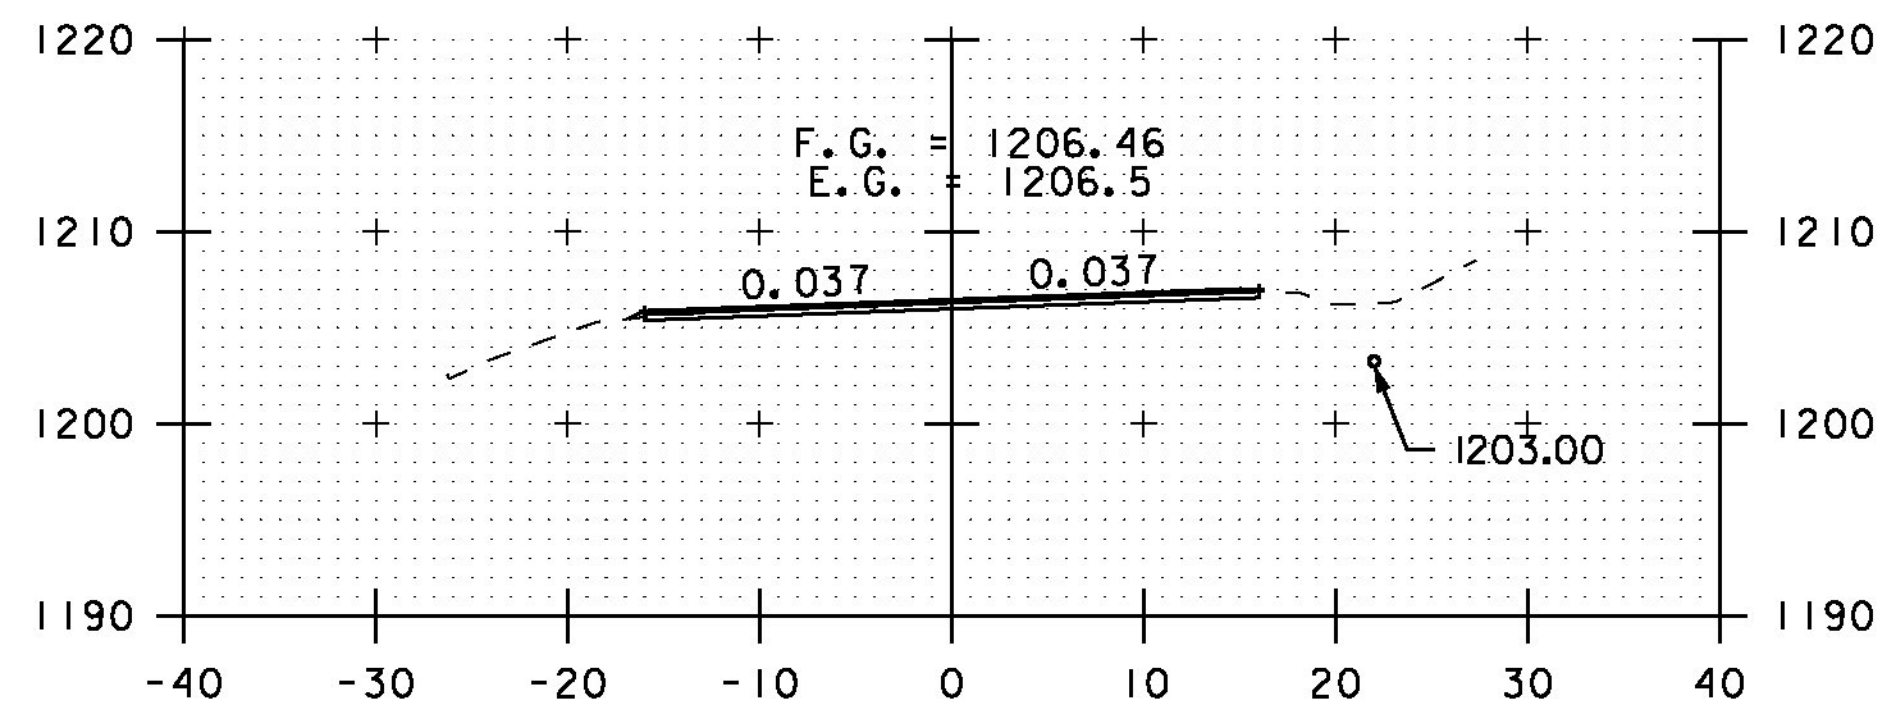


317+00

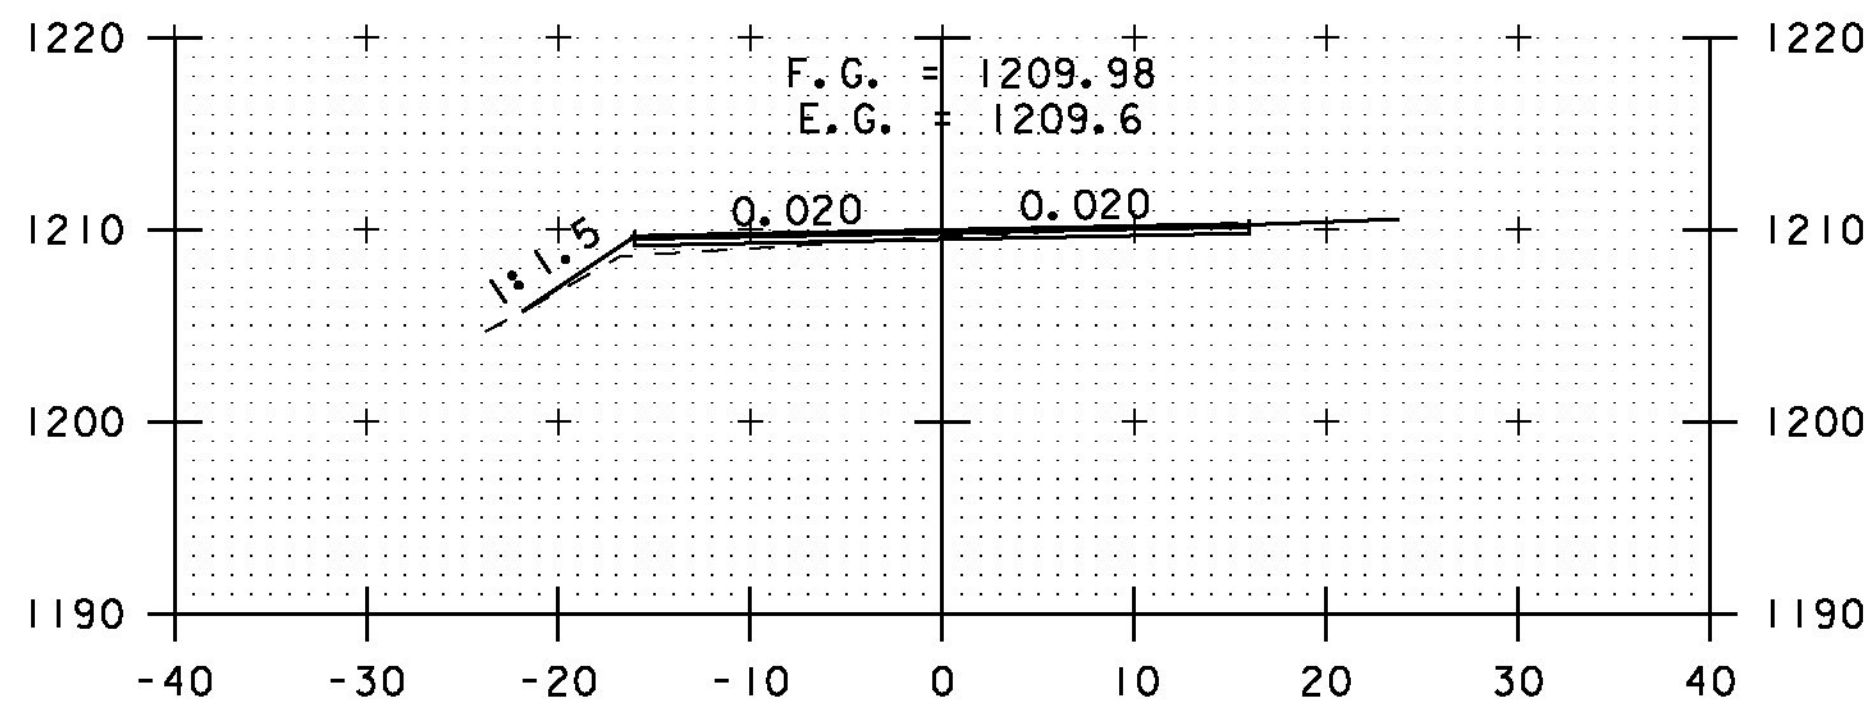


DRIVE RT
319+00

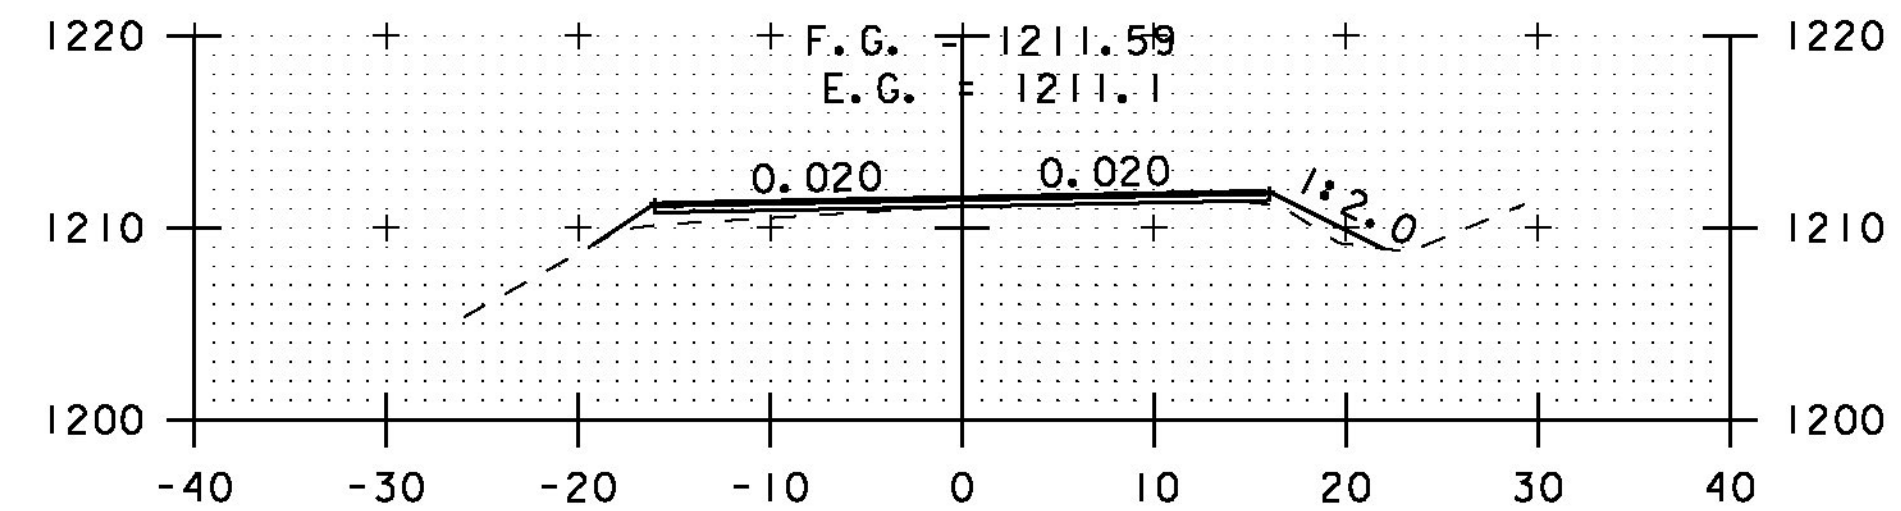


321+00

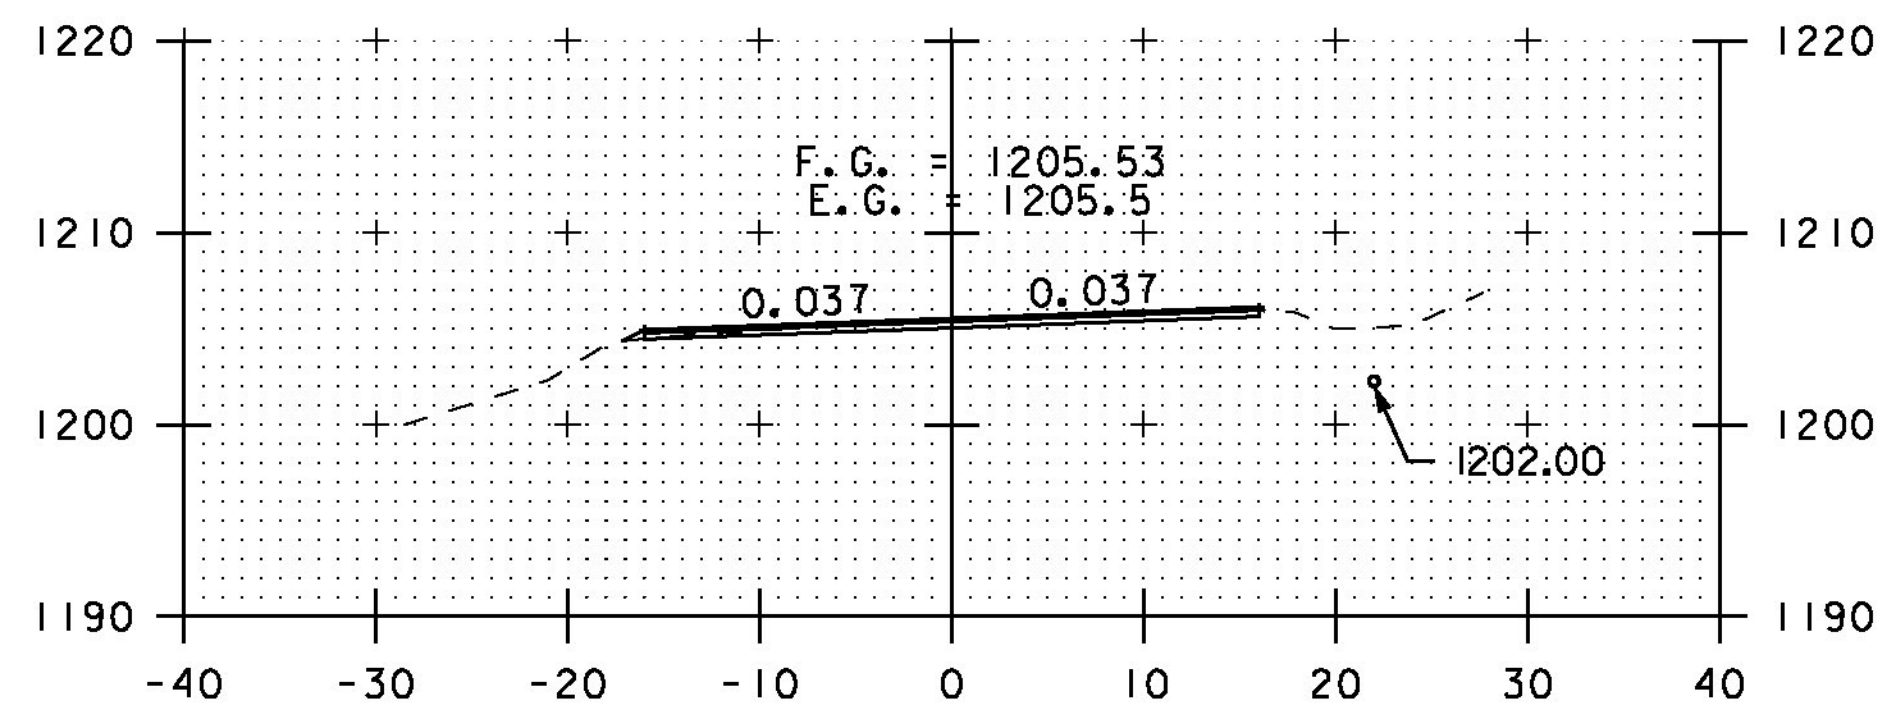


316+50

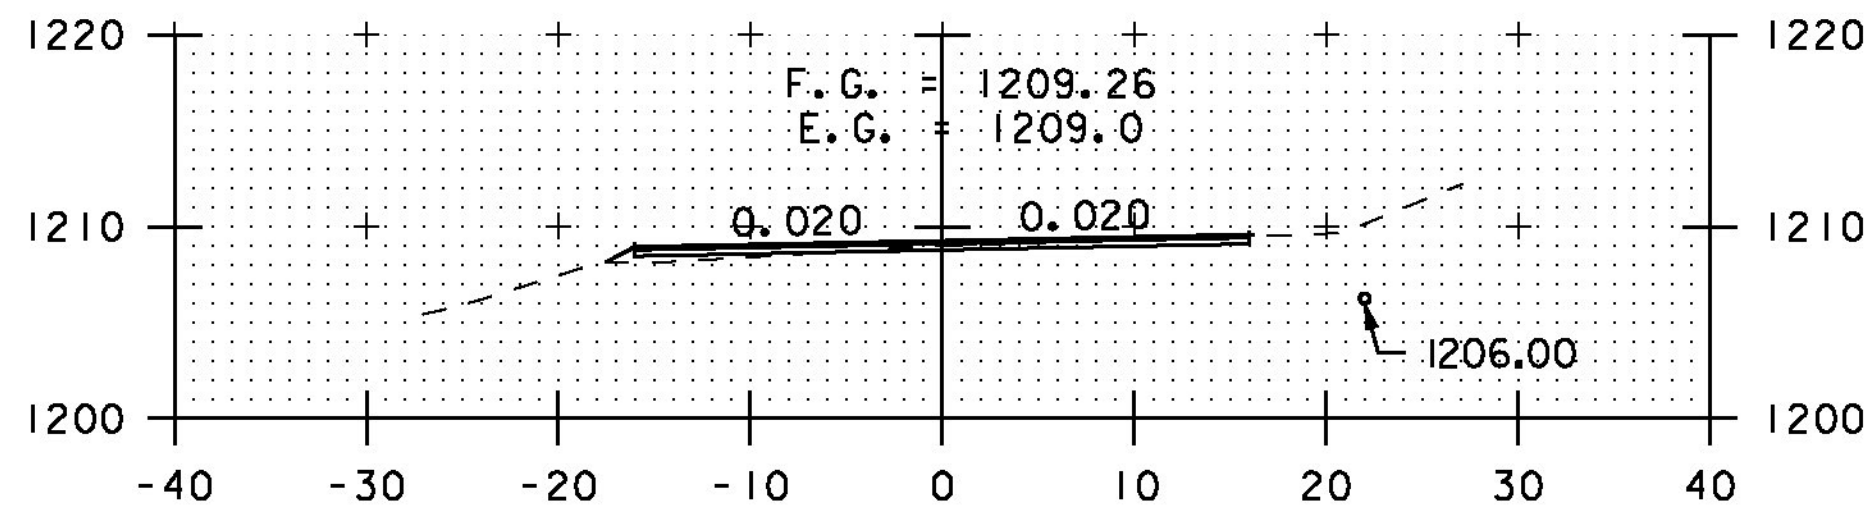


318+50

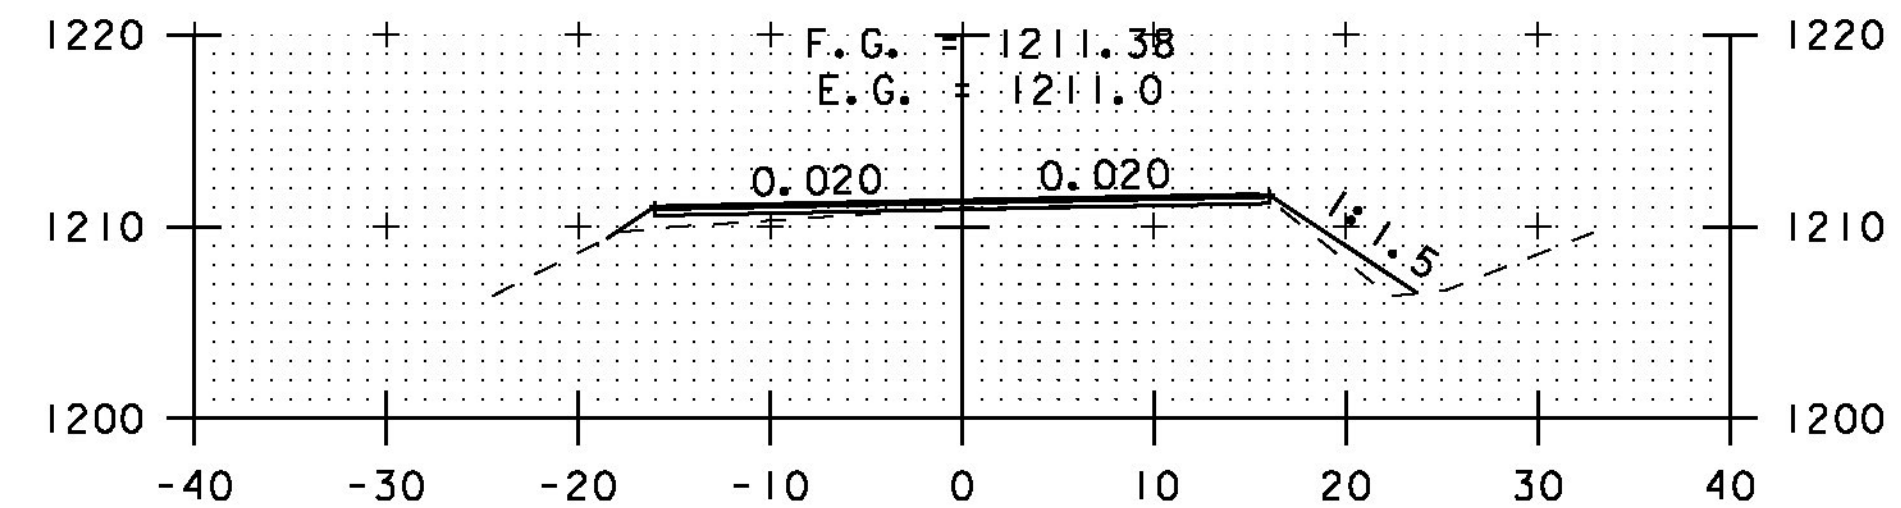


320+50

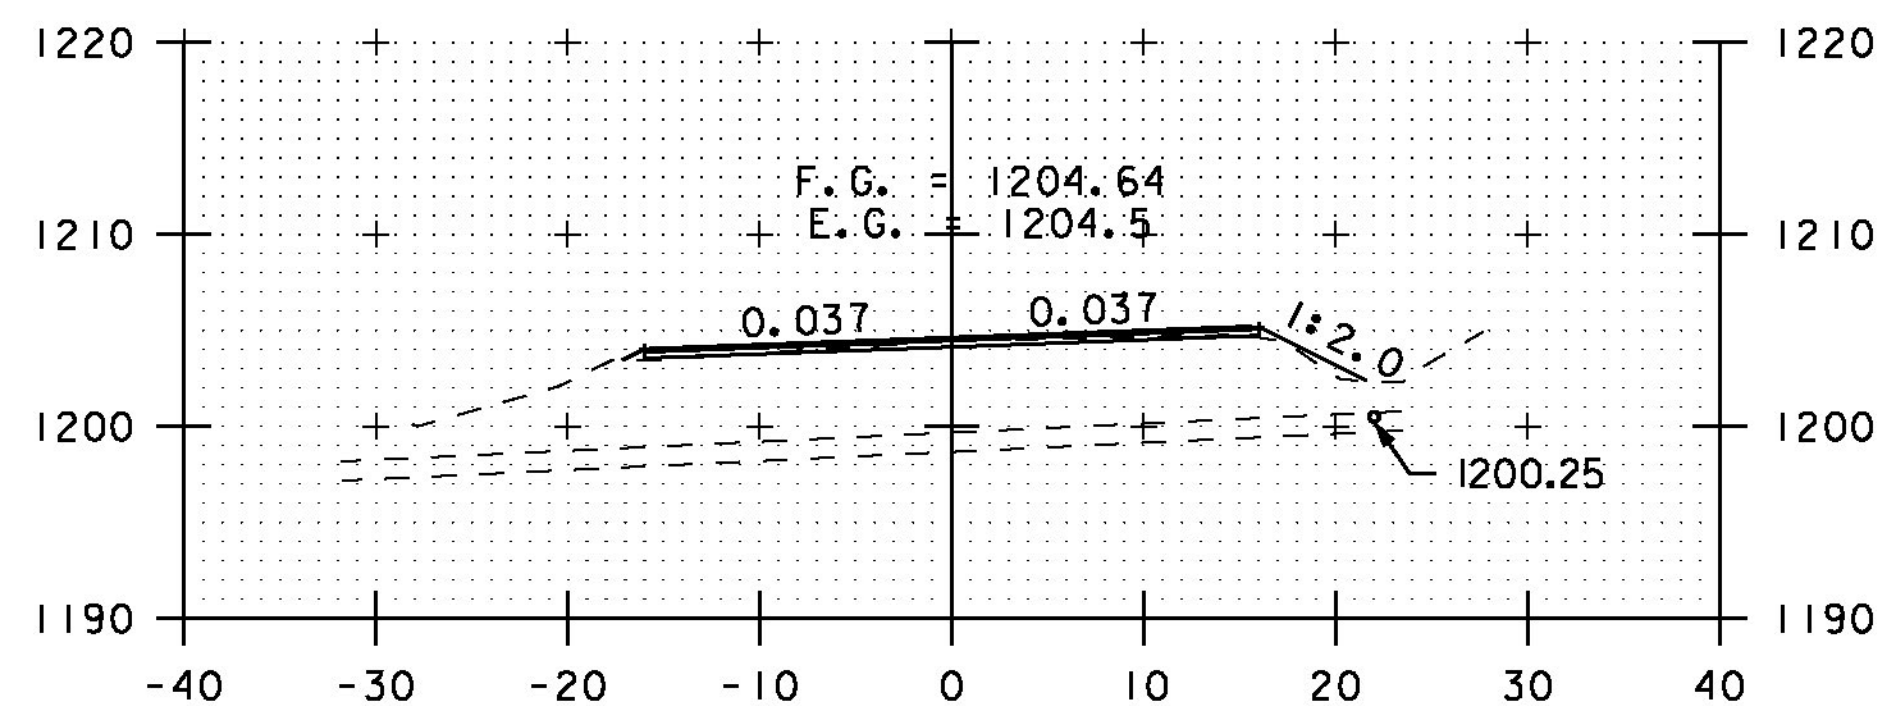

316+00

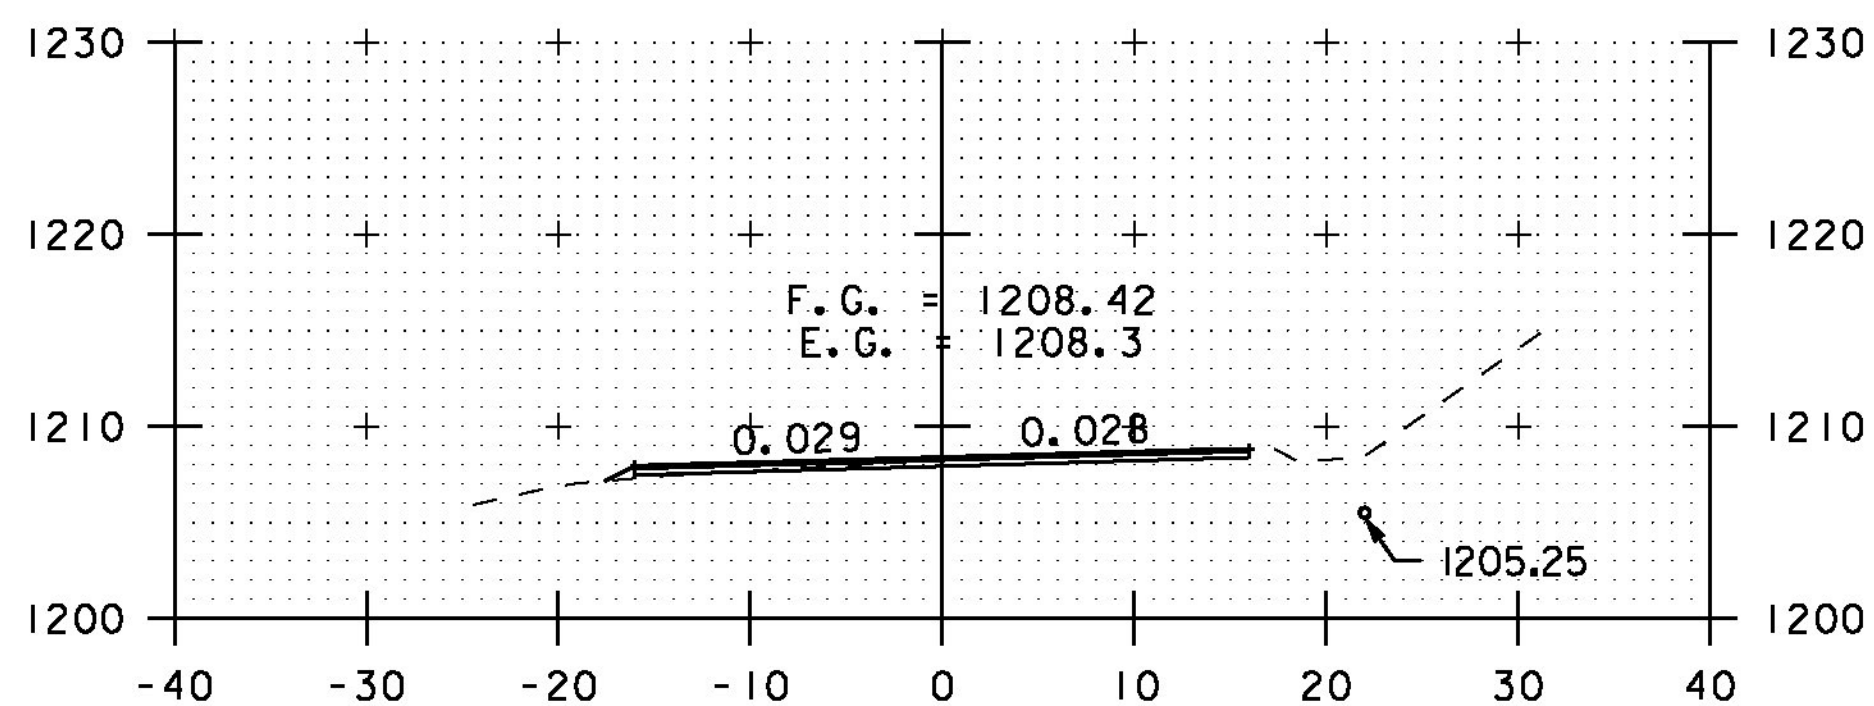

318+00

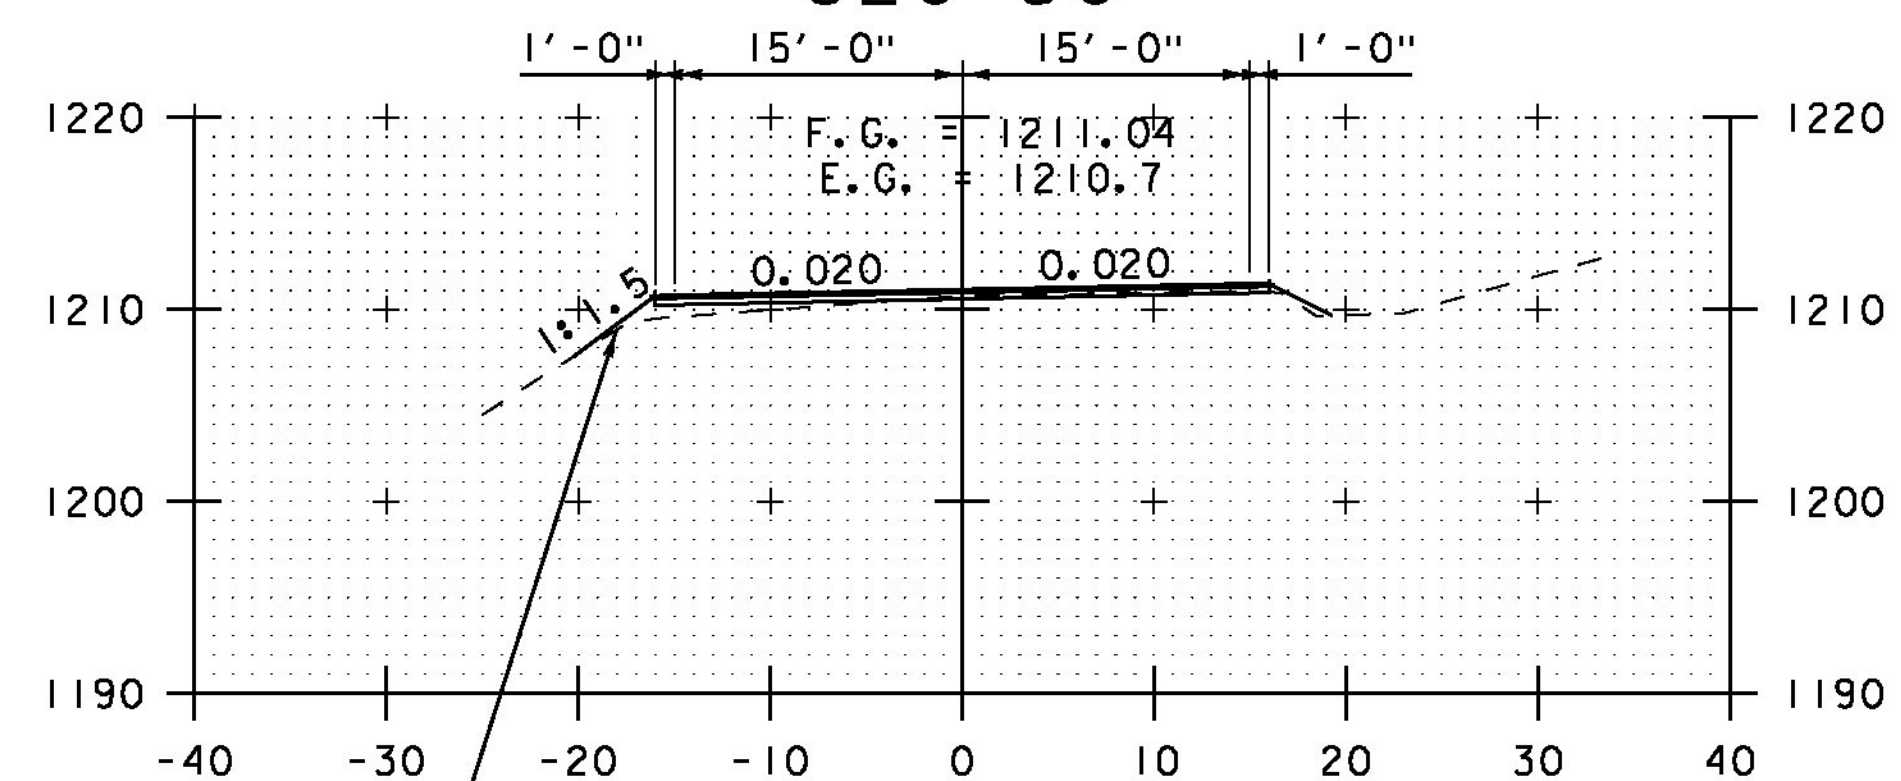

320+00

SCALE 1" = 10'-0"
10 0 10

STA. 316+00 TO STA. 321+50

CROSS SECTION SHEET 24

PROJECT NAME: ELMORE-MORRISTOWN

PROJECT NUMBER: STP 2937 (1)

FILE NAME: z11c310.dgn

PROJECT LEADER: C. LATHROP

DESIGNED BY: S. LAMPHERE

PLOT FILE: z11c310_152.i

PLOT DATE: 3/3/14

DRAWN BY: B. MARTIN

CHECKED BY: C. LATHROP

SHEET 152 OF 194