




328+00

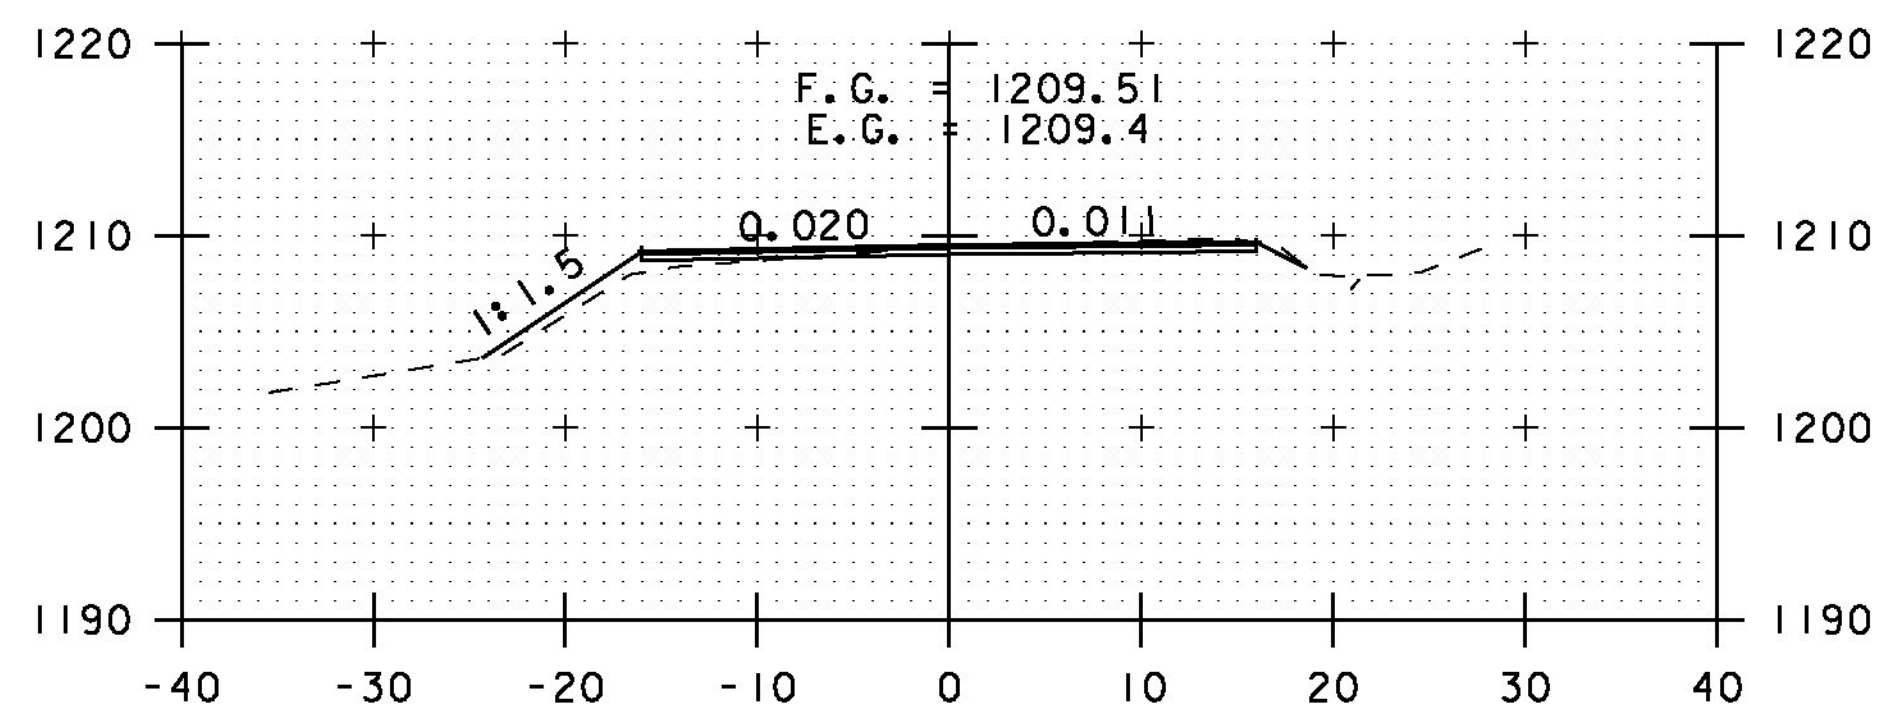


329+50

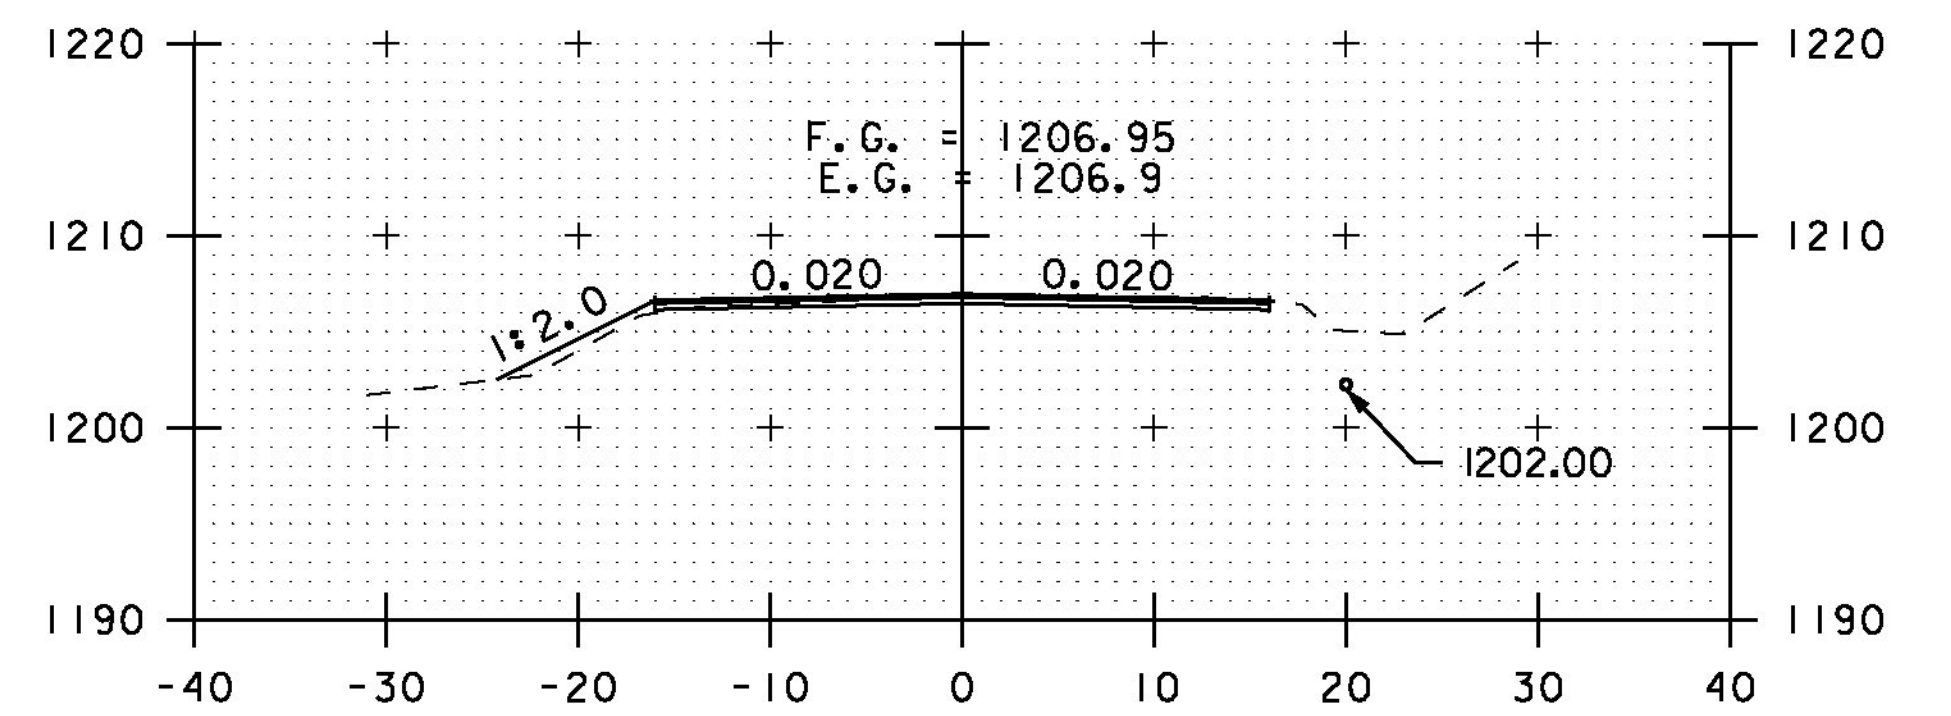


331+00

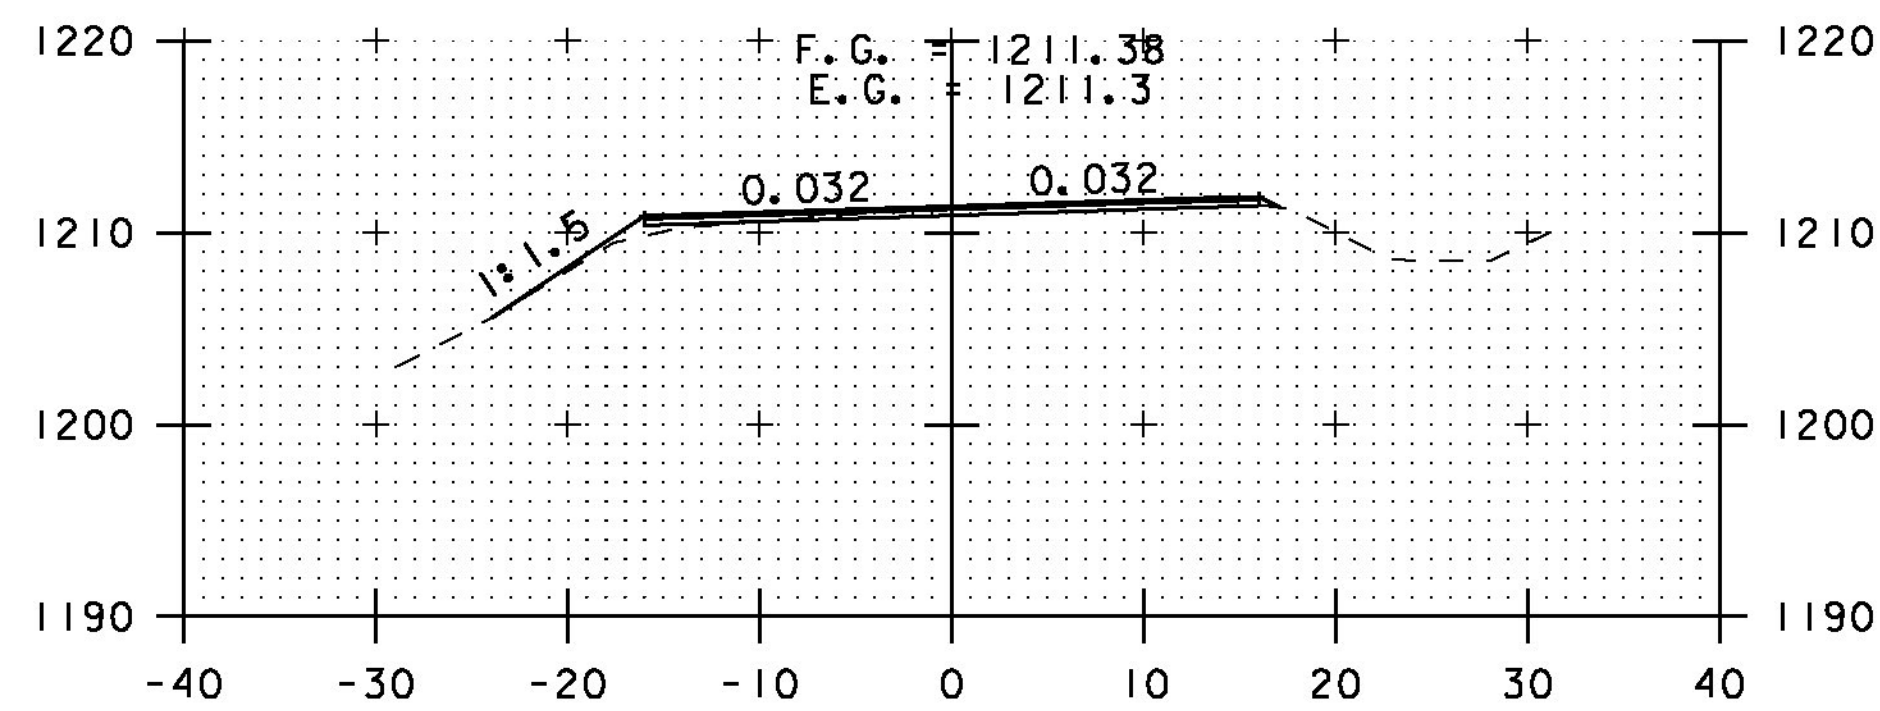

327+50

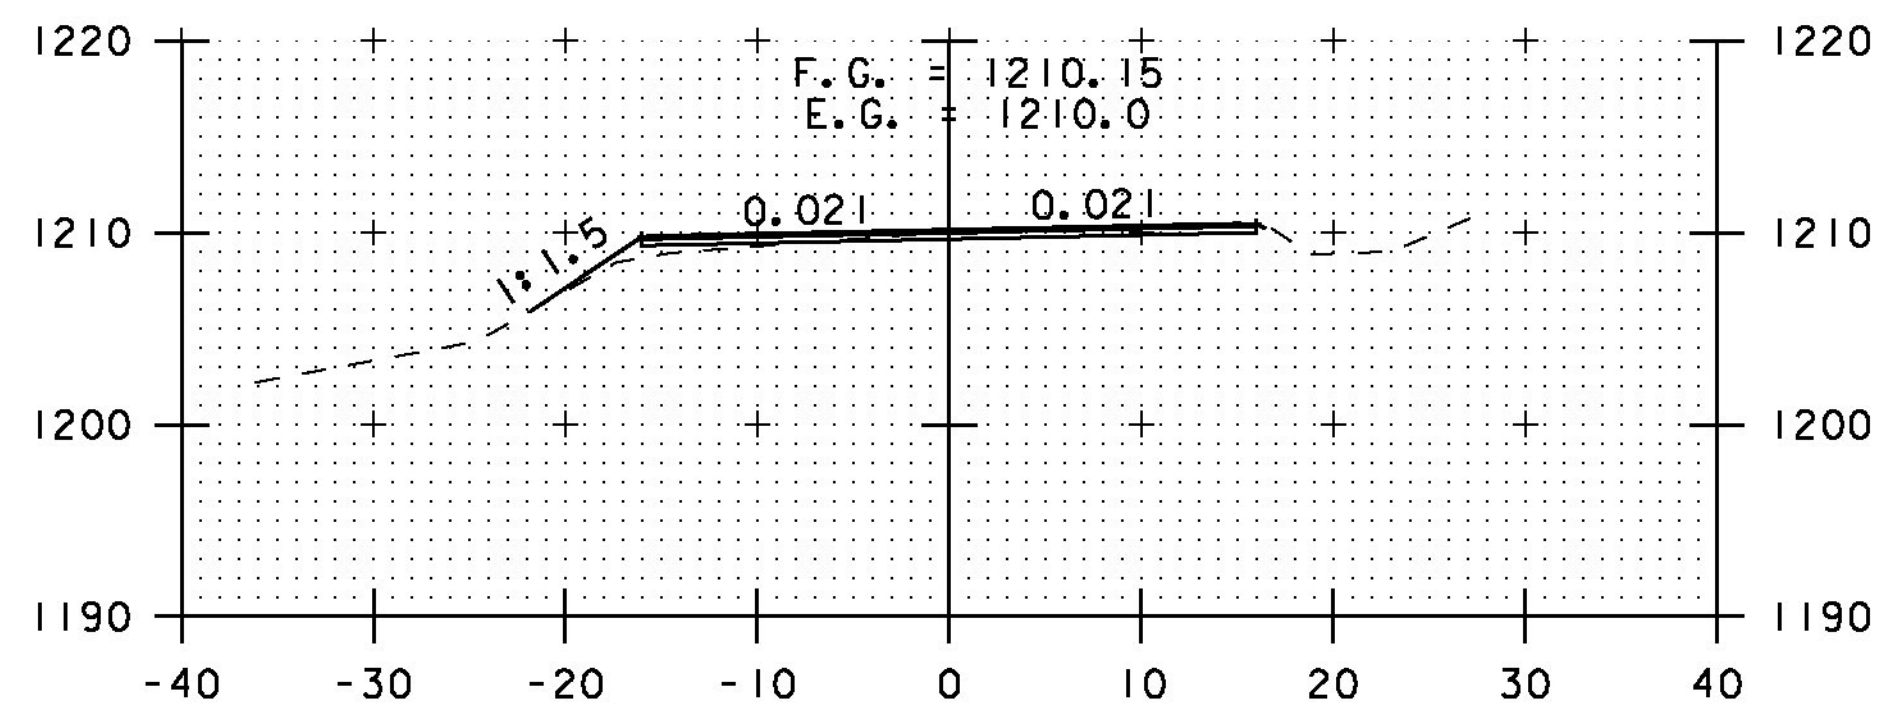


329+00

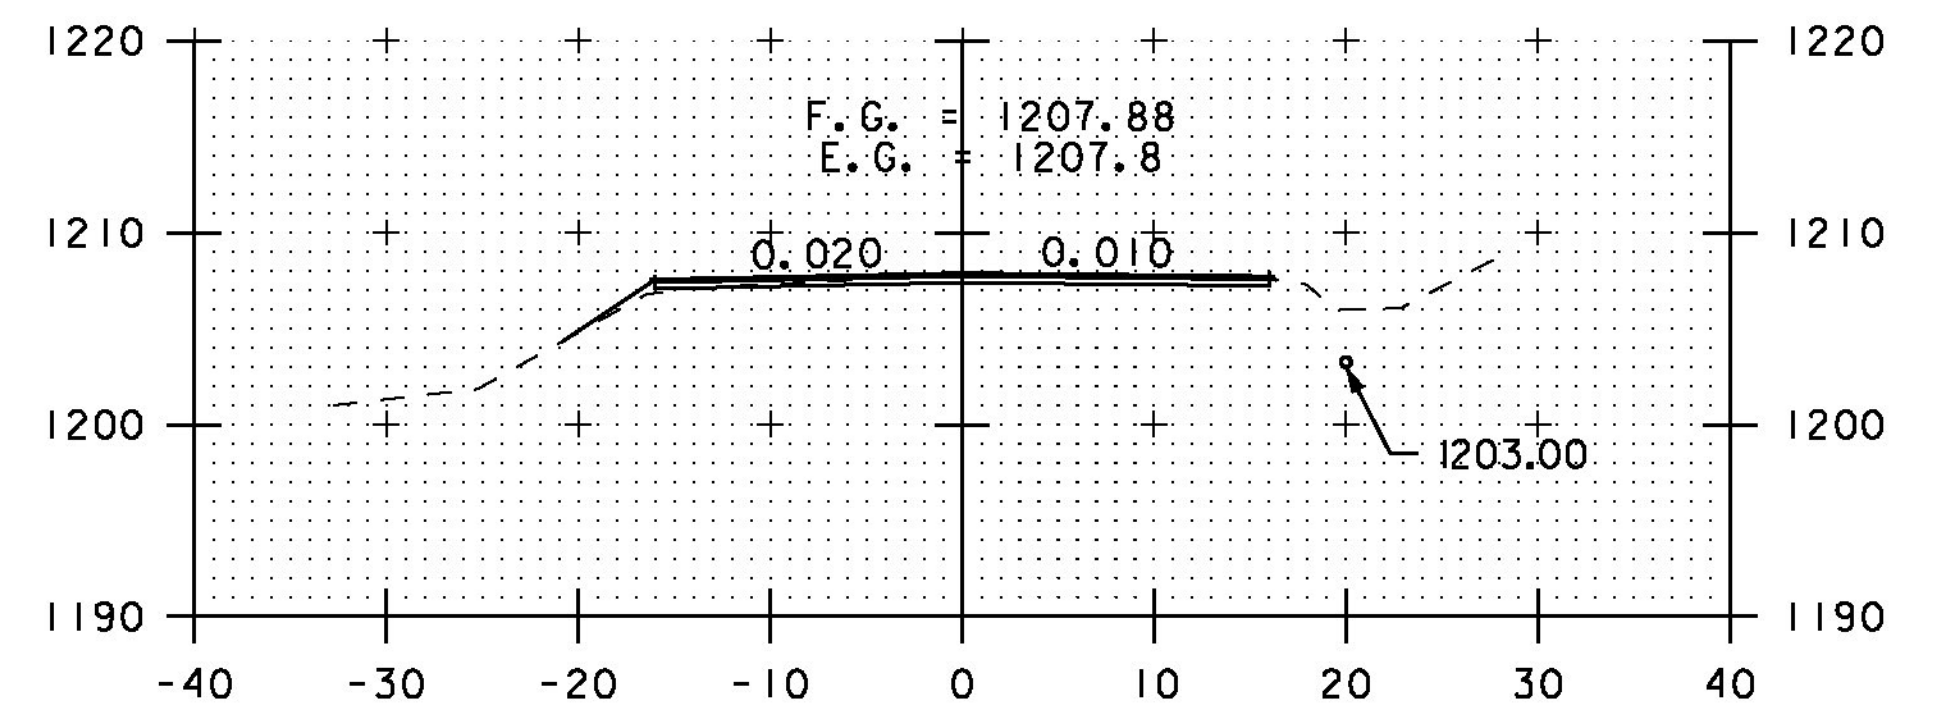


330+50



327+00

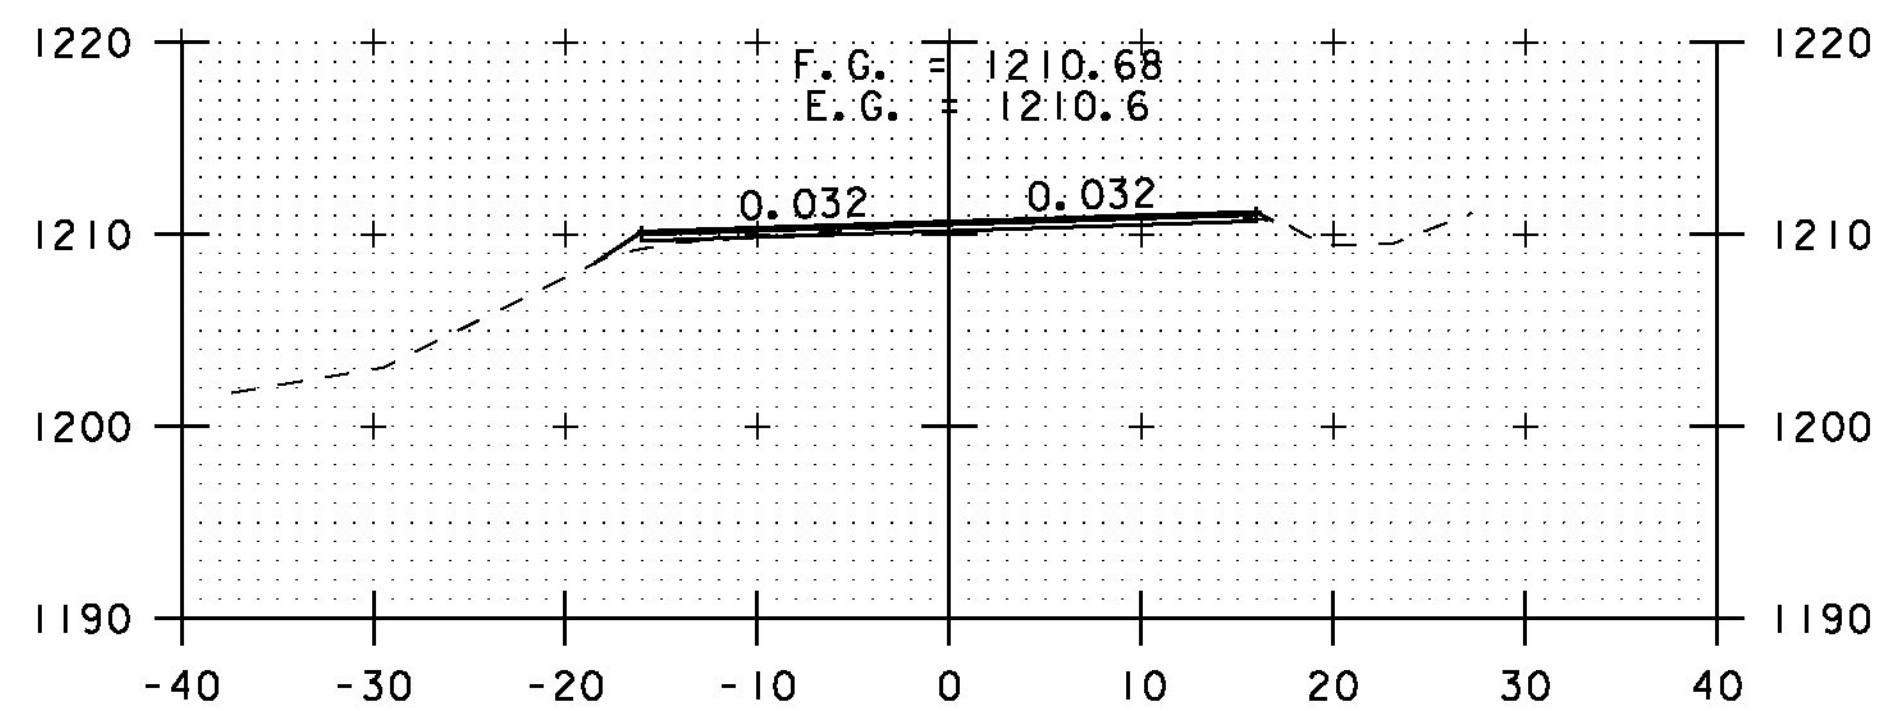

328+50

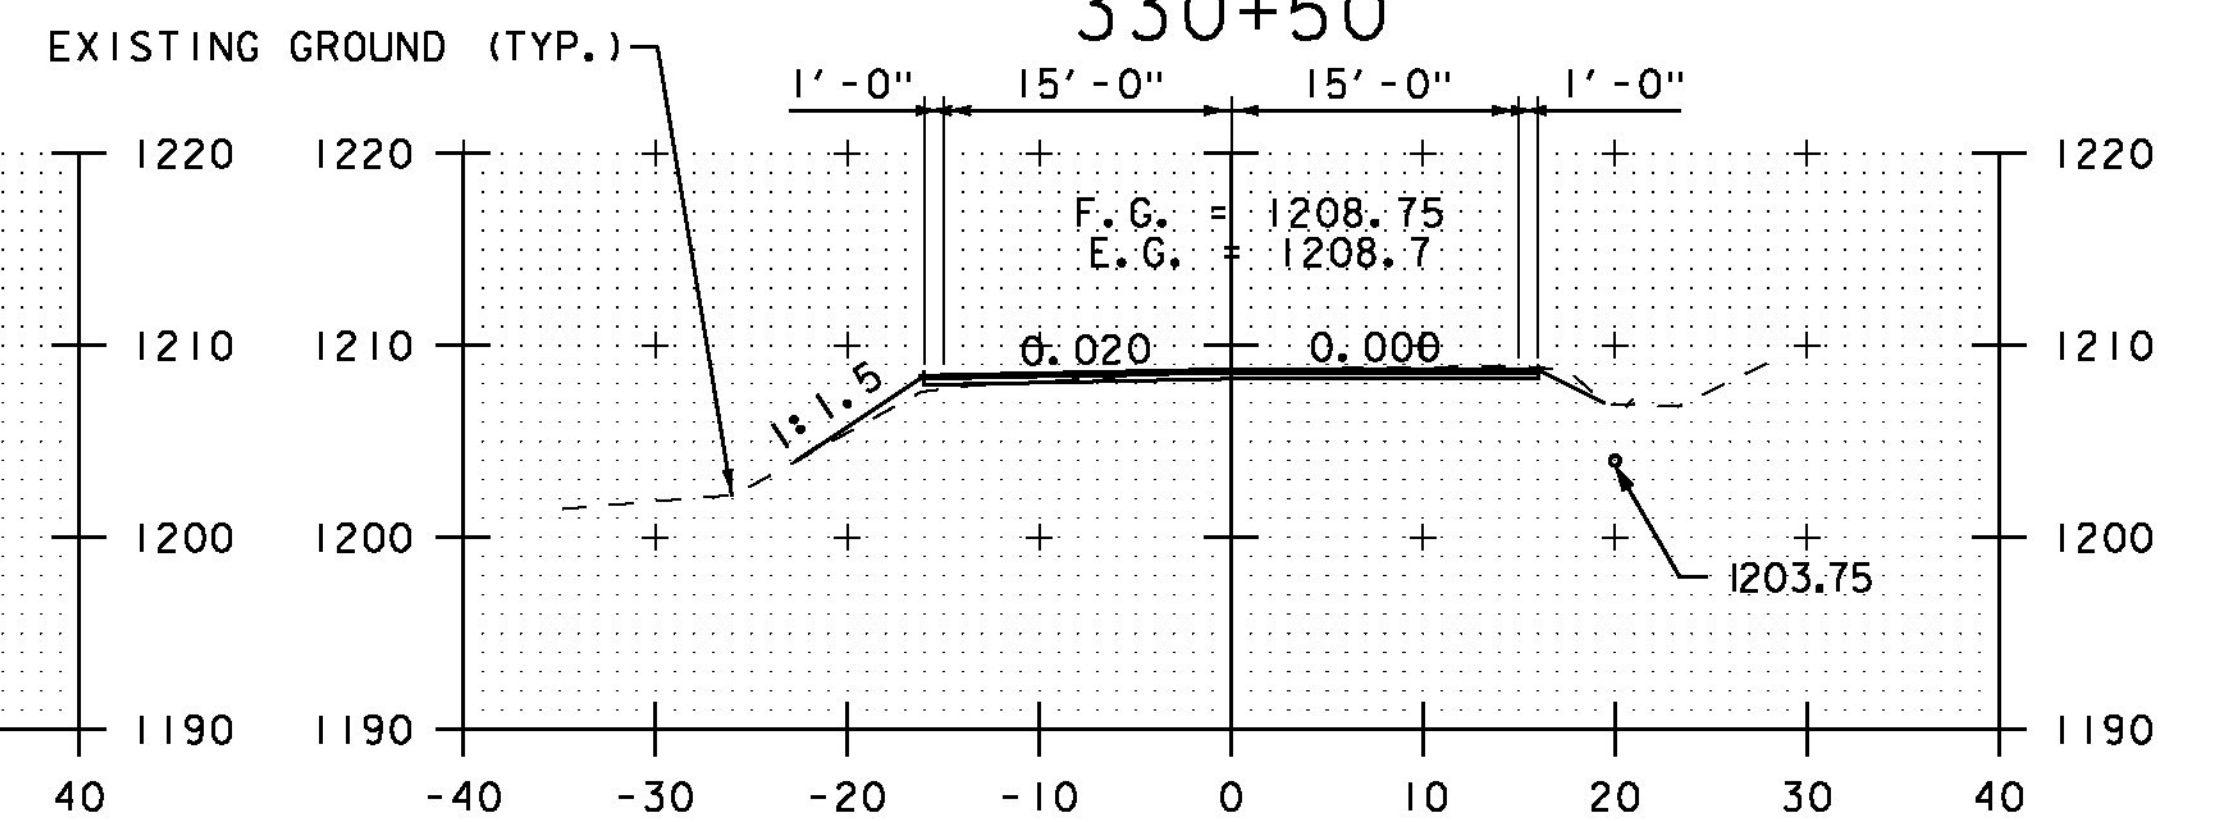

330+00

STA. 327+00 TO STA. 331+00

SCALE 1" = 10'-0"

CROSS SECTION SHEET 26

PROJECT NAME: ELMORE-MORRISTOWN	PROJECT NUMBER: STP 2937 (1)
FILE NAME: z11c310.dgn	PLOT DATE: 3/3/14
PROJECT LEADER: C. LATHROP	DRAWN BY: B. MARTIN
DESIGNED BY: S. LAMPHERE	CHECKED BY: C. LATHROP
PLOT FILE: z11c310_154.i	SHEET 154 OF 194