




345+00

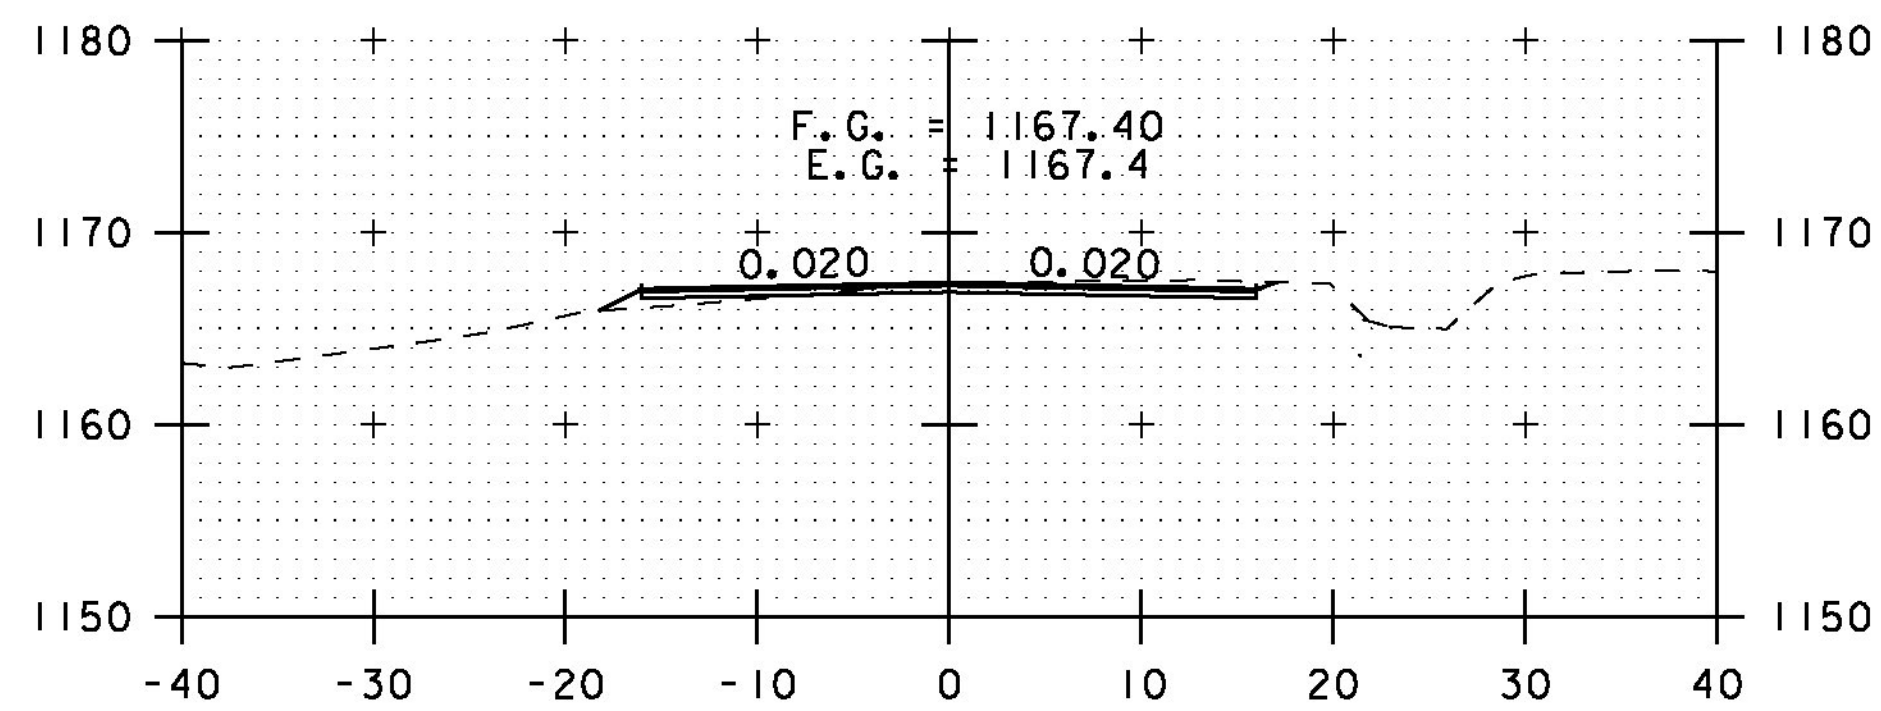


347+00

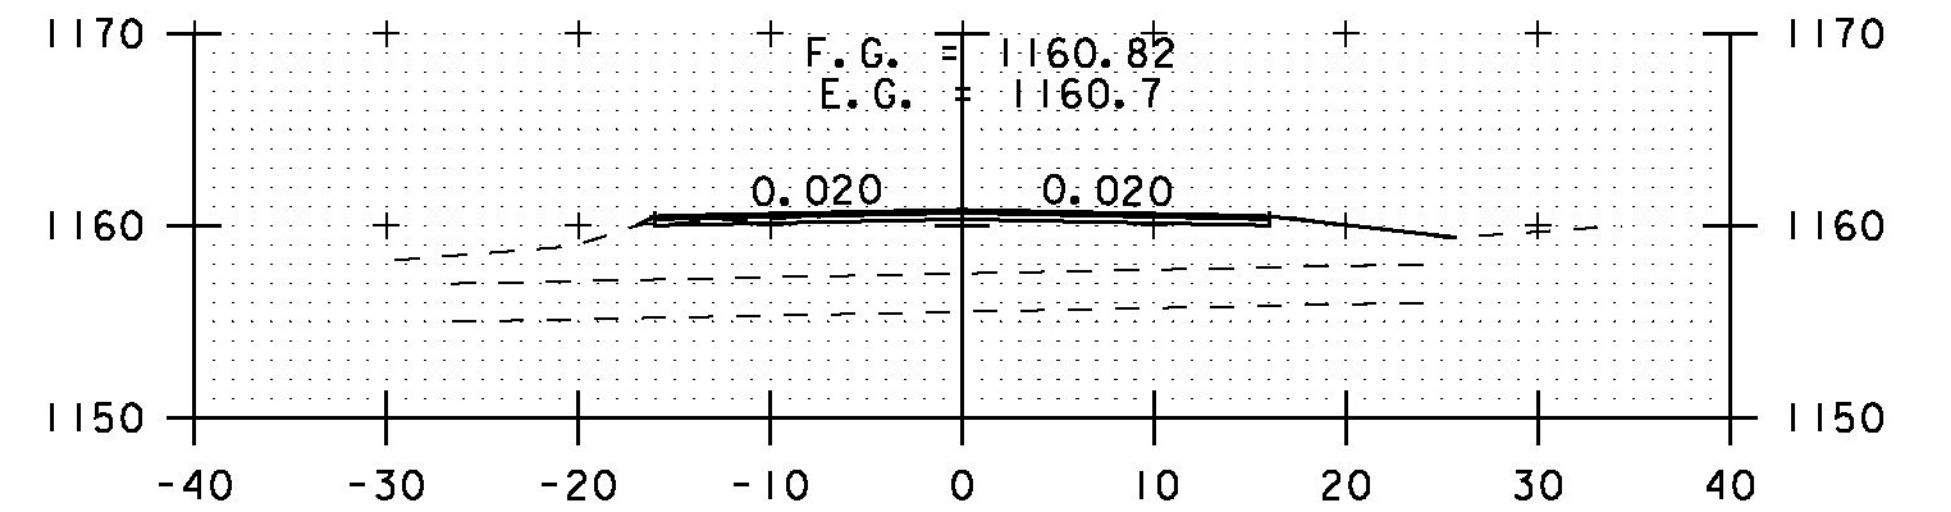


DRIVE RT
349+00

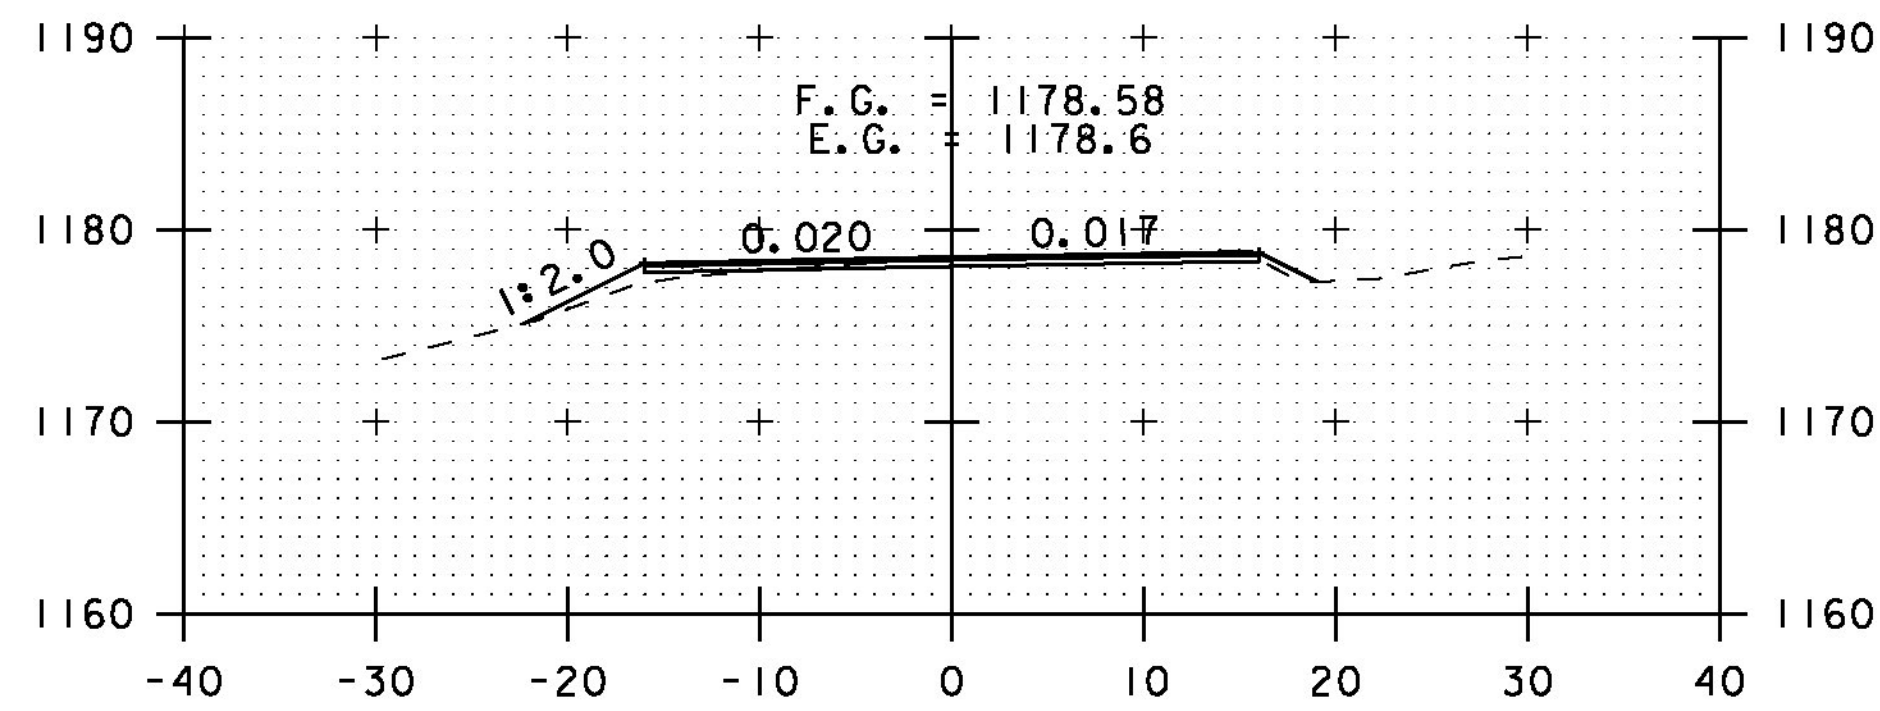


344+50

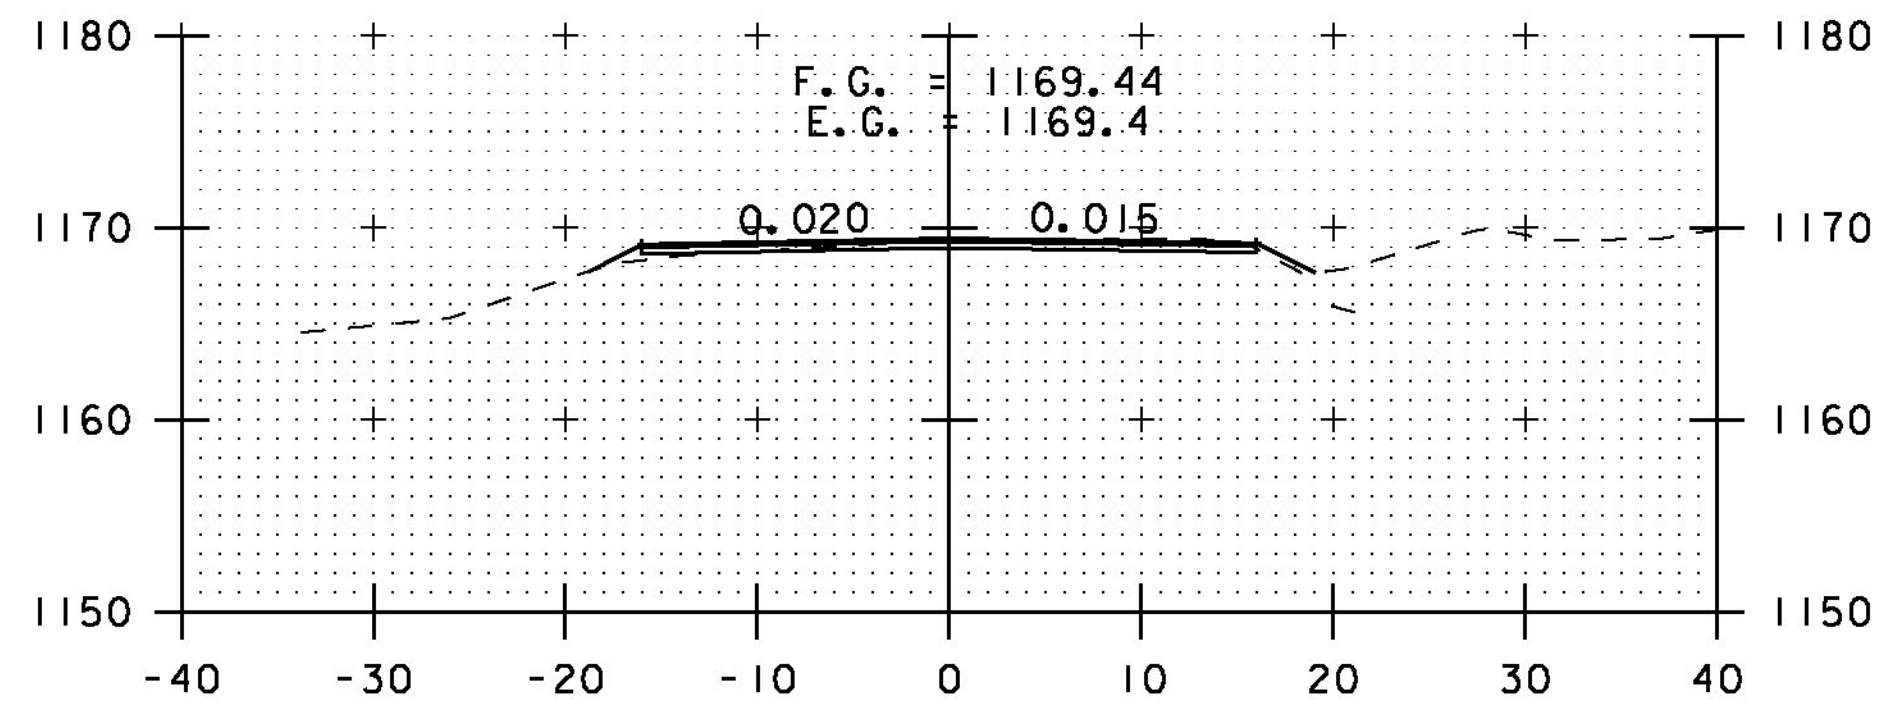


346+50

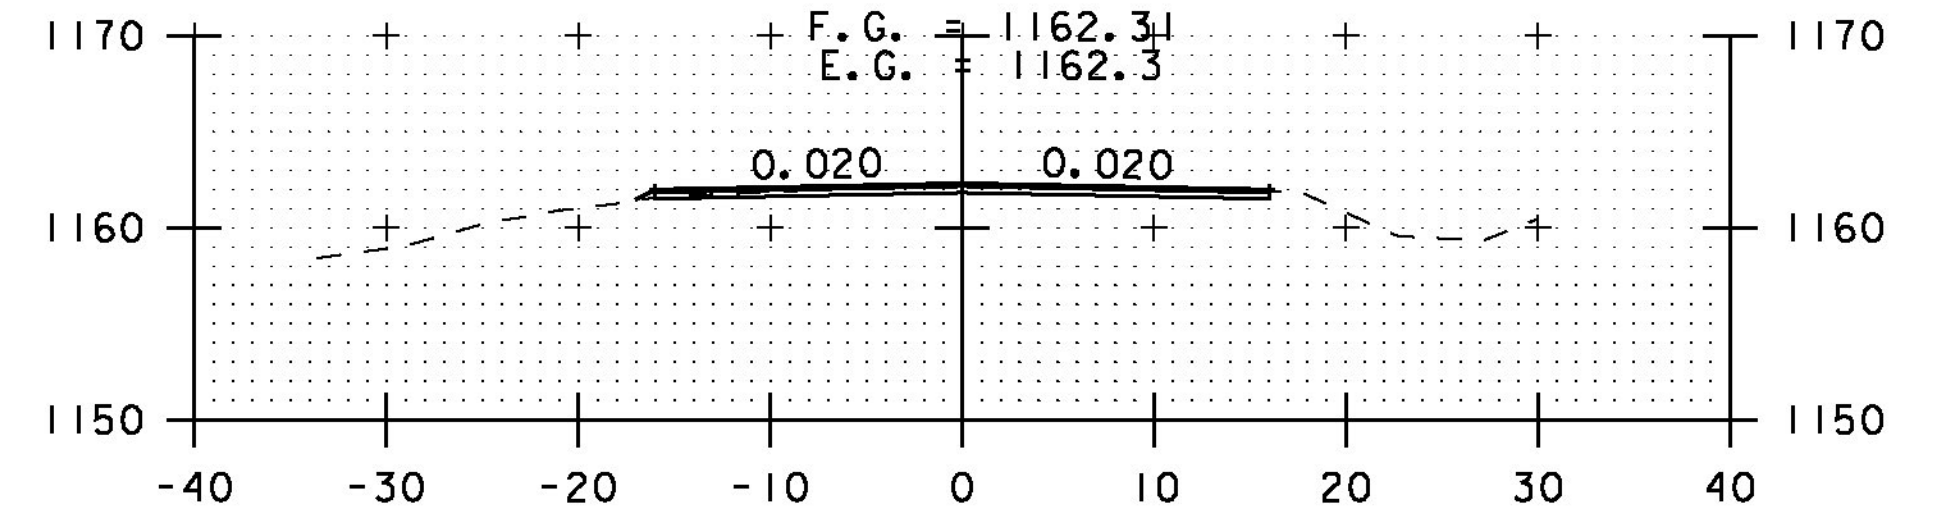


348+50

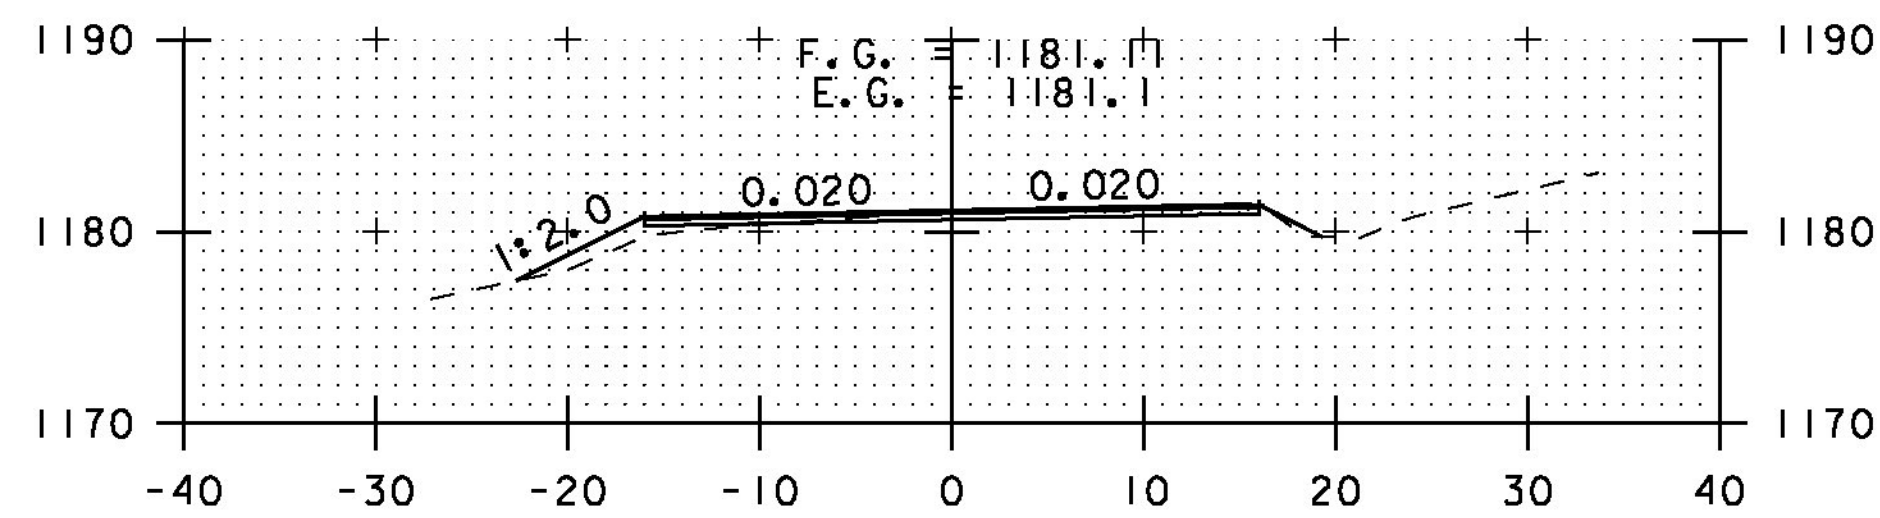


344+00

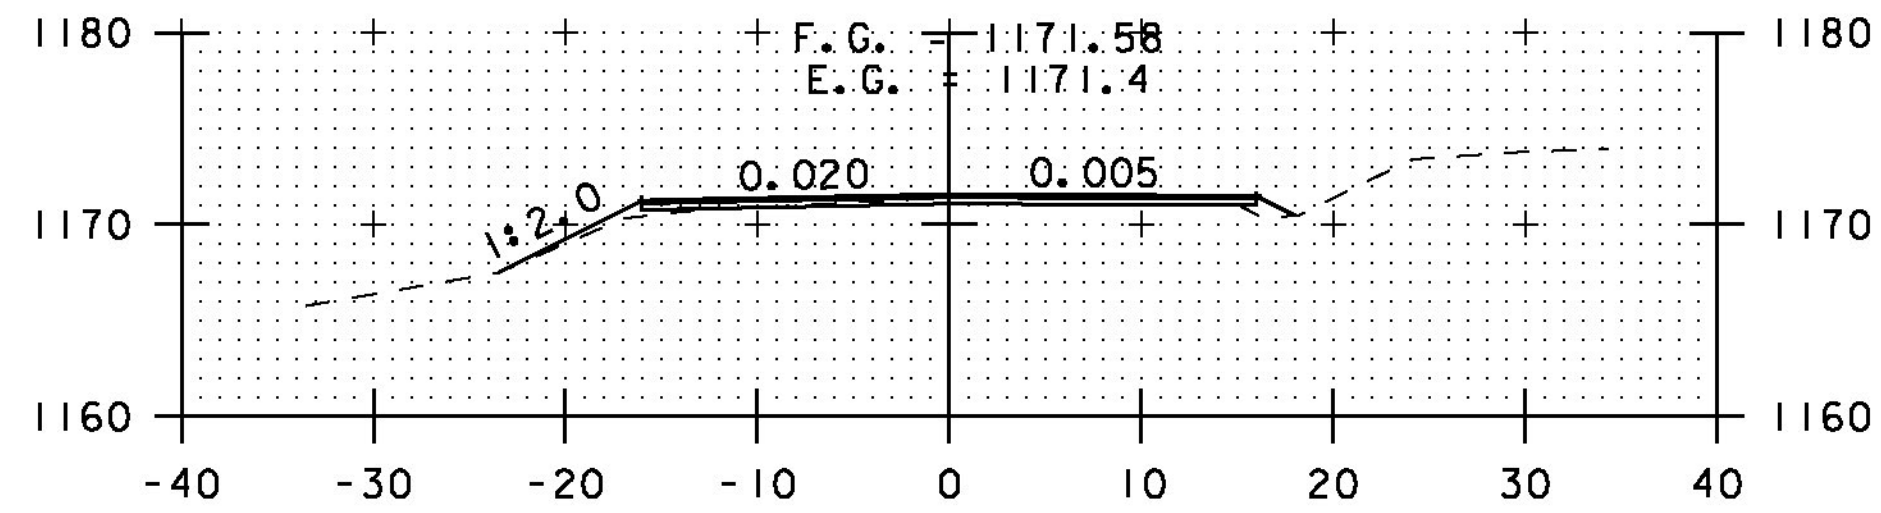


346+00

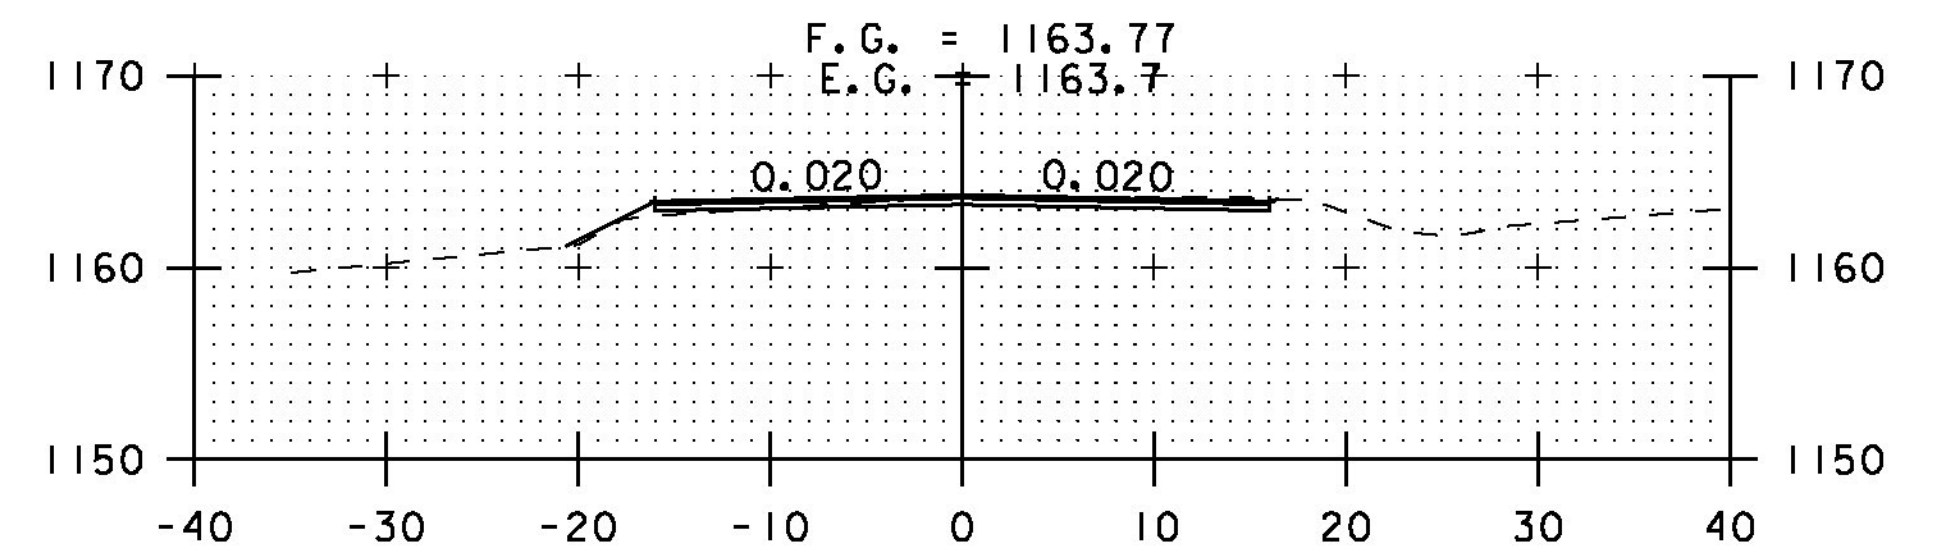


348+00

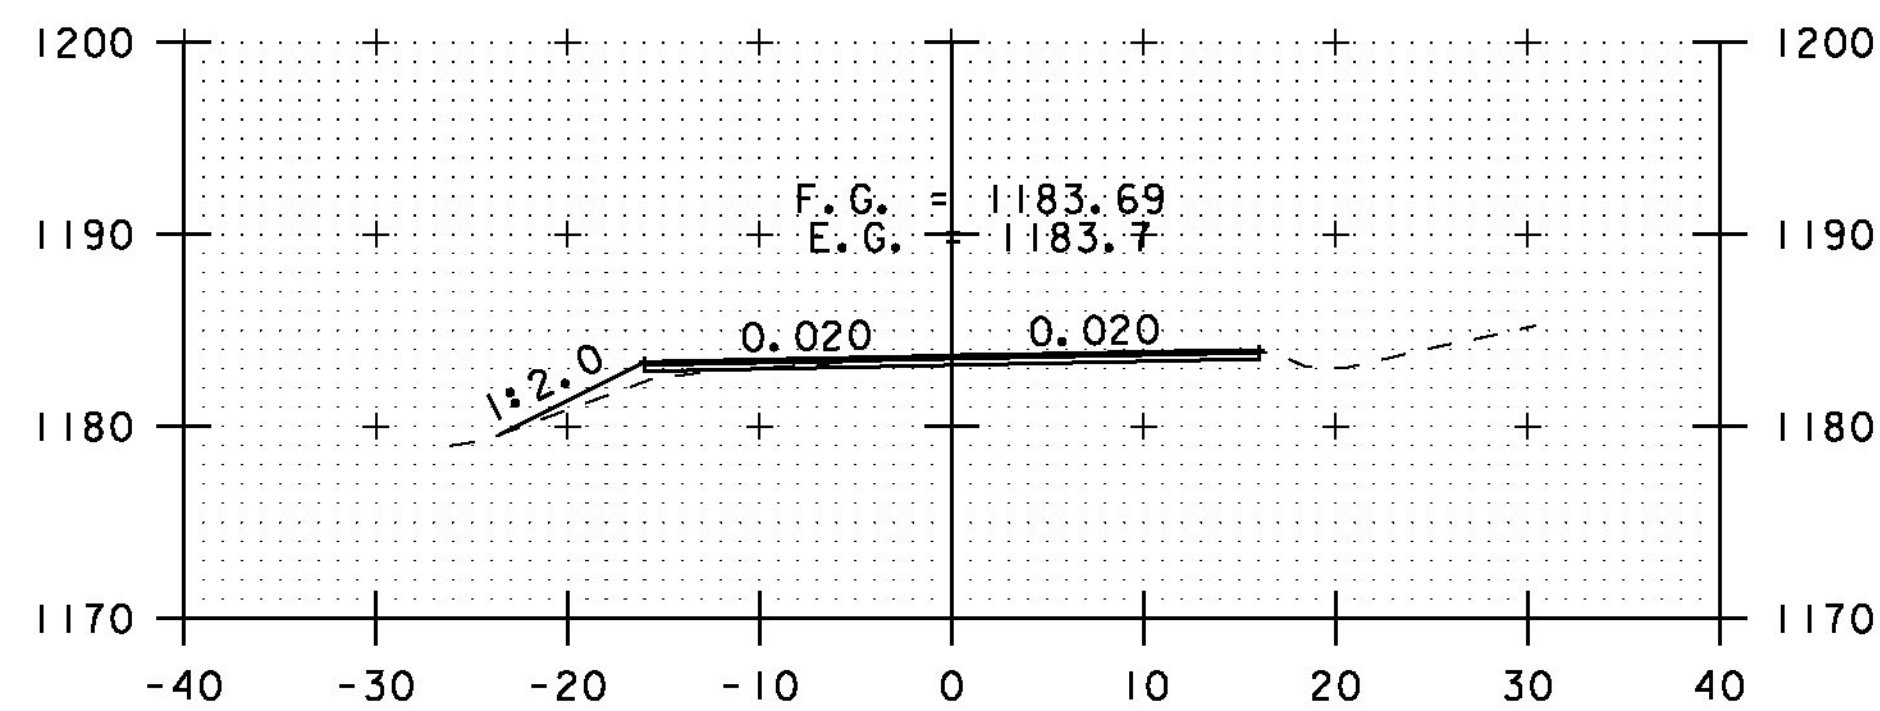

343+50

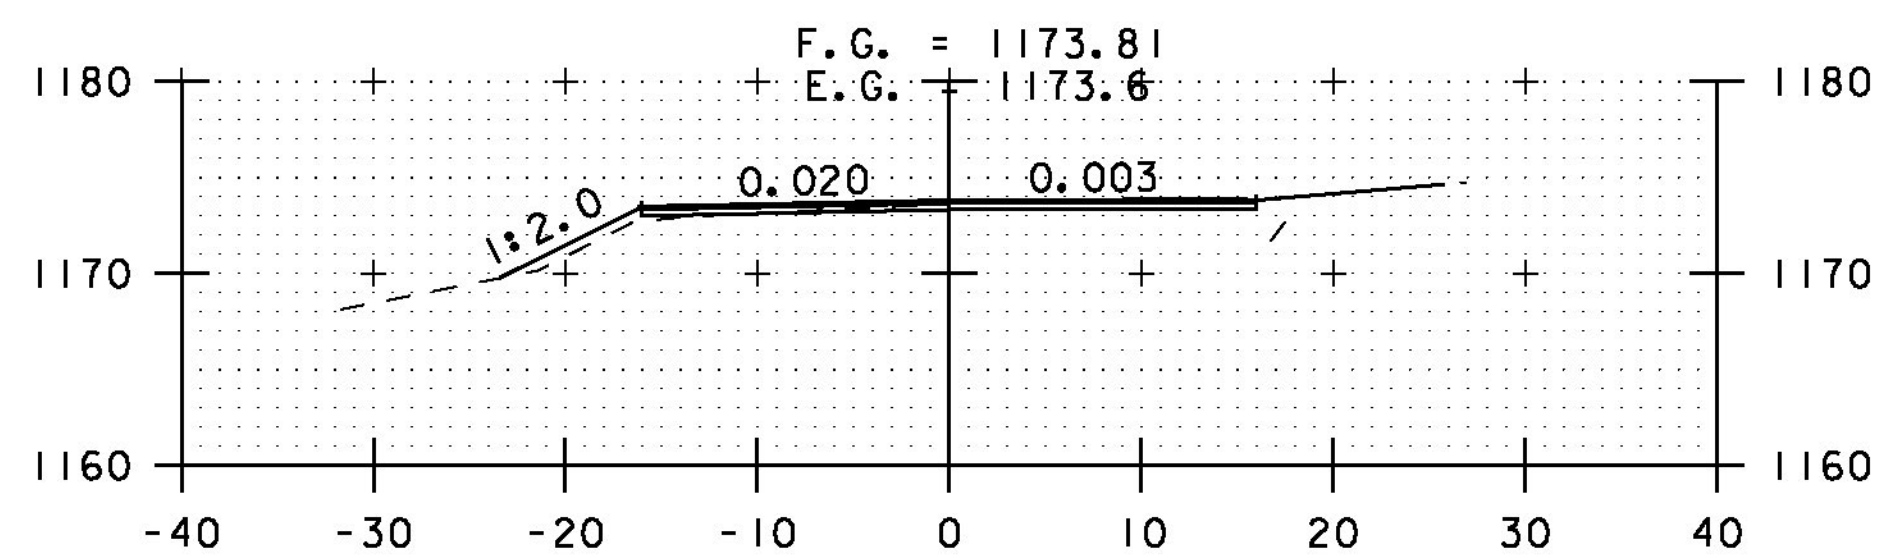

DRIVE RT
345+50

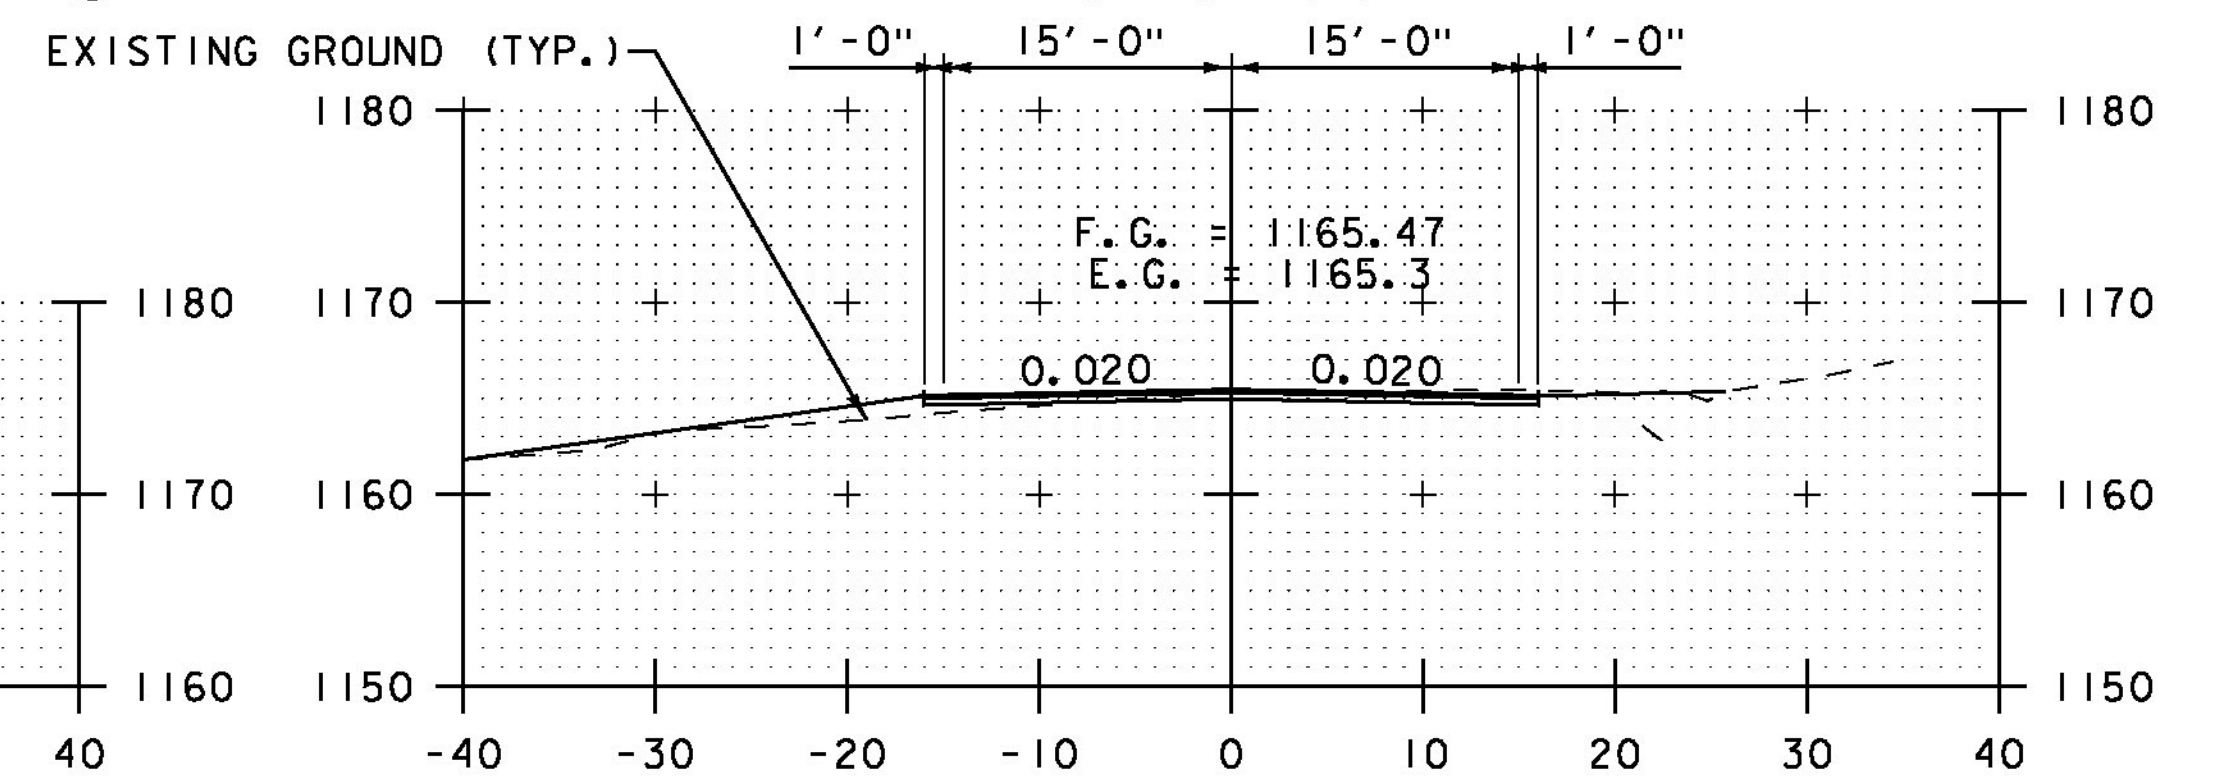

347+50 DRIVE RT, TH#8 LT

STA. 343+50 TO STA. 349+00



CROSS SECTION SHEET 29

PROJECT NAME: ELMORE-MORRISTOWN

PROJECT NUMBER: STP 2937 (I)

FILE NAME: z11c310.dgn

PROJECT LEADER: C. LATHROP

DESIGNED BY: S. LAMPHERE

PLOT FILE: z11c310_157.i

PLOT DATE: 3/3/14

DRAWN BY: B. MARTIN

CHECKED BY: C. LATHROP

SHEET 157 OF 194