




351+00

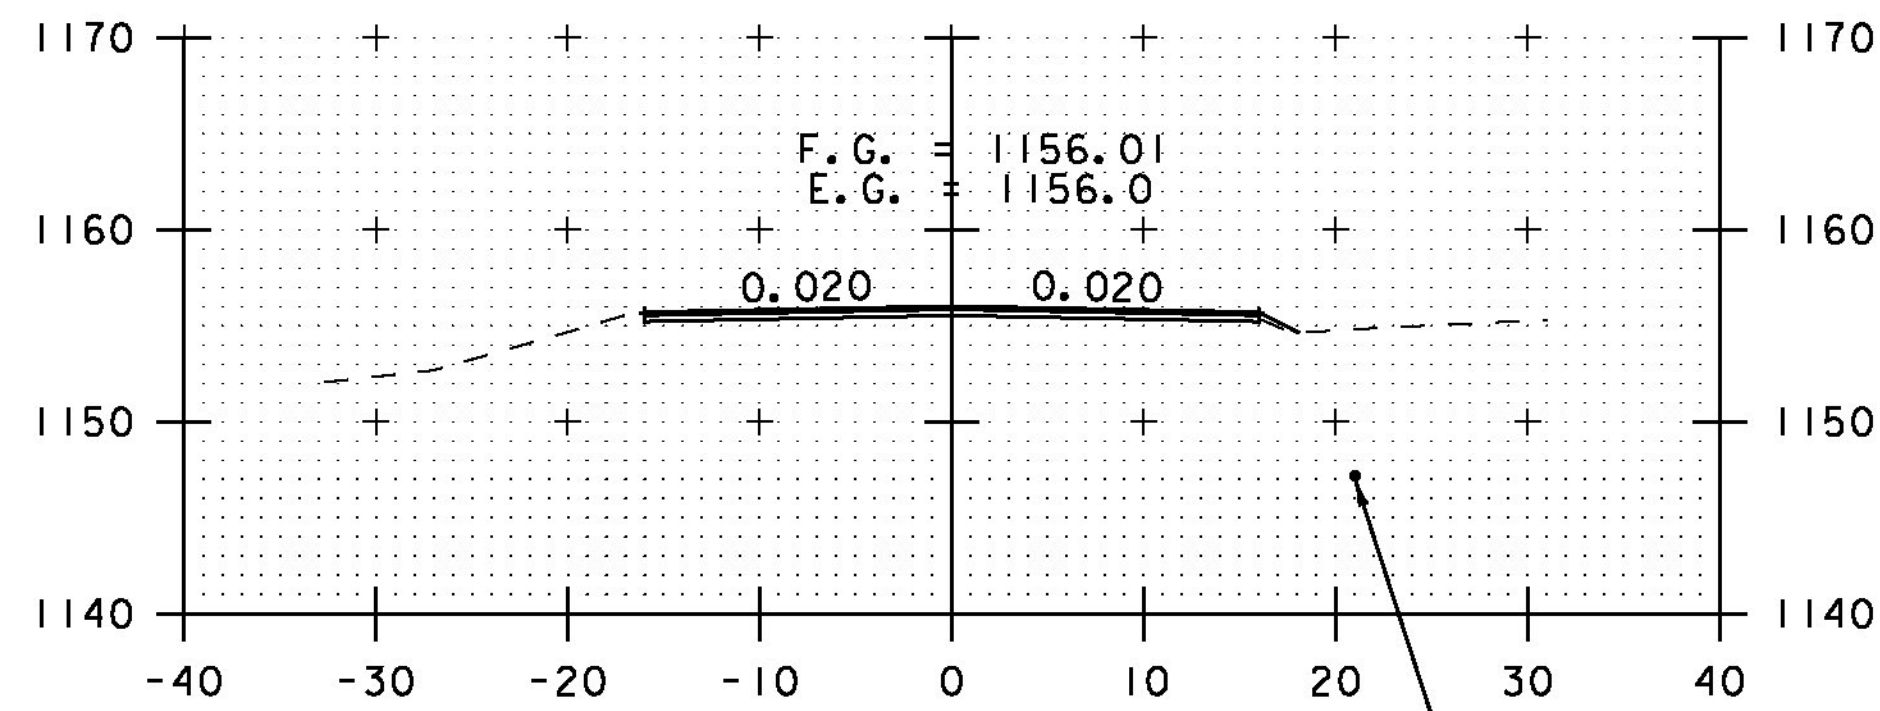


350+50

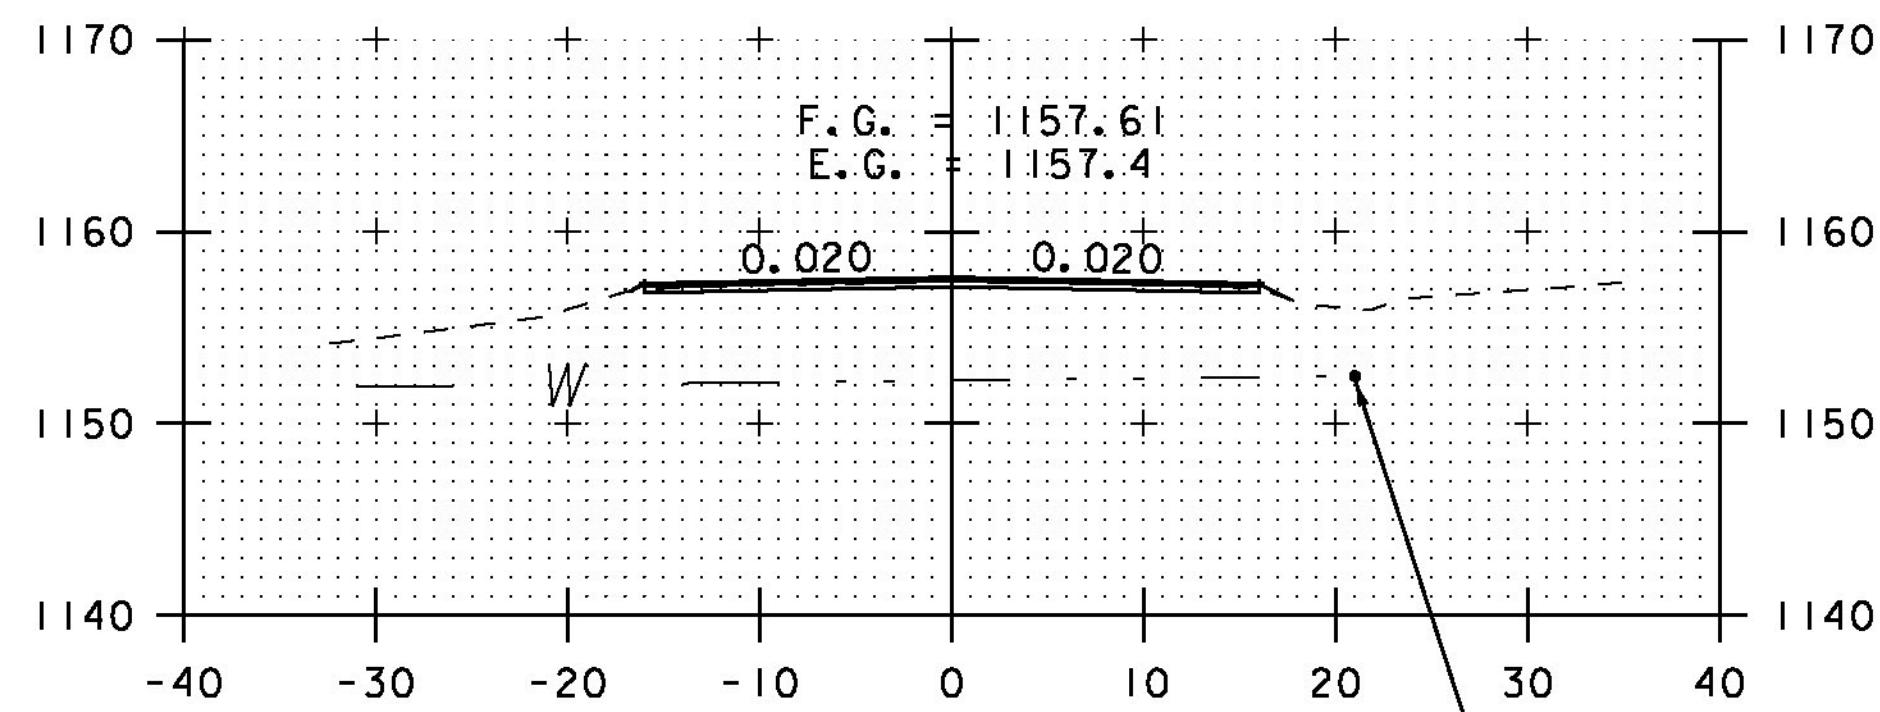


350+00

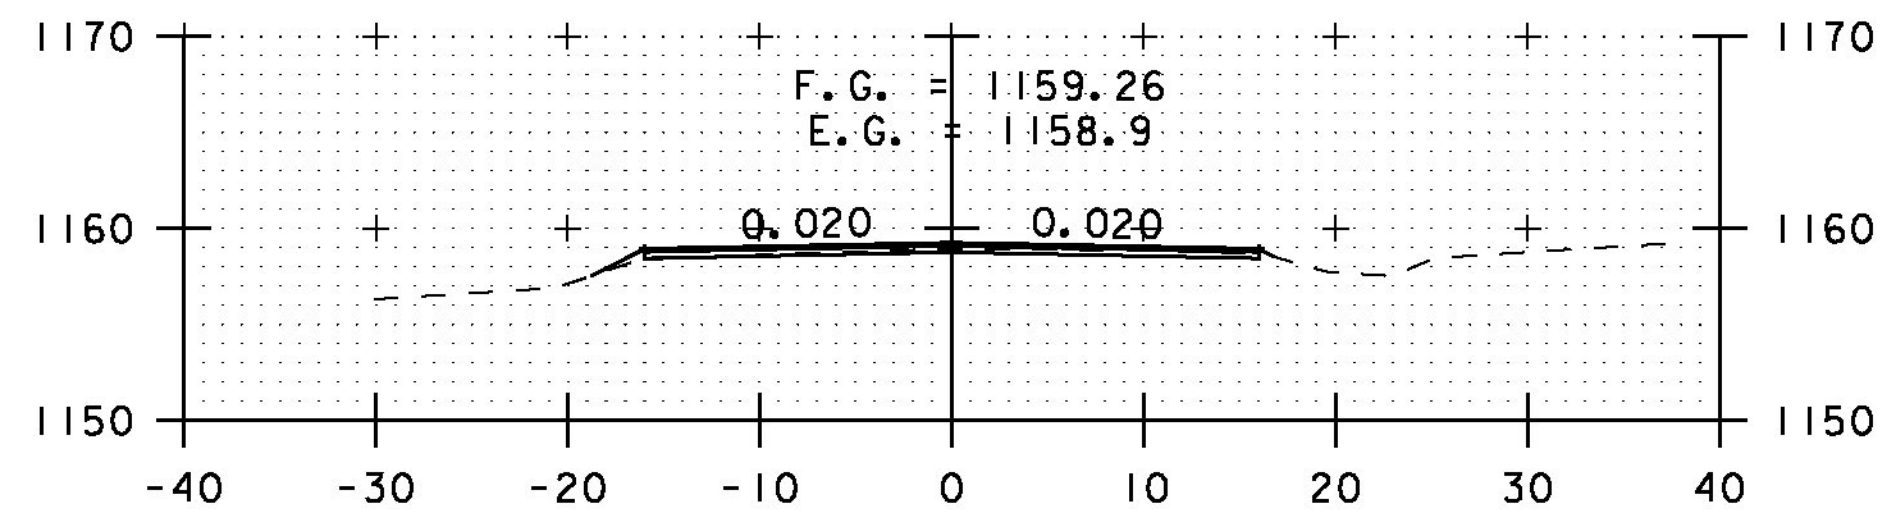


349+50

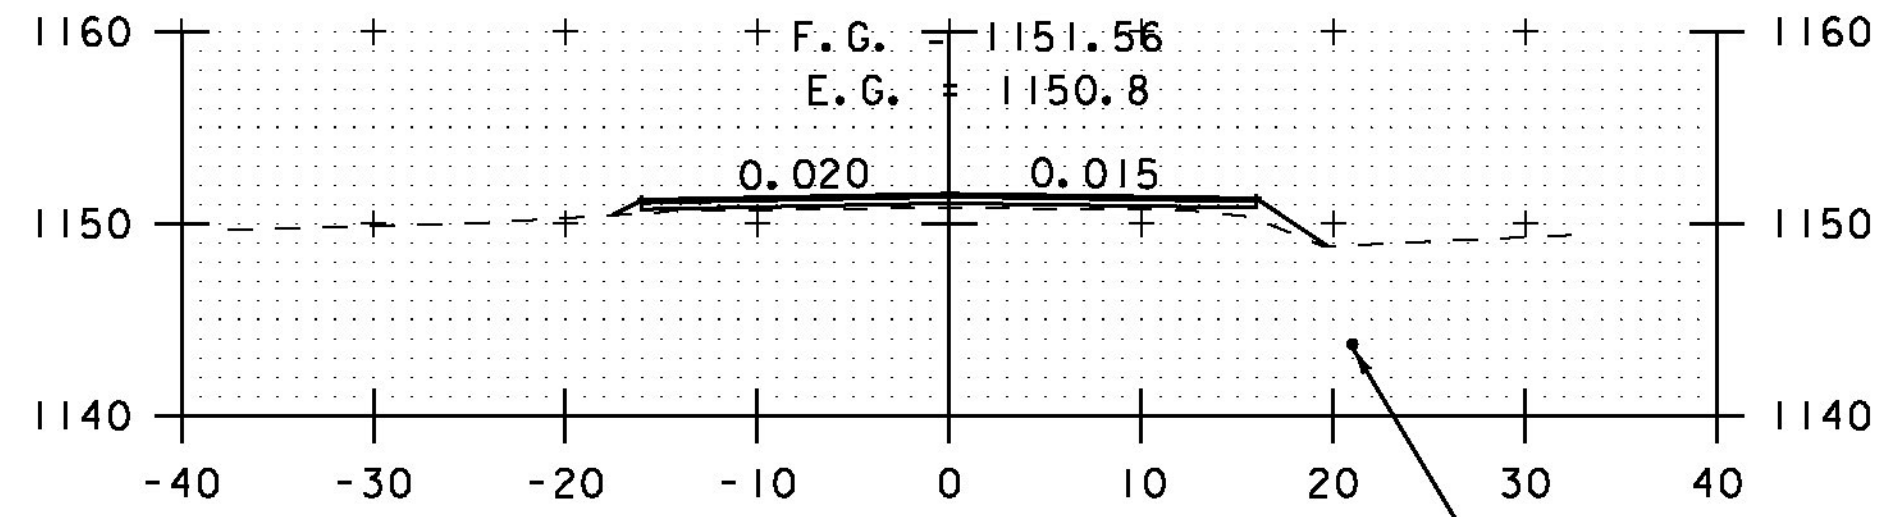


353+00

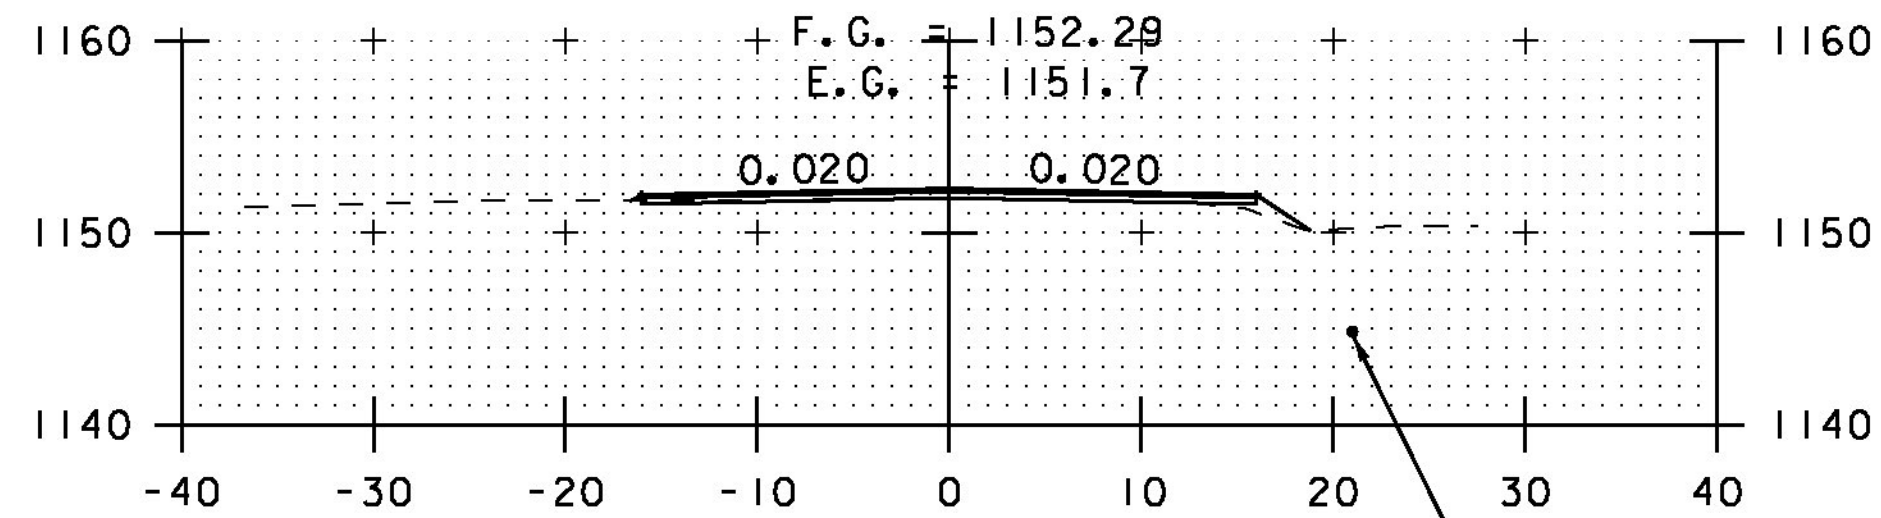


352+50

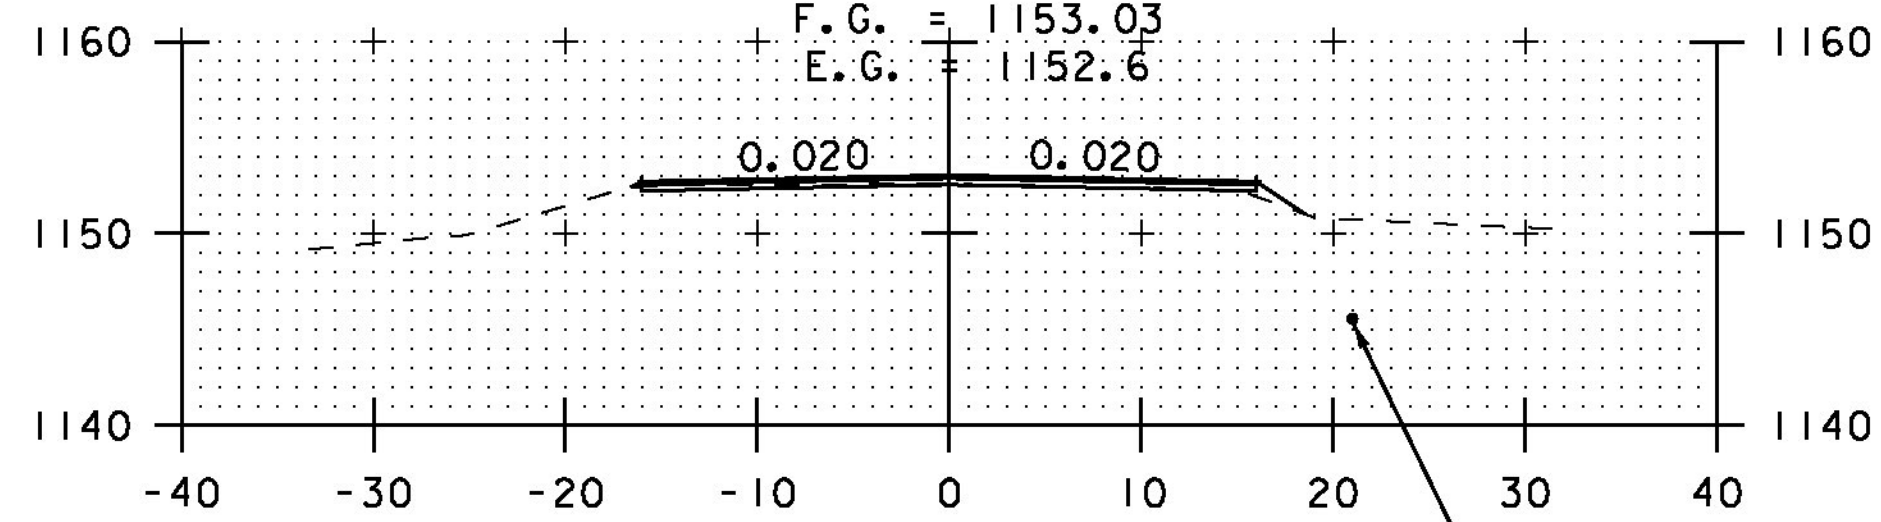


352+00

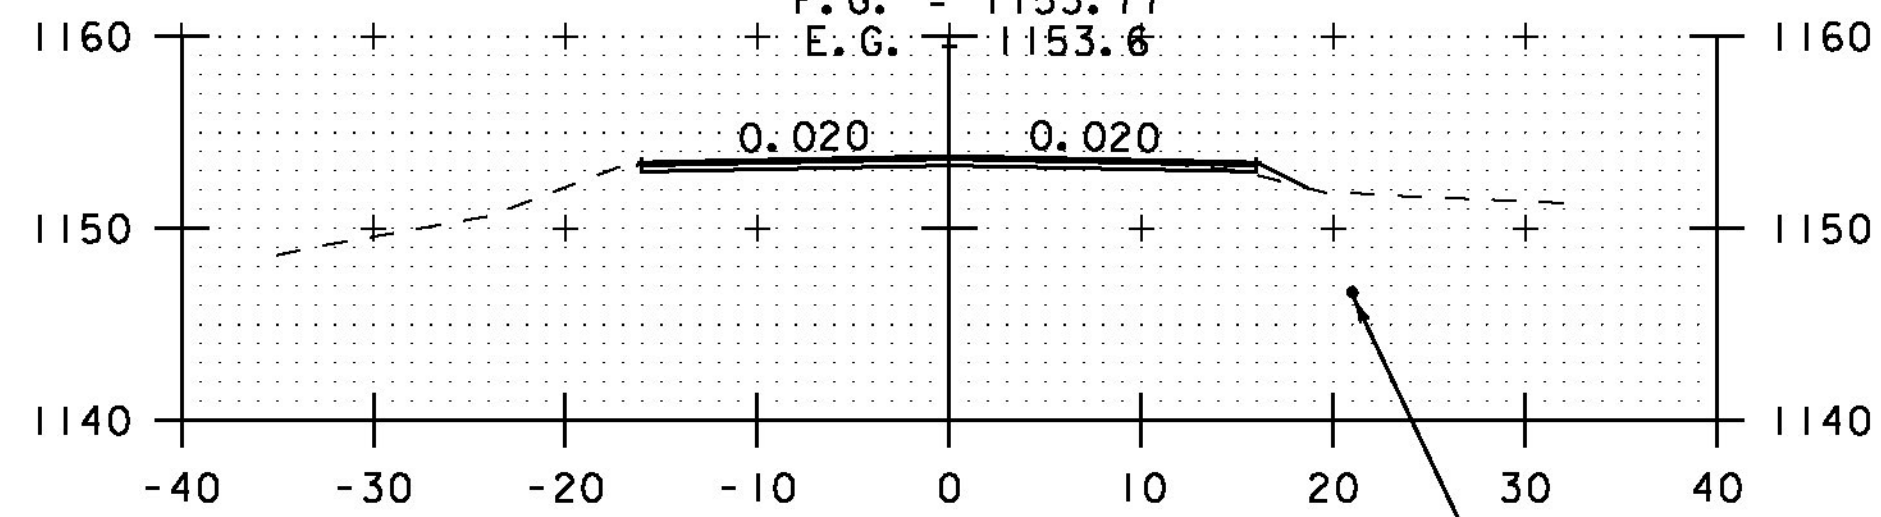


351+50

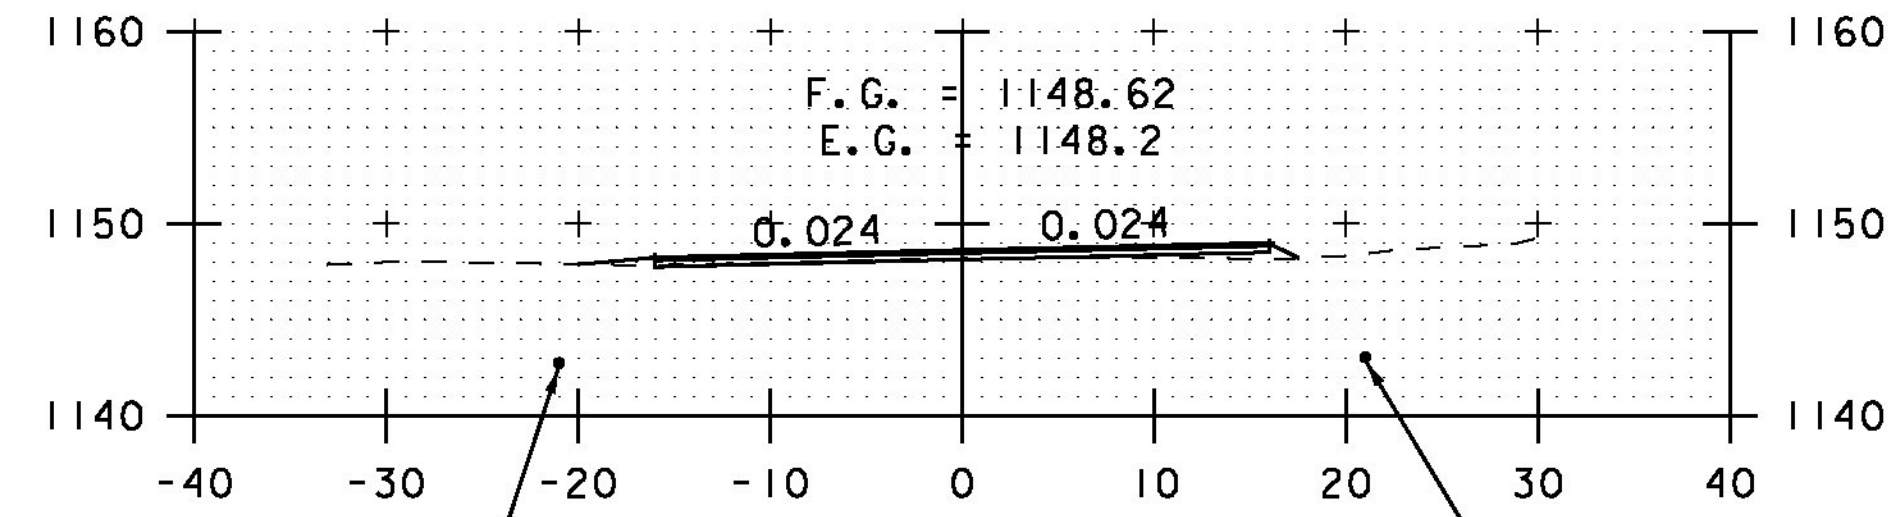


DRIVE LT
355+00

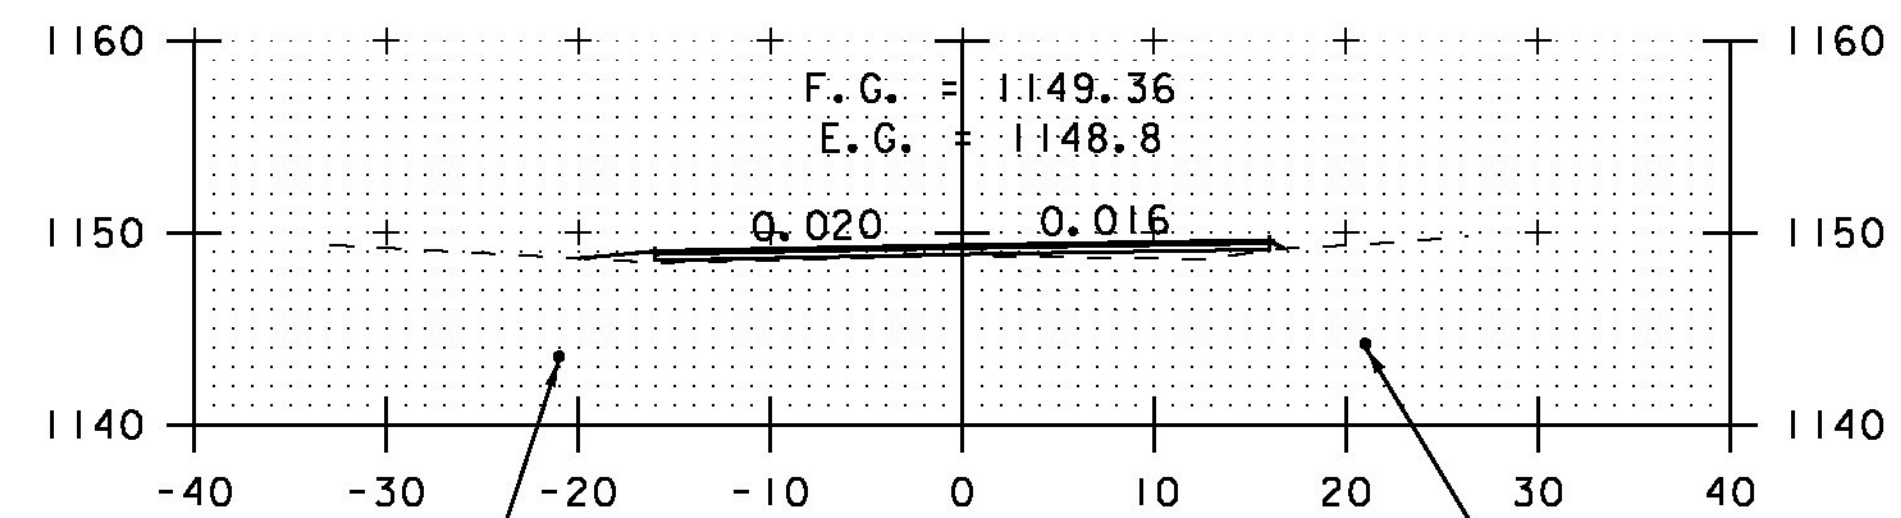

DRIVE LT
354+50

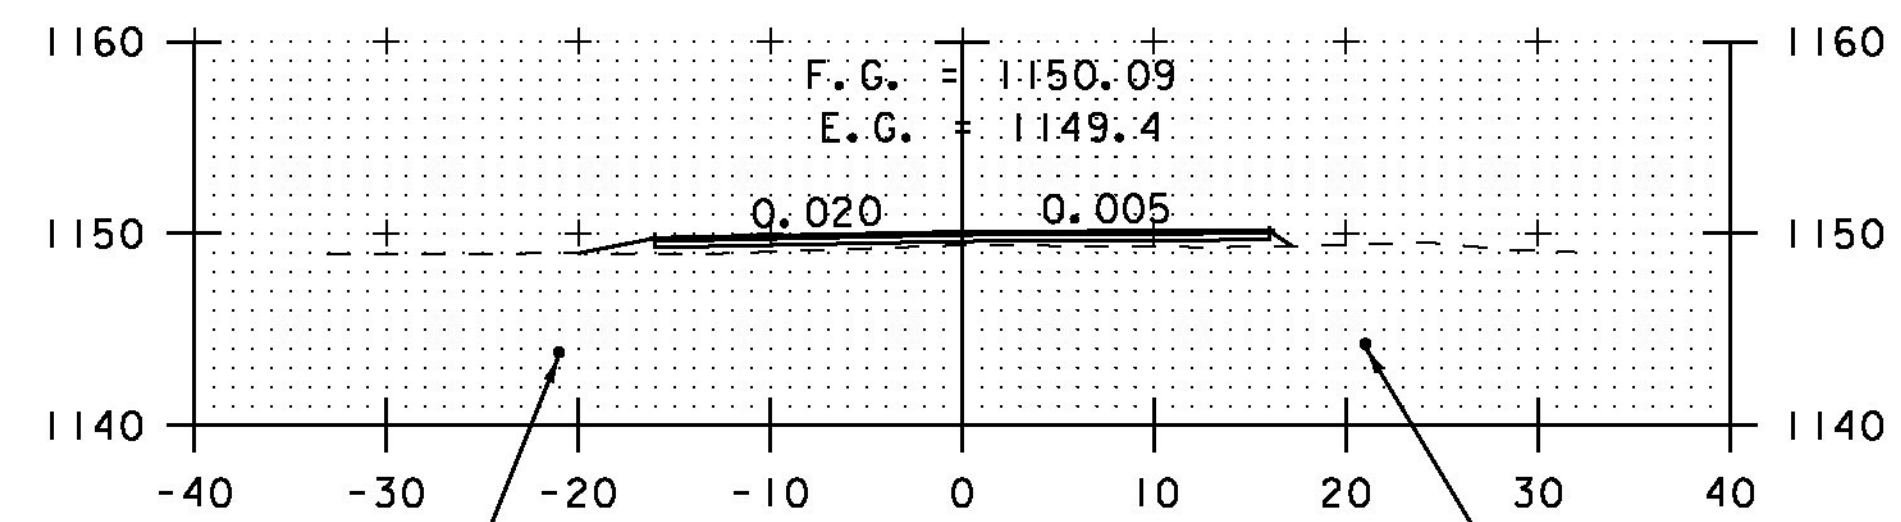

DRIVE LT
354+00

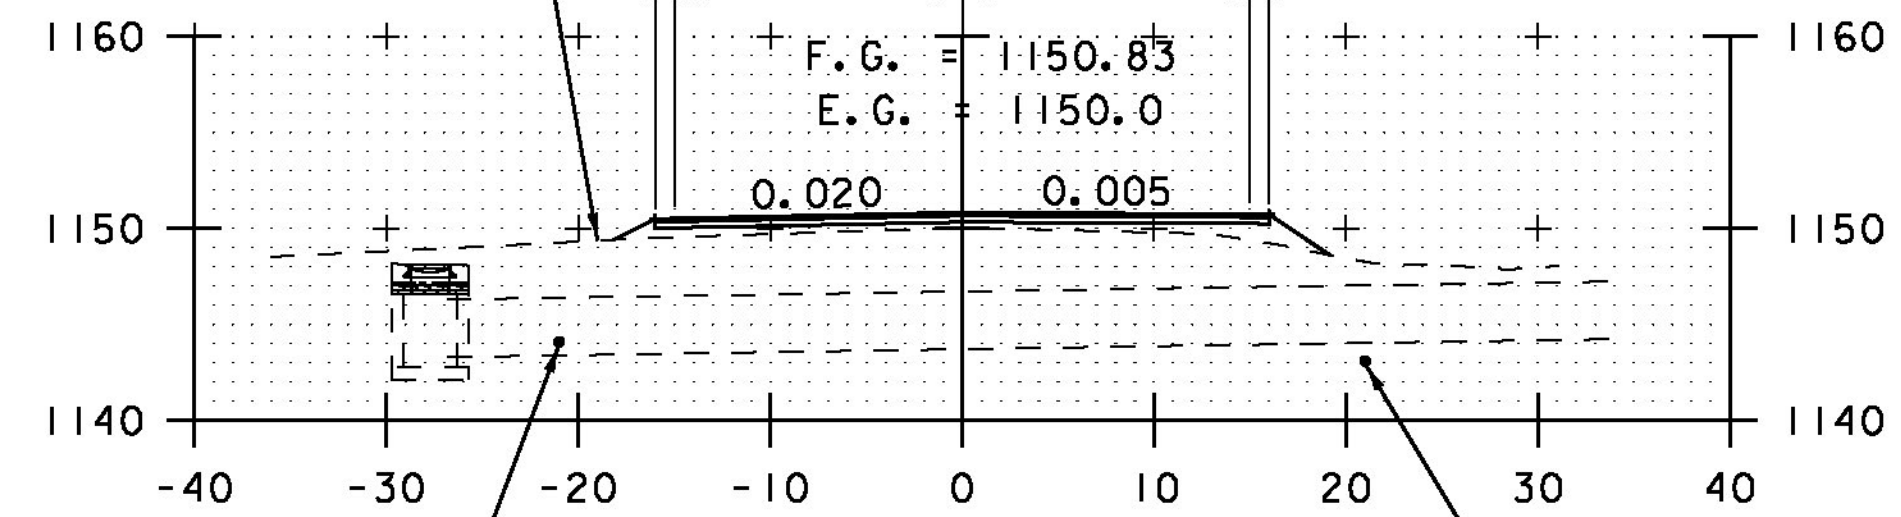

353+50

STA. 349+50 TO STA. 355+00



CROSS SECTION SHEET 30

PROJECT NAME: ELMORE-MORRISTOWN	PROJECT NUMBER: STP 2937 (1)
FILE NAME: z11c310.dgn	PLOT DATE: 3/3/14
PROJECT LEADER: C. LATHROP	DRAWN BY: B. MARTIN
DESIGNED BY: S. LAMPHERE	CHECKED BY: C. LATHROP
PLOT FILE: z11c310_158.i	SHEET 158 OF 194