




368+50

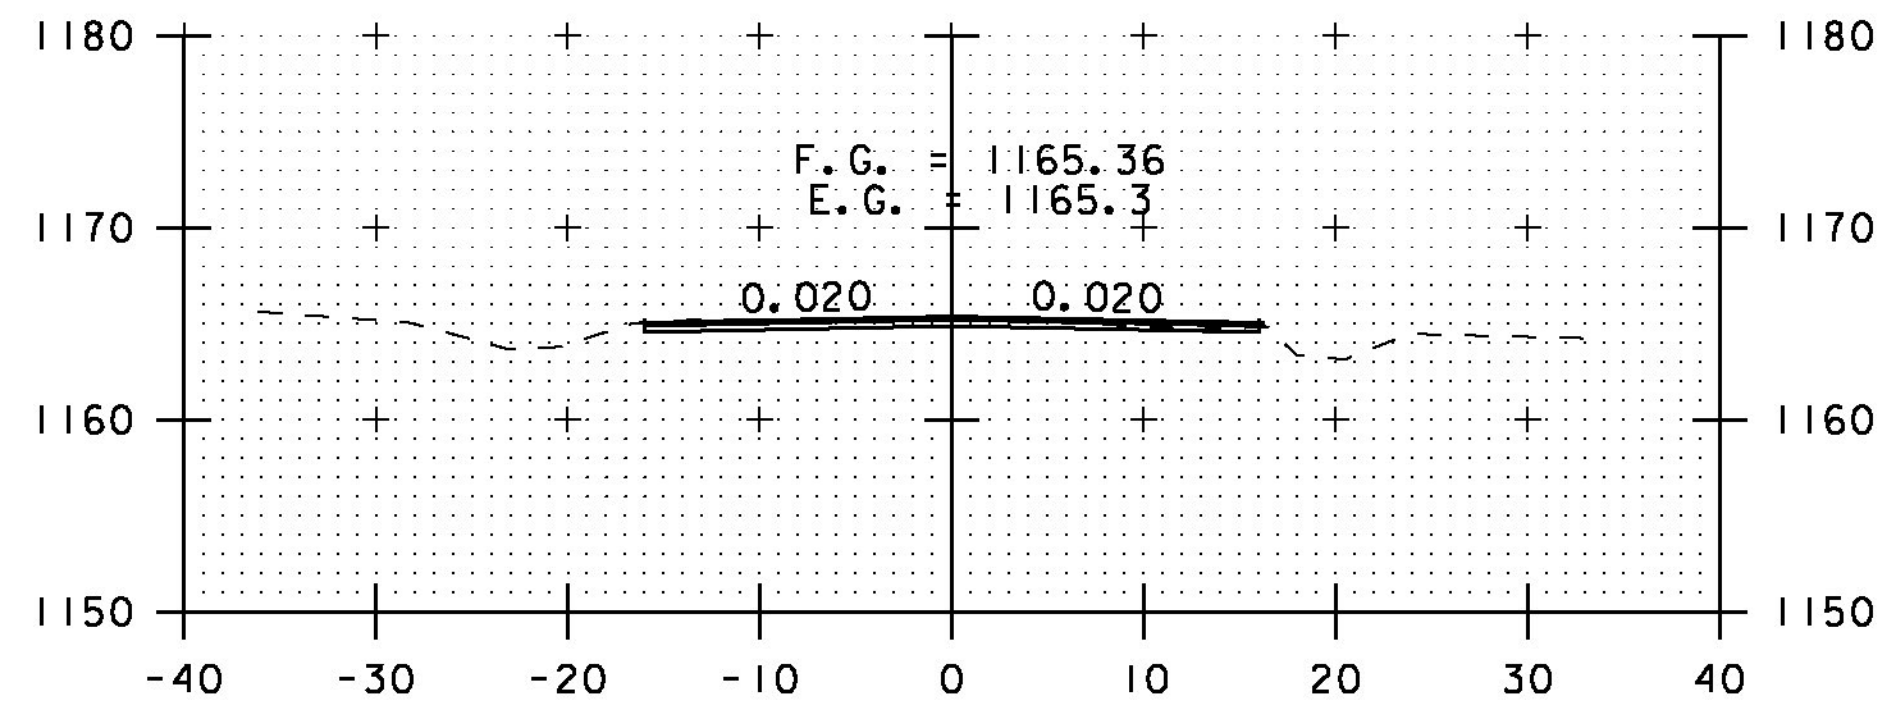


368+00

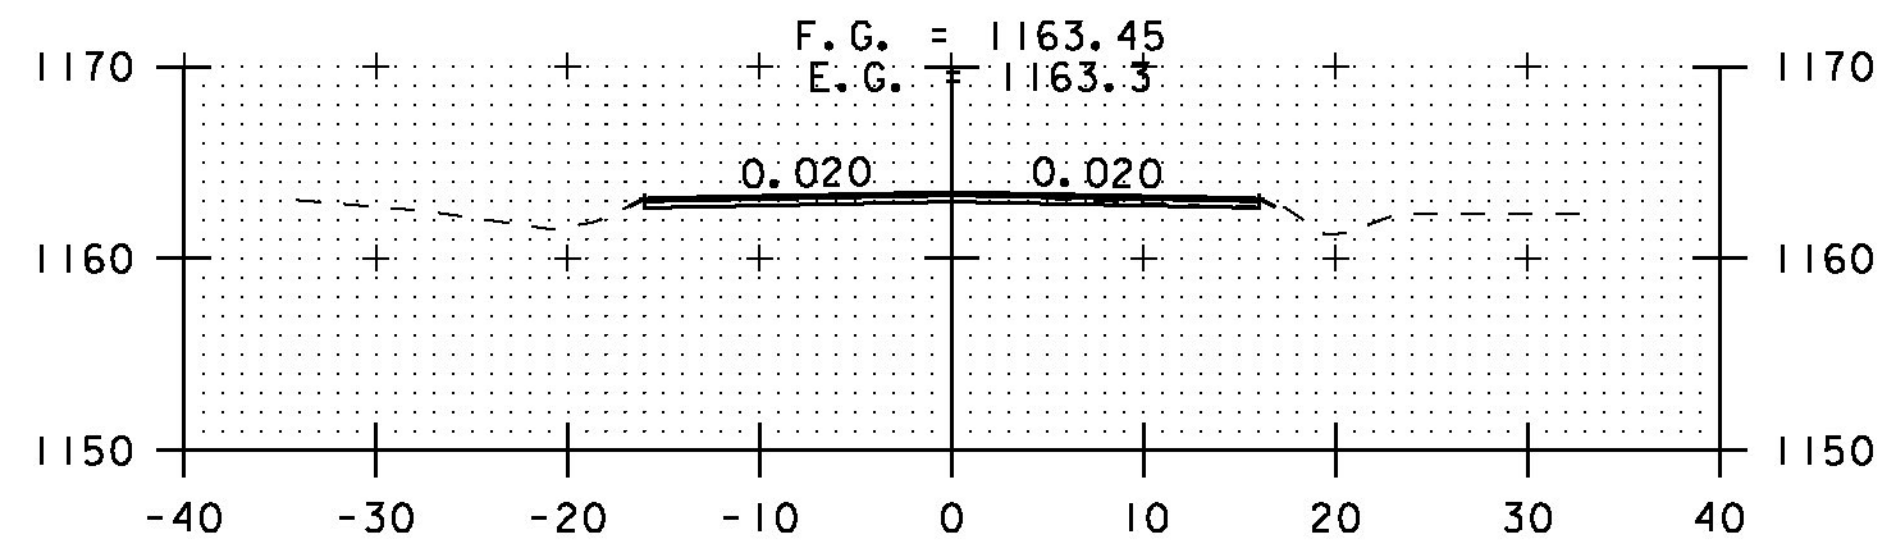


367+50

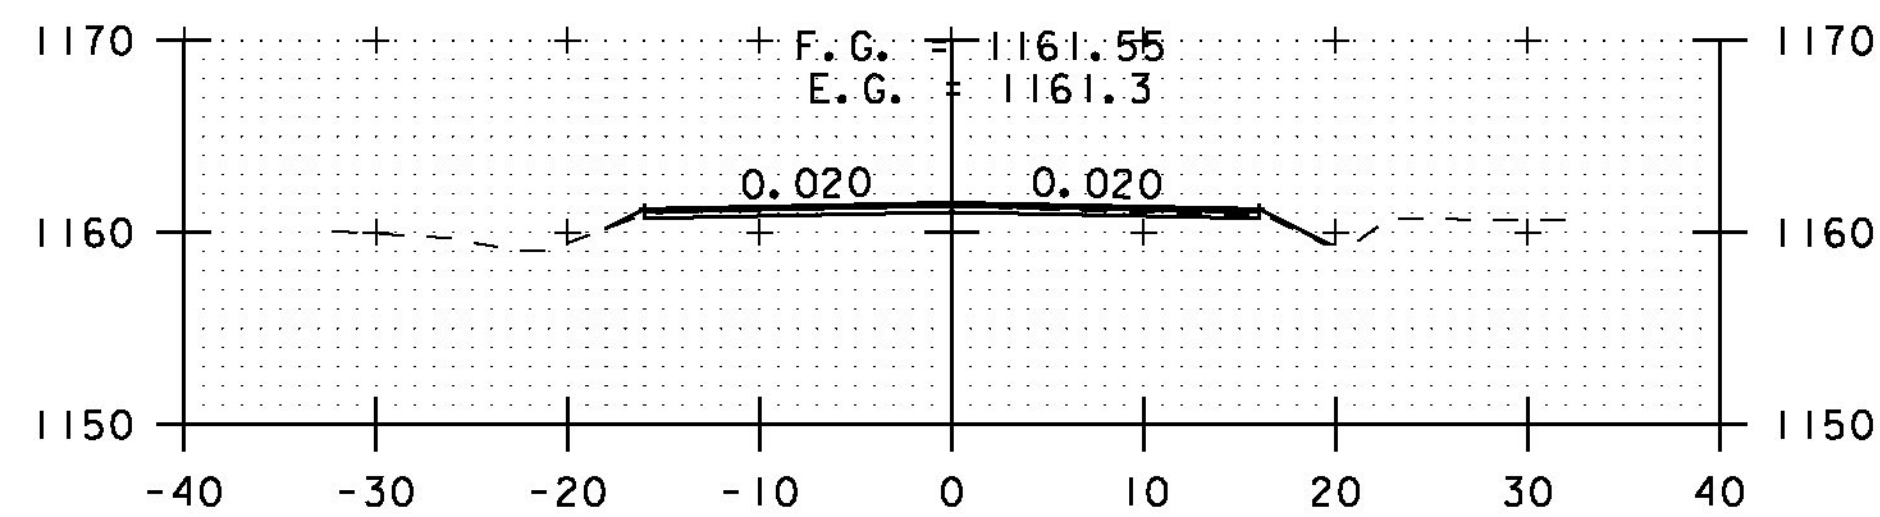


367+00

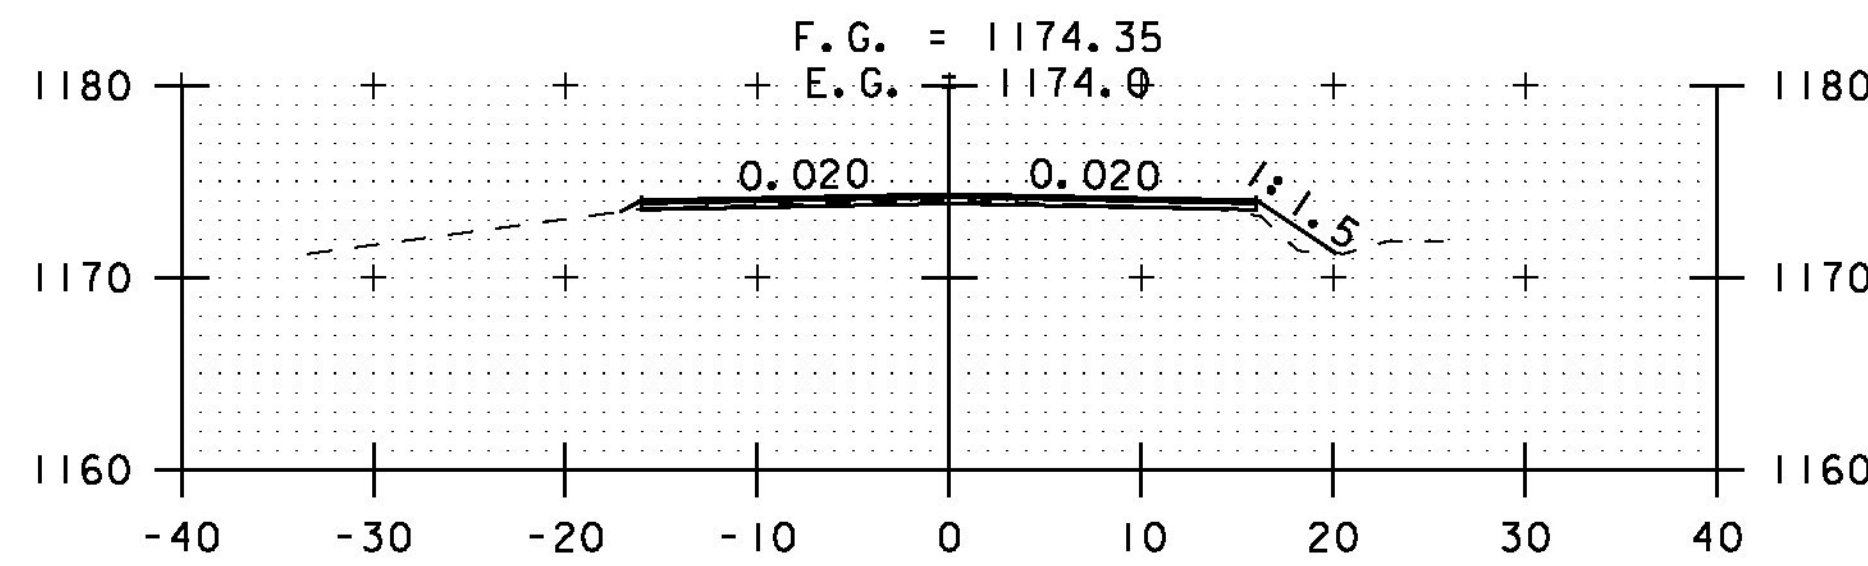


370+50

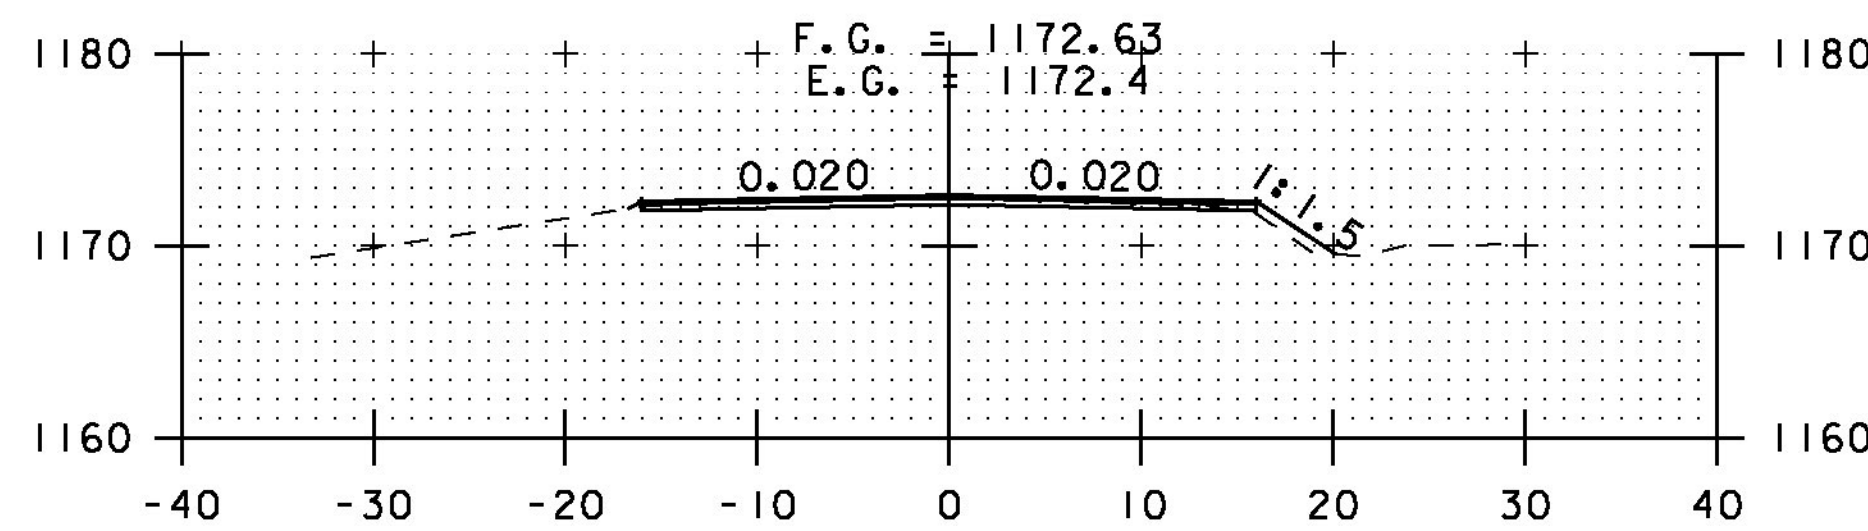


370+00

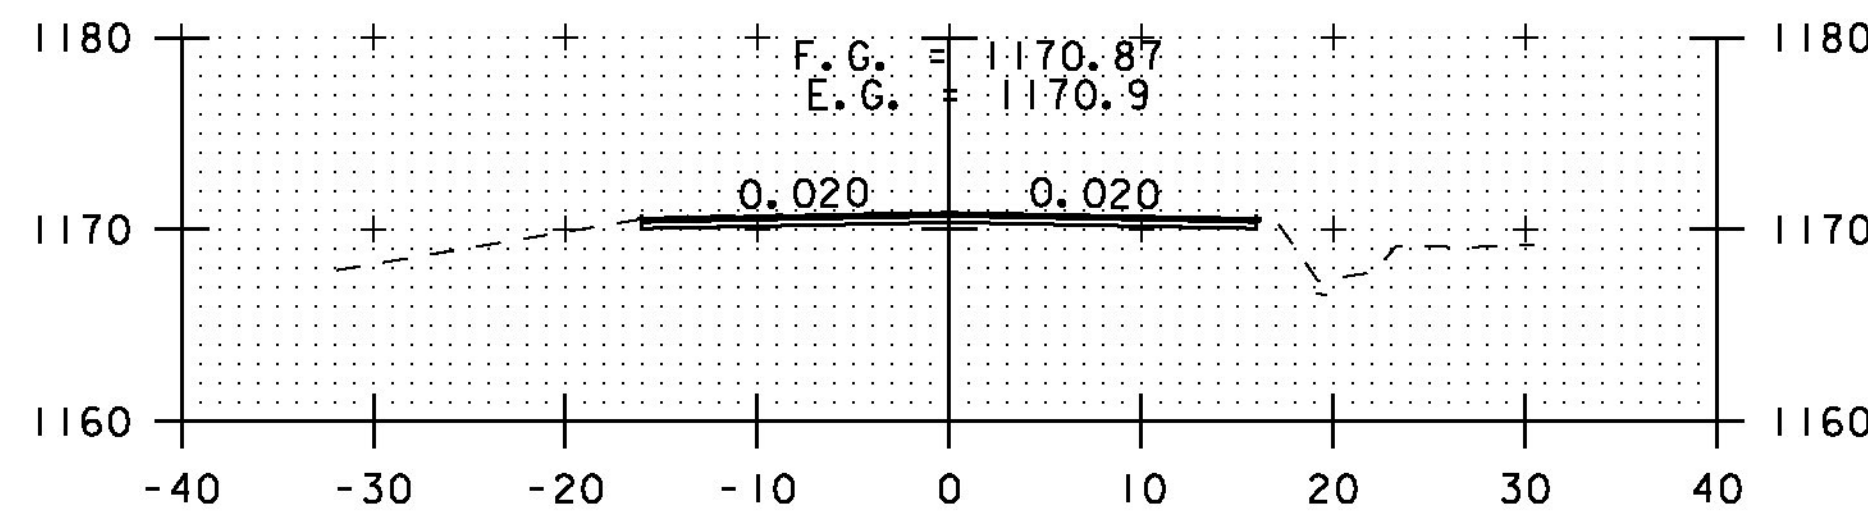


369+50

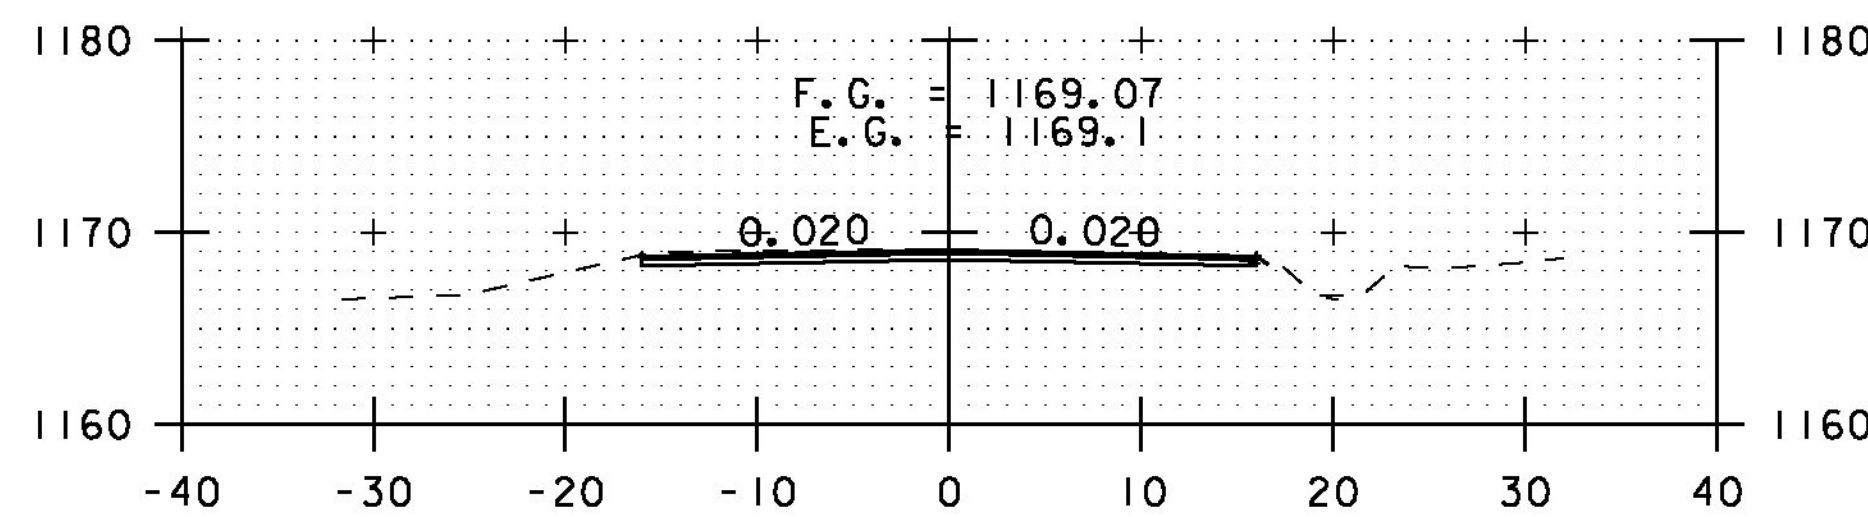


369+00

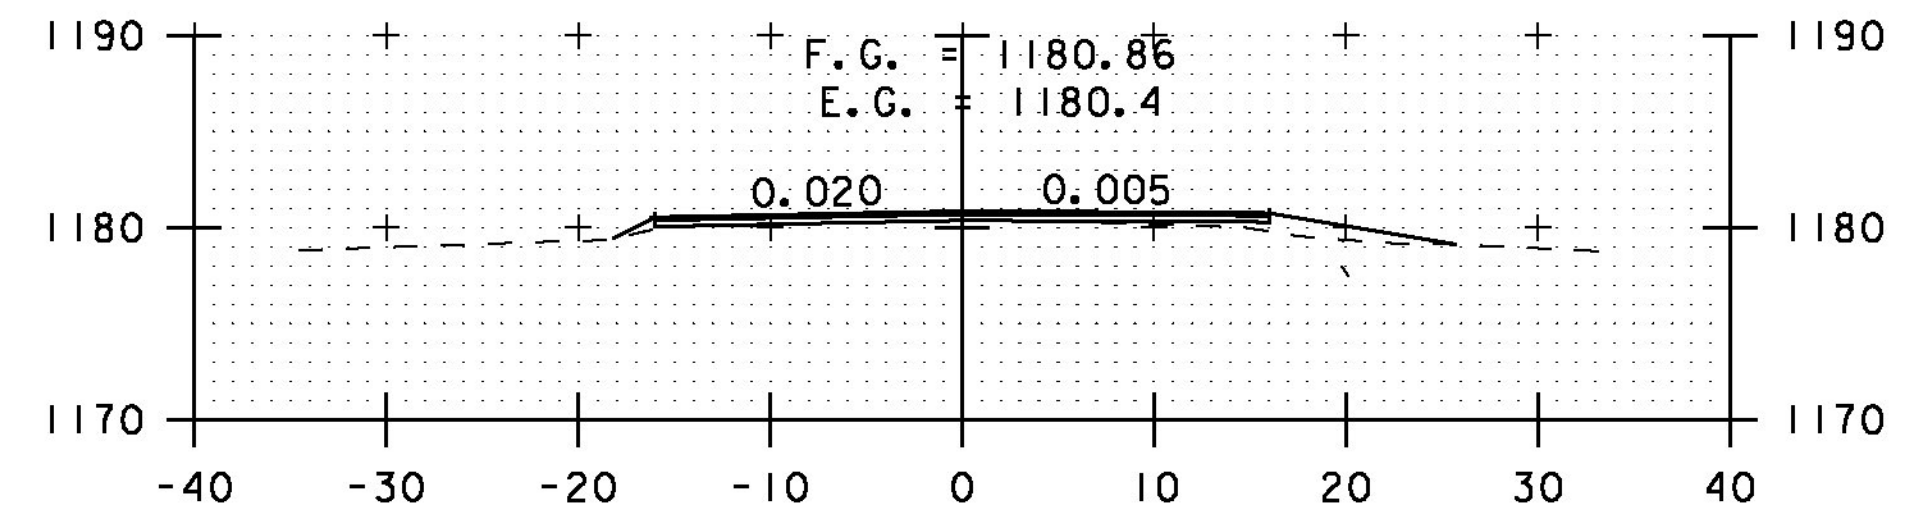


DRIVE RT  
372+50

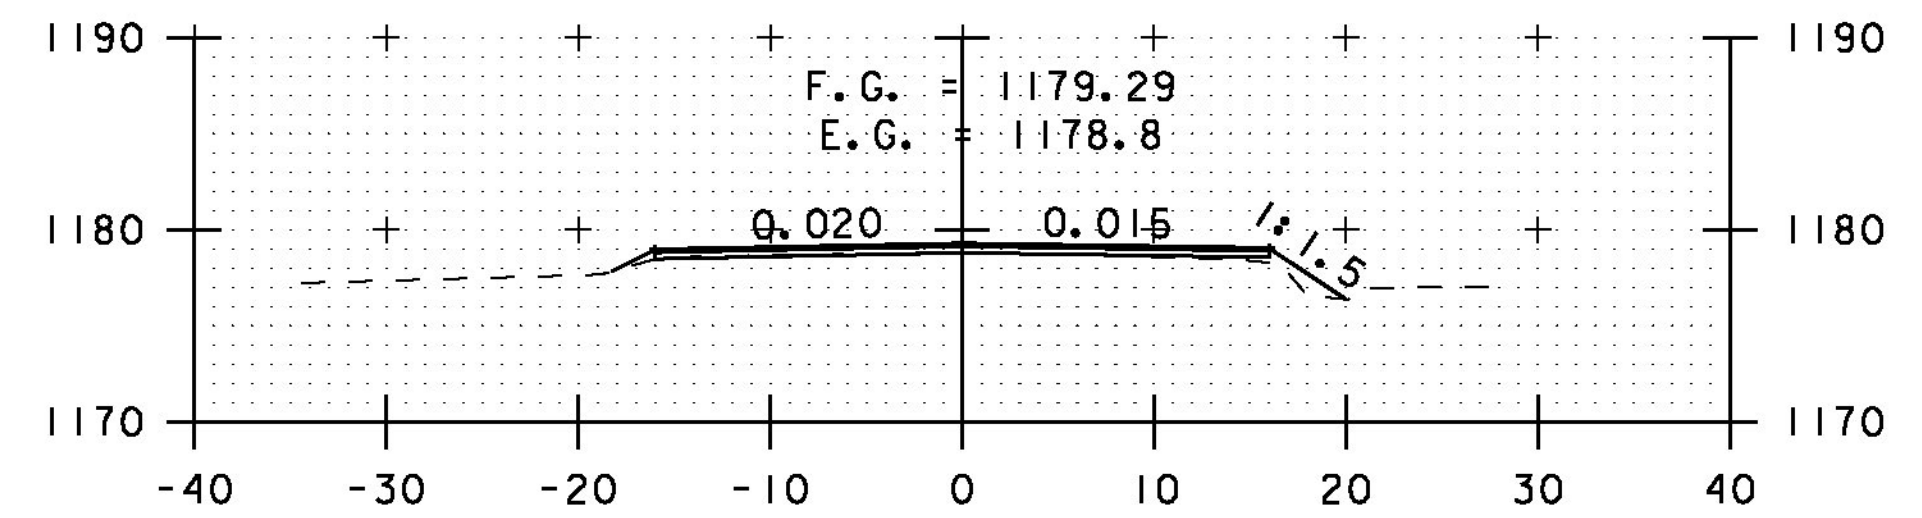

372+00

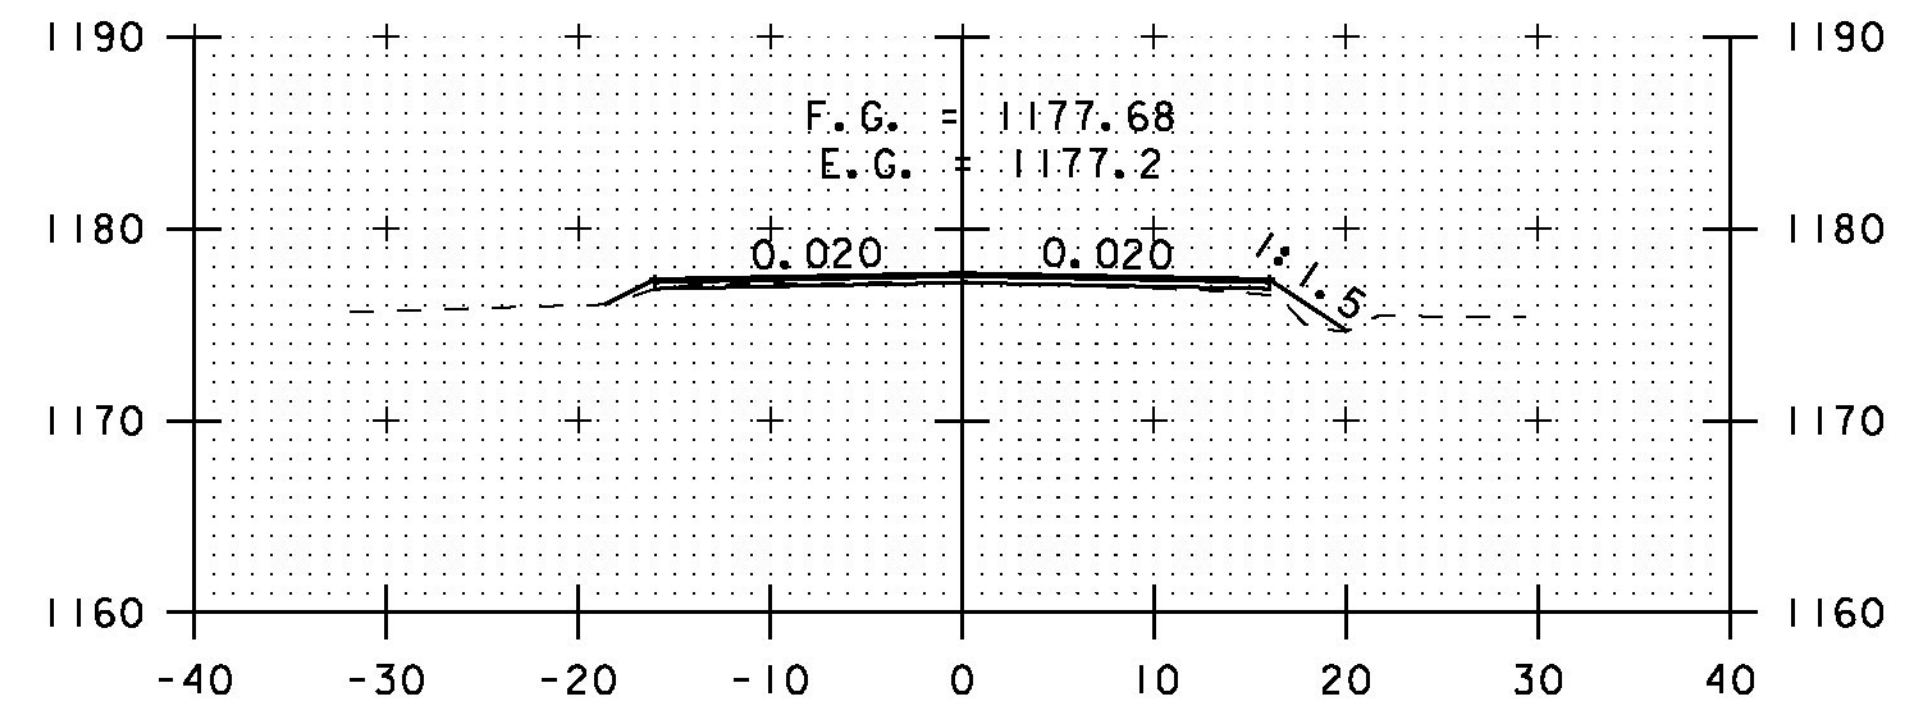

371+50

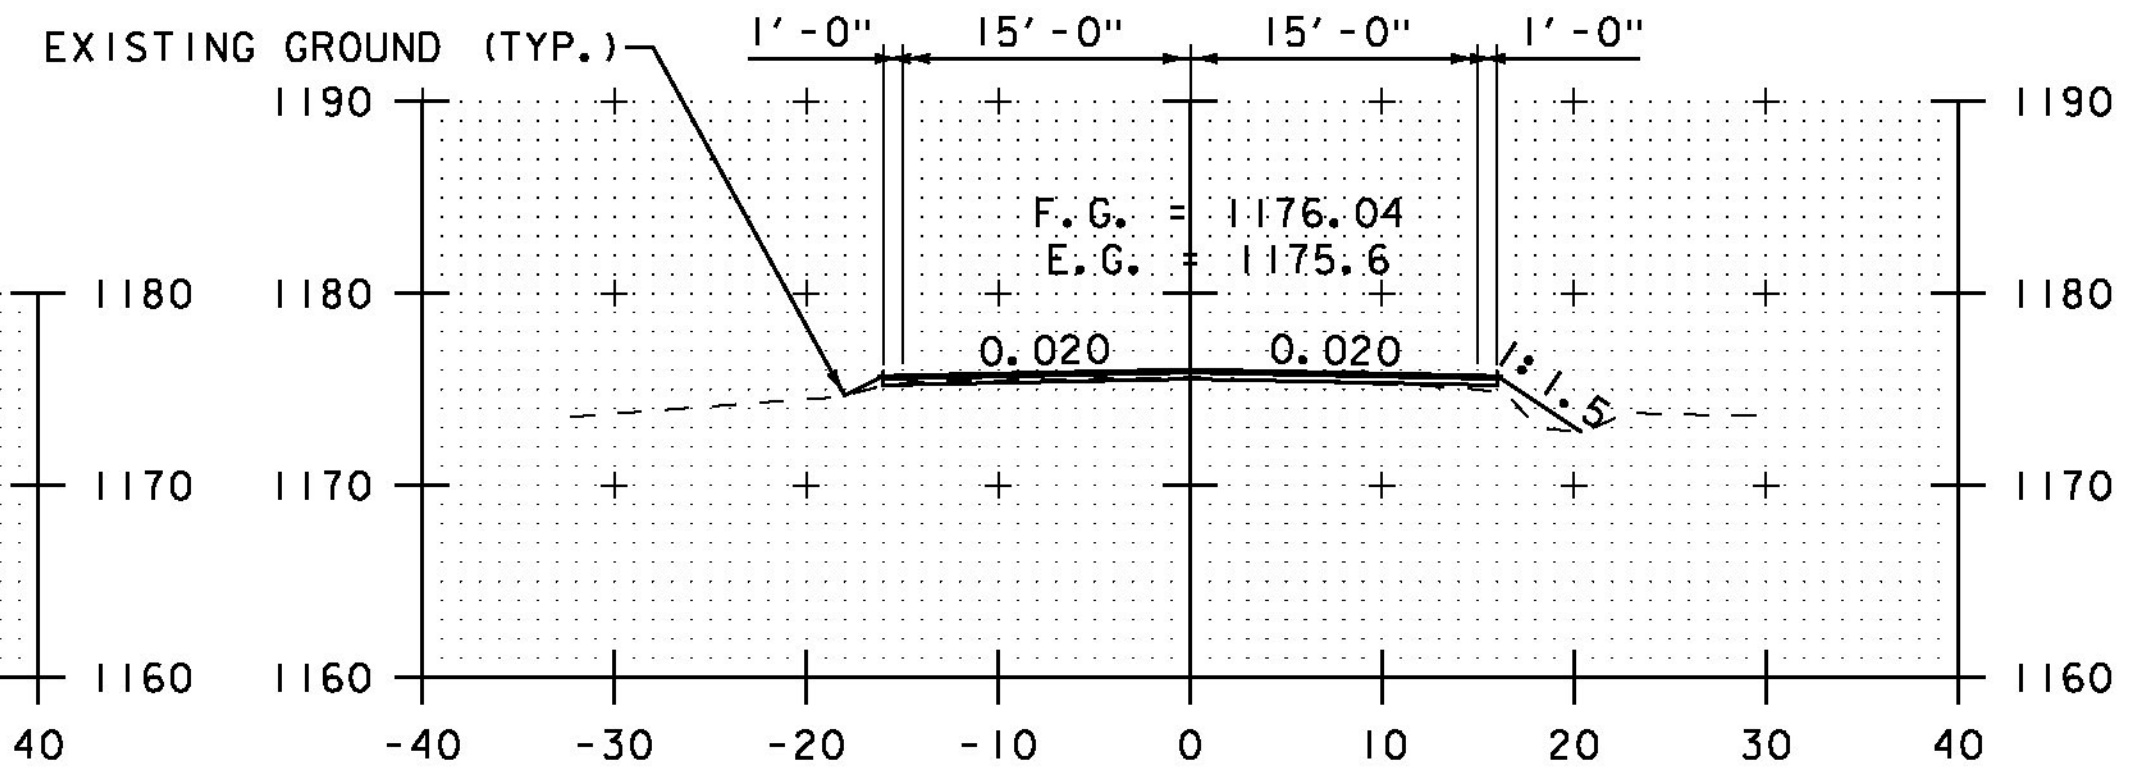

371+00

STA. 367+00 TO STA. 372+50



**CROSS SECTION SHEET 33**

PROJECT NAME: ELMORE-MORRISTOWN

PROJECT NUMBER: STP 2937 (1)

FILE NAME: z11c310.dgn

PROJECT LEADER: C. LATHROP

DESIGNED BY: S. LAMPHERE

PLOT FILE: z11c310\_161.i

PLOT DATE: 3/3/14

DRAWN BY: B. MARTIN

CHECKED BY: C. LATHROP

SHEET 161 OF 194