




374+50

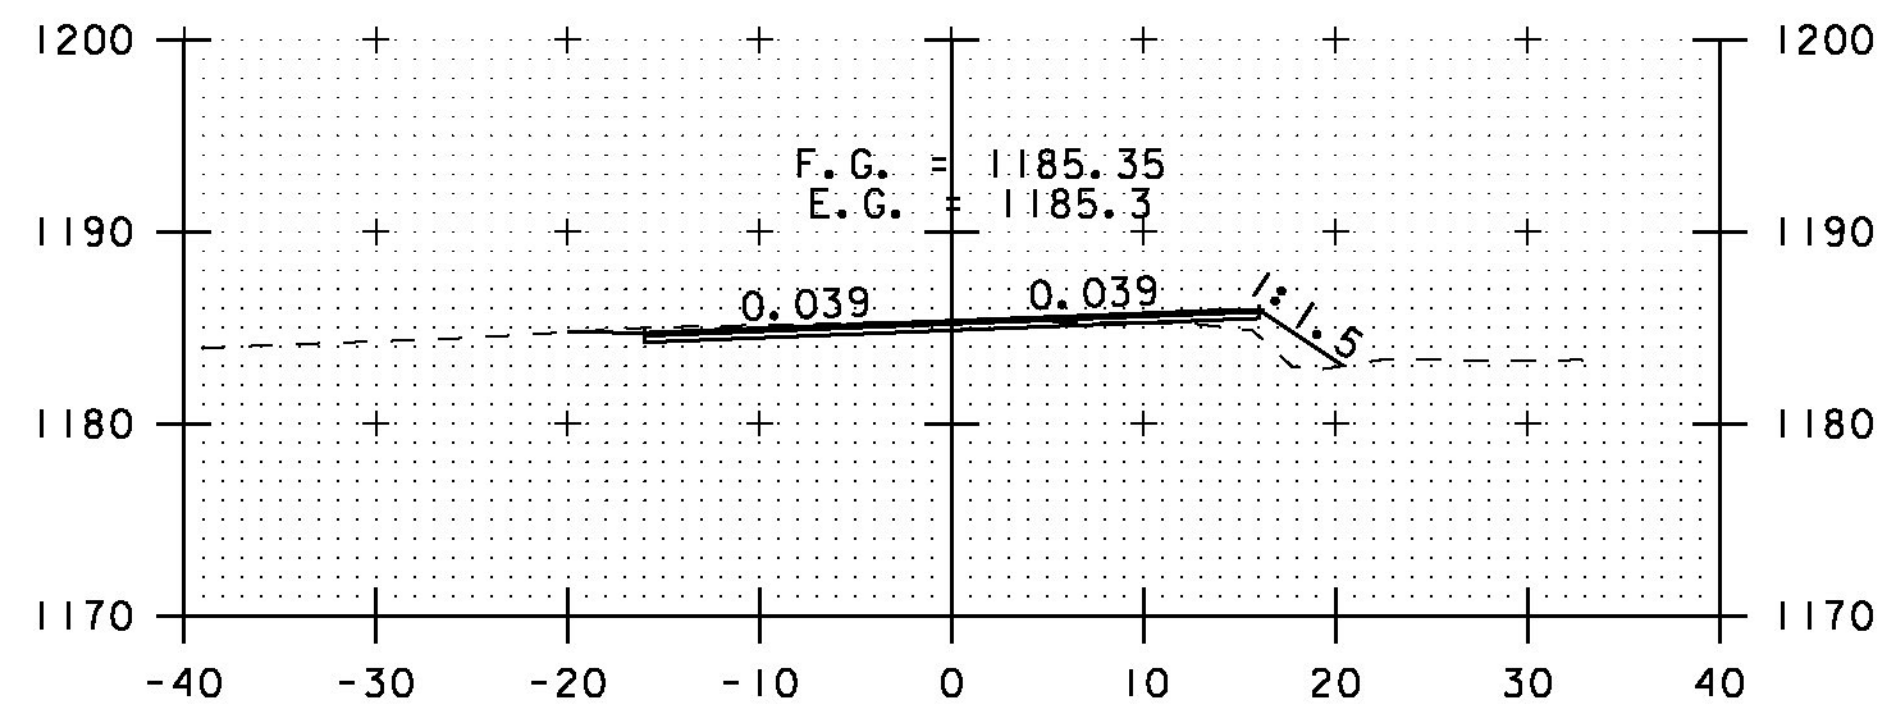


DRIVE LT
374+00

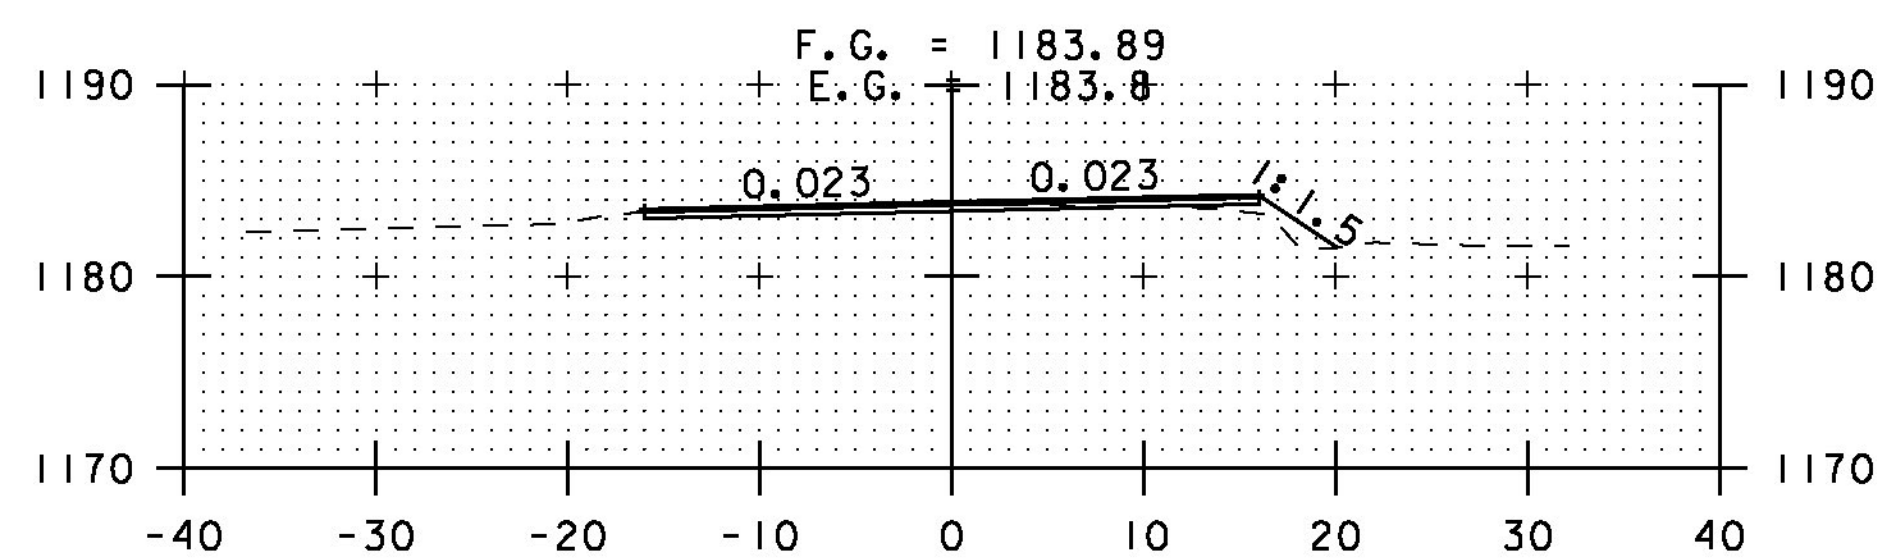


373+50

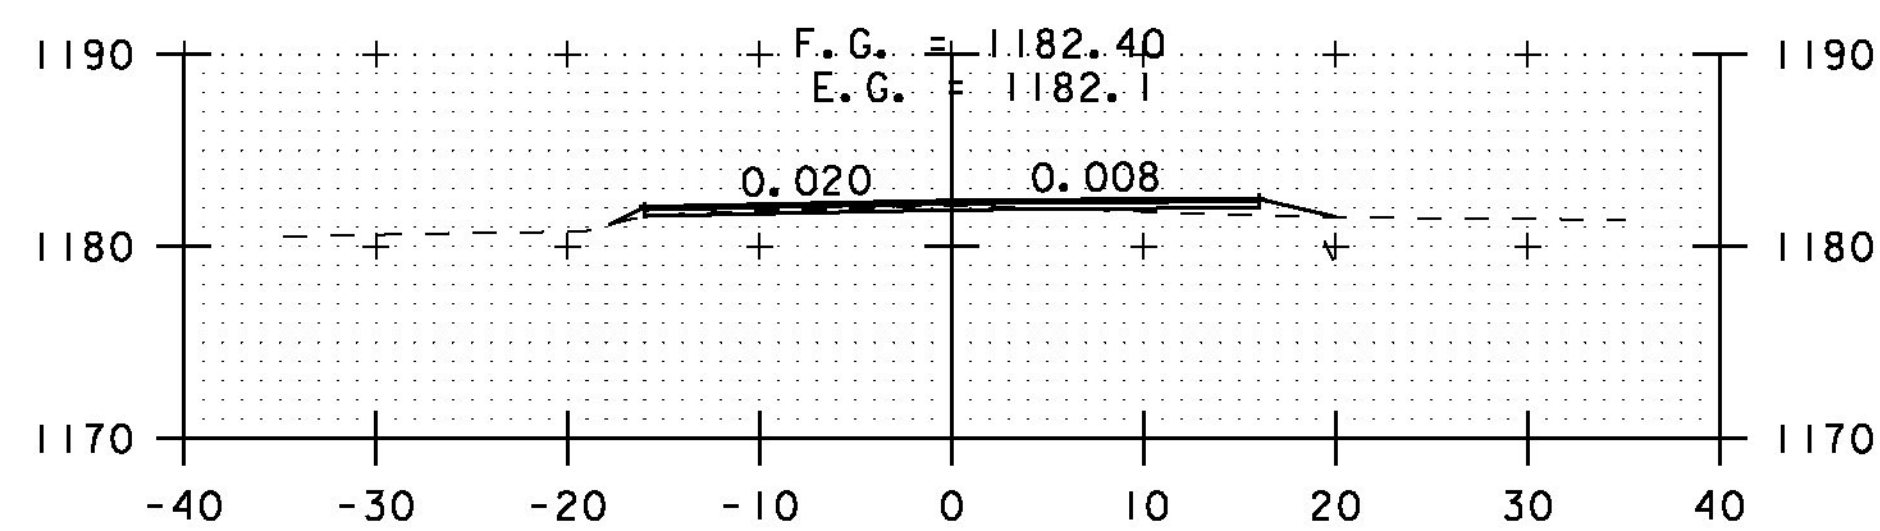


DRIVE RT
373+00

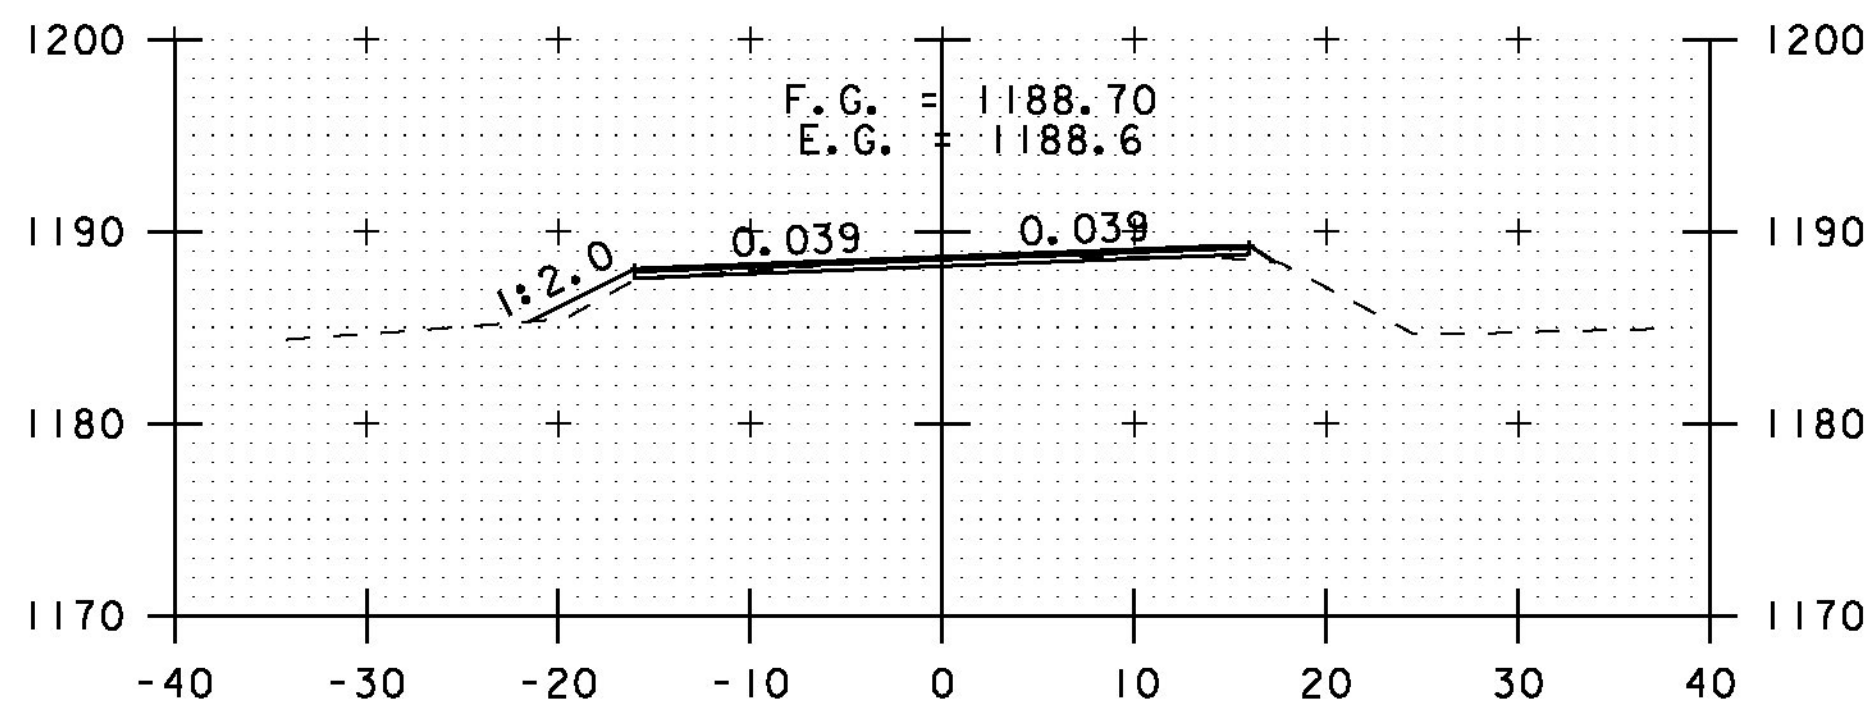


376+00

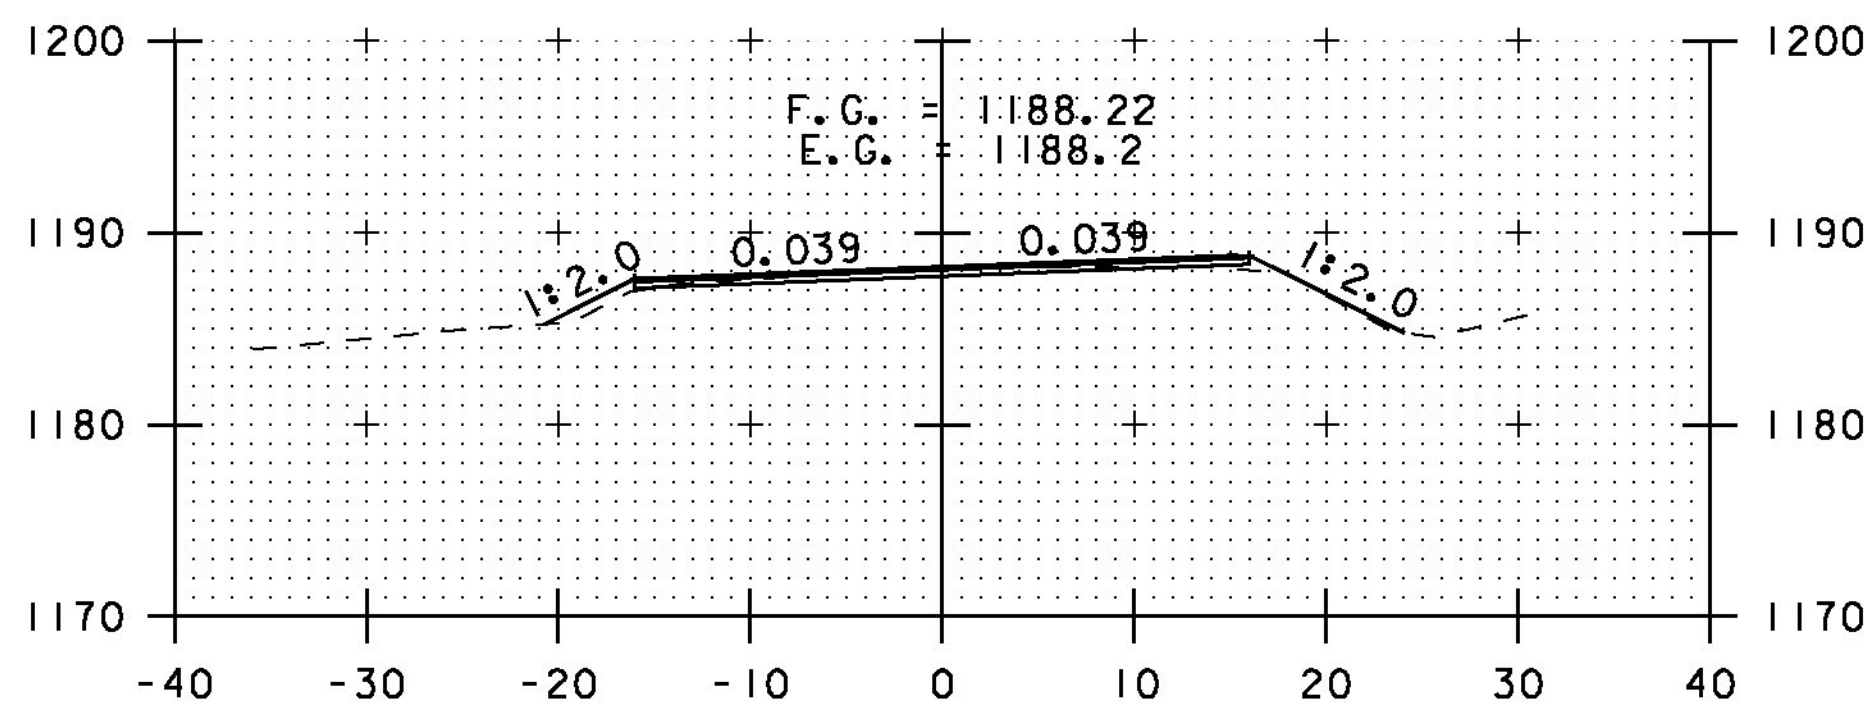


375+50

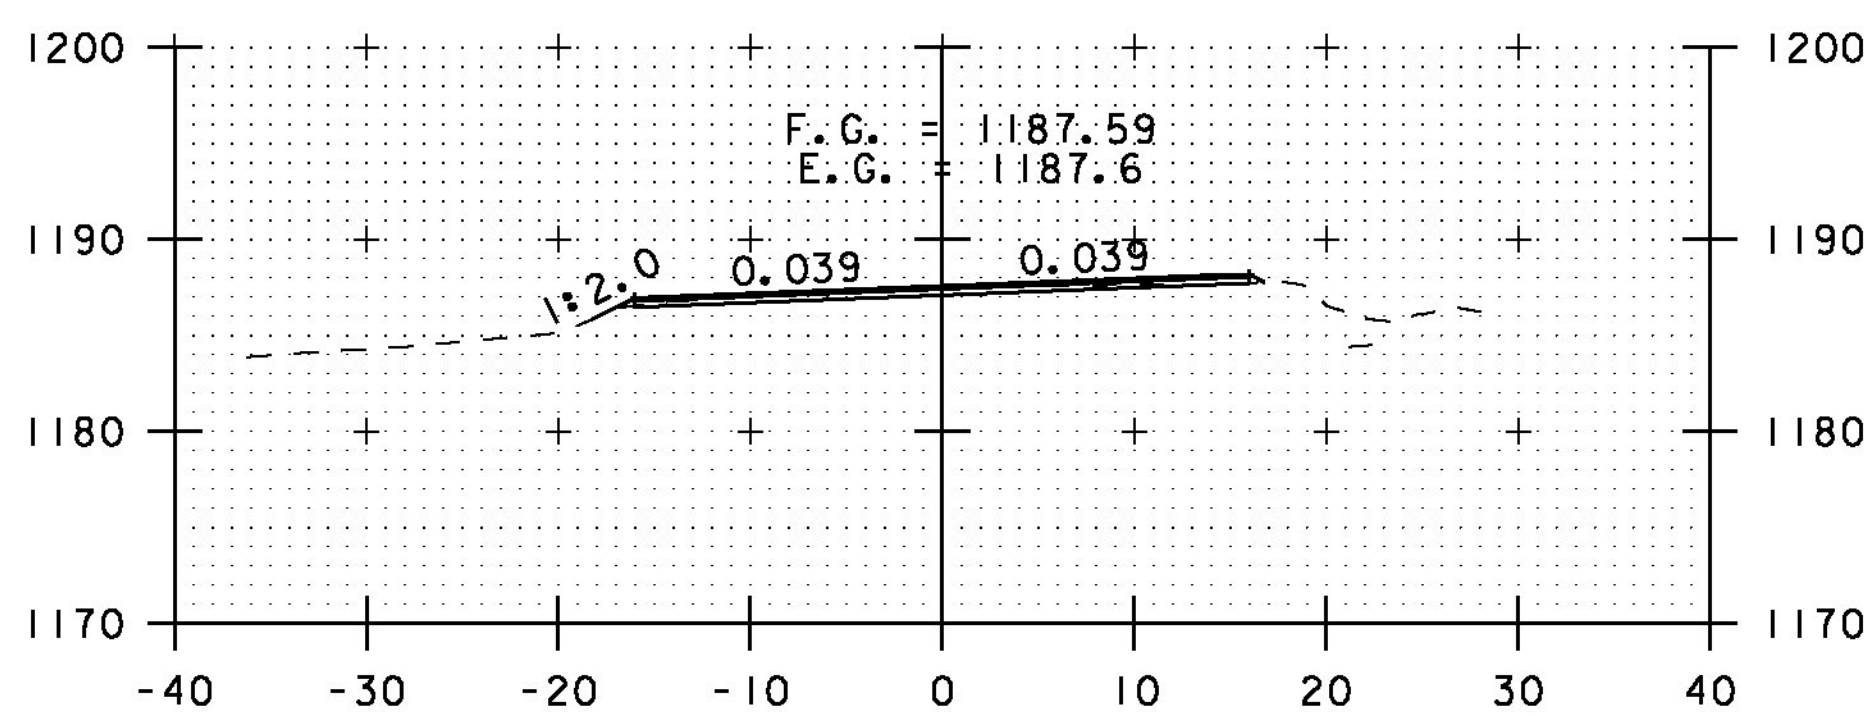


375+00

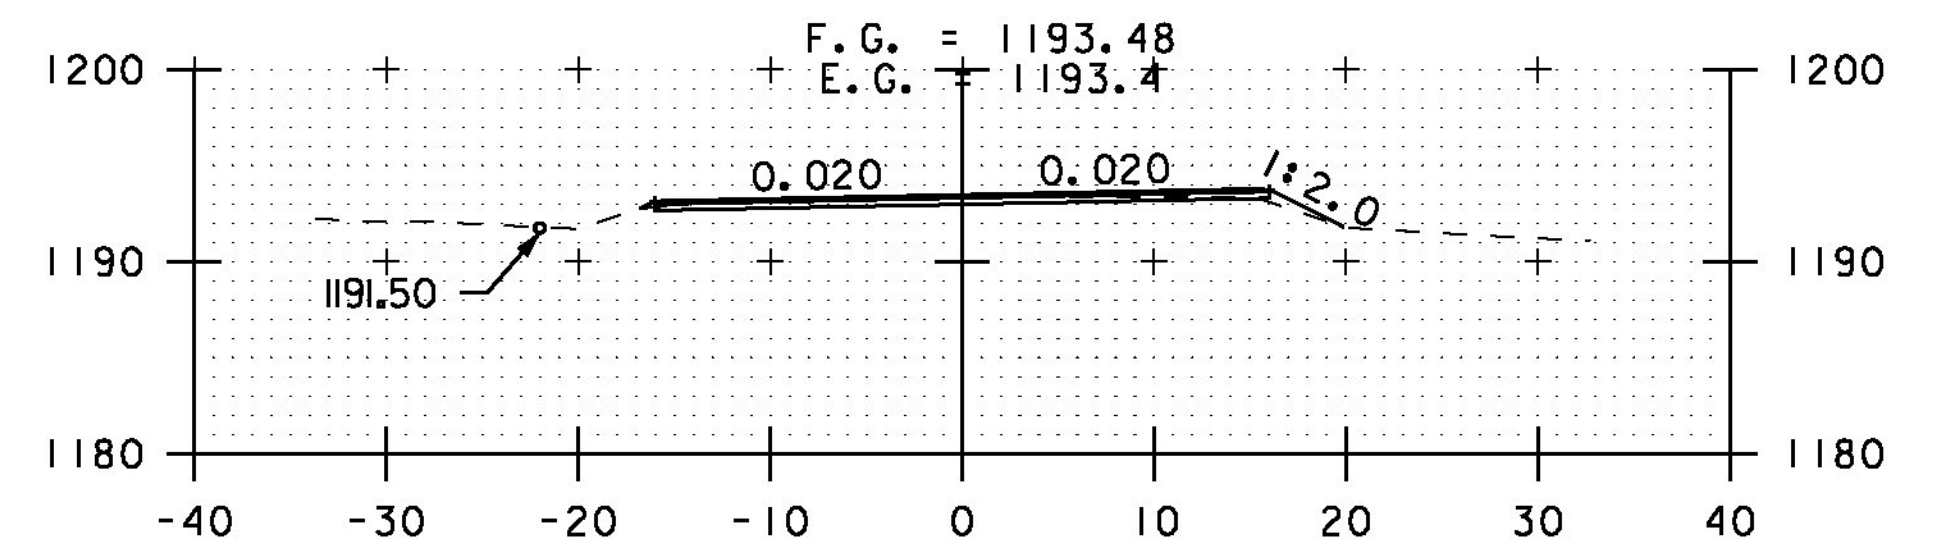


378+00

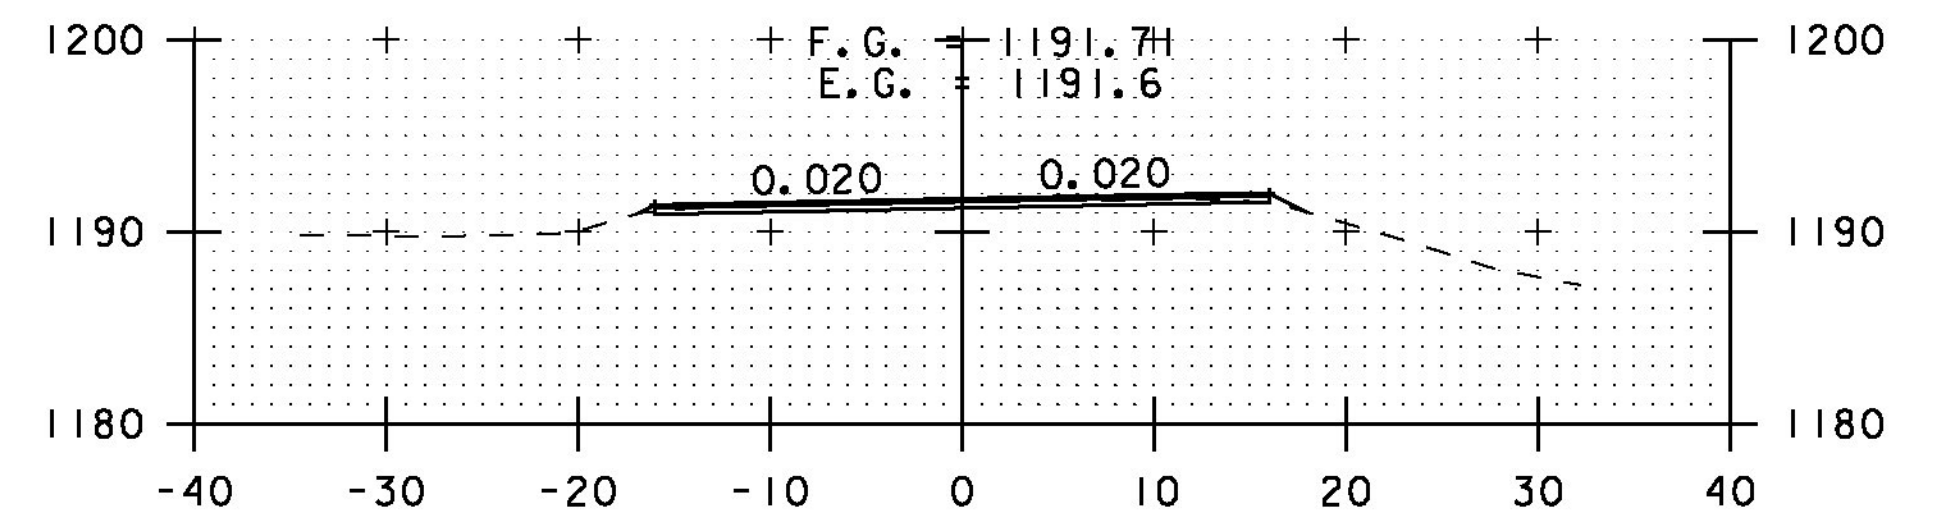

377+50

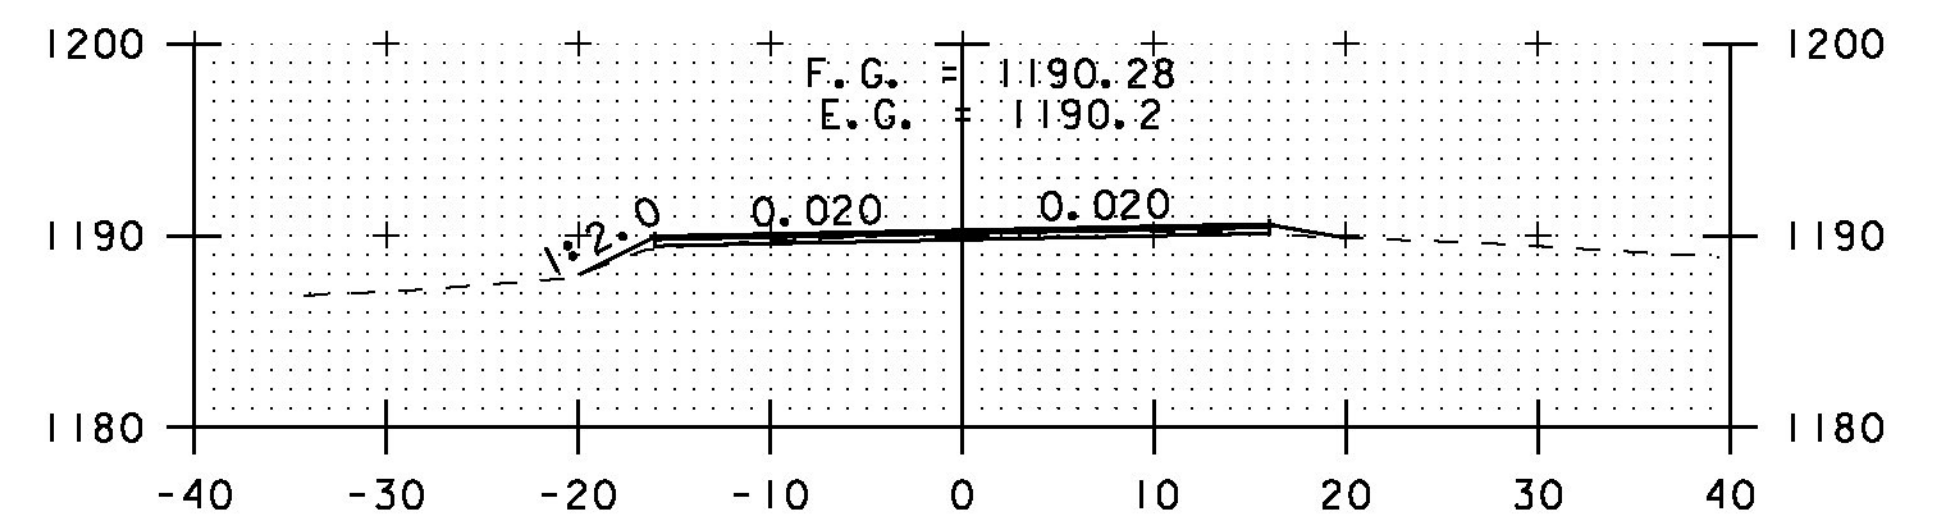

DRIVE RT
377+00

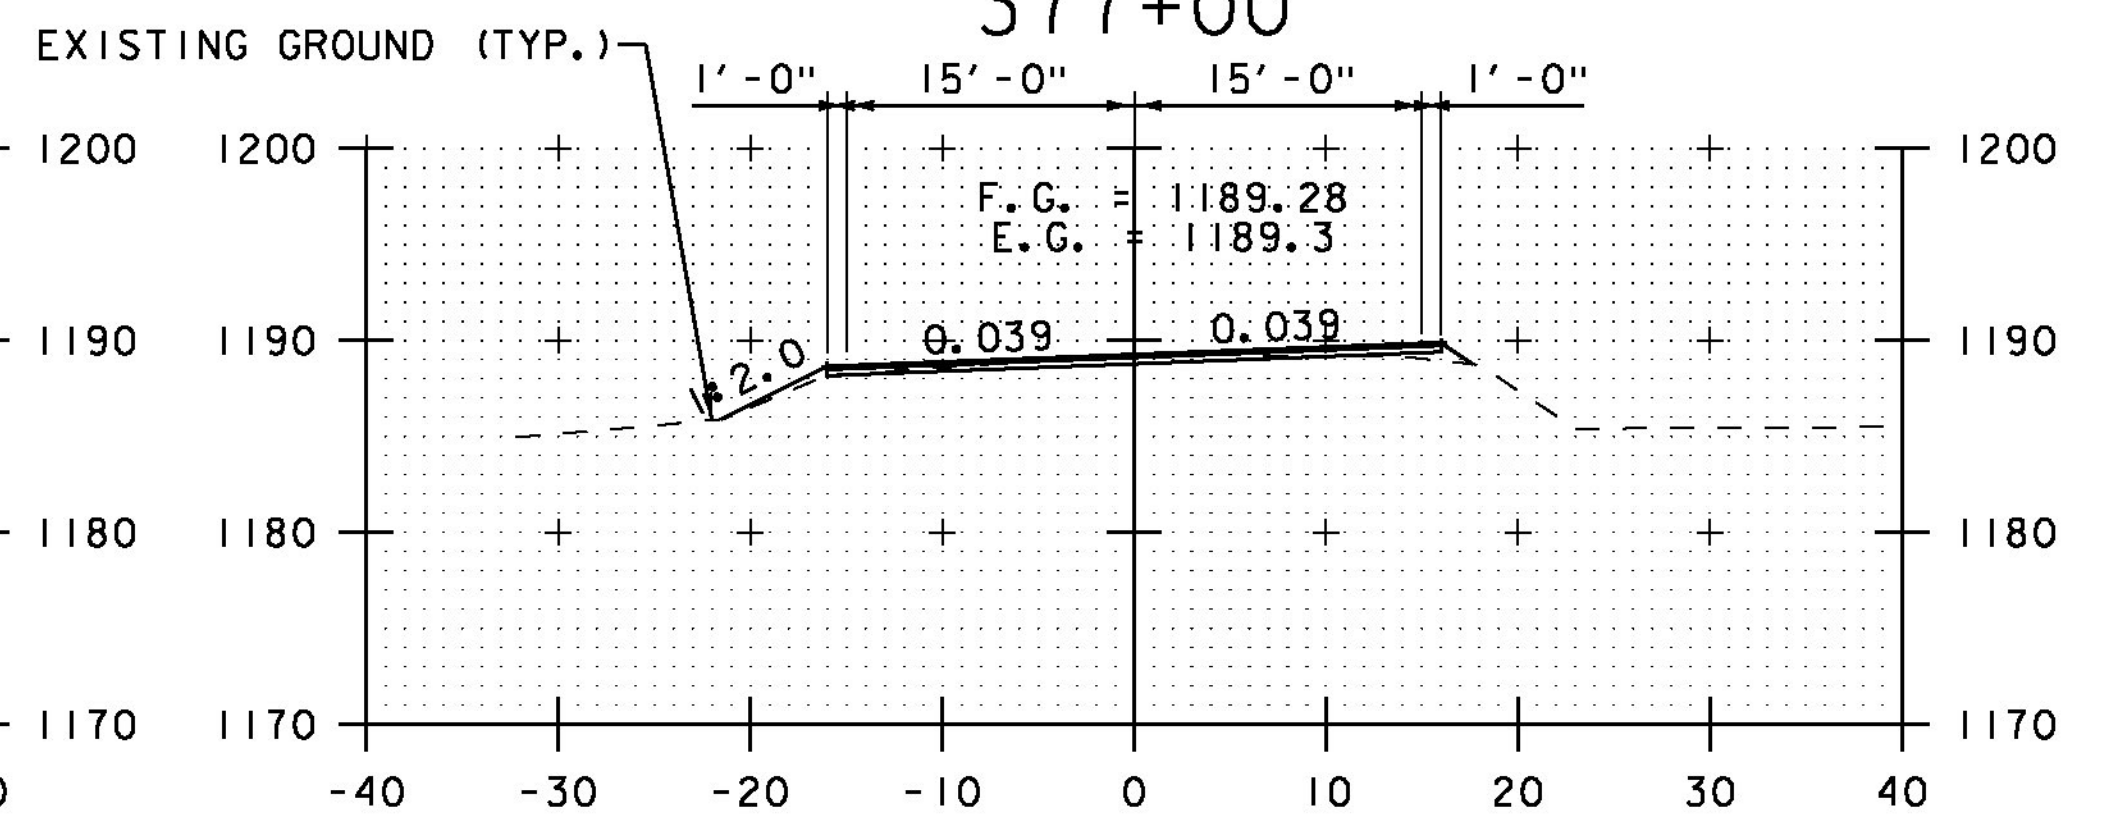

376+50

STA. 373+00 TO STA. 378+00



CROSS SECTION SHEET 34

PROJECT NAME: ELMORE-MORRISTOWN

PROJECT NUMBER: STP 2937 (1)

FILE NAME: z11c310.dgn

PROJECT LEADER: C. LATHROP

DESIGNED BY: S. LAMPHERE

PLOT FILE: z11c310_162.i

PLOT DATE: 3/3/14

DRAWN BY: B. MARTIN

CHECKED BY: C. LATHROP

SHEET 162 OF 194