



386+00




388+00

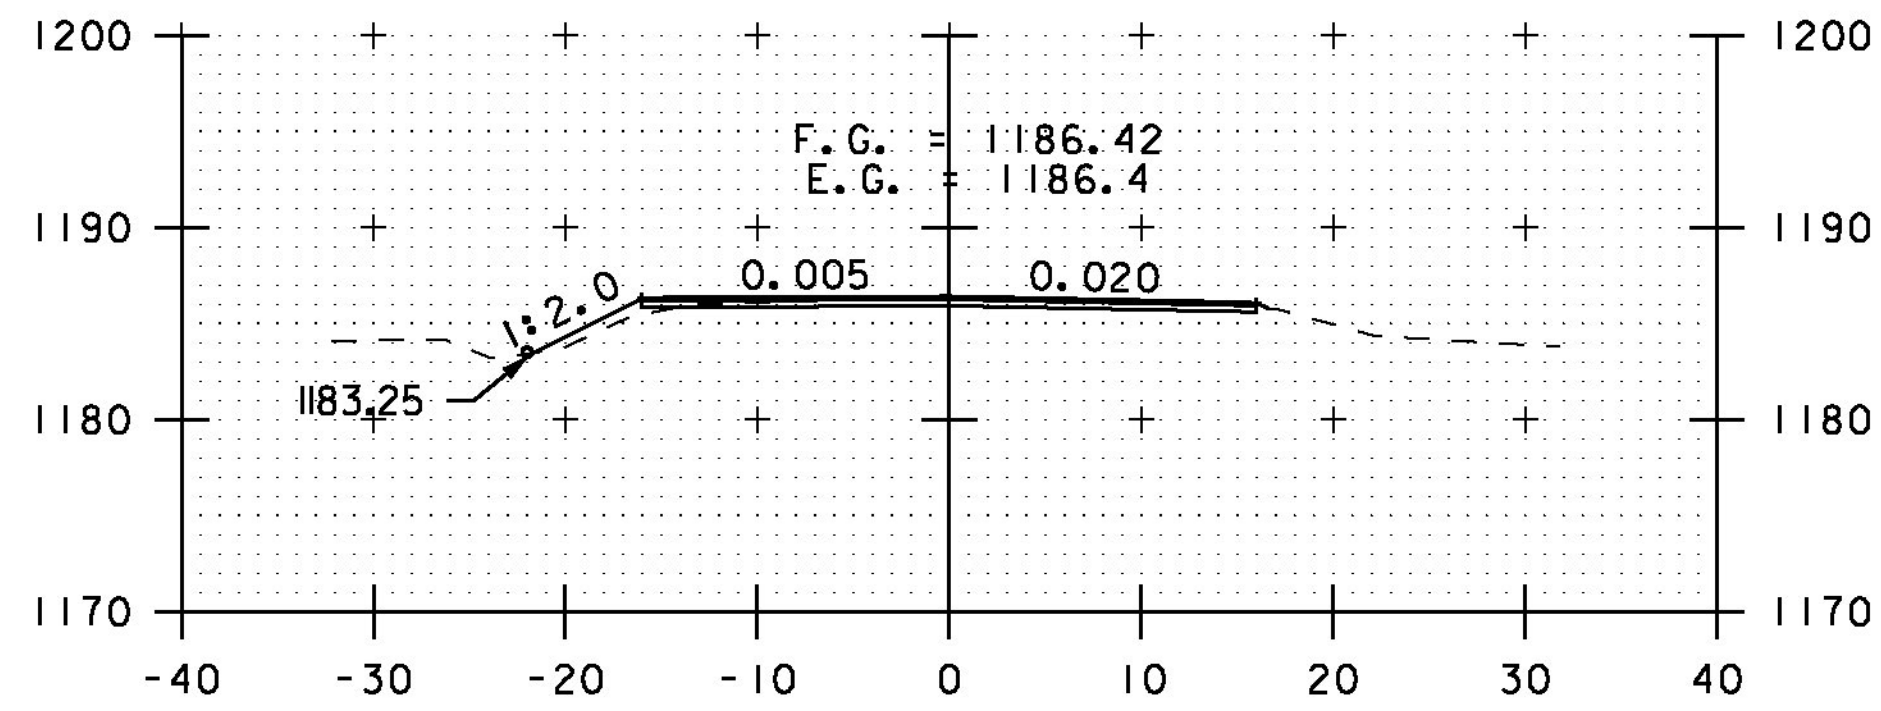


DRIVE RT
390+00

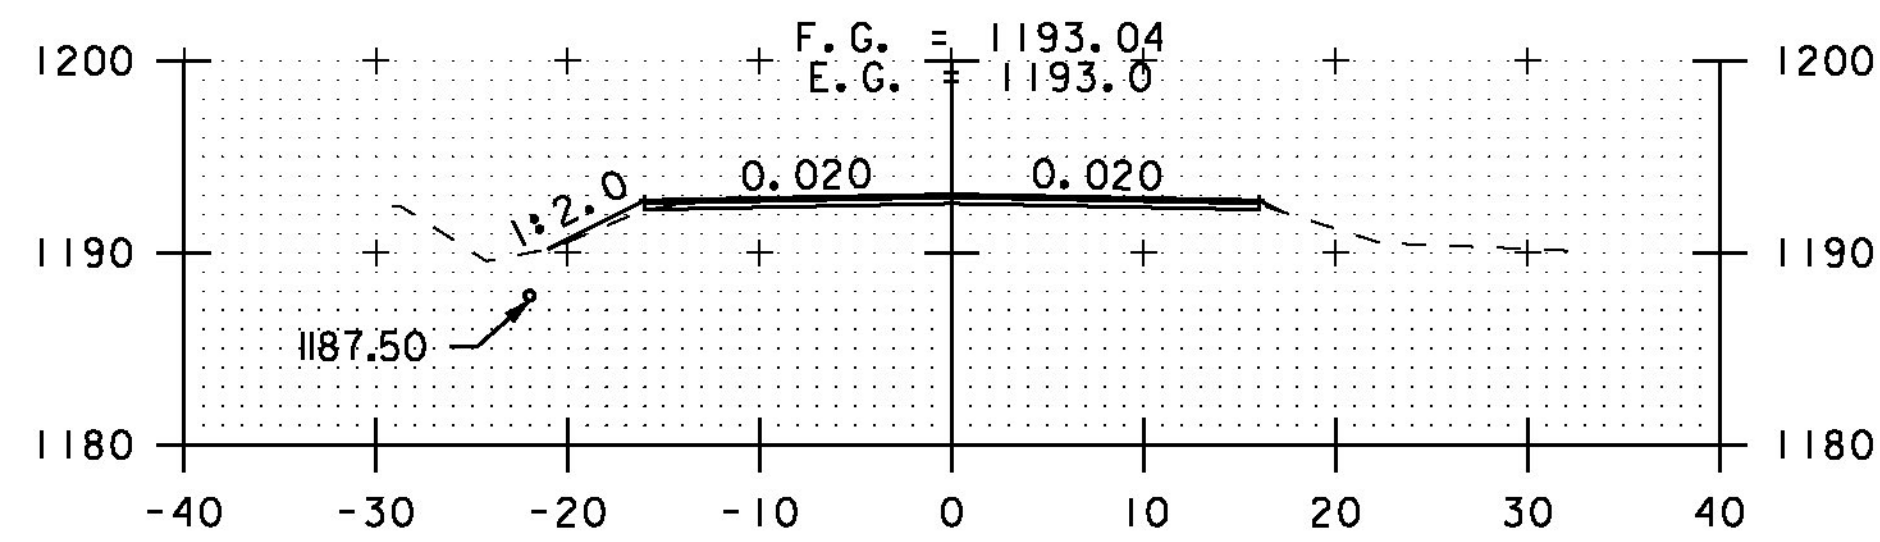


385+50

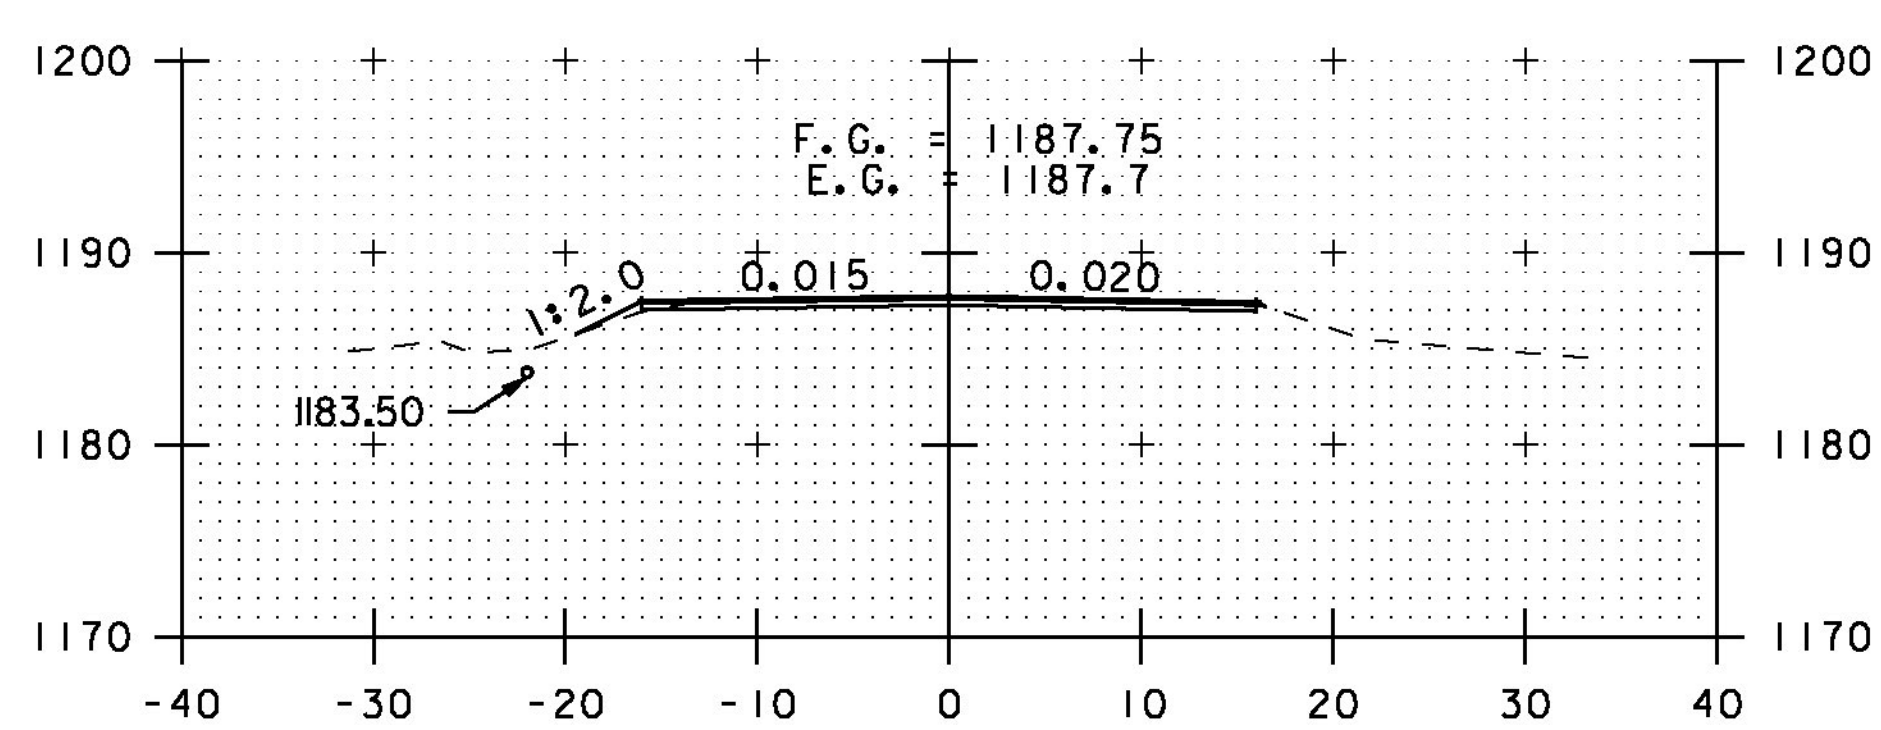


387+50

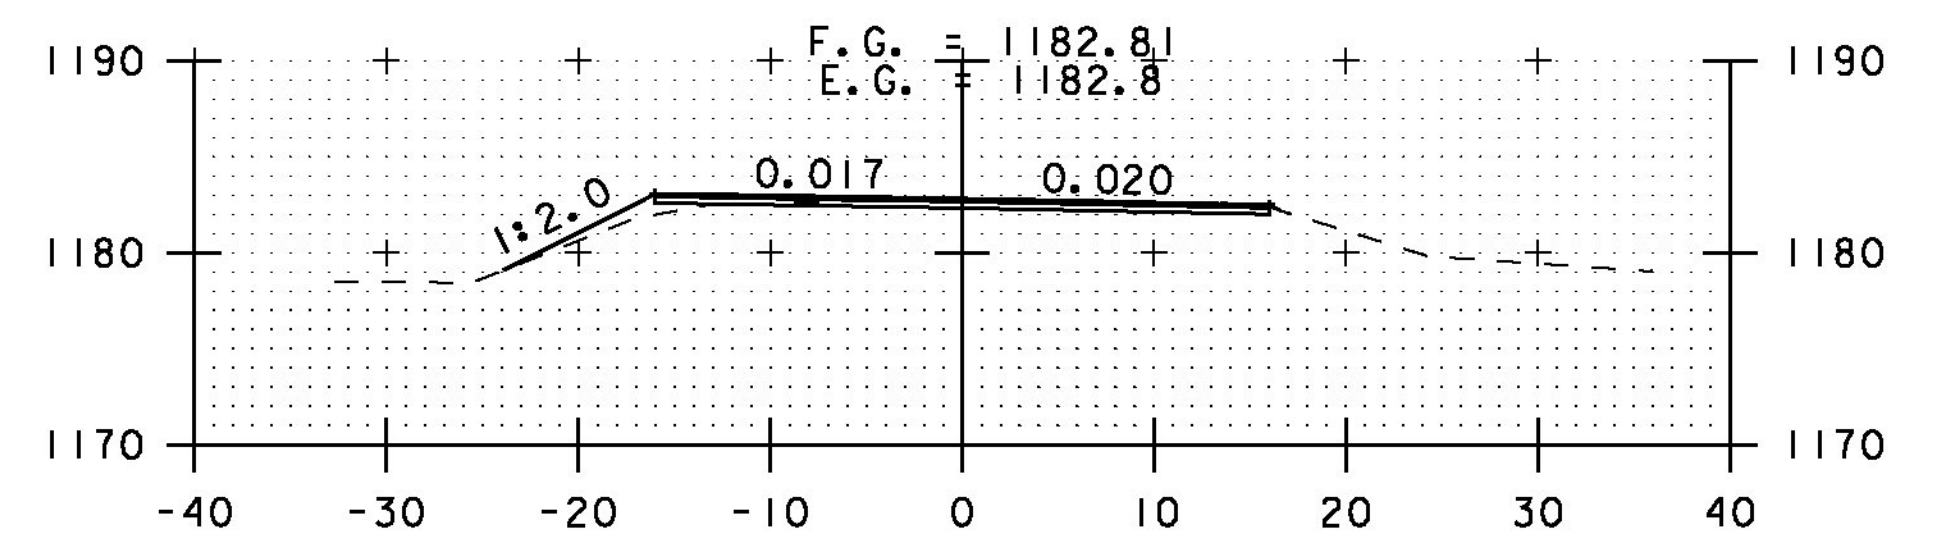


389+50

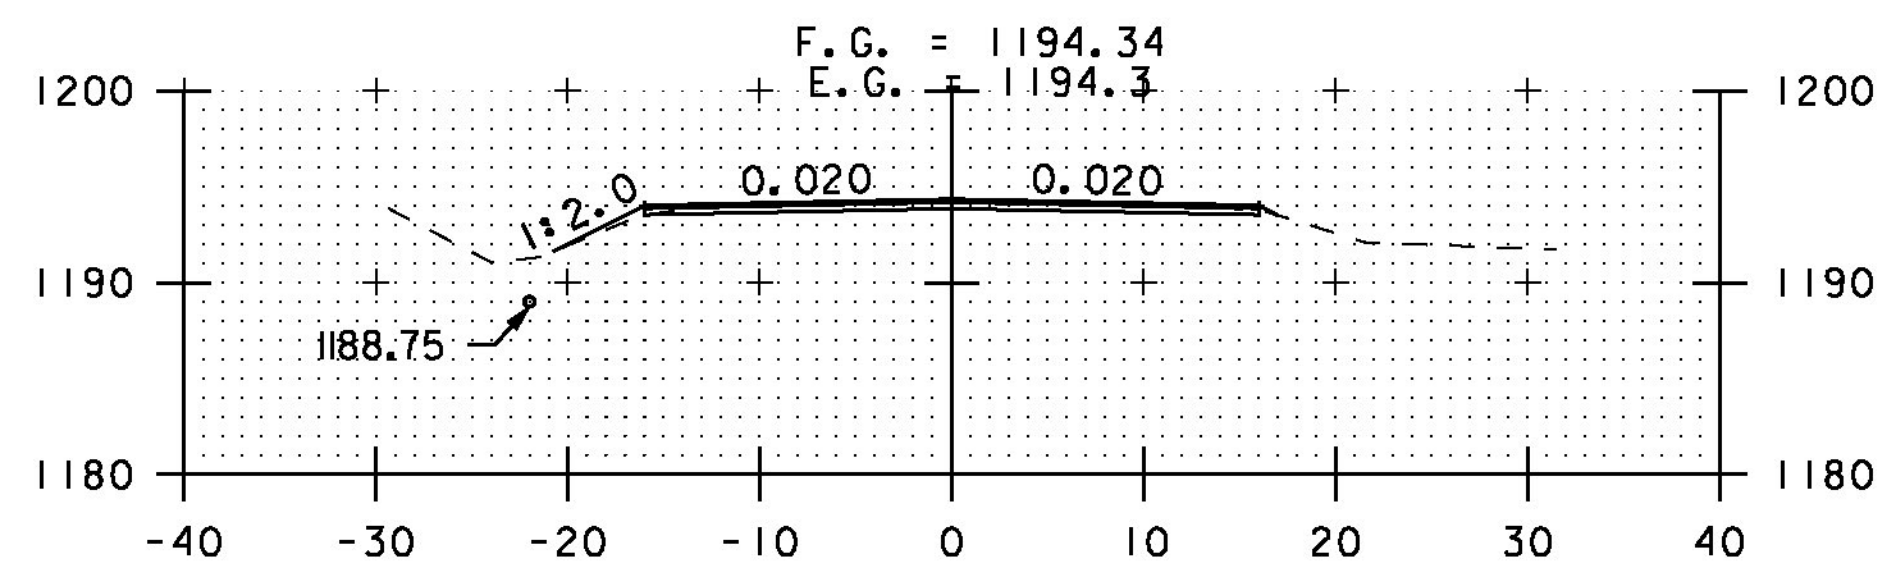


385+00

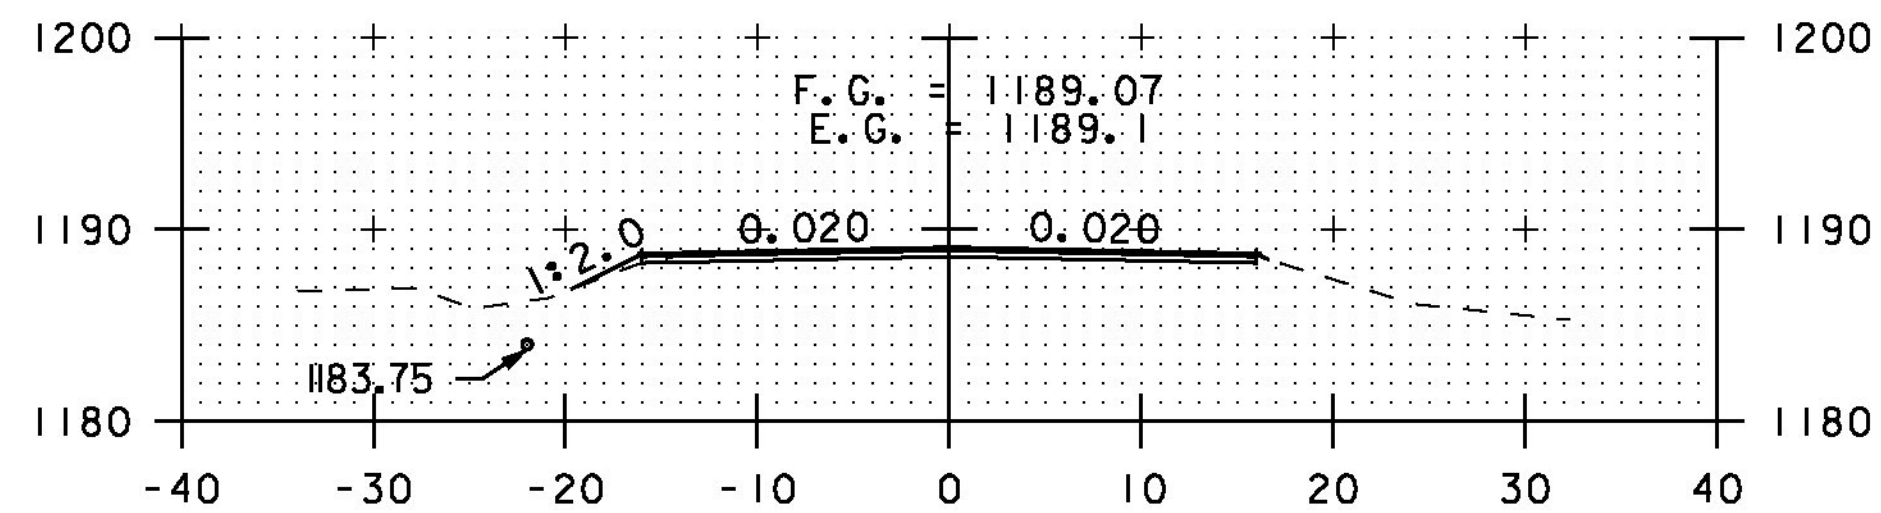


387+00

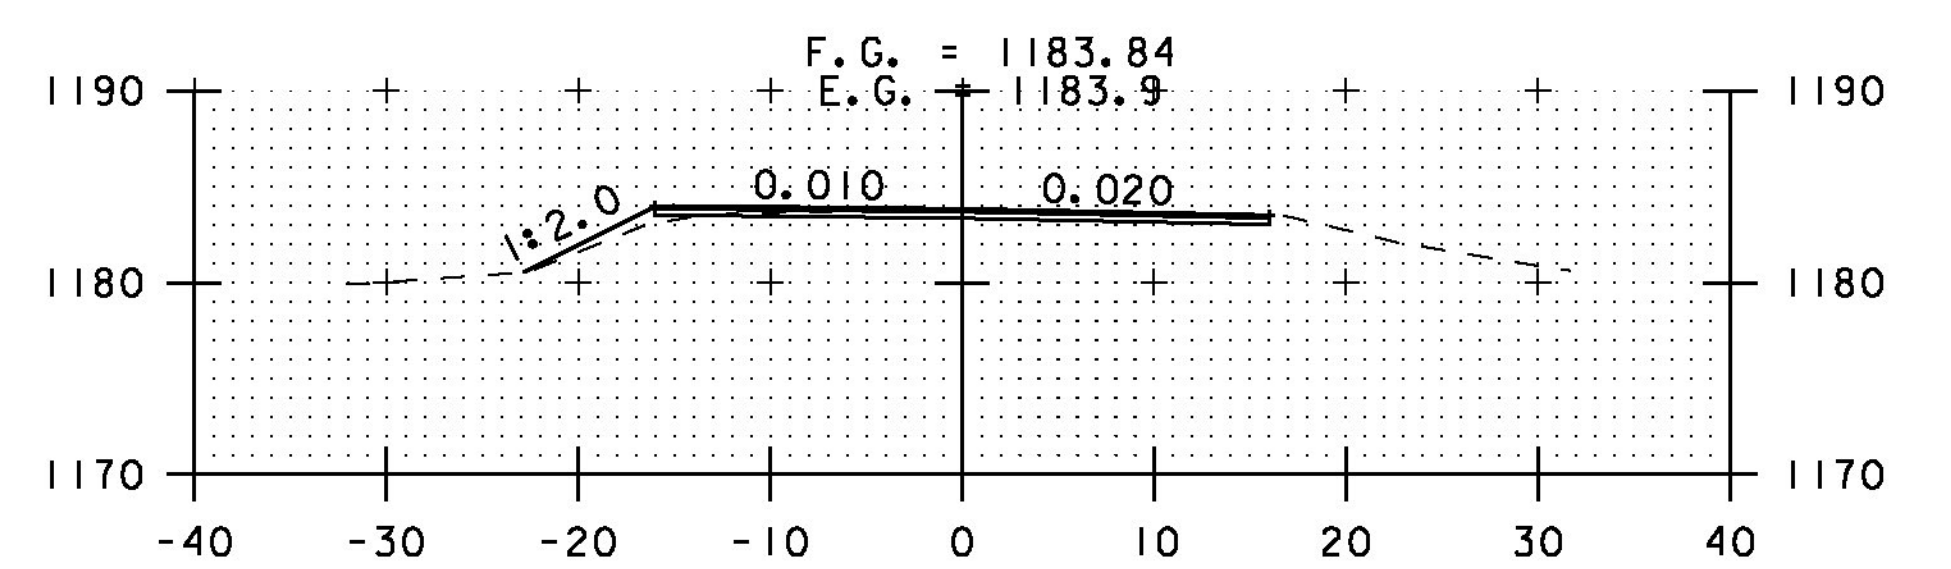


389+00

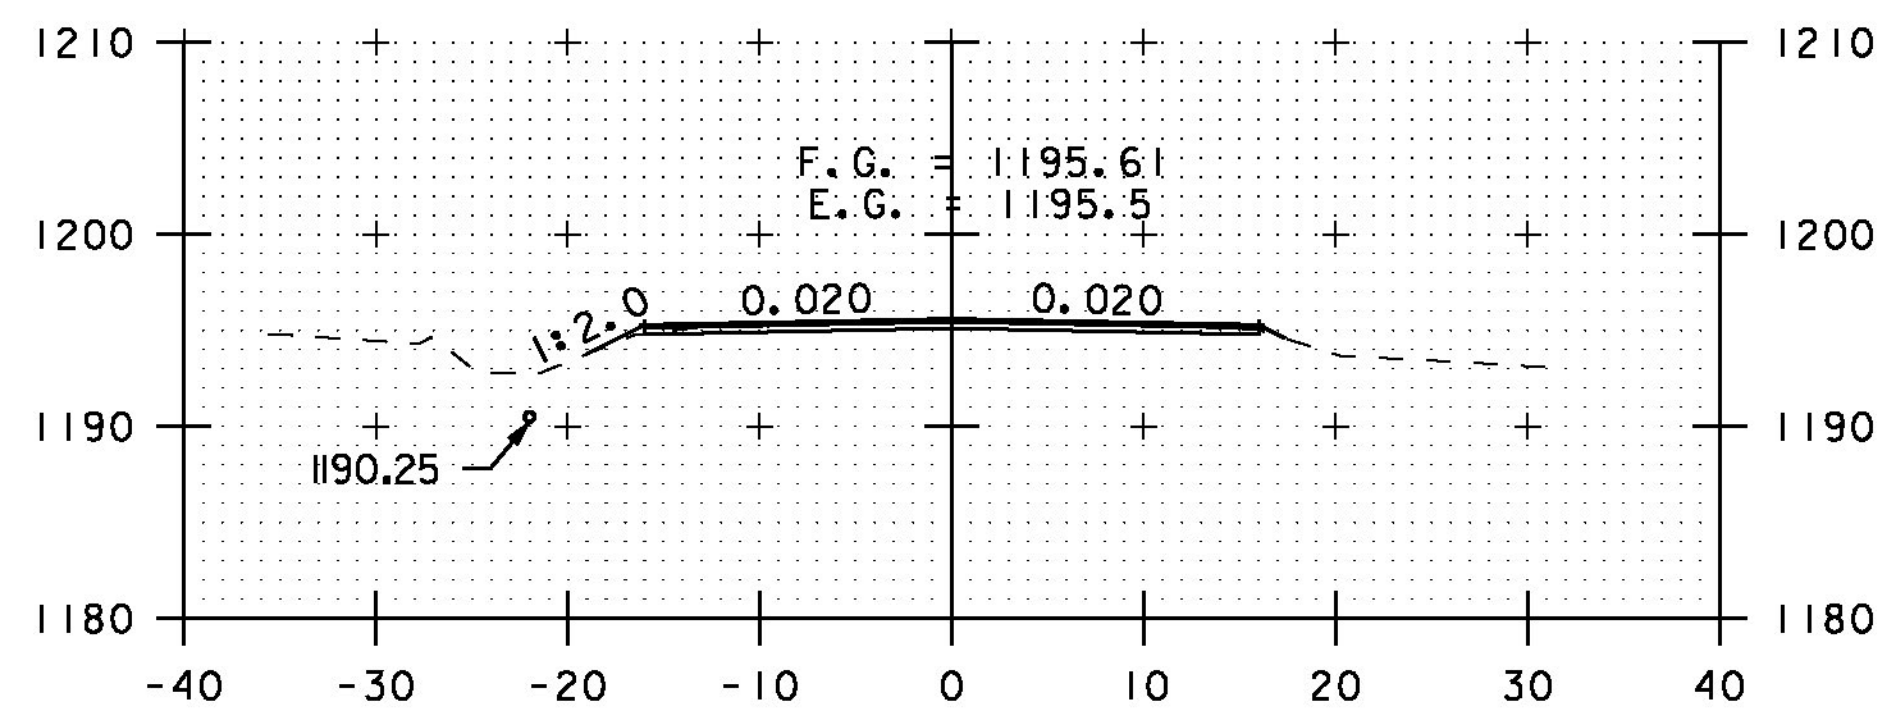

384+50

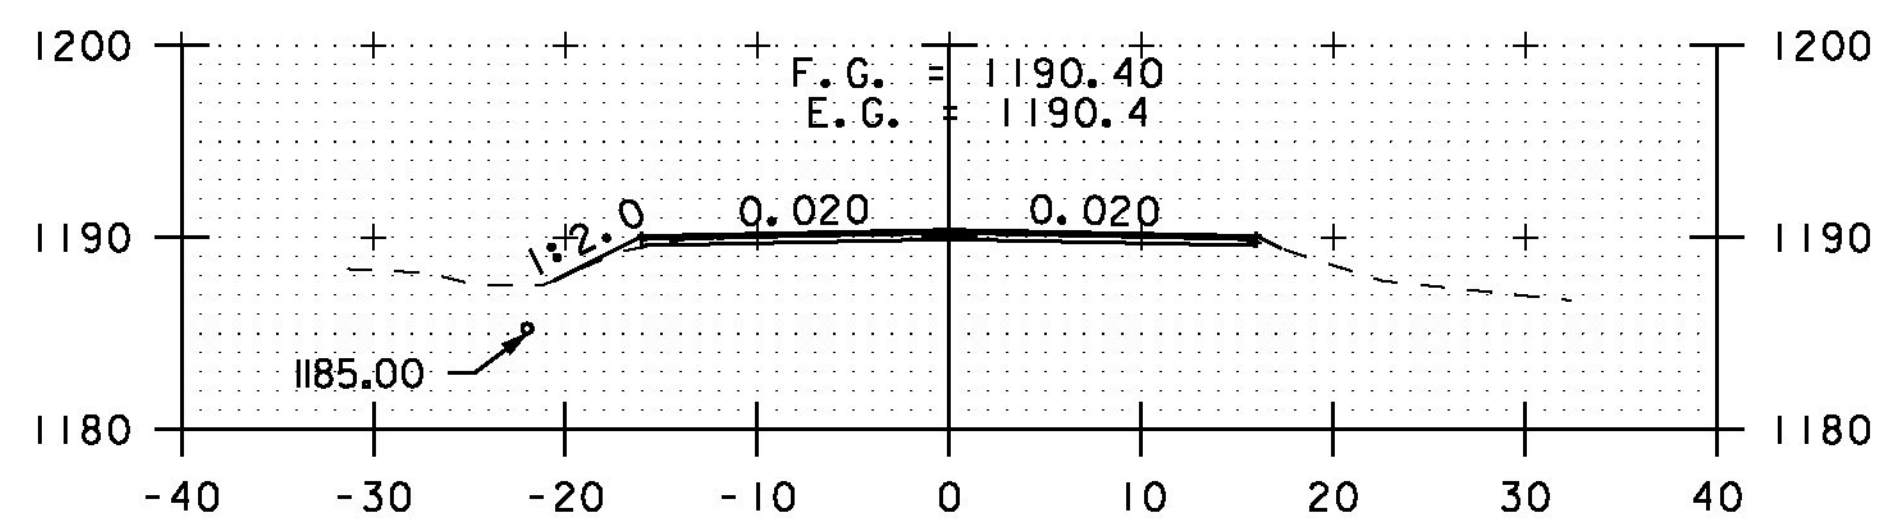

386+50

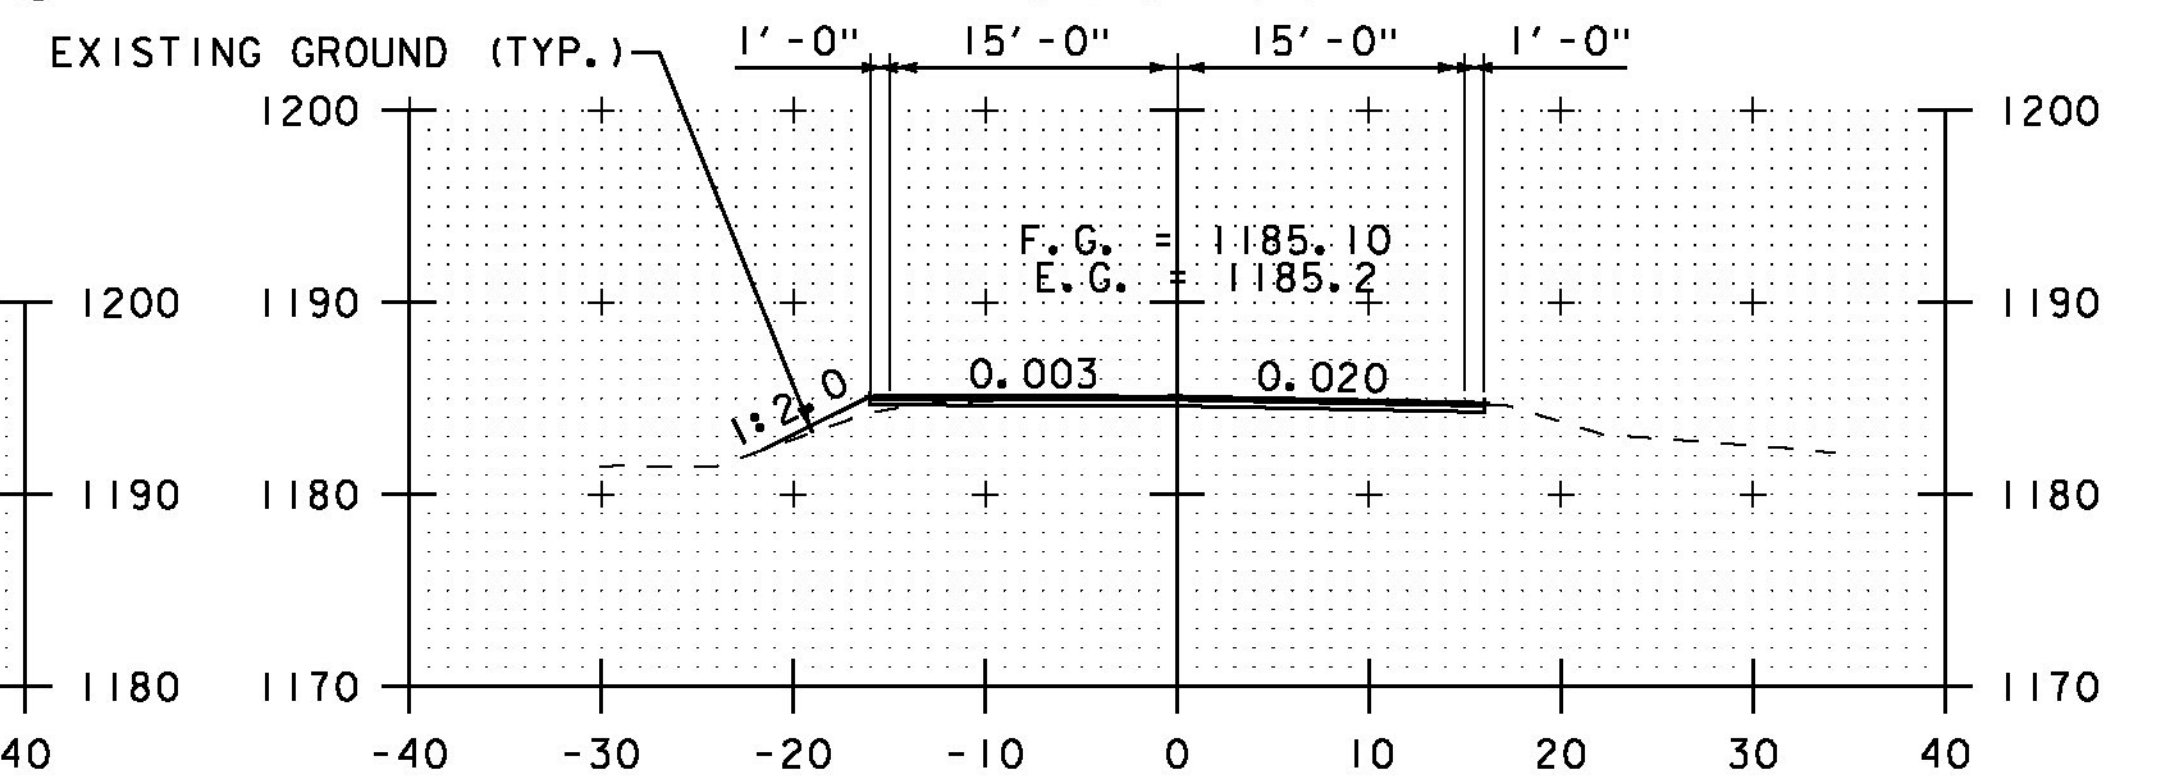

388+50

STA. 384+50 TO STA. 390+00



CROSS SECTION SHEET 36

PROJECT NAME: ELMORE-MORRISTOWN

PROJECT NUMBER: STP 2937 (1)

FILE NAME: z11c310.dgn

PROJECT LEADER: C. LATHROP

DESIGNED BY: S. LAMPHERE

PLOT FILE: z11c310_164.i

PLOT DATE: 3/3/14

DRAWN BY: B. MARTIN

CHECKED BY: C. LATHROP

SHEET 164 OF 194