




397+50

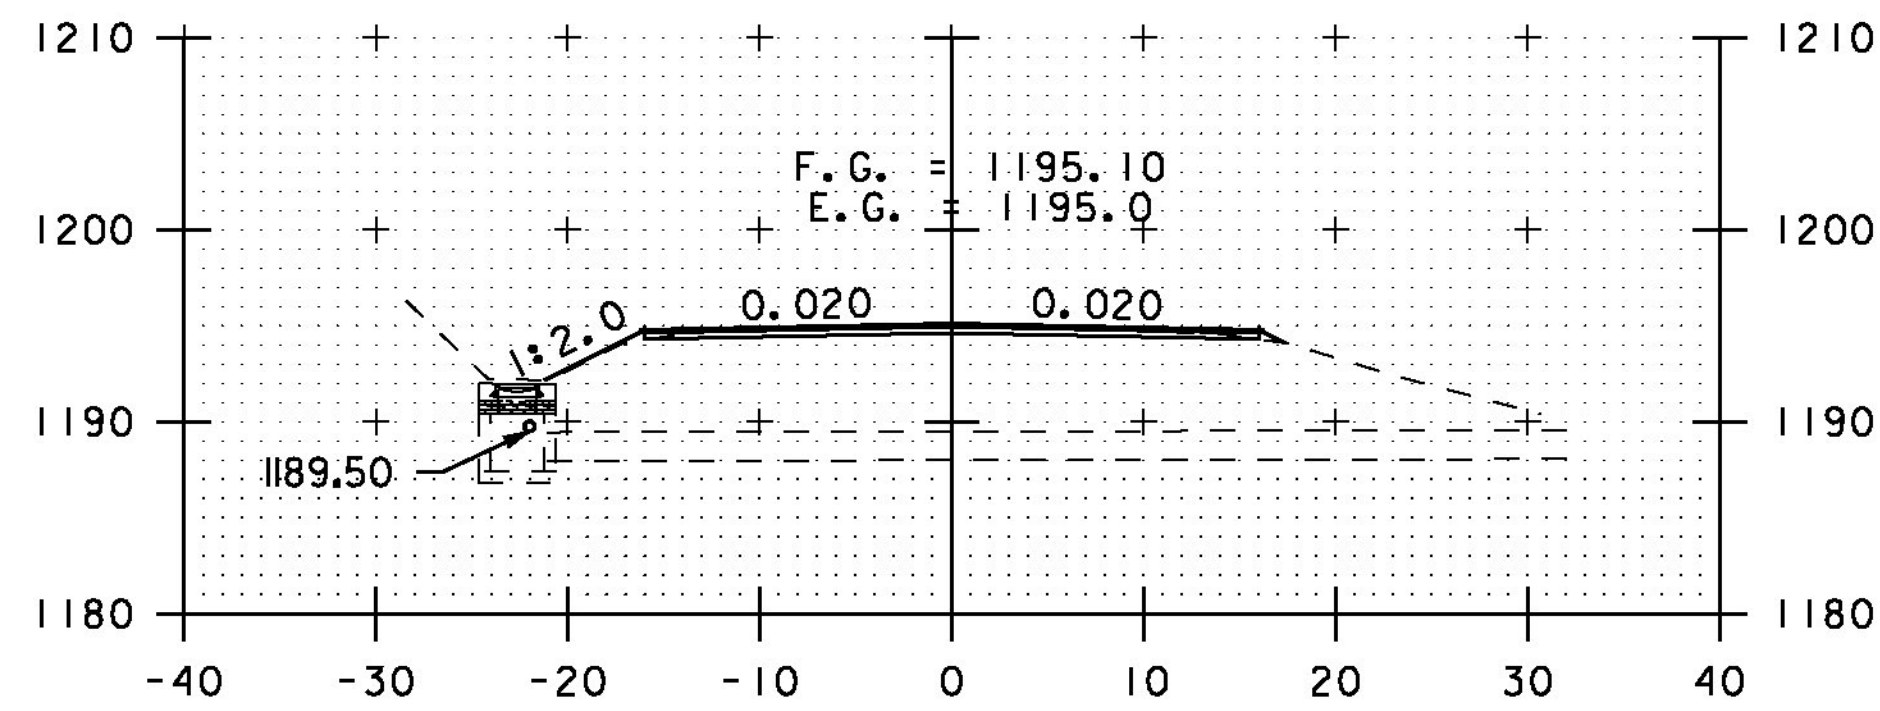


397+00

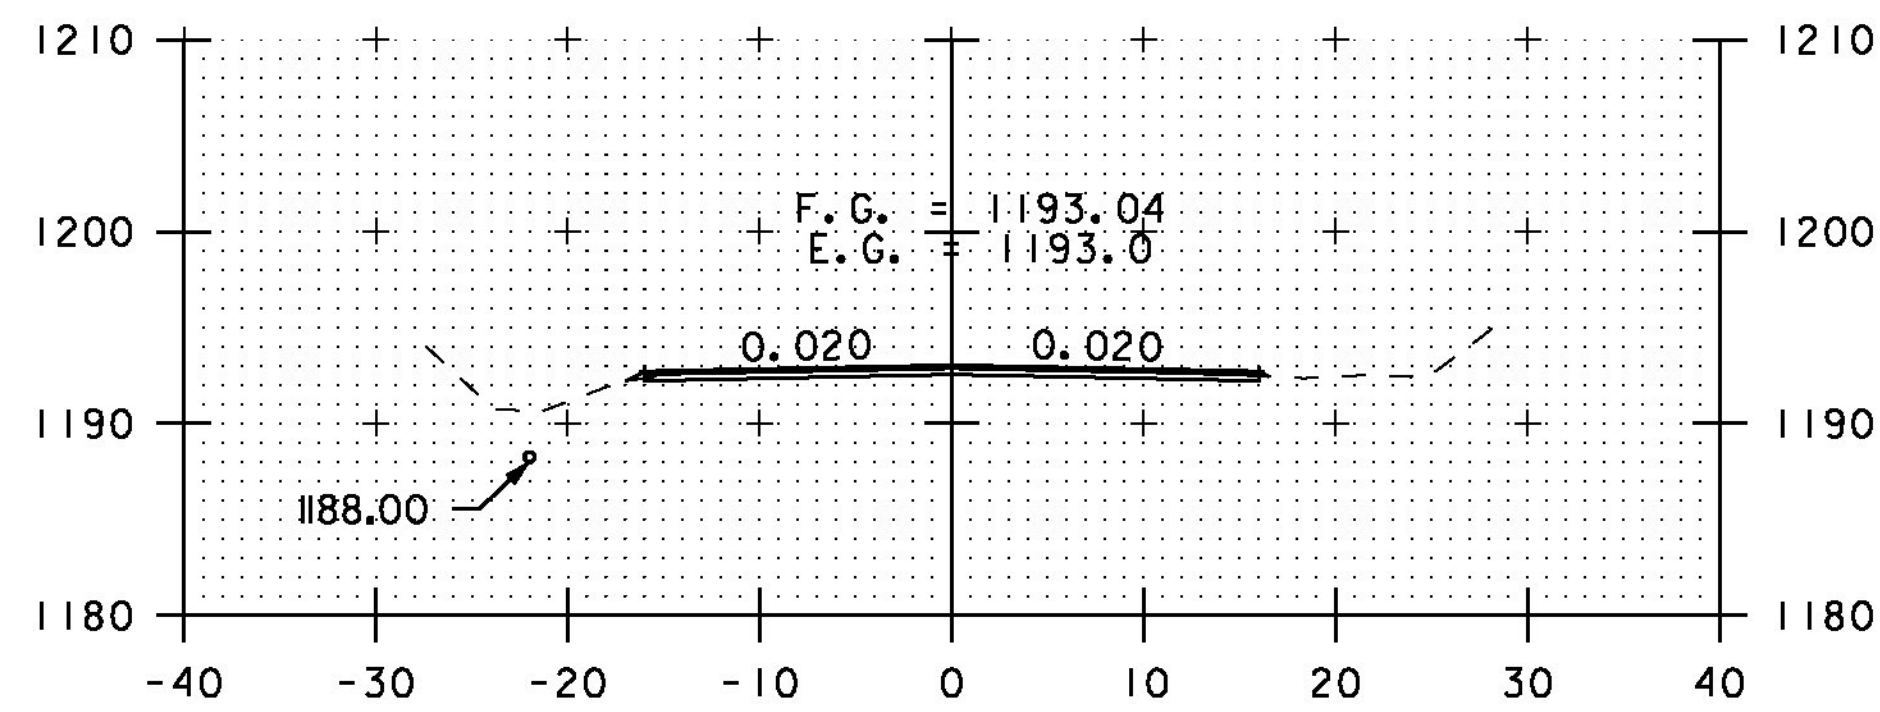


396+50

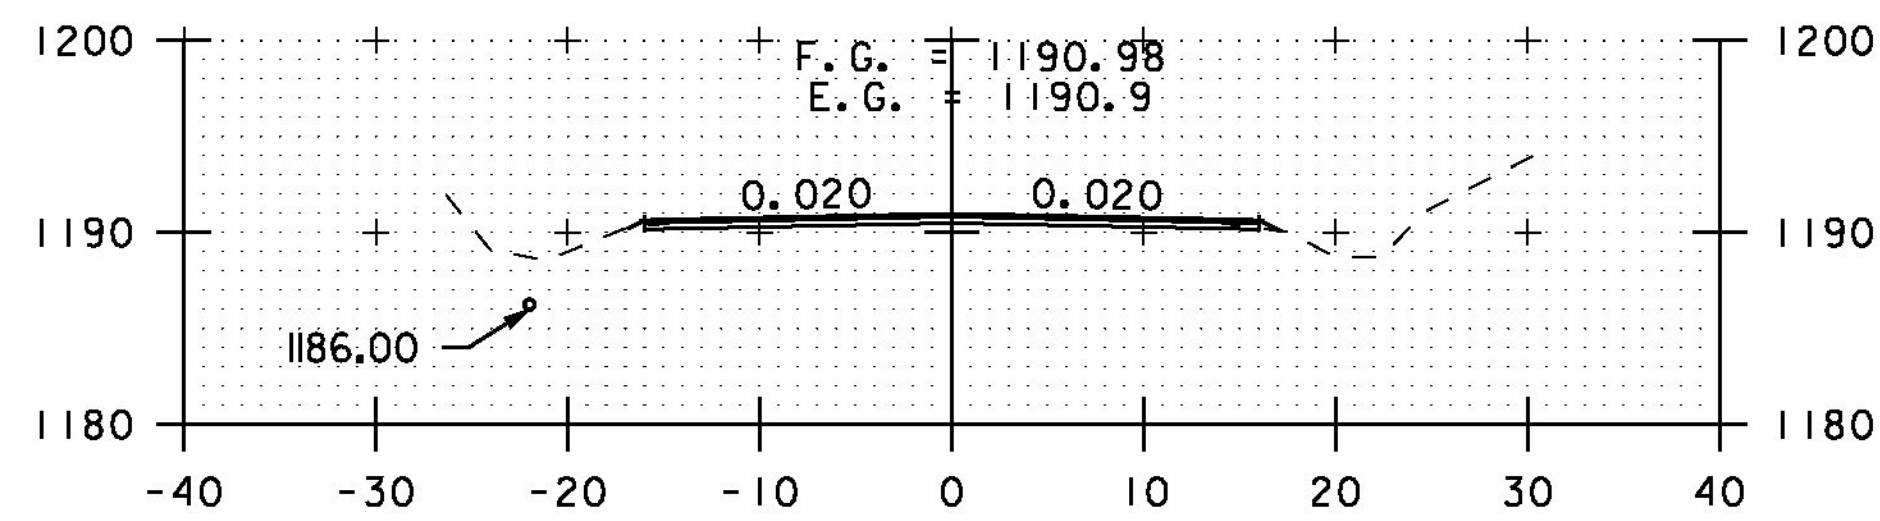


396+00

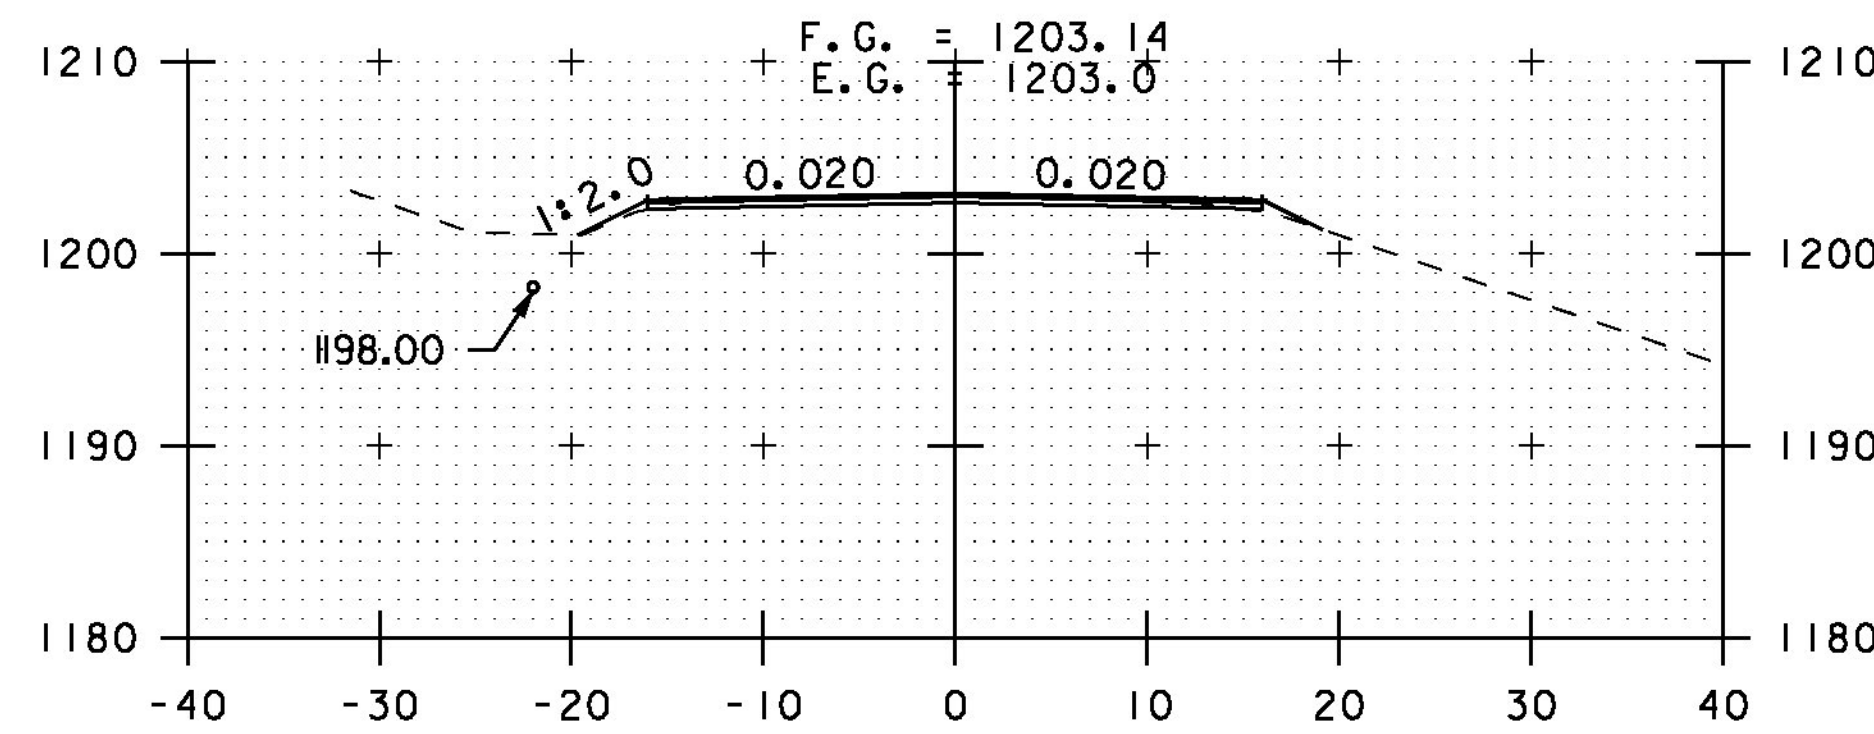


399+00

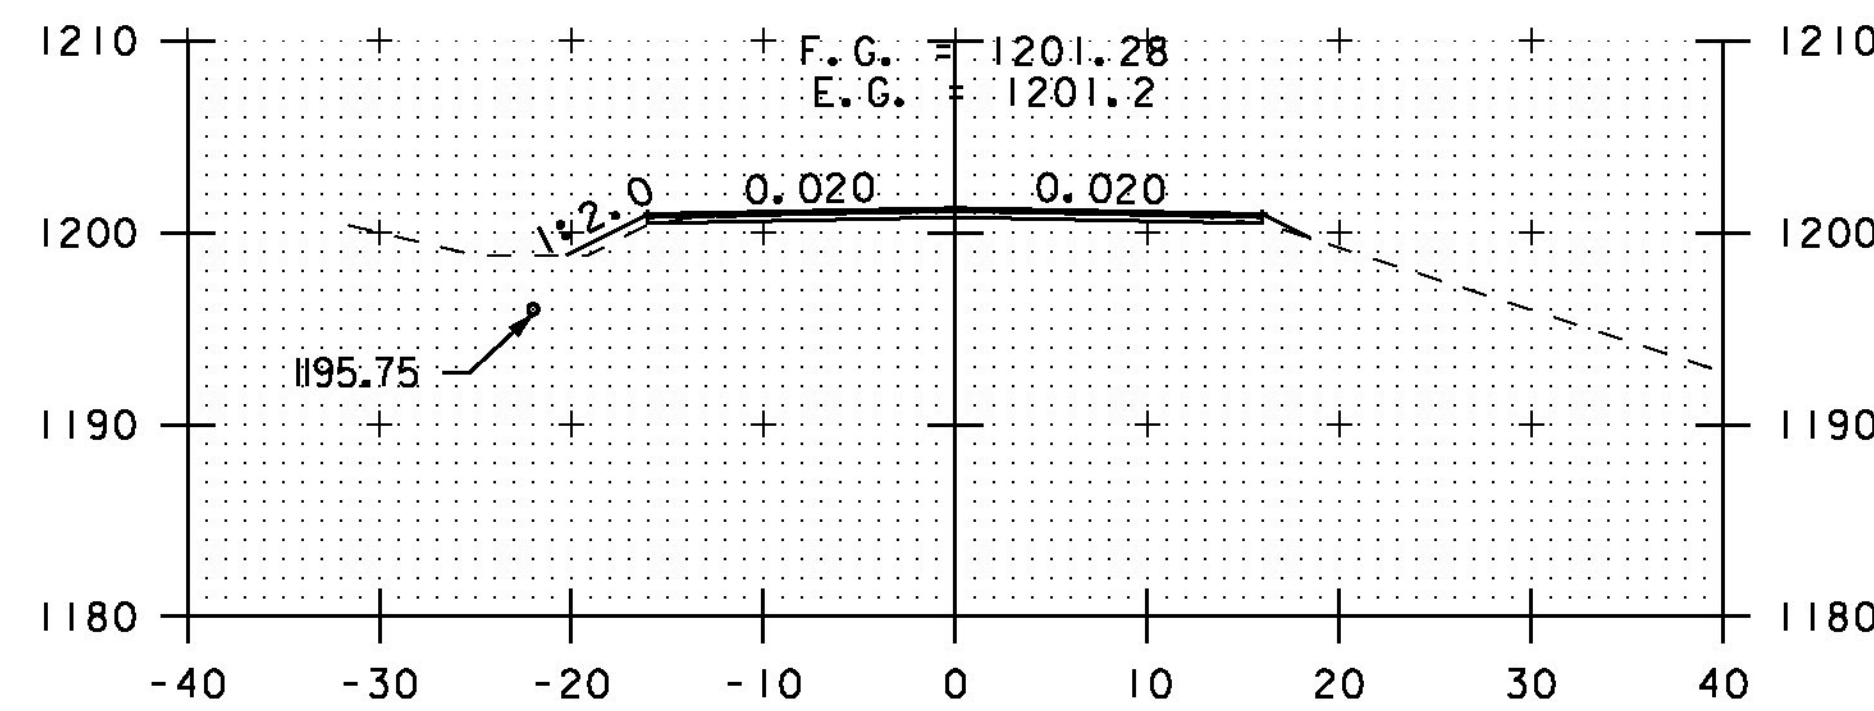


398+50

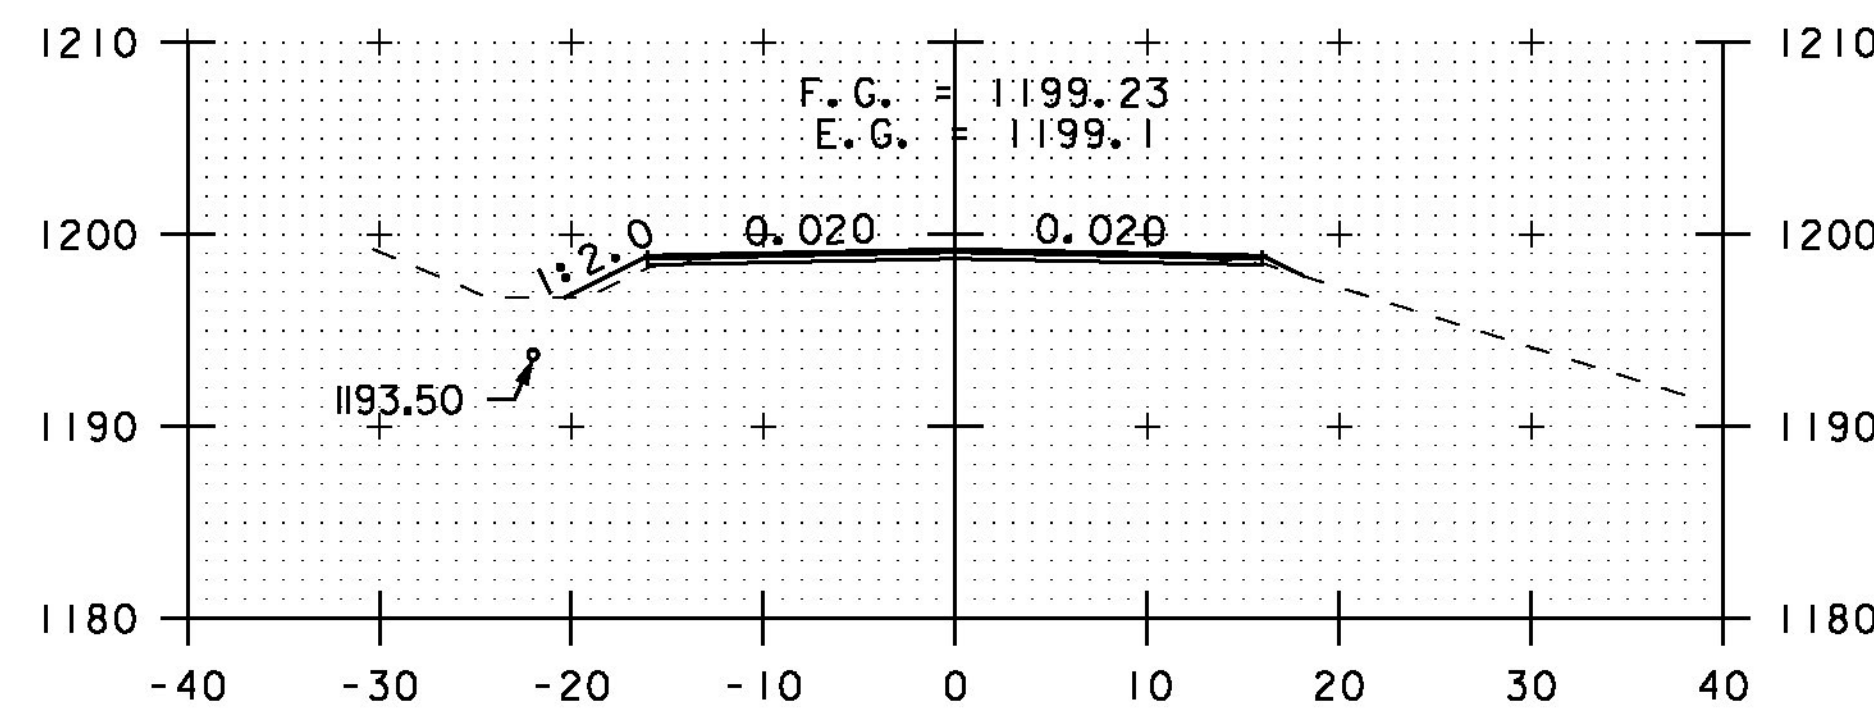


398+00

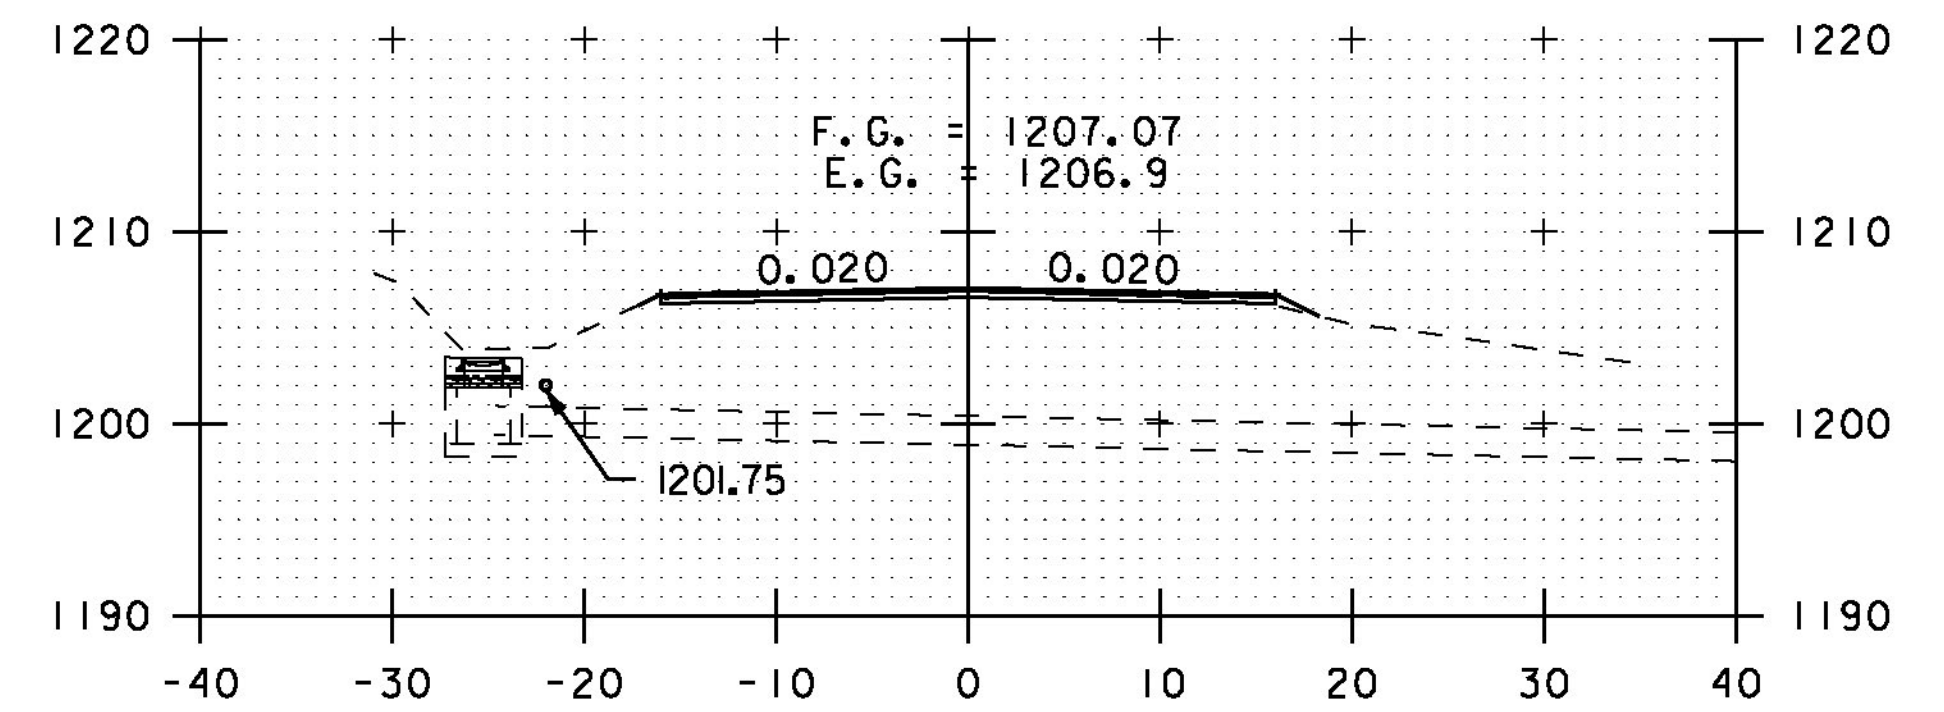

400+50

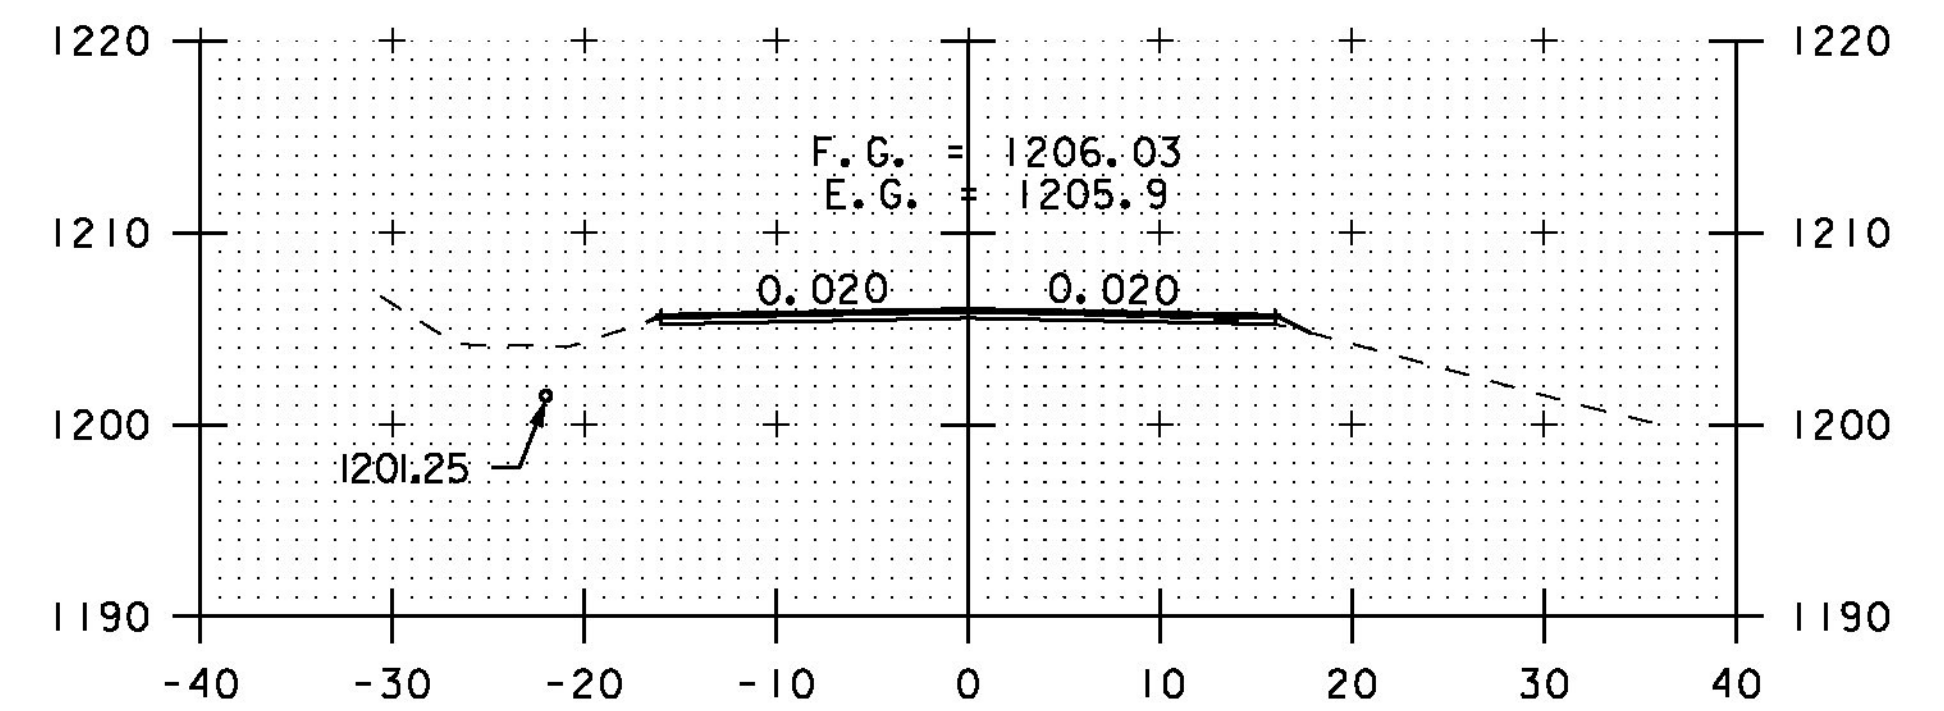

400+00

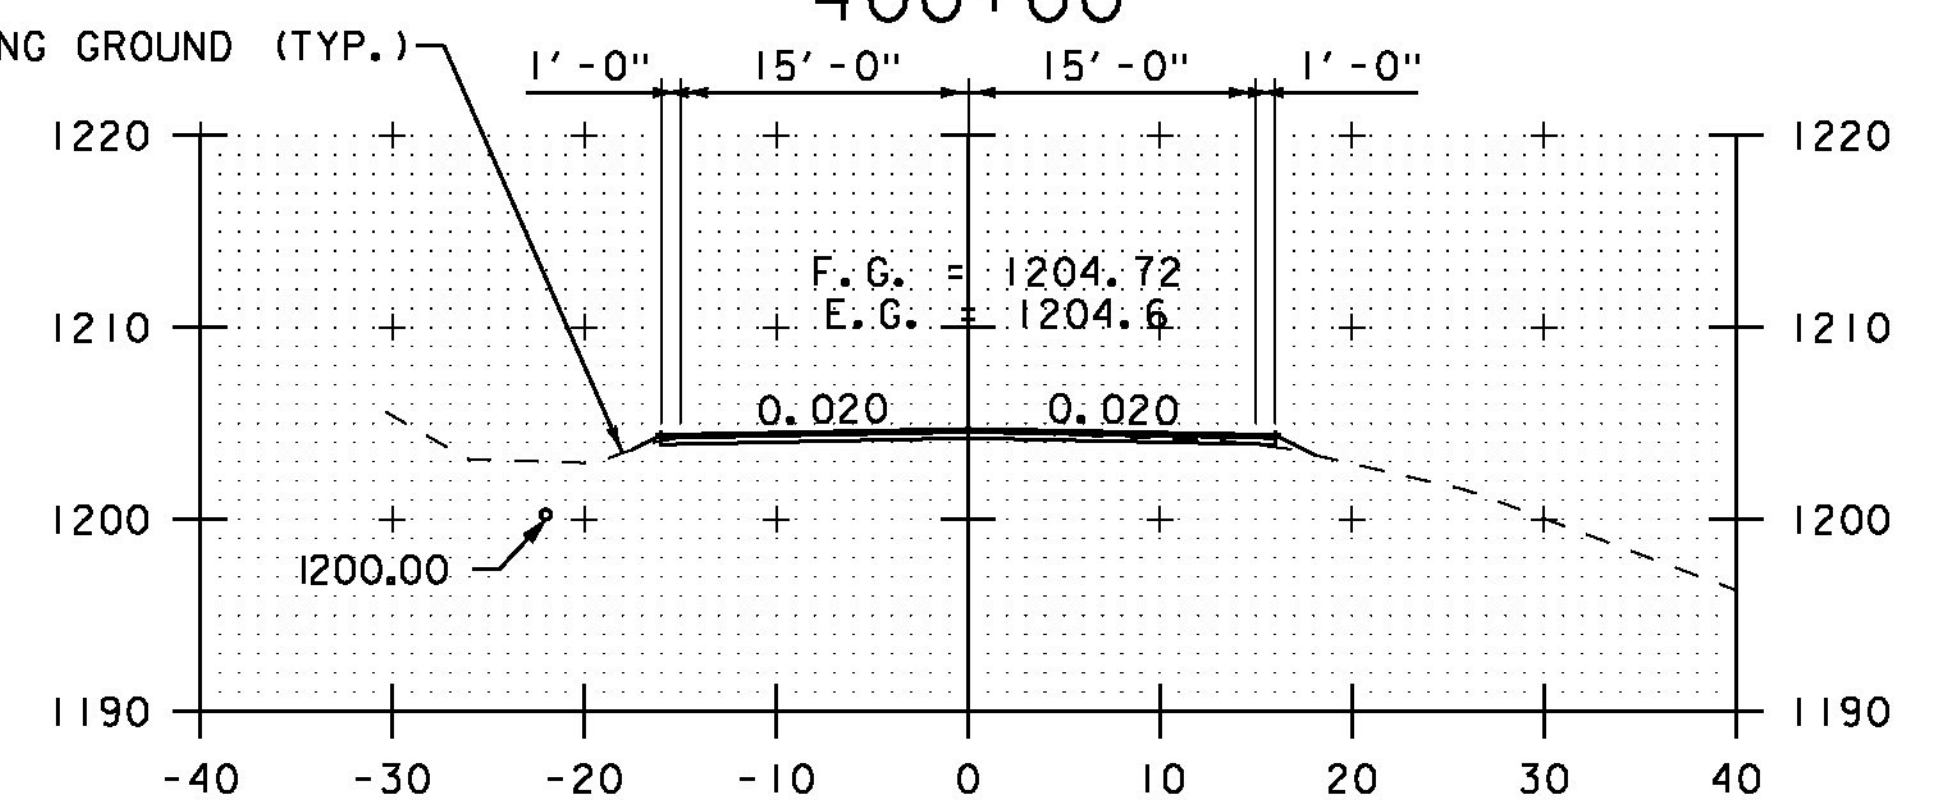

399+50

STA. 396+00 TO STA. 400+50

SCALE 1" = 10'-0"

**CROSS SECTION SHEET 38**

PROJECT NAME: ELMORE-MORRISTOWN

PROJECT NUMBER: STP 2937 (1)

FILE NAME: z11c310.dgn

PROJECT LEADER: C. LATHROP

DESIGNED BY: S. LAMPHERE

PLOT FILE: z11c310\_166.i

PLOT DATE: 3/3/14

DRAWN BY: B. MARTIN

CHECKED BY: C. LATHROP

SHEET 166 OF 194