




402+00

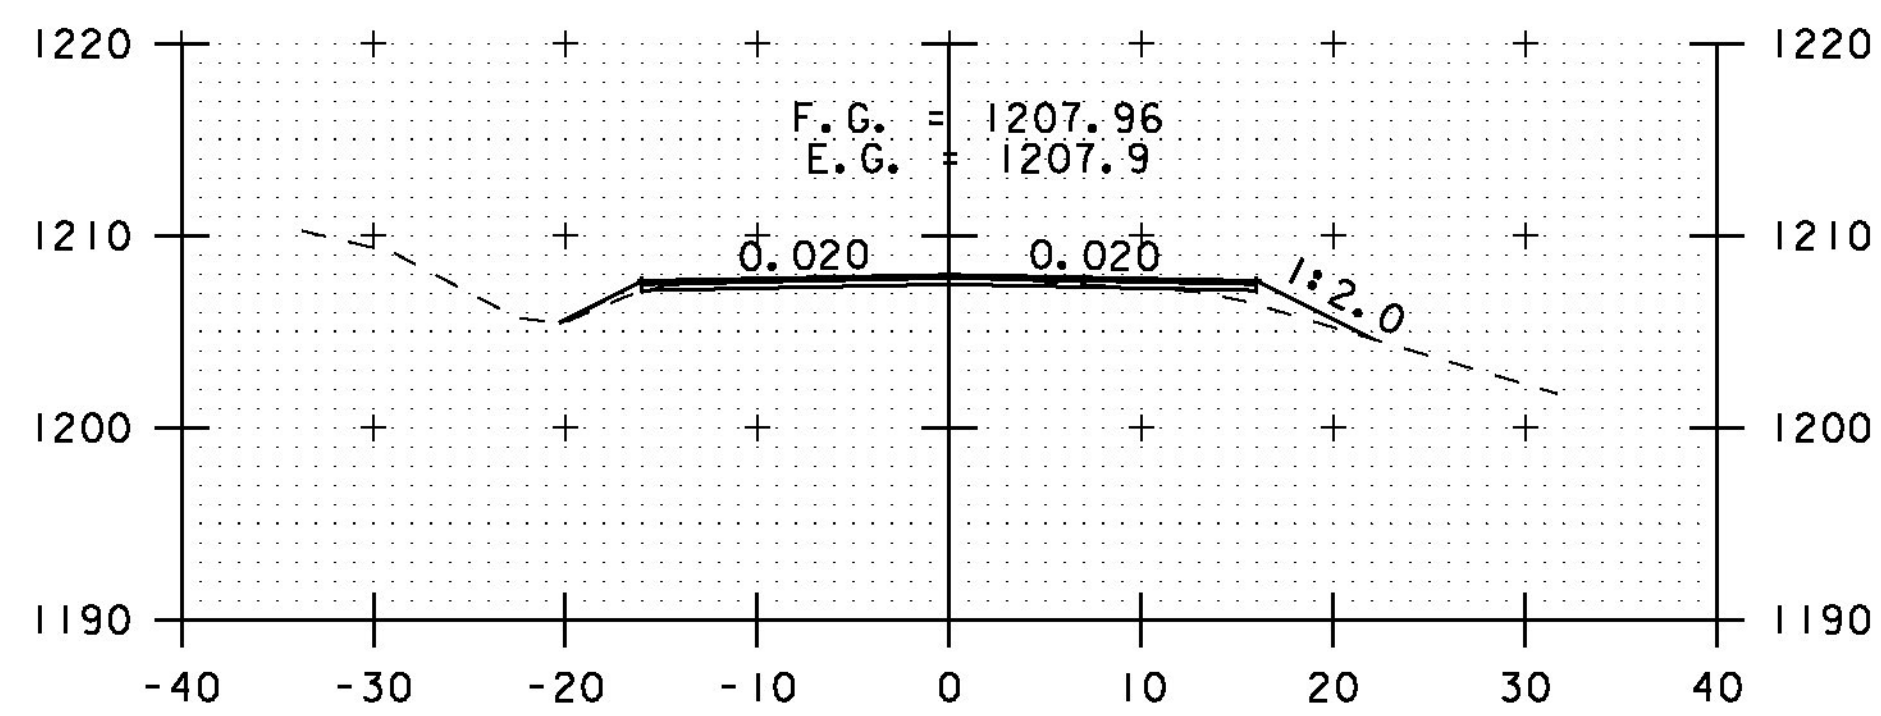


403+50

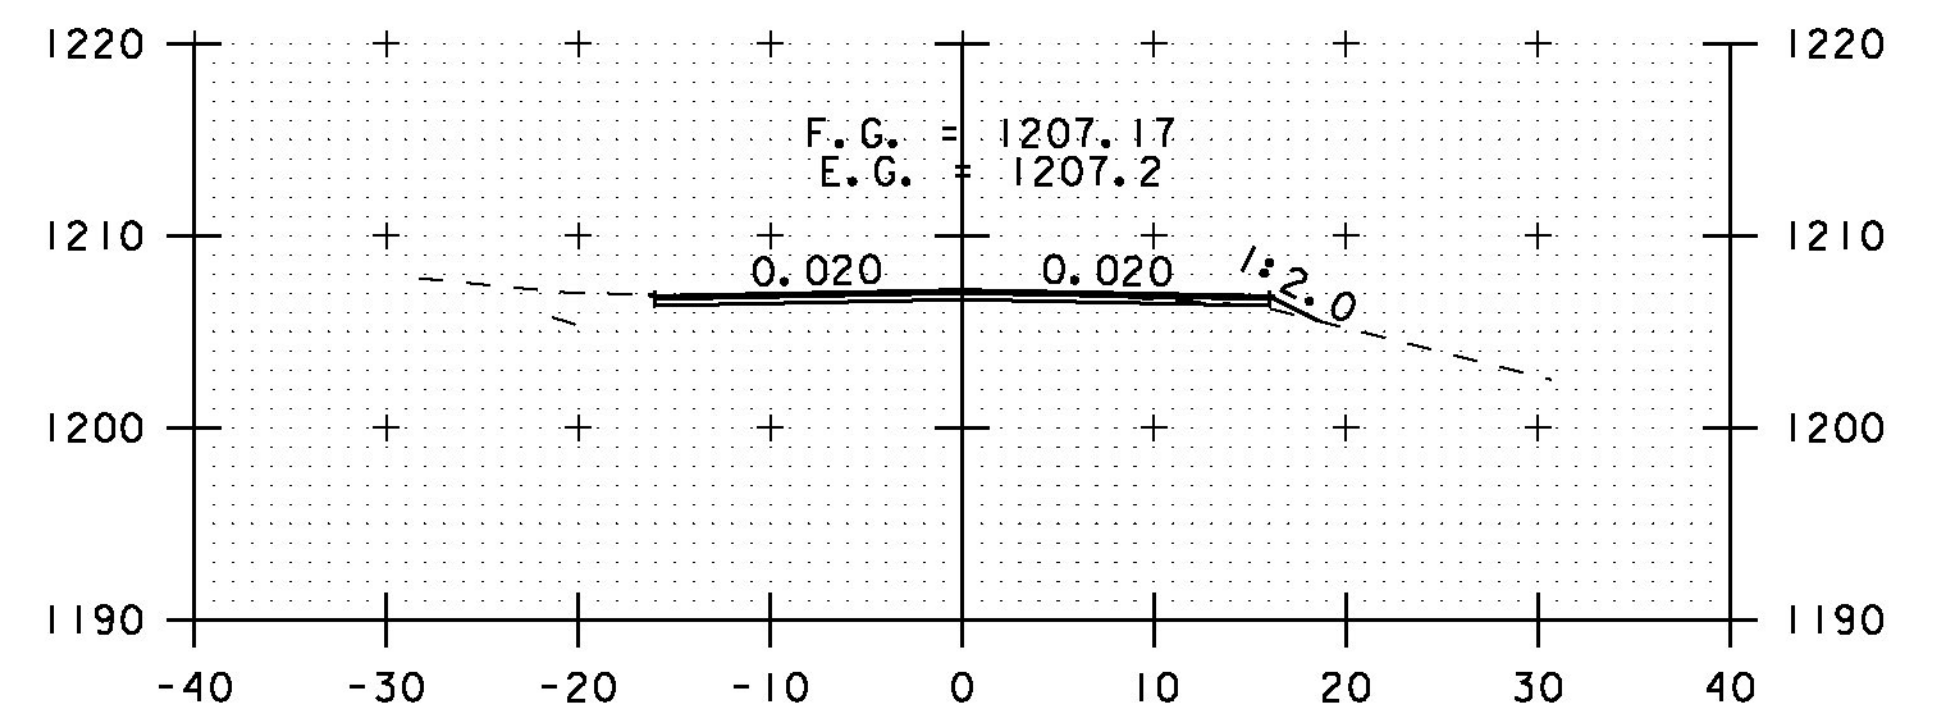


405+00

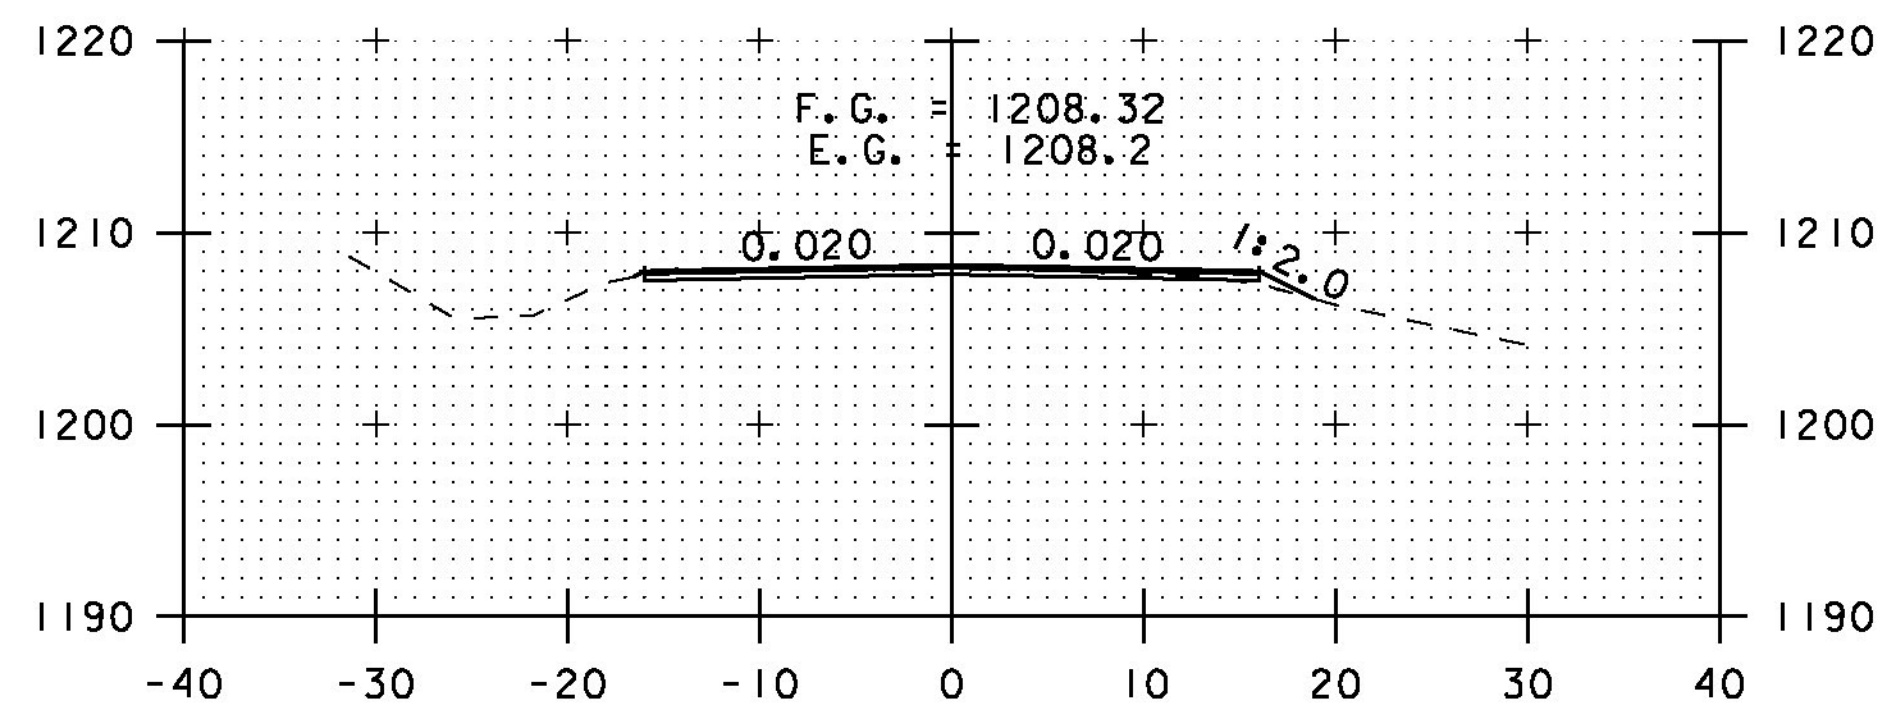


401+50

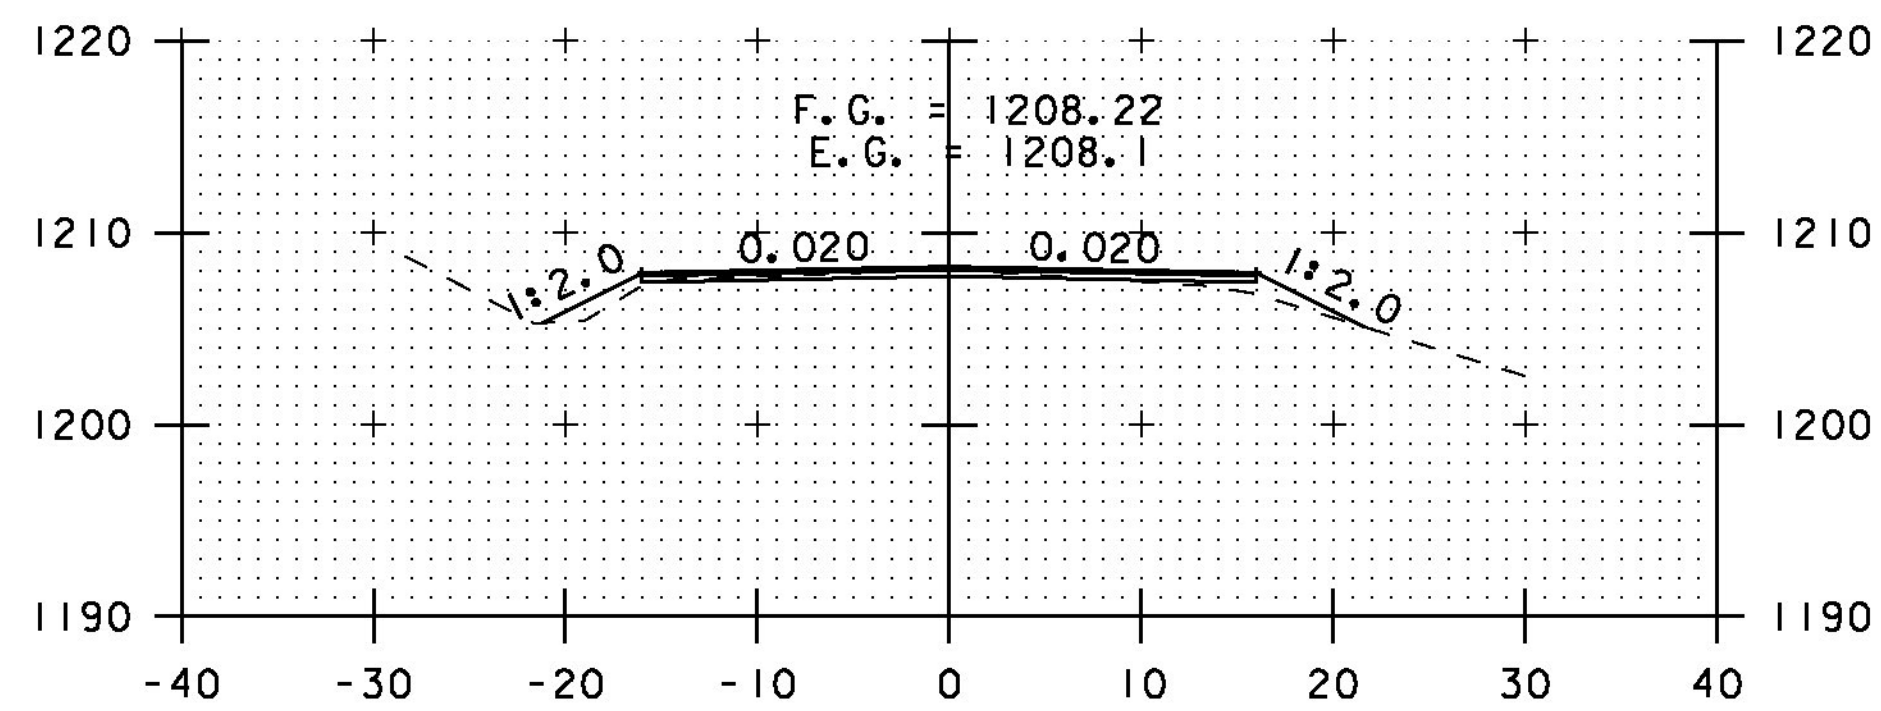


403+00

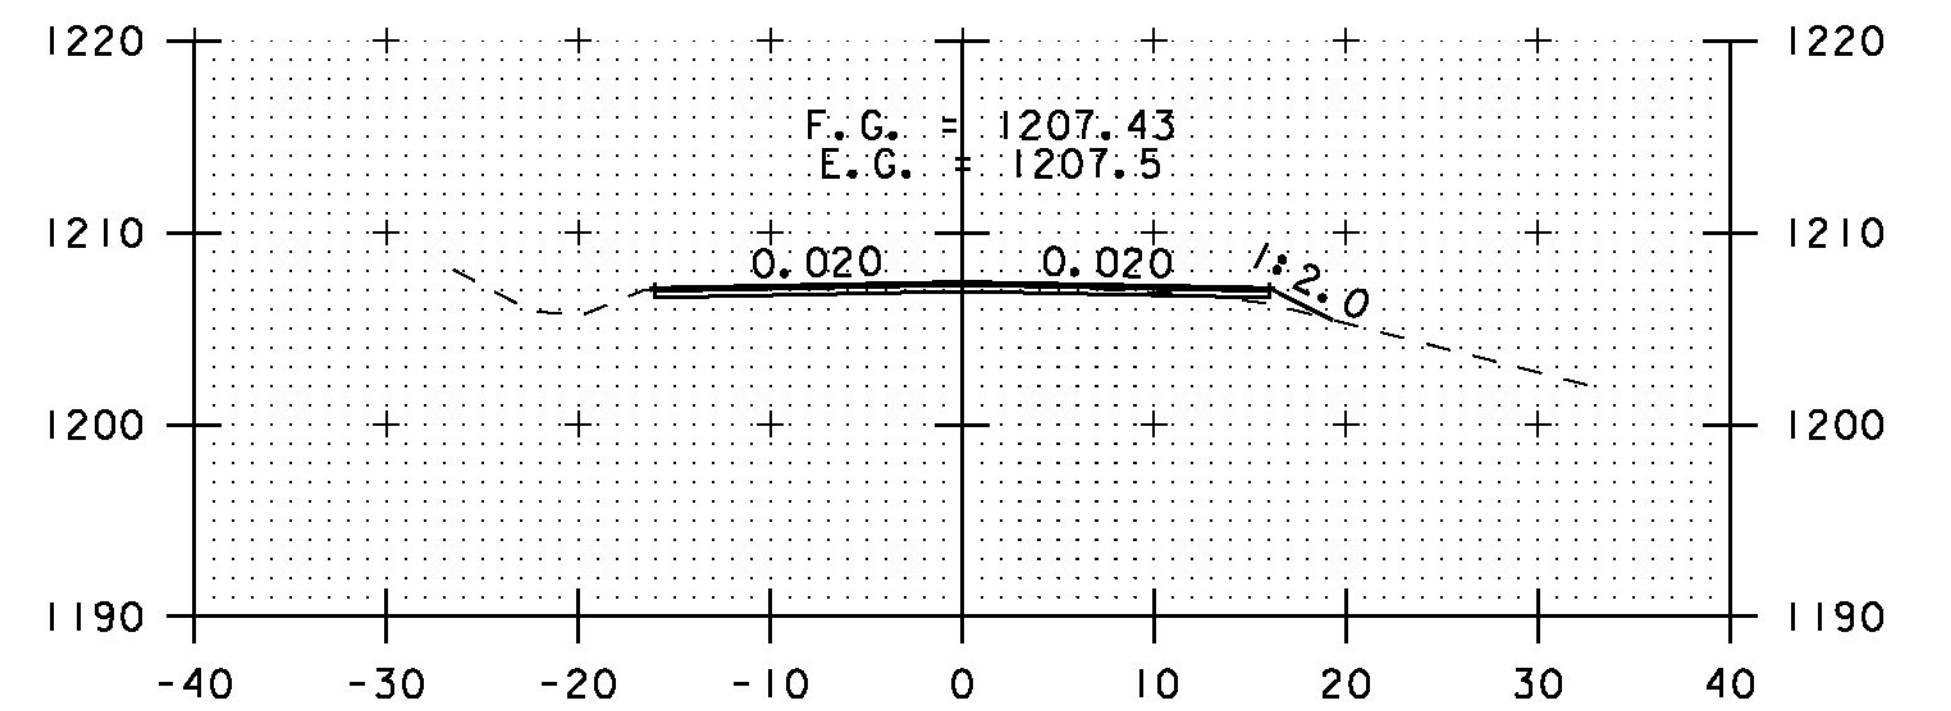


404+50

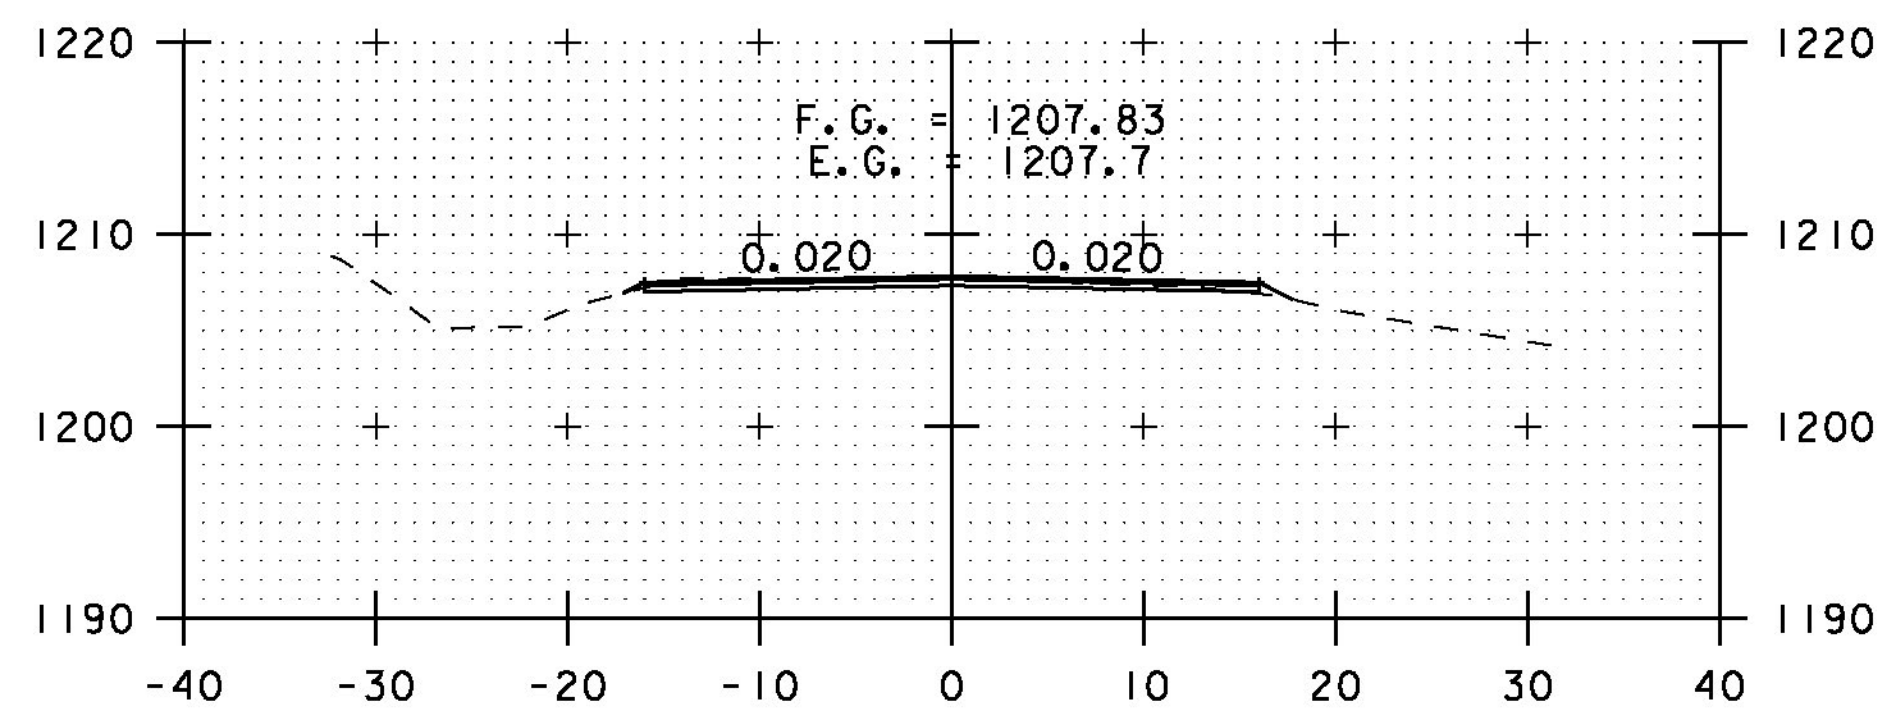

401+00

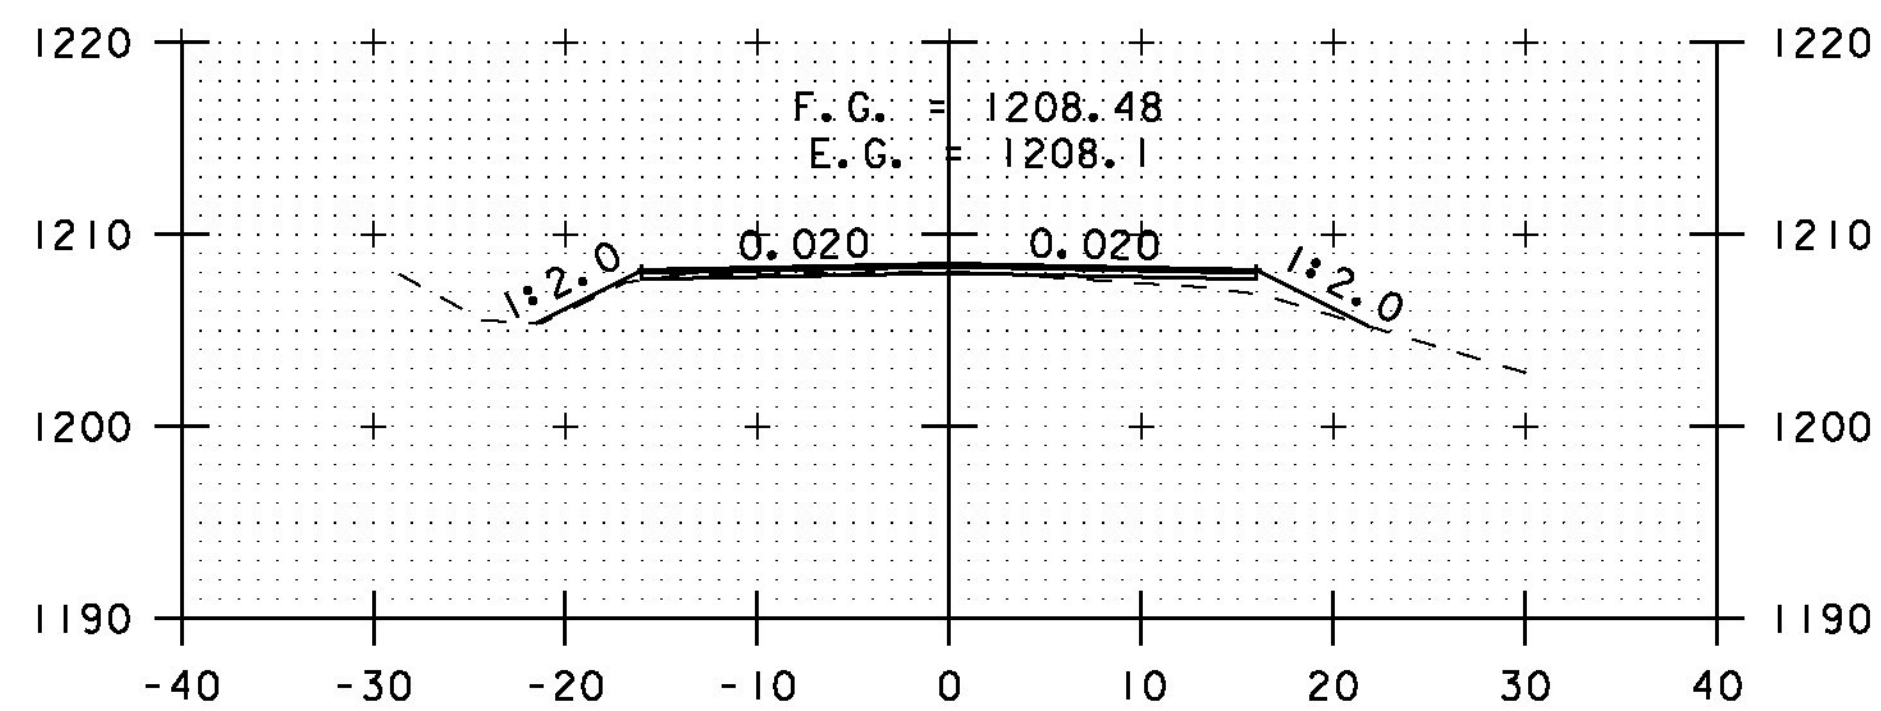

402+50

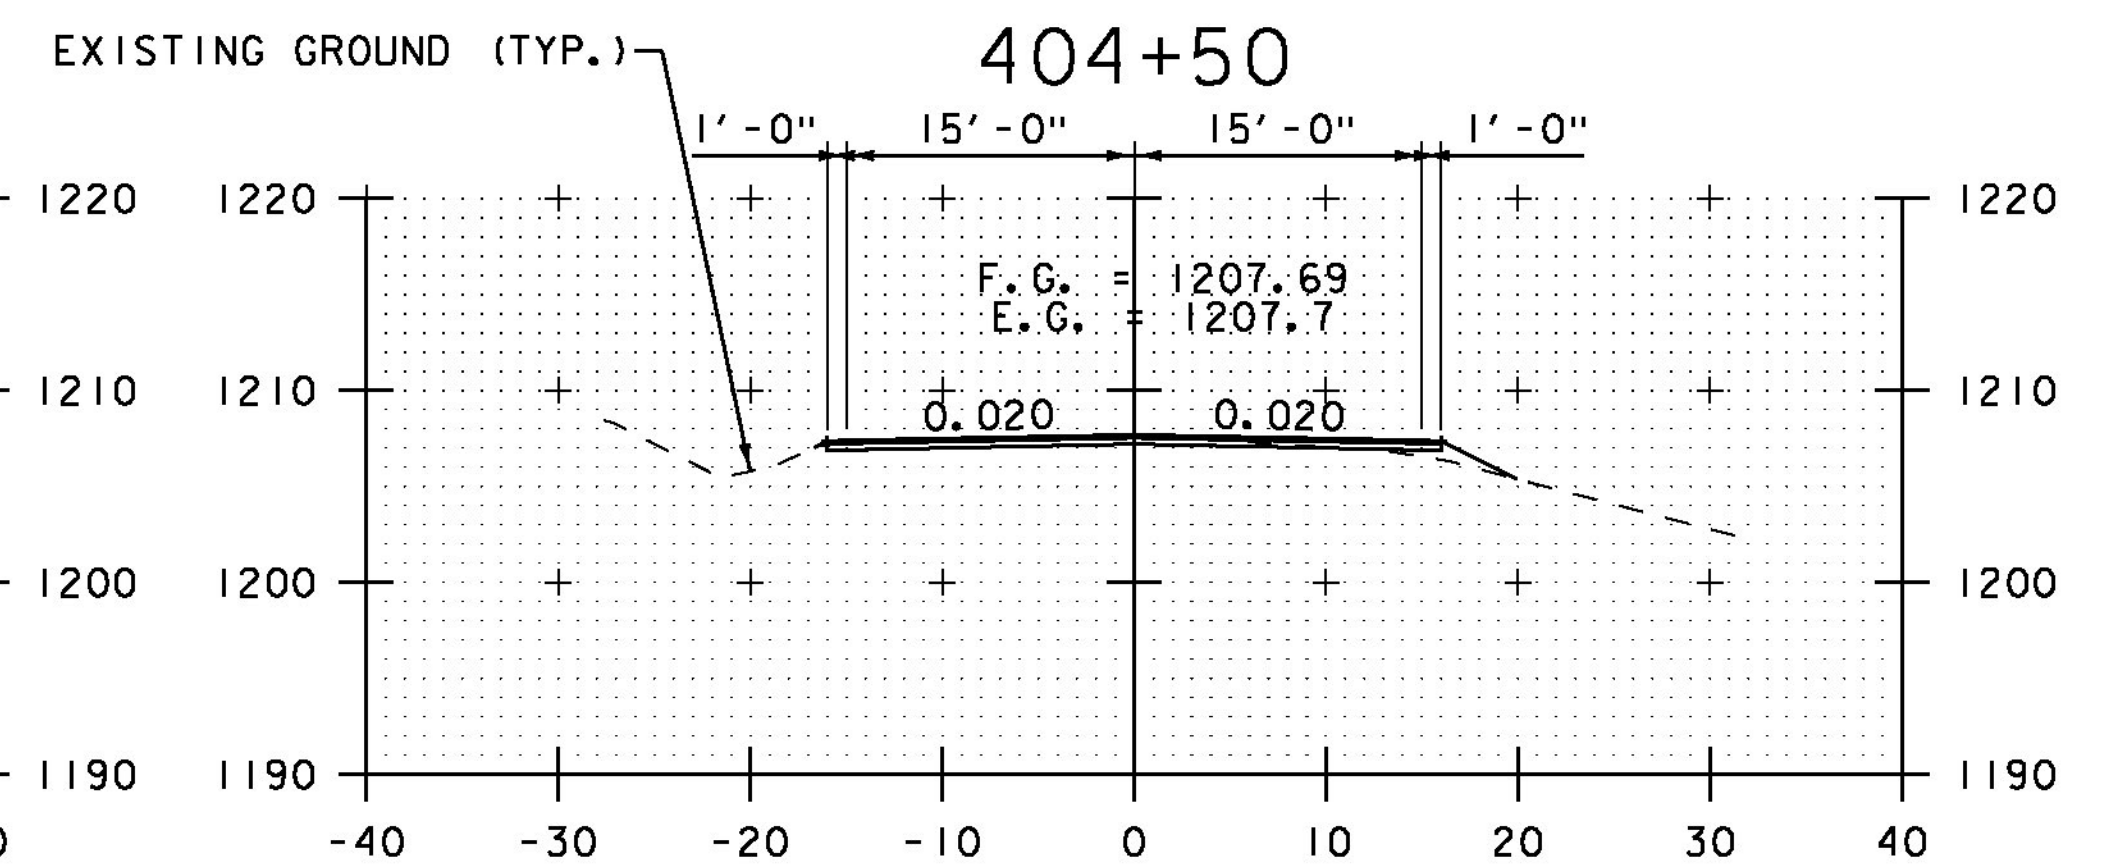

404+00

STA. 401+00 TO STA. 405+00



CROSS SECTION SHEET 39

PROJECT NAME: ELMORE-MORRISTOWN	PROJECT NUMBER: STP 2937 (1)
FILE NAME: z11c310.dgn	PLOT DATE: 3/3/14
PROJECT LEADER: C. LATHROP	DRAWN BY: B. MARTIN
DESIGNED BY: S. LAMPHERE	CHECKED BY: C. LATHROP
PLOT FILE: z11c310_167.i	SHEET 167 OF 194