




A 5+00

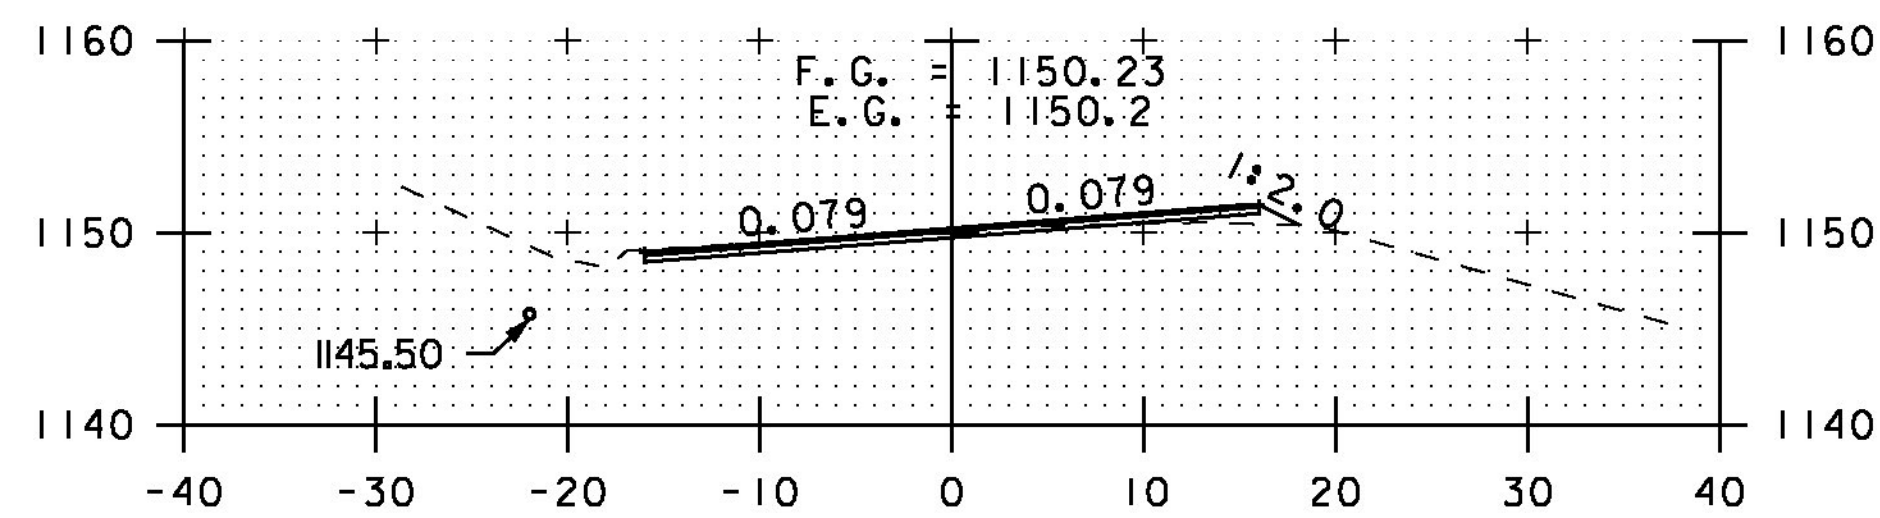


A 4+50

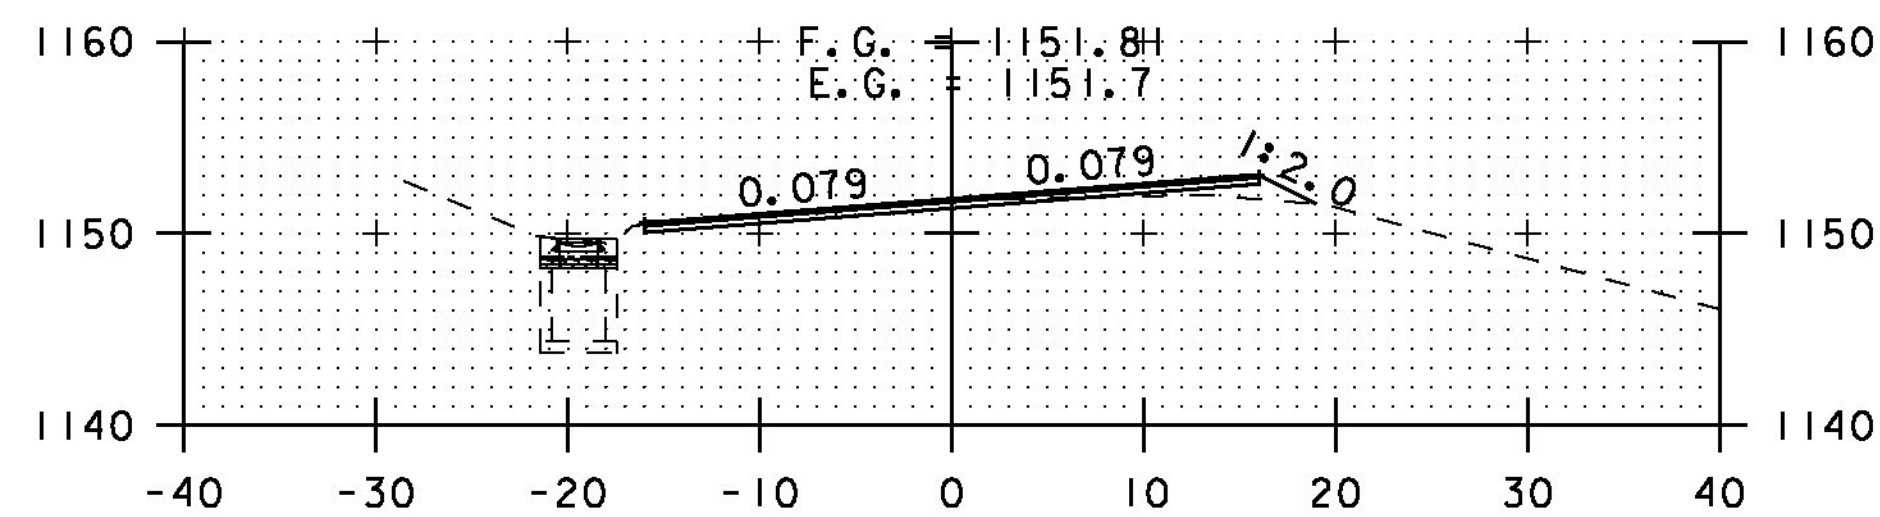


A 4+00

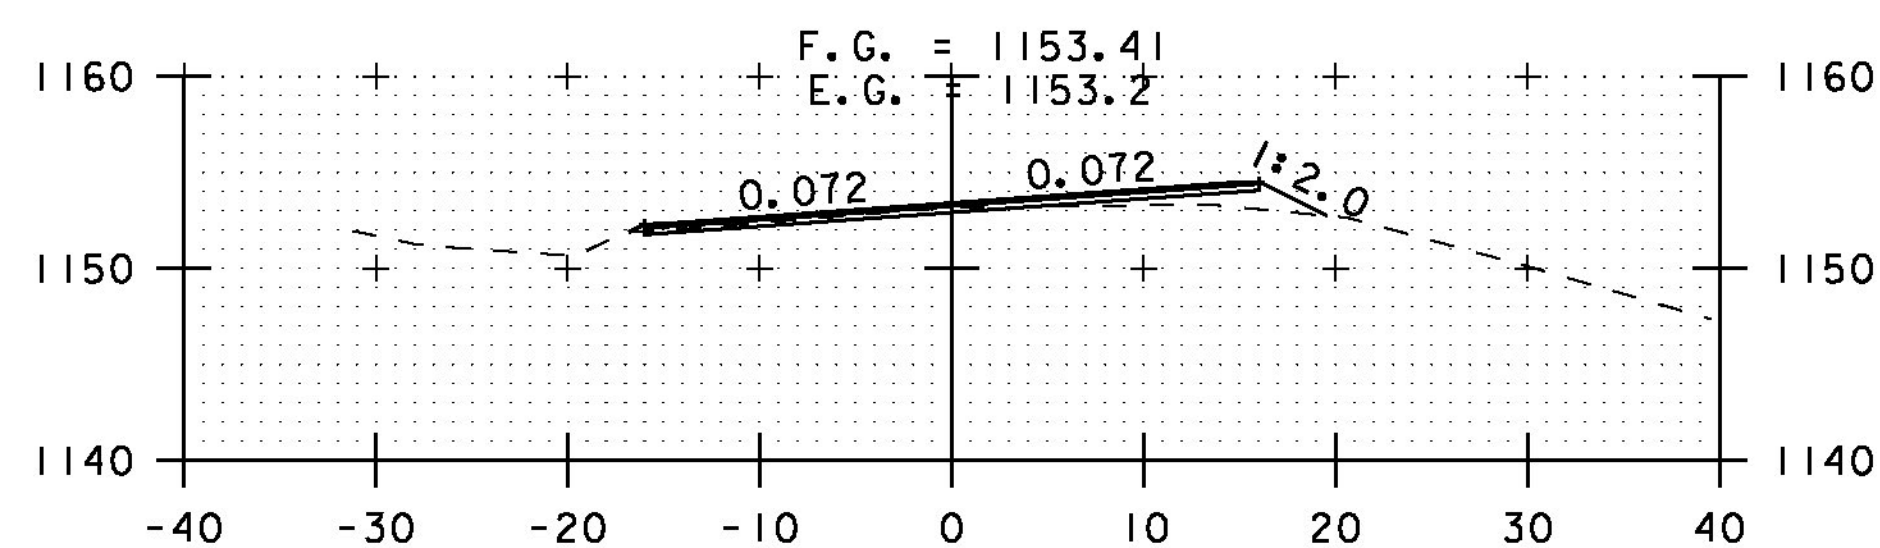


A 3+50

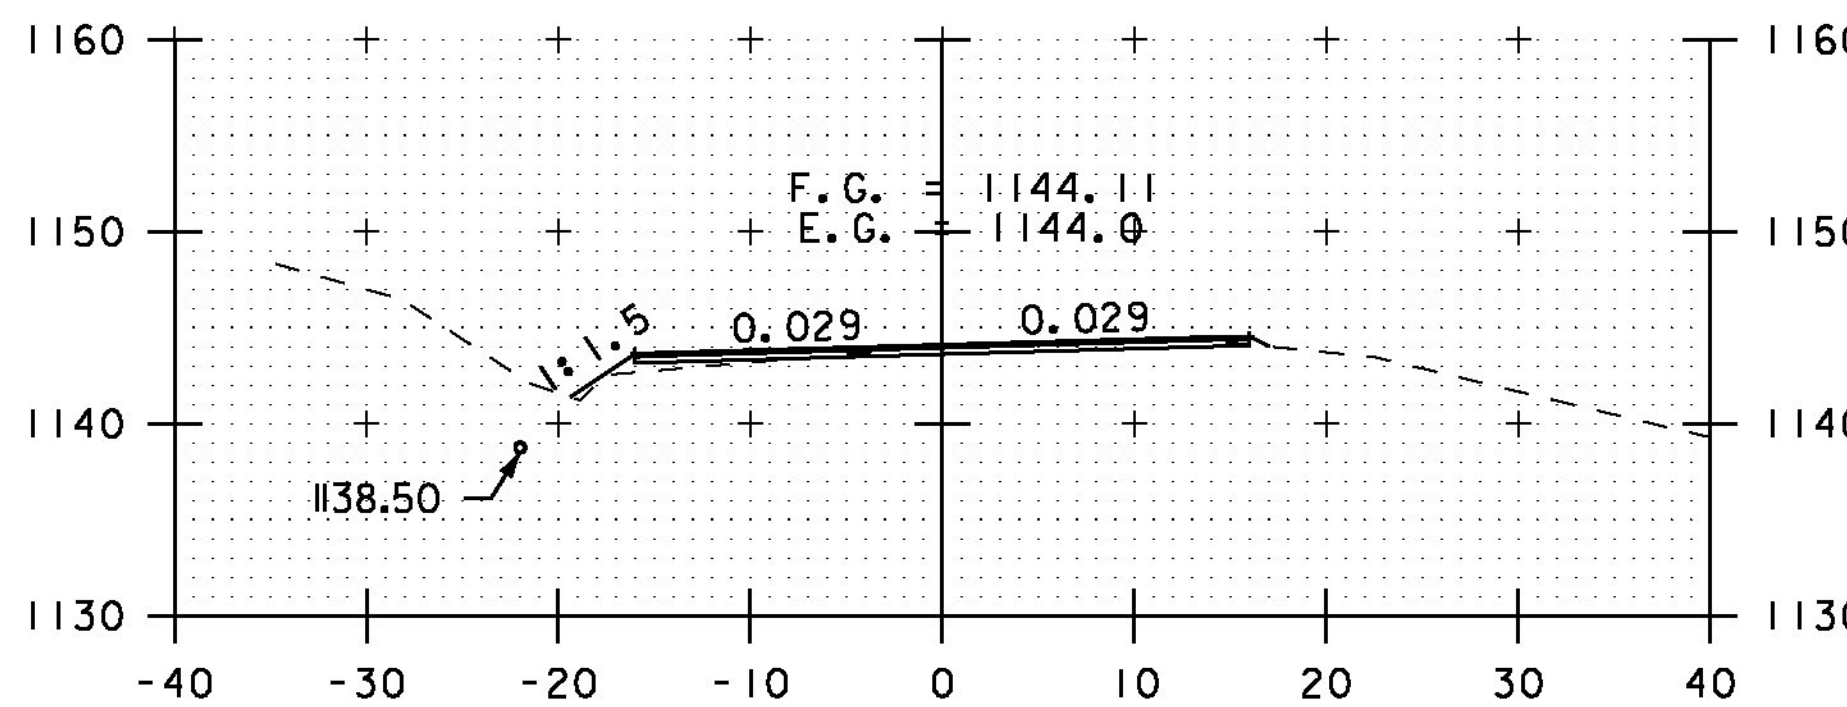


A 6+50

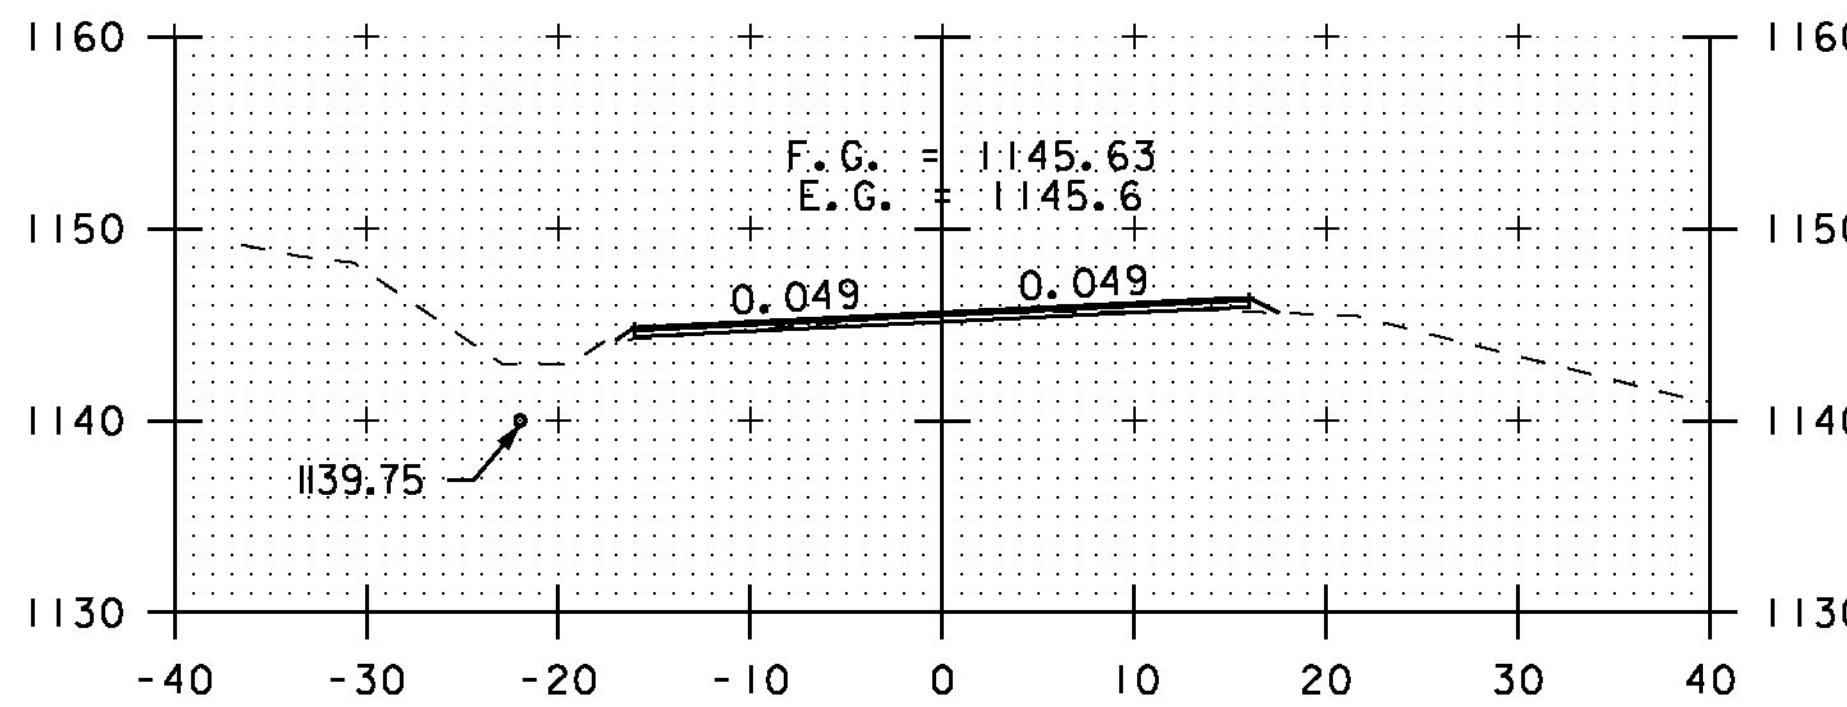


A 6+00

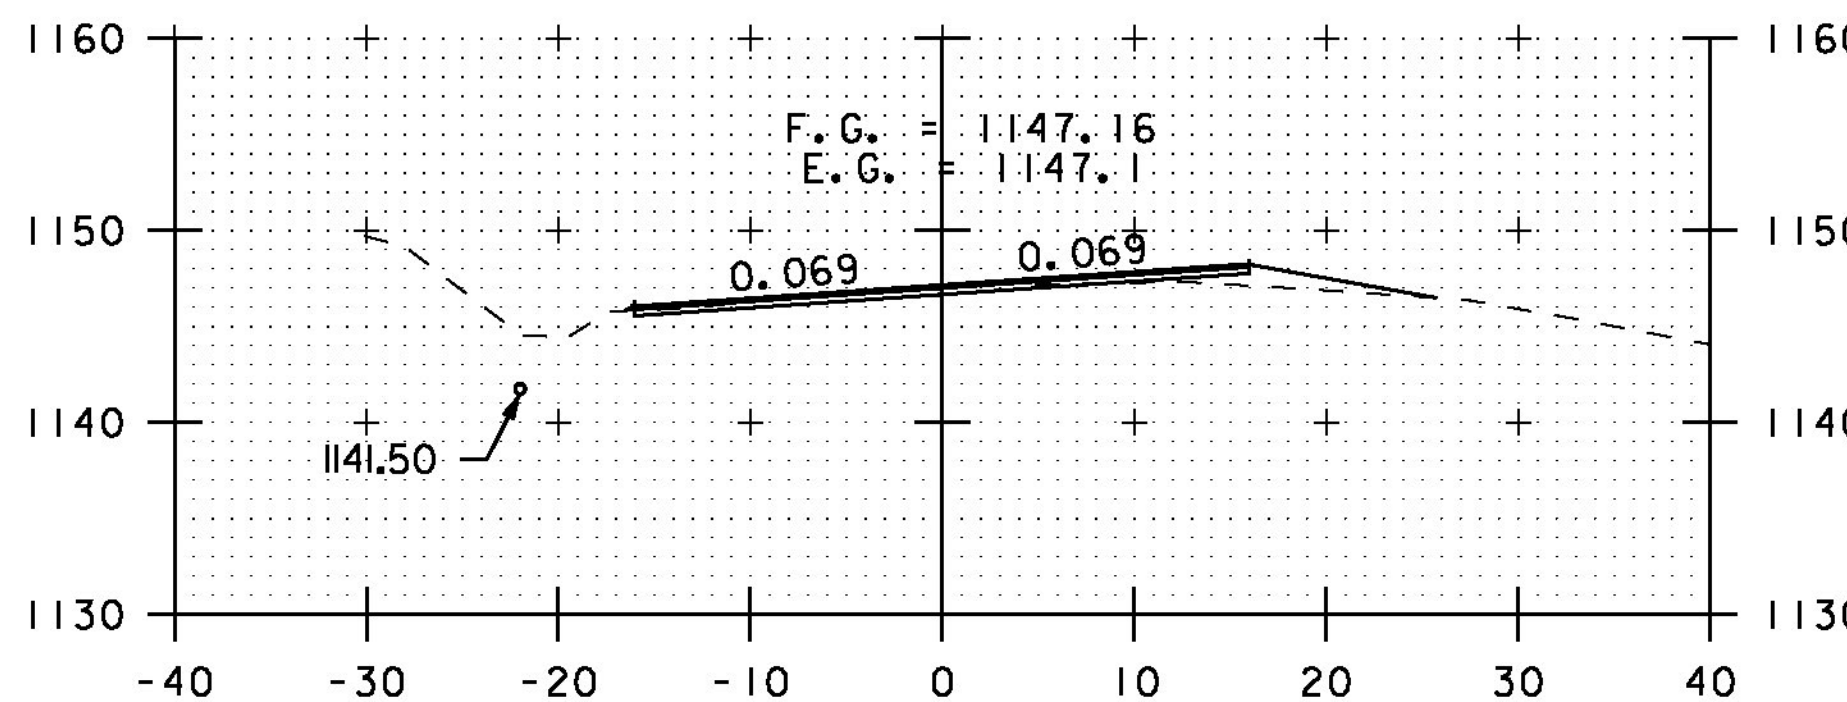


DRIVE RT
A 5+50

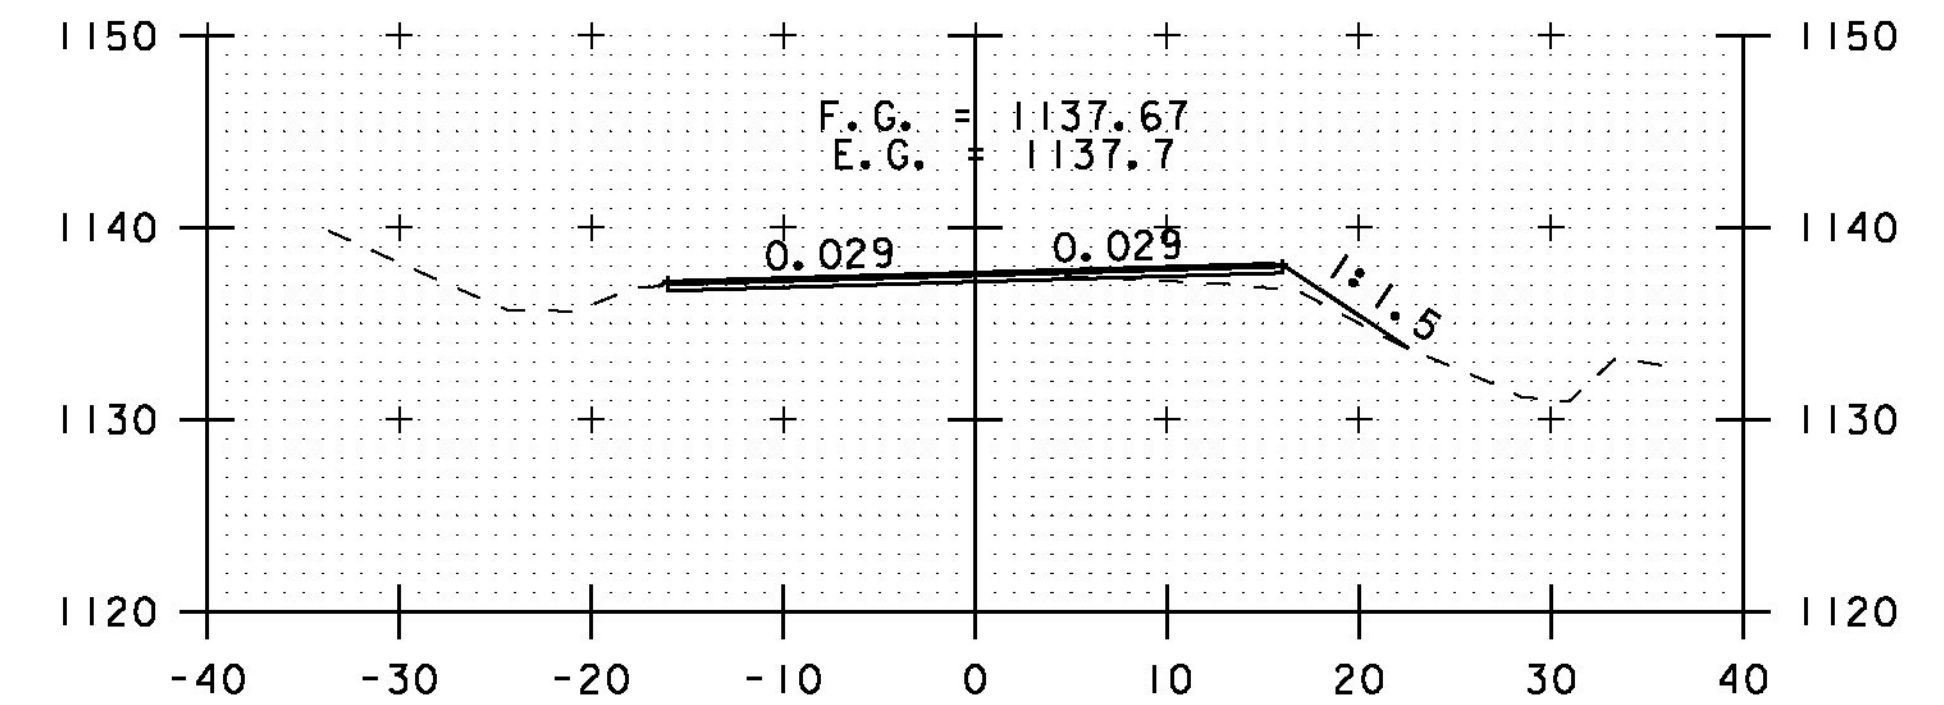


A 8+50

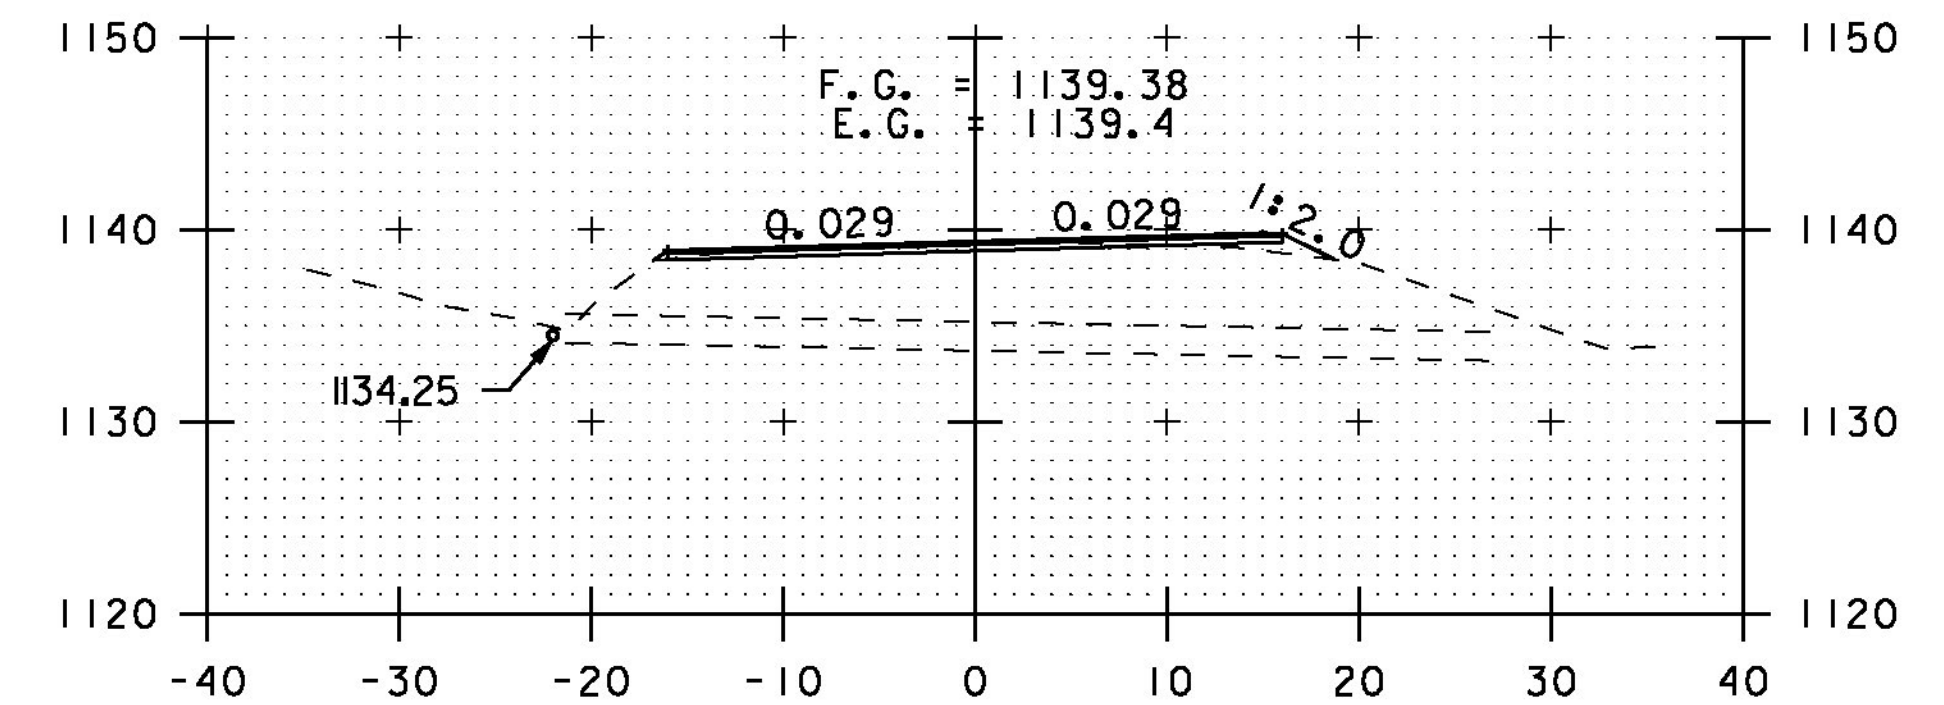

A 8+00

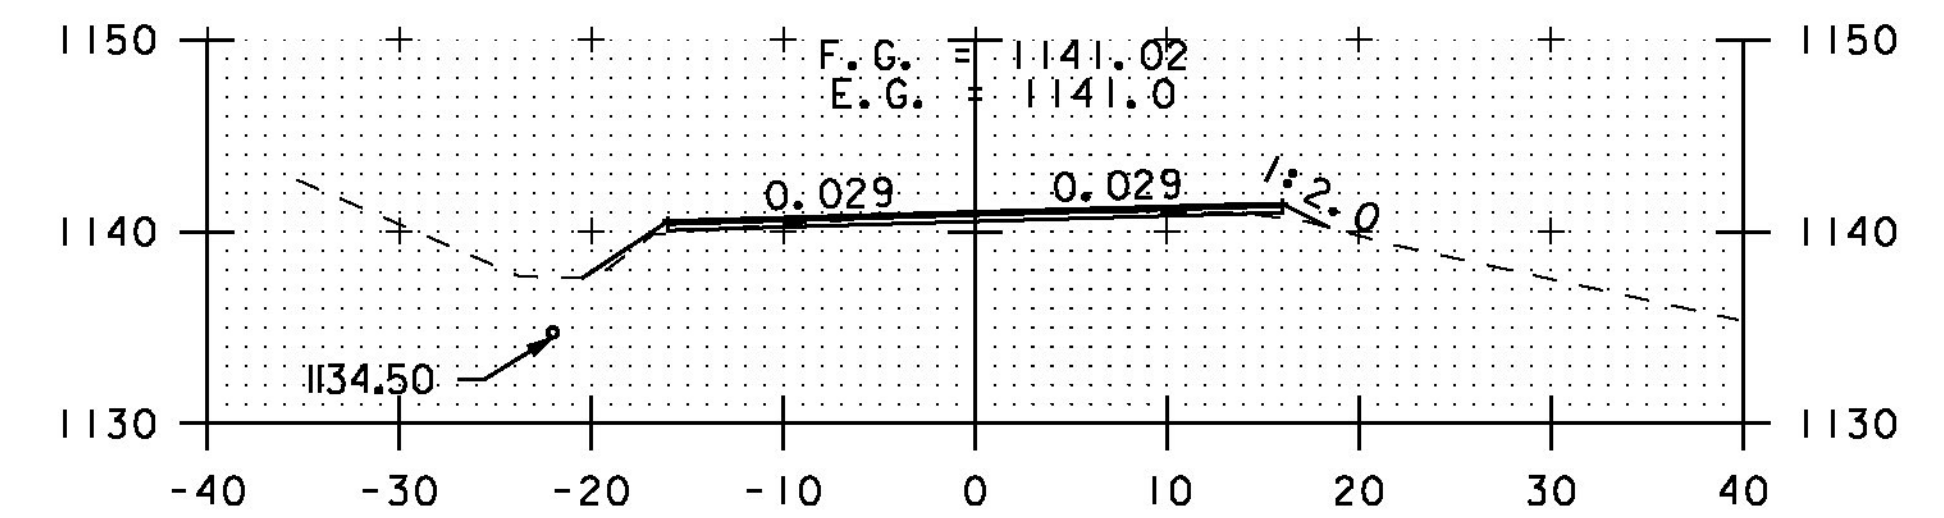

A 7+50

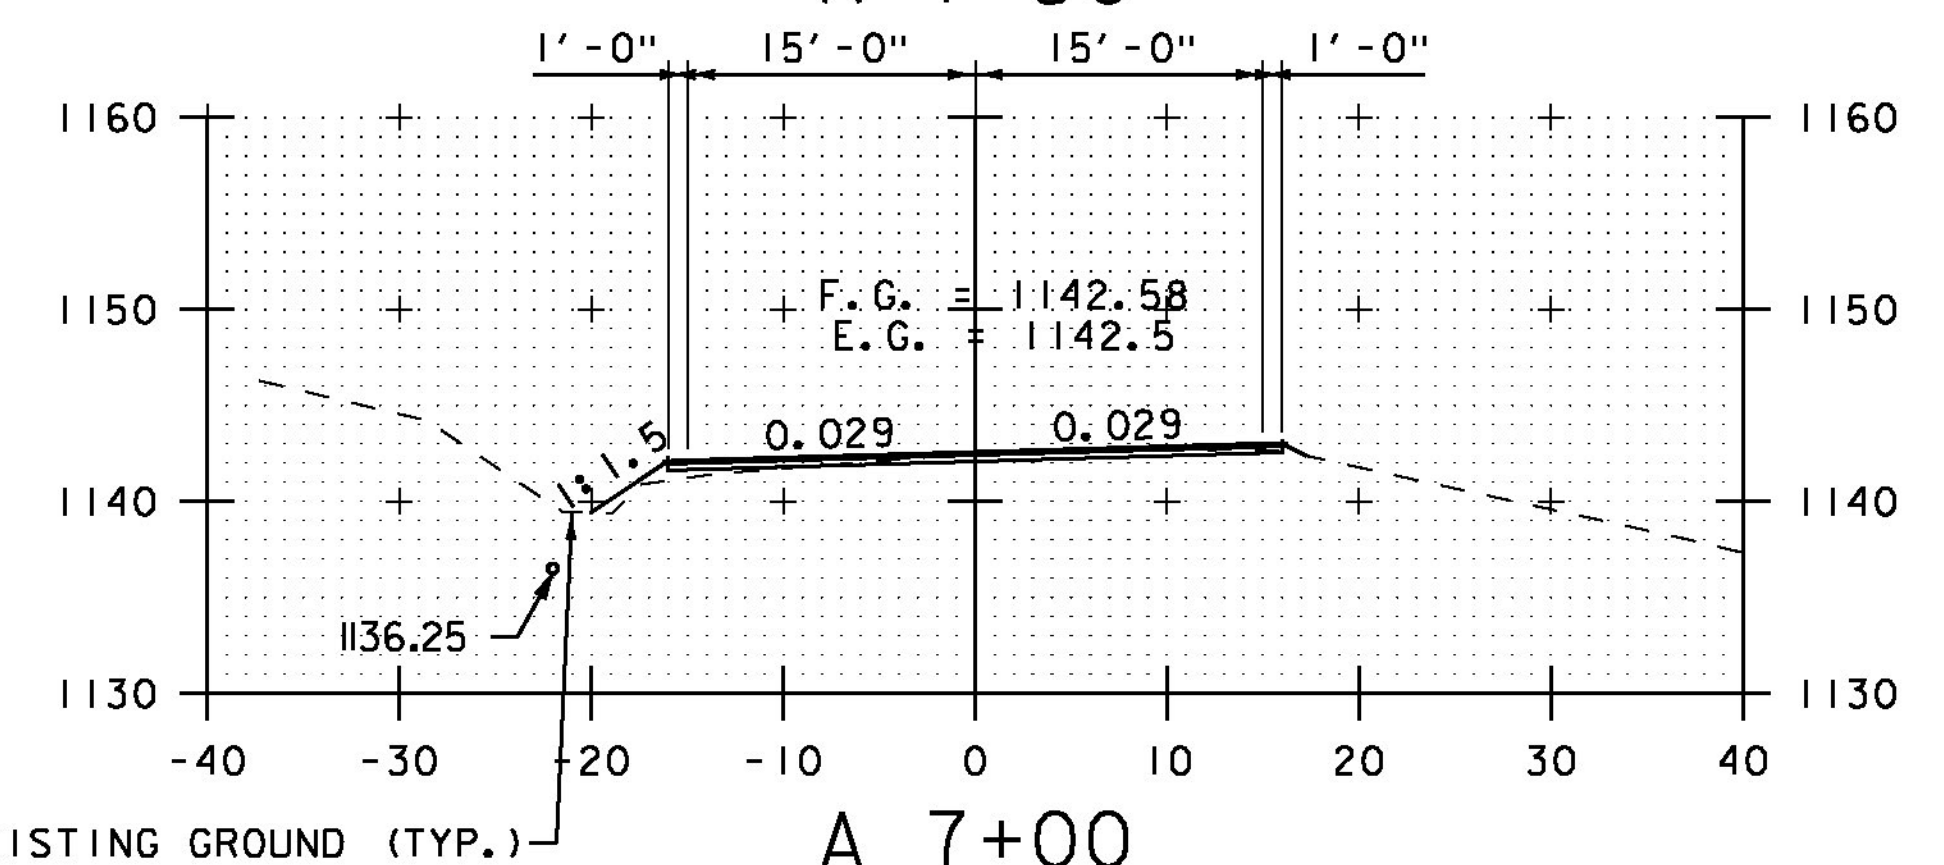

A 7+00

SCALE 1" = 10'-0"

STA. A 3+50 TO STA. A 8+50

CROSS SECTION SHEET 43

PROJECT NAME: ELMORE-MORRISTOWN

PROJECT NUMBER: STP 2937 (1)

FILE NAME: z11c310.dgn

PROJECT LEADER: C. LATHROP

DESIGNED BY: S. LAMPHERE

PLOT FILE: z11c310_171.i

PLOT DATE: 3/3/14

DRAWN BY: B. MARTIN

CHECKED BY: C. LATHROP

SHEET 171 OF 194