




A 10+50

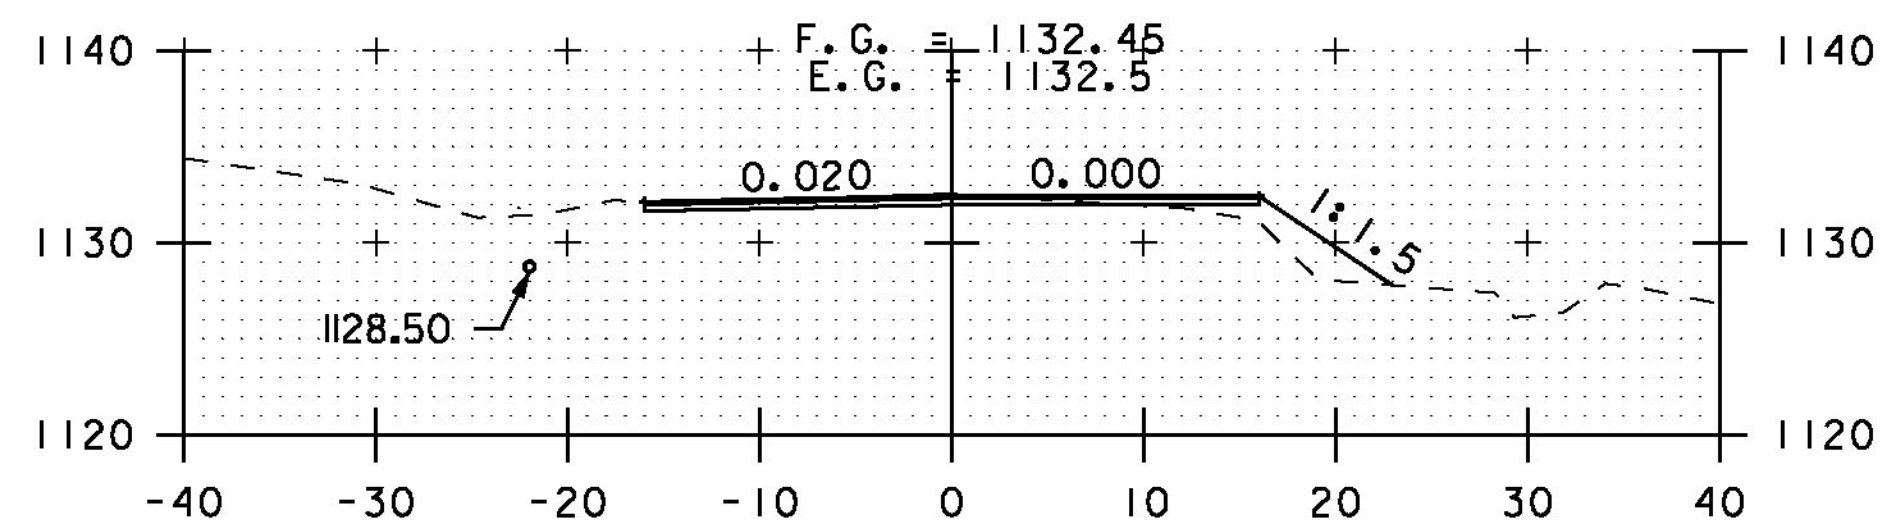


A 10+00

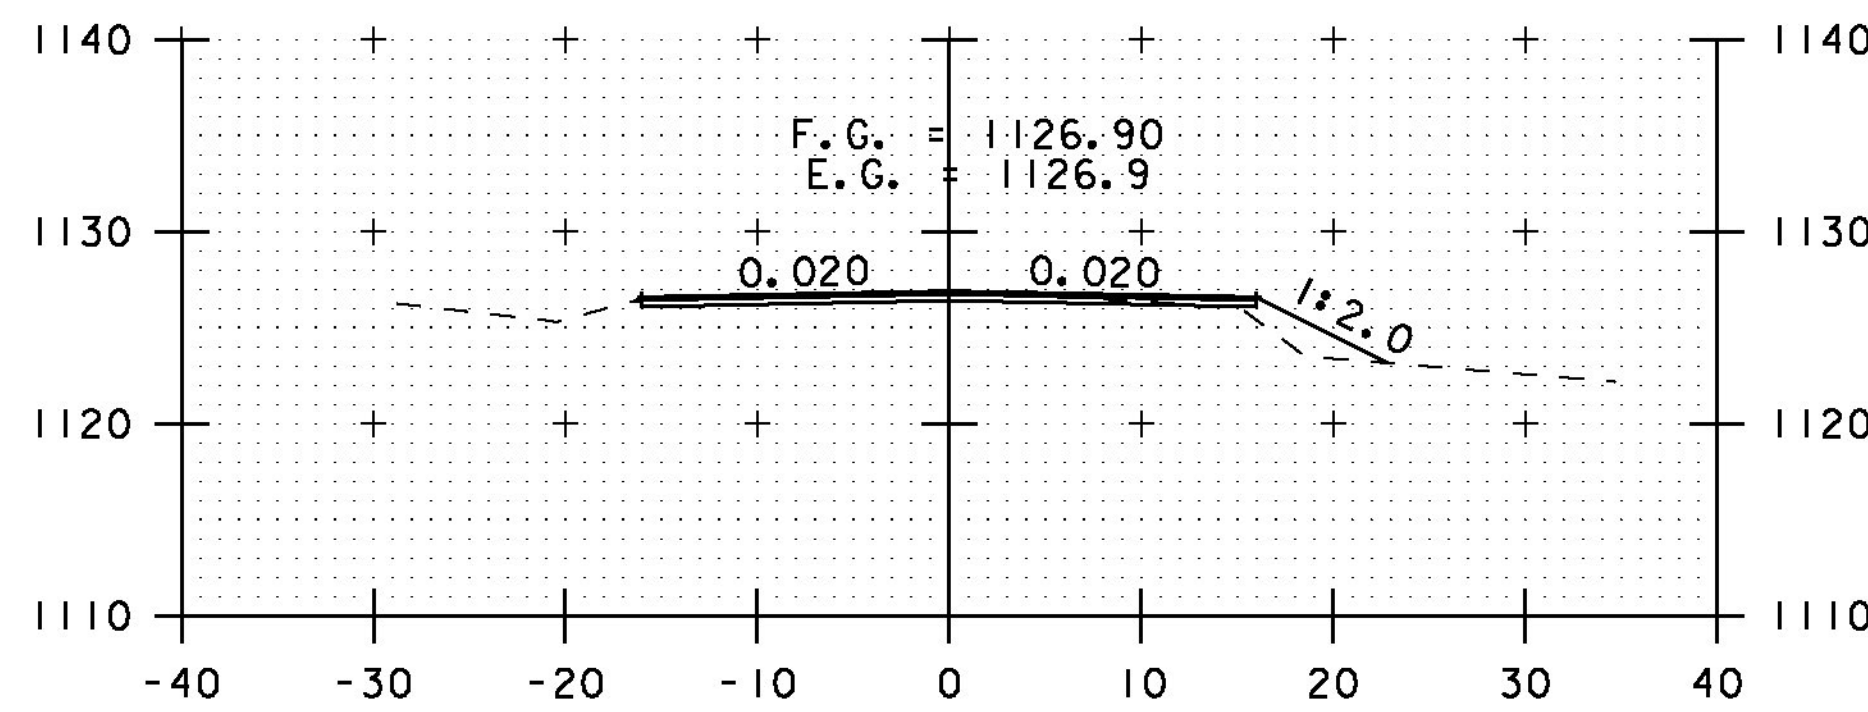


A 12+00

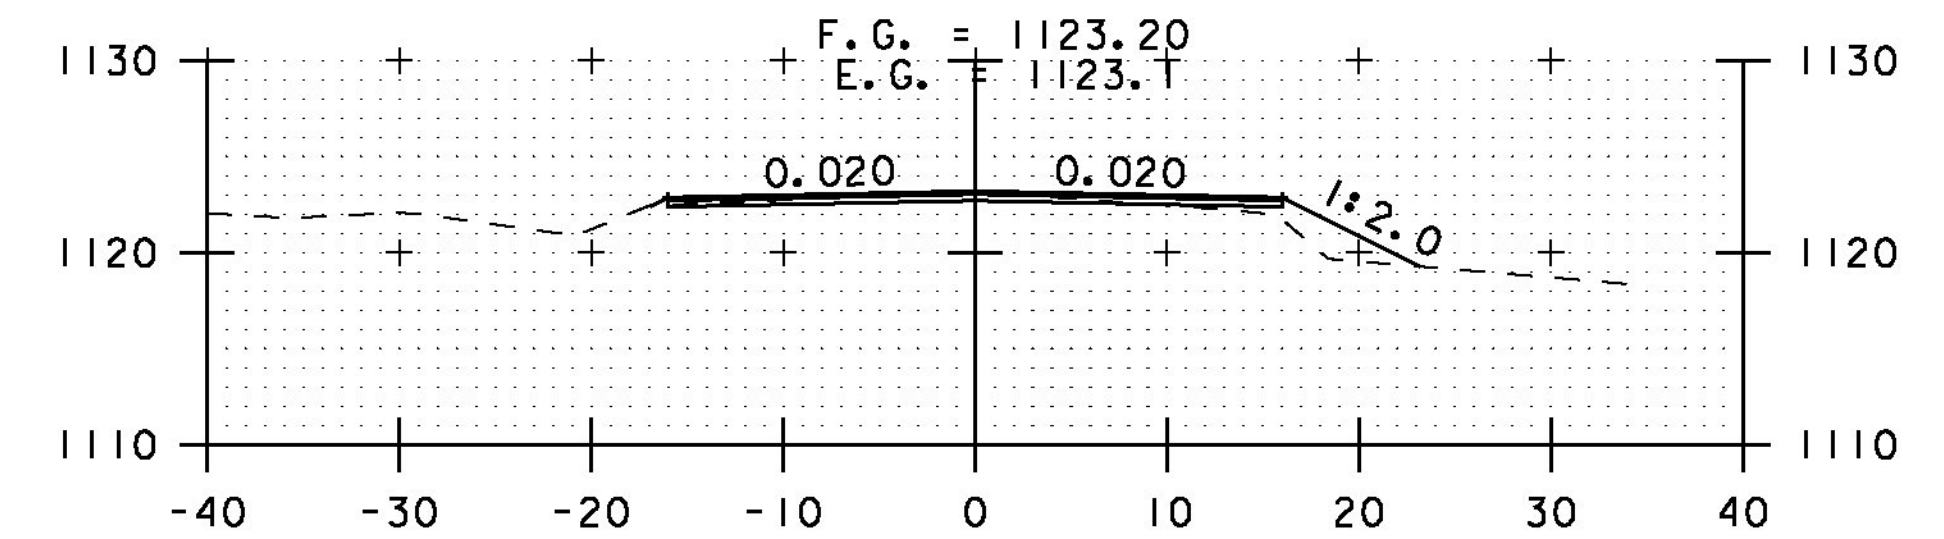


A 14+00

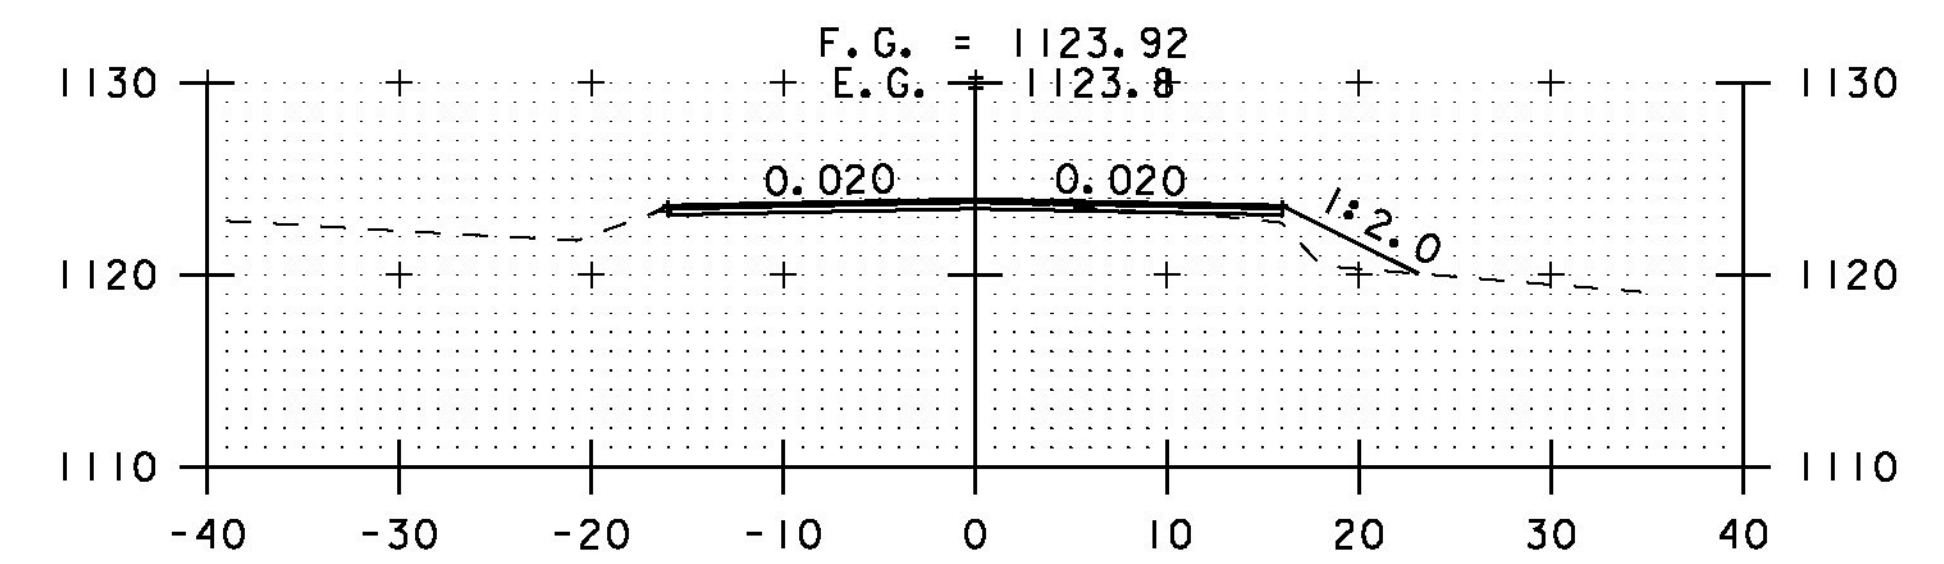


A 13+50

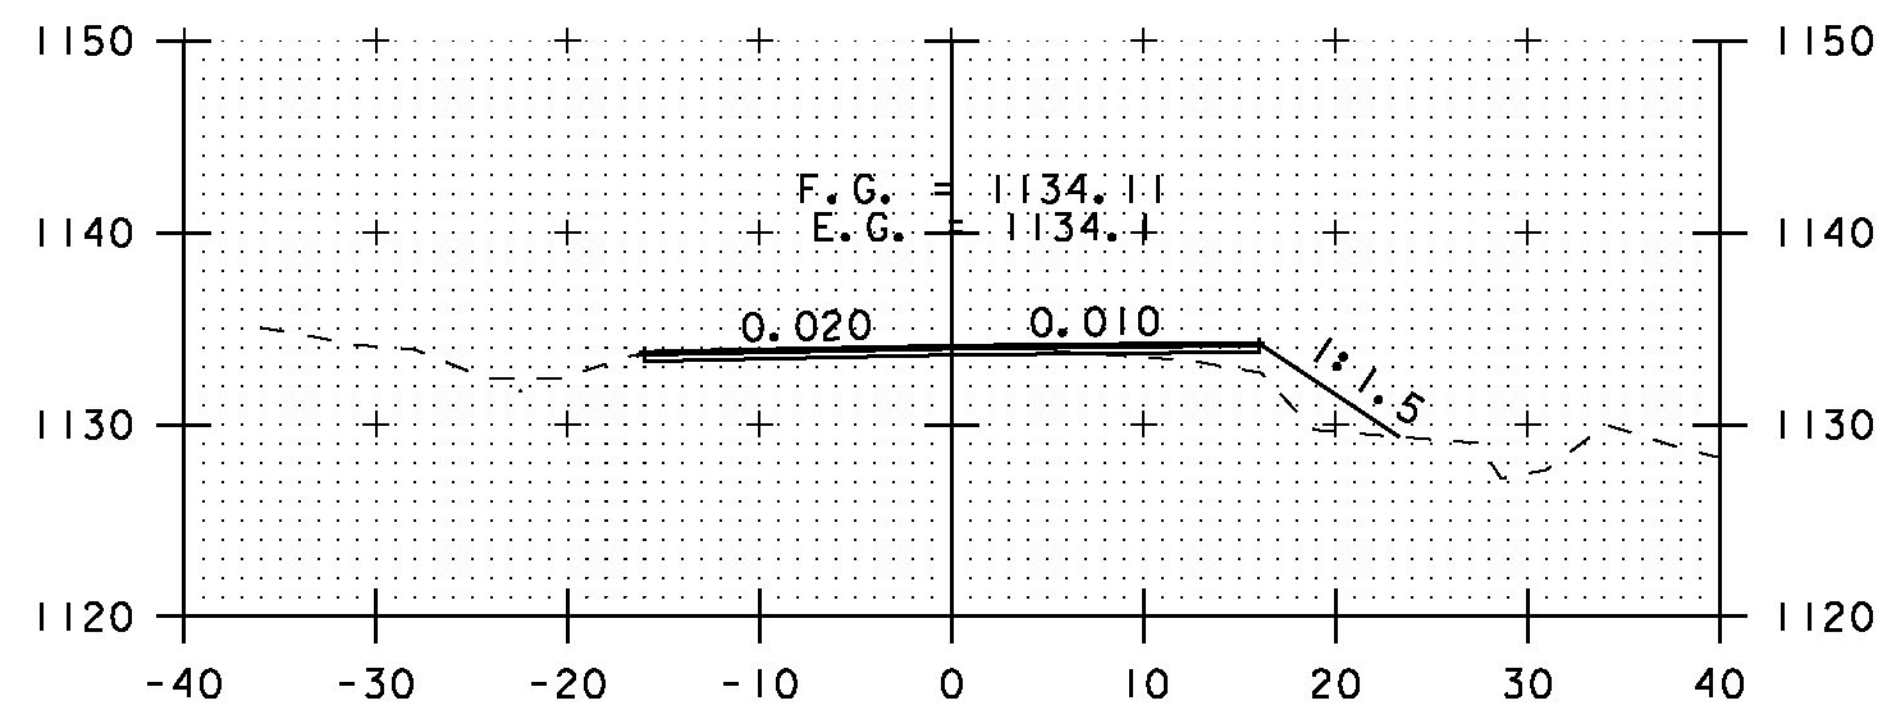


A 9+50

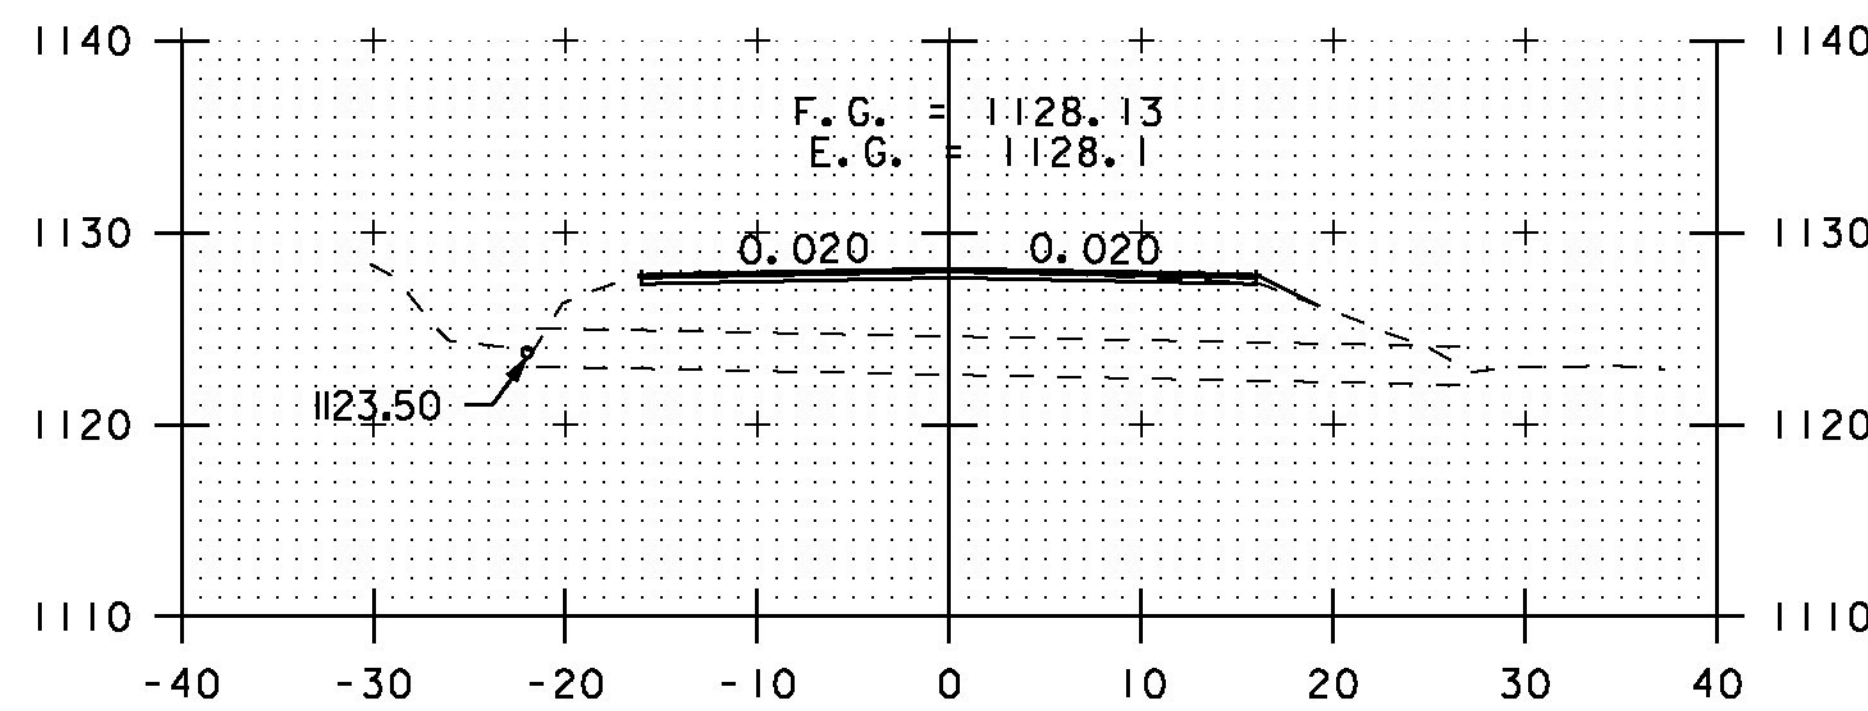


A 11+50

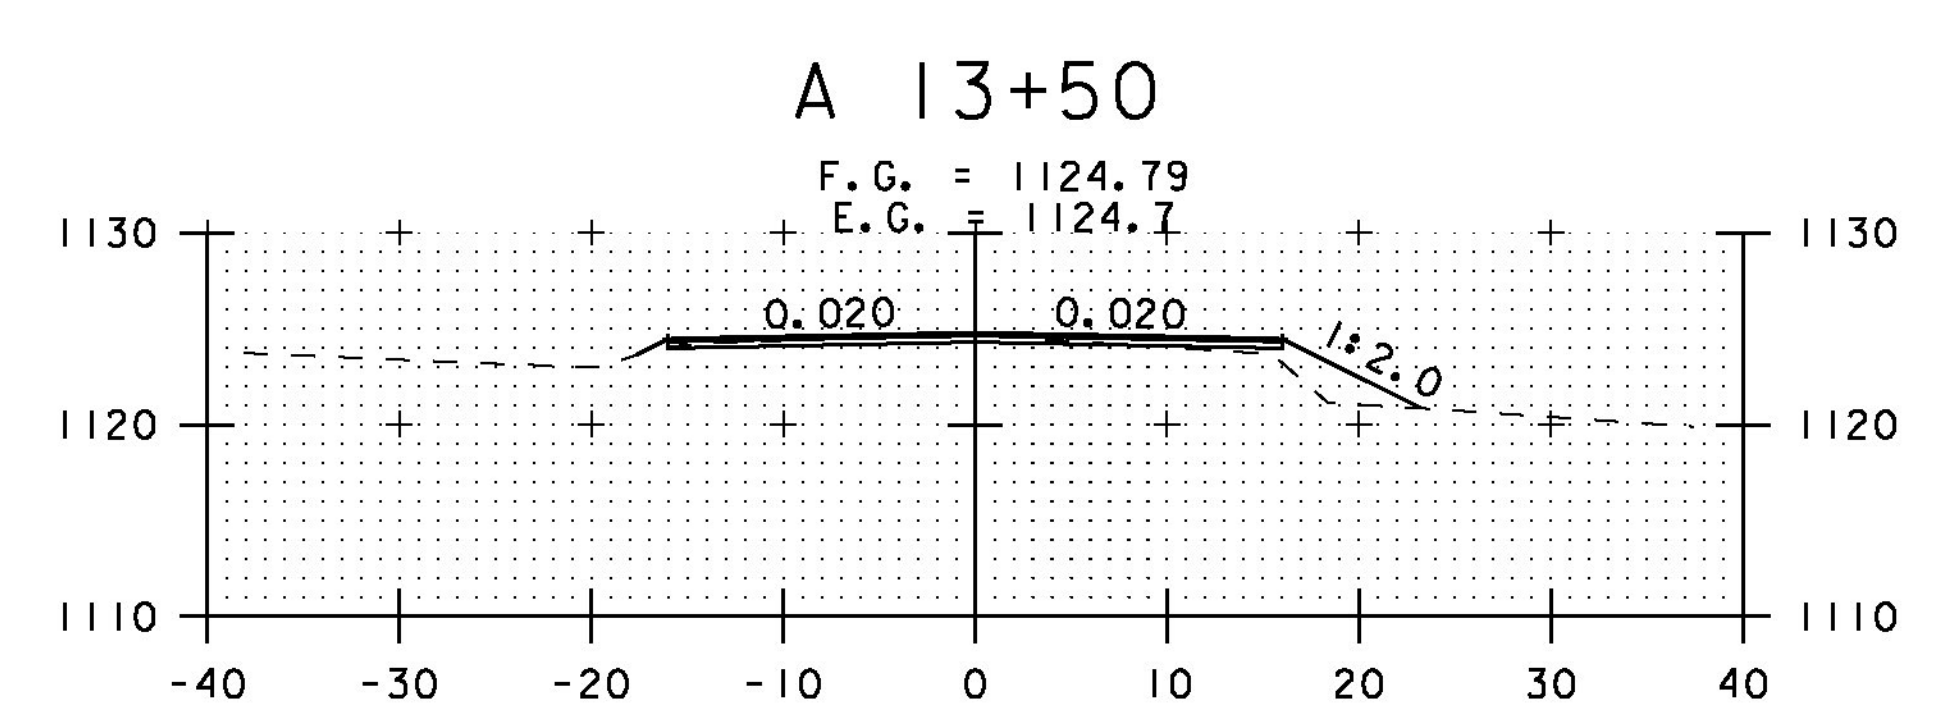


A 13+00

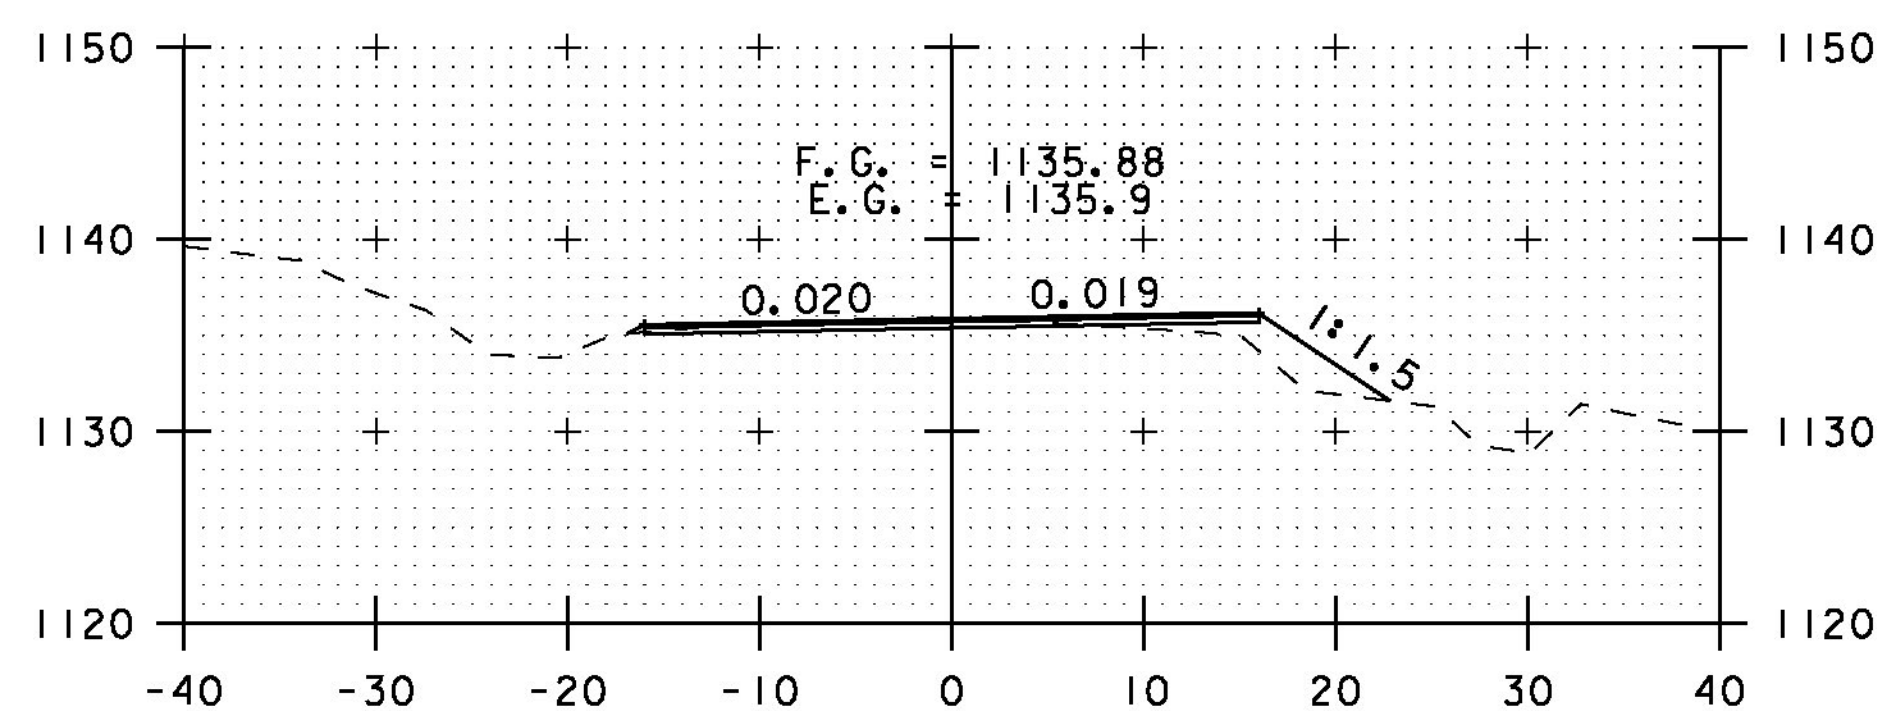

A 9+00

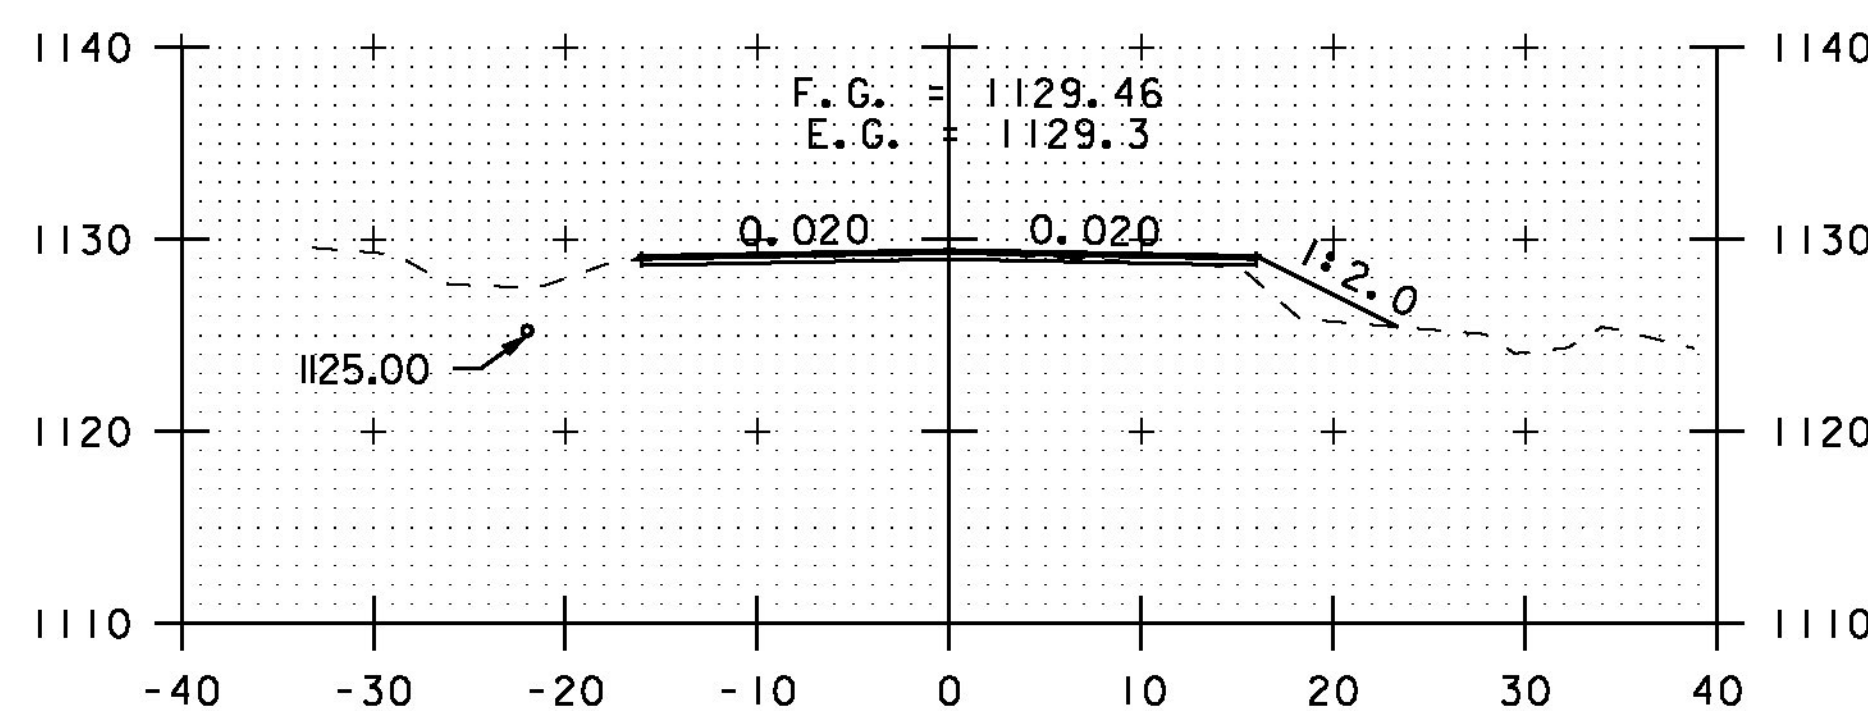

A 11+00

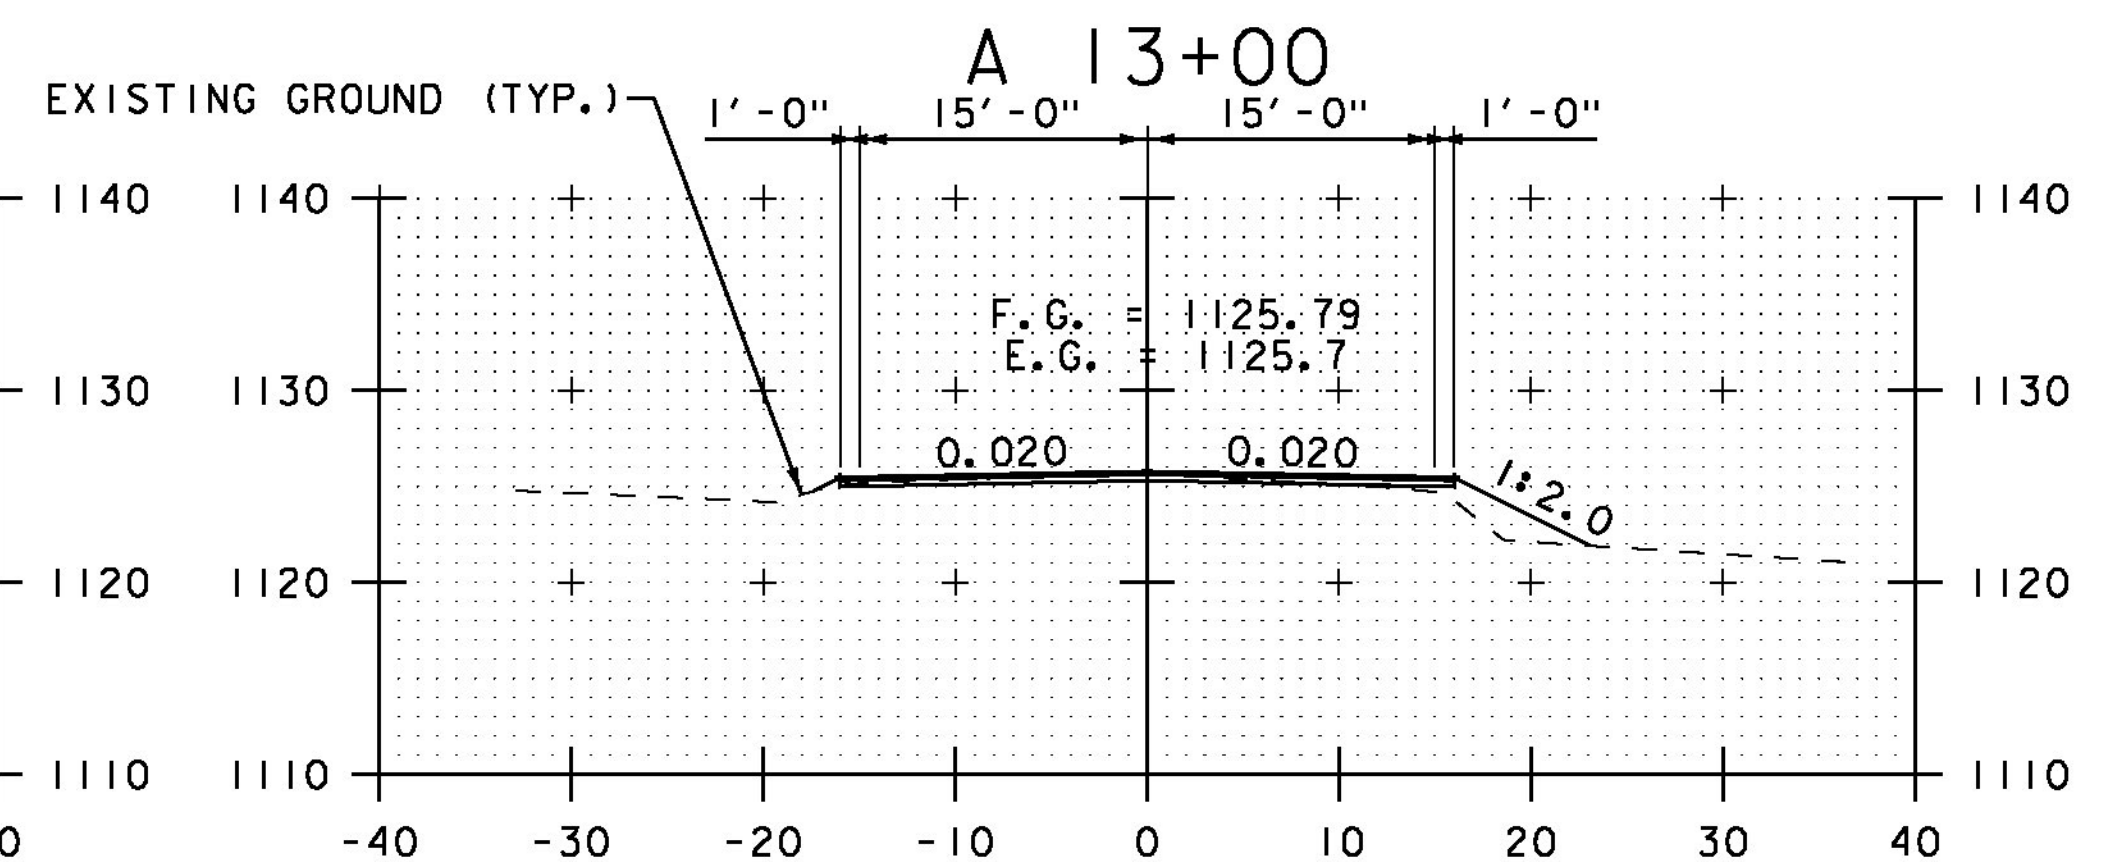

A 12+50

STA. A 9+00 TO STA. A 14+00



CROSS SECTION SHEET 44

PROJECT NAME: ELMORE-MORRISTOWN

PROJECT NUMBER: STP 2937 (I)

FILE NAME: z11c310.dgn

PROJECT LEADER: C. LATHROP

DESIGNED BY: S. LAMPHERE

PLOT FILE: z11c310_172.i

PLOT DATE: 3/3/14

DRAWN BY: B. MARTIN

CHECKED BY: C. LATHROP

SHEET 172 OF 194