




A 21+50

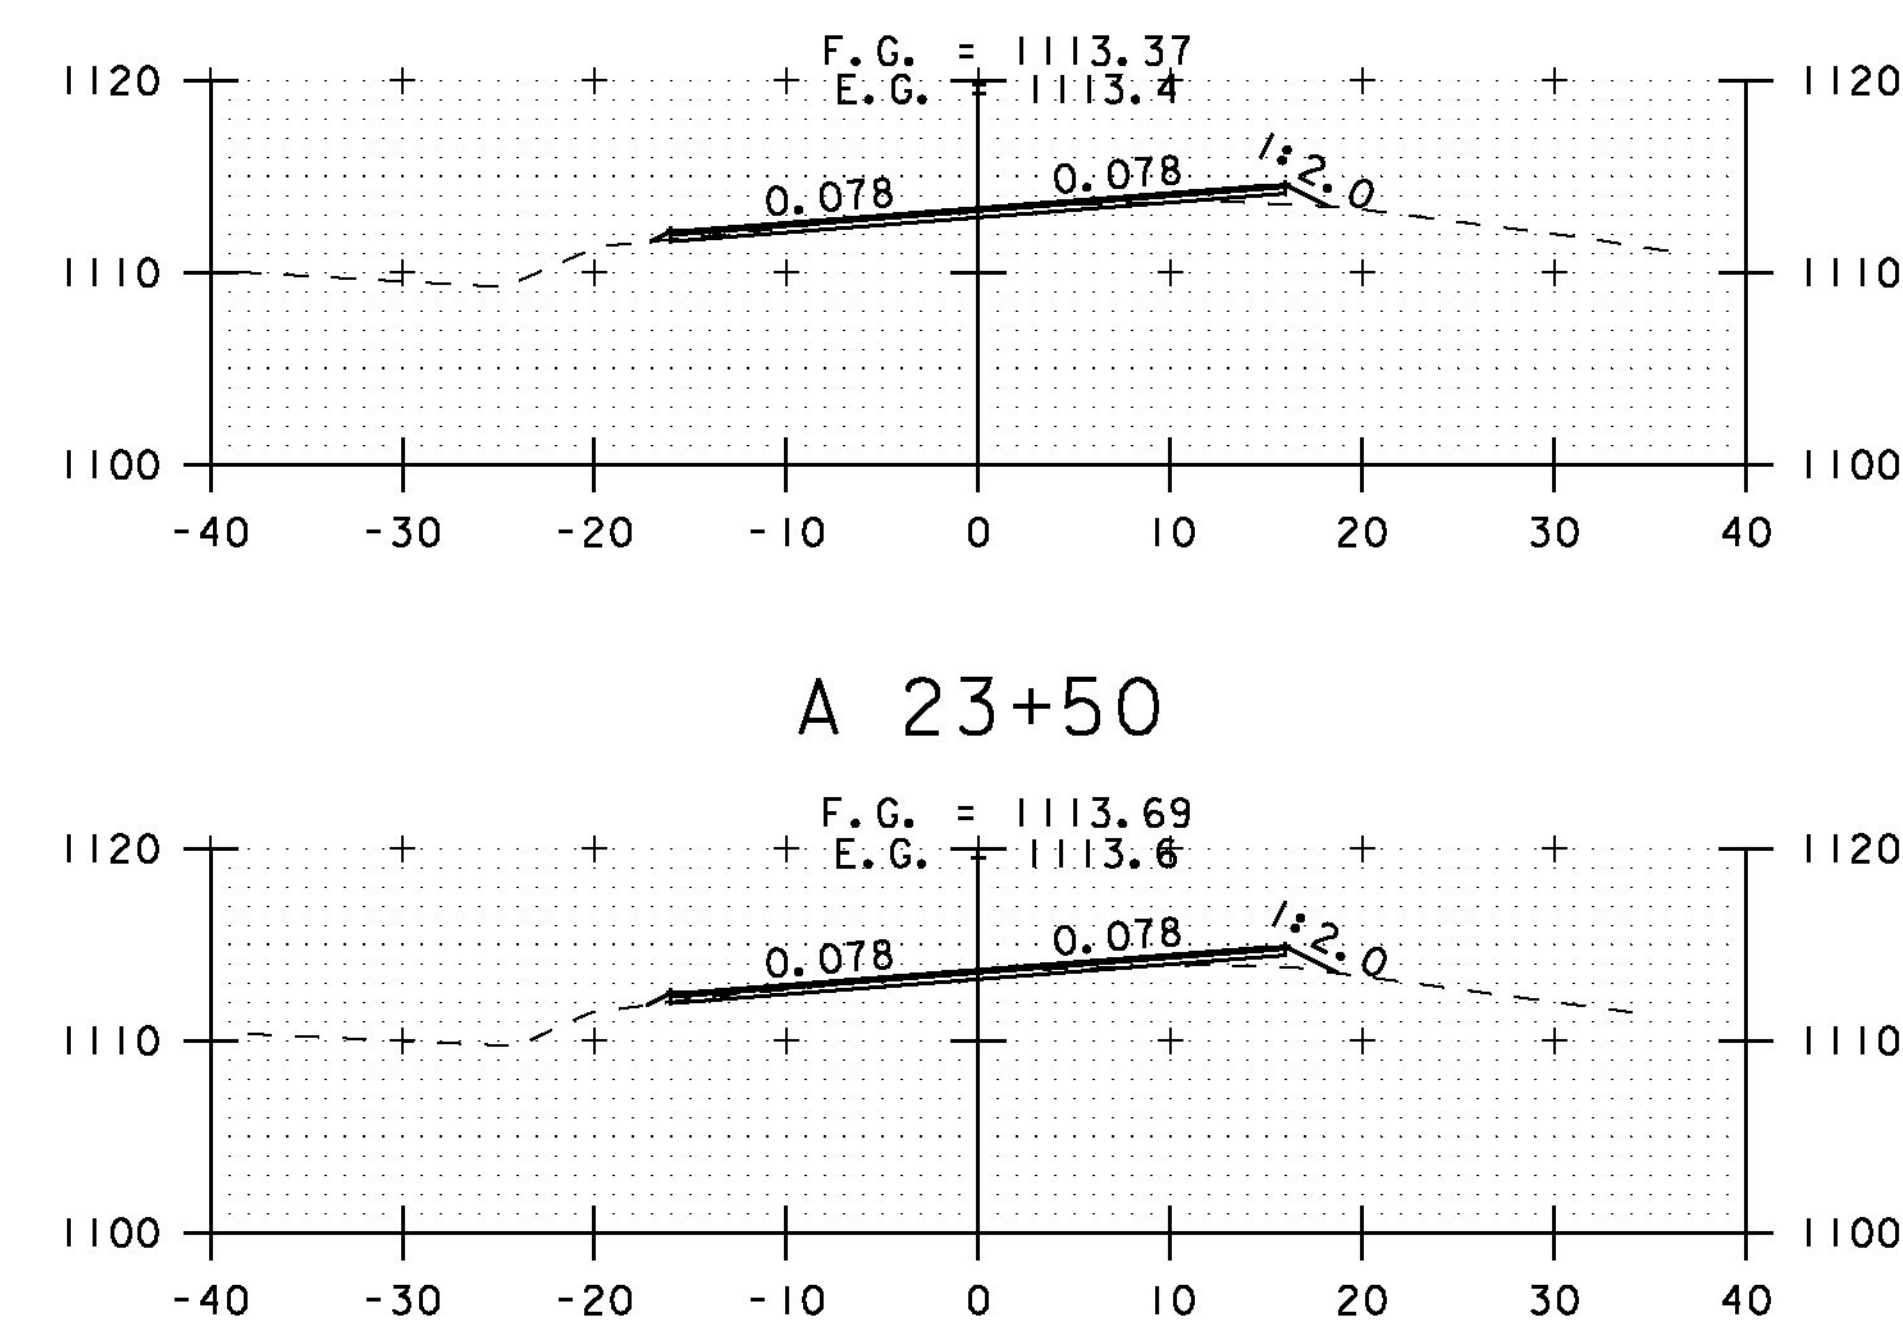


A 23+50

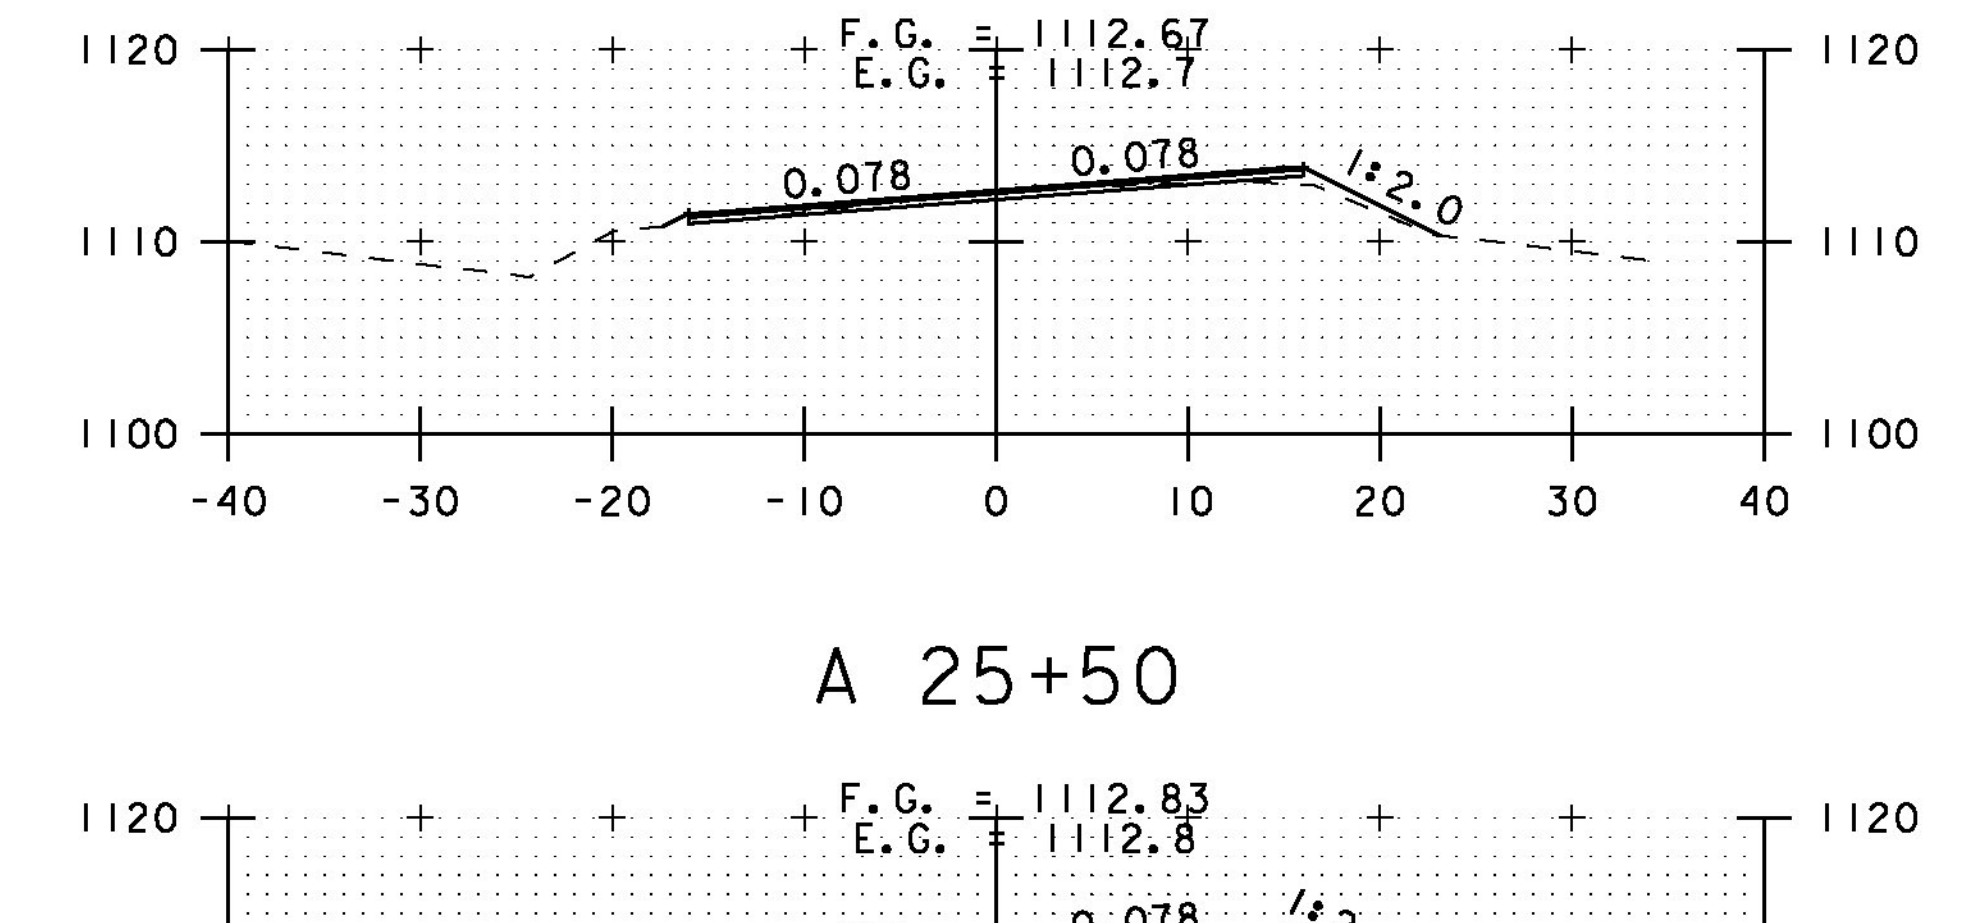


A 25+50

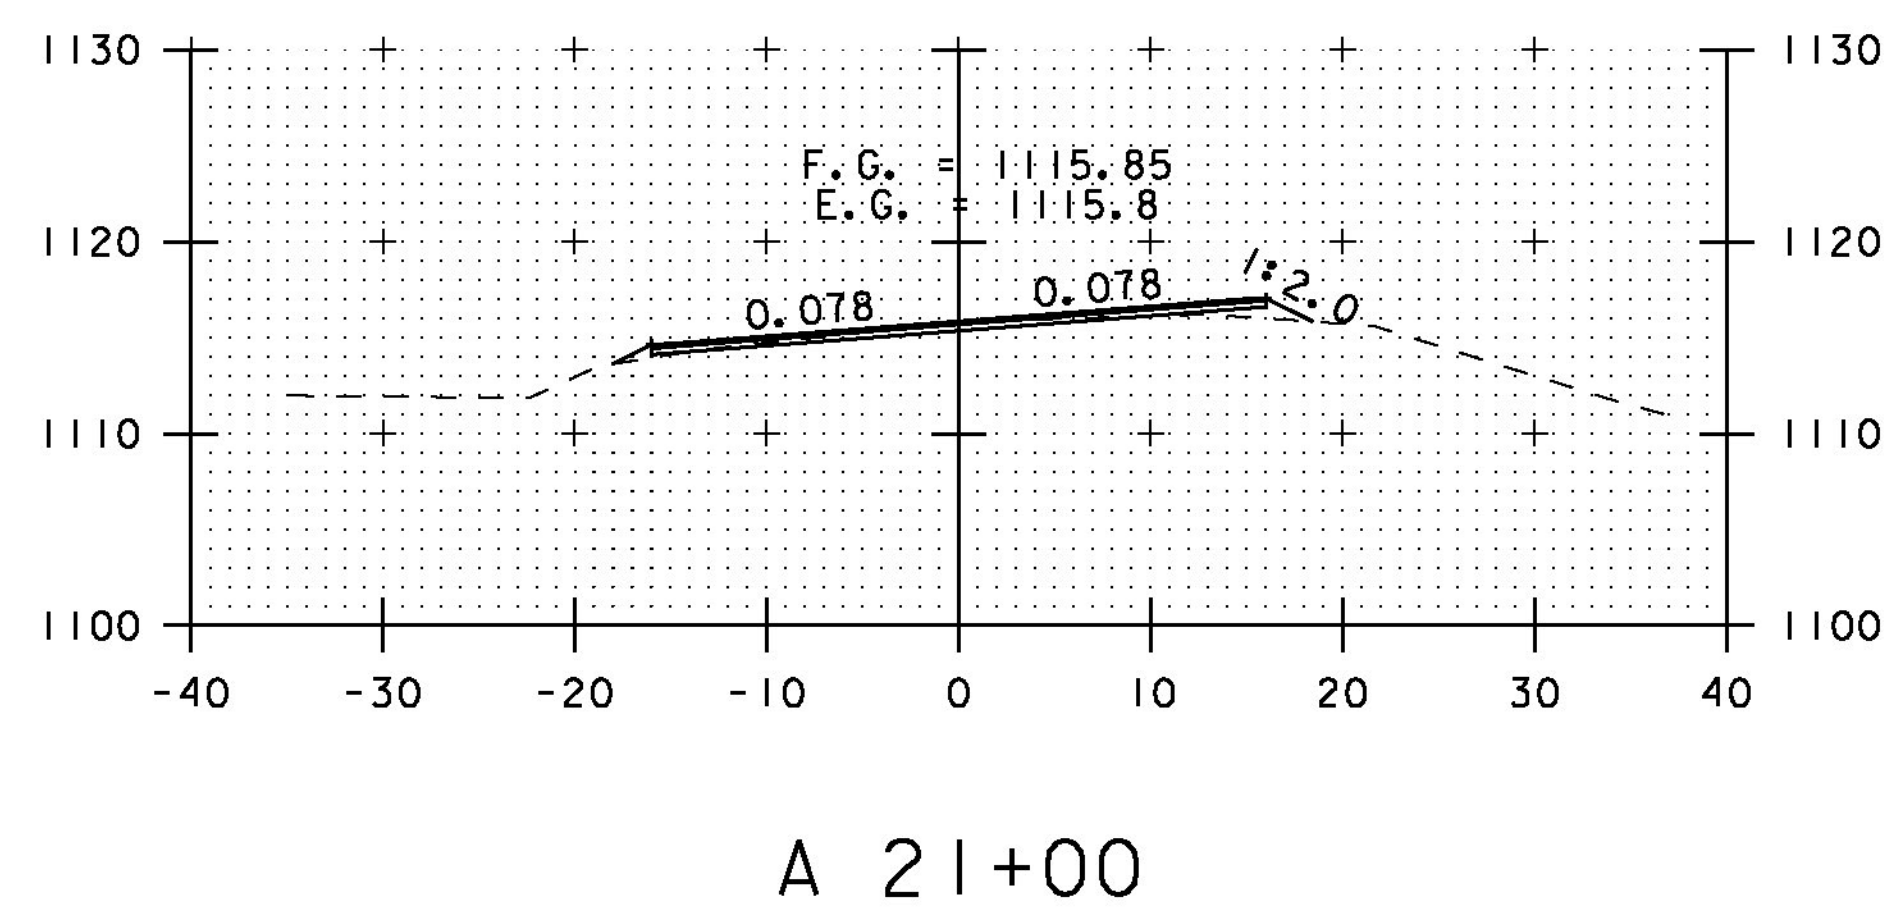


A 21+00

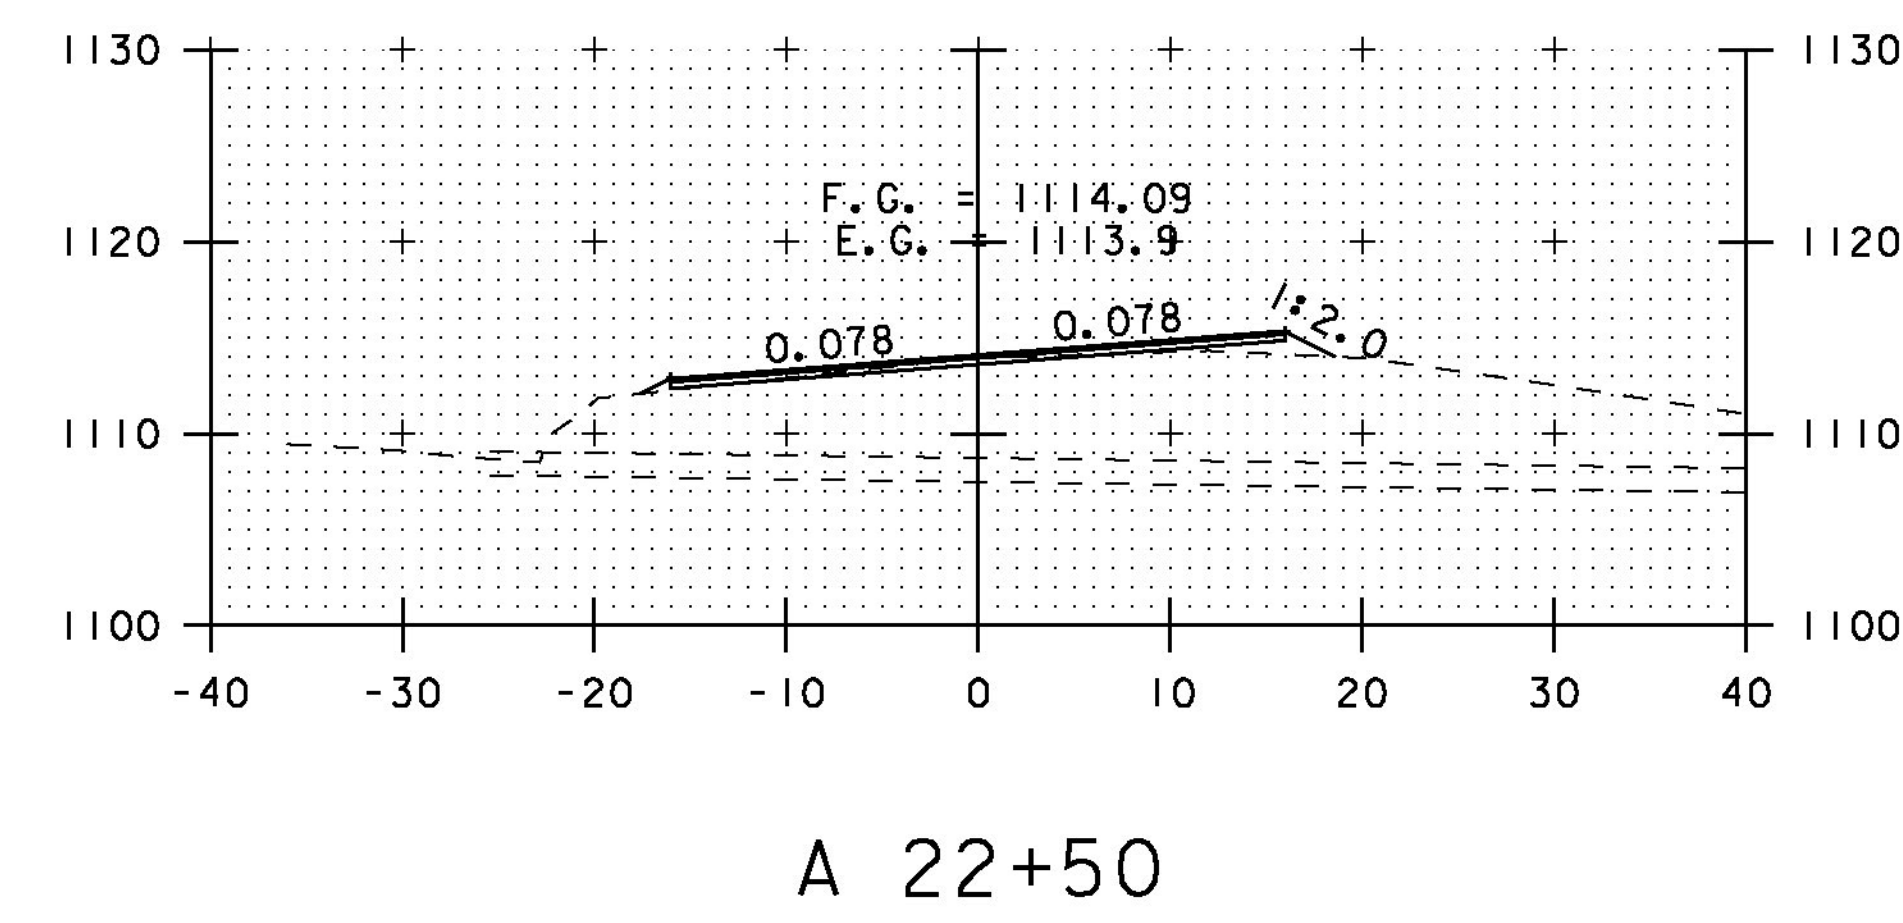


A 22+50

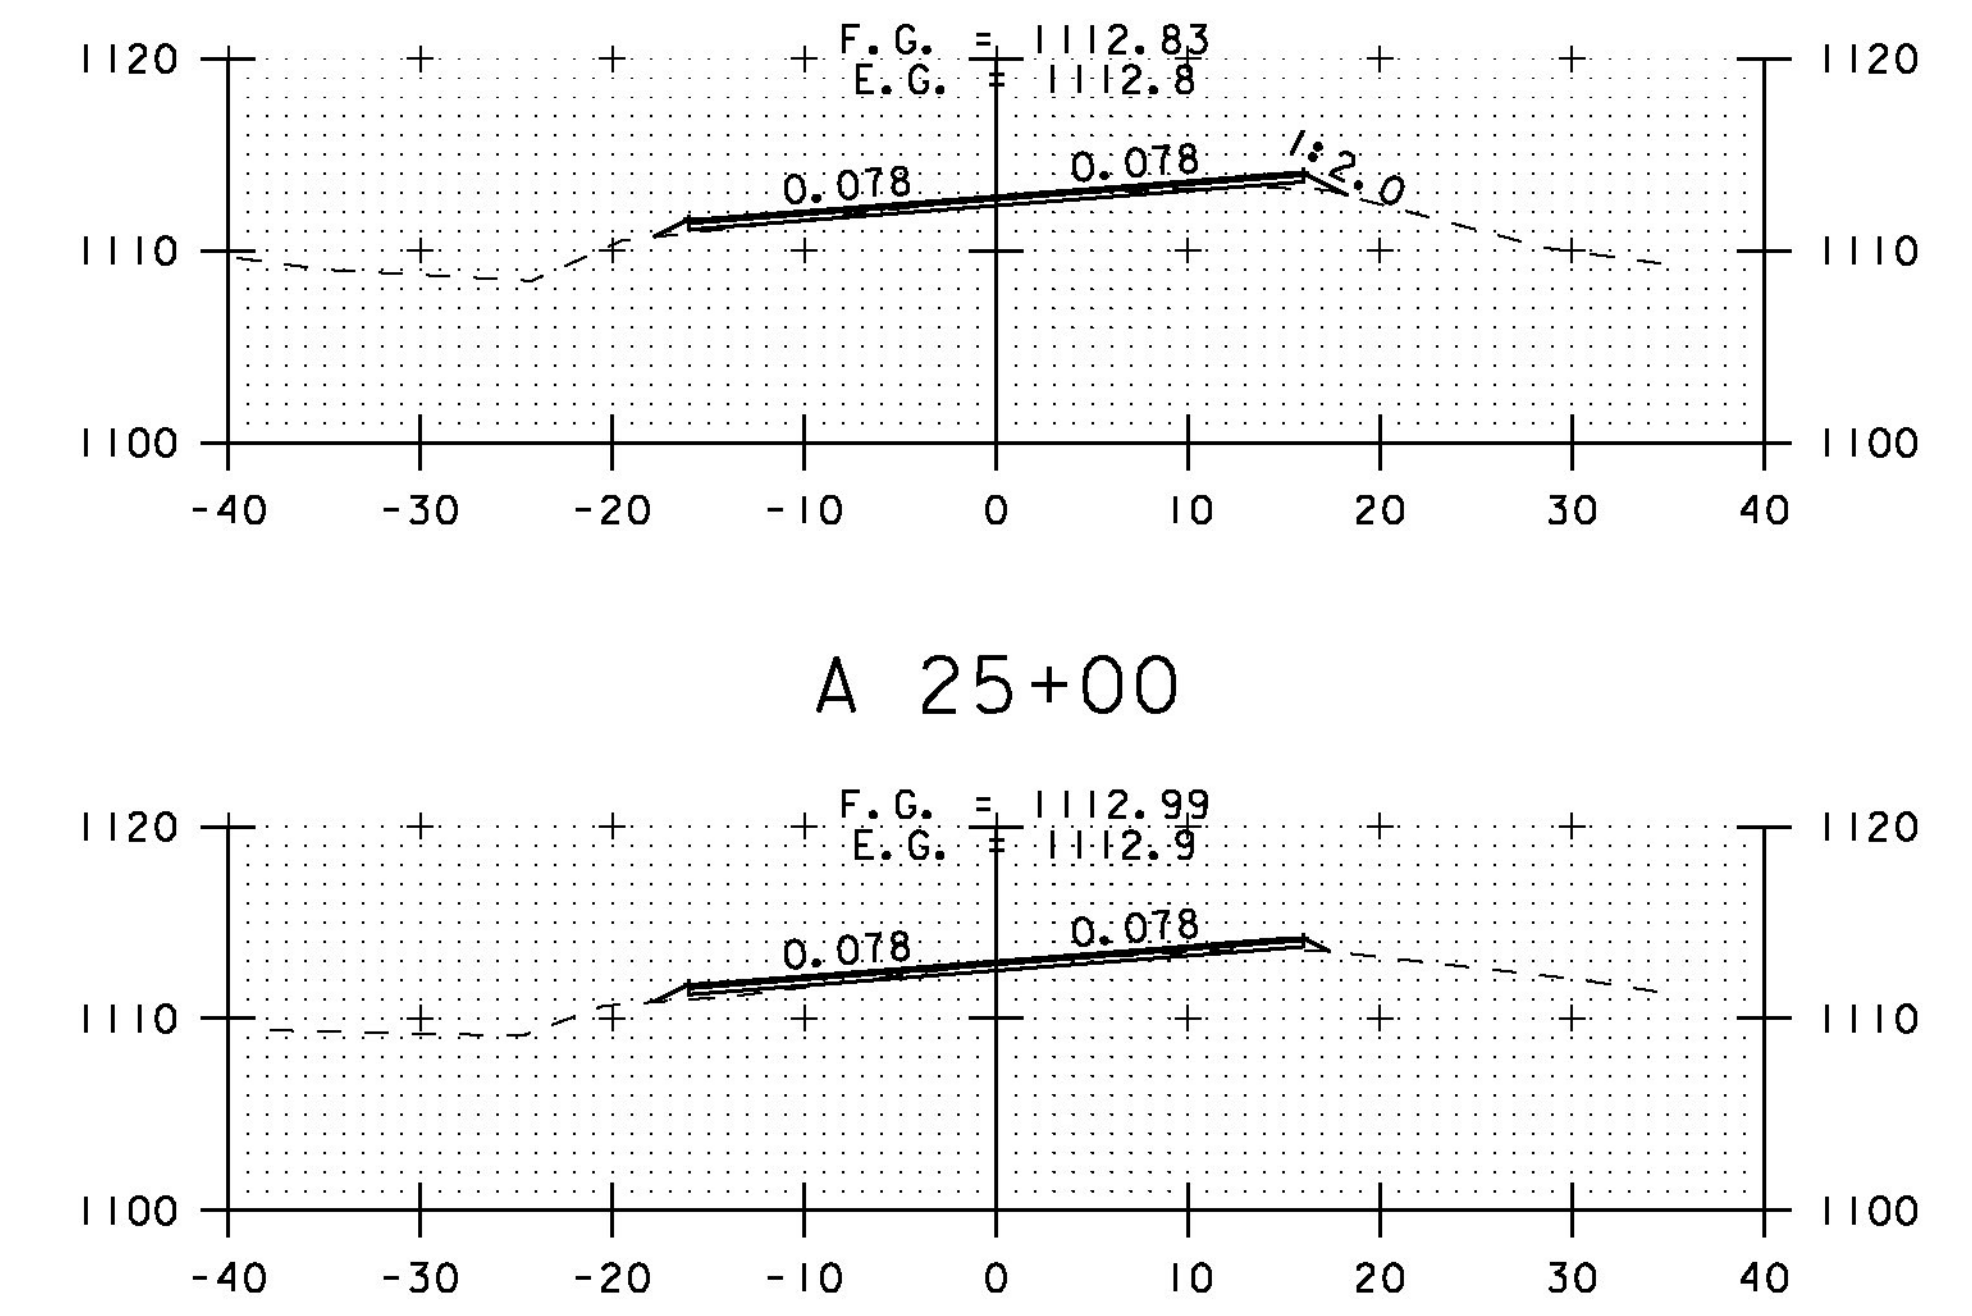


A 25+00

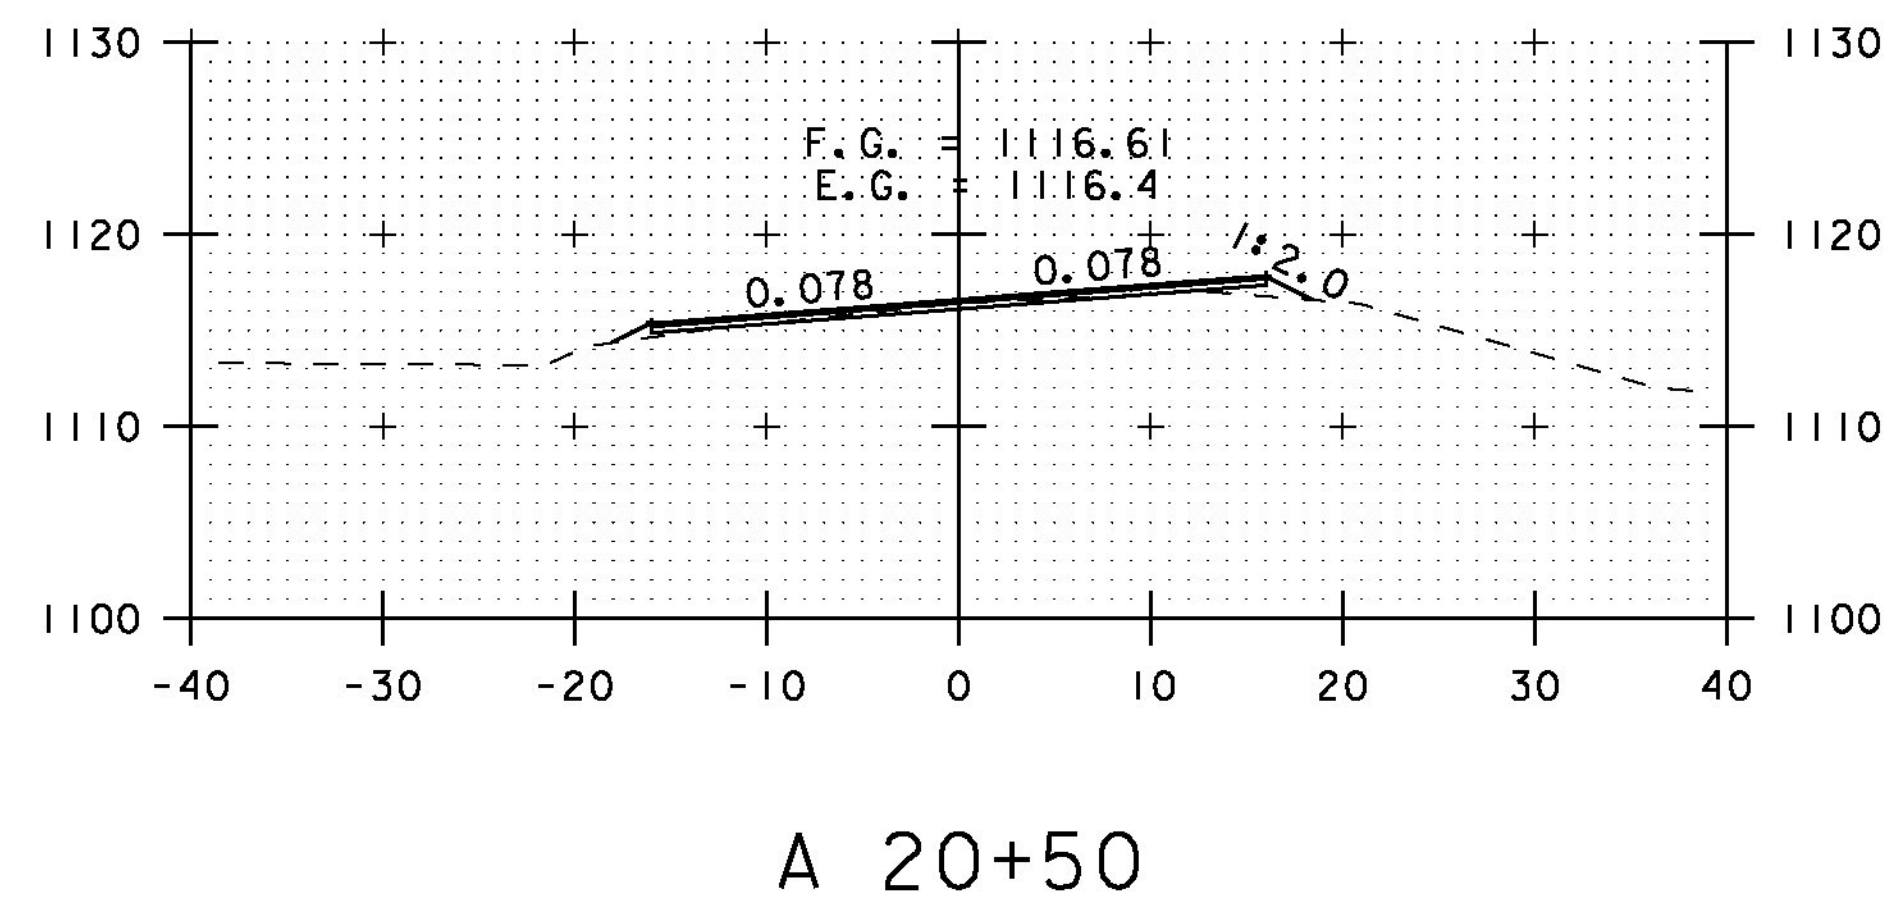

A 20+50

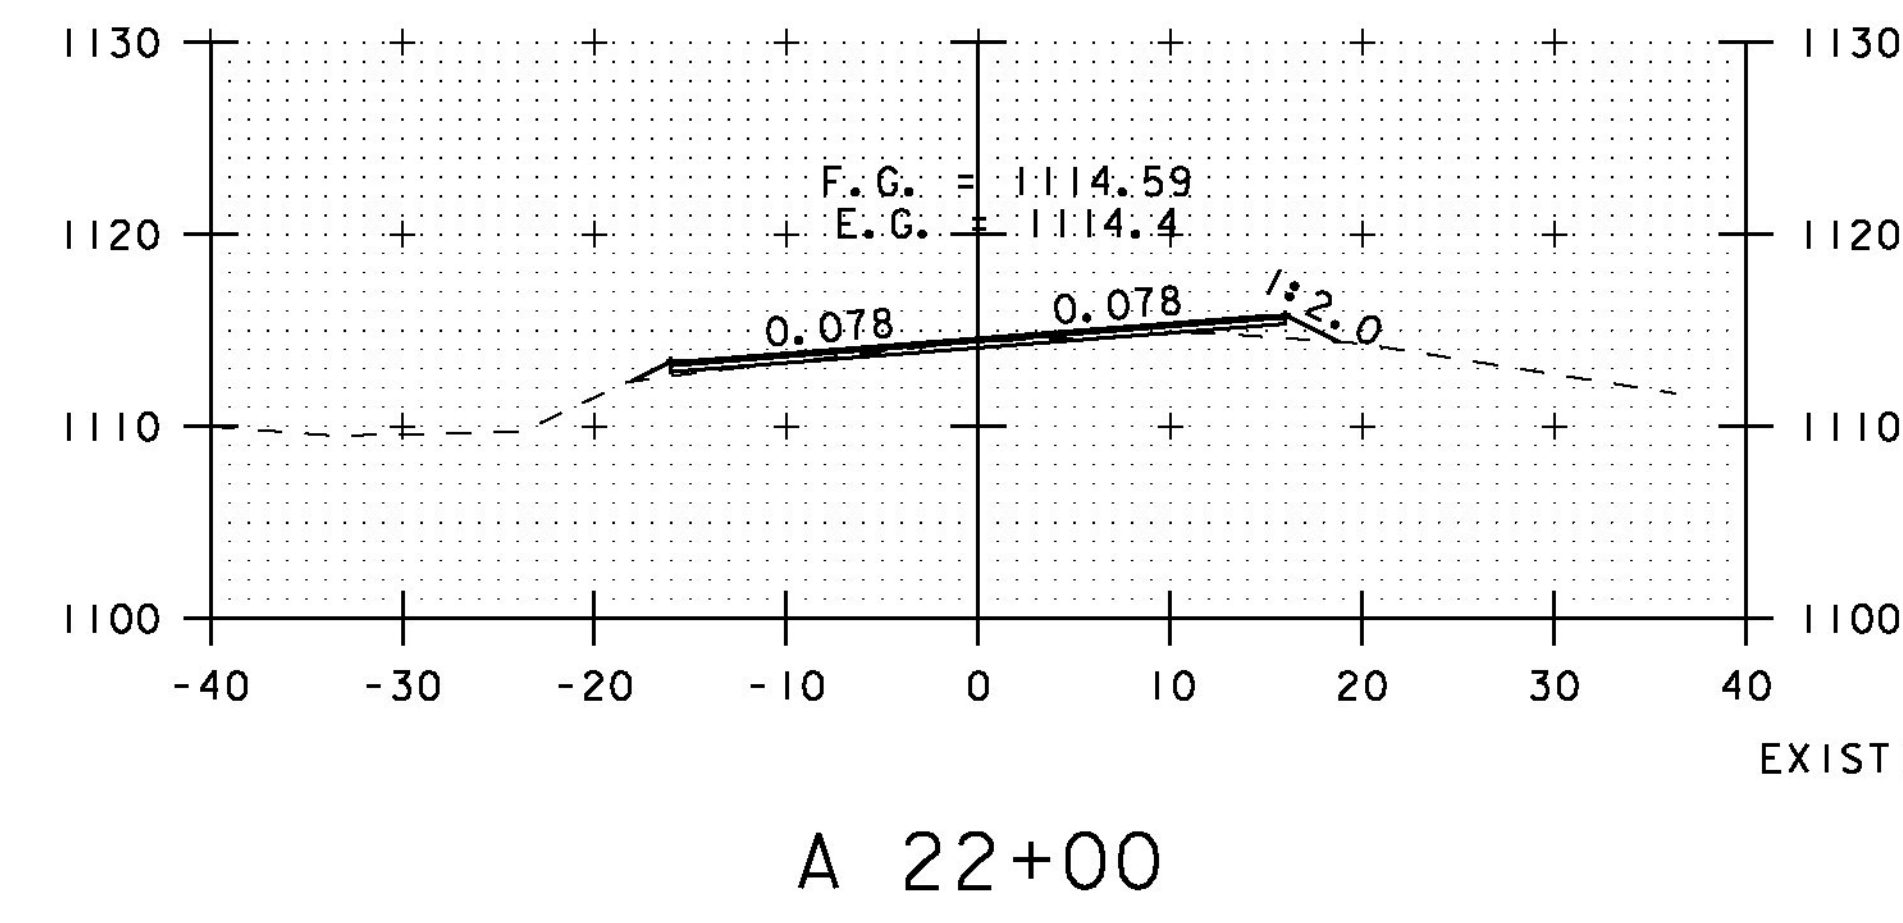

A 22+00

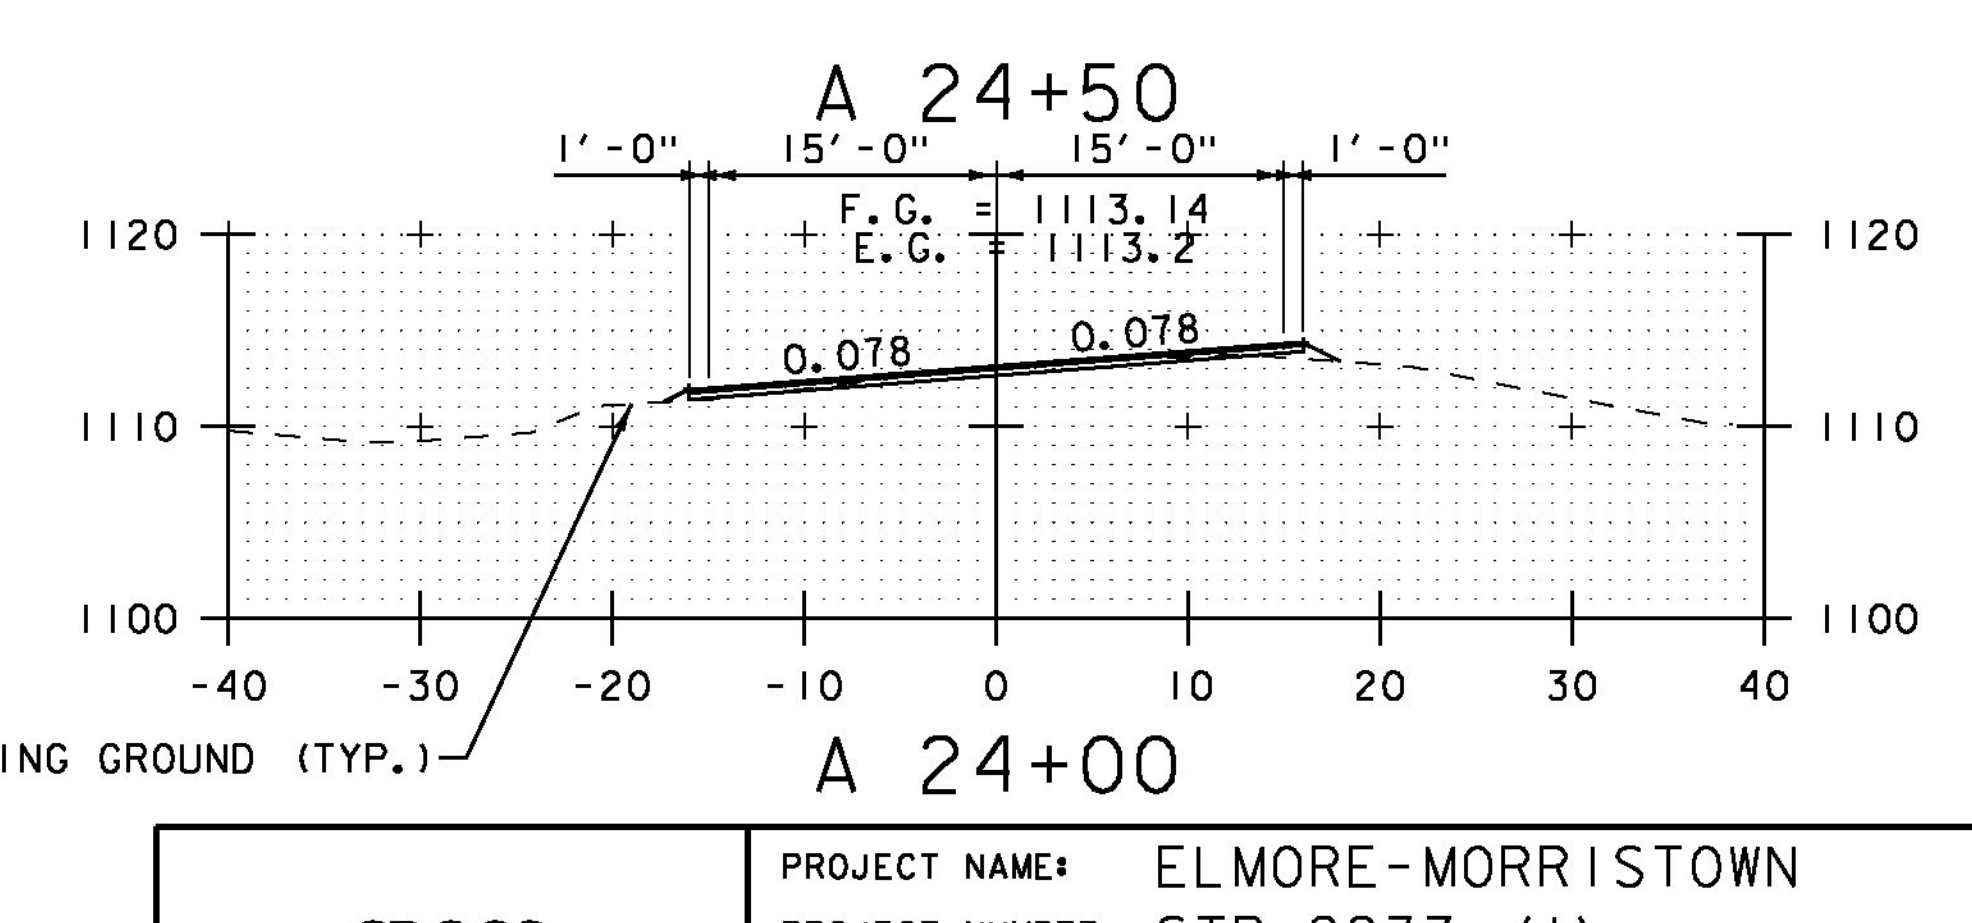

A 24+50

A 24+00

EXISTING GROUND (TYP.)

STA. A 20+50 TO STA. A 25+50



**CROSS SECTION SHEET 46**

PROJECT NAME: ELMORE-MORRISTOWN	PROJECT NUMBER: STP 2937 (1)
FILE NAME: z11c310.dgn	PLOT DATE: 3/3/14
PROJECT LEADER: C. LATHROP	DRAWN BY: B. MARTIN
DESIGNED BY: S. LAMPHERE	CHECKED BY: C. LATHROP
PLOT FILE: z11c310_174.i	SHEET 174 OF 194