




A 39+00

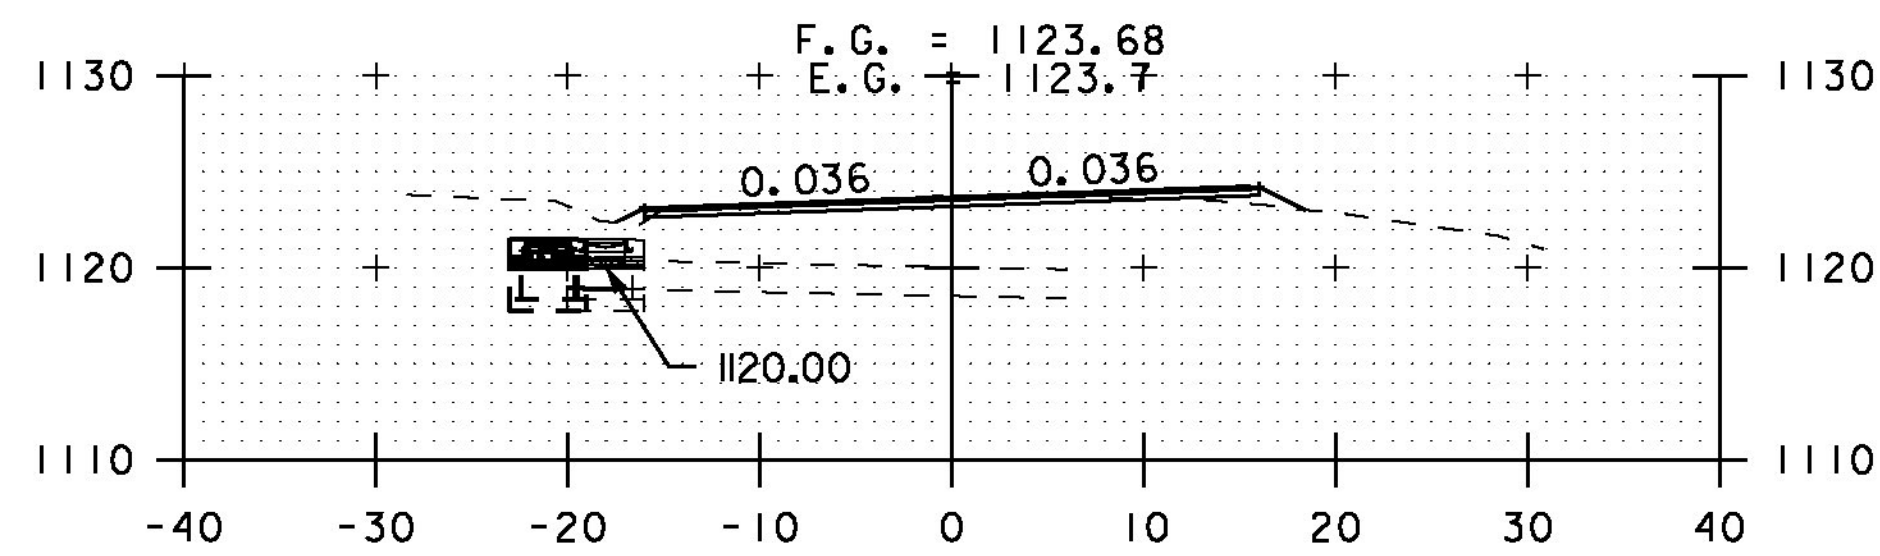


A 38+50

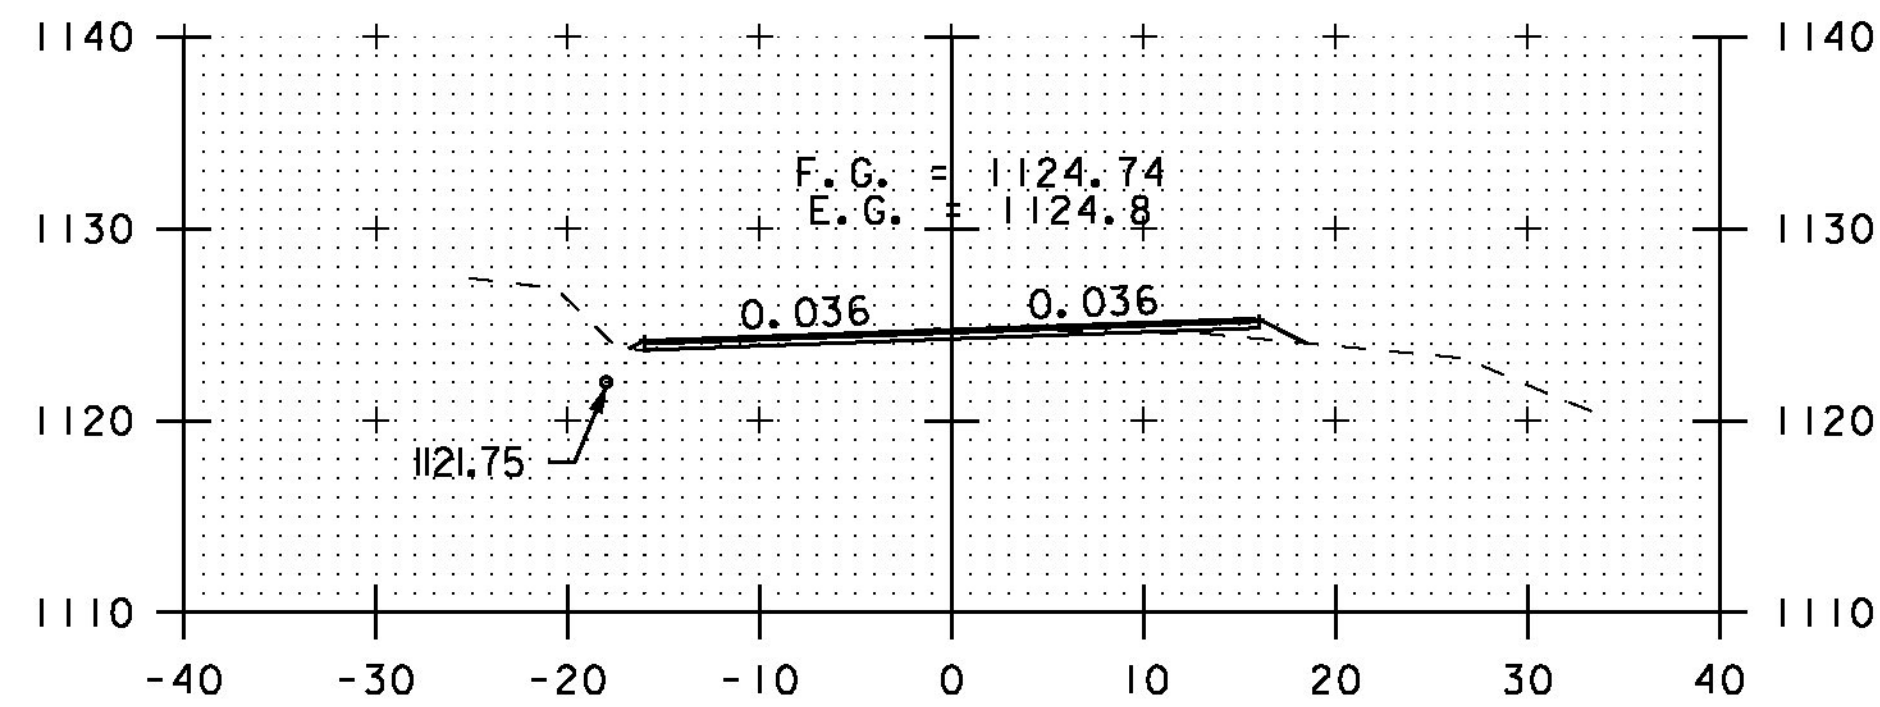


A 38+00

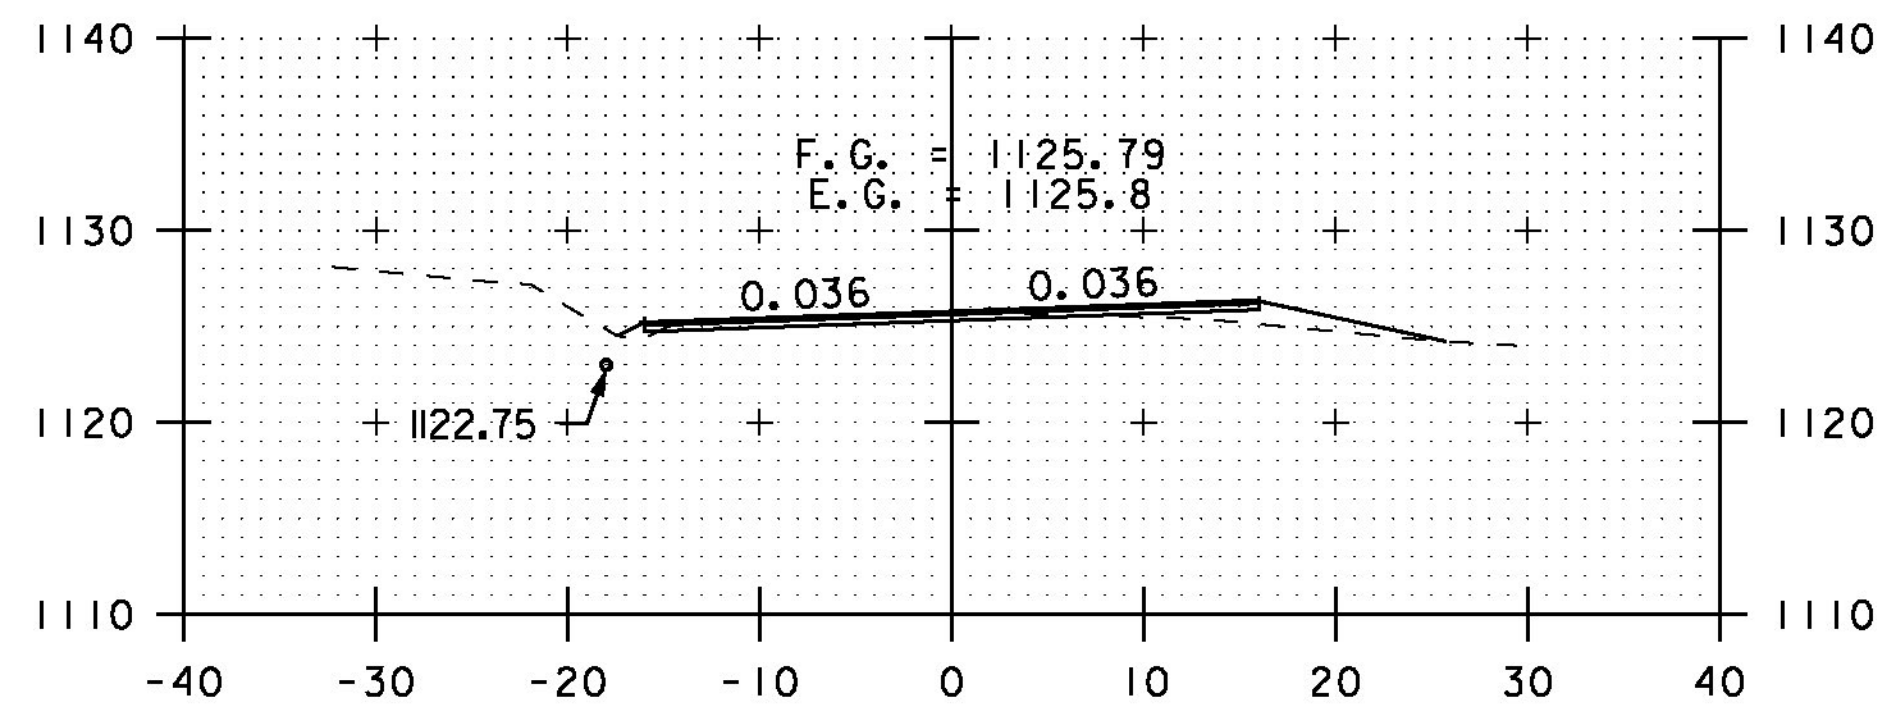


DRIVE RT
A 37+50

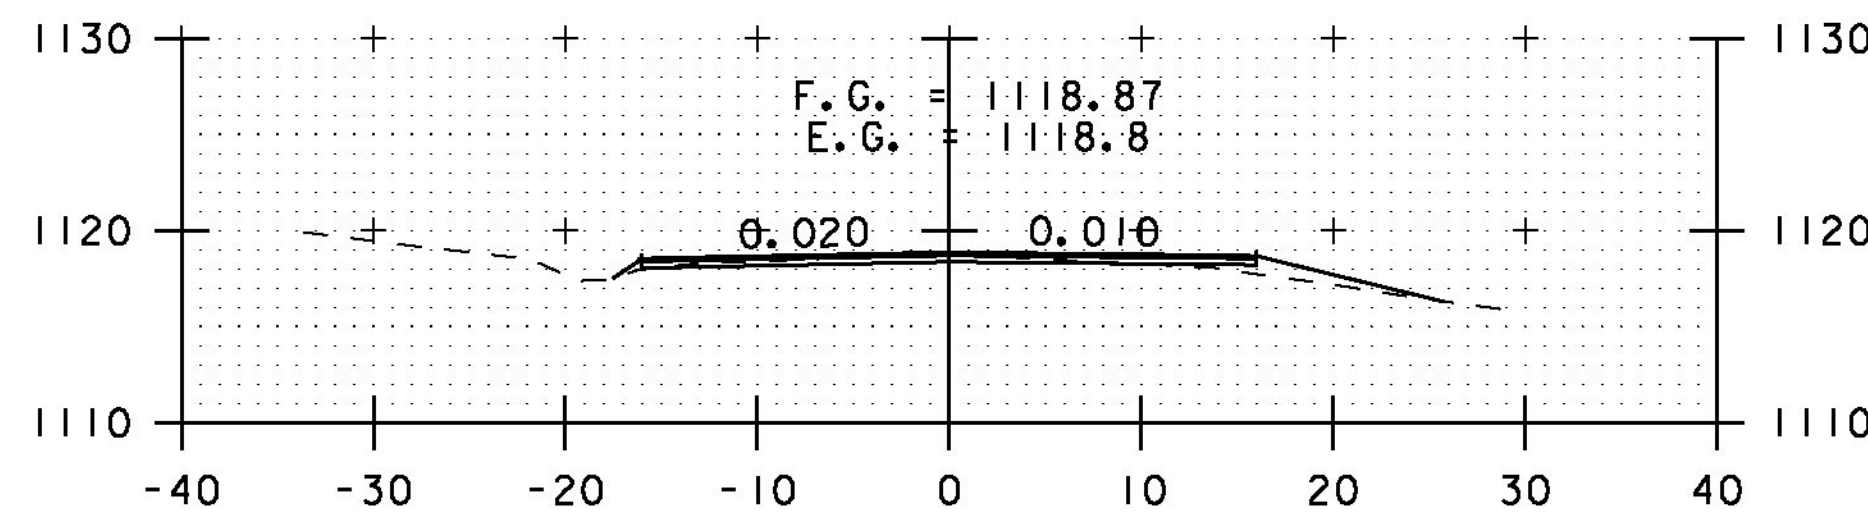


DRIVE RT
A 41+00

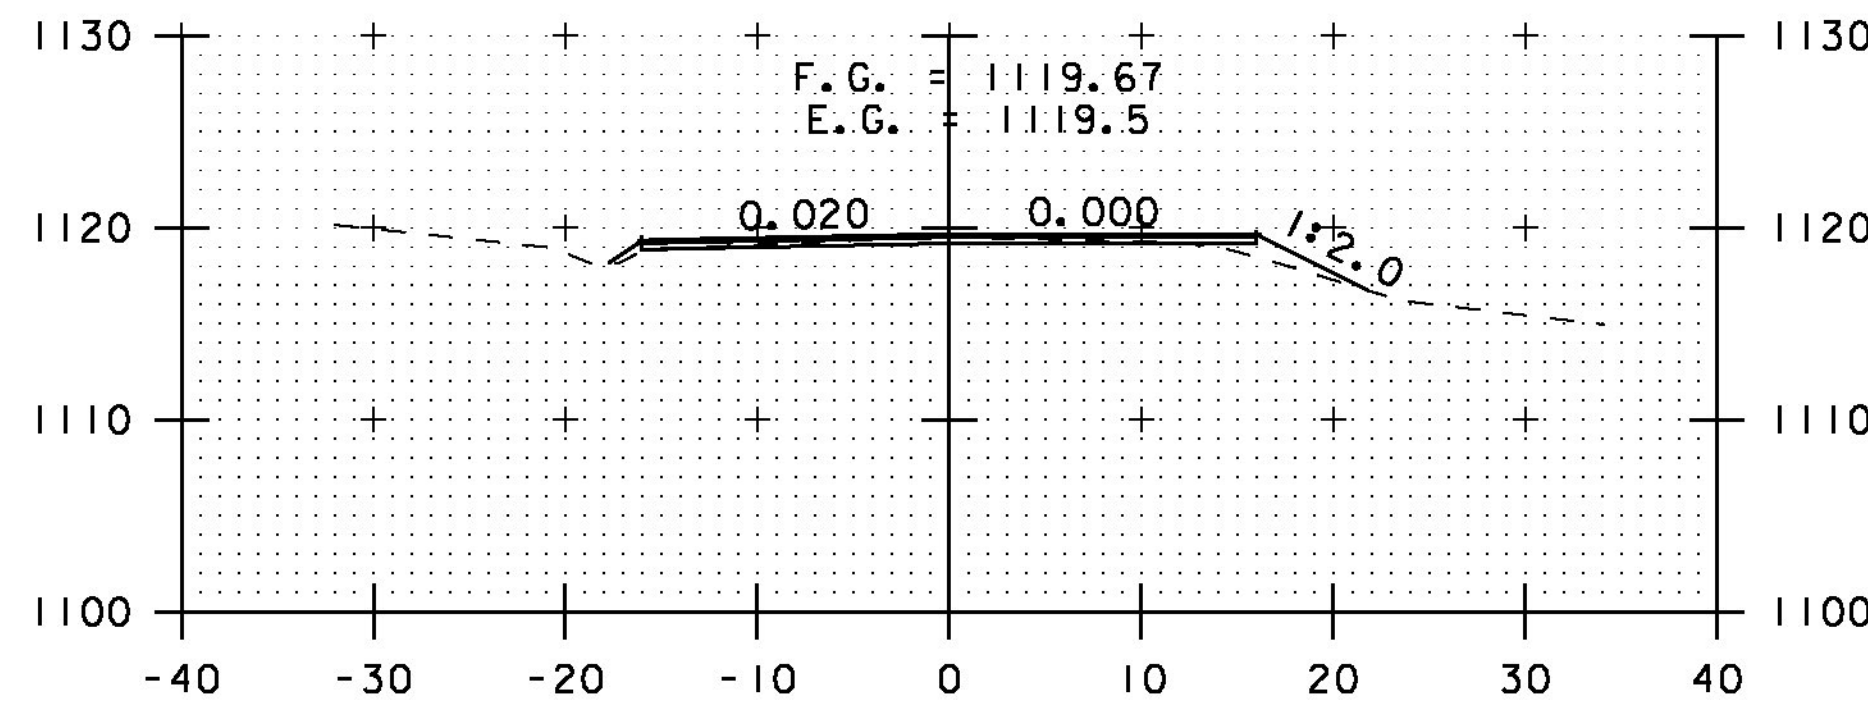


A 40+50

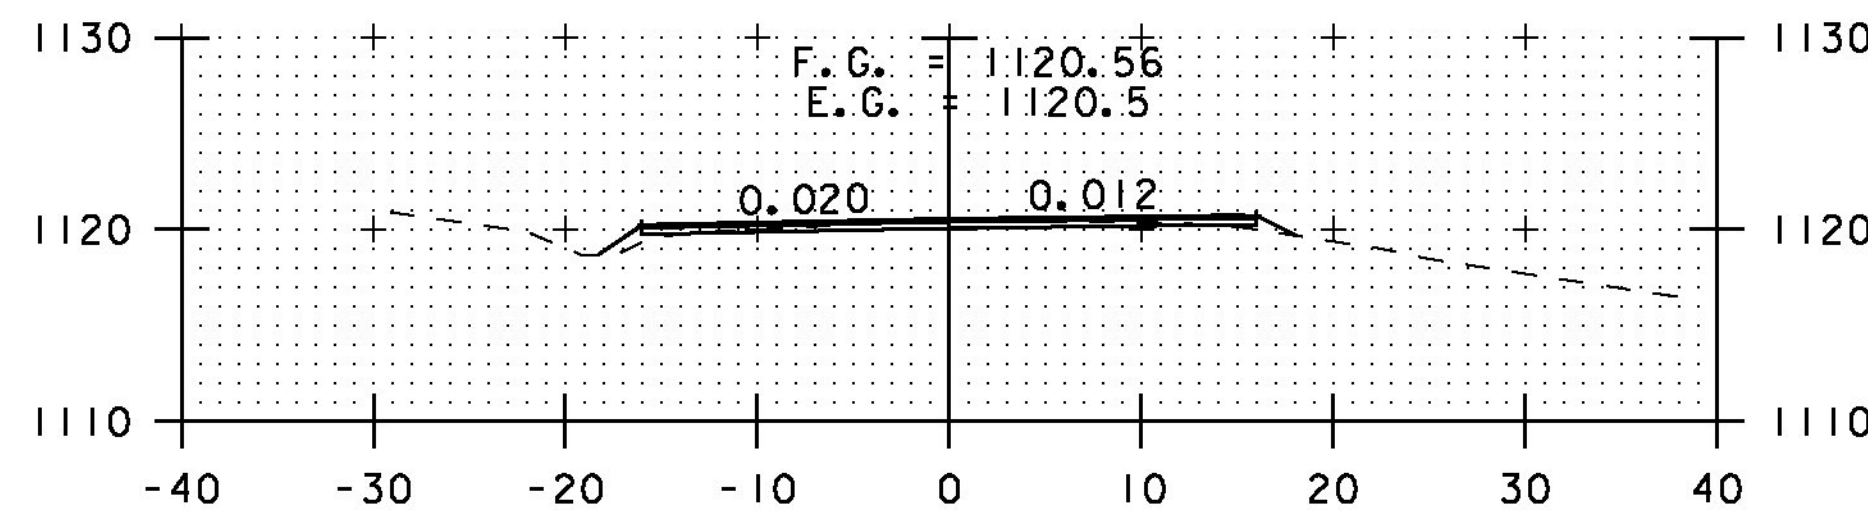


A 40+00

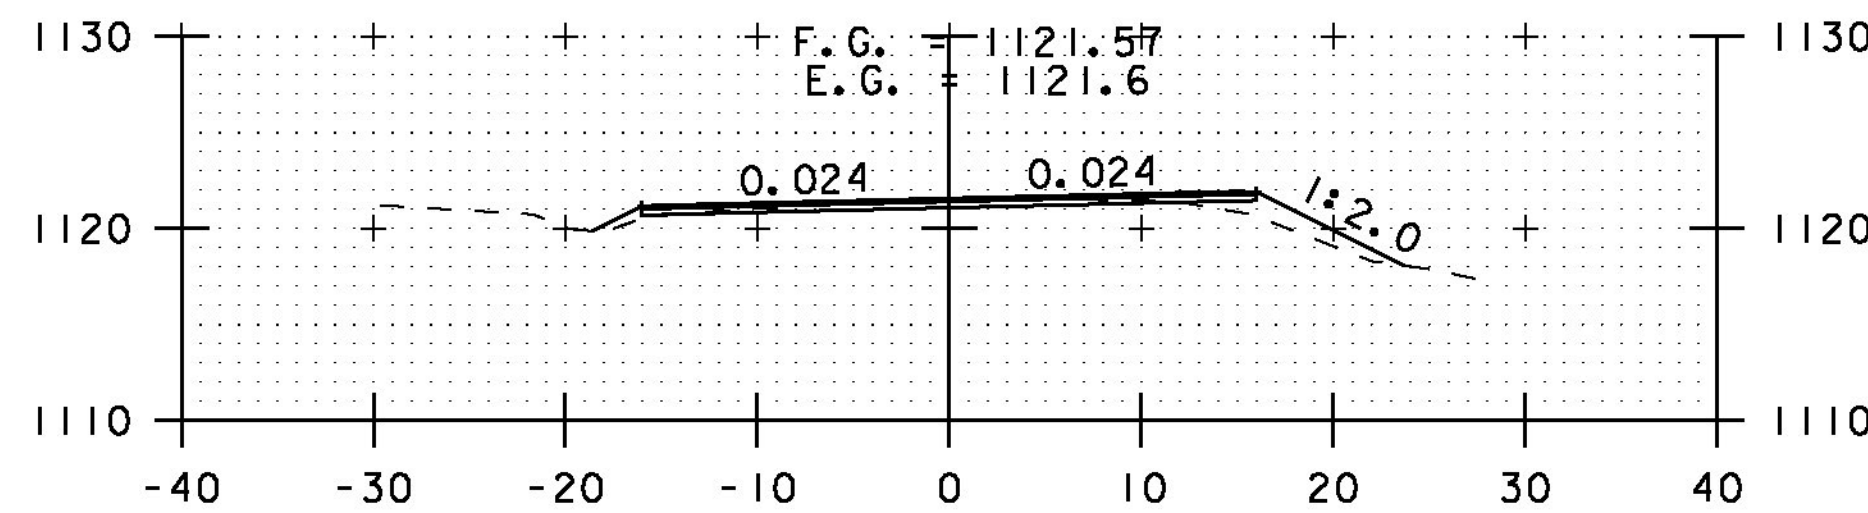


A 39+50

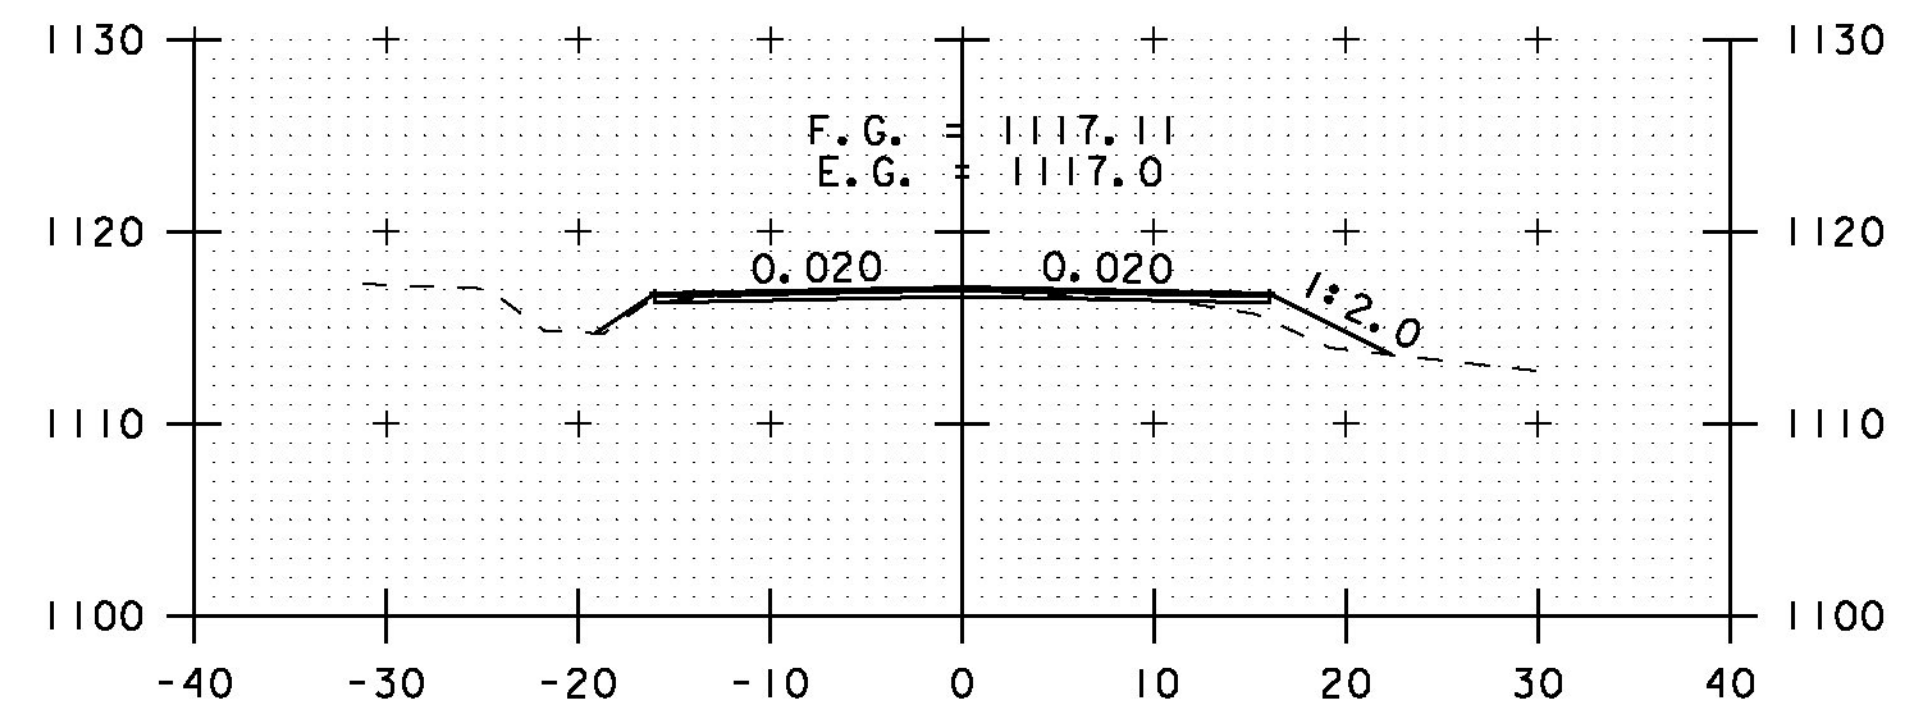

A 42+50

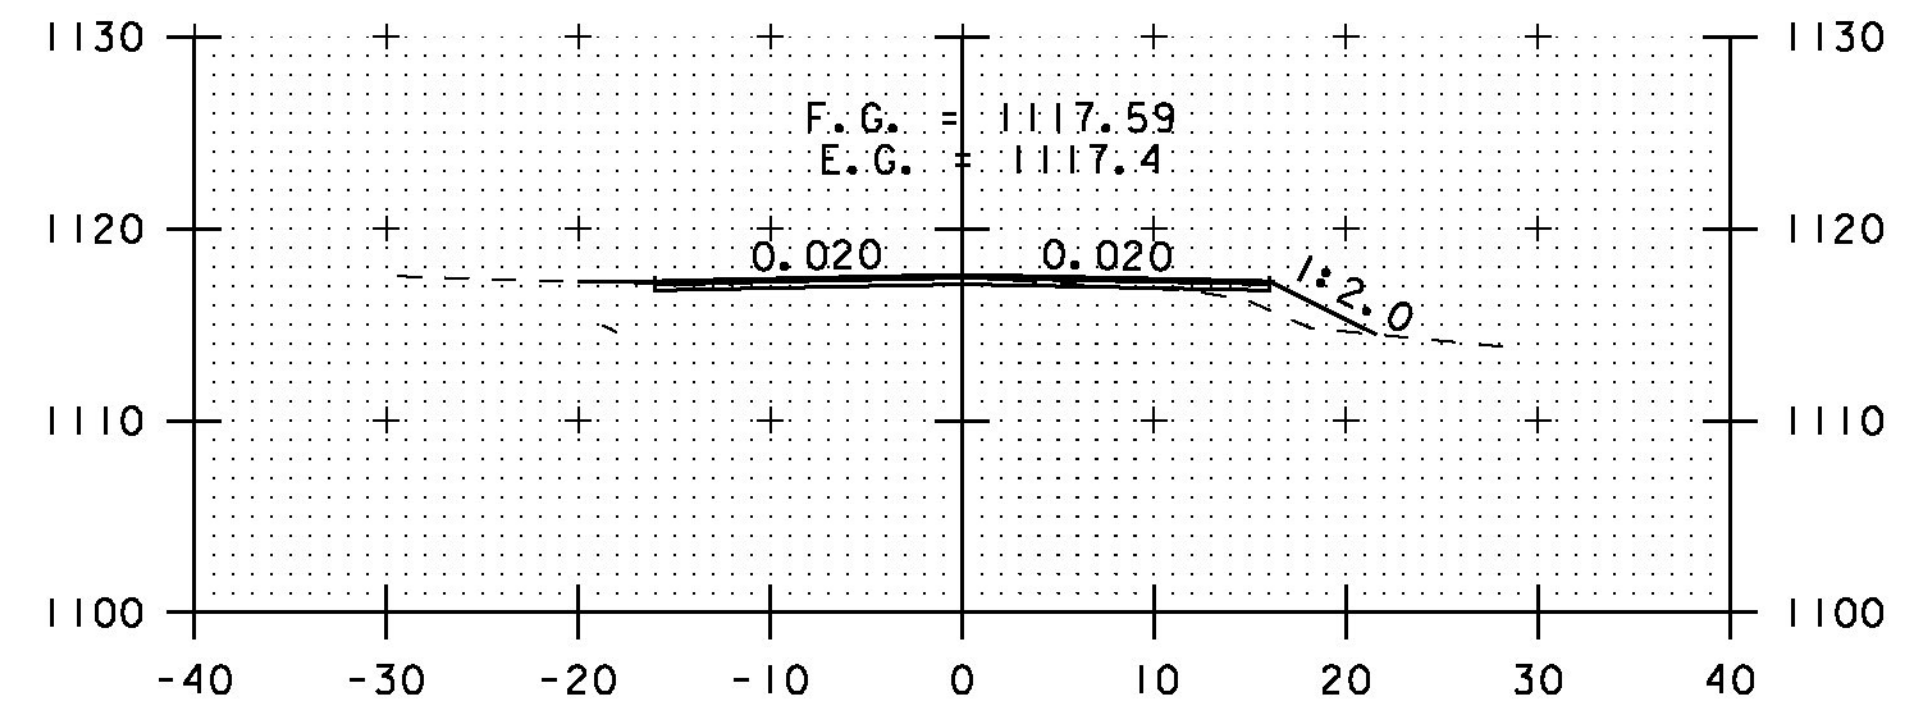

DRIVE LT
A 42+00

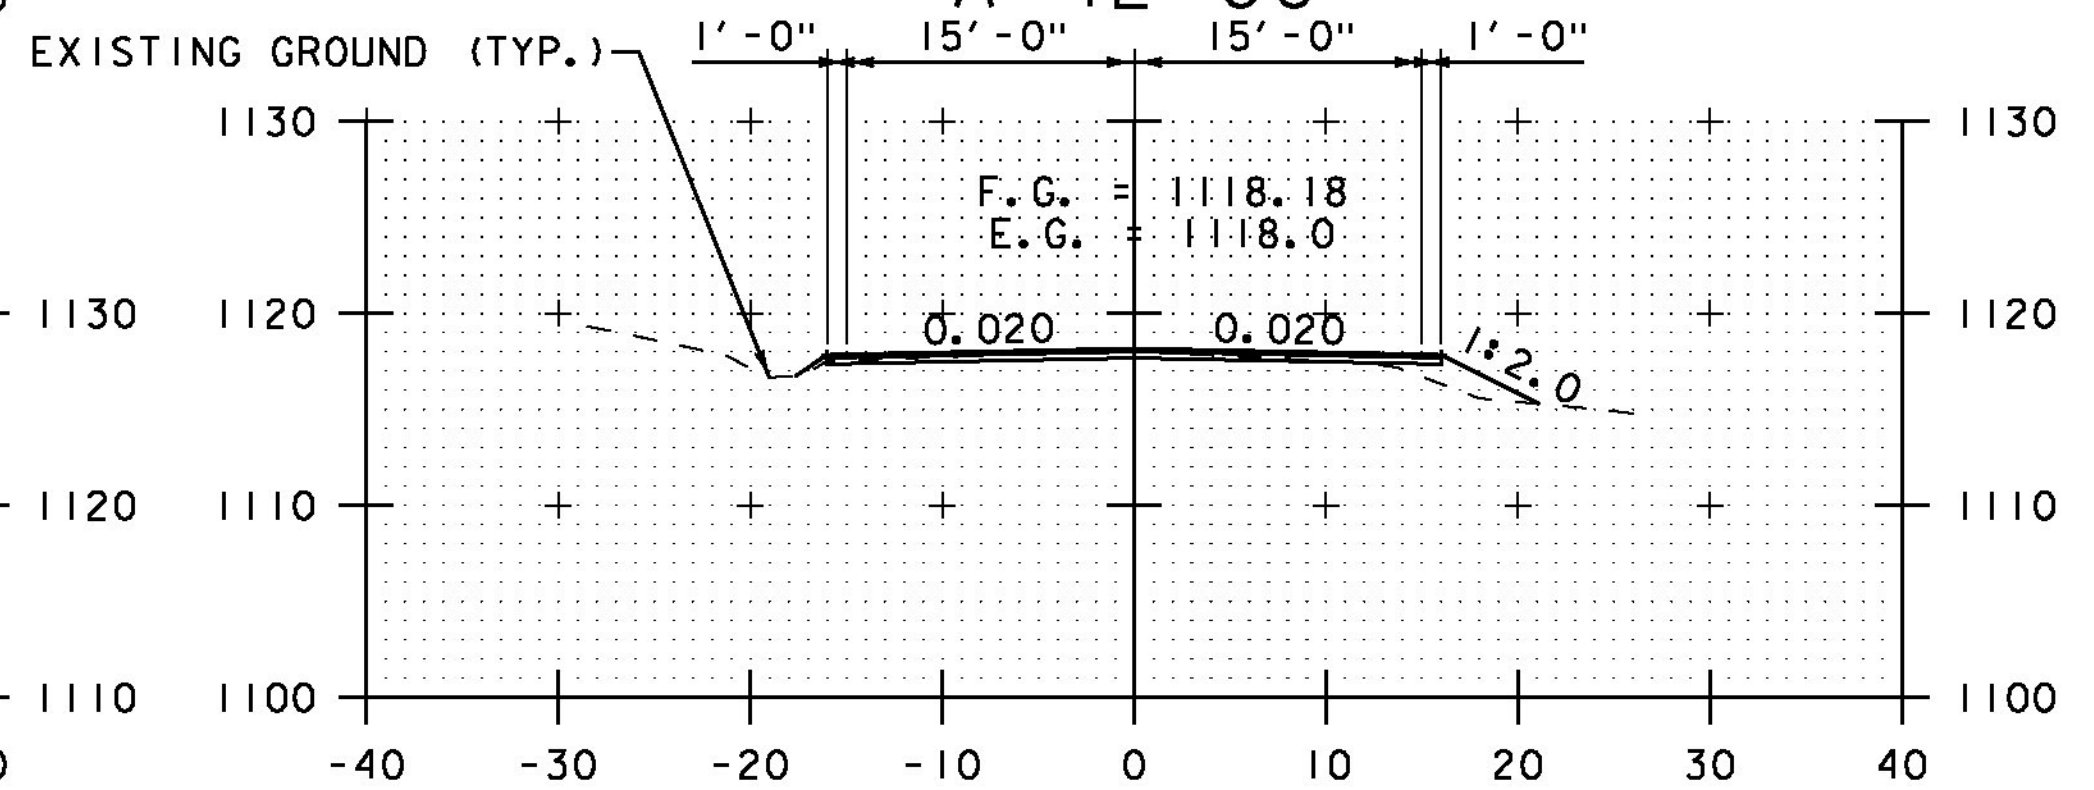

A 41+50

STA. A 37+50 TO STA. A 42+50

SCALE 1" = 10'-0"
10 0 10

CROSS SECTION SHEET 49

PROJECT NAME: ELMORE-MORRISTOWN

PROJECT NUMBER: STP 2937 (1)

FILE NAME: z11c310.dgn

PROJECT LEADER: C. LATHROP

DESIGNED BY: S. LAMPHERE

PLOT FILE: z11c310_177.i

PLOT DATE: 3/3/14

DRAWN BY: B. MARTIN

CHECKED BY: C. LATHROP

SHEET 177 OF 194