




A 55+50

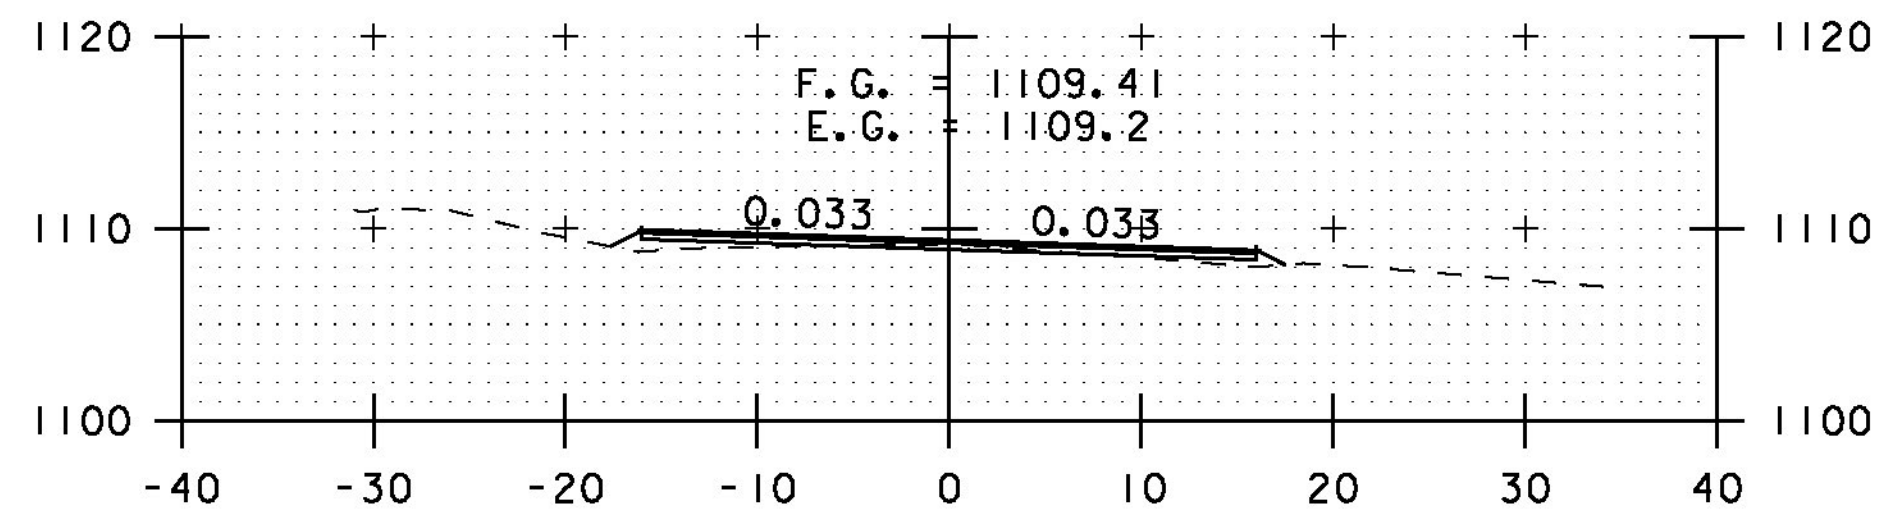


A 57+50

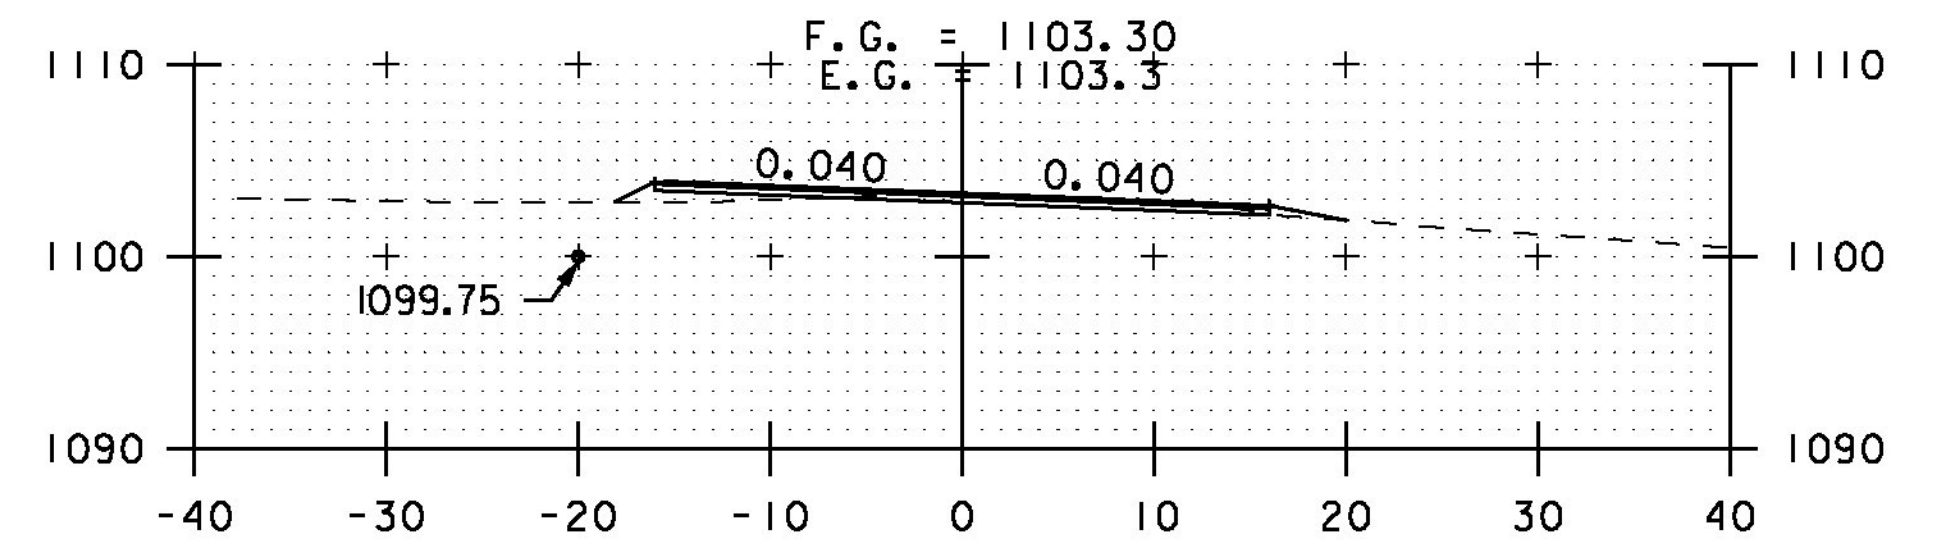


DRIVE RT
A 59+50

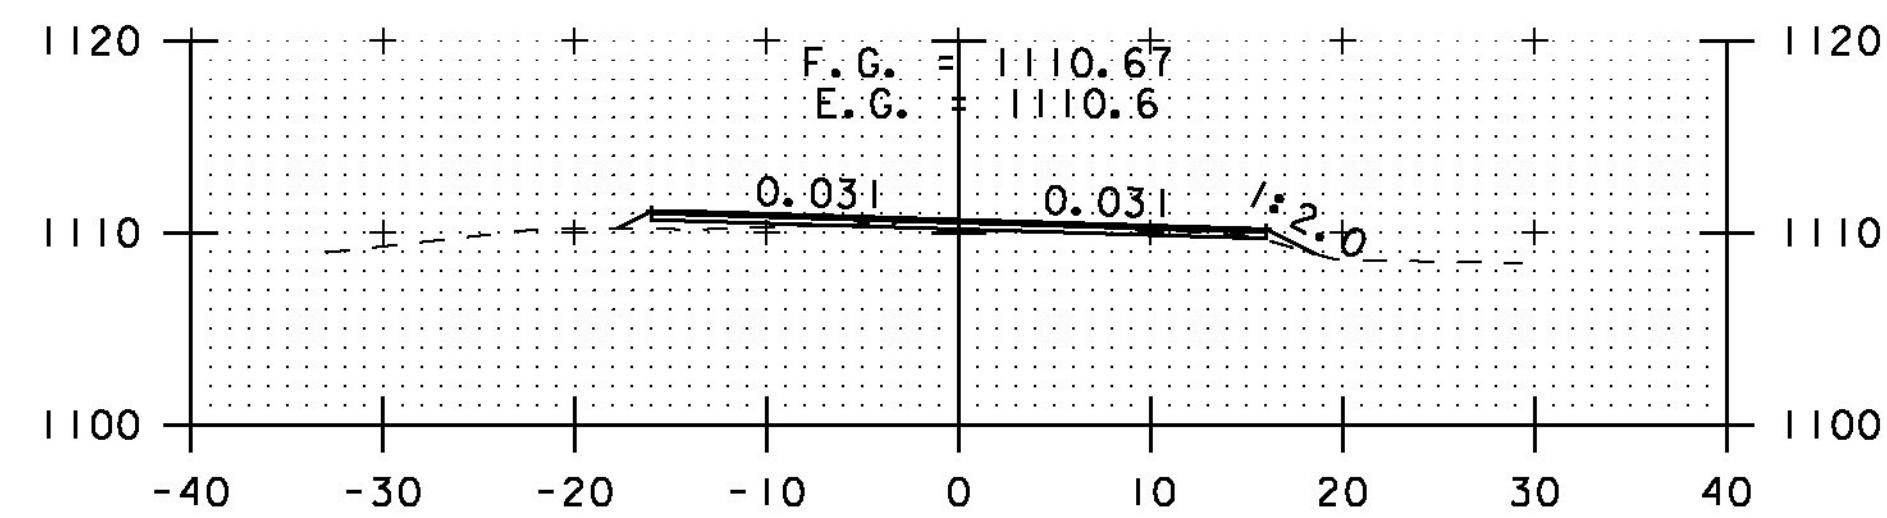


A 55+00

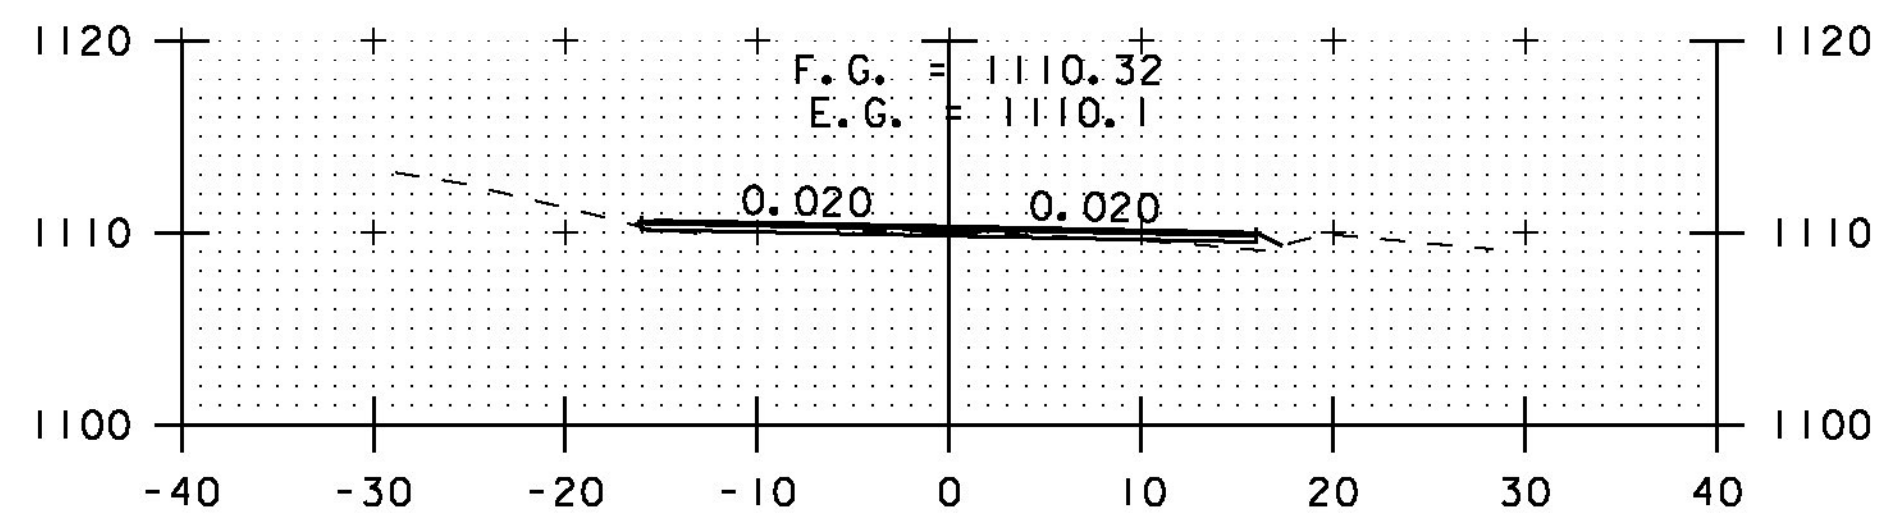


A 57+00

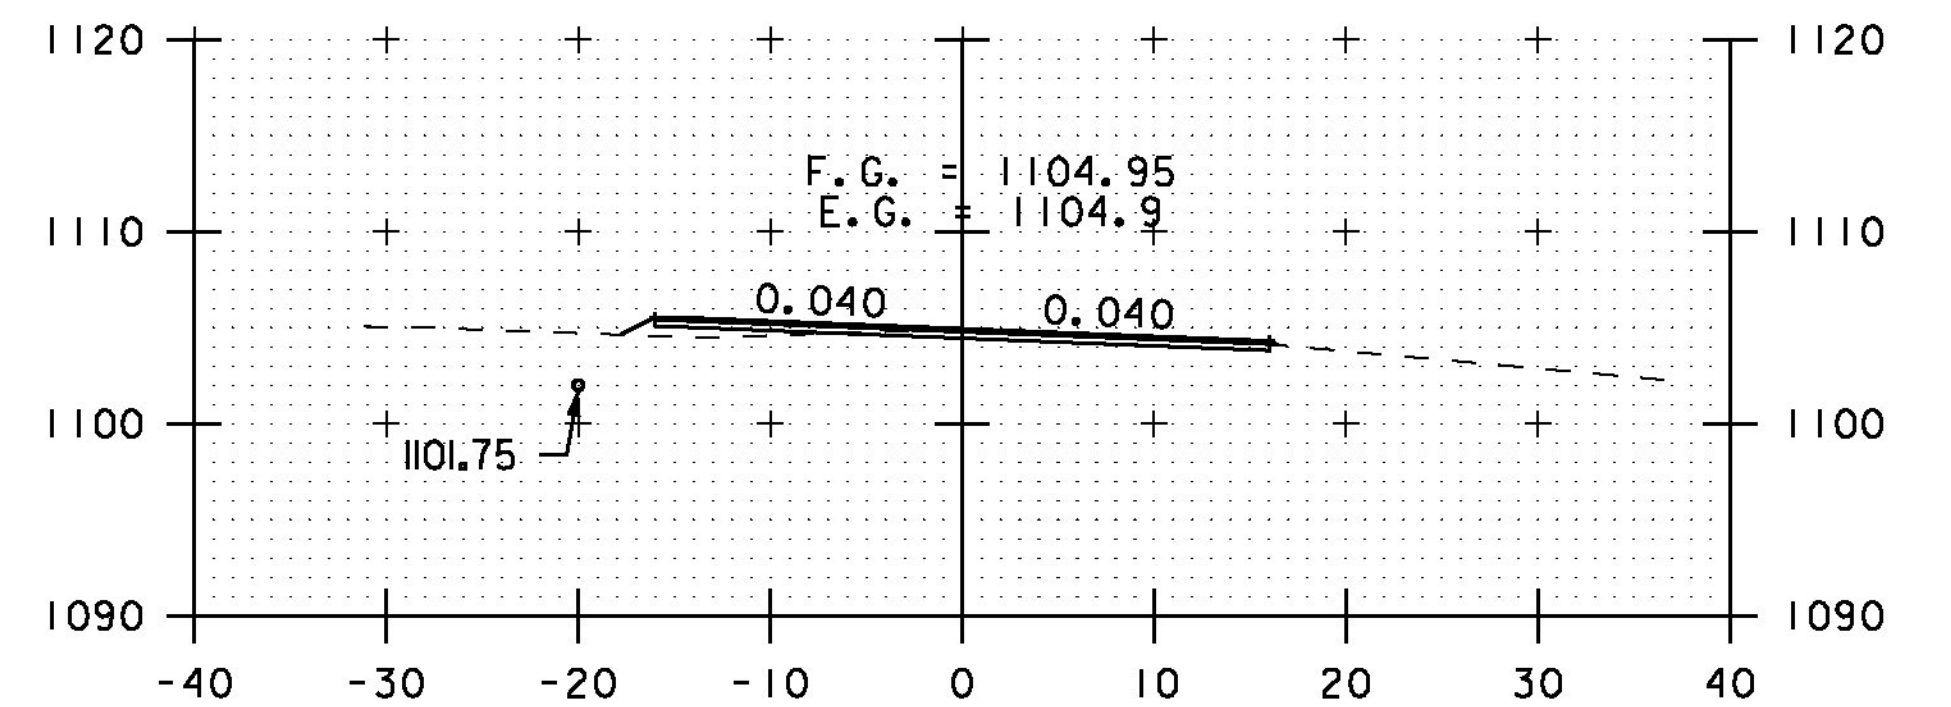


A 59+00

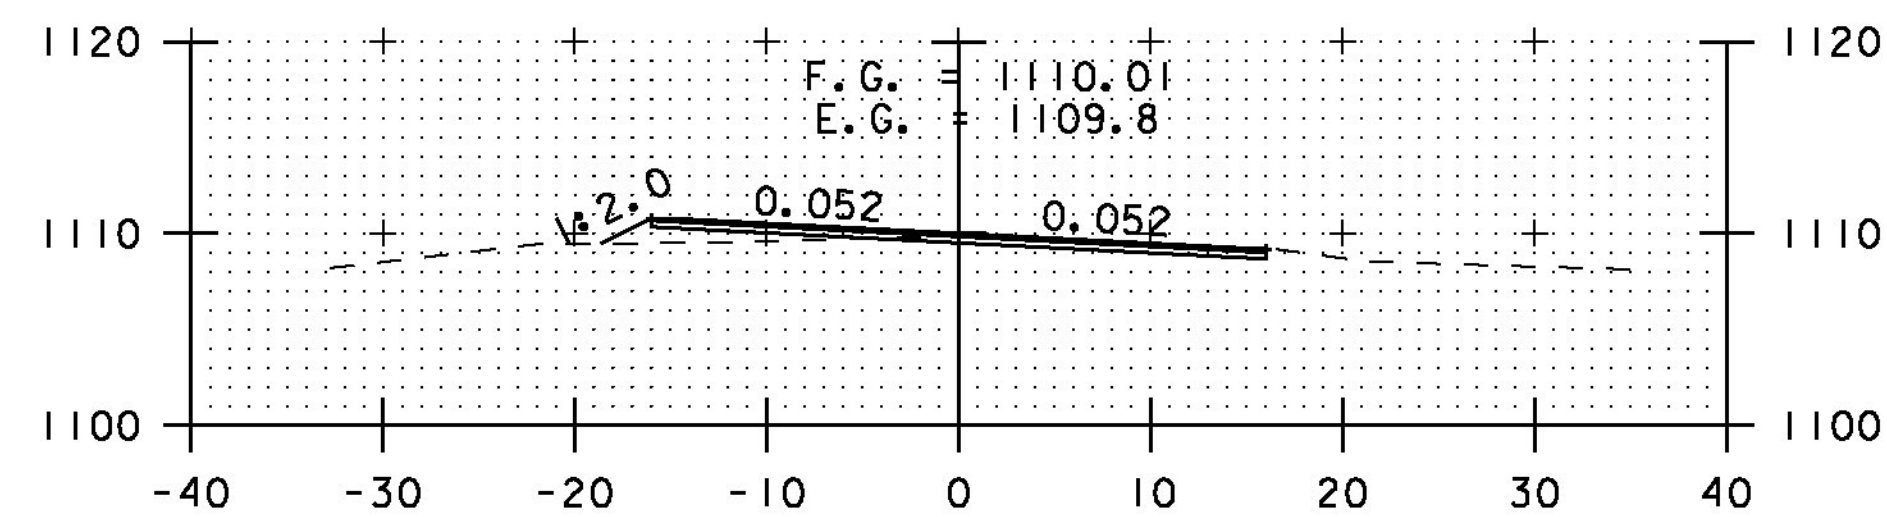


A 54+50

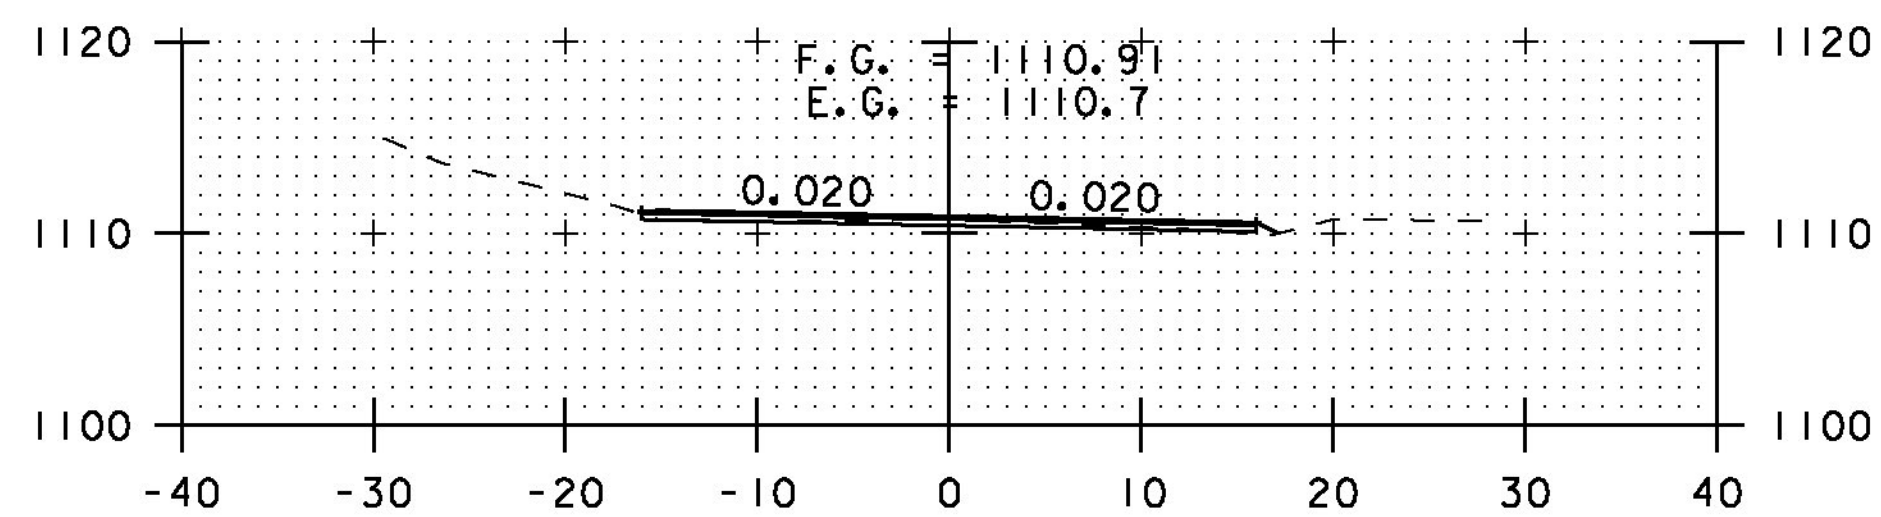


A 56+50

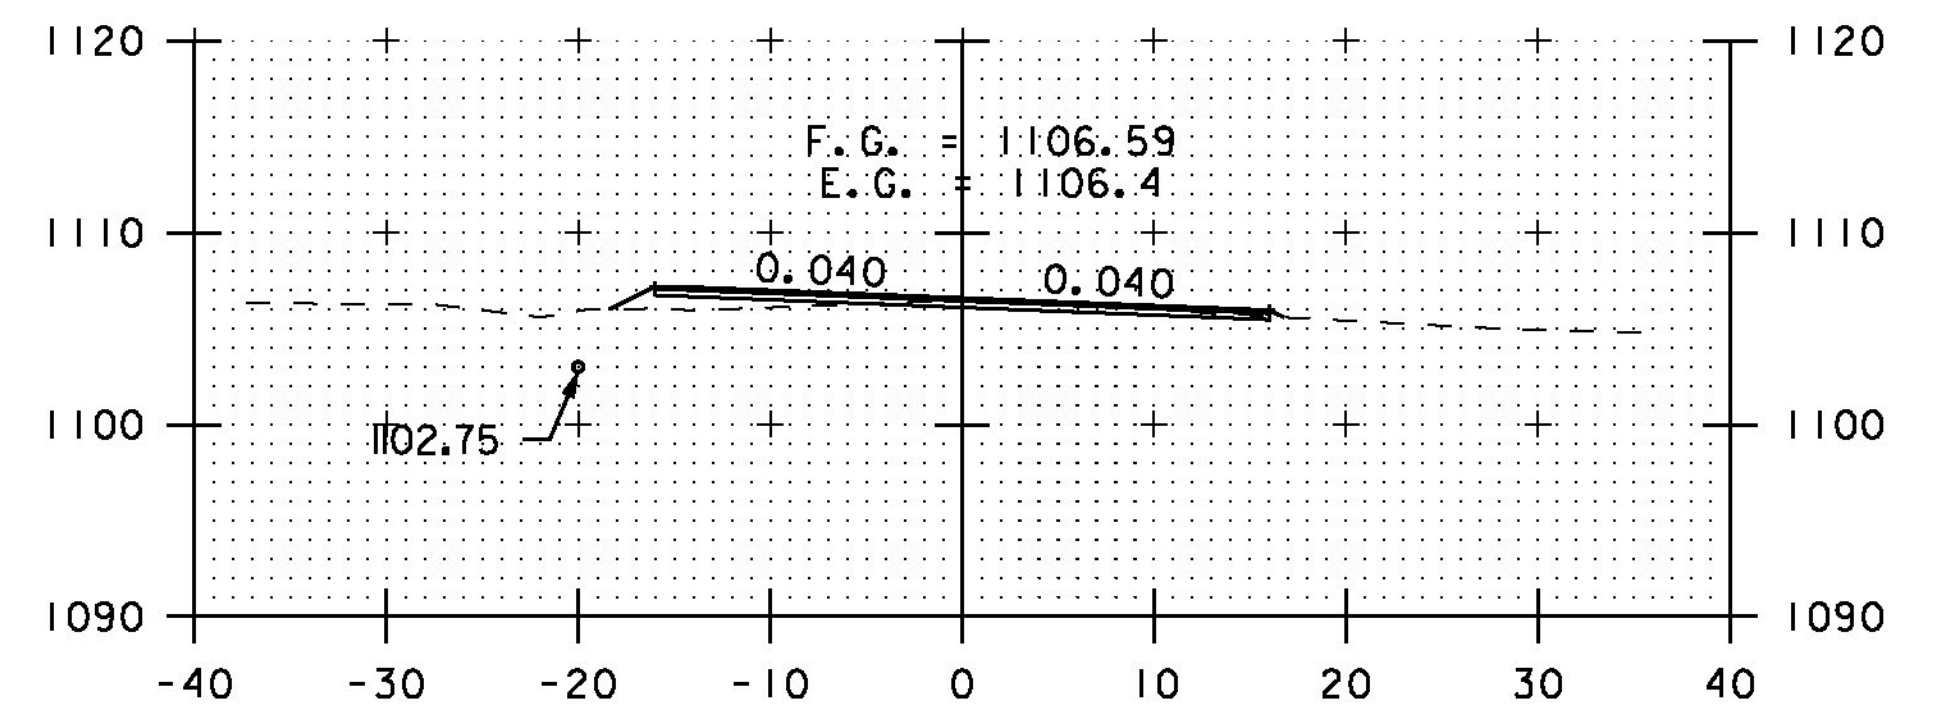


A 58+50

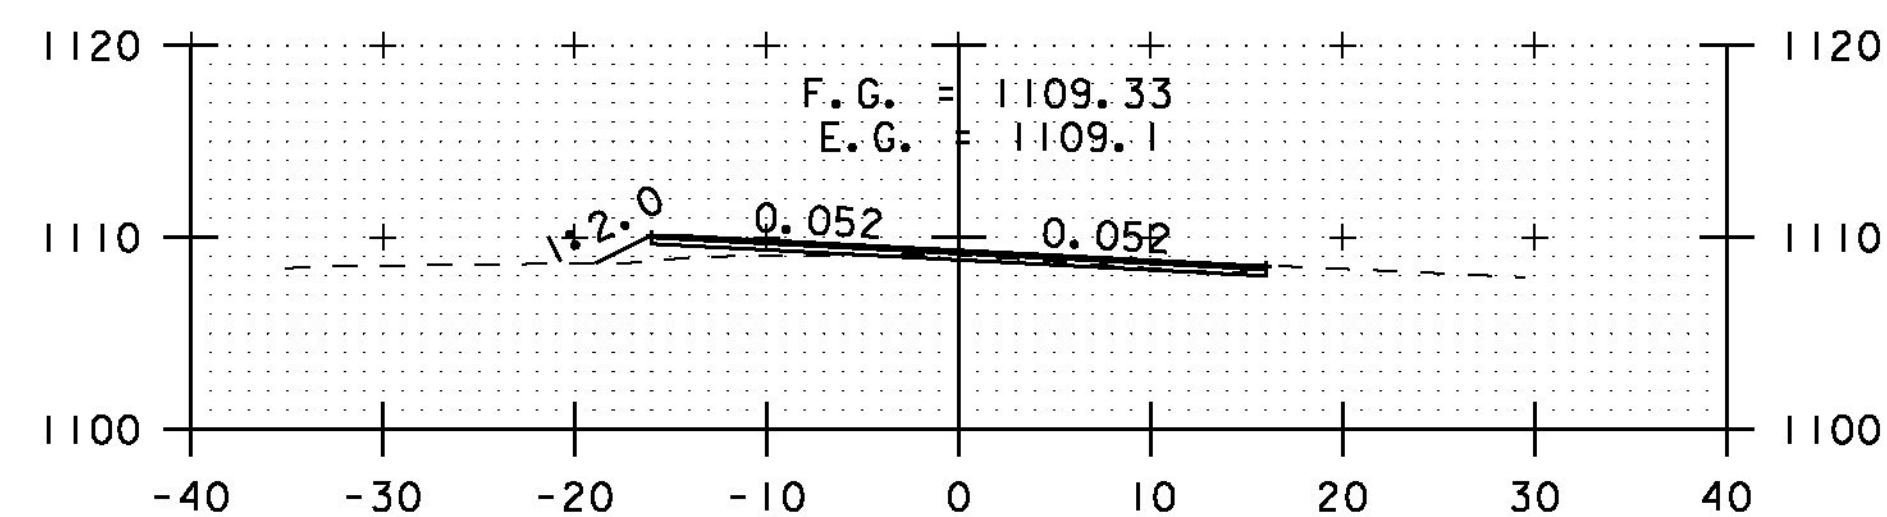

A 54+00

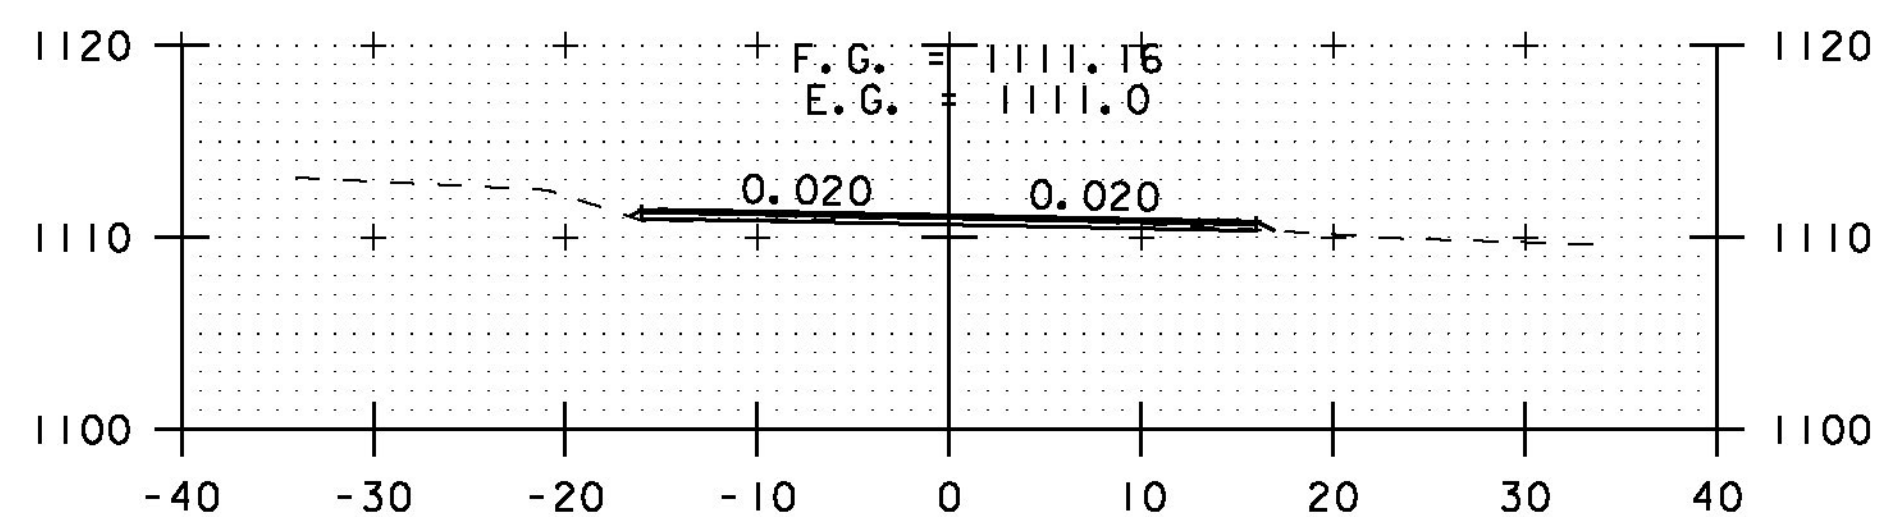

A 56+00

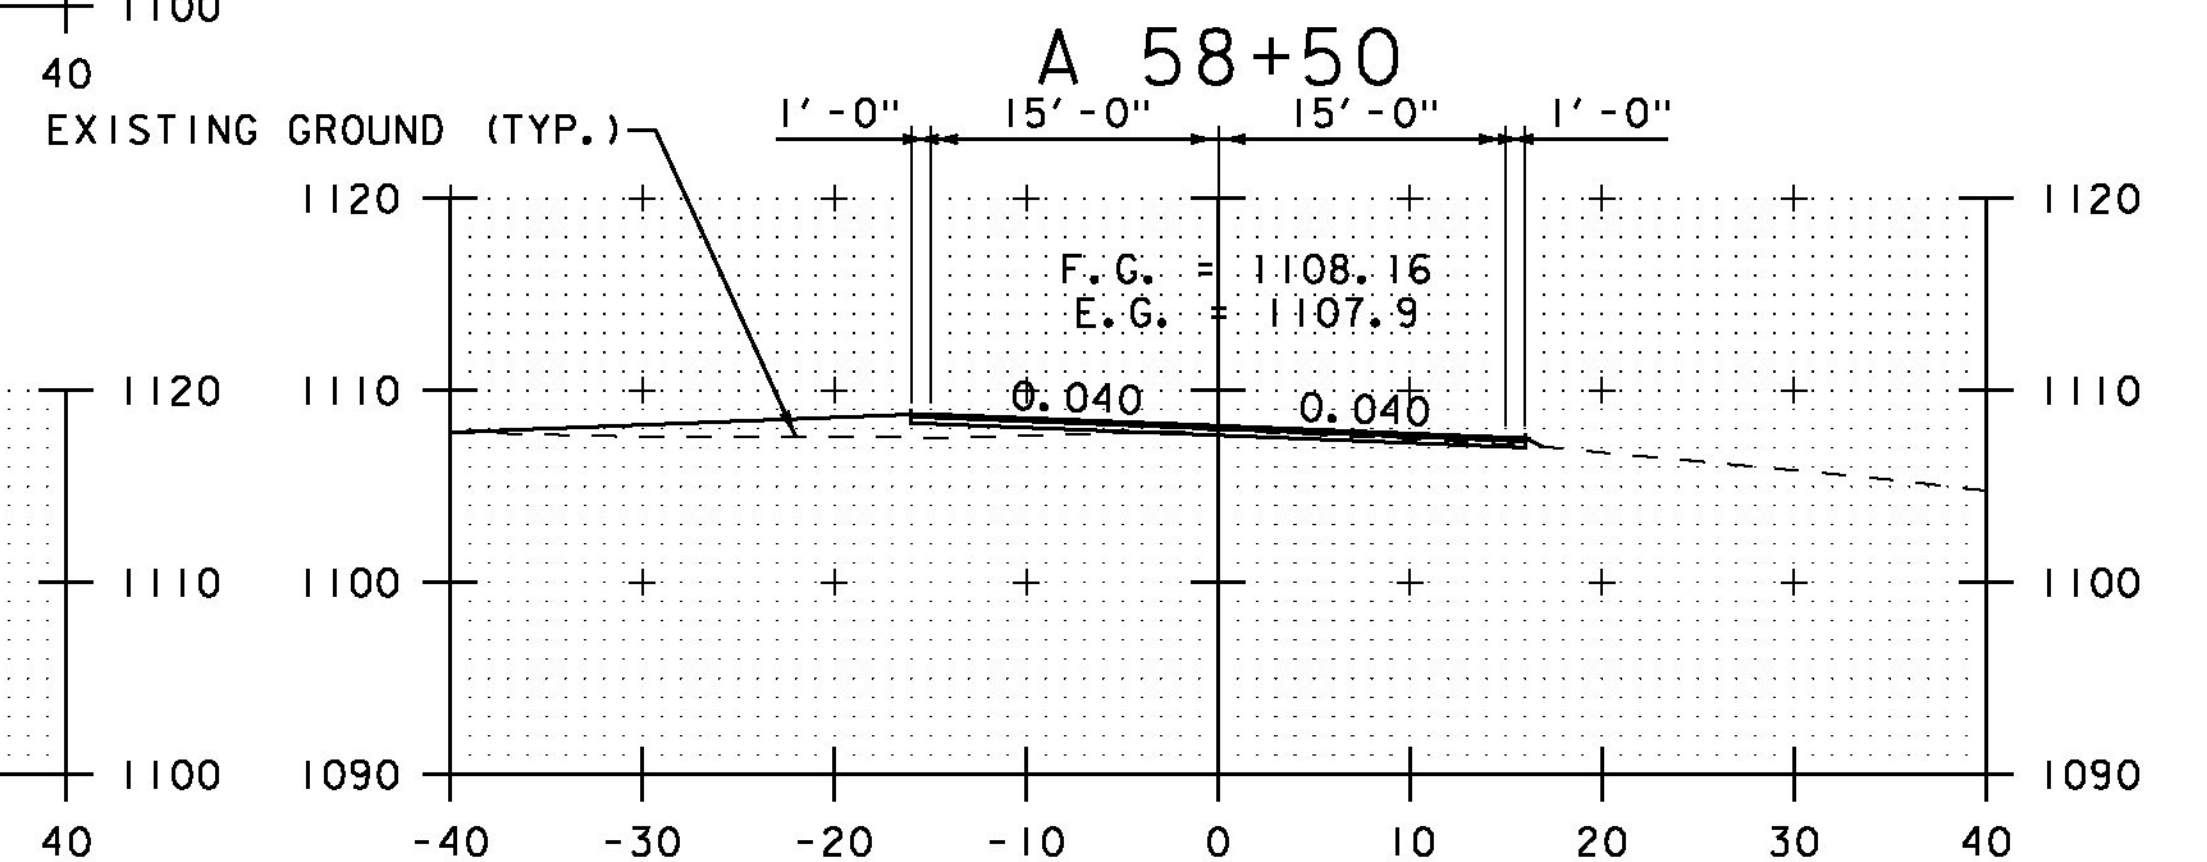

A 58+00 TH#39 LT

STA. A 54+00 TO STA. A 59+50



CROSS SECTION SHEET 52

PROJECT NAME: ELMORE-MORRISTOWN

PROJECT NUMBER: STP 2937 (1)

FILE NAME: z11c310.dgn

PROJECT LEADER: C. LATHROP

DESIGNED BY: S. LAMPHERE

PLOT FILE: z11c310_180.i

PLOT DATE: 3/3/14

DRAWN BY: B. MARTIN

CHECKED BY: C. LATHROP

SHEET 180 OF 194