




A 73+50

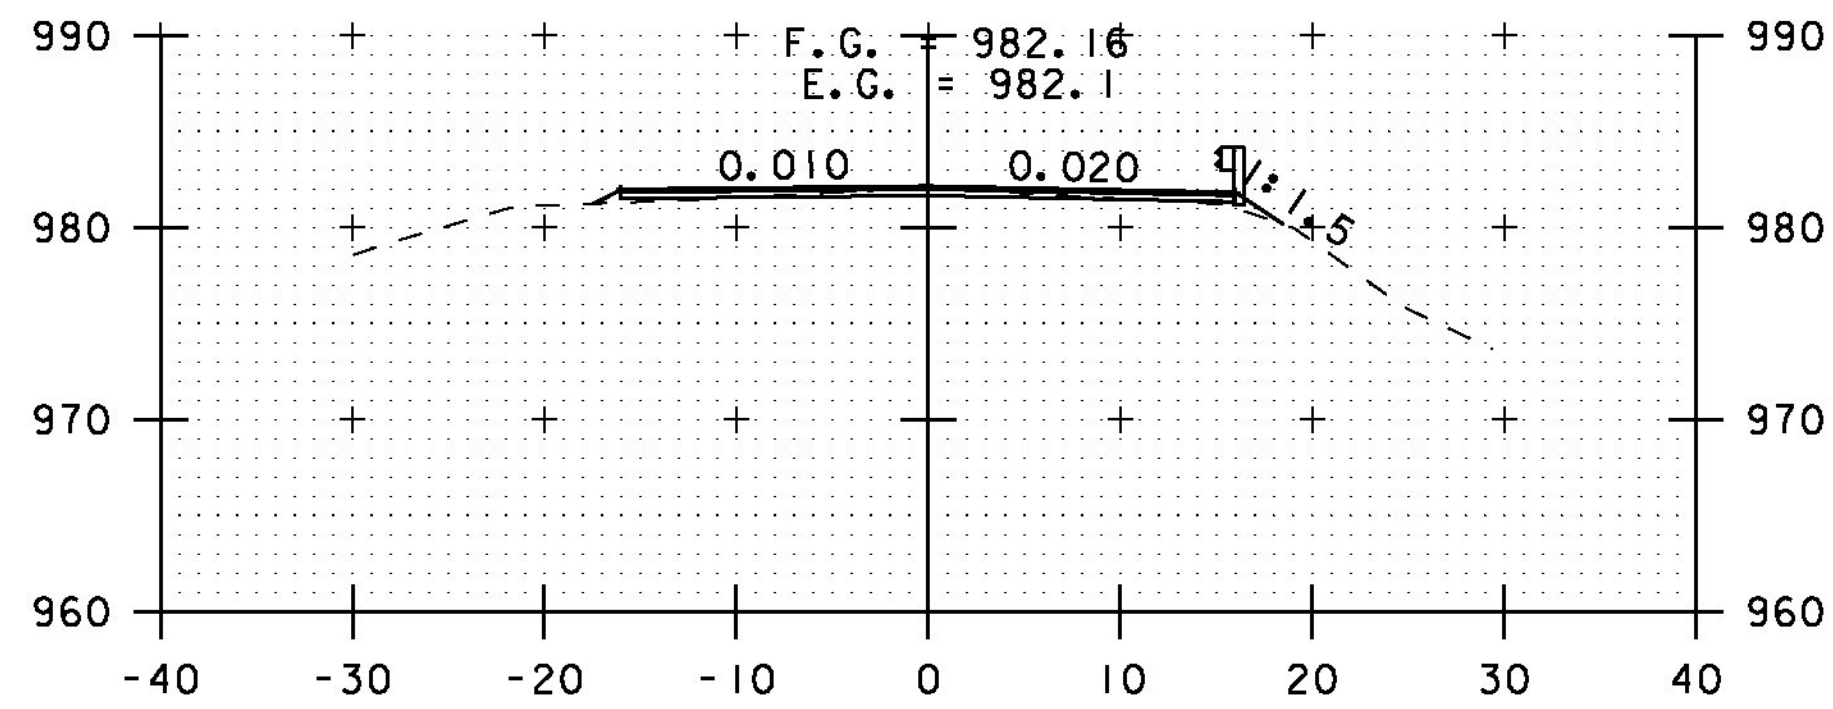


A 75+50

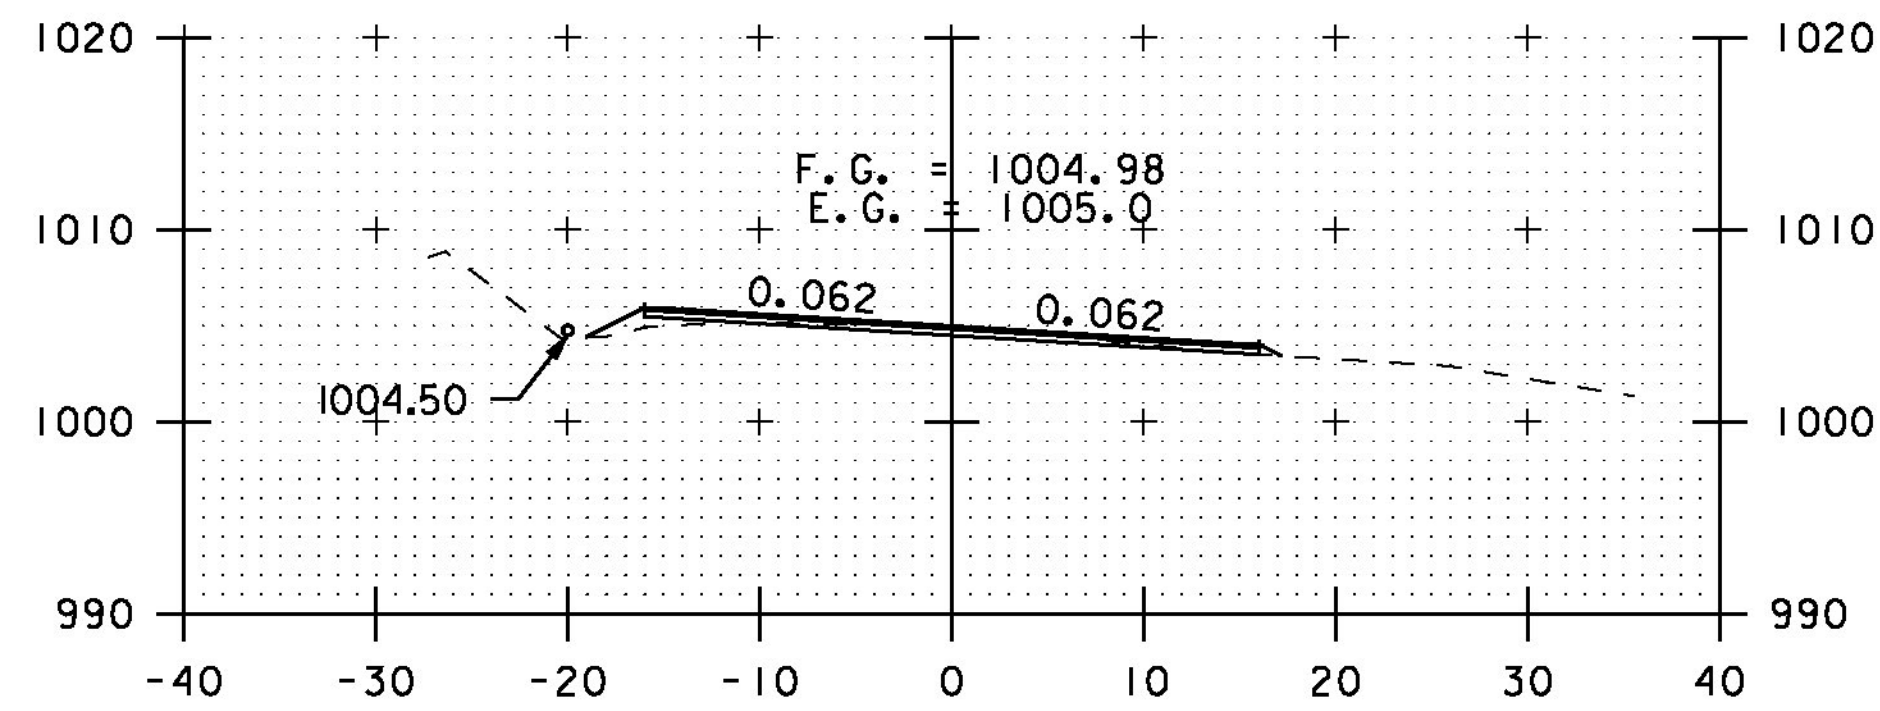


A 73+00

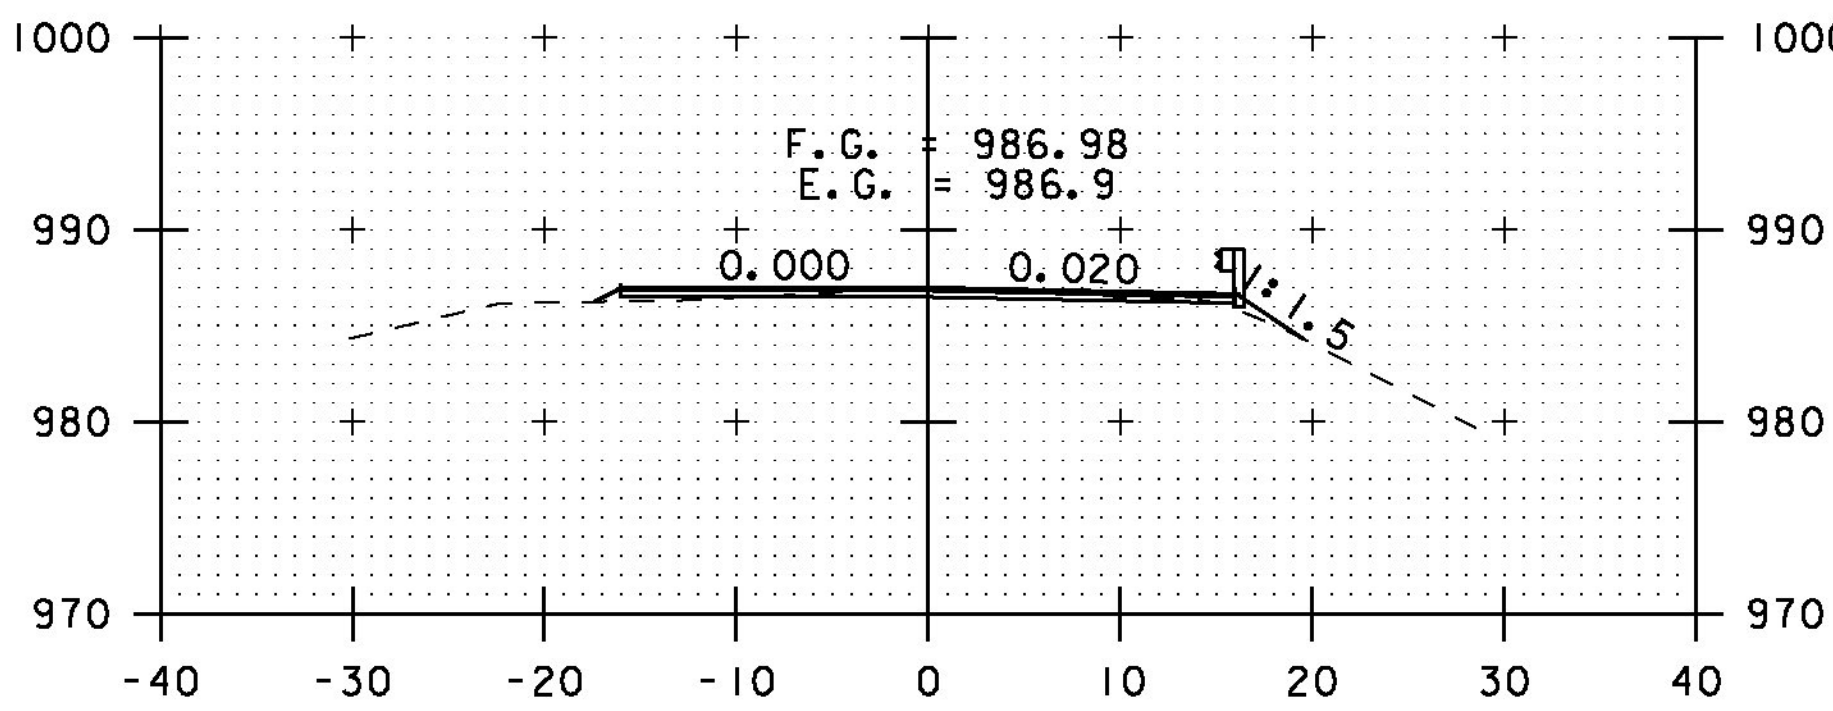


A 75+00

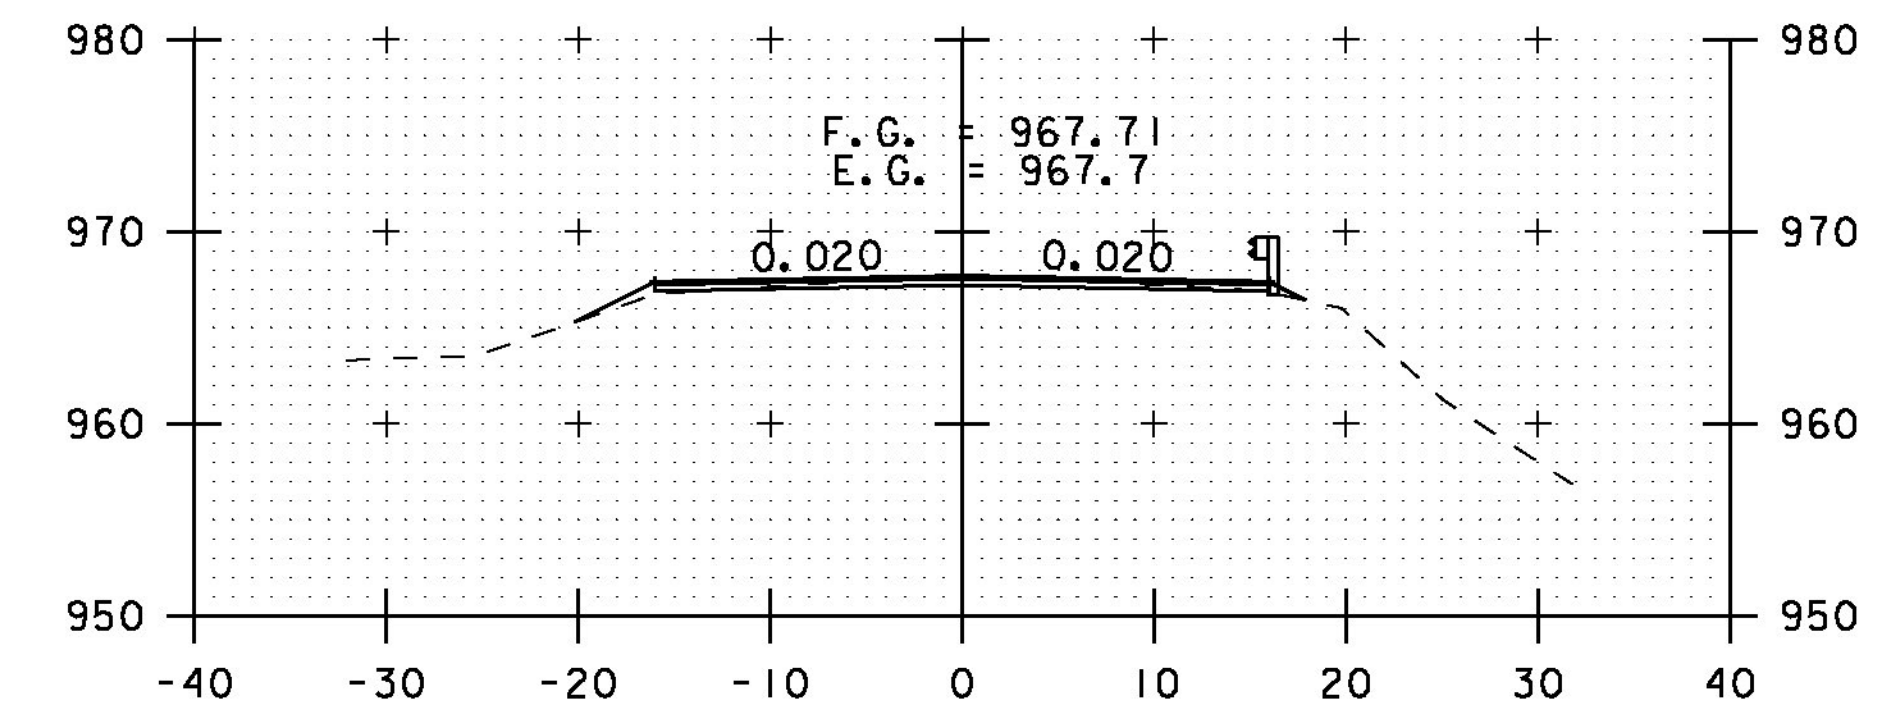


A 77+00

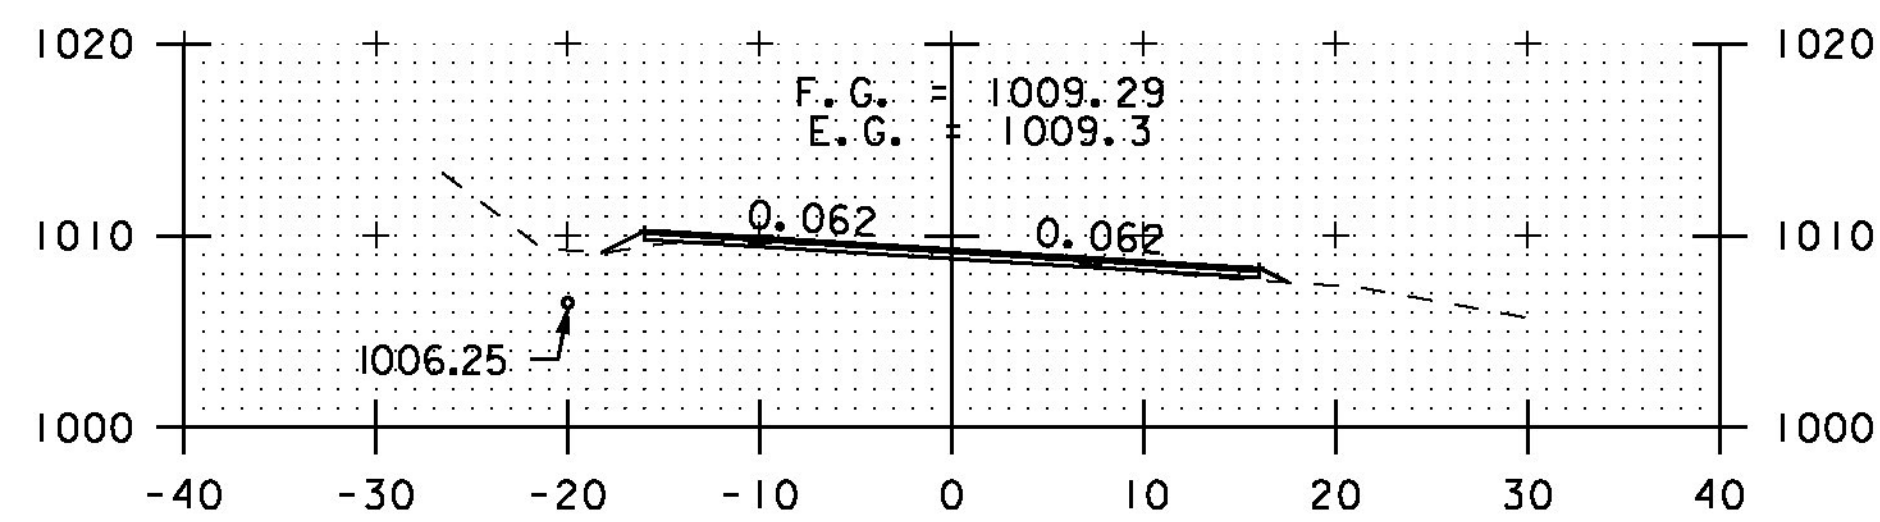


A 72+50

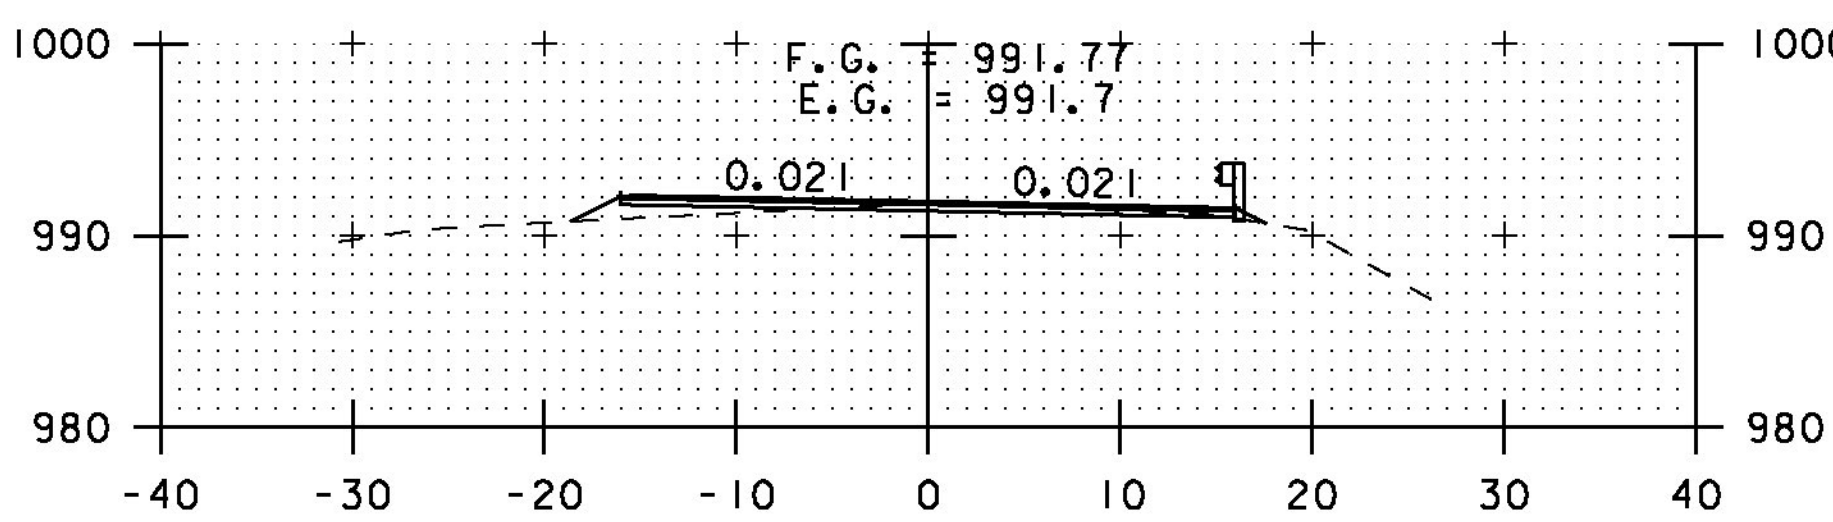


A 74+50

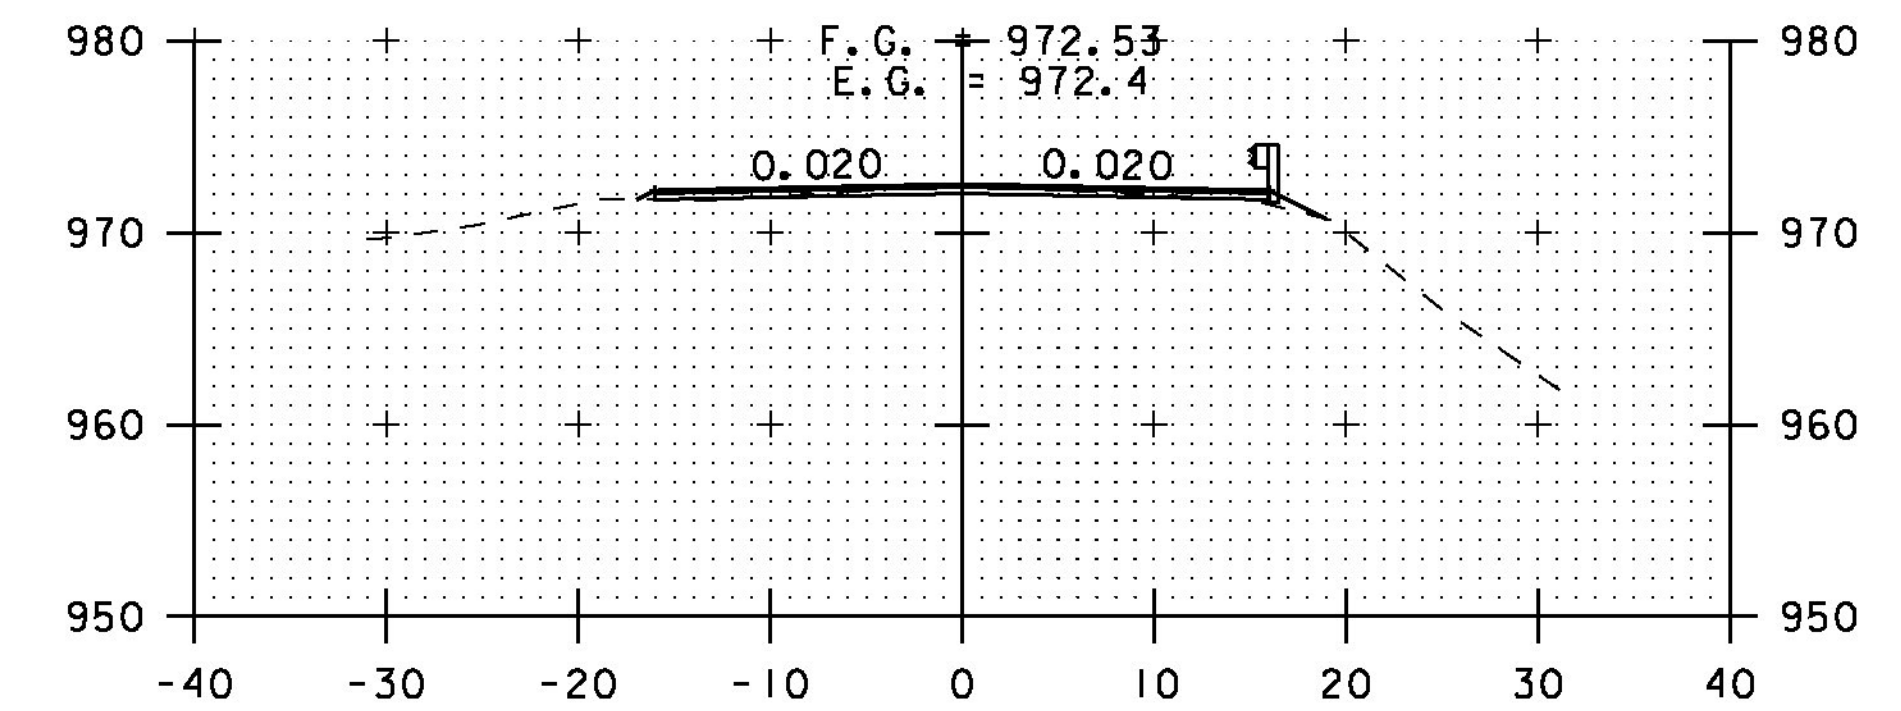


A 76+50

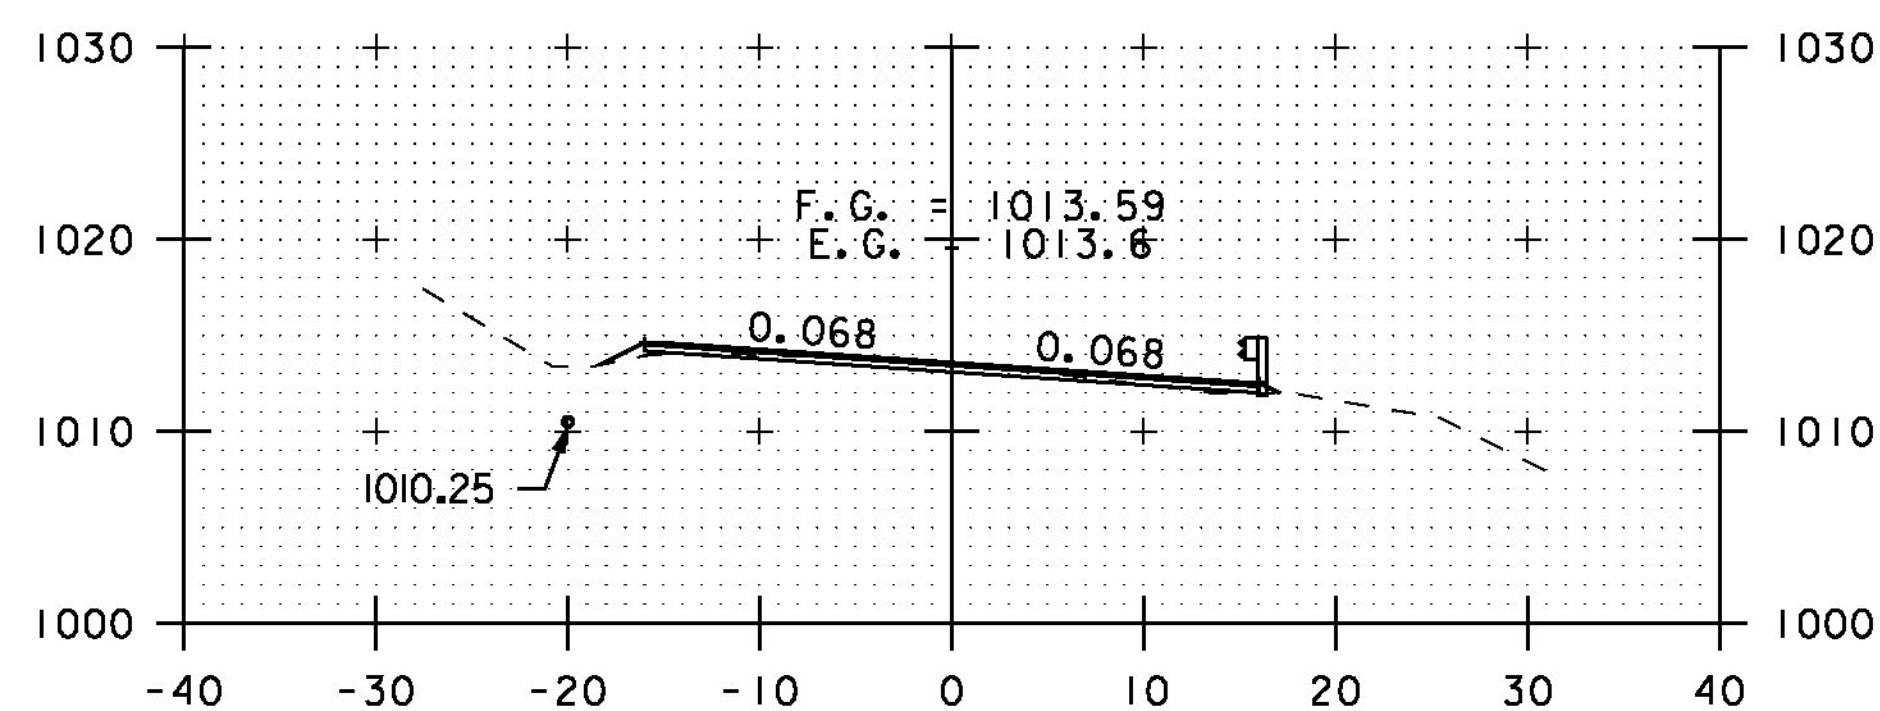

A 72+00

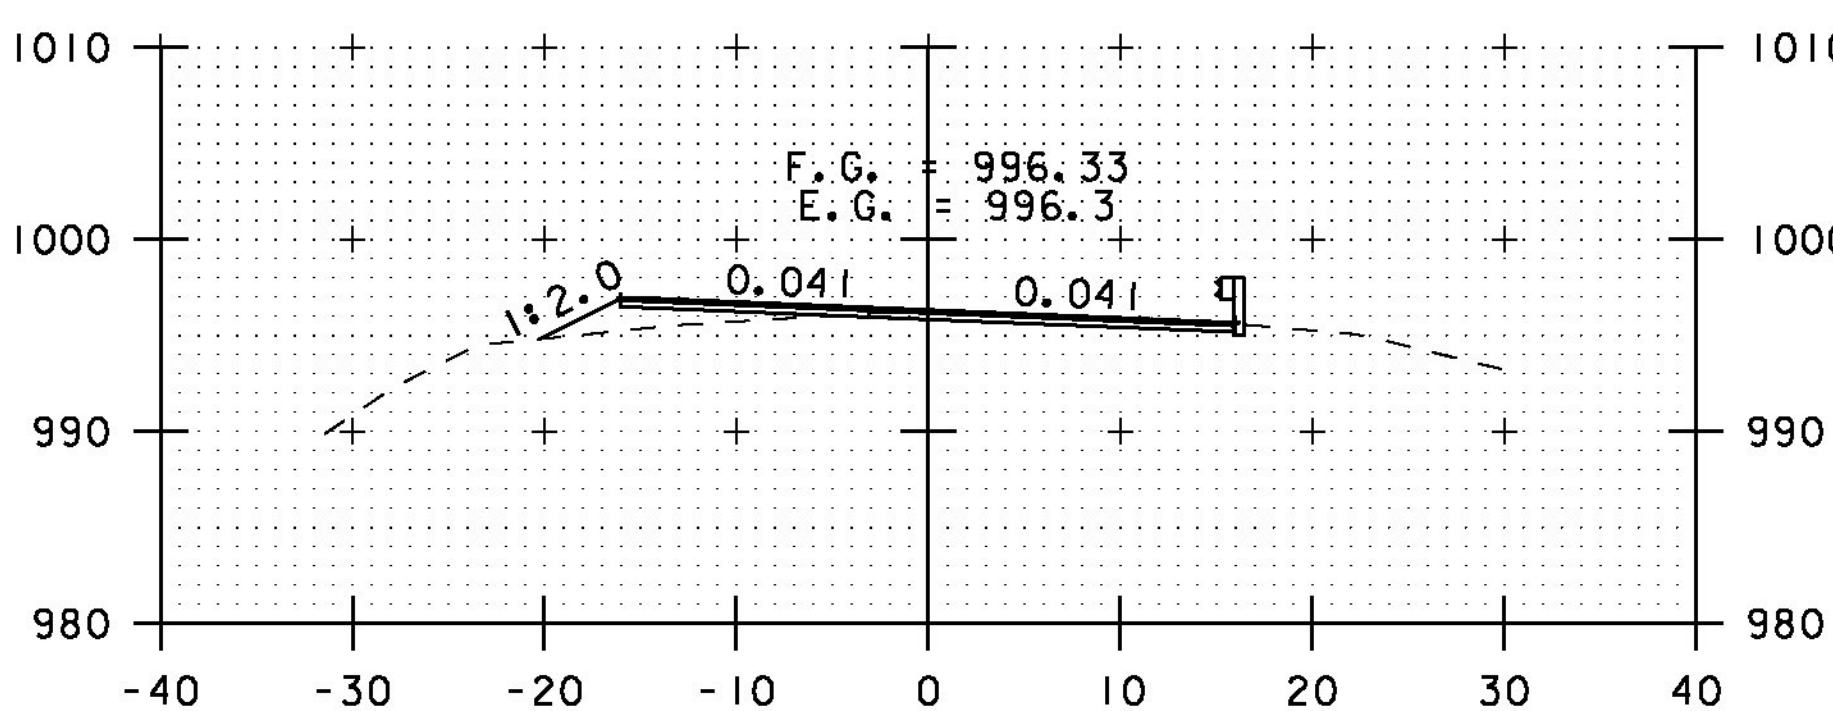

A 74+00

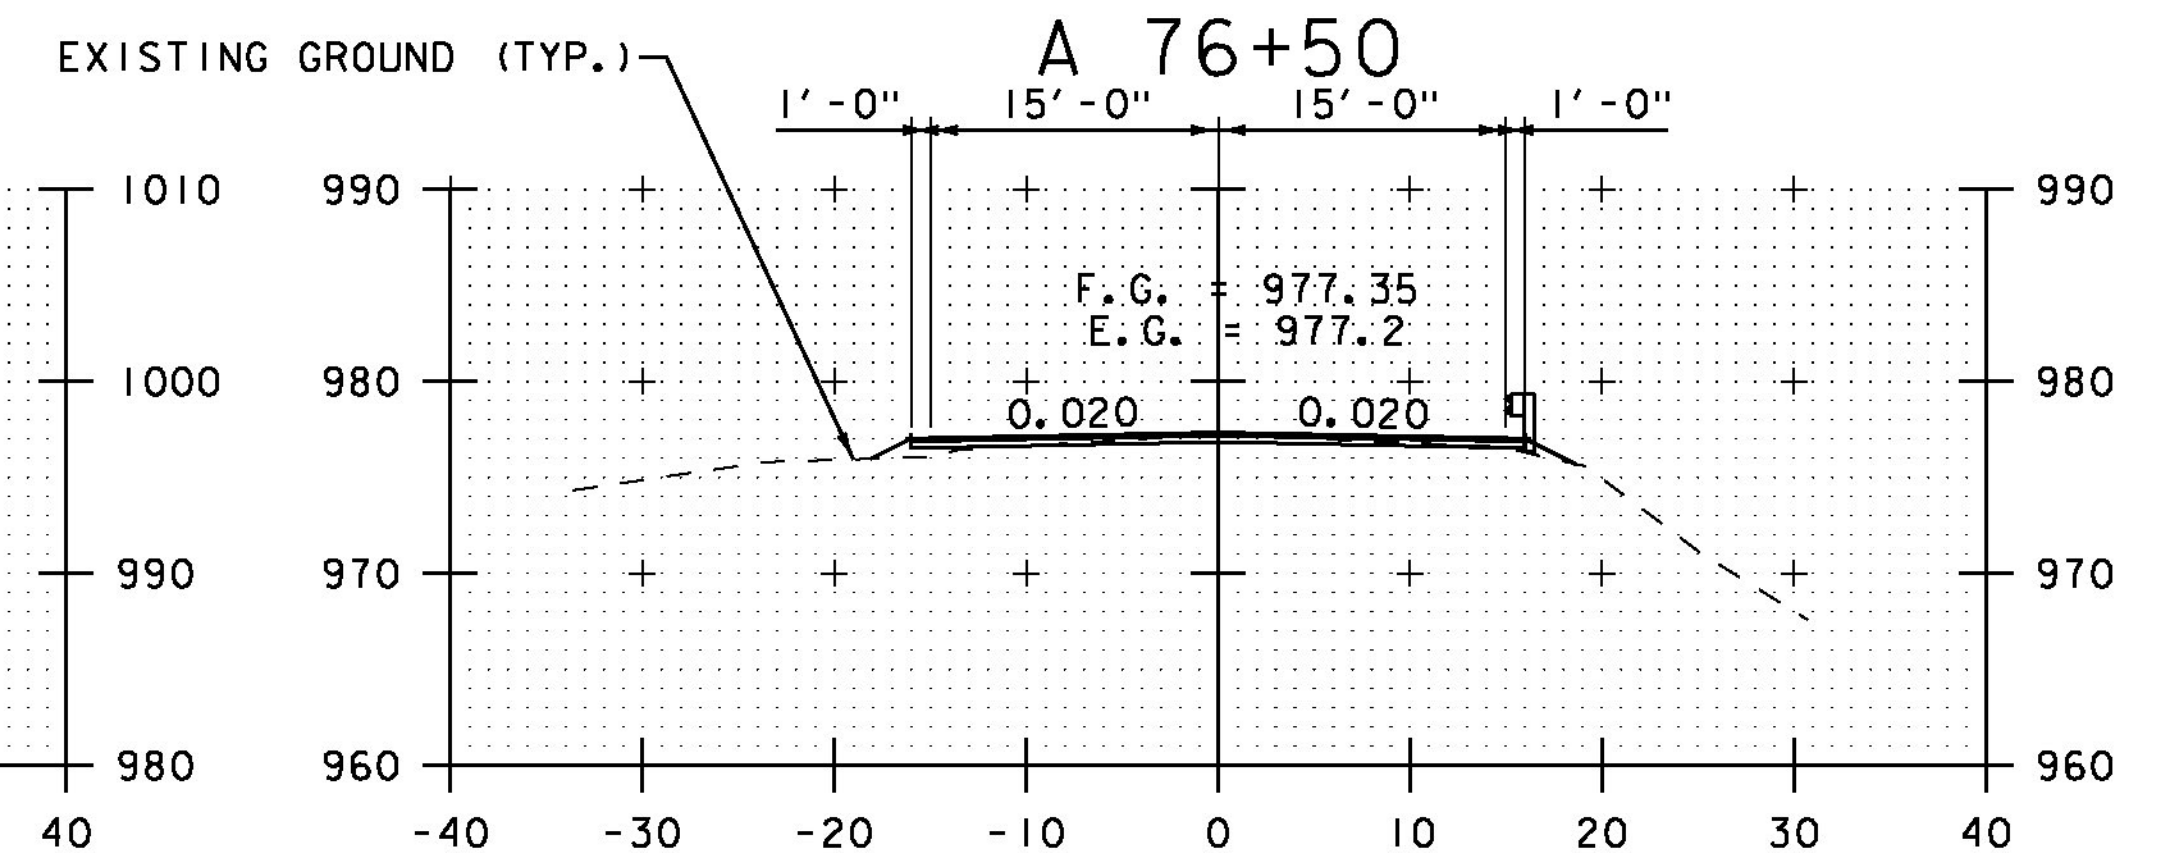

A 76+00

STA. A 72+00 TO STA. A 77+00

SCALE 1" = 10'-0"

CROSS SECTION SHEET 55

PROJECT NAME: ELMORE-MORRISTOWN	PROJECT NUMBER: STP 2937 (1)
FILE NAME: z11c310.dgn	PLOT DATE: 3/3/14
PROJECT LEADER: C. LATHROP	DRAWN BY: B. MARTIN
DESIGNED BY: S. LAMPHERE	CHECKED BY: C. LATHROP
PLOT FILE: z11c310_183.i	SHEET 183 OF 194