

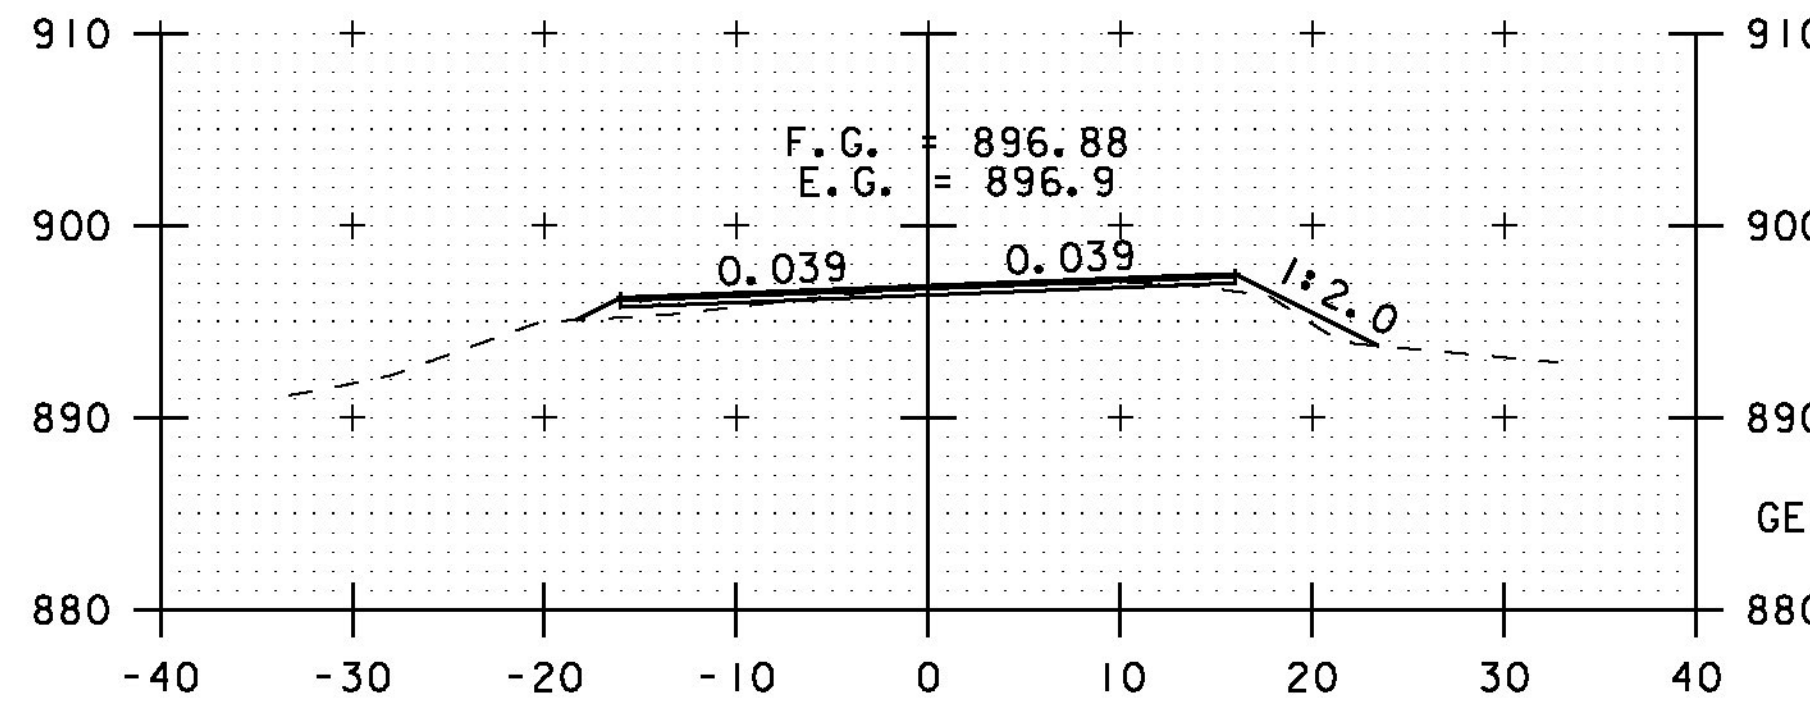



A 85+00

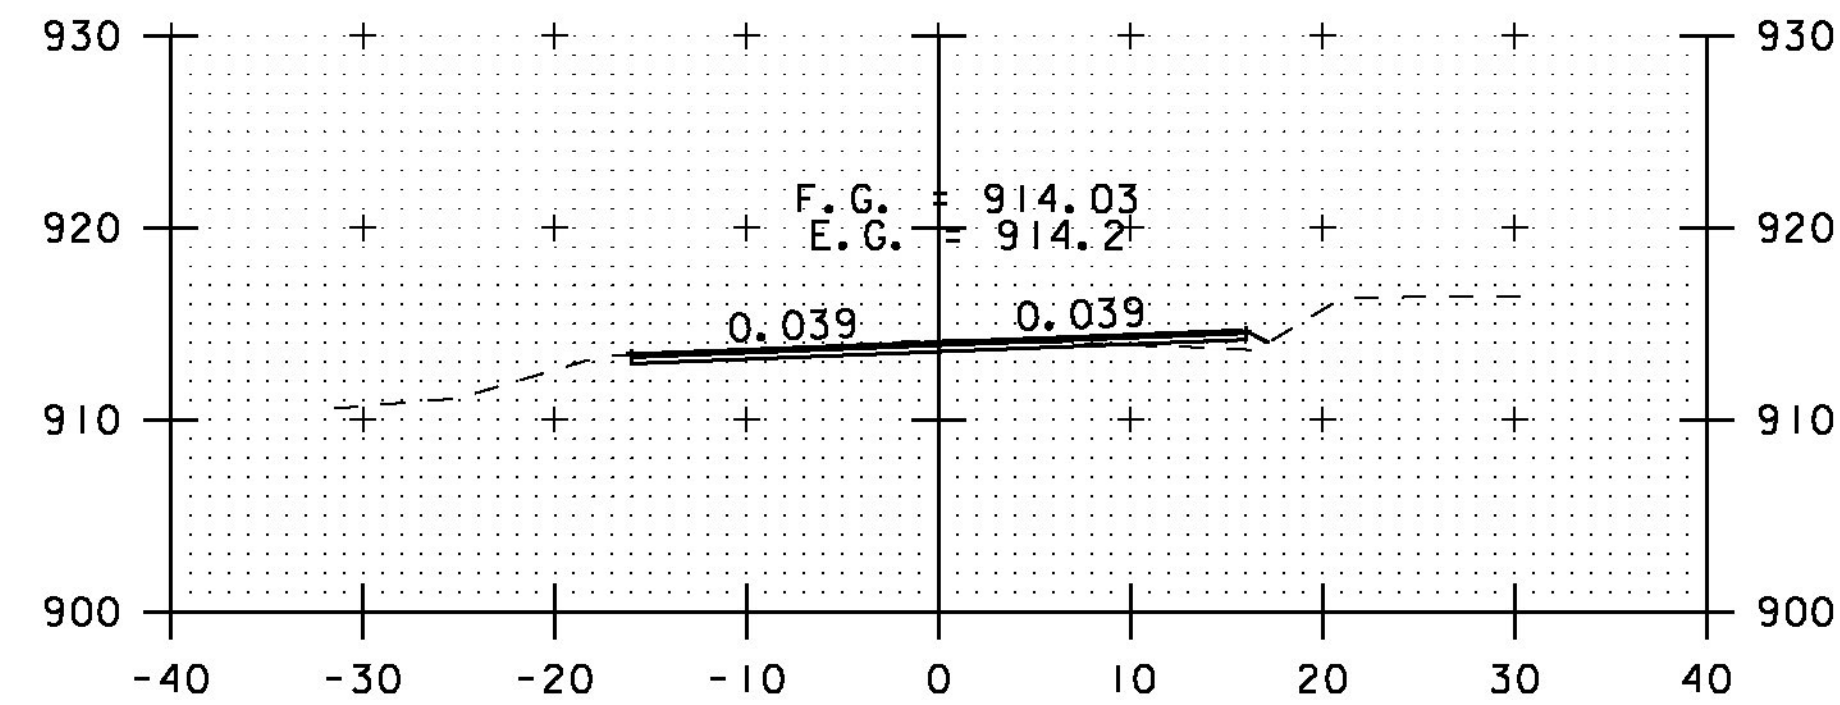



A 87+00

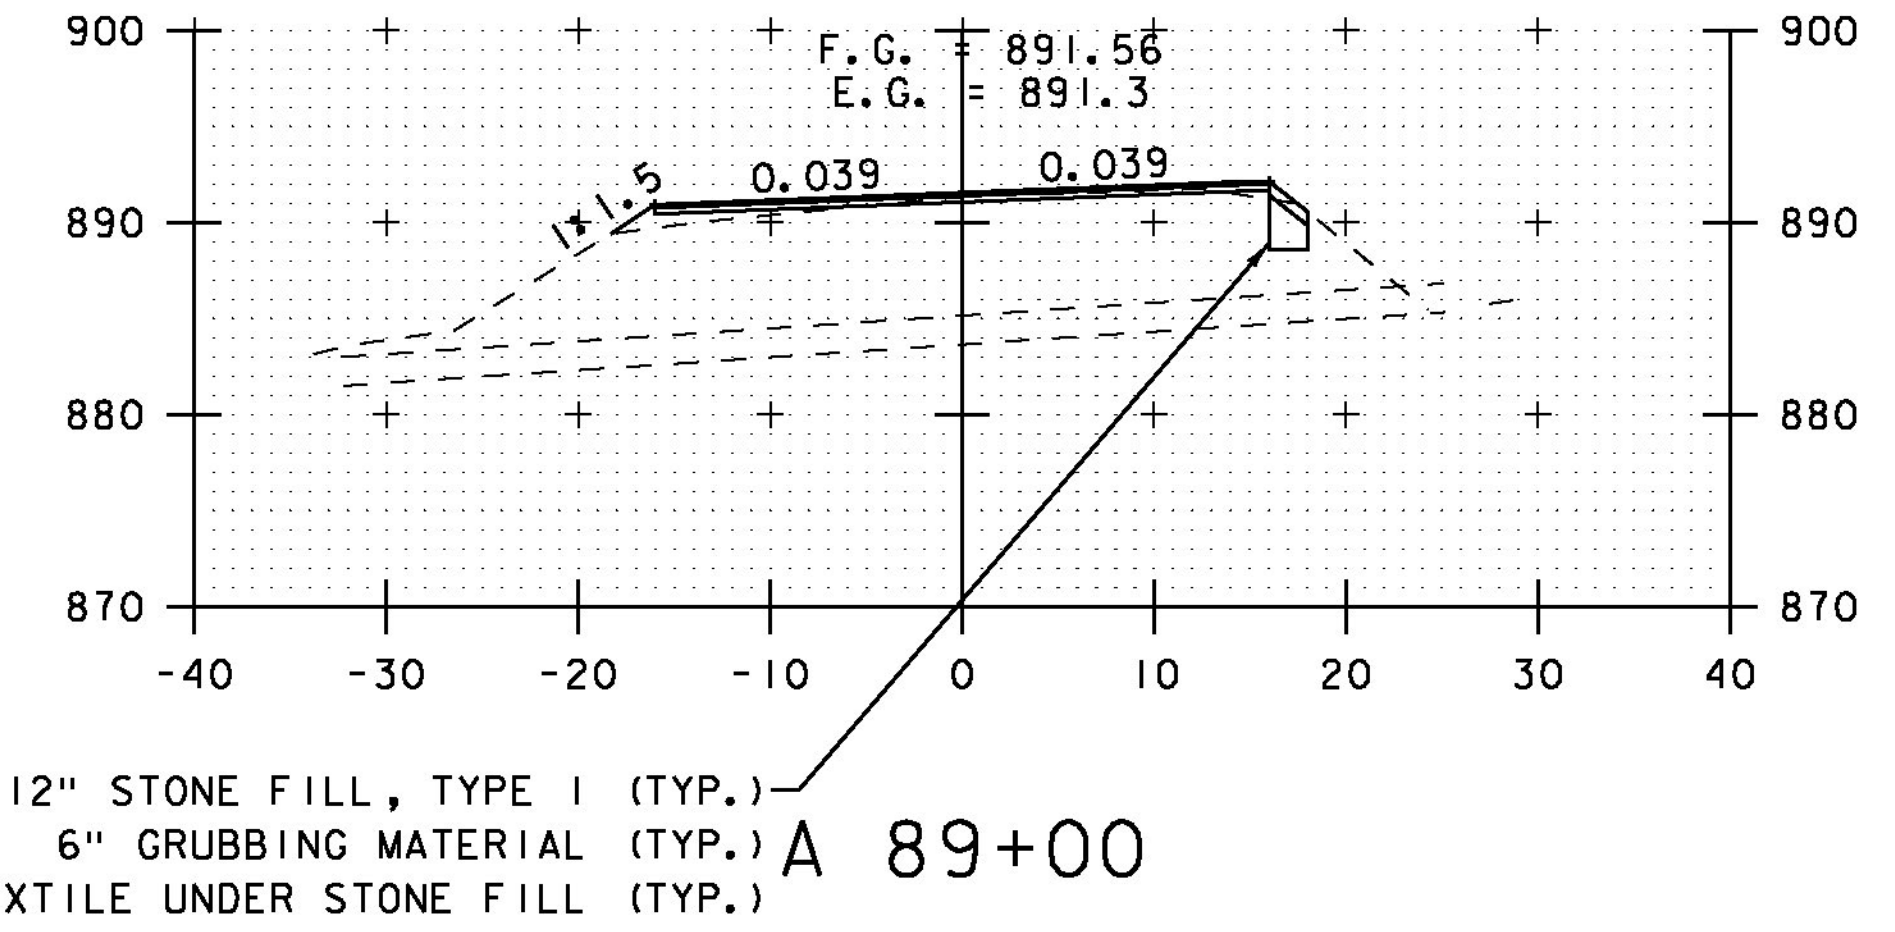


A 84+50

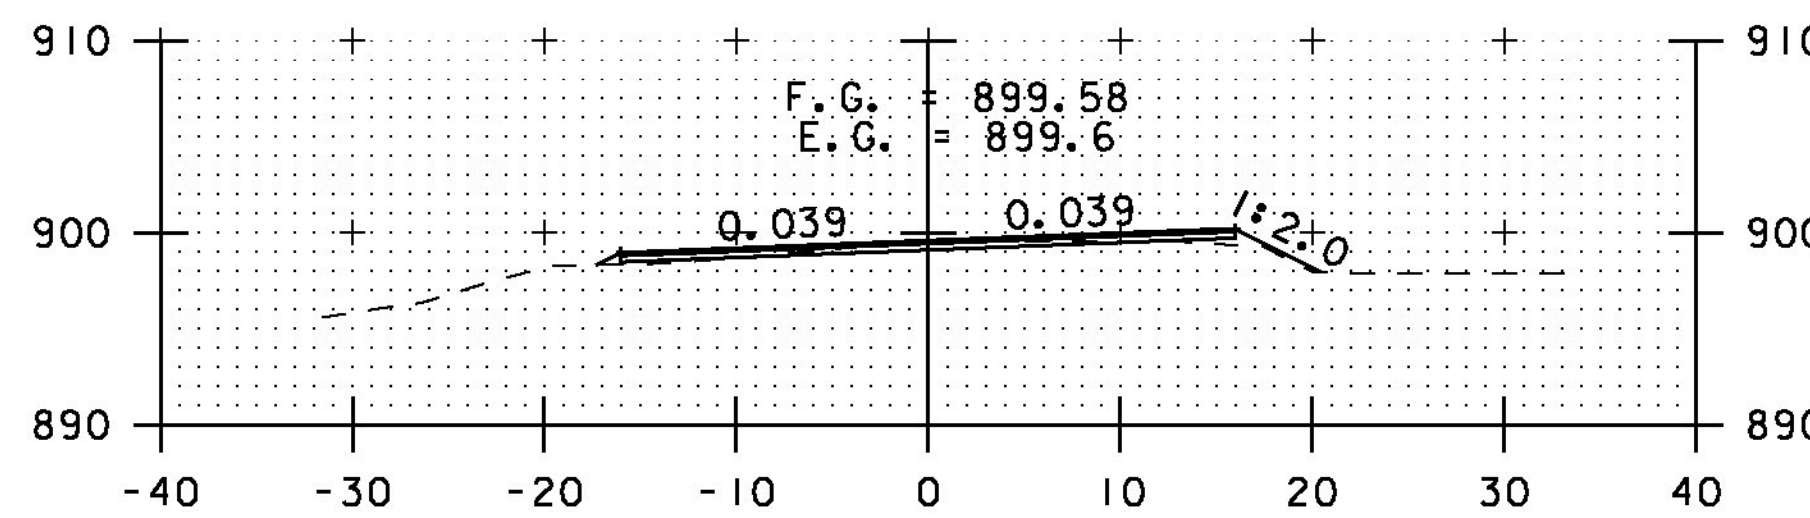



A 86+50

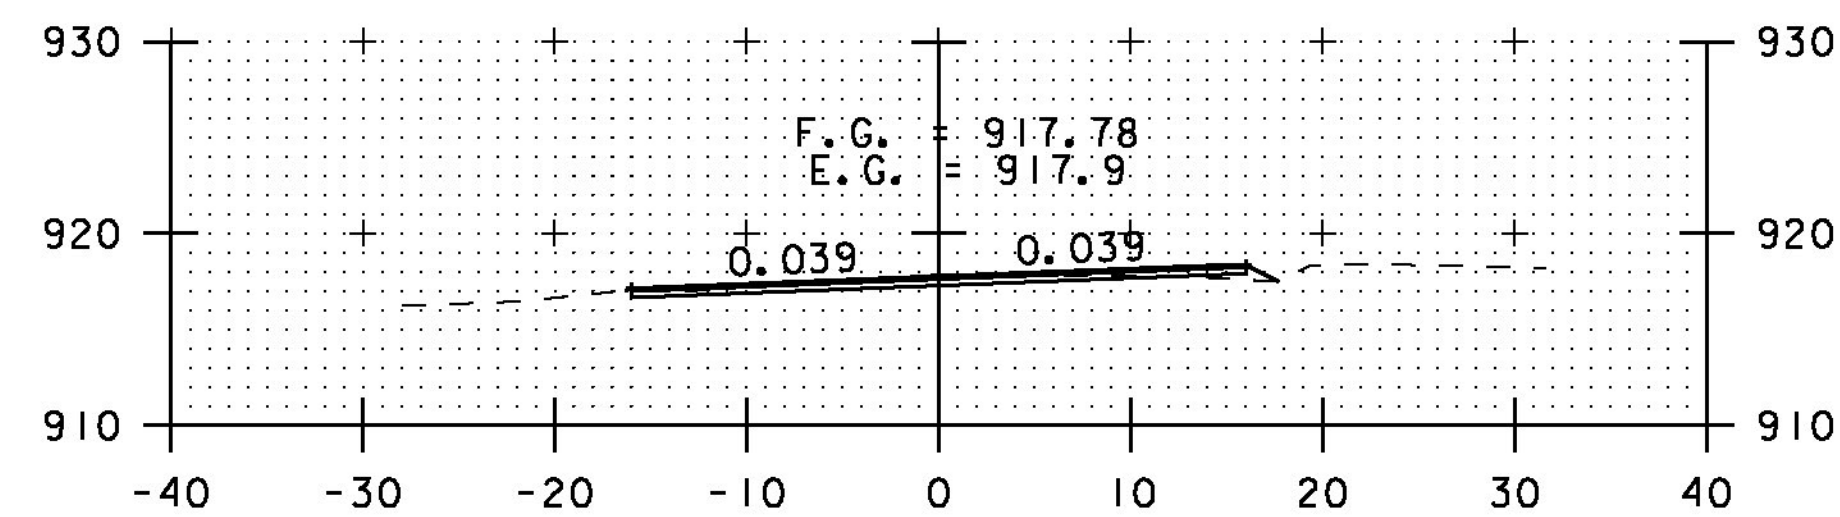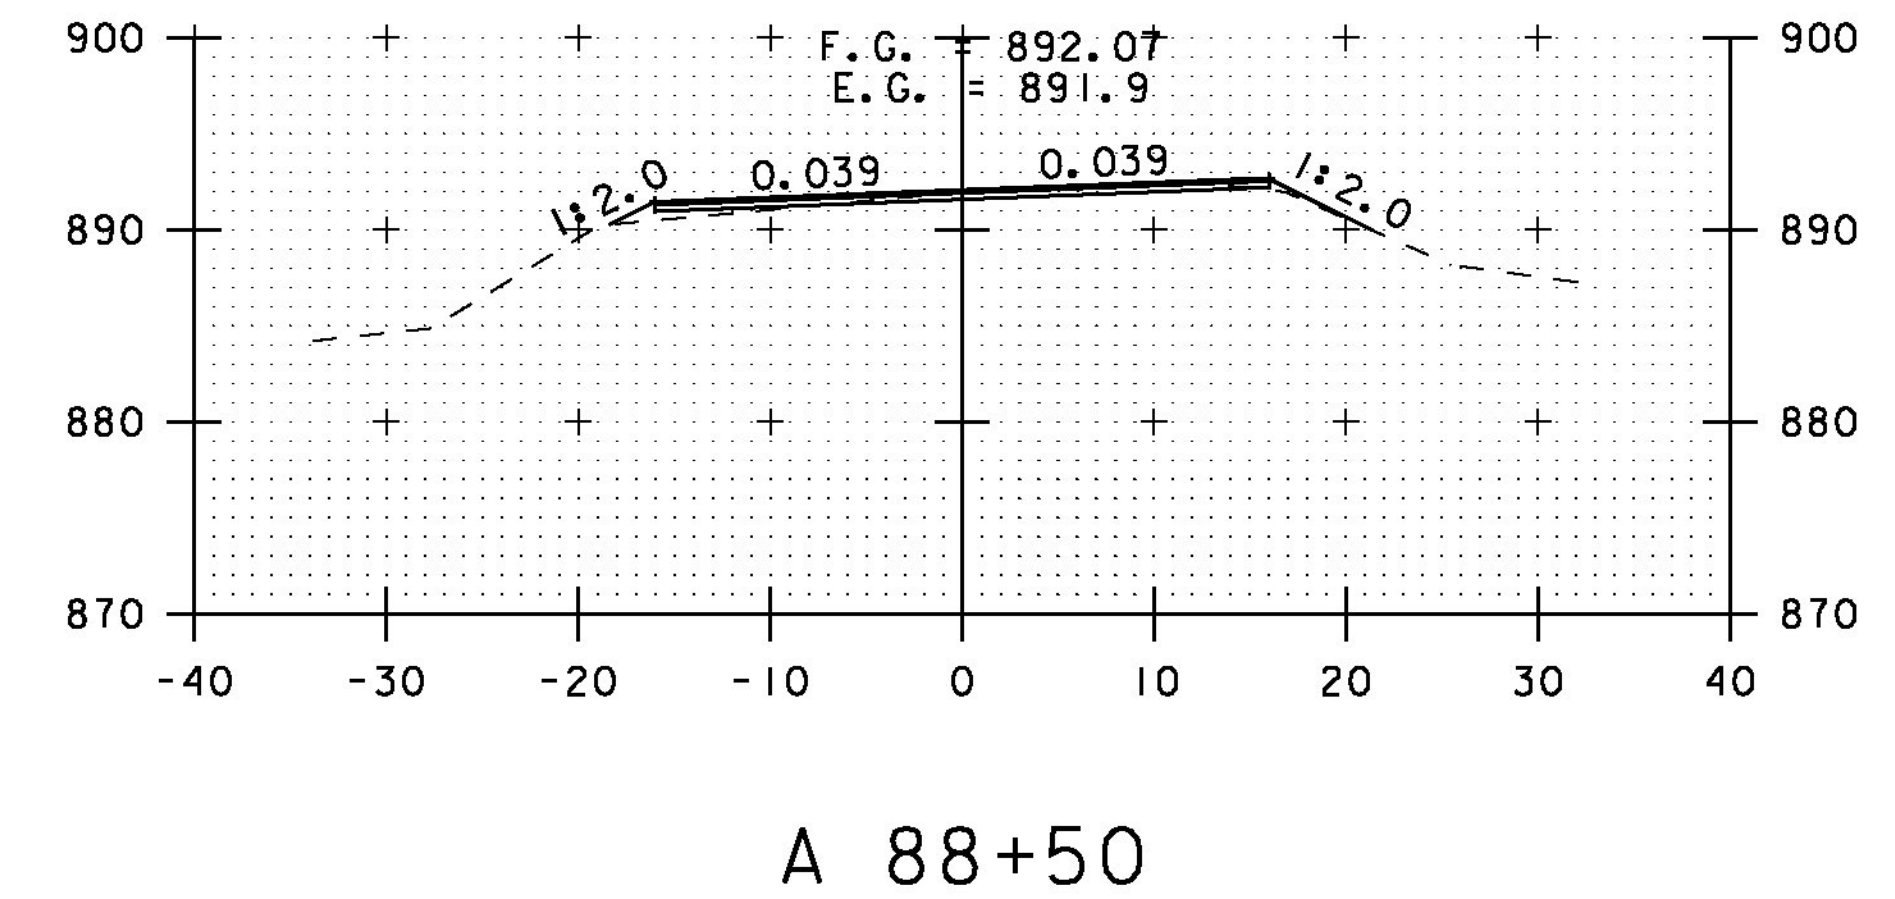


A 84+00

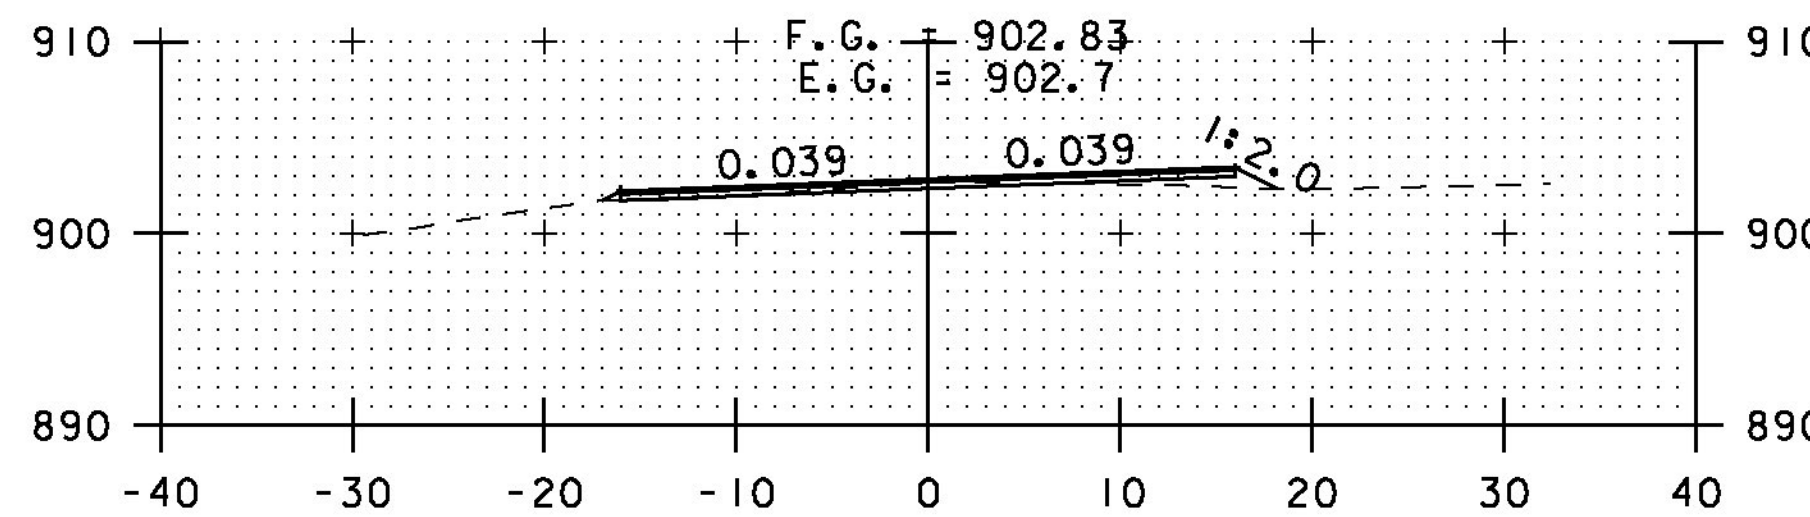


A 86+00

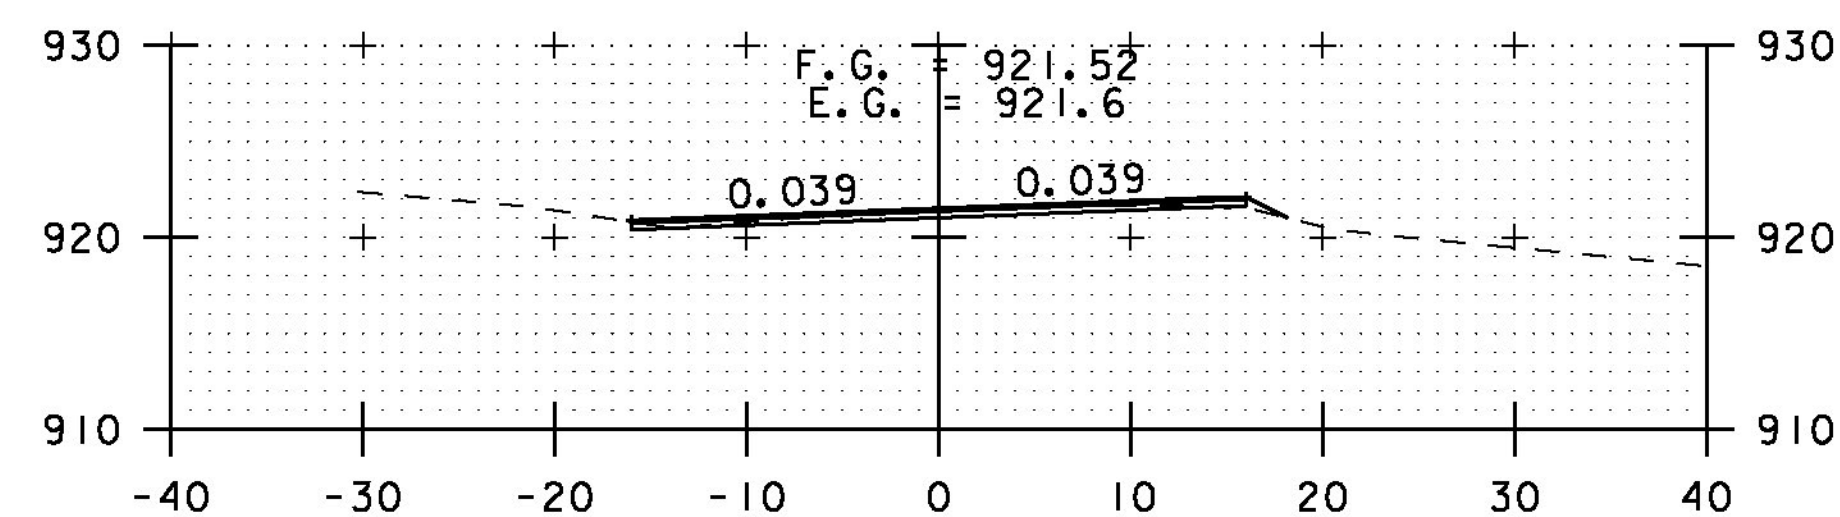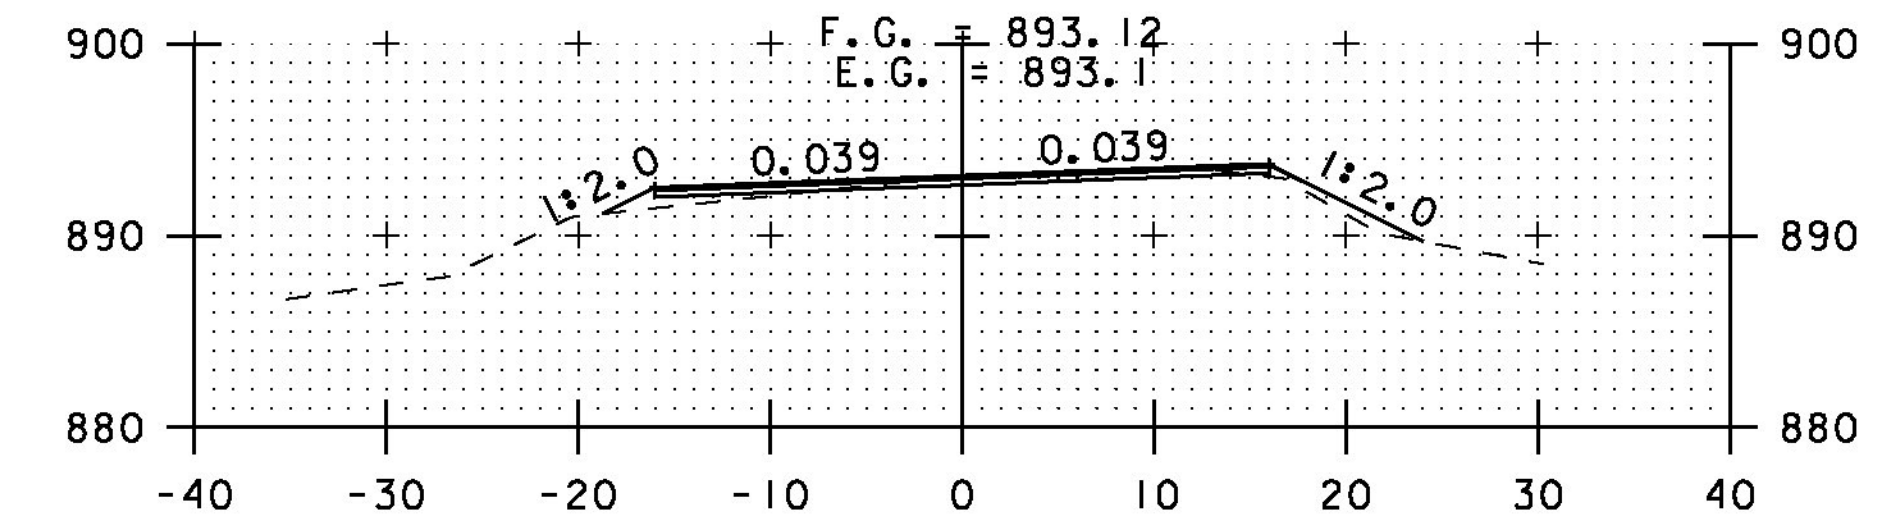

A 83+50

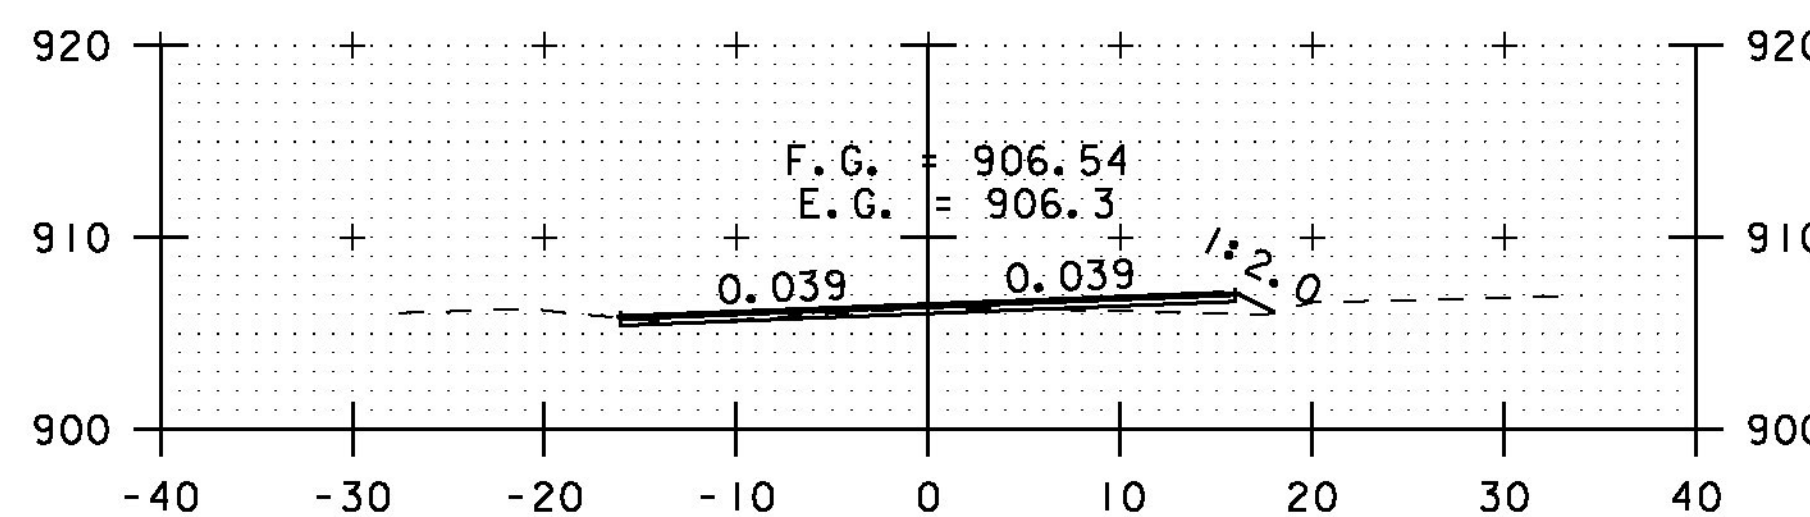

A 85+50

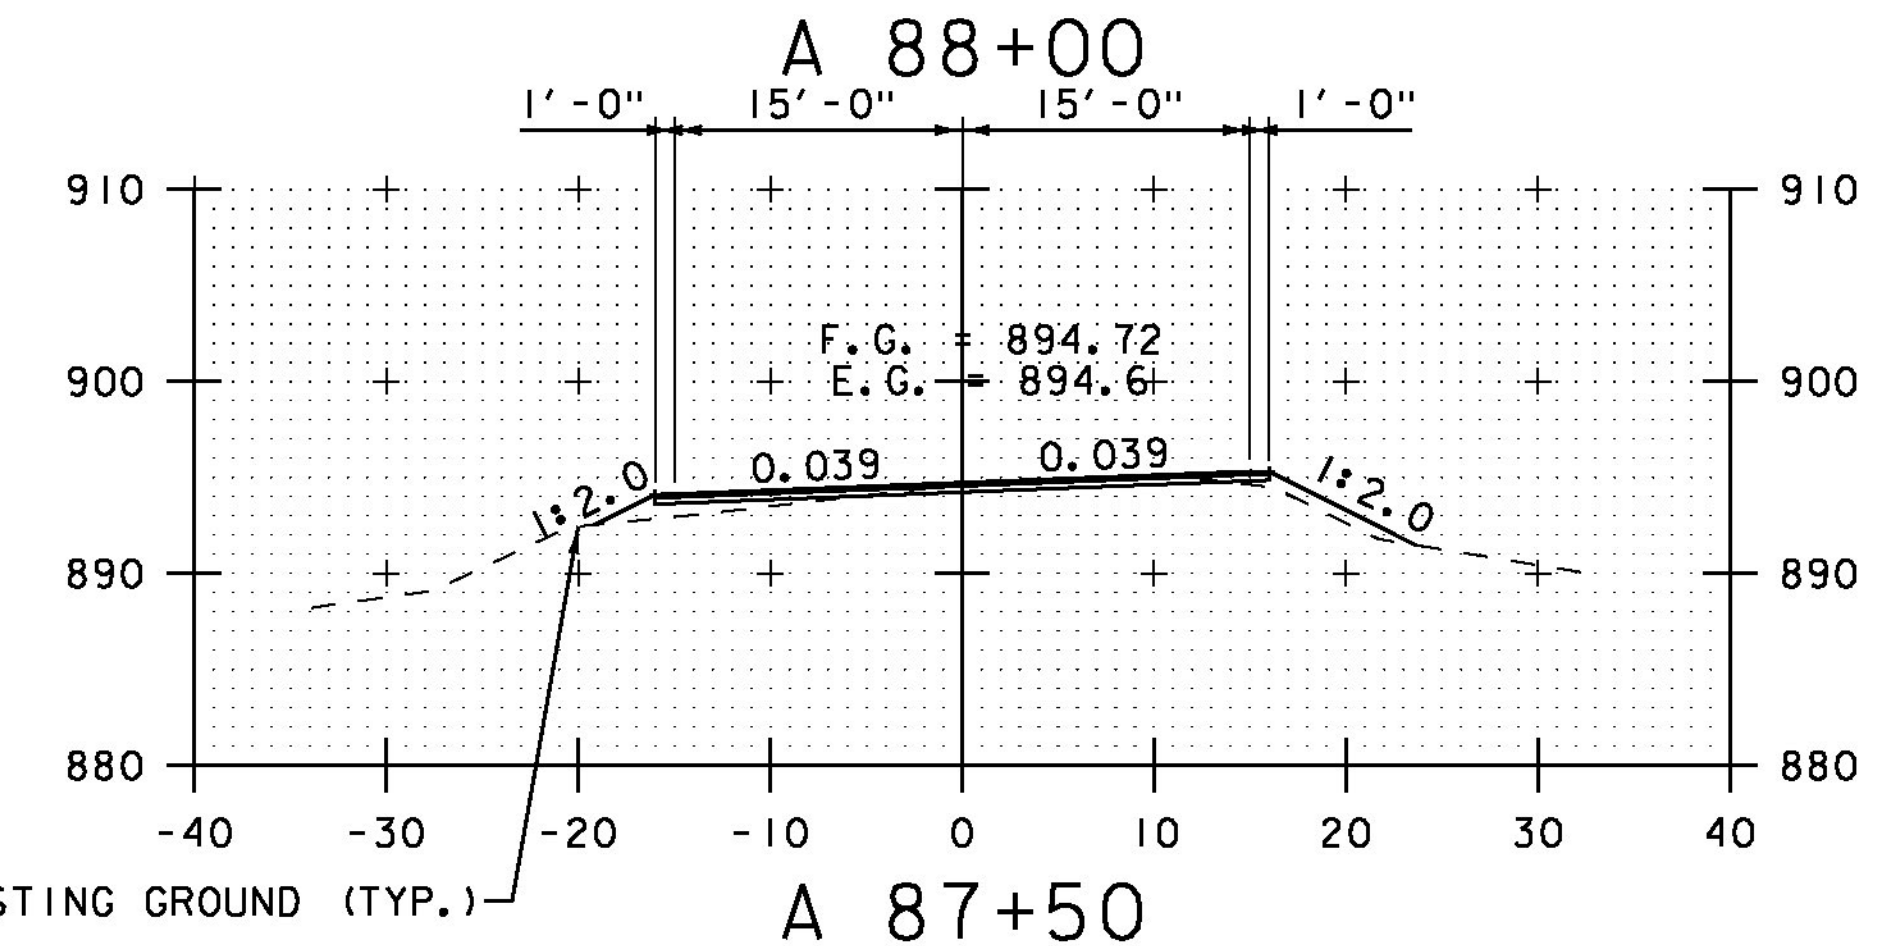

STA. A 83+50 TO STA. A 89+00



CROSS SECTION SHEET 57

PROJECT NAME: ELMORE-MORRISTOWN

PROJECT NUMBER: STP 2937 (1)

FILE NAME: z11c310.dgn

PROJECT LEADER: C. LATHROP

DESIGNED BY: S. LAMPHERE

PLOT FILE: z11c310_185.i

PLOT DATE: 3/3/14

DRAWN BY: B. MARTIN

CHECKED BY: C. LATHROP

SHEET 185 OF 194