




A 108+50

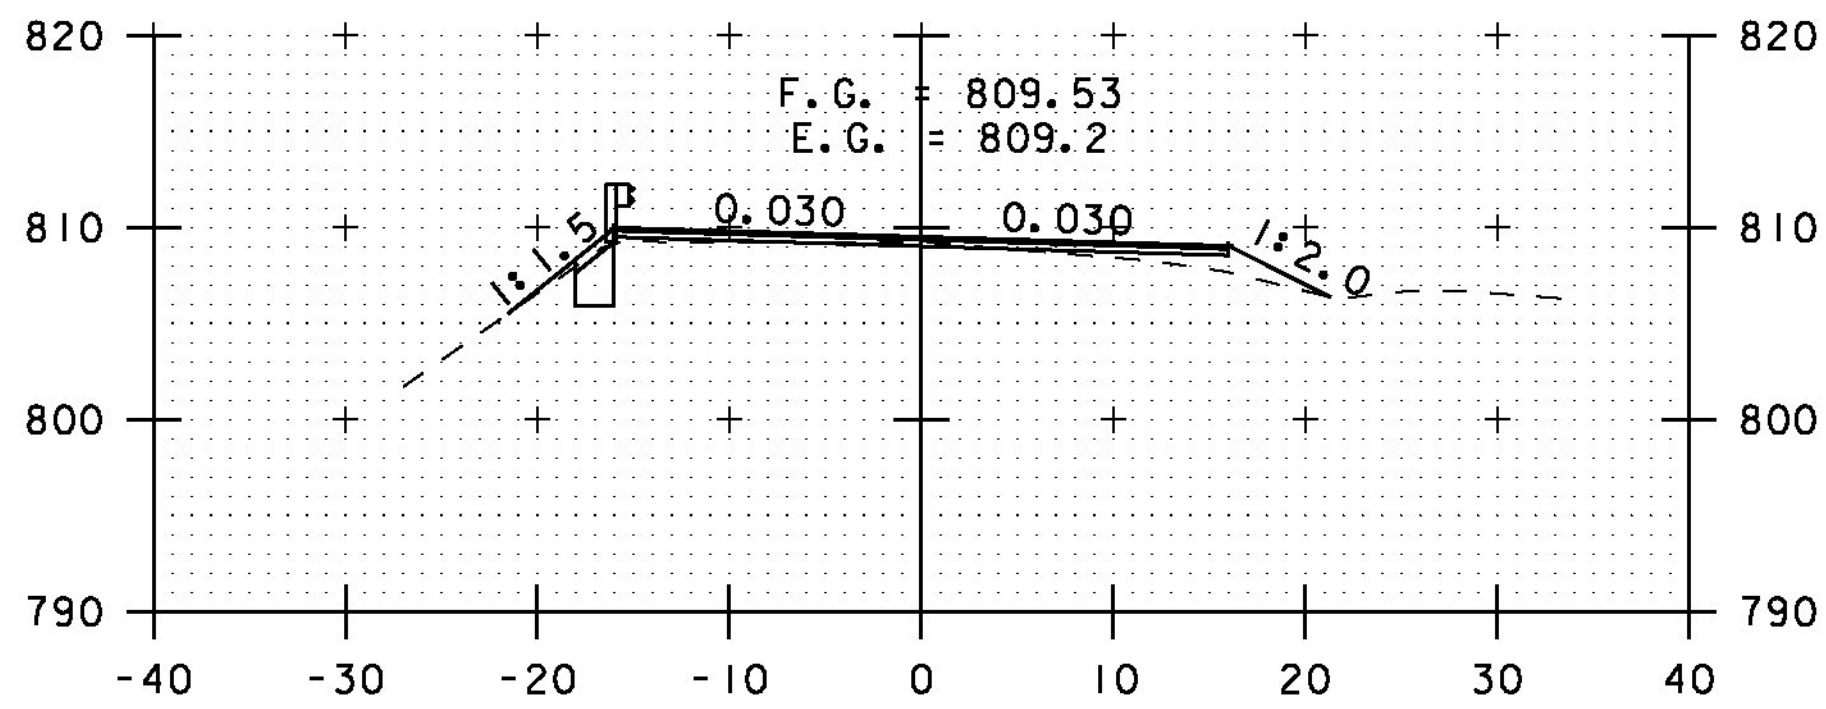


A 110+50

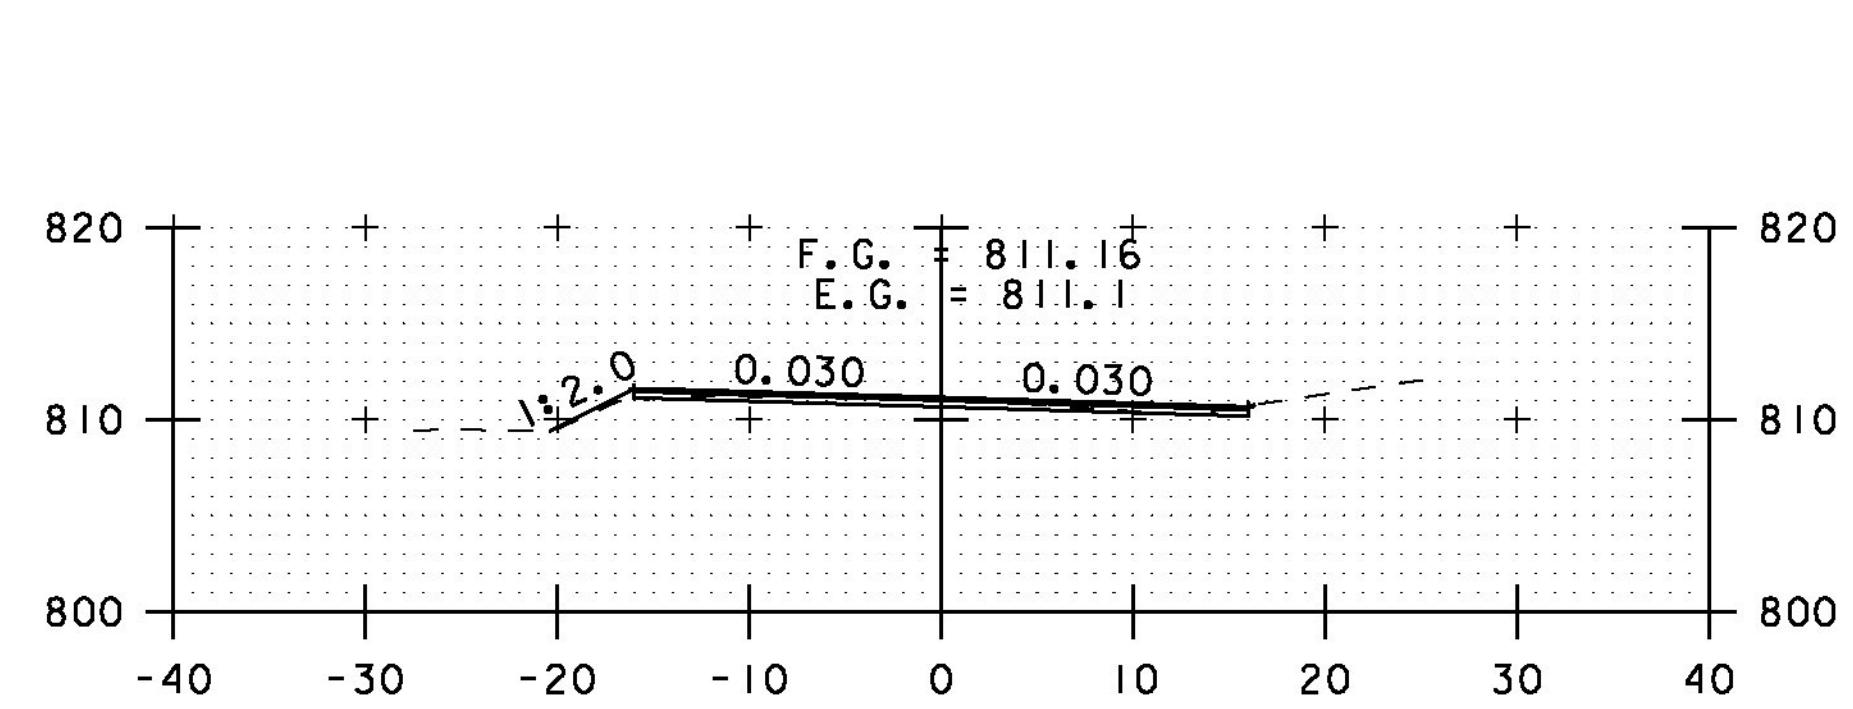


A 112+50

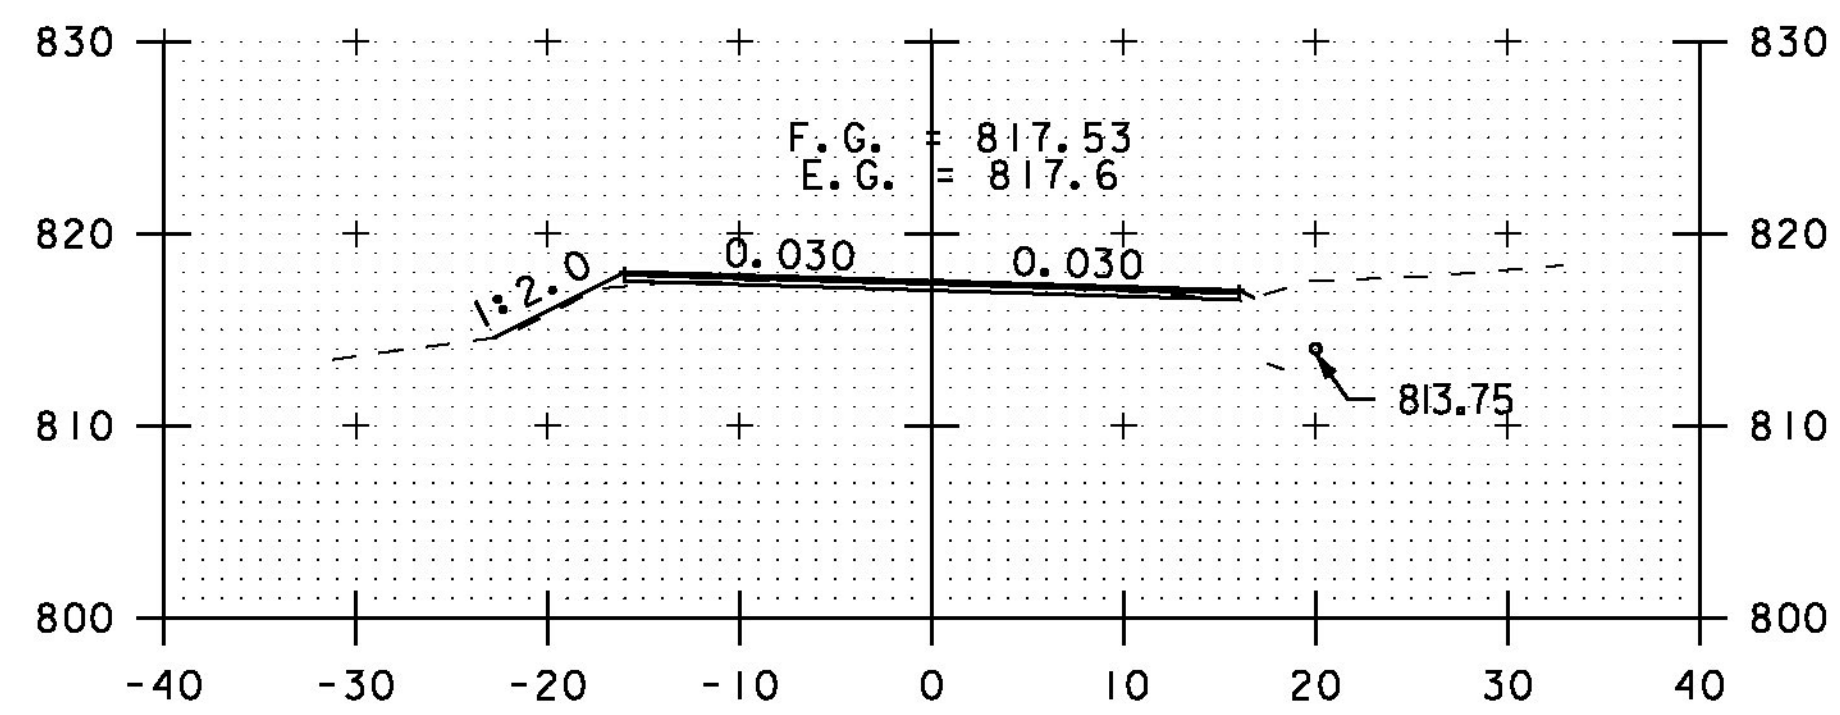


A 108+00

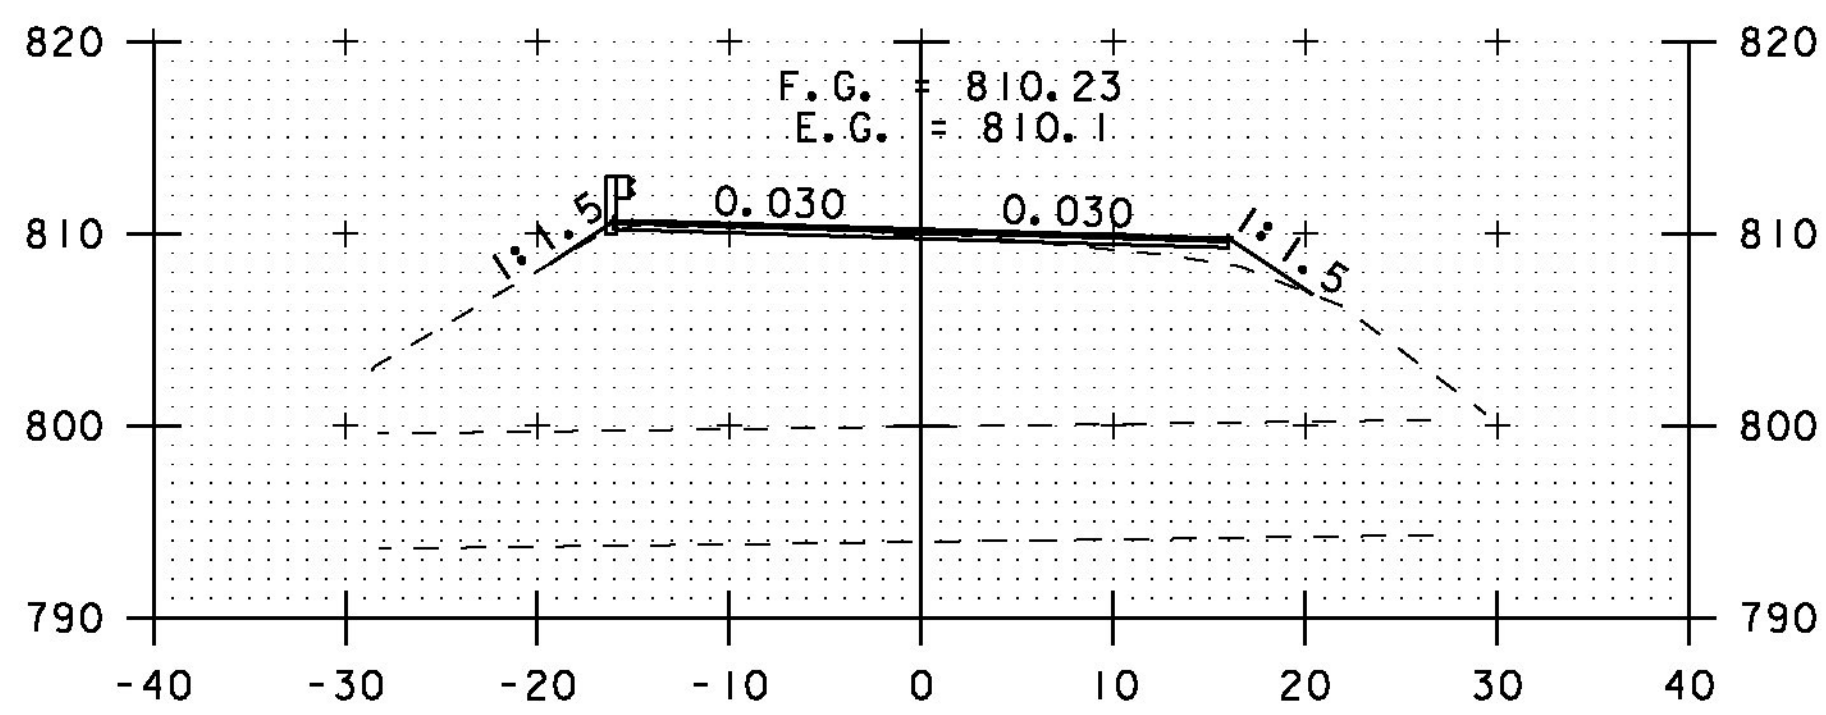


A 110+00

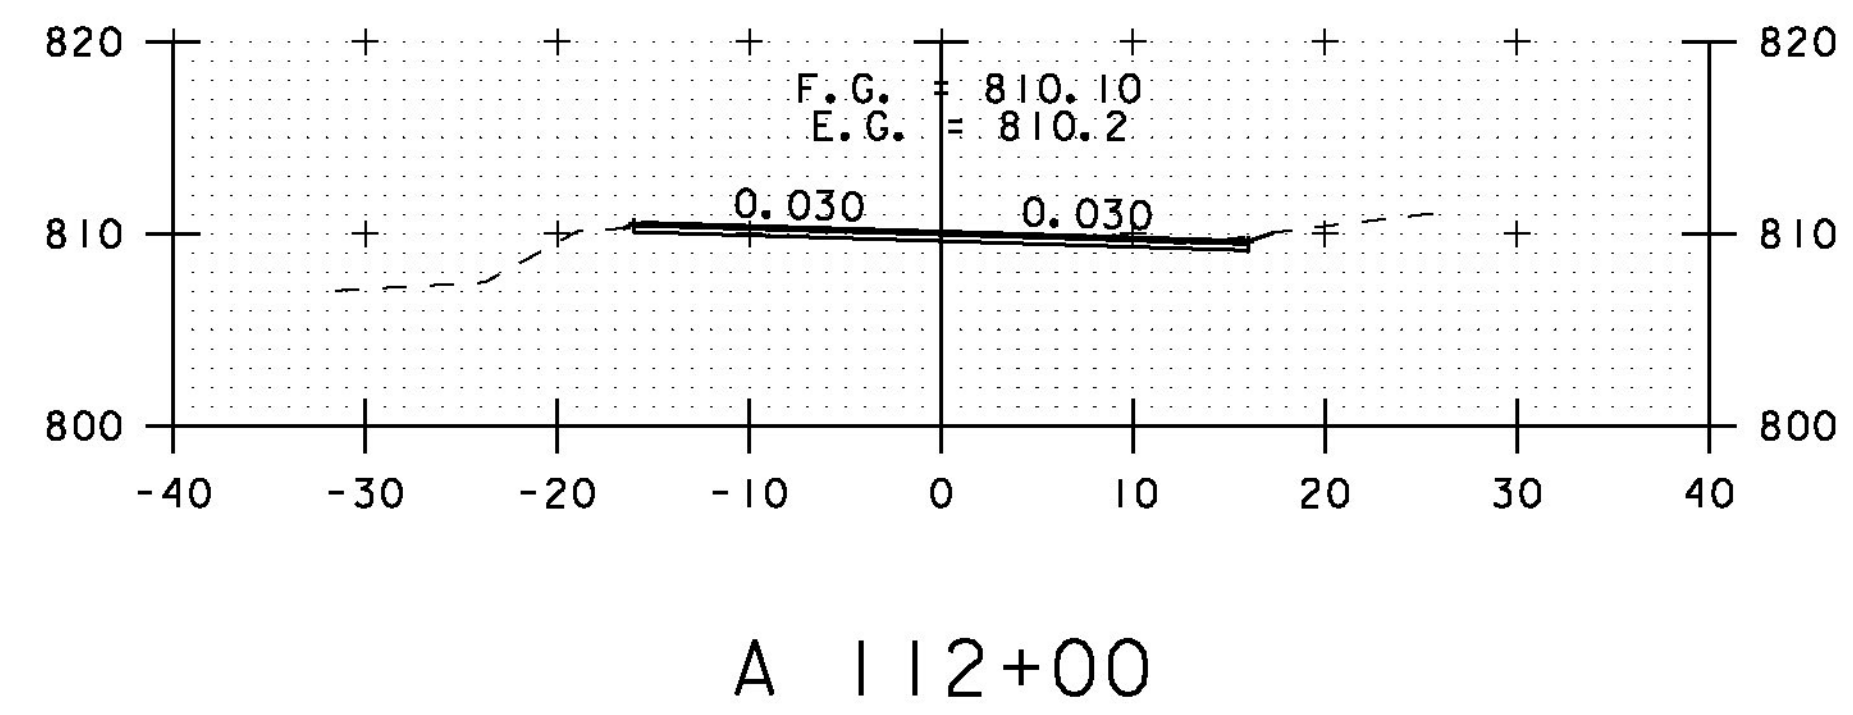


A 112+00

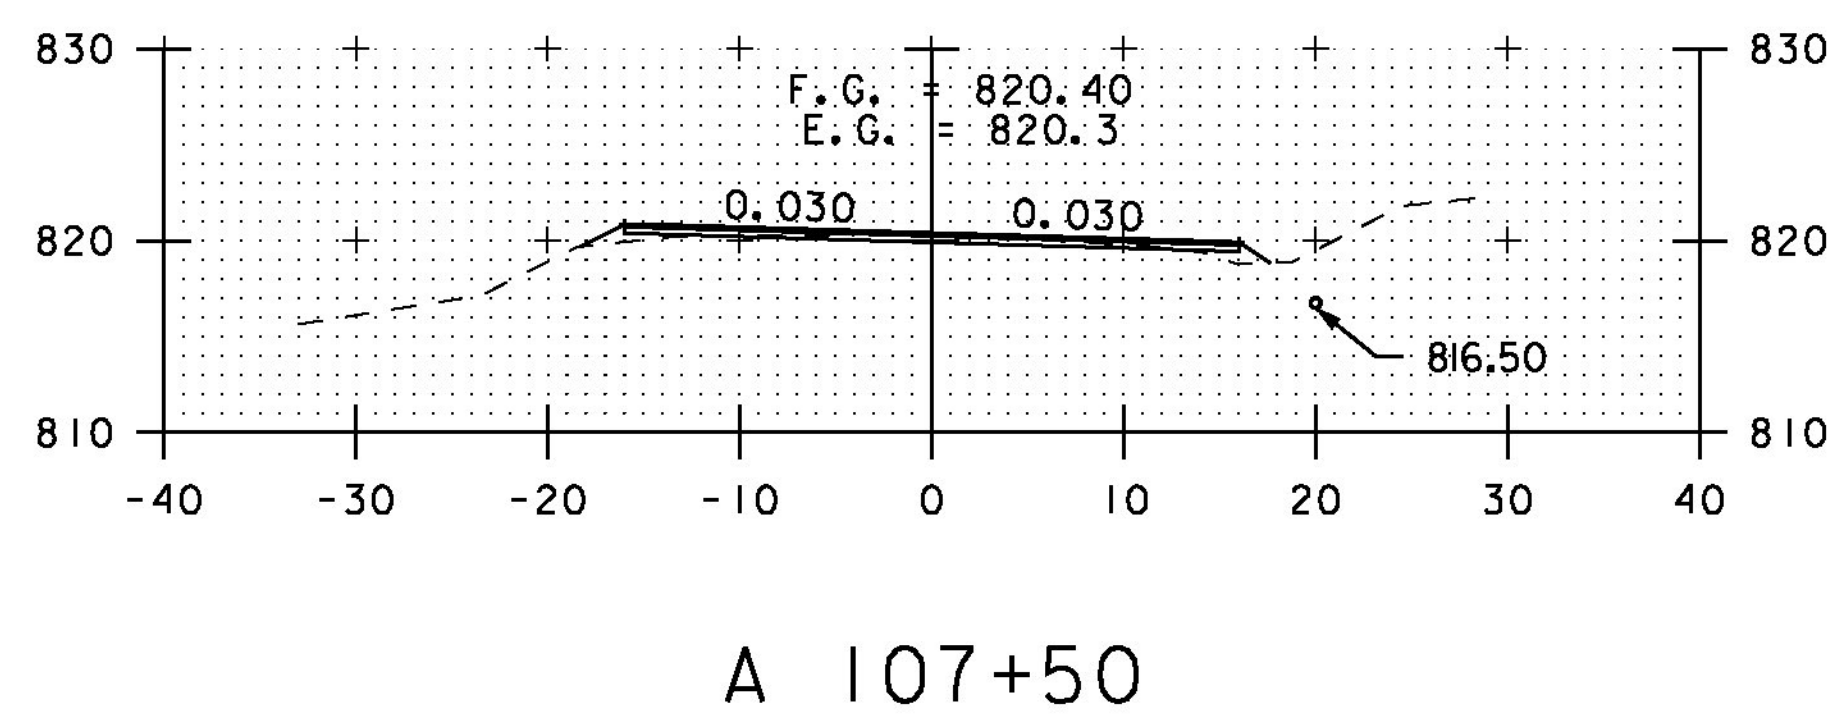


A 107+50

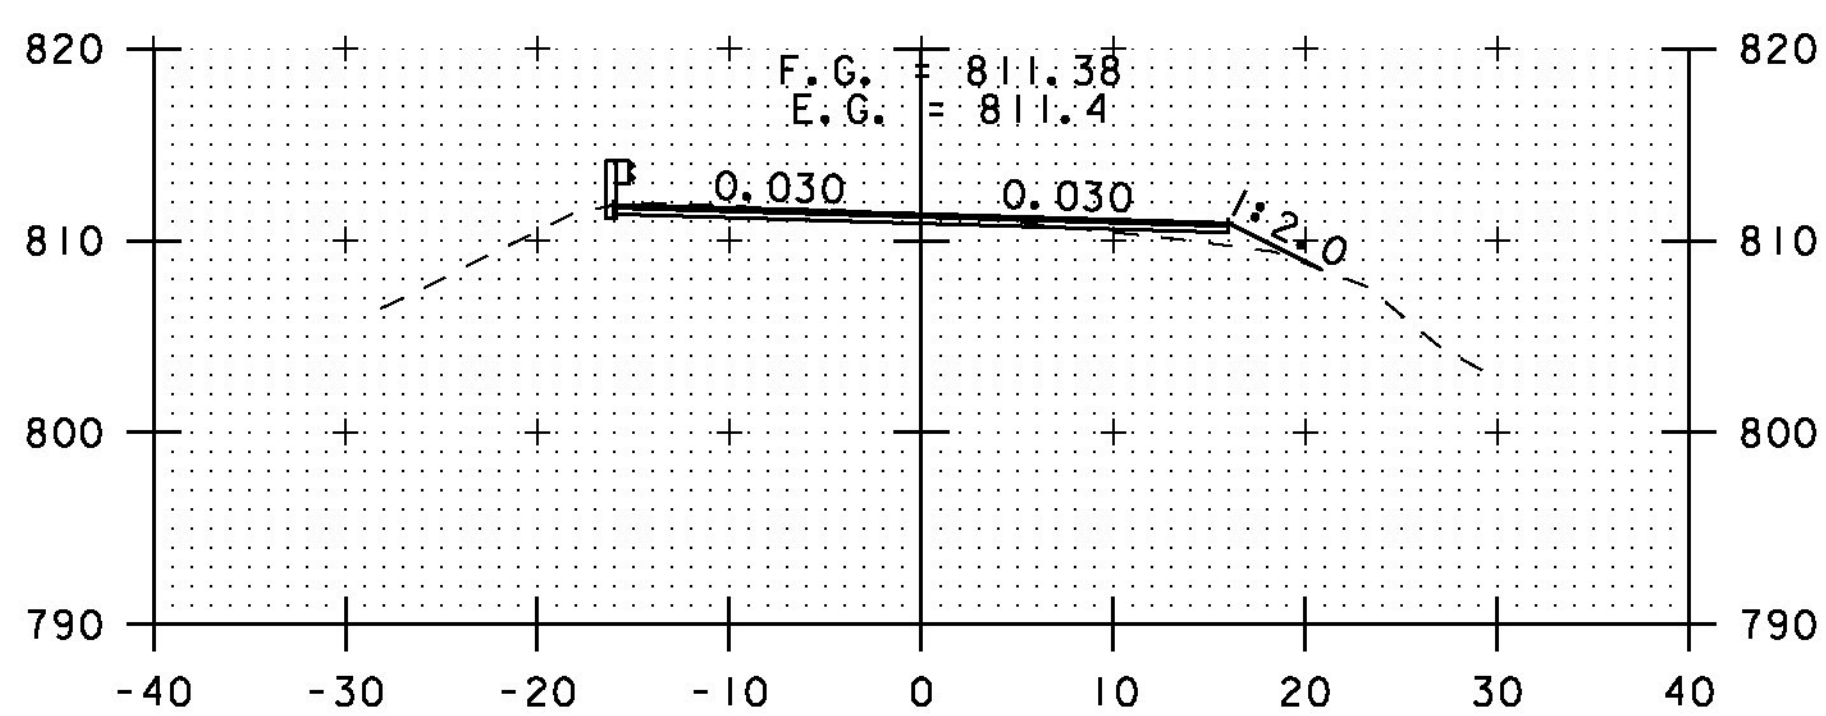


A 109+50

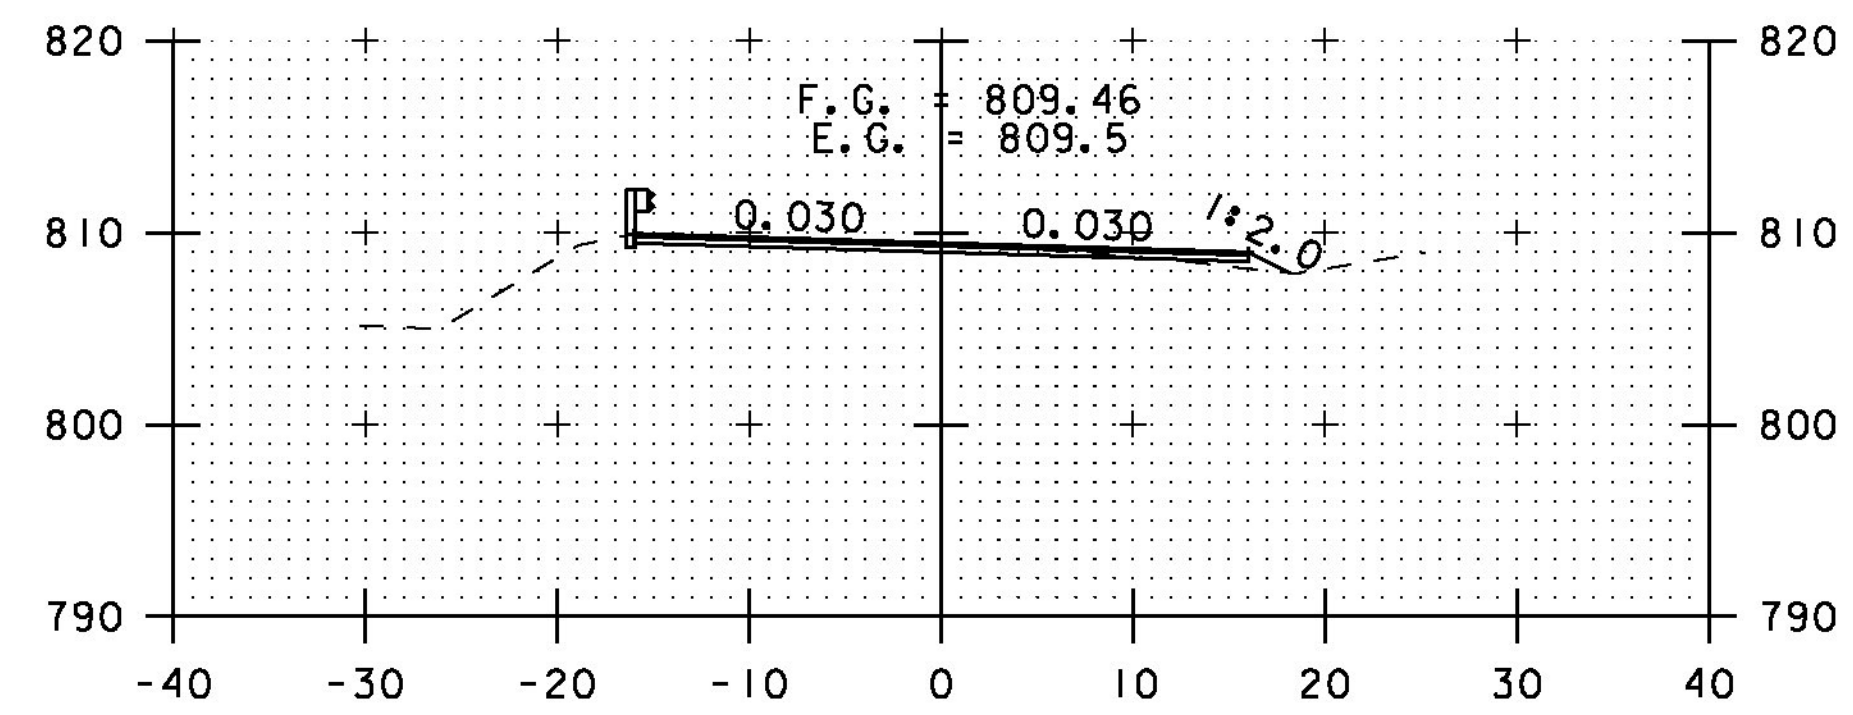


A 111+50

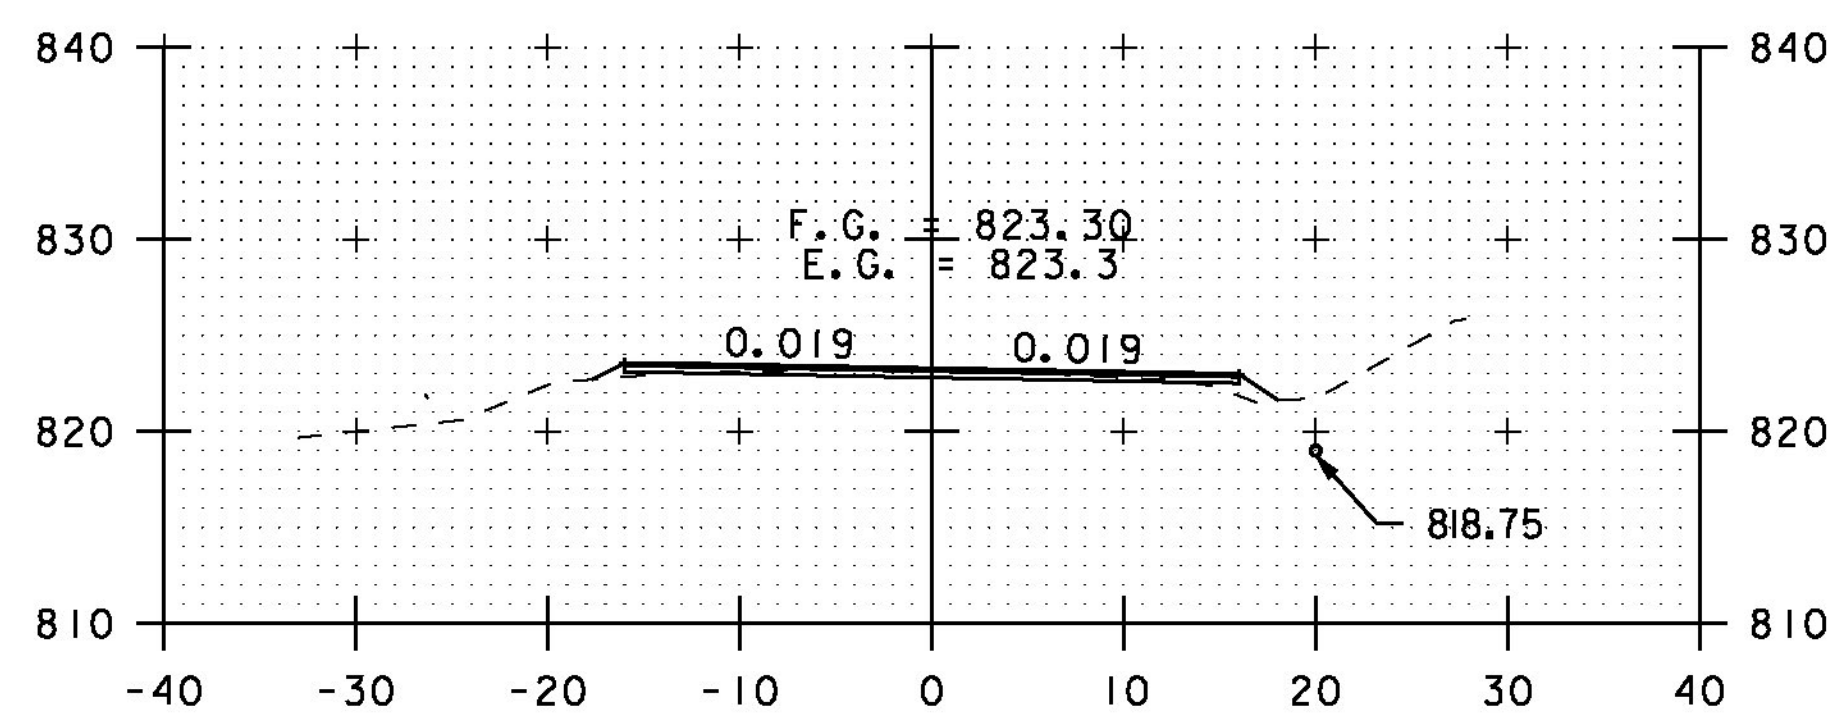

A 107+00

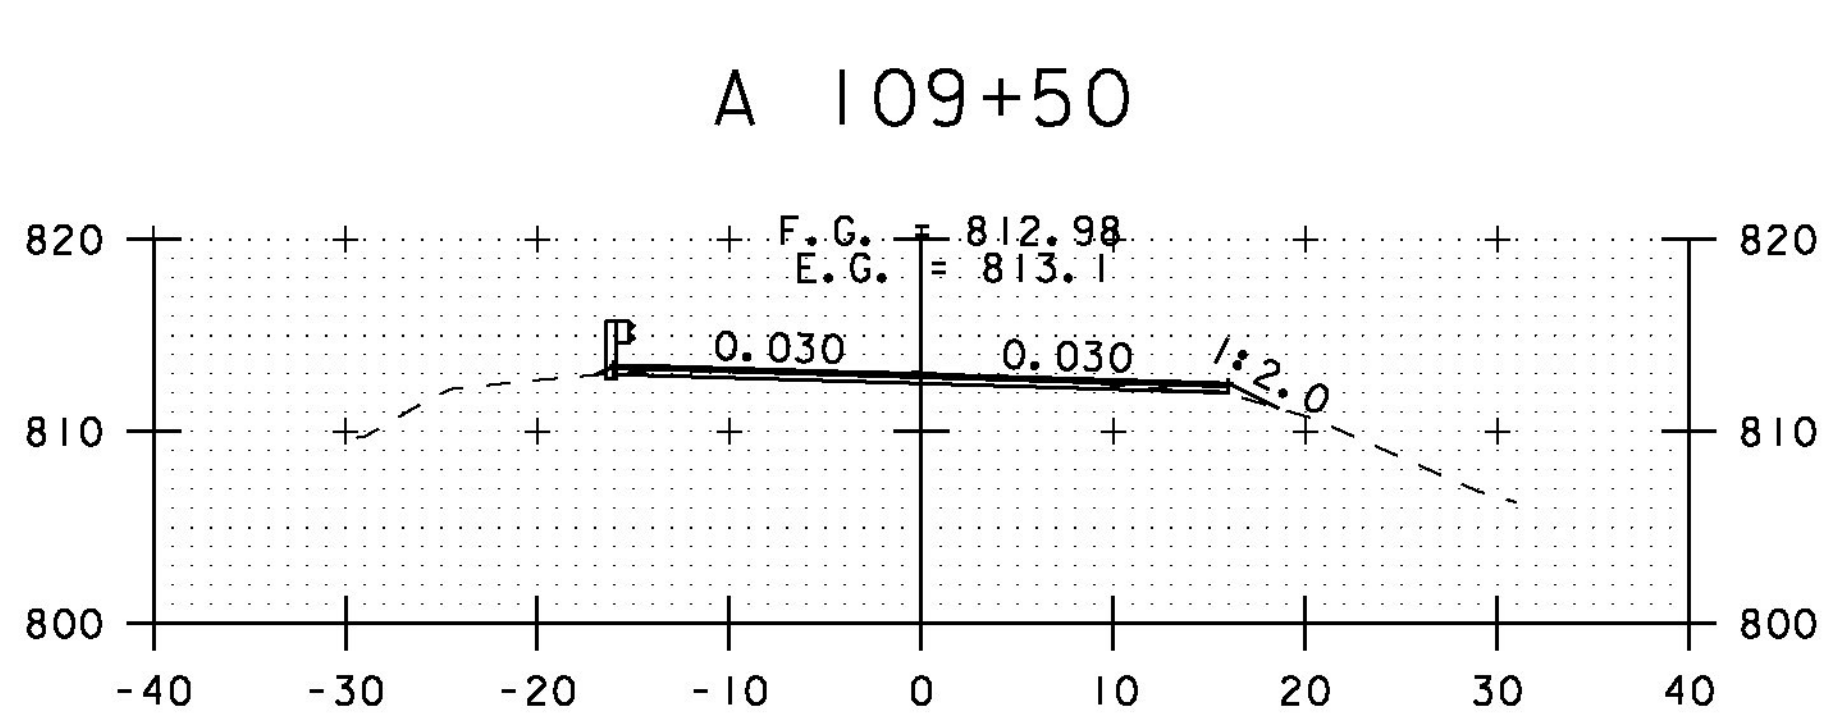

A 109+00

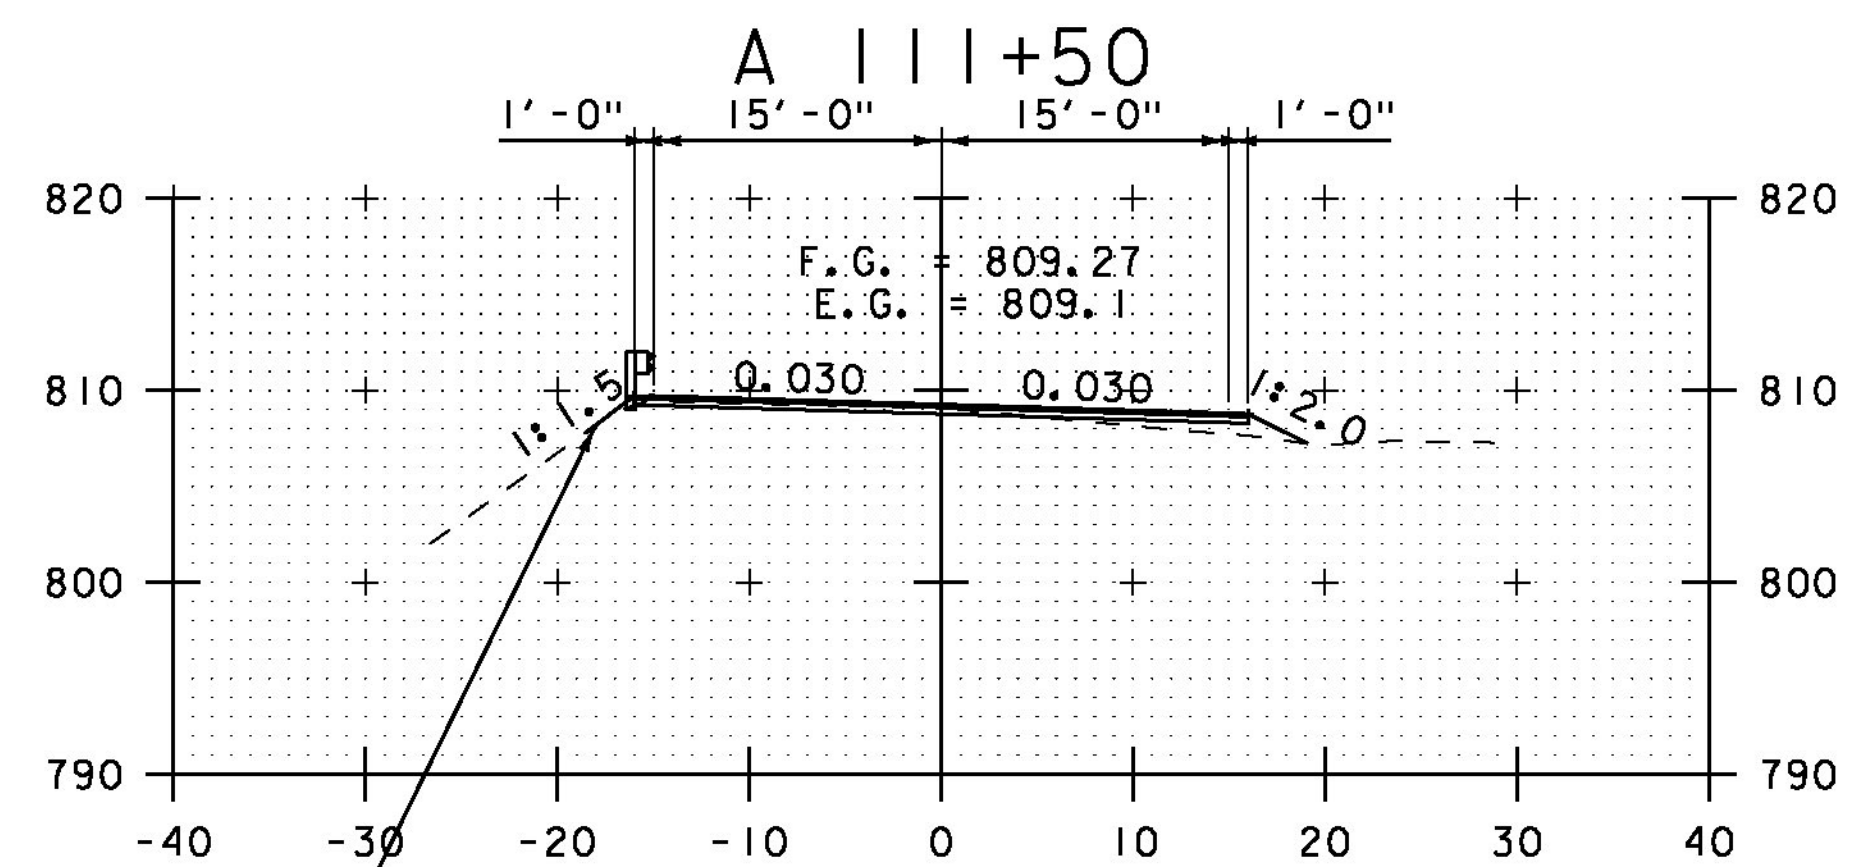

A 111+00

STA. A 107+00 TO STA. A 112+50

SCALE 1" = 10'-0"

CROSS SECTION SHEET 61

PROJECT NAME: ELMORE-MORRISTOWN

PROJECT NUMBER: STP 2937 (I)

FILE NAME: z11c310.dgn
 PROJECT LEADER: C. LATHROP
 DESIGNED BY: S. LAMPHERE
 PLOT FILE: z11c310_189.i

PLOT DATE: 3/3/14
 DRAWN BY: B. MARTIN
 CHECKED BY: C. LATHROP
 SHEET 189 OF 194