


PLAN
 SCALE 1" = 10'-0"
 10 0 10

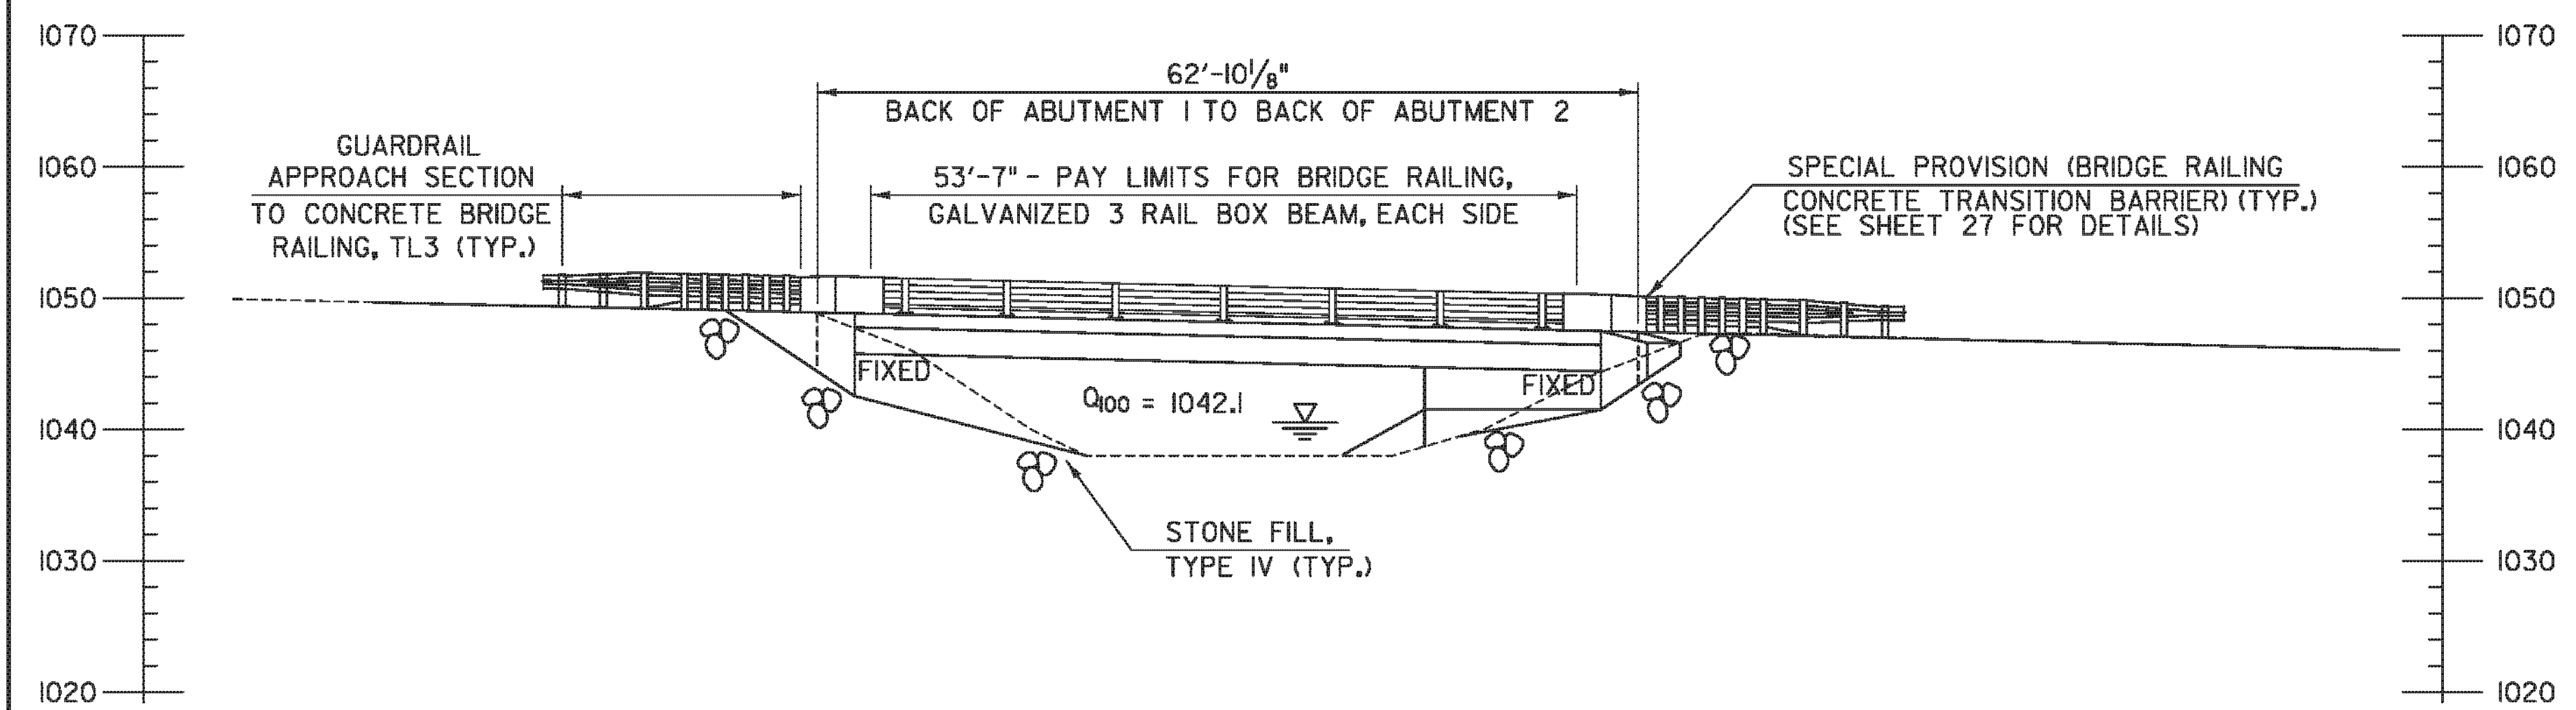

ELEVATION @ DOWNSTREAM FASCIA
 SCALE 1" = 10'-0"
 10 0 10

TYLINTERNATIONAL

PROJECT NAME: PLYMOUTH	PLOT DATE: 9/20/2012
PROJECT NUMBER: ER BRS 0149(5)	DRAWN BY: S. MORGAN
FILE NAME: zllc330bdr_pe_01.dgn	CHECKED BY: J. OLUND
PROJECT LEADER: J. OLUND	SHEET 18 OF 46
DESIGNED BY: D. MYERS	BRIDGE PLAN & ELEVATION