
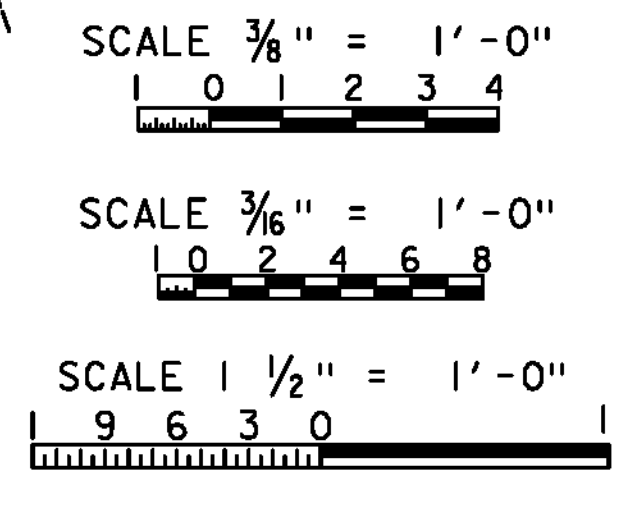


FLANGE CLOSURE POUR DETAILS
SCALE: 1/2" = 1'-0"

* TWO LONGITUDINAL #5 BARS SHALL BE PLACED AS SHOWN ALONG ENTIRE LENGTH OF EACH FLANGE CLOSURE POUR AND TERMINATED WITH A STANDARD HOOK IN THE CAST IN-PLACE PORTION OF THE ABUTMENTS. PAYMENT SHALL BE INCIDENTAL TO SPECIAL PROVISION (PRESTRESSED CONCRETE, NEXT D BEAM) (NEXT 32 D).

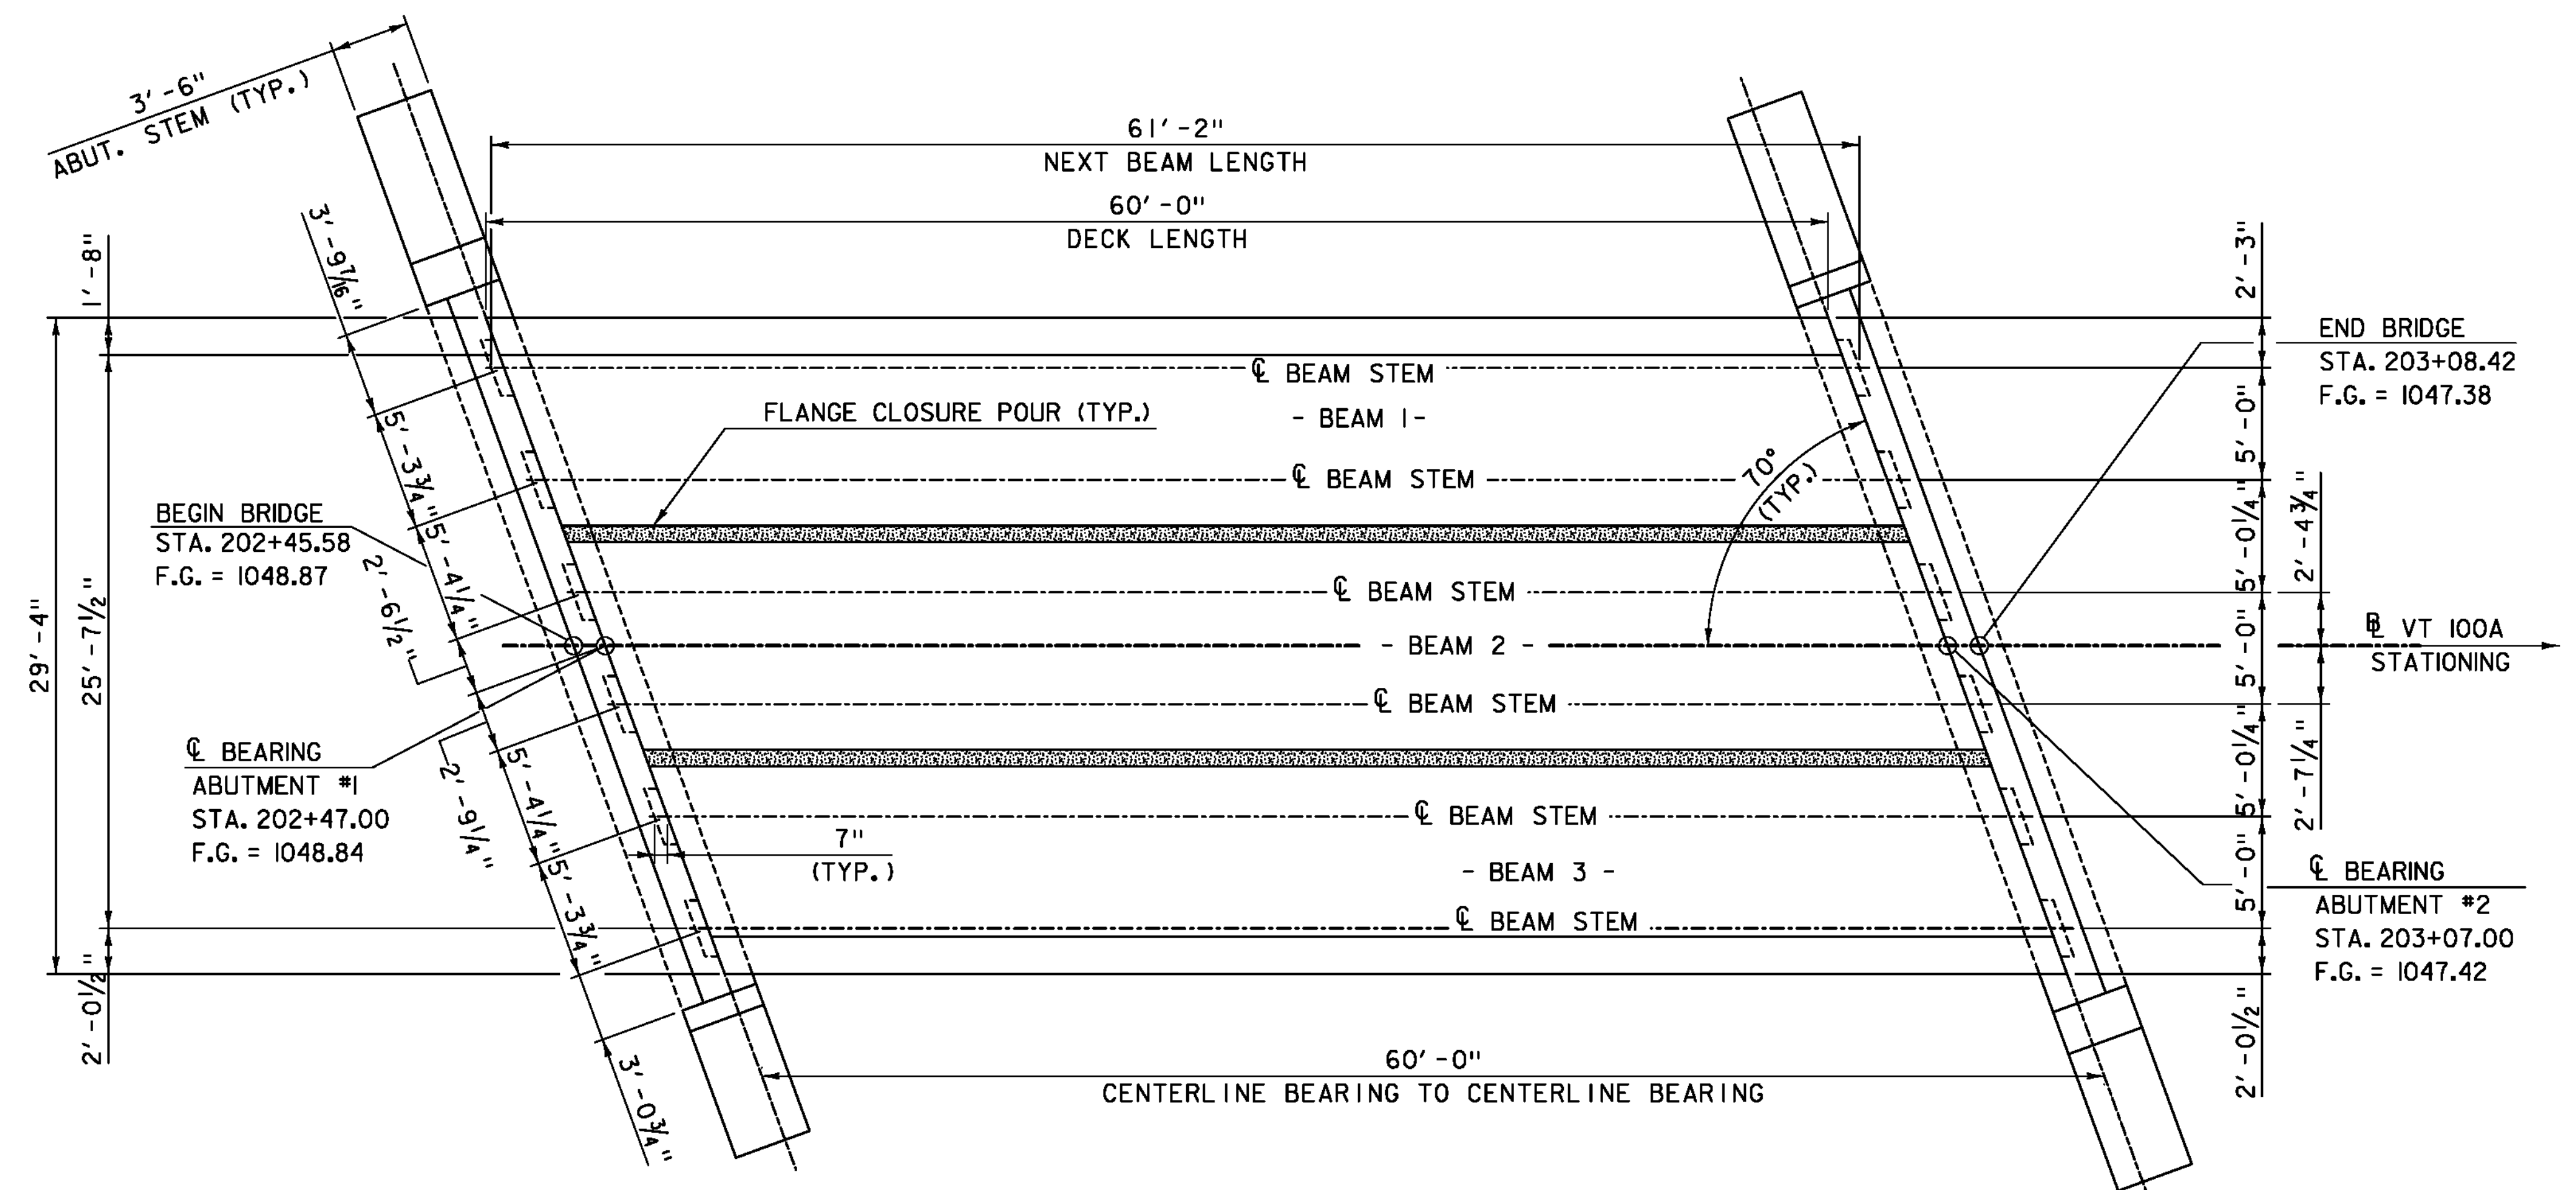

TYLIN INTERNATIONAL	PROJECT NAME: PLYMOUTH	PLOT DATE: 9/20/2012
	PROJECT NUMBER: ER BRS 0149(5)	DRAWN BY: T. KELLEY
	FILE NAME: zilc330sup.dgn	CHECKED BY: S. KELLER
	PROJECT LEADER: J. OLUND	SHEET 19 OF 46
	DESIGNED BY: D. MYERS	
	FRAMING PLAN	