


SOIL CLASSIFICATION
 TUNBRIDGE-LYMAN COMPLEX
 VERY ROCKY
 35 TO 60% SLOPES
 "K FACTOR" 0.28
 HIGH ERODIBILITY

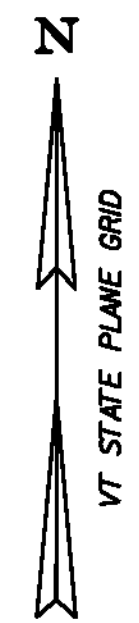

SOIL CLASSIFICATION
 BERKSHIRE AND MONADNOCK
 FINE SANDY LOAMS, VERY STONY
 35 TO 60% SLOPES
 "K FACTOR" 0.28
 HIGH ERODIBILITY

SOIL CLASSIFICATION
 CROGHAN AND SHEEPSHOT
 FINE SANDY LOAMS
 0 TO 8% SLOPES
 "K FACTOR" 0.24
 MEDIUM ERODIBILITY

LEGEND:

- WETLAND CLASS III
- AER E&T AERIAL ELECTRIC & TELEPHONE
- SOIL CLASSIFICATION BOUNDARY

SCALE 1" = 20'-0"
 20 0 20

TYL INTERNATIONAL

PROJECT NAME: PLYMOUTH
 PROJECT NUMBER: ER BRS 0149(5)

FILE NAME: zllc330bdr_ero.dgn
 PROJECT LEADER: J. OLUND
 DESIGNED BY: S. AMOROSO
 EPSC EXISTING CONDITIONS LAYOUT 1

PLOT DATE: 9/20/2012
 DRAWN BY: S. AMOROSO
 CHECKED BY: D. BRYANT
 SHEET 33 OF 46

