
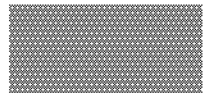



NOTES:  
 CONTOURS REFLECT EXISTING CONDITIONS.  
 SEE CROSS SECTION SHEETS FOR FINAL GRADES.

- LEGEND:
-  WETLAND CLASS III
  -  DISTURBED AREAS REQUIRING RE-VEGETATION
  -  STONE FILL, TYPE IV

SCALE 1" = 20'-0"  
 20 0 20

TYLIN INTERNATIONAL

PROJECT NAME: PLYMOUTH  
 PROJECT NUMBER: ER BRS 0149(5)

FILE NAME: zilc330bdr\_ero.dgn  
 PROJECT LEADER: J. OLUND  
 DESIGNED BY: S. AMOROSO  
 EPSC FINAL CONDITIONS LAYOUT I

PLOT DATE: 9/20/2012  
 DRAWN BY: S. AMOROSO  
 CHECKED BY: D. BRYANT  
 SHEET 37 OF 46