
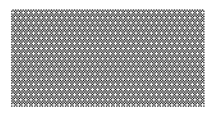
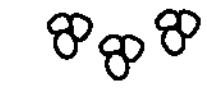


NOTES:
 CONTOURS REFLECT EXISTING CONDITIONS.
 SEE CROSS SECTION SHEETS FOR FINAL GRADES.

- LEGEND:**
-  WETLAND CLASS III
 -  DISTURBED AREAS REQUIRING RE-VEGETATION
 -  STONE FILL, TYPE IV

SCALE 1" = 20'-0"
 20 0 20

TYLININTERNATIONAL

PROJECT NAME: PLYMOUTH	FILE NAME: zlc330bdr_ero.dgn	PLOT DATE: 9/20/2012
PROJECT NUMBER: ER BRS 0149(5)	PROJECT LEADER: J. OLUND	DRAWN BY: S. AMOROSO
	DESIGNED BY: S. AMOROSO	CHECKED BY: D. BRYANT
	EPSC FINAL CONDITIONS LAYOUT 2	SHEET 38 OF 46