

INDEX OF SHEETS

- 1 TITLE SHEET
- 2 QUANTITY SHEET
- 3-7 ROUTE QUANTITIES SHEETS
- 8-9 INTERCHANGE QUANTITIES AND MATERIALS SHEETS
- 10-17 HAND WORK QUANTITIES SHEETS
- 18-19 LANE REDUCTION ARROWS QUANTITY SHEETS
- 20 PAVEMENT MARKING NOTES
- 21-25 PAVEMENT MARKING DETAILS SHEETS
- 26 RUMBLE STRIP DETAIL SHEET

STANDARDS

- E-106 TRAFFIC CONTROL MISCELLANEOUS DETAILS 03/01/04
- E-112 TRAFFIC CONTROL FOR TYPICAL MOVING MAINTENANCE OPERATIONS 01/23/97

STATE OF VERMONT AGENCY OF TRANSPORTATION




PROPOSED IMPROVEMENT

STATEWIDE NATIONAL HIGHWAY SYSTEM MARKING


NHG MARK (205)

LENGTH OF PROJECT 268.98 MILES

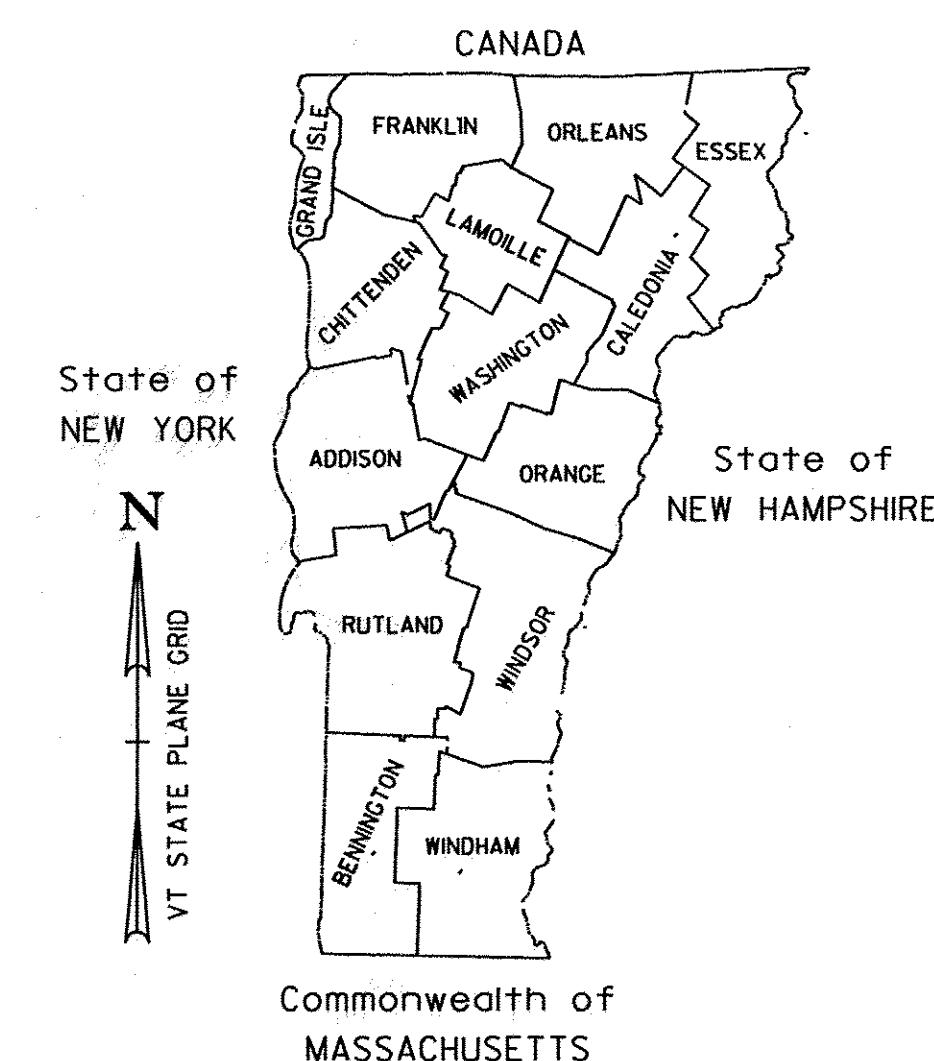

**PROPOSED IMPROVEMENT
NATIONAL HIGHWAY SYSTEM
PAVEMENT MARKING**


WORK TO BE PERFORMED UNDER THIS PROJECT INCLUDES GRINDING CENTERLINE RUMBLE STRIPS, NEW PAVEMENT MARKINGS INCLUDING CENTERLINES, EDGELINES, LANE LINES, DASHED AND DOTTED ACCELERATION AND DECELERATION LANES, GORE MARKINGS, STOP BARS AND STOP LETTERS, SYMBOLS, AND CROSSWALKS.

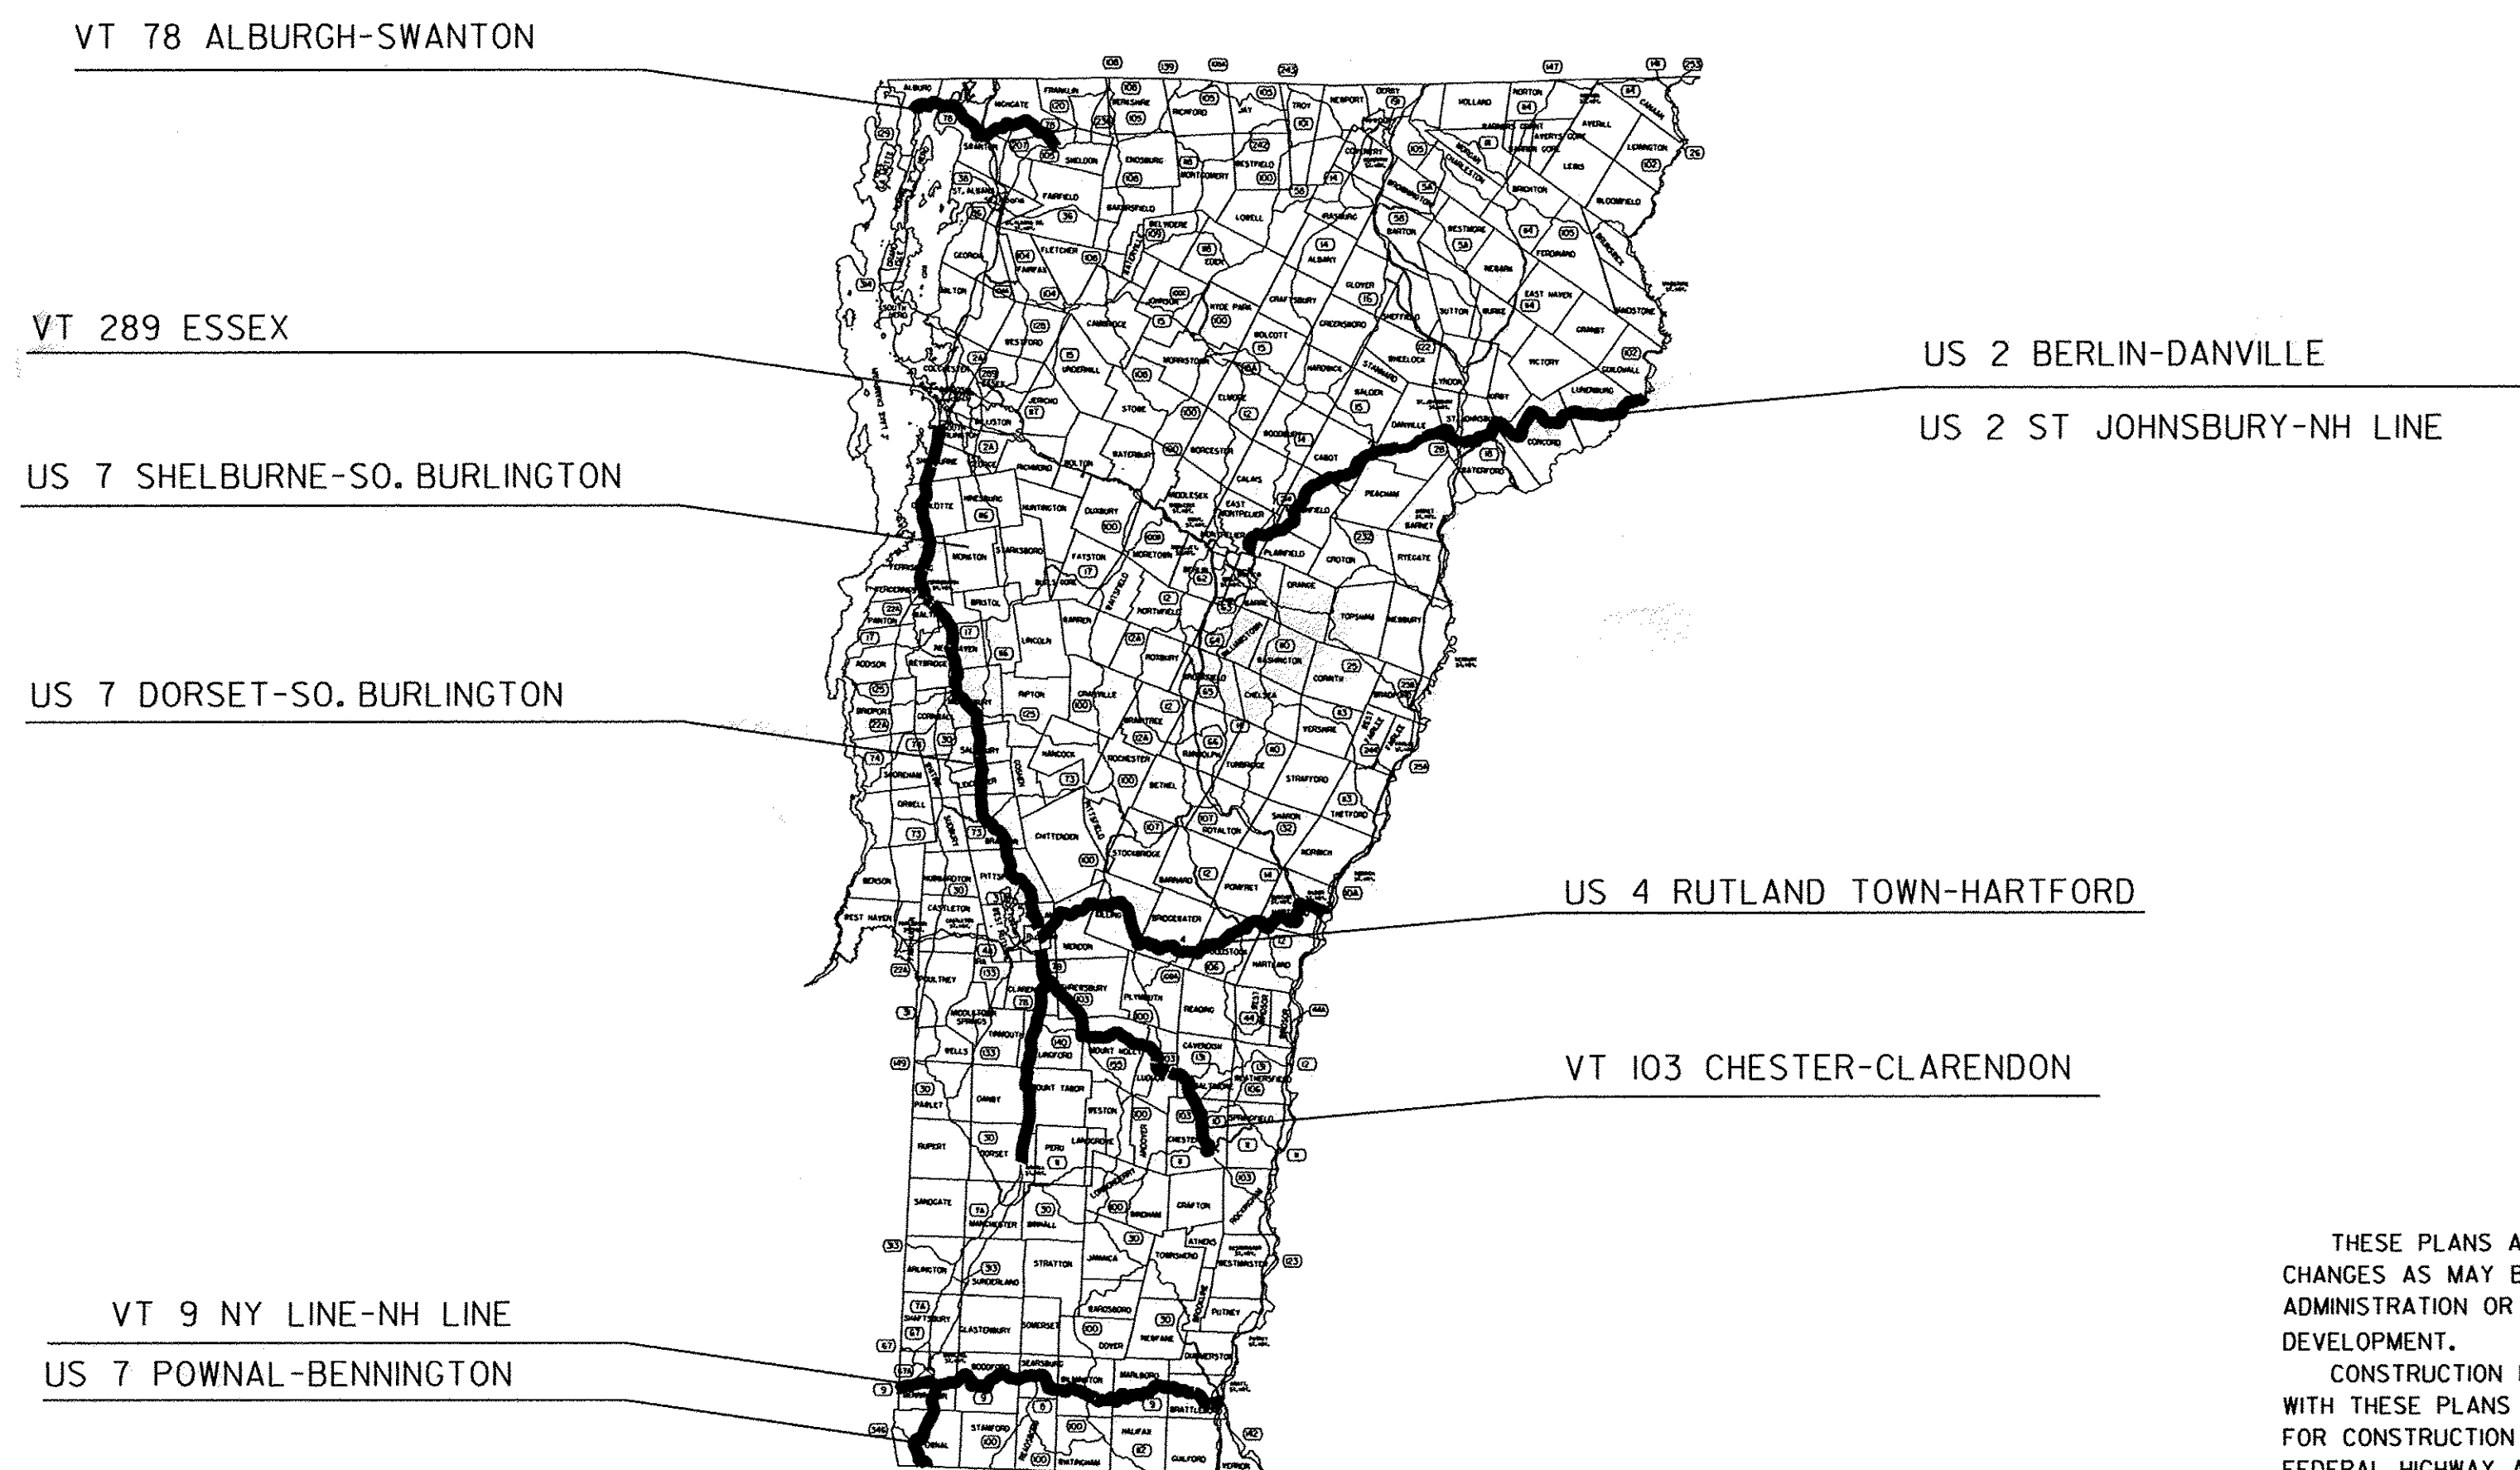

RECORD PLANS	
CONTRACTOR:	L&D SAFETY MARKINGS CORP.-BERLIN, VT
RESIDENT ENGINEER:	TIM POCKETT
CONSTRUCTION BEGAN:	JULY 18, 2011
CONSTRUCTION COMPLETE:	OCTOBER 20, 2011
RECORD PLANS BY:	TIM POCKETT
I HEREBY CERTIFY THAT ALL THE CONSTRUCTION REQUIRED BY THIS SET OF DRAWINGS HAS BEEN ACCOMPLISHED AS INDICATED HEREIN.	
BY:	RESIDENT ENGINEER
DATE:	03-02-2012
NOTE: Any further information concerning final quantities, amounts or other details relative to this project may be found at Central Files in the electronic archives.	

CONVENTIONAL SYMBOLS

COUNTY LINE	
TOWN LINE	
LIMITS OF ACCESS	
POINT OF ACCESS	
FENCE LINE	
STONE WALL	
TRAVELED WAY	
GUARD RAIL	
RAILROAD	
SURVEY LINE	
CULVERT	
POWER POLE	
TELEPHONE POLE	
TREES	
CONTROL OF ACCESS	
PROPERTY LINE	
R.O.W. TAKING LINE	
SLOPE RIGHTS	
TOP OF CUT	
TOE OF SLOPE	

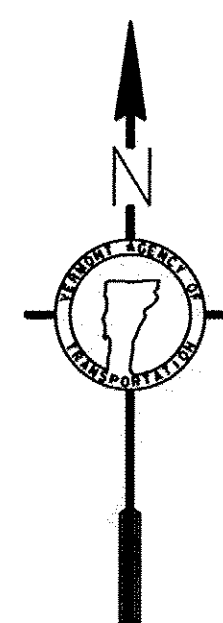

SURVEYED BY : N/A
SURVEYED DATE : N/A

DATUM
VERTICAL N/A
HORIZONTAL N/A

THESE PLANS ARE SUBJECT TO SUCH ENGINEERING CHANGES AS MAY BE REQUIRED BY THE FEDERAL HIGHWAY ADMINISTRATION OR THE DIRECTOR OF PROGRAM DEVELOPMENT.
CONSTRUCTION IS TO BE CARRIED ON IN ACCORDANCE WITH THESE PLANS AND THE STANDARD SPECIFICATIONS FOR CONSTRUCTION DATED 2006, AS APPROVED BY THE FEDERAL HIGHWAY ADMINISTRATION ON JUNE 15, 2006 FOR USE ON THIS PROJECT, INCLUDING ALL SUBSEQUENT REVISIONS AND SUCH REVISED SPECIFICATIONS AND SPECIAL PROVISIONS AS ARE INCORPORATED IN THESE PLANS.

DIRECTOR OF PROGRAM DEVELOPMENT	
APPROVED _____	DATE _____
PROJECT MANAGER : A GAMBLE	
PROJECT NAME : STATEWIDE	
PROJECT NUMBER : NHG MARK (205)	
SHEET 1 OF 26 SHEETS	