

6 INCH WHITE LINE

- MM 3.978 ~ 4.146 LT (SOLID)(EDGE LINE)
- MM 3.978 ~ 4.146 LT (DASHED)
- MM 3.978 ~ 4.146 RT (SOLID)(EDGE LINE)
- MM 3.978 ~ 4.106 RT (DASHED)
- MM 4.050 ~ 4.070 RT (DOTTED)
- MM 4.070 ~ 4.106 RT (DOTTED)
- MM 4.070 ~ 4.146 RT (SOLID)(LANE LINE) (12' RT)
- MM 4.106 ~ 4.146 RT (SOLID)(LANE LINE) (24' RT)
- MM 4.106 ~ 4.146 RT (SOLID)(LANE LINE) (36' RT)

6 INCH YELLOW LINE



- MM 3.978 ~ 4.146 CL (SOLID)(DBL)

24 INCH STOP BAR

- MM 4.146 RT

LETTER OR SYMBOL

- MM 4.070 RT (↵)
- MM 4.082 RT (ONLY)
- MM 4.095 RT (↵)
- MM 4.106 RT (↵)
- MM 4.107 RT (ONLY)
- MM 4.115 RT (ONLY)
- MM 4.119 RT (↵)
- MM 4.125 RT (↵)
- MM 4.132 RT (ONLY)(12' RT)
- MM 4.134 RT (ONLY)
- MM 4.144 RT (↵)(12' RT)
- MM 4.144 RT (↵)

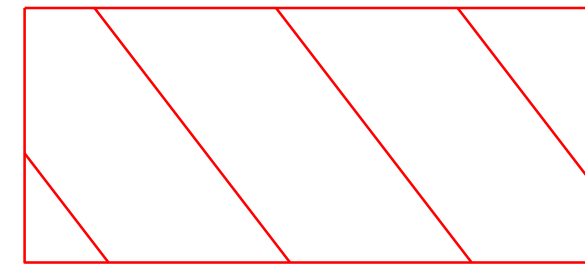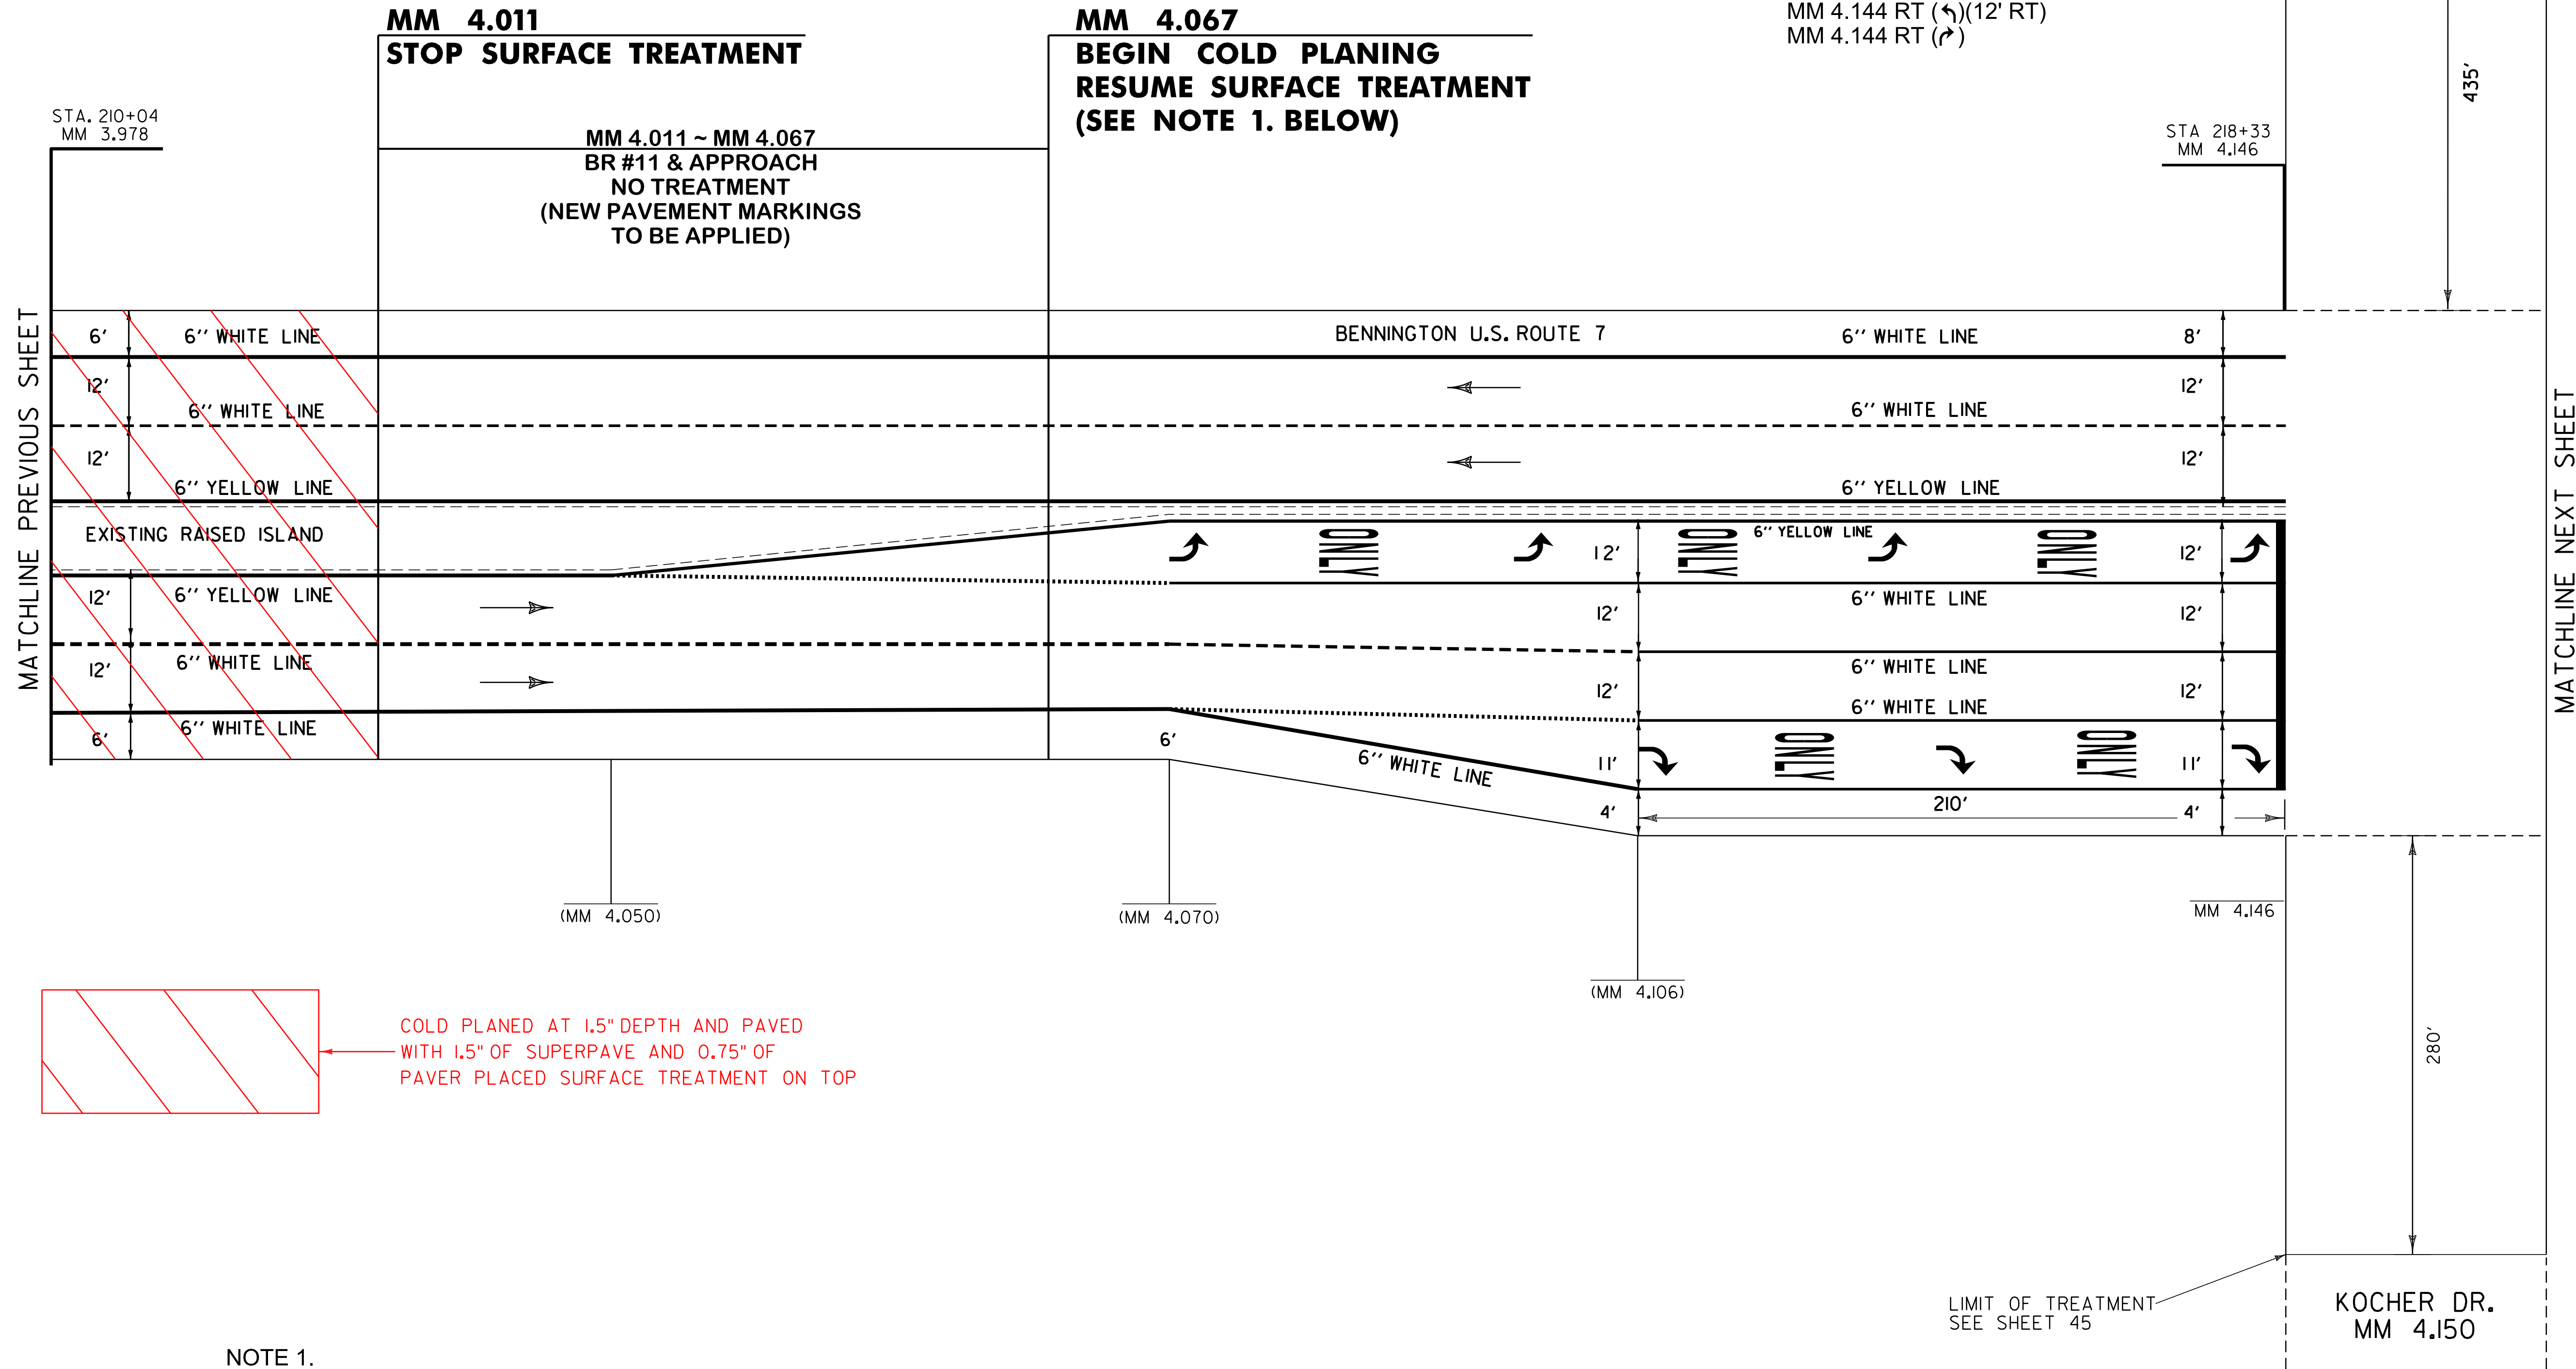

COLD PLANED AT 1.5" DEPTH AND PAVED WITH 1.5" OF SUPERPAVE AND 0.75" OF PAVER PLACED SURFACE TREATMENT ON TOP

NOTE 1.
 STA. 4.067 ~ 4.196: COLD PLANE 1.5", PAVE WITH 1.5" TYPE IVS, APPLY ALTERNATE A OR B.
 TACK COAT APPLICATION:
 COLD PLANED SURFACE--0.080 GAL/SY SPECIAL PROVISION (EMULSIFIED ASPHALT) (RS-1H OR CRS-1H)
 ALL OTHER PAVED SURFACES--0.080 GAL/SY SPECIAL PROVISION (EMULSIFIED ASPHALT) (RS-1H OR CRS-1H).
 SEE DETAIL ON SHEET 6.

NOT TO SCALE

PAVING PROJECT LAYOUT #2	PROJECT NAME: BENNINGTON-MANCHESTER	FILE NAME: I1b026\I1b026.dgn	PLOT DATE: 22-AUG-2013 14:34
	PROJECT NUMBER: NH SURF(29)	PROJECT LEADER: M. FOWLER	DRAWN BY: JLR
		DESIGNED BY: JLR	CHECKED BY: PVT. MGT.
		I1b026-11.i	SHEET 11 OF 63